
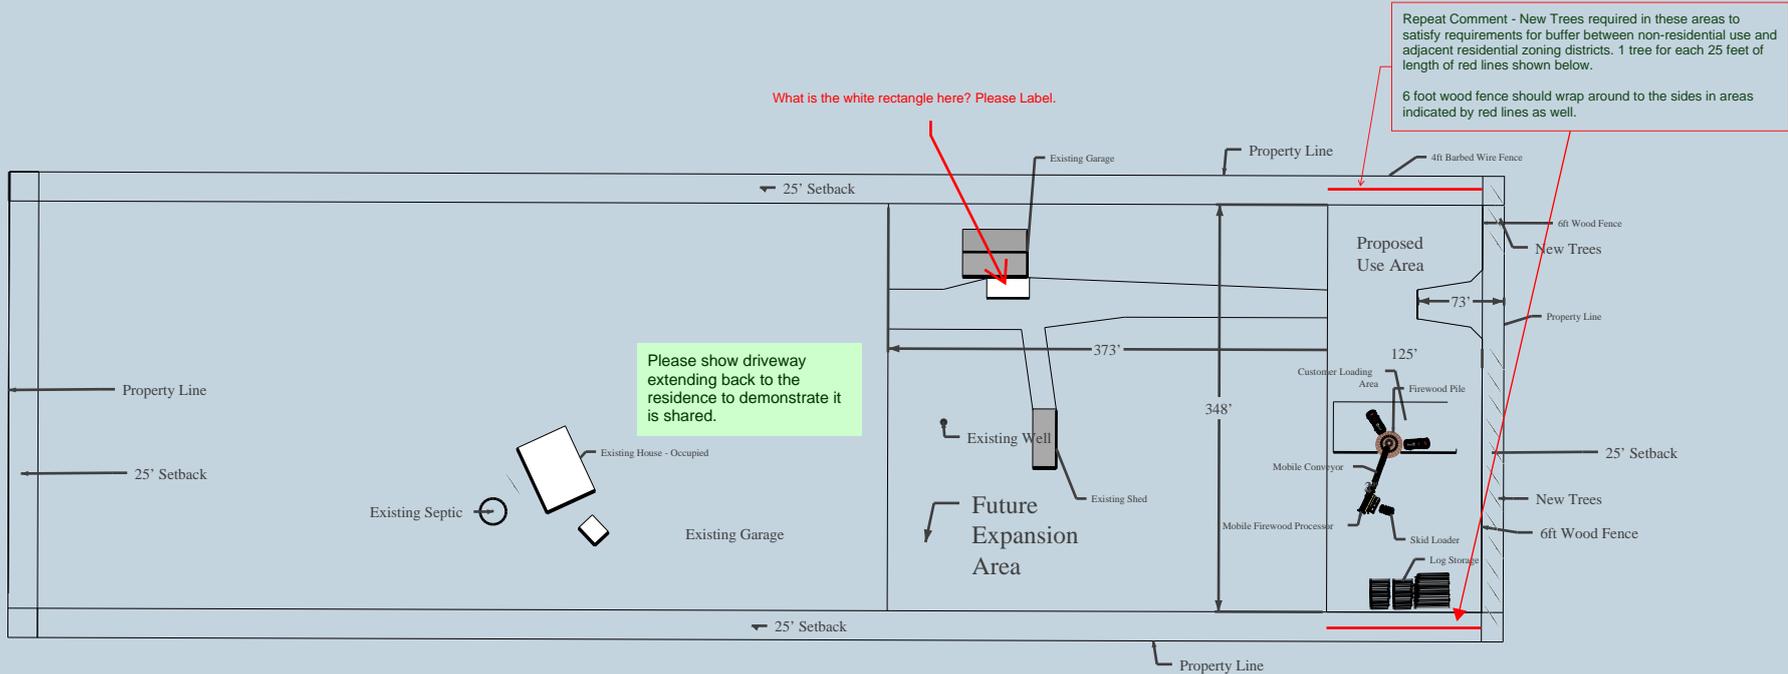


# SITE PLAN

Address: 11556 Highway 94  
Colorado Springs, CO, 80929

Scale 1"=120'

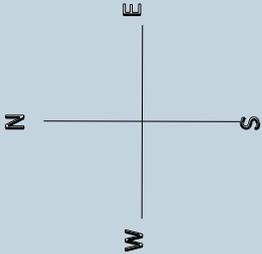


# Site Plan\_v3\_redlines.pdf Markup Summary

---

## Arrow (1)

---

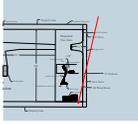


**Subject:** Arrow  
**Page Label:** 1  
**Author:** Lindsay Darden  
**Date:** 10/20/2019 5:48:14 PM  
**Status:**  
**Color:** ■  
**Layer:**  
**Space:**

---

## Callout (2)

---

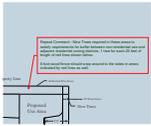

**Subject:** Callout  
**Page Label:** 1  
**Author:** Lindsay Darden  
**Date:** 10/20/2019 5:48:10 PM  
**Status:**  
**Color:** ■  
**Layer:**  
**Space:**

Repeat Comment - New Trees required in these areas to satisfy requirements for buffer between non-residential use and adjacent residential zoning districts. 1 tree for each 25 feet of length of red lines shown below.

6 foot wood fence should wrap around to the sides in areas indicated by red lines as well.




**Subject:** Callout  
**Page Label:** 1  
**Author:** Lindsay Darden  
**Date:** 10/20/2019 5:49:44 PM  
**Status:**  
**Color:** ■  
**Layer:**  
**Space:**

What is the white rectangle here? Please Label.

---

## Line (2)

---

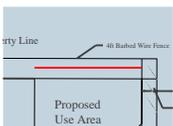

**Subject:** Line  
**Page Label:** 1  
**Author:** Lindsay Darden  
**Date:** 10/20/2019 5:43:23 PM  
**Status:**  
**Color:** ■  
**Layer:**  
**Space:**



**Subject:** Line  
**Page Label:** 1  
**Author:** Lindsay Darden  
**Date:** 10/20/2019 5:43:38 PM  
**Status:**  
**Color:** ■  
**Layer:**  
**Space:**

---

Text Box (1)

---



**Subject:** Text Box  
**Page Label:** 1  
**Author:** Lindsay Darden  
**Date:** 10/20/2019 5:51:09 PM  
**Status:**  
**Color:** ■  
**Layer:**  
**Space:**

Please show driveway extending back to the residence to demonstrate it is shared.