

BE IT KNOWN BY THESE PRESENTS:

THAT CLASSIC SRJ LAND, LLC, A COLORADO LIMITED LIABILITY COMPANY BEING THE OWNER OF THE FOLLOWING DESCRIBED TRACT OF LAND TO WIT:

LEGAL DESCRIPTION:

A PARCEL OF LAND BEING A PORTION OF THE SOUTHEAST QUARTER OF SECTION 33 AND THE SOUTHWEST QUARTER OF SECTION 34, TOWNSHIP 12 SOUTH, RANGE 65 WEST OF THE SIXTH PRINCIPAL MERIDIAN, EL PASO COUNTY, COLORADO, BEING MORE PARTICULARLY DESCRIBED AS FOLLOWS:

BASIS OF BEARINGS: THE SOUTH LINE OF THE SOUTHEAST QUARTER OF THE NORTHEAST QUARTER OF SECTION 28, TOWNSHIP 12 SOUTH, RANGE 65 WEST OF THE SIXTH PRINCIPAL MERIDIAN, BEING MONUMENTED AT THE WEST END WHICH IS THE CENTER-EAST ONE-SIXTEENTH CORNER OF SAID SECTION 28, BY A 3-1/4" ALUMINUM SURVEYORS CAP STAMPED "ESI PLS 10376, 2006" AND AT THE EAST END, WHICH IS A 30' WITNESS CORNER TO THE EAST OF THE EAST QUARTER CORNER OF SAID SECTION 28, BY A 3-1/4" ALUMINUM SURVEYORS CAP STAMPED "ESI 10376, 2006", DETERMINED FROM GPS OBSERVATIONS TO BEAR N89°08'28"E, A DISTANCE OF 1356.68 FEET.

COMMENCING AT THE CENTER-EAST ONE-SIXTEENTH CORNER OF SECTION 28, TOWNSHIP 12 SOUTH, RANGE 65 WEST OF THE SIXTH PRINCIPAL MERIDIAN EL PASO COUNTY, COLORADO, SAID POINT BEING THE SOUTHWESTERLY CORNER OF RETREAT AT TIMBERRIDGE FILING NO. 1 RECORDED UNDER RECEPTION NO. 220714653 RECORDS OF EL PASO COUNTY, COLORADO;

THENCE S07°13'18"E, A DISTANCE OF 6440.55 FEET TO A POINT ON CURVE SAID POINT BEING ON THE SOUTHERLY RIGHT OF WAY LINE OF STERLING RANCH ROAD AS PLATTED IN HOMESTEAD NORTH AT STERLING RANCH FILING NO. 1 RECORDED UNDER RECEPTION NO. 223715150 SAID POINT BEING ALSO THE NORTHEASTERLY CORNER OF STERLING RANCH EAST FILING NO. 3 RECORDED UNDER RECEPTION NO. SAID POINT BEING THE POINT OF BEGINNING;

THENCE ON THE SOUTHERLY RIGHT OF WAY LINE OF SAID STERLING RANCH ROAD THE FOLLOWING TWO (2) COURSES:

- 1. ON THE ARC OF A CURVE TO THE LEFT WHOSE CENTER BEARS N38°03'24"W, HAVING A DELTA OF 38°28'07", A RADIUS OF 1540.00 FEET AND A DISTANCE OF 1033.96 FEET TO A POINT OF TANGENT;
2. N13°28'29"E, A DISTANCE OF 203.00 FEET;

THENCE S76°31'31"E, A DISTANCE OF 770.18 FEET;
THENCE S13°28'29"W, A DISTANCE OF 312.80 FEET;
THENCE S11°50'41"W, A DISTANCE OF 117.53 FEET;
THENCE S02°44'13"W, A DISTANCE OF 116.36 FEET;
THENCE S00°46'00"E, A DISTANCE OF 1,815.92 FEET TO A POINT ON THE NORTHERLY BOUNDARY OF PAWNEE RANCHEROS FILING NO. 1 RECORDED IN PLAT BOOK 1-2 AT PAGE 28;
THENCE S89°14'14"W, ON THE NORTHERLY BOUNDARY OF SAID PAWNEE RANCHEROS FILING NO. 1, A DISTANCE OF 681.43 FEET TO THE SOUTHEASTERLY CORNER OF SAID STERLING RANCH FILING NO. 3;

THENCE ON THE EASTERLY BOUNDARY OF SAID STERLING RANCH FILING NO. 3 THE FOLLOWING FIVE (5) COURSES:

- 1. N00°46'00"W, A DISTANCE OF 1,085.87 FEET;
2. S89°14'00"W, A DISTANCE OF 7.06 FEET TO A POINT OF CURVE;
3. ON THE ARC OF A CURVE TO THE RIGHT, HAVING A DELTA OF 54°34'00", A RADIUS OF 575.00 FEET, AND A DISTANCE OF 547.61 FEET TO A POINT OF CURVE;
4. N36°12'00"W, A DISTANCE OF 163.72 FEET;
5. N08°06'02"E, A DISTANCE OF 35.78 FEET TO THE POINT OF BEGINNING.

CONTAINING A CALCULATED AREA OF 47.168 ACRES.

OWNERS CERTIFICATE:

THE UNDERSIGNED, BEING ALL THE OWNERS, MORTGAGEES, BENEFICIARIES OF DEEDS OF TRUST AND HOLDERS OF OTHER INTERESTS IN THE LAND DESCRIBED HEREIN, HAVE LAID OUT, SUBDIVIDED, AND PLATTED SAID LANDS INTO LOTS, TRACTS, STREETS, AND EASEMENTS AS SHOWN HEREON UNDER THE NAME AND SUBDIVISION OF STERLING RANCH EAST FILING NO. 5. ALL PUBLIC IMPROVEMENTS SO PLATTED ARE HEREBY DEDICATED TO PUBLIC USE AND SAID OWNER DOES HEREBY COVENANT AND AGREE THAT THE PUBLIC IMPROVEMENTS WILL BE CONSTRUCTED TO EL PASO COUNTY STANDARDS AND THAT PROPER DRAINAGE AND EROSION CONTROL FOR SAME WILL BE PROVIDED AT SAID OWNER'S EXPENSE, ALL TO THE SATISFACTION OF THE BOARD OF COUNTY COMMISSIONERS OF EL PASO COUNTY, COLORADO. UPON ACCEPTANCE BY RESOLUTION, ALL PUBLIC IMPROVEMENTS SO DEDICATED WILL BECOME MATTERS OF MAINTENANCE BY EL PASO COUNTY, COLORADO. THE UTILITY EASEMENTS SHOWN HEREON ARE HEREBY DEDICATED FOR PUBLIC UTILITIES AND COMMUNICATION SYSTEMS AND OTHER PURPOSES AS SHOWN HEREON. THE ENTITIES RESPONSIBLE FOR PROVIDING THE SERVICES FOR WHICH THE EASEMENTS ARE ESTABLISHED ARE HEREBY GRANTED THE PERPETUAL RIGHT OF INGRESS AND EGRESS FROM AND TO ADJACENT PROPERTIES FOR INSTALLATION, MAINTENANCE, AND REPLACEMENT OF UTILITY LINES AND RELATED FACILITIES.

OWNER:

THE AFOREMENTIONED, CLASSIC SRJ LAND, LLC, A COLORADO LIMITED LIABILITY COMPANY HAS EXECUTED THIS INSTRUMENT THIS ___ DAY OF ____, 20__.

BY: DOUGLAS M. STIMPLE, CEO, ELITE PROPERTIES OF AMERICA, INC. MANAGER OF CLASSIC SRJ LAND, LLC, A COLORADO LIMITED LIABILITY COMPANY, THE SUBDIVIDER(S) AGREE ON BEHALF OF HIM/HERSELF AND ANY DEVELOPER OR BUILDER, SUCCESSORS AND ASSIGNS THAT SUBDIVIDER AND/OR SAID SUCCESSORS AND ASSIGNS SHALL BE REQUIRED TO PAY TRAFFIC IMPACT FEES IN ACCORDANCE WITH THE EL PASO COUNTY ROAD IMPACT FEE PROGRAM RESOLUTION (RESOLUTION NO. 19-471) OR ANY AMENDMENTS THERETO, AT OR PRIOR TO THE TIME OF BUILDING PERMIT SUBMITTALS. THE FEE OBLIGATION IF NOT PAID AT FINAL PLAT RECORDING SHALL BE DOCUMENTED ON ALL SALES DOCUMENTS AND ON PLAT NOTES TO ENSURE THAT A TITLE SEARCH WOULD FIND THE FEE OBLIGATION BEFORE SALE OF THE PROPERTY.

STATE OF COLORADO)
)ss
COUNTY OF EL PASO)

ACKNOWLEDGED BEFORE ME THIS ___ DAY OF ____, 20__ BY DOUGLAS M. STIMPLE AS CEO, ELITE PROPERTIES OF AMERICA INC. MANAGER OF CLASSIC SRJ LAND, LLC, A COLORADO LIMITED LIABILITY COMPANY.

WITNESS MY HAND AND OFFICIAL SEAL.


MY COMMISSION EXPIRES: ___ NOTARY PUBLIC

NOTICE:

ACCORDING TO COLORADO LAW YOU MUST COMMENCE ANY LEGAL ACTION BASED UPON ANY DEFECT IN THIS SURVEY WITHIN THREE YEARS AFTER YOU FIRST DISCOVER SUCH DEFECT. IN NO EVENT, MAY ANY ACTION BASED UPON ANY DEFECT IN THIS SURVEY BE COMMENCED MORE THAN TEN YEARS FROM THE DATE OF THE CERTIFICATION SHOWN HEREON.

STERLING RANCH EAST FILING NO. 5

A PORTION OF THE SOUTHEAST QUARTER OF SECTION 33 AND THE SOUTHWEST QUARTER OF SECTION 34, TOWNSHIP 12 SOUTH, RANGE 65 WEST OF THE SIXTH PRINCIPAL MERIDIAN, EL PASO COUNTY, COLORADO

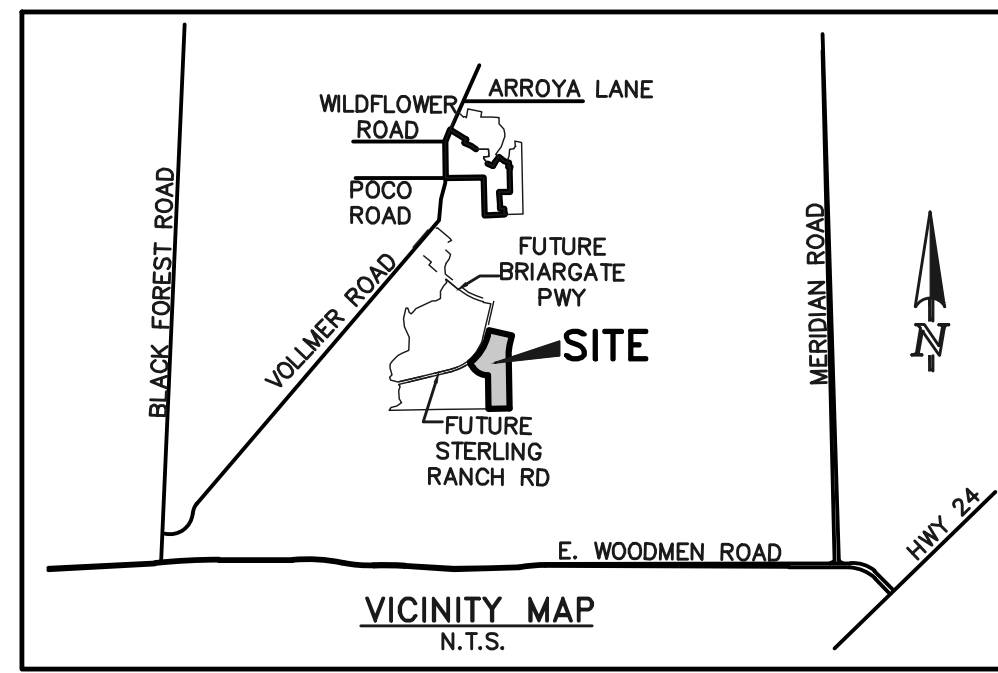

Add clarifying notes addressing landscape; we will install and own along certain roads

GENERAL NOTES:

- 1. THE DATE OF PREPARATION IS JUNE 1, 2024.
2. ANY PERSON WHO KNOWINGLY REMOVES, ALTERS OR DEFACES ANY PUBLIC LAND SURVEY MONUMENT OR LAND BOUNDARY MONUMENT OR ACCESSORY COMMITS A CLASS TWO (2) MISDEMEANOR PURSUANT TO C.R.S. § 18-4-50B"
3. THIS PROPERTY IS SUBJECT TO STERLING RANCH METROPOLITAN DISTRICT NO. 1, AS EVIDENCED BY INSTRUMENT RECORDED UNDER RECEPTION NO. 215110523 AND AS AMENDED.
4. ALL PROPERTY WITHIN THIS SUBDIVISION IS SUBJECT TO THE DECLARATION OF COVENANTS, CONDITIONS, RESTRICTIONS AND EASEMENTS FOR STERLING RANCH EAST FILING NO. 5 RECORDED UNDER RECEPTION NO. RECORDS OF EL PASO COUNTY, COLORADO.
5. TRACT I IS FOR PUBLIC RIGHT-OF-WAY AND IS DEDICATED TO EL PASO COUNTY FOR RIGHT-OF-WAY PURPOSES BY THIS PLAT.
6. THE FOLLOWING REPORTS HAVE BEEN SUBMITTED IN ASSOCIATION WITH THE PRELIMINARY PLAN OR FINAL PLAT FOR THIS SUBDIVISION AND ARE ON FILE AT THE COUNTY PLANNING AND COMMUNITY DEVELOPMENT DEPARTMENT: TRANSPORTATION IMPACT STUDY; DRAINAGE REPORT; WATER RESOURCES REPORT; WASTEWATER DISPOSAL REPORT; GEOLOGY AND SOILS REPORT; FIRE PROTECTION REPORT; WILDFIRE HAZARD REPORT; NATURAL FEATURES REPORT; SP-235
7. ALL PROPERTY OWNERS ARE RESPONSIBLE FOR MAINTAINING PROPER STORM WATER DRAINAGE IN AND THROUGH THEIR PROPERTY. PUBLIC DRAINAGE EASEMENTS AS SPECIFICALLY NOTED ON THE PLAT SHALL BE MAINTAINED BY THE INDIVIDUAL LOT OWNERS UNLESS OTHERWISE INDICATED. STRUCTURES, FENCES, MATERIALS OR LANDSCAPING THAT COULD IMPEDE THE FLOW OF RUNOFF SHALL NOT BE PLACED IN DRAINAGE EASEMENTS.
8. UNLESS OTHERWISE INDICATED, ALL SIDE, FRONT, AND REAR LOT LINES ARE HEREBY PLATTED ON EITHER SIDE WITH A 5 FOOT PUBLIC UTILITY AND DRAINAGE EASEMENT UNLESS OTHERWISE INDICATED. ALL EXTERIOR SUBDIVISION BOUNDARIES ARE HEREBY PLATTED WITH A 7 FOOT PUBLIC UTILITY AND DRAINAGE EASEMENT. THE SOLE RESPONSIBILITY FOR MAINTENANCE OF THESE EASEMENTS IS HEREBY VESTED WITH THE INDIVIDUAL PROPERTY OWNERS.
9. DEVELOPER SHALL COMPLY WITH FEDERAL AND STATE LAWS, REGULATIONS, ORDINANCES, REVIEW AND PERMIT REQUIREMENTS, AND OTHER AGENCY REQUIREMENTS, IF ANY, OF APPLICABLE AGENCIES INCLUDING, BUT NOT LIMITED TO, THE COLORADO DIVISION OF PARKS AND WILDLIFE, COLORADO DEPARTMENT OF TRANSPORTATION, U.S. ARMY CORPS OF ENGINEERS AND THE U.S. FISH AND WILDLIFE SERVICE AND/OR COLORADO DEPARTMENT OF WILDLIFE REGARDING THE ENDANGERED SPECIES ACT.
10. THE ADDRESSES () EXHIBITED ON THIS PLAT ARE FOR INFORMATIONAL PURPOSES ONLY. THEY ARE NOT THE LEGAL DESCRIPTION AND ARE SUBJECT TO CHANGE.
11. NO DRIVEWAY SHALL BE ESTABLISHED UNLESS AN ACCESS PERMIT HAS BEEN GRANTED BY EL PASO COUNTY.
12. MAILBOXES SHALL BE INSTALLED IN ACCORDANCE WITH ALL EL PASO COUNTY AND UNITED STATES POSTAL SERVICE REGULATIONS.
13. NO LOT OR INTEREST THEREIN, SHALL BE SOLD, CONVEYED, OR TRANSFERRED WHETHER BY DEED OR BY CONTRACT, NOR SHALL BUILDING PERMITS BE ISSUED, UNTIL AND UNLESS EITHER THE REQUIRED PUBLIC AND COMMON DEVELOPMENT IMPROVEMENTS HAVE BEEN CONSTRUCTED AND COMPLETED AND PRELIMINARILY ACCEPTED IN ACCORDANCE WITH THE SUBDIVISION IMPROVEMENTS AGREEMENT BETWEEN THE APPLICANT/OWNER AND EL PASO COUNTY AS RECORDED UNDER RECEPTION NUMBER ___ IN THE OFFICE OF THE CLERK AND RECORDER OF EL PASO COUNTY, COLORADO OR, IN THE ALTERNATIVE, OTHER COLLATERAL IS PROVIDED TO MAKE PROVISION FOR THE COMPLETION OF SAID IMPROVEMENTS IN ACCORDANCE WITH THE EL PASO COUNTY LAND DEVELOPMENT CODE AND ENGINEERING CRITERIA MANUAL. ANY SUCH ALTERNATIVE, COLLATERAL MUST BE APPROVED BY THE BOARD OF COUNTY COMMISSIONERS OR, IF PERMITTED BY THE SUBDIVISION IMPROVEMENTS AGREEMENT, BY THE PLANNING AND COMMUNITY DEVELOPMENT DEPARTMENT DIRECTOR AND MEET THE POLICY AND PROCEDURE REQUIREMENTS OF EL PASO COUNTY PRIOR TO THE RELEASE BY THE COUNTY OF ANY LOTS FOR SALE, CONVEYANCE OR TRANSFER.
THIS PLAT RESTRICTION MAY BE REMOVED OR RESCINDED BY THE BOARD OF COUNTY COMMISSIONERS OR, IF PERMITTED BY THE SUBDIVISION IMPROVEMENTS AGREEMENT, BY THE PLANNING AND COMMUNITY DEVELOPMENT DEPARTMENT DIRECTOR UPON EITHER APPROVAL OF AN ALTERNATIVE FORM OF COLLATERAL OR COMPLETION AND PRELIMINARY ACCEPTANCE BY THE EL PASO BOARD OF COUNTY COMMISSIONERS OF ALL IMPROVEMENTS REQUIRED TO BE CONSTRUCTED AND COMPLETED IN ACCORDANCE WITH SAID SUBDIVISION IMPROVEMENTS AGREEMENT. THE PARTIAL RELEASE OF LOTS FOR SALE, CONVEYANCE OR TRANSFER MAY ONLY BE GRANTED IN ACCORDANCE WITH ANY PLANNED PARTIAL RELEASE OF LOTS AUTHORIZED BY THE SUBDIVISION IMPROVEMENTS AGREEMENT.
14. THE SUBDIVIDER(S) AGREE ON BEHALF OF HIM/HERSELF AND ANY DEVELOPER OR BUILDER, SUCCESSORS AND ASSIGNEES THAT SUBDIVIDER AND/OR SAID SUCCESSORS AND ASSIGNS SHALL BE REQUIRED TO PAY TRAFFIC IMPACT FEES IN ACCORDANCE WITH THE EL PASO COUNTY ROAD IMPACT FEE PROGRAM RESOLUTION (RESOLUTION NO. 19-471) OR ANY AMENDMENTS THERETO, AT OR PRIOR TO THE TIME OF BUILDING PERMIT SUBMITTALS. THE FEE OBLIGATION IF NOT PAID AT FINAL PLAT RECORDING SHALL BE DOCUMENTED ON ALL SALES DOCUMENTS AND ON PLAT NOTES TO ENSURE THAT A TITLE SEARCH WOULD FIND THE FEE OBLIGATION BEFORE SALE OF THE PROPERTY.
15. PURSUANT TO RESOLUTION ____, APPROVED BY THE BOARD OF DIRECTORS, EL PASO COUNTY PUBLIC IMPROVEMENT DISTRICT AND RECORDED IN THE RECORDS OF THE EL PASO COUNTY CLERK AND RECORDED AT RECEPTION NO. ____, THE PARCELS WITHIN THE PLATTED BOUNDARY OF STERLING RANCH EAST FILING NO. 5 IS INCLUDED WITHIN THE BOUNDARIES OF THE EL PASO COUNTY PUBLIC IMPROVEMENT DISTRICT NO. 3 AND AS SUCH ARE SUBJECT TO APPLICABLE ROAD IMPACT FEES AND MILL LEVY.
16. THERE SHALL BE NO DIRECT LOT ACCESS TO STERLING RANCH ROAD.
17. INDIVIDUAL LOT PURCHASERS ARE RESPONSIBLE FOR CONSTRUCTING DRIVEWAYS, INCLUDING NECESSARY DRAINAGE CULVERTS PER LAND DEVELOPMENT CODE SECTION 6.3.3.C.2 AND 6.3.3.C.3. DUE TO THEIR LENGTH, SOME OF THE DRIVEWAYS WILL NEED TO BE SPECIFICALLY APPROVED BY THE BLACK FOREST FIRE DISTRICT.
18. GAS SERVICE FOR THIS SUBDIVISION IS PROVIDED BY COLORADO SPRINGS UTILITIES SUBJECT TO THE PROVIDERS RULES, REGULATIONS AND SPECIFICATIONS.THE SUBDIVIDER/DEVELOPER IS RESPONSIBLE FOR EXTENDING UTILITIES TO EACH LOT, TRACT OR BUILDING SITE.
19. ELECTRIC SERVICE FOR THIS SUBDIVISION IS PROVIDED BY MOUNTAIN VIEW ELECTRIC ASSOCIATION SUBJECT TO THE PROVIDERS RULES, REGULATIONS AND SPECIFICATIONS.THE SUBDIVIDER/DEVELOPER IS RESPONSIBLE FOR EXTENDING UTILITIES TO EACH LOT, TRACT OR BUILDING SITE.

GENERAL NOTES (CONT.):

- 20. THIS PROPERTY IS SUBJECT TO A PRIVATE DETENTION BASIN/STORMWATER QUALITY BMP MAINTENANCE AGREEMENT AND EASEMENT AS RECORDED UNDER RECEPTION NO. ___ OF THE RECORDS OF EL PASO COUNTY. STERLING RANCH METROPOLITAN DISTRICT NO. 1 IS RESPONSIBLE FOR MAINTENANCE OF THE SUBJECT DRAINAGE FACILITIES. THIS PROPERTY IS SUBJECT TO A PRIVATE CHANNEL AND WETLAND MAINTENANCE AGREEMENT AND EASEMENT AS RECORDED UNDER RECEPTION NO. ___ OF THE RECORDS OF EL PASO COUNTY. STERLING RANCH METROPOLITAN DISTRICT NO. 1 IS RESPONSIBLE FOR MAINTENANCE OF THE SUBJECT DRAINAGE FACILITIES.
21. THE OVERALL SITE HAS BEEN FOUND TO BE IMPACTED BY GEOLOGIC HAZARDS. MITIGATION MEASURES AND A MAP OF THE HAZARD AREA CAN BE FOUND IN THE REPORT "SOILS AND GEOLOGY STUDY FOR STERLING RANCH EAST FILING NO. 5, EL PASO COUNTY, COLORADO" BY ENTECH ENGINEERING, INC. DATED JUNE 27, 2023 IN FILE SP-23-235 AVAILABLE AT THE EL PASO COUNTY PLANNING AND COMMUNITY DEVELOPMENT DEPARTMENT.
POTENTIALLY SEASONALLY HIGH GROUNDWATER FOUND ON THE FOLLOWING LOTS: 130-132, 135-137 AND 152-155
MITIGATION FOR THESE LOTS INCLUDE OVERLOT GRADING AND INCORPORATION OF UNDERGROUND DRAINAGE SYSTEMS AROUND FOUNDATIONS WITH DIRECT CONNECTION TO UNDERDRAIN SYSTEM WITHIN ADJACENT STREET. THE UNDERDRAIN CONSTRUCTED BY THE DEVELOPER, ACCORDING TO PLANS APPROVED BY THE STERLING RANCH METROPOLITAN DISTRICT SHALL BE MAINTAINED BY STERLING RANCH METROPOLITAN DISTRICT NO. 1.
22. WATER IN THE DENVER BASIN AQUIFERS IS ALLOCATED BASED ON A 100-YEAR AQUIFER LIFE; HOWEVER, FOR EL PASO COUNTY PLANNING PURPOSES, WATER IN THE DENVER BASIN AQUIFERS IS EVALUATED BASED ON A 300-YEAR AQUIFER LIFE. APPLICANTS AND ALL FUTURE OWNERS IN THE SUBDIVISION SHOULD BE AWARE THAT THE ECONOMIC LIFE OF A WATER SUPPLY BASED ON WELLS IN A GIVEN DENVER BASIN AQUIFER MAY BE LESS THAN EITHER THE 100 YEARS OR 300 YEARS INDICATED DUE TO ANTICIPATED WATER LEVEL DECLINES. FURTHERMORE, THE WATER SUPPLY PLAN SHOULD NOT RELY SOLELY UPON NON-RENEWABLE AQUIFERS. ALTERNATIVE RENEWABLE WATER RESOURCES SHOULD BE ACQUIRED AND INCORPORATED IN A PERMANENT WATER SUPPLY PLAN THAT PROVIDES FUTURE GENERATIONS WITH A WATER SUPPLY.
23. WATER AND WASTEWATER SERVICE FOR THIS SUBDIVISION IS PROVIDED BY FALCON AREA WATER AND WASTEWATER AUTHORITY SUBJECT TO THE PROVIDERS RULES, REGULATIONS AND SPECIFICATIONS.THE SUBDIVIDER/DEVELOPER IS RESPONSIBLE FOR EXTENDING UTILITIES TO EACH LOT, TRACT OR BUILDING SITE.
24. FLOODPLAIN STATEMENT: THIS SITE, STERLING RANCH EAST FILING NO. 5, IS PARTIALLY LOCATED WITHIN A DESIGNATED F.E.M.A. FLOODPLAIN AS DETERMINED BY THE FLOOD INSURANCE RATE MAP, COMMUNITY MAP NUMBER 08041C05336, DATED DECEMBER 7, 2018. (ZONE X AND AE)
25. THIS PLAT DOES NOT CONSTITUTE A TITLE SEARCH TO DETERMINE OWNERSHIP OR EASEMENTS OF RECORD. FOR ALL INFORMATION REGARDING EASEMENTS, RIGHT-OF-WAY AND TITLE OF RECORD, CLASSIC CONSULTING ENGINEERS AND SURVEYORS AND THE SURVEYOR OF RECORD RELIED UPON THE TITLE COMMITMENT ORDER NUMBER RND55101996.5-3 ISSUED BY LAND TITLE GUARANTEE COMPANY, EFFECTIVE DATE JULY 11, 2022 AT 5:00 P.M.
26. THE EFFECT OF NOTICE CONCERNING UNDERGROUND FACILITIES OF THE MOUNTAIN VIEW ELECTRIC ASSOCIATION, INC. RECORDED MAY 9, 1983 IN BOOK 3718 AT PAGE 812 AFFECTS THE ENTIRE PROPERTY.
27. TERMS, CONDITIONS, PROVISIONS, BURDENS AND OBLIGATIONS AS SET FORTH IN EASEMENT AND AGREEMENT RECORDED MARCH 09, 2001 UNDER RECEPTION NO. 201029151 AFFECTS THAT PORTION OF THE PROPERTY THAT LIES IN THE NORTHEAST QUARTER OF THE NORTHEAST QUARTER OF THE SOUTHEAST QUARTER OF SECTION 33 AND THE NORTH HALF OF THE NORTHWEST QUARTER OF THE SOUTHWEST QUARTER OF SECTION 34, TOWNSHIP 12 SOUTH, RANGE 65 WEST.
28. RESTRICTIONS AS CONTAINED IN DEED RECORDED MARCH 29, 2006 UNDER RECEPTION NO. 206045408 AFFECTS THE ENTIRE PROPERTY.
29. TERMS, CONDITIONS, PROVISIONS, BURDENS AND OBLIGATIONS AS SET FORTH IN LEASE AGREEMENT AS DISCLOSED BY ASSIGNMENT OF LEASE RECORDED MARCH 29, 2006 UNDER RECEPTION NO. 20645405 AFFECTS THE ENTIRE PROPERTY.
30. THE EFFECT OF RESOLUTION NO. 08-476 REGARDING SKETCH PLAN, RECORDED AUGUST 25, 2009, UNDER RECEPTION NO. 209100915 AFFECTS THE ENTIRE PROPERTY.
31. TERMS, CONDITIONS AND PROVISIONS OF RESOLUTION RECORDED NOVEMBER 26, 2014 UNDER RECEPTION NO. 214109190 AFFECTS THE ENTIRE PROPERTY.
32. RESTRICTIVE COVENANTS, WHICH DO NOT CONTAIN A FORFEITURE OR REVERTER CLAUSE, BUT OMITTING ANY COVENANTS OR RESTRICTIONS, IF ANY, BASED UPON RACE, COLOR, RELIGION, SEX, SEXUAL ORIENTATION, FAMILIAL STATUS, MARITAL STATUS, DISABILITY, HANDICAP, NATIONAL ORIGIN, ANCESTRY, OR SOURCE OF INCOME, AS SET FORTH IN APPLICABLE STATE OR FEDERAL LAWS, EXCEPT TO THE EXTENT THAT SAID COVENANT OR RESTRICTION IS PERMITTED BY APPLICABLE LAW, AS CONTAINED IN INSTRUMENT RECORDED JANUARY 10, 2019, UNDER RECEPTION NO. 219003168, FIRST AMENDMENT THERETO RECORDED MAY 23, 2019 UNDER RECEPTION NO. 219055956, AND AS AMENDED BY INSTRUMENT RECORDED FEBRUARY 4, 2021 UNDER RECEPTION NO. 221022771 AFFECTS THE ENTIRE PROPERTY.
NOTE: SUBJECT PROPERTY IS INCLUDED IN THE "EXPANSION PROPERTY" AS SET FORTH IN EXHIBIT B OF SAID INSTRUMENT.
33. RESTRICTIVE COVENANTS, WHICH DO NOT CONTAIN A FORFEITURE OR REVERTER CLAUSE, BUT OMITTING ANY COVENANTS OR RESTRICTIONS, IF ANY, BASED UPON RACE, COLOR, RELIGION, SEX, SEXUAL ORIENTATION, FAMILIAL STATUS, MARITAL STATUS, DISABILITY, HANDICAP, NATIONAL ORIGIN, ANCESTRY, OR SOURCE OF INCOME, AS SET FORTH IN APPLICABLE STATE OR FEDERAL LAWS, EXCEPT TO THE EXTENT THAT SAID COVENANT OR RESTRICTION IS PERMITTED BY APPLICABLE LAW, AS CONTAINED IN INSTRUMENT RECORDED FEBRUARY 14, 2019, UNDER RECEPTION NO. 219016251, AND AS AMENDED BY INSTRUMENT RECORDED FEBRUARY 4, 2021 UNDER RECEPTION NO. 221022771 AFFECTS THE ENTIRE PROPERTY.
NOTE: SUBJECT PROPERTY IS INCLUDED IN THE "EXPANSION PROPERTY" AS SET FORTH IN EXHIBIT B OF SAID INSTRUMENT.
34. TERMS, CONDITIONS, PROVISIONS, BURDENS AND OBLIGATIONS AS SET FORTH IN EASEMENT RECORDED DECEMBER 23, 2020 UNDER RECEPTION NO. 220210781 AFFECTS THE ENTIRE PROPERTY.
35. THE RESERVATION OF ALL WATER AND MINERAL RIGHTS IN FAVOR OF MORLEY-HALL STERLING, LLC A COLORADO LIMITED LIABILITY COMPANY AS RESERVED IN SPECIAL WARRANTY DEED RECORDED DECEMBER 22, 2021 AT RECEPTION NO. 221232399 AFFECTS THE ENTIRE PROPERTY.
36. TERMS, CONDITIONS, PROVISIONS, BURDENS AND OBLIGATIONS AS SET FORTH IN PRIVATE STORM WATER DRAINAGE MAINTENANCE AGREEMENT AND EASEMENT RECORDED AUGUST 02, 2022 UNDER RECEPTION NO. 222103273 AFFECTS THE ENTIRE PROPERTY.
37. TERMS, CONDITIONS, PROVISIONS, BURDENS AND OBLIGATIONS AS SET FORTH IN RESOLUTION FOR FALCON AREA WATER WASTEWATER AUTHORITY RECORDED AUGUST 19, 2022 UNDER RECEPTION NO. 222110514 AND RECORDED AUGUST 18, 2022 UNDER RECEPTION NO. 222109714 AFFECTS THE ENTIRE PROPERTY.
38. TERMS, CONDITIONS, PROVISIONS, BURDENS AND OBLIGATIONS AS SET FORTH IN PRIVATE STORM WATER MAINTENANCE AGREEMENT RECORDED MAY 19, 2023 UNDER RECEPTION NO. 223041858, 223041859 AFFECTS THE ENTIRE PROPERTY.
39. TERMS, CONDITIONS, PROVISIONS, BURDENS AND OBLIGATIONS AS SET FORTH IN RESOLUTION NO.24-89 RECORDED FEBRUARY 22, 2024 UNDER RECEPTION NO. 224012436, 224012437 AFFECTS THE ENTIRE PROPERTY.
40. TERMS, CONDITIONS, PROVISIONS, BURDENS AND OBLIGATIONS AS SET FORTH IN RESOLUTION FOR STERLING RANCH RECORDED MARCH 19, 2024 UNDER RECEPTION NO. 22419932, 22419933, 22419934, AND 22419935 AFFECTS THE ENTIRE PROPERTY.

SUMMARY TABLE:

Table with columns: LOTS, SQUARE FEET, PERCENTAGE, OWNER, MAINTENANCE. Rows include Tract A, Tracts B and E, Tracts C, D, F, G, H, Tracts I, Lots (160 Total), R.O.W., and Total.

LOT AND DENSITY DATA:

GROSS ACREAGE: 47.17 ACRES (2,054,633 SF)
TOTAL NUMBER OF LOTS IN SUBDIVISION: 160
GROSS DENSITY: 3.4 LOTS PER ACRE
NET DENSITY: 5.8 LOTS PER ACRE

ACCEPTANCE CERTIFICATE FOR TRACTS

THE DEDICATION OF TRACTS A, B, C, D, E, F, G, AND H WITH USE STATED IN THE TRACT TABLE, ARE HEREBY ACCEPTED FOR OWNERSHIP AND MAINTENANCE BY THE STERLING RANCH METROPOLITAN DISTRICT NO. 1.

BY:
AS:

OF STERLING RANCH METROPOLITAN DISTRICT NO. 1.

STATE OF COLORADO
)ss
COUNTY OF EL PASO)

ACKNOWLEDGED BEFORE ME THIS ___ DAY OF ____, 20__ A.D. BY ____, AS ___ OF STERLING RANCH METROPOLITAN DISTRICT NO. 1.

WITNESS MY HAND AND OFFICIAL SEAL.

MY COMMISSION EXPIRES: ___ NOTARY PUBLIC

COUNTY APPROVAL CERTIFICATE:

THIS PLAT FOR STERLING RANCH EAST FILING NO. 5 WAS APPROVED FOR FILING BY THE EXECUTIVE DIRECTOR OF THE EL PASO COUNTY PLANNING AND COMMUNITY DEVELOPMENT DEPARTMENT ON THIS ___ DAY OF ____, 20__ SUBJECT TO ANY NOTES SPECIFIED HEREON AND ANY CONDITIONS INCLUDED IN THE RECORD OF ADMINISTRATIVE DETERMINATION. THE DEDICATIONS OF LAND TO THE PUBLIC (STREETS AND EASEMENTS) ARE ACCEPTED, BUT PUBLIC IMPROVEMENTS THEREON WILL NOT BECOME MAINTENANCE RESPONSIBILITY OF EL PASO COUNTY UNTIL PRELIMINARY ACCEPTANCE OF THE PUBLIC IMPROVEMENTS IN ACCORDANCE WITH THE REQUIREMENTS OF THE LAND DEVELOPMENT CODE AND ENGINEERING CRITERIA MANUAL AND THE SUBDIVISION IMPROVEMENTS AGREEMENT.

EXECUTIVE DIRECTOR OF PLANNING AND COMMUNITY DEVELOPMENT DEPARTMENT DATE

SURVEYOR'S STATEMENT:

I, ROBERT L. MEADOWS JR., A DULY LICENSED PROFESSIONAL LAND SURVEYOR IN THE STATE OF COLORADO, DO HEREBY CERTIFY THIS PLAT TRULY AND CORRECTLY REPRESENTS THE RESULTS OF A SURVEY MADE ON DATE OF SURVEY, BY ME OR UNDER MY DIRECT SUPERVISION AND THAT ALL MONUMENTS EXIST AS SHOWN HEREON; THAT MATHEMATICAL CLOSURE ERRORS ARE LESS THAN 1:10,000; AND THAT SAID PLAT HAS BEEN PREPARED IN FULL COMPLIANCE WITH ALL APPLICABLE LAWS OF THE STATE OF COLORADO DEALING WITH MONUMENTS, SUBDIVISION, OR SURVEYING OF LAND AND ALL APPLICABLE PROVISION OF THE EL PASO COUNTY LAND DEVELOPMENT CODED.

I ATTEST THE ABOVE ON THIS ___ DAY OF ____, 20__.

PRELIMINARY
THIS DOCUMENT HAS NOT BEEN PLAT CHECKED

ROBERT L. MEADOWS JR., PROFESSIONAL LAND SURVEYOR DATE
COLORADO P.L.S. NO. 34977 FOR AND ON BEHALF OF CLASSIC CONSULTING, ENGINEERS AND SURVEYORS, LLC.

CLERK AND RECORDER:

STATE OF COLORADO
)ss
COUNTY OF EL PASO)

I HEREBY CERTIFY THAT THIS INSTRUMENT WAS FILED FOR RECORD IN MY OFFICE AT O'CLOCK __.M. THIS ___ DAY OF ____, 20__ A.D., AND IS DULY RECORDED AT RECEPTION NO. ___ OF THE RECORDS OF EL PASO COUNTY, COLORADO.

STEVE SCHLEIKER, RECORDER

BY: DEPUTY

SHEET 1 OF 5
JUNE 1, 2024
JOB NO. 1183.25
STERLING RANCH EAST FILING NO. 5

FEES:
DRAINAGE:
BRIDGE FEES:
URBAN PARK:
REGIONAL PARK:
SCHOOL FEE:





County SF2430 619 N. Cascade Avenue, Suite 200 Colorado Springs, Colorado 80903 (719)785-0790

CITY FILE NO.


STERLING RANCH EAST FILING NO. 5

A PORTION OF THE SOUTHEAST QUARTER OF SECTION 33 AND THE SOUTHWEST QUARTER OF SECTION 34, TOWNSHIP 12 SOUTH, RANGE 65 WEST OF THE SIXTH PRINCIPAL MERIDIAN, EL PASO COUNTY, COLORADO

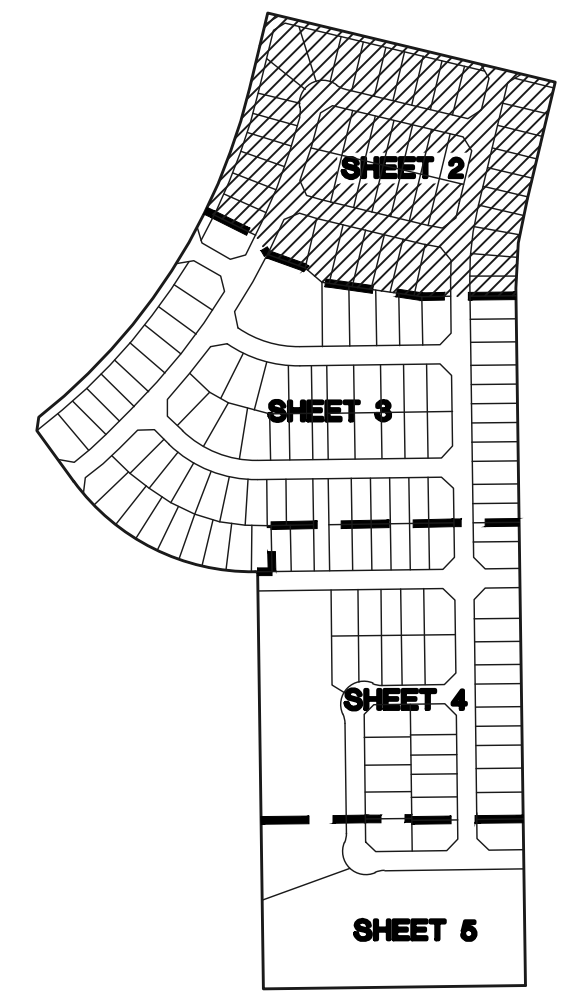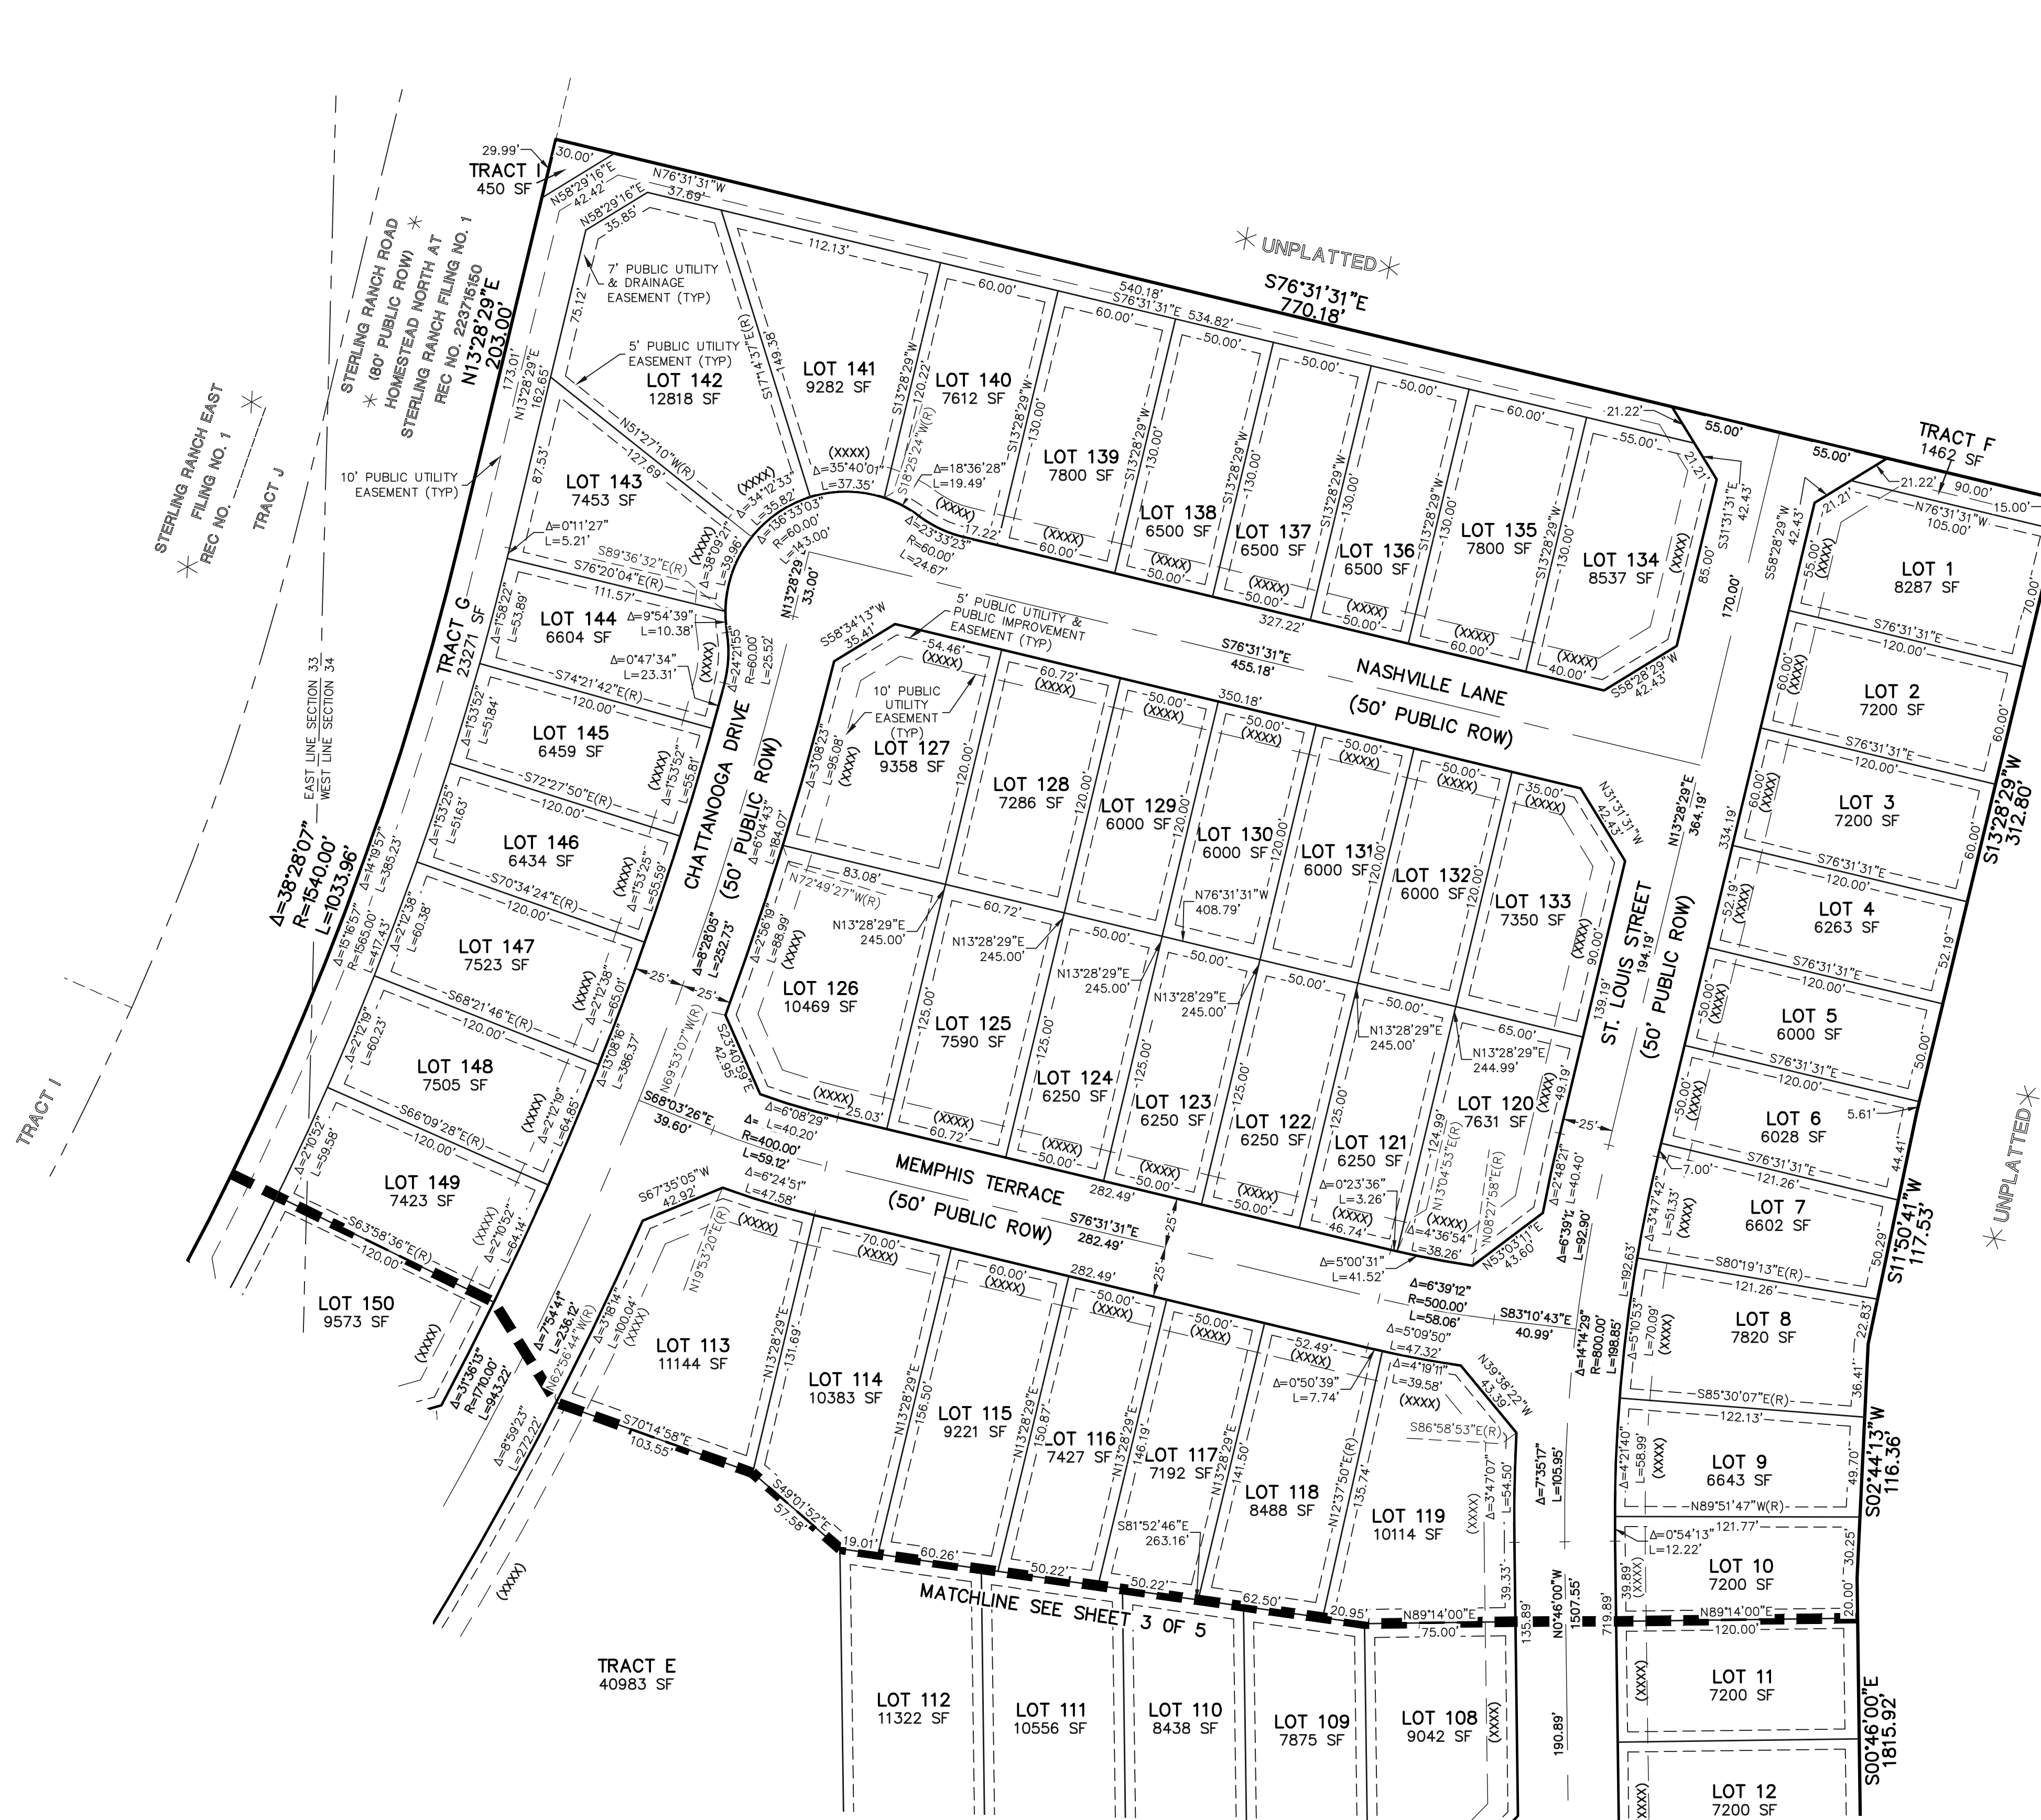

KEY MAP
N.T.S.

- LEGEND
- (R) RADIAL BEARING
 - SF SQUARE FEET
 - (XXXX) ADDRESS
 - ✱ NOT PART OF THIS SUBDIVISION

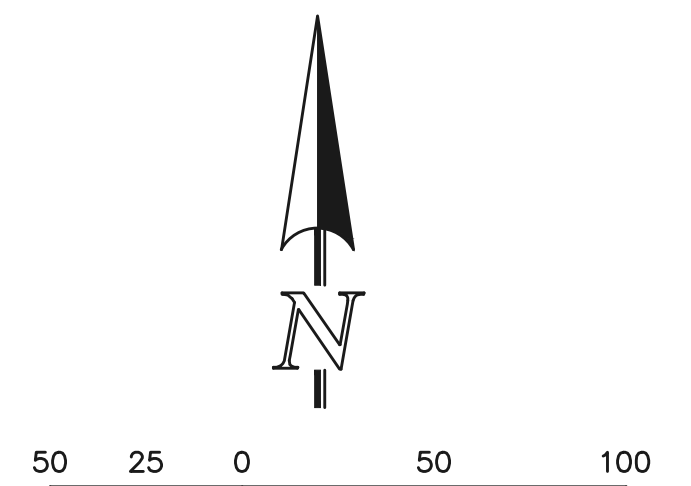

SCALE: 1" = 50'
U.S. SURVEY FOOT

PRELIMINARY
THIS DOCUMENT HAS NOT BEEN
PLAT CHECKED

SHEET 2 OF 5
JUNE 1, 2024
JOB NO. 1183.25
STERLING RANCH
EAST FILING NO. 5





619 N. Cascade Avenue, Suite 200
Colorado Springs, Colorado 80903
(719)785-0790

CITY FILE NO. _____

STERLING RANCH EAST FILING NO. 5

A PORTION OF THE SOUTHEAST QUARTER OF SECTION 33 AND THE SOUTHWEST QUARTER OF SECTION 34, TOWNSHIP 12 SOUTH, RANGE 65 WEST OF THE SIXTH PRINCIPAL MERIDIAN, EL PASO COUNTY, COLORADO

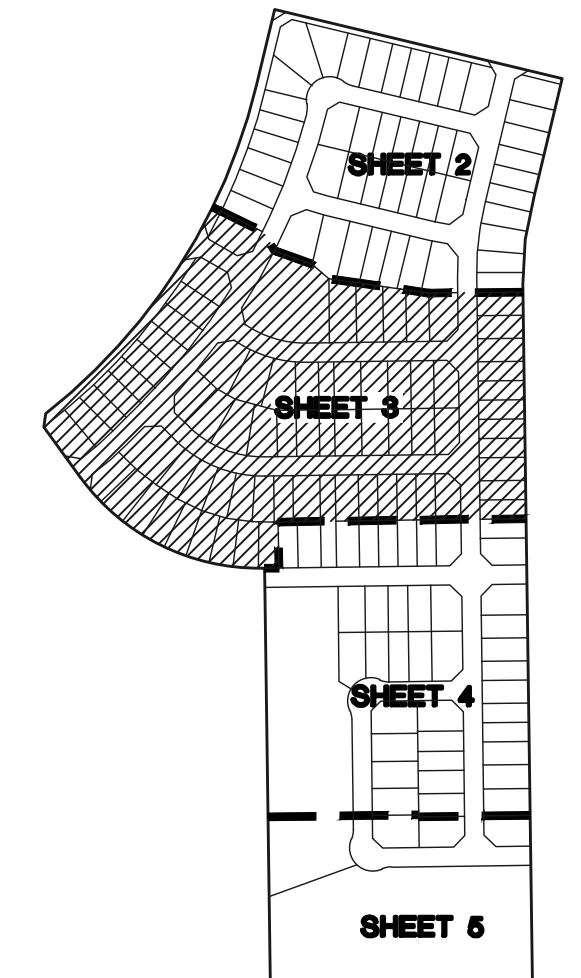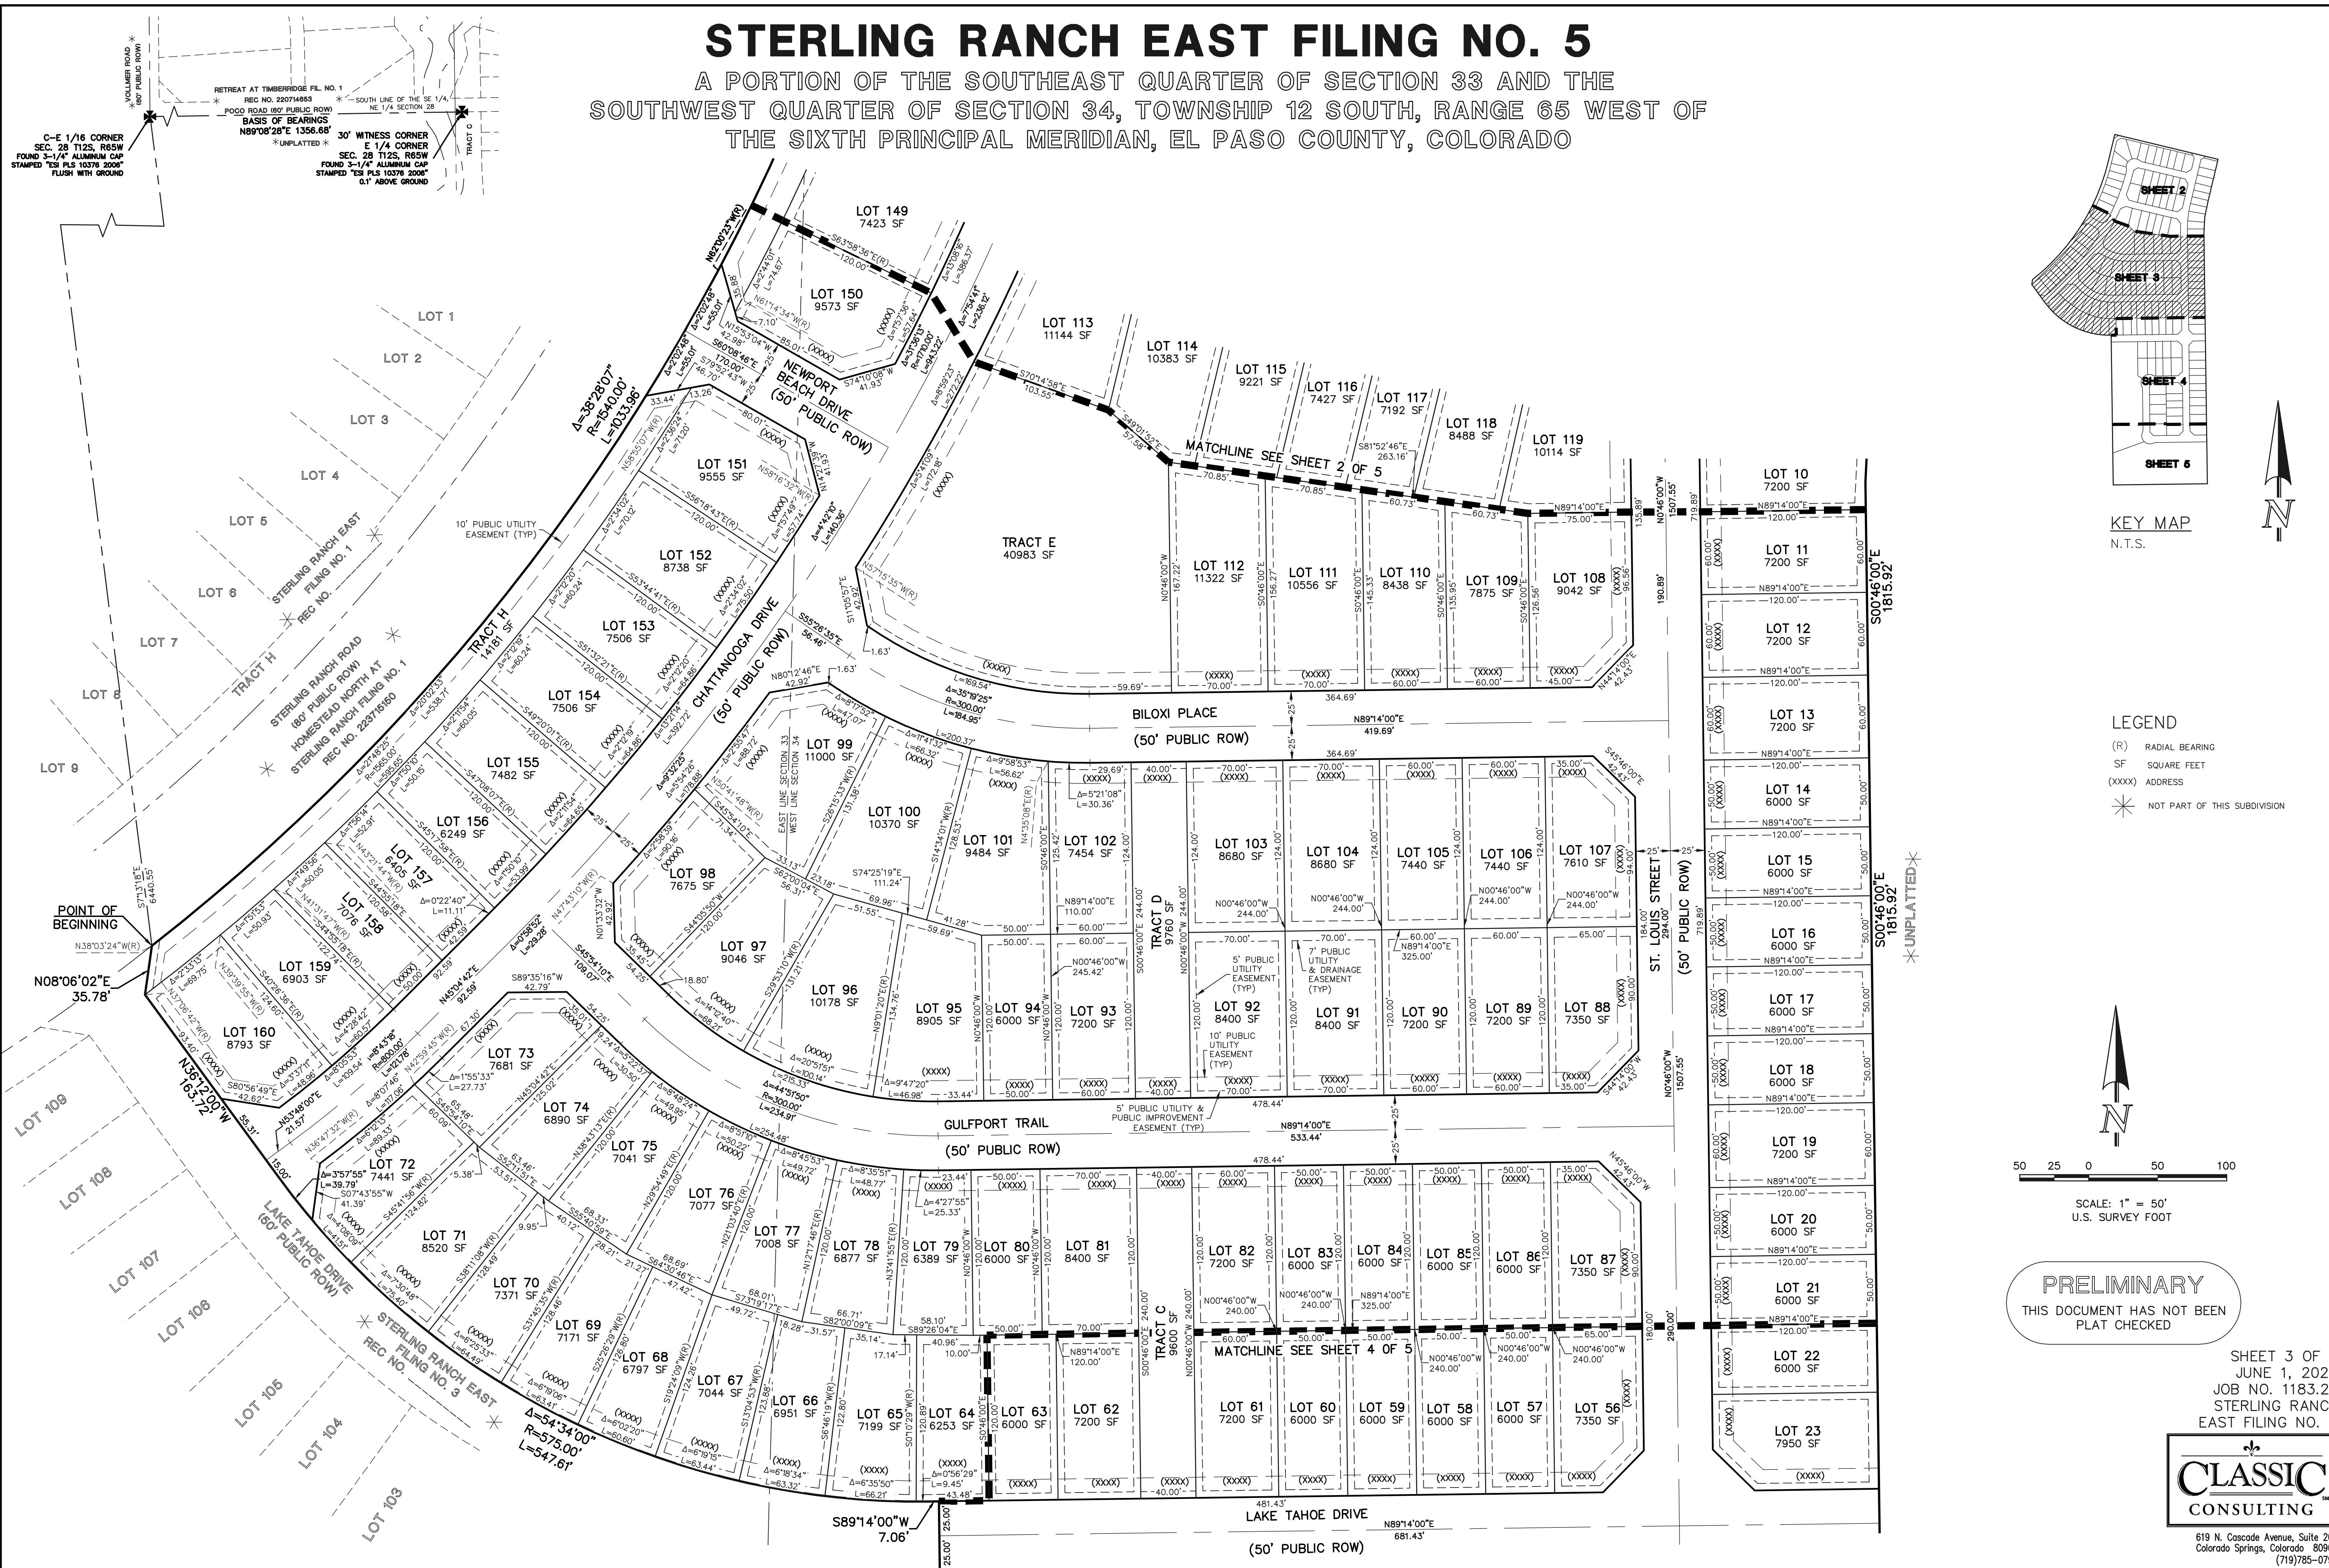

KEY MAP
N.T.S.

LEGEND

- (R) RADIAL BEARING
- SF SQUARE FEET
- (XXXX) ADDRESS
- * NOT PART OF THIS SUBDIVISION



SCALE: 1" = 50'
U.S. SURVEY FOOT

PRELIMINARY
THIS DOCUMENT HAS NOT BEEN
PLAT CHECKED

SHEET 3 OF 5
JUNE 1, 2024
JOB NO. 1183.25
STERLING RANCH
EAST FILING NO. 5




619 N. Cascade Avenue, Suite 200
Colorado Springs, Colorado 80903
(719)785-0790


CITY FILE NO. _____

STERLING RANCH EAST FILING NO. 5


A PORTION OF THE SOUTHEAST QUARTER OF SECTION 33 AND THE SOUTHWEST QUARTER OF SECTION 34, TOWNSHIP 12 SOUTH, RANGE 65 WEST OF THE SIXTH PRINCIPAL MERIDIAN, EL PASO COUNTY, COLORADO

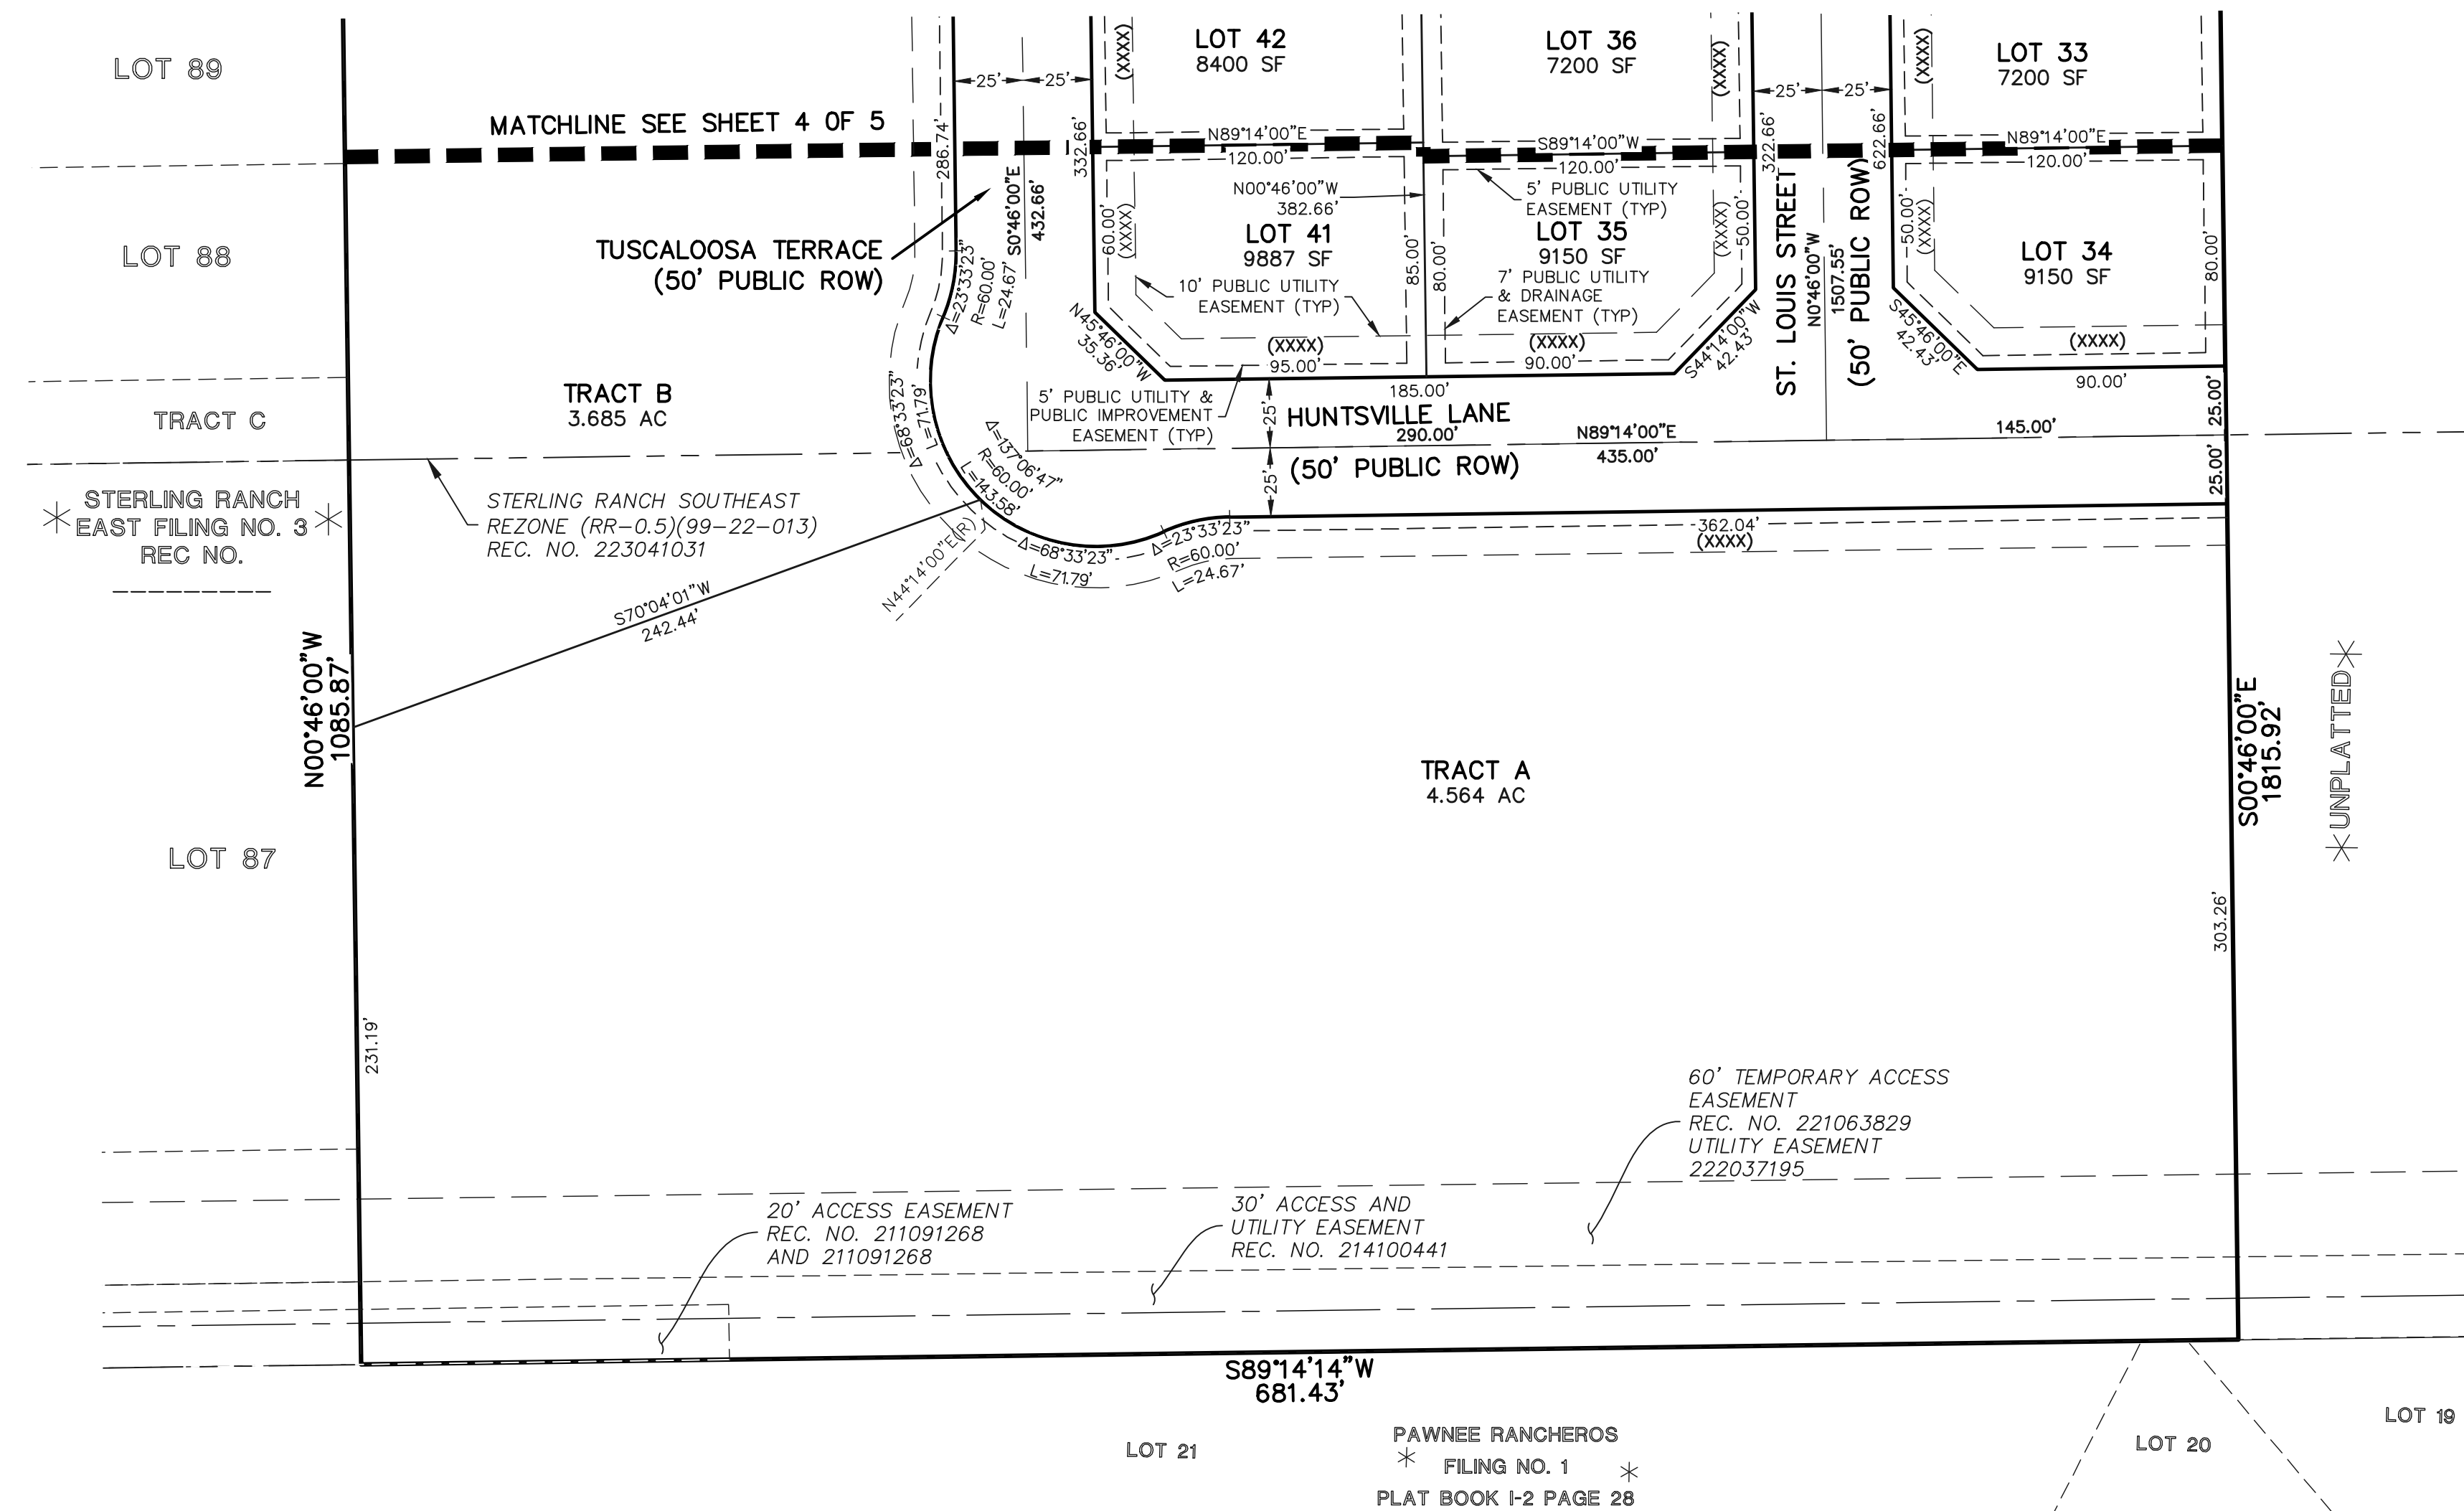

Per my comments in the FDR:
SPAs need to be in no-build drainage easements or tracts.
All of Basin Y1 is not within Tract A, some is within Lots 86 and 87 west of Tract A. So that area of those two lots will need to be shown as no-build easements on the Final Plat of that Filing (SR East F3).
Similar comment for the portion of Basin Y2 that is east of Tract A in the future SR filing.

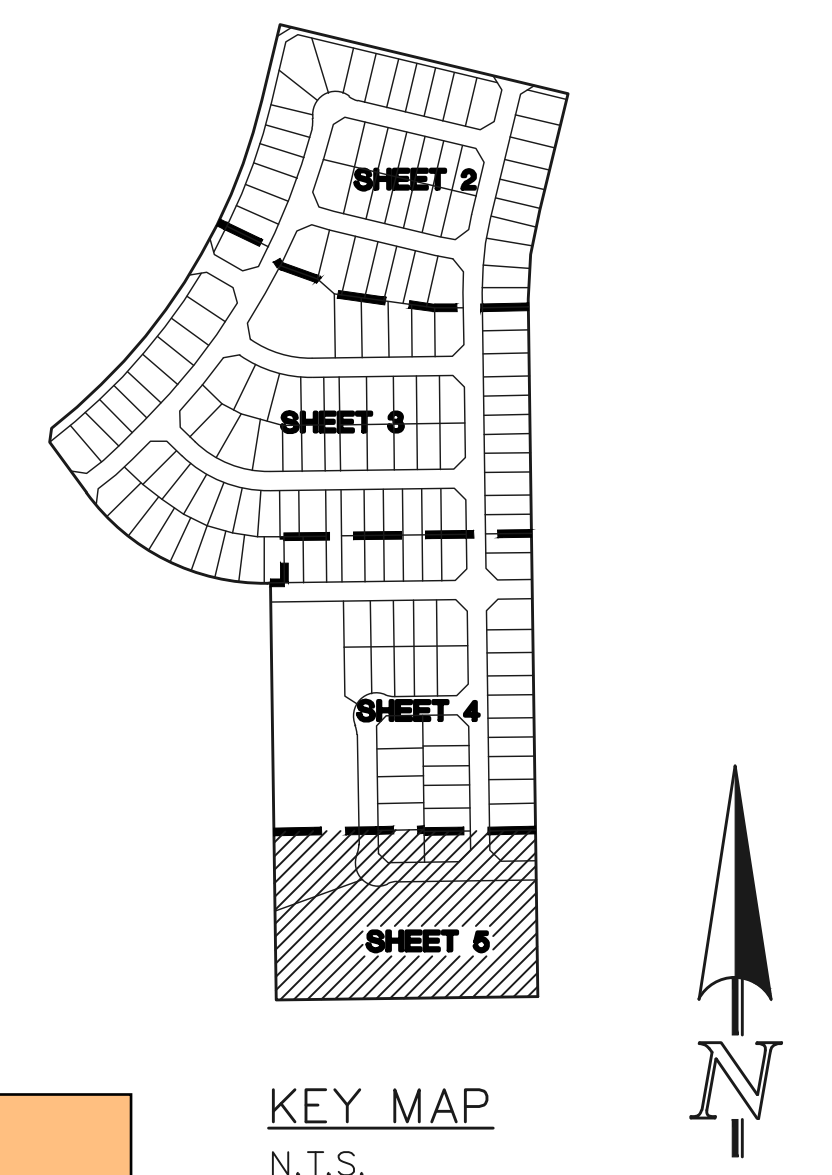

LEGEND
(R) RADIAL BEARING
SF SQUARE FEET
(XXXX) ADDRESS
* NOT PART OF THIS SUBDIVISION

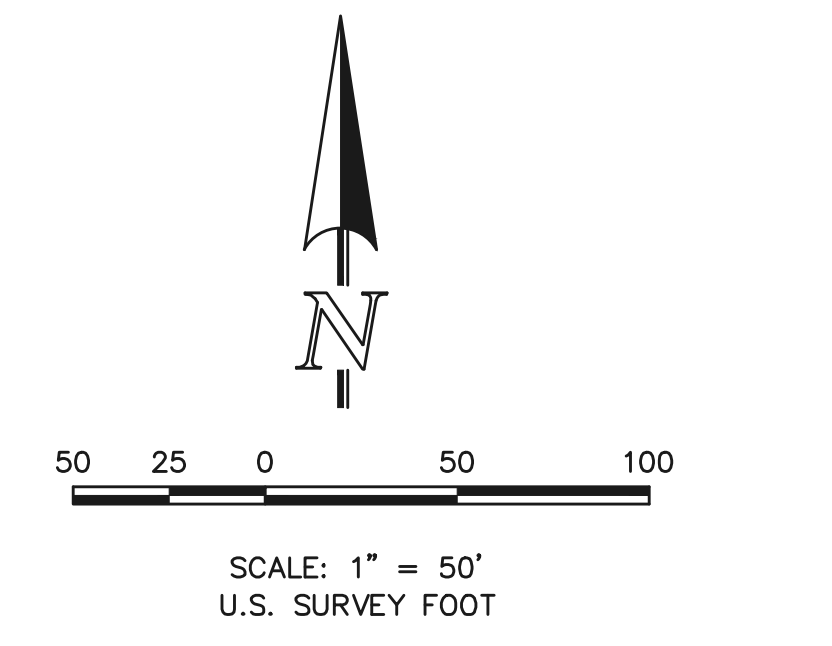

PRELIMINARY
THIS DOCUMENT HAS NOT BEEN
PLAT CHECKED

SHEET 5 OF 5
JUNE 1, 2024
JOB NO. 1183.25
STERLING RANCH
EAST FILING NO. 5



619 N. Cascade Avenue, Suite 200
Colorado Springs, Colorado 80903
(719)785-0790

V1_Final Plat Drawings.pdf Markup Summary

Bret (1)

NOTIFIED WATER LEVEL RECORDS. THEREFORE, THE
RELY UPON NON-RENEWABLE/ALTERERS. ALTERNATIVE RE
BE ACCURATE AND INCORPORATED IN A PERMANENT WA
NERATIONS WITH A WATER SUPPLY.
YOUR SERVICE FOR THE SUBMITTER IS PROVIDED BY T
BY SUBJECT TO THE PROVIDER'S RULES, REGULATIONS
OR IS RESPONSIBLE FOR EXISTING UTILITIES TO EACH
N/A. [Please refer to the following document for more information.](#)
RANCH EAST FILING NO. 5, IS PARTIALLY LOCATED WITH
AS DETERMINED BY THE 2000 INSURANCE RATE MAP,
G. DATED DECEMBER 7, 2018. (ZONE 1 AND 4)
CONSTITUTE A TITLE SEARCH TO DETERMINE OWNERSHIP
FORMATION REGARDING EASEMENTS, RIGHT-OF-WAY AND
ENGINEERS AND SURVEYORS, AND THE SURVEYOR OF S

Subject: Engineer
Page Label: [1] 118325 P1-P1
Author: Bret
Date: 11/22/2024 11:59:15 AM
Status:
Color: ■
Layer:
Space:

Please revise statement, drainage report states there is no FEMA floodplain

dspdparsons (6)

UNLAWFUL PUBL
N.T.S.
Add clarifying notes
addressing
landscape: wo will
install and own along
certain roads
1, 2024.
ES, ALTERS OR DEFACES ANY PUBL
ACCESSORY COMMITS A CLASS TWO

Subject: Callout
Page Label: [1] 118325 P1-P1
Author: dspdparsons
Date: 11/21/2024 8:13:39 AM
Status:
Color: ■
Layer:
Space:

Add clarifying notes addressing landscape: wo will install and own along certain roads

BE IMPACTED BY GEOLOGIC
AREA CAN BE FOUND IN T
3 NO. 5, EL PASO COUNTY,
5 IN FILE SP-23-235 A) ALL
T DEPARTMENT.
WATER FOUND ON THE FOLI

Subject: Cloud
Page Label: [1] 118325 P1-P1
Author: dspdparsons
Date: 11/21/2024 8:22:05 AM
Status:
Color: ■
Layer:
Space:

THE CITY OF EL PASO COUNTY, COLORADO" BY E
\$5 AVAILABLE AT THE EL
File number error
SP235
THE FOLLOWING LOTS: 13C
D INCORPORATION OF UND
NECTION TO UNDERDRAIN

Subject: Text Box
Page Label: [1] 118325 P1-P1
Author: dspdparsons
Date: 11/21/2024 8:23:05 AM
Status:
Color: ■
Layer:
Space:

File number error SP235

FEES:
DRAINAGE:
BRIDGE FEES:
URBAN FARR:
REGIONAL FARR:
SCHOOL FEES:

Subject: Cloud
Page Label: [1] 118325 P1-P1
Author: dspdparsons
Date: 11/21/2024 8:24:59 AM
Status:
Color: ■
Layer:
Space:

Complete

Subject: Callout
Page Label: [1] 118325 P1-P1
Author: dspdparsons
Date: 11/21/2024 8:25:08 AM
Status:
Color: ■
Layer:
Space:

Complete

County
SF2430

Subject: Text Box
Page Label: [1] 118325 P1-P1
Author: dsdparsons
Date: 11/21/2024 8:25:23 AM
Status:
Color: ■
Layer:
Space:

County SF2430

Glenn Reese - EPC Stormwater (1)

Per my comments in the FDR:
SPAs need to be in no-build drainage easements or tracts.
All of Basin Y1 is not within Tract A, some is within Lots 86
and 87 west of Tract A. So that area of those lots may need
to be shown as no-build easements on the Final Plat
of that Filing (SR East F3).
Similar comment for the portion of Basin Y2 that is east of
Tract A in the future SR filing.

Subject: SW - Textbox
Page Label: [5] 118325FIL5 P2-P5-SHEET5
Author: Glenn Reese - EPC Stormwater
Date: 11/26/2024 3:34:20 PM
Status:
Color: ■
Layer:
Space:

Per my comments in the FDR:

SPAs need to be in no-build drainage easements
or tracts.

All of Basin Y1 is not within Tract A, some is within
Lots 86 and 87 west of Tract A. So that area of
those two lots will need to be shown as no-build
easements on the Final Plat of that Filing (SR East
F3).

Similar comment for the portion of Basin Y2 that is
east of Tract A in the future SR filing.