

FS SCHWAB TIRE CENTER 7105 N. MERIDIAN ROAD FALCON, COLORADO 80831

GRADING AND EROSION CONTROL PLAN

PROPERTY OWNER

PARK PLACE ENTERPRISES LLO 15 MIRANDA ROAD COLORADO SPRINGS, CO 80906

ENTITLEMENT CONSULTANT ARCHITECT

LANDSCAPE ARCHITECT CIVIL ENGINEER / SURVEYOR GEOTECHNICAL ENGINEER

GALLOWAY & COMPANY 6162 S. WILLOW DRIVE, SUITE 320 GREENWOOD VILLAGE, CO 80111 TEL: (303) 770-8884 FAX: (303) 770-3636

ATTN: AARON MCLEAN (ENTITLEMENTS) ATTN: KYLE J. MATTHEWS (ARCHITECT) ATTN: KERRI LILJEGREN, RLA (LANDSCAPE ARCHITECT) ATTN: JOE PARK, P.E. (CIVIL ENGINEERING)

ATTN: LYLE BISSEGGER, P.L.S. (SURVEY)

DEVELOPER/APPLICANT

SFP-E P.O. BOX 5350 BEND, OR 97708 (541) 416-5238 ATTN: GEORGE BUNTING

PICKERING, COLE & HIVNER WESTMINSTER, CO 80234 TEL: (303) 996-2999 ATTN: GLENN D. OHLSEN, P.E.

PLANNING DEPARTMENT

EL PASO COUNTY-PLANNING 2880 INTERNATIONAL CIRCLE #110 COLORADO SPRINGS, CO 80910 TEL: (719) 520-6313 ATTN: NINA RUIZ

ENGINEERING DEPARTMENT

EL PASO COUNTY-ENGINEERING 2880 INTERNATIONAL CIRCLE COLORADO SPRINGS, CO 80910 TEL: (719) 520-6813 ATTN: ELIZABETH NIJKAMP

TEL: (719) 327-2880

FALCON FIRE DISTRICT

UTILITY CONTACTS

POWER

MOUNTAIN VIEW ELECTRIC ASSOCIATION 11140 E WOODMEN ROAD FALCON, CO 80831 TEL: (800) 388-9881

WATER

FALCON HIGHLANDS METROPOLITAN DISTRICT 111 SOUTH TEJON STREET #705 COLORADO SPRINGS, CO 80903 TEL: (719) 635-0330 ATTN: CYNTHIA BEYER

SANITARY SEWER

WOODMAN HILLS METRO DISTRICT 8046 EASTON ROAD FALCON, CO 80831 TEL: (719) 495-2500 x111 ATTN: DANNY EVERETT

1070 W. 124TH AVENUE, SUITE 300

JURISDICTIONAL CONTACTS

BUILDING DEPARTMENT PIKES PEAK REGIONAL BUILDING DEPARTMENT

2880 INTERNATIONAL CIRCLE COLORADO SPRINGS, CO 80910

FIRE DEPARTMENT

7030 OLD MERIDIAN ROAD FALCON, CO 80831 TEL: (719) 495-4050 ATTN: CHIEF TRENT HARWIG

ATTN: JIM CONNELLY

GAS

COLORADO SPRINGS UTILITIES (719) 668-4462


TELEPHONE

CENTURYLINK TEL: (719) 633-2998

ATTN: BEN SCHMITT

EAST WOODMEN ROAD VICINITY MAP

NOT TO SCALE

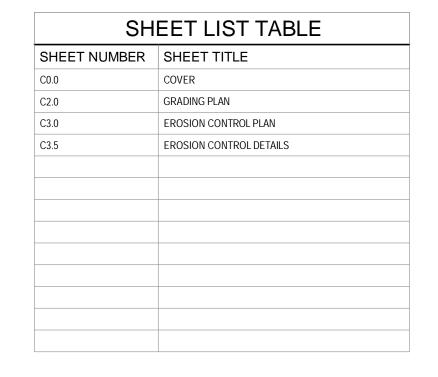

STANDARD NOTES FOR EL PASO COUNTY GRADING AND EROSION CONTROL PLANS

- 1. CONSTRUCTION MAY NOT COMMENCE UNTIL A CONSTRUCTION PERMIT IS OBTAINED FROM PLANNING AND COMMUNITY DEVELOPMENT AND A PRECONSTRUCTION CONFERENCE IS HELD WITH PLANNING AND COMMUNITY DEVELOPMENT INSPECTIONS.
- STORMWATER DISCHARGES FROM CONSTRUCTION SITES SHALL NOT CAUSE OF THREATEN TO CAUSE POLLUTION, CONTAMINATION, OR DEGRADATION OF STATE 10. ANY EARTH DISTURBANCE SHALL BE CONDUCTED IN SUCH A MANNER SO AS TO WATERS. ALL WORK AND EARTH DISTURBANCE SHALL BE DONE IN A MANNER THAT MINIMIZES POLLUTION OF ANY ON-SITE OR OFF SITE WATERS, INCLUDING WETLANDS.
- NOTWITHSTANDING ANYTHING DEPICTED IN THESE PLANS IN WORDS OR GRAPHIC DRAINAGE AND EROSION CONTROL SHALL CONFORM TO THE STANDARDS AND REQUIREMENTS OF THE MOST RECENT VERSION OF THE RELEVANT ADOPTED EL PASO COUNTY STANDARDS, INCLUDING THE LAND DEVELOPMENT CODE, THE ENGINEERING CRITERIA MANUAL, THE DRAINAGE CRITERIA MANUAL, AND THE DRAINAGE CRITERIA MANUAL VOLUME 2. ANY DEVIATIONS TO REGULATIONS AND 12. CONCRETE WASH WATER SHALL BE CONTAINED AND DISPOSED OF IN STANDARDS MUST BE REQUESTED, AND APPROVED, IN WRITING.
- 4. A SEPARATE STORMWATER MANAGEMENT PLAN (SWMP) FOR THIS PROJECT SHALL BE COMPLETED AND AN EROSION AND STORMWATER QUALITY CONTROL PERMIT (ESQCP) ISSUED PRIOR TO COMMENCING CONSTRUCTION. DURING CONSTRUCTION13. EROSION CONTROL BLANKETING IS TO BE USED ON SLOPES STEEPER THAN 3:1. THE SWMP IS THE RESPONSIBILITY OF THE DESIGNATED STORMWATER MANAGER, WORK PROGRESS AND CHANGES IN THE FIELD.
- 5. ONCE THE ESQCP HAS BEEN ISSUED, THE CONTRACTOR MAY INSTALL THE INITIAL STAGE EROSION AND SEDIMENT CONTROL BMPS AS INDICATED ON THE GEC. A PRECONSTRUCTION MEETING BETWEEN THE CONTRACTOR, ENGINEER, AND EL PASO COUNTY WILL BE HELD PRIOR TO ANY CONSTRUCTION. IT IS THE RESPONSIBILITY OF THE APPLICANT TO COORDINATE THE MEETING TIME AND PLACE WITH COUNTY PCD INSPECTIONS STAFF.
- 6. SOIL EROSION CONTROL MEASURES FOR ALL SLOPES, CHANNELS, DITCHES, OR 16. CONTRACTOR SHALL BE RESPONSIBLE FOR THE REMOVAL OF ALL WASTES FROM 27. AT LEAST TEN DAYS PRIOR TO THE ANTICIPATED START OF CONSTRUCTION, FOR ANY DISTURBED LAND AREA SHALL BE COMPLETED WITHIN 21 CALENDAR DAYS AFTER FINAL GRADING, OR FINAL EARTH DISTURBANCE, HAS BEEN COMPLETED. DISTURBED AREAS AND STOCKPILES WHICH ARE NOT AT FINAL GRADE BUT WILL REMAIN DORMANT FOR LONGER THAN 30 DAYS SHALL ALSO BE MULCHED WITHIN 21 DAYS AFTER INTERIM GRADING. AN AREA THAT IS GOING TO REMAIN IN AN INTERIM STATE FOR MORE THAN 60 DAYS SHALL ALSO BE SEEDED. ALL TEMPORARY SOIL EROSION CONTROL MEASURES AND BMPS SHALL BE MAINTAINED UNTIL PERMANENT SOIL EROSION CONTROL MEASURES ARE IMPLEMENTED AND
- 7. TEMPORARY SOIL EROSION CONTROL FACILITIES SHALL BE REMOVED AND EARTH DISTURBANCE AREAS GRADED AND STABILIZED WITH PERMANENT SOIL EROSION CONTROL MEASURES PURSUANT TO STANDARDS AND SPECIFICATION PRESCRIBED18. THE QUANTITY OF MATERIALS STORED ON THE PROJECT SITE SHALL BE LIMITED, IN THE DCM VOLUME II AND THE ENGINEERING CRITERIA MANUAL (ECM) APPENDIX I.
- 8. ALL PERSONS ENGAGED IN EARTH DISTURBANCE SHALL IMPLEMENT AND MAINTAIN ACCEPTABLE SOIL EROSION AND SEDIMENT CONTROL MEASURES INCLUDING BMPS IN CONFORMANCE WITH THE EROSION CONTROL TECHNICAL STANDARDS OF THE DRAINAGE CRITERIA MANUAL (DCM) VOLUME II AND IN ACCORDANCE WITH THE 19. NO CHEMICALS ARE TO BE USED BY THE CONTRACTOR, WHICH HAVE THE STORMWATER MANAGEMENT PLAN (SWMP).

- 9. ALL TEMPORARY EROSION CONTROL FACILITIES INCLUDING BMPS AND ALL PERMANENT FACILITIES INTENDED TO CONTROL EROSION OF ANY EARTH DISTURBANCE OPERATIONS, SHALL BE INSTALLED AS DEFINED IN THE APPROVED PLANS, THE SWMP AND THE DCM VOLUME II AND MAINTAINED THROUGHOUT THE DURATION OF THE EARTH DISTURBANCE OPERATION.
- EFFECTIVELY REDUCE ACCELERATED SOIL EROSION AND RESULTING SEDIMENTATION. ALL DISTURBANCES SHALL BE DESIGNED, CONSTRUCTED, AND LIMITED TO THE SHORTEST PRACTICAL PERIOD OF TIME.
- THE CONVEYANCE OF STORMWATER AROUND, THROUGH, OR FROM THE EARTH DISTURBANCE AREA SHALL BE DESIGNED TO LIMIT THE DISCHARGE TO A NON-EROSIVE VELOCITY.
- ACCORDANCE WITH THE SWMP. NO WASH WATER SHALL BE DISCHARGED TO OR ALLOWED TO RUNOFF TO STATE WATERS, INCLUDING ANY SURFACE OR SUBSURFACE STORM DRAINAGE SYSTEM OR FACILITIES.
- SHALL BE LOCATED ON SITE AT ALL TIMES AND SHALL BE KEPT UP TO DATE WITH 14. BUILDING, CONSTRUCTION, EXCAVATION, OR OTHER WASTE MATERIALS SHALL NOT24. PRIOR TO ACTUAL CONSTRUCTION THE PERMITEE SHALL VERIFY THE LOCATION OF BE TEMPORARILY PLACED OR STORED IN THE STREET, ALLEY, OR OTHER PUBLIC EXISTING UTILITIES. WAY, UNLESS IN ACCORDANCE WITH AN APPROVED TRAFFIC CONTROL PLAN. BMP'S MAY BE REQUIRED BY EL PASO COUNTY ENGINEERING IF DEEMED NECESSARY, BASED ON SPECIFIC CONDITIONS AND CIRCUMSTANCES.
 - 15. VEHICLE TRACKING OF SOILS AND CONSTRUCTION DEBRIS OFF-SITE SHALL BE MINIMIZED. MATERIALS TRACKED OFFSITE SHALL BE CLEANED UP AND PROPERLY 26. THE SOILS REPORT FOR THIS SITE HAS BEEN PREPARED BY _____ DISPOSED OF IMMEDIATELY.
 - THE CONSTRUCTION SITE FOR DISPOSAL IN ACCORDANCE WITH LOCAL AND STATE REGULATORY REQUIREMENTS. NO CONSTRUCTION DEBRIS, TREE SLASH, BUILDING MATERIAL WASTES OR UNUSED BUILDING MATERIALS SHALL BE BURIED, DUMPED, OR DISCHARGED AT THE SITE.
 - 17. THE OWNER, SITE DEVELOPER, CONTRACTOR, AND/OR THEIR AUTHORIZED AGENTS SHALL BE RESPONSIBLE FOR THE REMOVAL OF ALL CONSTRUCTION DEBRIS, DIRT, TRASH, ROCK, SEDIMENT, AND SAND THAT MAY ACCUMULATE IN THE STORM SEWER OR OTHER DRAINAGE CONVEYANCE SYSTEM AND STORMWATER APPURTENANCES AS A RESULT OF SITE DEVELOPMENT.
 - AS MUCH AS PRACTICAL, TO THAT QUANTITY REQUIRED TO PERFORM THE WORK IN AN ORDERLY SEQUENCE. ALL MATERIALS STORED ON-SITE SHALL BE STORED IN A NEAT, ORDERLY MANNER, IN THEIR ORIGINAL CONTAINERS, WITH ORIGINAL MANUFACTURER'S LABELS.

POTENTIAL TO BE RELEASED IN STORMWATER UNLESS PERMISSION FOR THE USE

OF A SPECIFIC CHEMICAL IS GRANTED IN WRITING BY THE ECM ADMINISTRATOR. IN GRANTING THE USE OF SUCH CHEMICALS, SPECIAL CONDITIONS AND MONITORING MAY BE REQUIRED.

20. BULK STORAGE STRUCTURES FOR PETROLEUM PRODUCTS AND OTHER CHEMICALS SHALL HAVE ADEQUATE PROTECTION SO AS TO CONTAIN ALL SPILLS AND PREVENT ANY SPILLED MATERIAL FROM ENTERING STATE WATERS, INCLUDING ANY SURFACE OR SUBSURFACE STORM DRAINAGE SYSTEM OR FACILITIES.

COMPLETED SO THAT THE EXPOSED AREA OF ANY DISTURBED LAND SHALL BE 21. NO PERSON SHALL CAUSE THE IMPEDIMENT OF STORMWATER FLOW IN THE FLOW LINE OF THE CURB AND GUTTER OR IN THE DITCH-LINE.

- REPRESENTATION, ALL DESIGN AND CONSTRUCTION RELATED TO ROADS, STORM 11. ANY TEMPORARY OR PERMANENT FACILITY DESIGNED AND CONSTRUCTED FOR 22. INDIVIDUALS SHALL COMPLY WITH THE "COLORADO WATER QUALITY CONTROL ACT" (TITLE 25, ARTICLE 8, CRS), AND THE "CLEAN WATER ACT" (33 USC 1344), IN ADDITION TO THE REQUIREMENTS INCLUDED IN THE DCM VOLUME II AND THE ECM APPENDIX I. ALL APPROPRIATE PERMITS MUST BE OBTAINED BY THE CONTRACTOR PRIOR TO CONSTRUCTION (NPDES, FLOODPLAIN, 404, FUGITIVE DUST, ETC.). IN THE EVENT OF CONFLICTS BETWEEN THESE REQUIREMENTS AND LAWS, RULES, OR REGULATIONS OF OTHER FEDERAL, STATE, OR COUNTY AGENCIES, THE MORE RESTRICTIVE LAWS, RULES, OR REGULATIONS SHALL APPLY.
 - 23. ALL CONSTRUCTION TRAFFIC MUST ENTER/EXIT THE SITE AT APPROVED CONSTRUCTION ACCESS POINTS.

25. A WATER SOURCE SHALL BE AVAILABLE ON SITE DURING EARTHWORK OPERATIONS AND UTILIZED AS REQUIRED TO MINIMIZE DUST FROM EARTHWORK EQUIPMENT AND WIND.

BE CONSIDERED A PART OF THESE PLANS.

PROJECTS THAT WILL DISTURB 1 ACRE OR MORE, THE OWNER OR OPERATOR OF CONSTRUCTION ACTIVITY SHALL SUBMIT A PERMIT APPLICATION FOR STORMWATER DISCHARGE TO THE COLORADO DEPARTMENT OF PUBLIC HEALTH AND ENVIRONMENT, WATER QUALITY DIVISION. THE APPLICATION CONTAINS CERTIFICATION OF COMPLETION OF A STORMWATER MANAGEMENT PLAN (SWMP), OF WHICH THIS GRADING AND EROSION CONTROL PLAN MAY BE A PART. FOR INFORMATION OR APPLICATION MATERIALS CONTACT:

> COLORADO DEPARTMENT OF PUBLIC HEALTH AND ENVIRONMENT WATER QUALITY CONTROL DIVISION WQCD - PERMITS 4300 CHERRY CREEK DRIVE SOUTH DENVER, CO 80246-1530 ATTN: PERMITS UNIT

NOTE: CONTRACTOR IS RESPONSIBLE FOR CALCULATING AND VERIFYING ALL QUANTITIES PROVIDED ON PLANS PRIOR TO BIDDING AND CONSTRUCTION.

NOTE: CONTRACTOR RESPONSIBLE FOR AS-BUILT DRAWINGS TESTS, REPORTS AND/OR ANY OTHER CERTIFICATES OR INFORMATION AS REQUIRED FOR ACCEPTANCE OF WORK FROM CITY, UTILITY DISTRICTS OR ANY OTHER GOVERNING

SURVEYOR TO OBTAIN AUTOCAD FILE FROM ENGINEER AND VERIFY ALL HORIZONTAL CONTROL DIMENSIONING PRIOR TO CONSTRUCTION STAKING. SURVEYOR MUST VERIFY ALL BENCHMARK. BASIS OF BEARING AND DATUM INFORMATION TO ENSURE IMPROVEMENTS WILL BE AT THE SAME HORIZONTAL AND VERTICAL LOCATIONS SHOWN ON THE DESIGN CONSTRUCTION DRAWINGS. PRIOR TO CONSTRUCTION STAKING ANY DISCREPANCY MUST BE REPORTED TO OWNER AND ENGINEER PRIOR TO CONTINUATION OF ANY FURTHER STAKING OR CONSTRUCTION WORK.

DESIGN ENGINEER'S STATEMENT:

THIS GRADING AND EROSION CONTROL PLAN WAS PREPARED UNDER MY DIRECTION AND SUPERVISION AND IS CORRECT TO THE BEST OF MY KNOWLEDGE AND BELIEF. SAID PLAN HAS BEEN PREPARED ACCORDING TO THE CRITERIA ESTABLISHED BY THE COUNTY FOR GRADING AND EROSION CONTROL PLANS. I ACCEPT RESPONSIBILITY FOR ANY LIABILITY CAUSED BY ANY NEGLIGENT ACTS, ERRORS OR OMISSIONS ON MY PART IN PREPARING THIS PLAN.

JOSEPH D. PARK, P.E. # 42470

OWNER/DEVELOPER'S STATEMENT

I, THE OWNER/DEVELOPER HAVE READ AND WILL COMPLY WITH THE REQUIREMENTS OF THE GRADING AND EROSION CONTROL PLAN.

GEORGE BUNTING LES SCHWAB TIRE PO BOX 5350 BEND, OR 97708

EL PASO COUNTY:

COUNTY PLAN REVIEW IS PROVIDED ONLY FOR GENERAL CONFORMANCE WITH COUNTY DESIGN CRITERIA. THE COUNTY IS NOT RESPONSIBLE FOR THE ACCURACY AND ADEQUACY OF THE DESIGN, DIMENSIONS, AND/ OR ELEVATIONS WHICH SHALL BE CONFIRMED AT THE JOB SITE. THE COUNTY THROUGH THE APPROVAL OF THIS DOCUMENT ASSUMES NO RESPONSIBILITY FOR COMPLETENESS AND/ OR ACCURACY

FILED IN ACCORDANCE WITH THE REQUIREMENTS OF THE EL PASO COUNTY LAND DEVELOPMENT CODE, DRAINAGE CRITERIA MANUAL, VOLUMES 1 AND 2, AND ENGINEERING CRITERIA MANUAL AS AMENDED.

IN ACCORDANCE WITH ECM SECTION 1.12, THESE CONSTRUCTION DOCUMENTS WILL BE VALID FOR CONSTRUCTION FOR A PERIOD OF 2 YEARS FROM THE DATE SIGNED BY THE EL PASO COUNTY ENGINEER. IF CONSTRUCTION HAS NOT STARTED WITHIN THOSE 2 YEARS, THE PLANS WILL NEED TO BE RESUBMITTED FOR APPROVAL, INCLUDING PAYMENT OF REVIEW FEES AT THE PLANNING AND COMMUNITY DEVELOPMENT DIRECTORS DISCRETION.

JENNIFER IRVINE, P.E. COUNTY ENGINEER / ECM ADMINISTRATOR Colorado Springs, Co 80920 719.900.7220 O www.gallowayUS.com




COPYRIGHT THESE PLANS ARE AN INSTRUMENT OF SERVICE AND ARE THE PROPERTY OF GALLOWAY, AND MAY NOT BE DUPLICATED, DISCLOSED. OR REPRODUCED WITHOUT THE WRITTEN CONSENT OF GALLOWAY COPYRIGHTS AND INFRINGEMENTS WILL BE ENFORCED AND PROSECUTED.

Date Issue / Description **0** 3/27/18 CLIENT SET 4/6/18 SDP SUBMITTAL 6/8/18 2ND SDP SUBMITTAL **3** 8/7/18 BID SET **4** 8/10/18 3RD SDP SUBMITTAL

LST00067 Drawn By: Checked By 4/6/2018

COVER

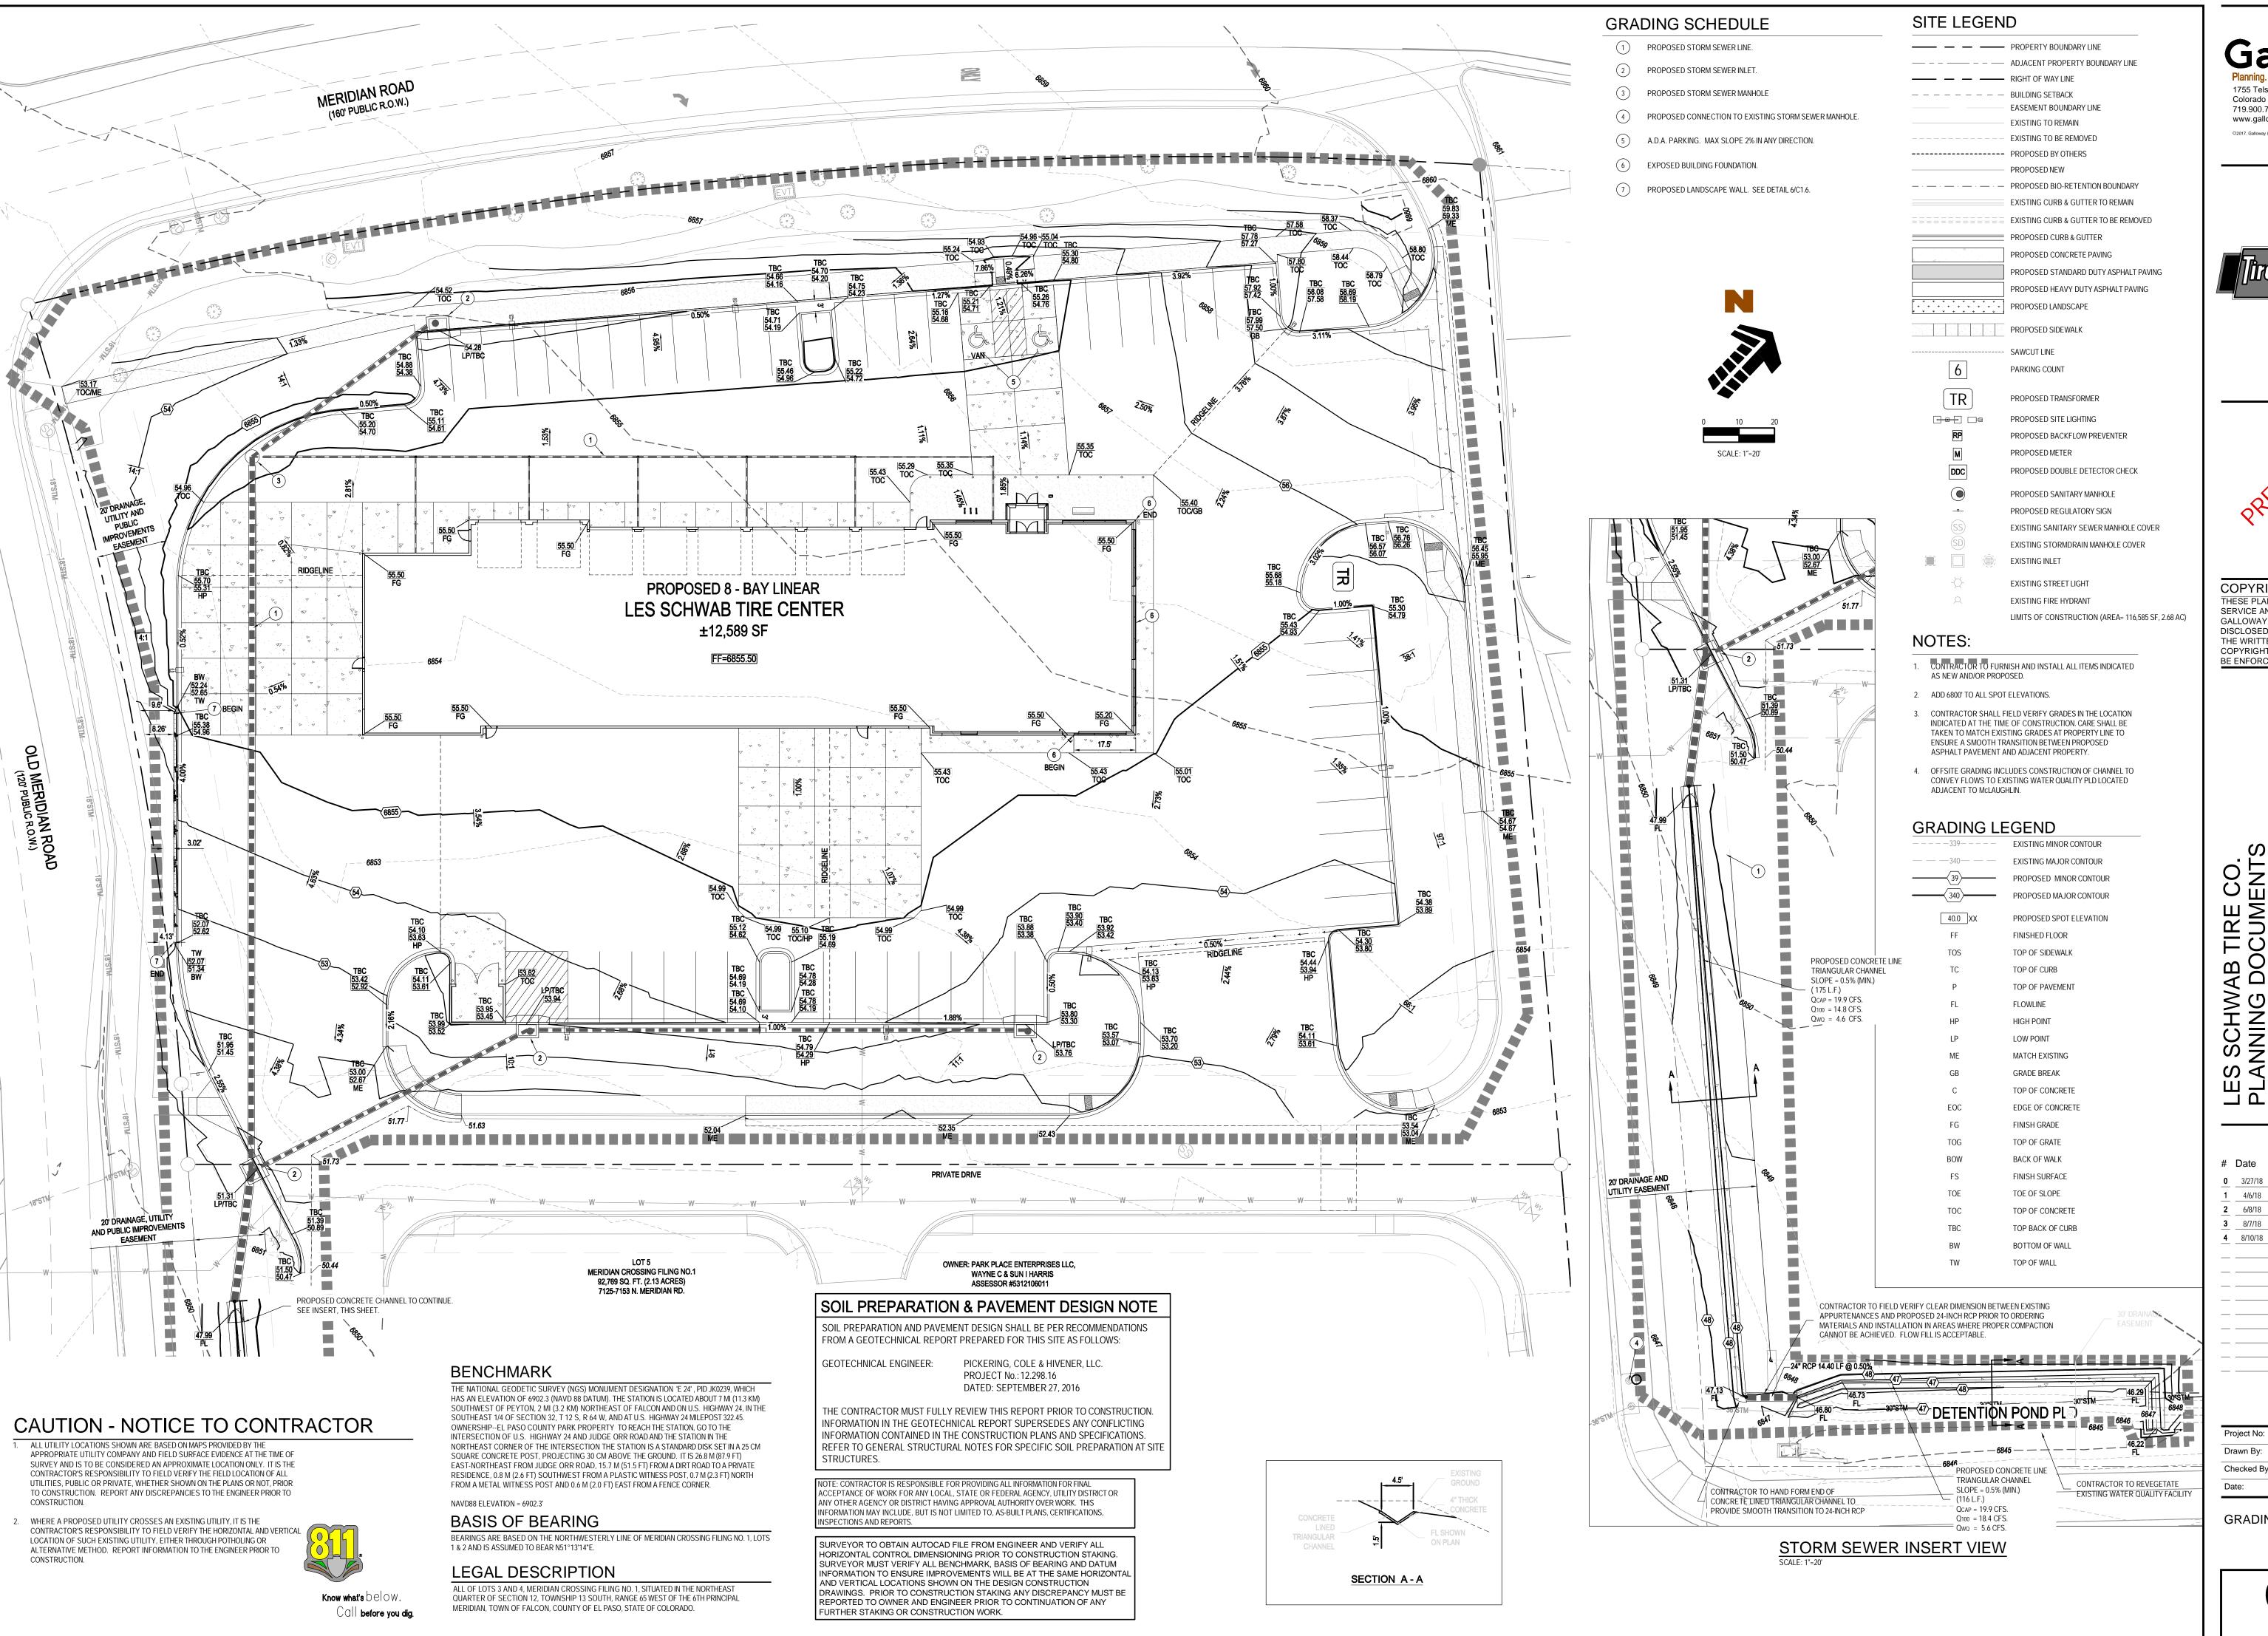

1755 Telstar Drive, Suite 107 Colorado Springs, Co 80920 719.900.7220 O www.gallowayUS.com

O2017. Galloway & Company, Inc. All Rights Reserve




COPYRIGHT THESE PLANS ARE AN INSTRUMENT OF SERVICE AND ARE THE PROPERTY OF GALLOWAY, AND MAY NOT BE DUPLICATED, DISCLOSED, OR REPRODUCED WITHOUT THE WRITTEN CONSENT OF GALLOWAY. COPYRIGHTS AND INFRINGEMENTS WILL BE ENFORCED AND PROSECUTED.

Date Issue / Description 1 4/6/18 SDP SUBMITTAL 6/8/18 2ND SDP SUBMITTAL 8/7/18 BID SET **4** 8/10/18 3RD SDP SUBMITTAL

LST00067 4/6/2018

GRADING PLAN

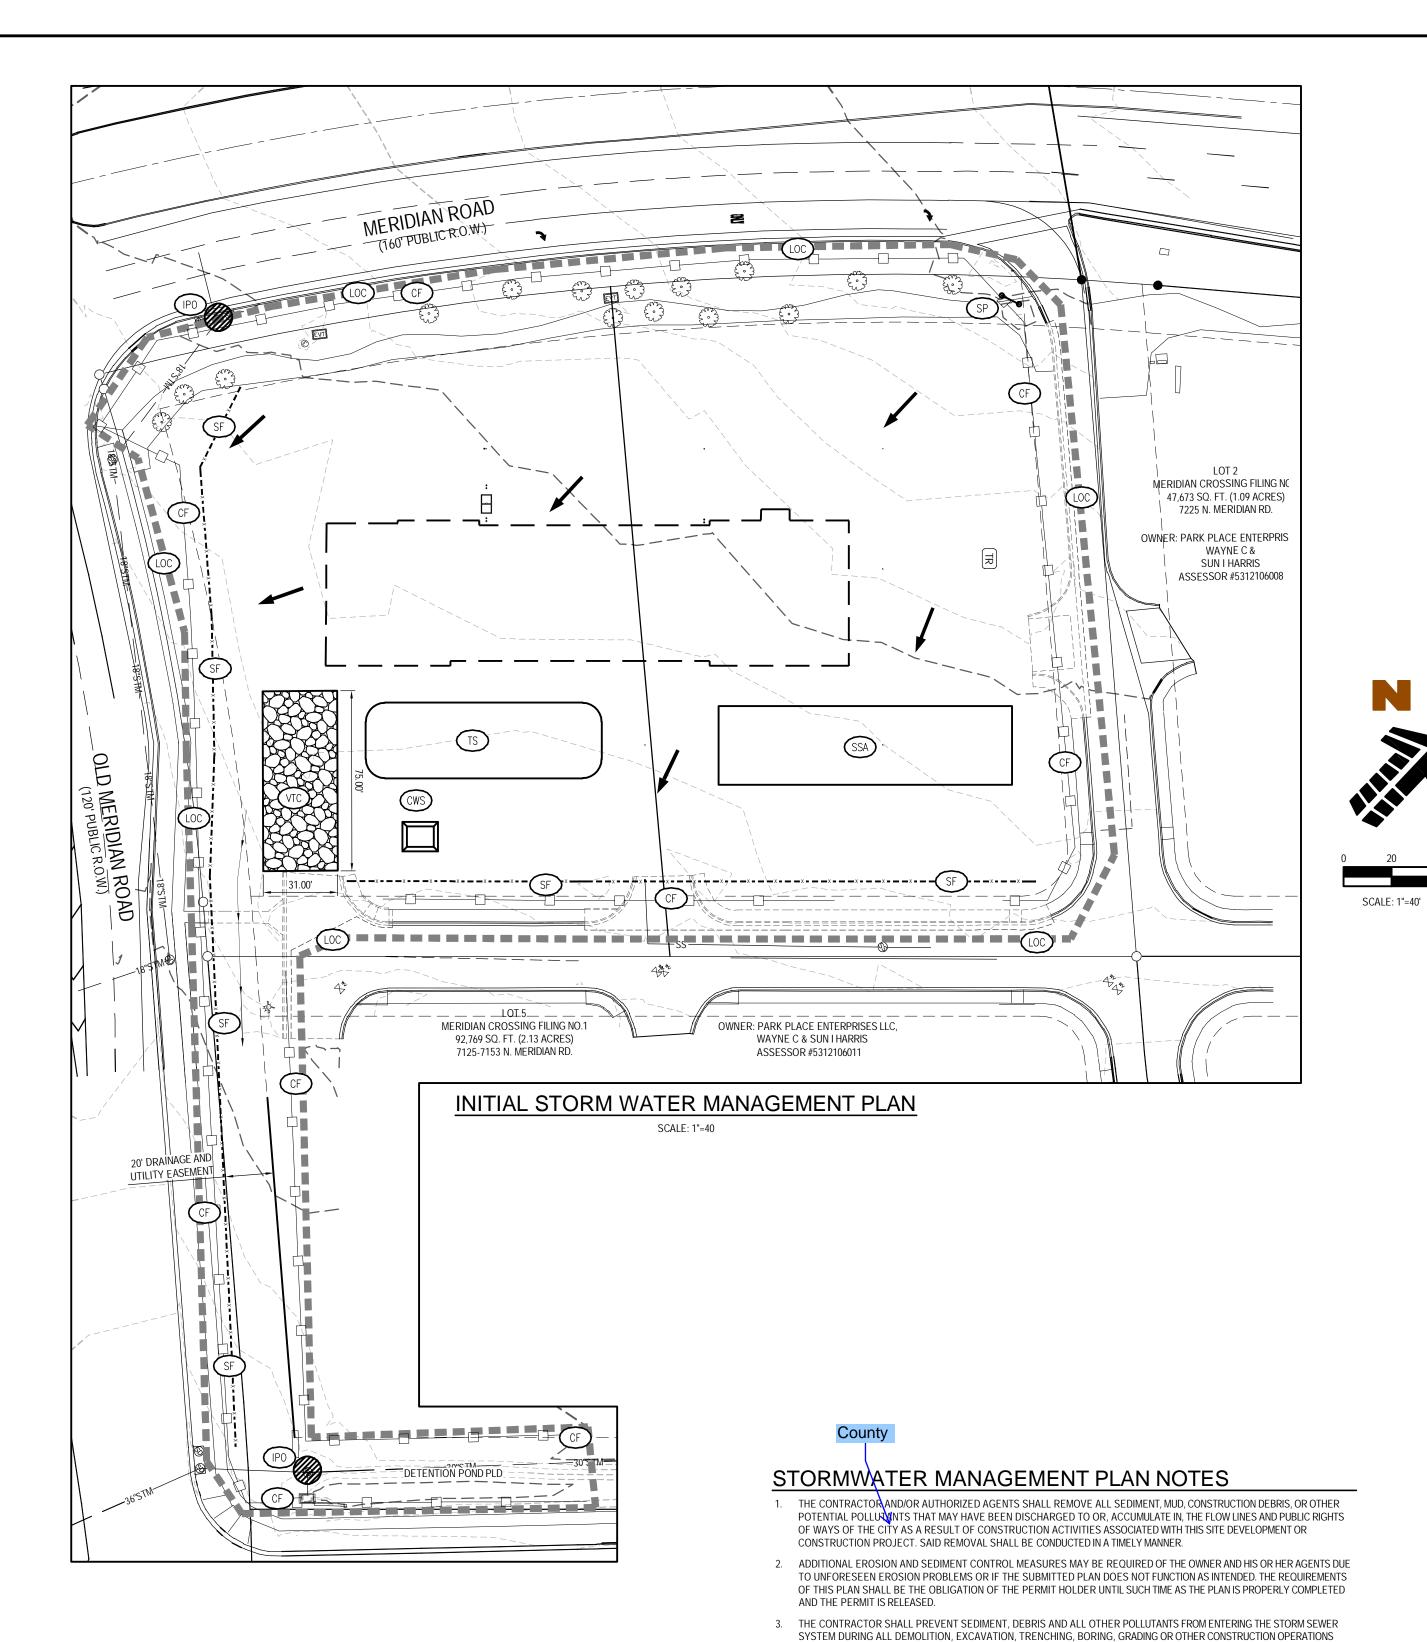

GRADING LEGEND

339	EXISTING MINOR CONTOUR
— — —340— — —	EXISTING MAJOR CONTOUR
39	PROPOSED MINOR CONTOUR
340	PROPOSED MAJOR CONTOUR
40.0 XX	PROPOSED SPOT ELEVATION
FF	FINISHED FLOOR
TOS	TOP OF SIDEWALK
TC	TOP OF CURB
Р	TOP OF PAVEMENT
FL	FLOWLINE
HP	HIGH POINT
LP	LOW POINT
ME	MATCH EXISTING

GRADE BREAK

FINISH GRADE

EOC

TOP OF CONCRETE

EDGE OF CONCRETE

EROSION CONTROL LEGEND

LIMITS OF CONSTRUCTION (AREA= 119,912 SF,
LIMITS OF DISTURBANCE (AREA= 119,912 SF, 2
SILT FENCE
CONSTRUCTION FENCE
SMALL SITE CONCRETE WASHOUT AREA
TEMPORARY STOCKPILE
VEHICLE TRACKING CONTROL/CONSTRUCTION
EROSION CONTROL BLANKET
INLET PROTECTION
SWMP SITE POSTING
STABILIZED STAGING AREA
DIVERSION DITCH/BERM
SILT DIKE ON PAVEMENT
LANDSCAPE AREA

(RES) PORTABLE RESTROOM

_		FLOW APPOW		MANAGEMENT FINACTICES AS INDICATED IN THE ALT NOVED STORMWATER MANAGEMENT LAN.
-	_	FLOW ARROW	5.	THE DEVELOPER, GENERAL CONTRACTOR, GRADING CONTRACTOR AND/OR THEIR AUTHORIZED AGENTS SHALL INSURE THAT
	LOC	LIMITS OF CONSTRUCTION (AREA= 119,912 SF, 2.75 AC)		ALL LOADS OF CUT AND FILL MATERIAL IMPORTED TO OR EXPORTED FROM THIS SITE SHALL BE PROPERLY COVERED TO PREVENT LOSS OF THE MATERIAL DURING TRANSPORT ON PUBLIC RIGHTS OF WAY.
	LOD	LIMITS OF DISTURBANCE (AREA= 119,912 SF, 2.75 AC)	6.	SOILS THAT WILL BE STOCKPILED FOR MORE THAN 30 DAYS SHALL BE PROTECTED FROM WIND AND WATER EROSION WITHIN 14 DAYS OF STOCKPILE CONSTRUCTION. IF STOCKPILES ARE LOCATED WITHIN 100 FEET OF A DRAINAGEWAY, ADDITIONAL
_x x -	SF	SILT FENCE		SEDIMENT CONTROLS SUCH AS TEMPORARY DIKES OR SILT FENCE SHALL BE REQUIRED.
	CF	CONSTRUCTION FENCE	7.	APPROVED EROSION AND SEDIMENT CONTROL BEST MANAGEMENT PRACTICES SHALL BE MAINTAINED AND KEPT IN GOOD REPAIR OF THE DURATION OF THIS PROJECT. ACCUMULATED SEDIMENT AND DEBRIS SHALL BE REMOVED FROM A BMP WHEN THE SEDIMENT OR DEBRIS ADVERSELY IMPACTS THE FUNCTIONING OF THE BMP.
	CWS	SMALL SITE CONCRETE WASHOUT AREA	8.	THE CONTRACTOR SHALL PROTECT STORM DRAIN INLETS DIRECTLY DOWNSTREAM OF CONSTRUCTION AREA NOT NECESSARILY SHOWN ON THIS PLAN.
	TS	TEMPORARY STOCKPILE	9.	THE EXISTING VEGETATION OF THE SITE INCLUDES GRASSES AND WEEDS AND COVERS APPROXIMATELY 2.0 ACRES OF THE SITE.
4 44 1	\sim		10.	TOTAL SITE AREA IS 2.49 AC.; EXPECTED AREA TO UNDERGO DISTURBANCE IS APPROXIMATELY 2.75 AC.
\$C\\\	(VTC)	VEHICLE TRACKING CONTROL/CONSTRUCTION ENTRANCE	11.	SOIL EROSION POTENTIAL IS LOW. POTENTIAL IMPACTS UPON DISCHARGE INCLUDES TYPICAL SOIL EROSION.
200	(ECB)	EROSION CONTROL BLANKET	12.	OTHER POTENTIAL POLLUTION SOURCES INCLUDE AUTOMOBILE MAINTENANCE, LOCATED AT BUILDING ON SITE.
			13.	MATERIAL HANDLING PROCEDURES ARE INDICATED IN THE APPROVED STORMWATER MANAGEMENT PLAN.
	(IPO)	INLET PROTECTION	14.	NO BATCH PLANTS ARE USED FOR THIS SITE.
		SWMP SITE POSTING	15.	OTHER STORM WATER POLLUTANT CONTROL PROCEDURES INCLUDE WASTE DISPOSAL AND OFFSITE SOIL TRACKING.
-			14	THERE ARE NO MON STORMWATER COMPONENTS OF DISCHARGE ON DROJECT SITE INCLUDING NATURAL SPRINGS

16. THERE ARE NO NON-STORMWATER COMPONENTS OF DISCHARGE ON PROJECT SITE, INCLUDING NATURAL SPRINGS, 17. ULTIMATE RECEIVING WATERS ARE FALCON BASIN DPBS WHICH IS IN A FEMA DESIGNATED FLOODPLAIN. 🧲

18. EXISTING STORM WATER OUTFALL IS LOCATED $\frac{1}{4}$ MILES SOUTH OF THE SITE AT AN EXISTING RETENTION POND.

20. VEGETATIVE COVER DENSITY SHALL BE MINIMUM 70% OF PRE-DISTURBED LEVELS TO BE CONSIDERED STABILIZED.

19. FINAL STABILIZATION INCLUDES PAVEMENT AND LANDSCAPING. LONG-TERM STORM WATER QUALITY IS OBTAINED BY ROUTING OF FLOWS THROUGH EXISTING WATER QUALITY POND PLD.


21. CONTRACTOR TO INCLUDE SIGNATURE ON INSPECTION LOGS AND LOCATION OF SWMP RECORDS ON-SITE AT ALL TIMES IN ADDITION TO AUTHORITY HAVING JURISDICTION.

THAT ARE PART OF THIS PROJECT. THE CONTRACTOR SHALL BE HELD RESPONSIBLE FOR REMEDIATION OF ANY ADVERSE

IMPACTS TO ADJACENT WATERWAYS, WETLANDS, ETC., RESULTING FROM WORK DONE AS PART OF THIS PROJECT.

4. THE CONTRACTOR SHALL LOCATE, INSTALL, AND MAINTAIN ALL EROSION CONTROL AND WATER QUALITY "BEST

MANAGEMENT PRACTICES" AS INDICATED IN THE APPROVED STORMWATER MANAGEMENT PLAN.

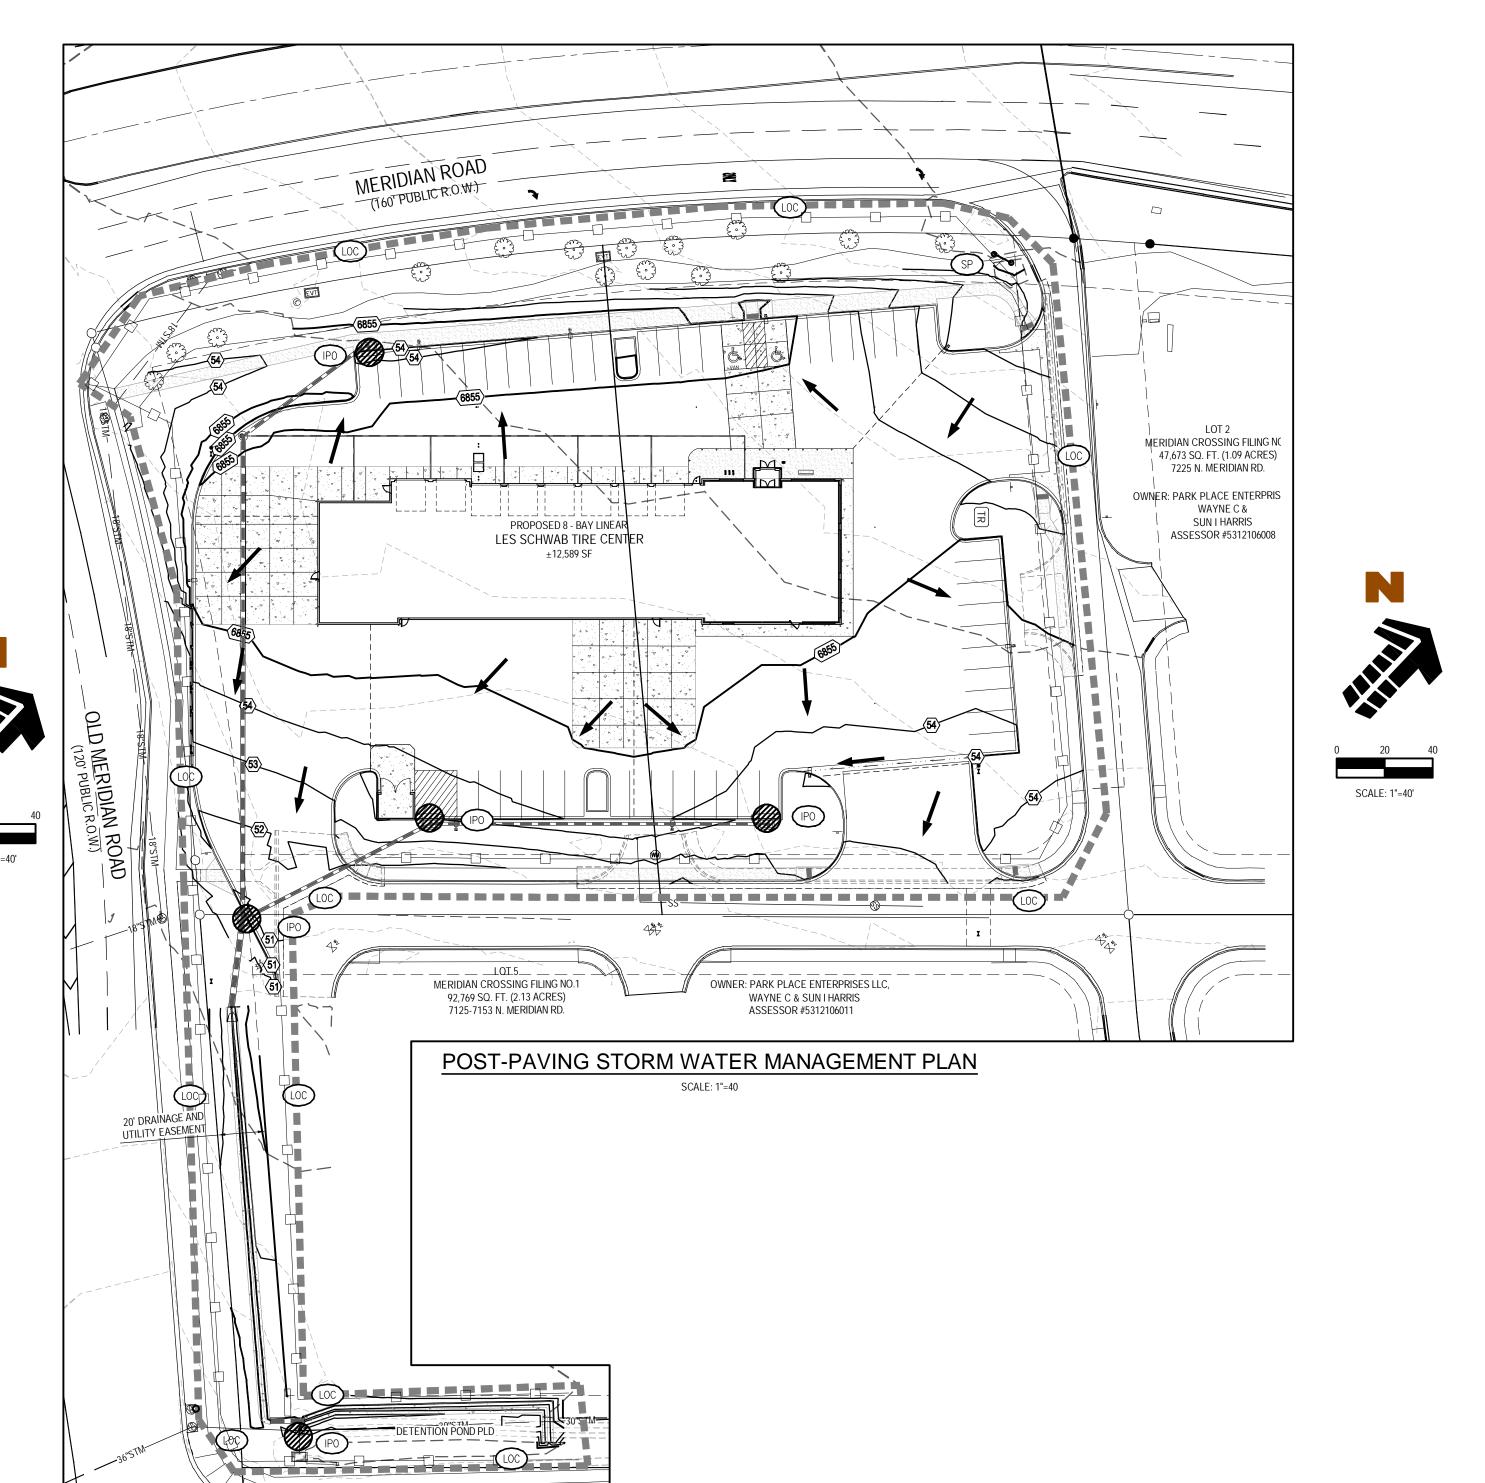

DUST CONTROL GENERAL NOTES

INSTALLATION OF WIND FENCING, AND THE TREATMENT OF STAGING AREAS.

THE CITY ENGINEER MAY REQUIRE THE SUBMITTAL OF A DUST PREVENTION AND CONTROL PLAN FOR GRADING AND CONSTRUCTION AS DEEMED NECESSARY. AT THE VERY MINIMUM THE FOLLOWING CONDITIONS CONCERNING THE CONTROL OF GRADING AND CONSTRUCTION DUST SHALL BE ADHERED TO, AS WELL AS FOLLOWING SCAQMD REQUIREMENTS WITH REGARDS TO FUGITIVE DUST. • FUGITIVE DUST EMISSIONS WILL BE CONTROLLED TWENTY-FOUR (24) HOURS A DAY, SEVEN (7) DAYS A WEEK, WHETHER OR

- NOT THERE IS CURRENT ACTIVITY ON THE SITE. THERE SHALL BE A 24-HOUR CONTACT NAME AND PHONE NUMBER FOR THE PERSON RESPONSIBLE FOR ENSURING THE
- CONTROL OF FUGITIVE DUST, WHETHER OR NOT THERE IS CURRENT ACTIVITY AT THE SITE.

• DUST CONTROL MEASURES SHALL INCLUDE, BUT ARE NOT LIMITED TO THE APPLICATION OF WATER OR DUST PALLIATIVES, THE

 WHEN AN ENTIRE PROJECT IS GRADED AND THE SUBSEQUENT CONSTRUCTION ON THE SITE IS TO BE COMPLETED IN PHASES, THE PORTION OF THE SITE NOT UNDER CONSTRUCTION SHALL BE TREATED WITH CHEMICAL STABILIZERS, OR PLANT MATERIALS AND AN IRRIGATION SYSTEM.

IF THE IMPORTING OR EXPORTING OF SOIL IS NECESSARY, DUST CONTROL SHALL INCLUDE PROCEDURES FOR THE CONTROL OF DUST RESULTING FROM THE LOADING, TRANSPORTATION AND UNLOADING OF SOIL FROM, TO OR WITHIN THE PROJECT AREA AND

INSPECTION AND MAINTENANCE PROCEDURES FOR CONSTRUCTION

THE CORNERSTONE OF THE MAINTENANCE PROCEDURE IS CONTAINED IN THE APPROVED STORMWATER MANAGEMENT PLAN. QUALIFIED OWNERS REPRESENTATIVES AND GENERAL CONTRACTOR SITE SUPERINTENDENTS WILL BE TRAINED IN THE INSPECTION AND MAINTENANCE PRACTICES NECESSARY FOR KEEPING THE POLLUTANT CONTROLS USED IN THE SWMP IN GOOD WORKING ORDER. THE SITE SUPERINTENDENT WILL BE RESPONSIBLE FOR THE DAILY OVERSIGHT OF THE POLLUTION CONTROLS ALONG WITH THE EXECUTION OF THE SITE INSPECTION REPORT IN ACCORDANCE WITH THE SWMP. THE OWNER'S REPRESENTATIVE WILL ALSO HAVE PERIODIC INSPECTION REQUIREMENTS TO ENSURE PROPER EXECUTION OF SITE INSPECTIONS AND MAINTENANCE.

NARRATIVE:

APPROVED STORMWATER MANAGEMENT PLAN.

- DESCRIPTION OF BMPS TO BE USED, INCLUDING DIVERSION DITCHES / BERM, CHECK DAM, CONSTRUCTION ENTRANCE, INLET PROTECTION, SEDIMENT BASINS / TRAPS, SILT FENCE, AND FIBER FLOCCULENT TUBE (WATTLES) ARE INCLUDED IN THE
- APPROVED STORMWATER MANAGEMENT PLAN. DESCRITION OF NON-STRUCTURAL BMPS INCLUDING DUST CONTROL, CONCRETE WASTE, EQUIPMENT/VEHICLE MAINTANENCE, FUEL TANKS, HAZARDOUS WASTE MANAGEMENT AND SPILL REPORTING, BUILDING MATERIALS AND SUPPLIES, OFFSITE VEHICLE TRACKING, SANITARY WASTE, SOLID WASTE MATERIAL, AND NON STORMWATER DISCHARGED ARE INCLUDED IN THE
- DESCRIPTION OF CONSTRUCTION ACTIVITIES INCLUDING PRE (PHASE I) AND POST (PHASE II) SEQUENCING, TEMPORARY STABALIZATION, DEWATERING, AND PERMANENT STABILIZATION ARE INCLUDED IN THE APPROVED STORMWATER MANAGEMENT PLAN.

SWMP REVISION NOTE:

THE SWMP (E.G., DESIGN OF RETENTION POND CAPACITY)

AT NEARLY EVERY SITE, THE IMPLEMENTED BMPS WILL HAVE TO BE MODIFIED TO ADAPT TO CHANGING SITE CONDITIONS, OR TO ENSURE THAT POTENTIAL POLLUTANTS ARE CONSISTENTLY AND PROPERLY MANAGED. THE POLLUTANT SOURCES AND MANAGEMENT PRACTICES AT A SITE MUST BE REVIEWED ON AN ONGOING BASIS (AND SPECIFICALLY DURING THE REQUIRED INSPECTIONS LISTED IN PART I.D.6 OF THE CDPHE STORMWATER CONSTRUCTION PERMIT). WHEN BMPS OR OTHER SITE CONDITIONS CHANGE. THE SWMP MUST BE MODIFIED TO ACCURATELY REFLECT THE ACTUAL FIELD CONDITIONS. EXAMPLES INCLUDE. BUT ARE NOT LIMITED TO, REMOVAL OF BMPS, IDENTIFICATION OF NEW POTENTIAL POLLUTANT SOURCES, ADDITION OF BMPS, MODIFICATION OF BMP INSTALLATION AND IMPLEMENTATION CRITERIA OR MAINTENANCE PROCEDURES, AND CHANGES IN ITEMS INCLUDED IN THE SITE MAP AND/OR DESCRIPTION. SWMP REVISIONS MUST BE MADE PRIOR TO CHANGES IN SITE CONDITIONS, EXCEPT FOR RESPONSIVE SWMP CHANGES, AS FOLLOWS:

SWMP REVISIONS MUST BE MADE IMMEDIATELY AFTER CHANGES ARE MADE IN THE FIELD TO ADDRESS BMP INSTALLATION AND/OR IMPLEMENTATION ISSUES; OR SWMP REVISIONS MUST BE MADE AS SOON AS PRACTICABLE, BUT IN NO CASE MORE THAN 72 HOURS, AFTER CHANGE(S) IN BMP INSTALLATION AND/OR IMPLEMENTATION OCCUR AT THE SITE THAT REQUIRE DEVELOPMENT OF MATERIALS TO MODIFY

THE SWMP SHOULD BE VIEWED AS A "LIVING DOCUMENT" THAT IS CONTINUOUSLY BEING REVIEWED AND MODIFIED AS PART OF THE OVERALL PROCESS OF ASSESSING AND MANAGING STORMWATER QUALITY ISSUES AT THE SITE.

BENCHMARK

THE NATIONAL GEODETIC SURVEY (NGS) MONUMENT DESIGNATION 'E 24' , PID JK0239, WHICH HAS AN ELEVATION OF 6902.3 (NAVD 88 DATUM). THE STATION IS LOCATED ABOUT 7 MI (11.3 KM) SOUTHWEST OF PEYTON, 2 MI (3.2 KM) NORTHEAST OF FALCON AND ON U.S. HIGHWAY 24, IN THE SOUTHEAST 1/4 OF SECTION 32, T 12 S, R 64 W, AND AT U.S. HIGHWAY 24 MILEPOST 322.45. OWNERSHIP--EL PASO COUNTY PARK PROPERTY TO REACH THE STATION, GO TO THE INTERSECTION OF U.S. HIGHWAY 24 AND JUDGE ORR ROAD AND THE STATION IN THE NORTHEAST CORNER OF THE INTERSECTION THE STATION IS A STANDARD DISK SET IN A 25 CM SQUARE CONCRETE POST, PROJECTING 30 CM ABOVE THE GROUND. IT IS 26.8 M (87.9 FT) EAST-NORTHEAST FROM JUDGE ORR ROAD. 15.7 M (51.5 FT) FROM A DIRT ROAD TO A PRIVATE RESIDENCE, 0.8 M (2.6 FT) SOUTHWEST FROM A PLASTIC WITNESS POST, 0.7 M (2.3 FT) NORTH FROM A METAL WITNESS POST AND 0.6 M (2.0 FT) EAST FROM A FENCE CORNER.

NAVD88 ELEVATION = 6902.3'

LEGAL DESCRIPTION

ALL OF LOTS 3 AND 4, MERIDIAN CROSSING FILING NO. 1, SITUATED IN THE NORTHEAST QUARTER OF SECTION 12, TOWNSHIP 13 SOUTH, RANGE 65 WEST OF THE 6TH PRINCIPAL MERIDIAN, TOWN OF FALCON, COUNTY OF EL PASO, STATE OF COLORADO.

BASIS OF BEARING

BEARINGS ARE BASED ON THE NORTHWESTERLY LINE OF MERIDIAN CROSSING FILING NO. 1, LOTS 1 & 2 AND IS ASSUMED TO BEAR N51°13'14"E.

1755 Telstar Drive, Suite 107 Colorado Springs, Co 80920 719.900.7220 O www.gallowayUS.com







COPYRIGHT THESE PLANS ARE AN INSTRUMENT OF SERVICE AND ARE THE PROPERTY OF GALLOWAY, AND MAY NOT BE DUPLICATED, DISCLOSED, OR REPRODUCED WITHOUT THE WRITTEN CONSENT OF GALLOWAY COPYRIGHTS AND INFRINGEMENTS WILL BE ENFORCED AND PROSECUTED.

Date Issue / Description **0** 3/27/18 CLIENT SET 4/6/18 SDP SUBMITTAL 6/8/18 2ND SDP SUBMITTAL **3** 8/7/18 BID SET 4 8/10/18 3RD SDP SUBMITTAL

Checked By

EROSION CONTROL PLAN

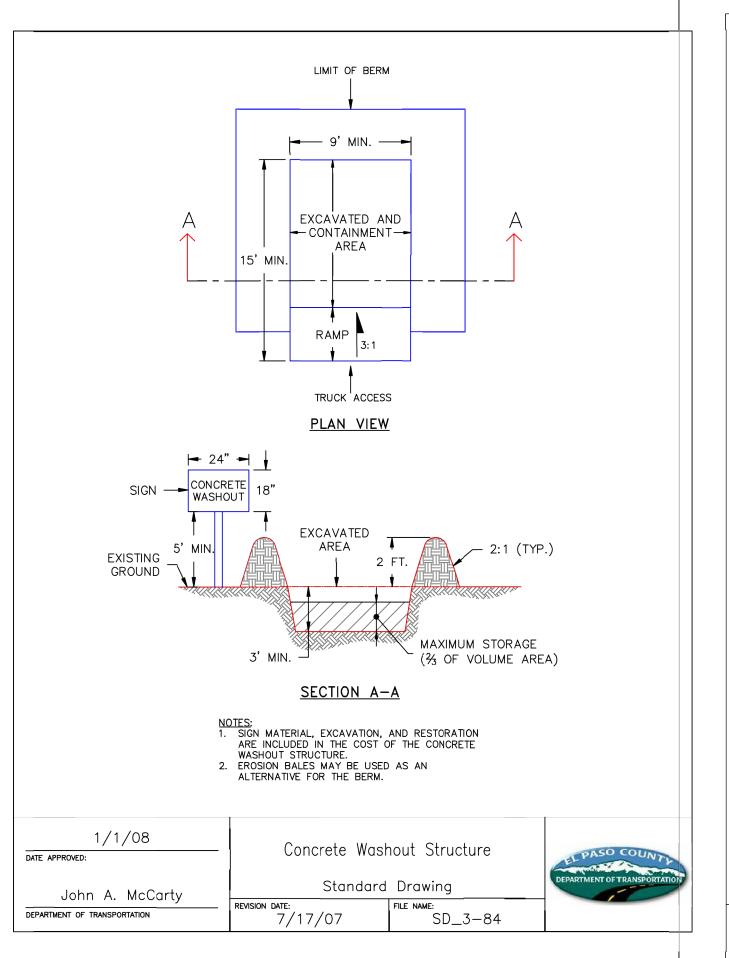


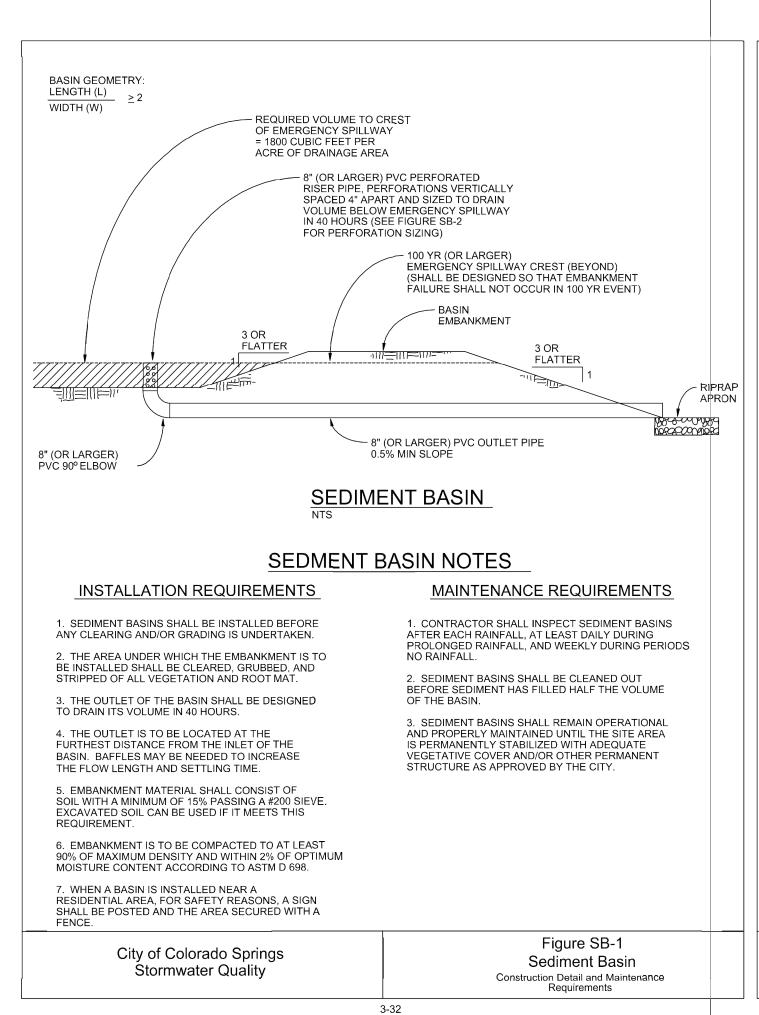

	-				Depth at C	Outlet (ft)			
		1.0	1.5	2.0	2.5	3.0	3.5	4.0	4.5
	2	15.04	7.71	5.10	3.76	2.95	2.41	2.02	1.73
Ī	1	7.52	3.86	2.55	1.88	1.48	1.21	1.01	0.87
æ l	0.6	4.51	2.31	1.53	1.13	0.89	0.72	0.61	0.52
ė	0.4	3.01	1.54	1.02	0.75	0.59	0.48	0.40	0.35
(ac	0.2	1.50	0.77	0.51	0.38	0.30	0.24	0.20	0.17
E [0.1	0.75	0.39	0.26	0.19	0.15	0.12	0.10	0.09
/olc	0.06	0.45	0.23	0.15	0.11	0.09	0.07	0.06	0.05
Design Volume (acre-ft)	0.04	0.30	0.15	0.10	0.08	0.06	0.05	0.04	0.03
esić	0.02	0.15	0.08	0.05	0.04	0.03	0.02	0.02	0.02
Δ	0.01	0.08	0.04	0.03	0.02	0.01	0.01	0.01	0.01
cular	Perforati	on Sizina							
le Dia	ameter		Diameter (in)		n = 1		Row (in ²)	n = 3
	ameter)	Hole [Diameter (in) 250		n = 1 0.05)	n = 3 0.15
le Dia (in	ameter) 1	Hole D (0.	in)				n = 2)	
le Dia (in 1/4	ameter) 4 6	Hole [(0. 0.	250 313 375		0.05 0.08 0.11		n = 2 0.10 0.15 0.22)	0.15 0.23 0.33
le Dia (in 1/ ² 5/1 3/8 7/1	ameter) 4 6 3	Hole E 0. 0. 0.	250 313 375 438		0.05 0.08 0.11 0.15		n = 2 0.10 0.15 0.22 0.30)	0.15 0.23 0.33 0.45
le Dia (in 1/4 5/1 3/8 7/1	ameter) 4 6 3 6 2	Hole C (0. 0. 0. 0.	250 313 375 438 500		0.05 0.08 0.11 0.15 0.20		n = 2 0.10 0.15 0.22 0.30 0.39)	0.15 0.23 0.33 0.45 0.59
le Dia (in 1/4 5/1 3/8 7/1 1/2 9/1	ameter) 4 6 3 6 2 6	Hole C 0. 0. 0. 0.	250 313 375 438 500 563		0.05 0.08 0.11 0.15 0.20 0.25		n = 2 0.10 0.15 0.22 0.30 0.39 0.50)	0.15 0.23 0.33 0.45 0.59
le Dia (in 1/2 5/1 3/8 7/1 1/2 9/1 5/8	ameter) 4 6 3 6 2 6 3	Hole E (0. 0. 0. 0. 0. 0. 0. 0. 0. 0.	250 313 375 438 500 563 625		0.05 0.08 0.11 0.15 0.20 0.25		n = 2 0.10 0.15 0.22 0.30 0.39 0.50 0.61)	0.15 0.23 0.33 0.45 0.59 0.75
le Dia (in 1/2 5/1 3/8 7/1 1/2 9/1 5/8	ameter) 4 6 3 6 2 6 3 1 6	Hole C 0. 0. 0. 0. 0. 0. 0. 0. 0. 0. 0. 0. 0.	(in) 250 313 375 438 500 563 625 688		0.05 0.08 0.11 0.15 0.20 0.25 0.31 0.37		n = 2 0.10 0.15 0.22 0.30 0.39 0.50 0.61 0.74		0.15 0.23 0.33 0.45 0.59 0.75 0.92 1.11
le Dia (in 1/4 5/1 3/8 7/1 1/2 9/1 5/8 11/1 3/4	meter) 4 6 3 6 2 6 3 16 4	Hole [((0 () .	(in) 250 313 375 438 500 563 625 688 750		0.05 0.08 0.11 0.15 0.20 0.25 0.31 0.37 0.44		n = 2 0.10 0.15 0.22 0.30 0.39 0.50 0.61 0.74 0.88		0.15 0.23 0.33 0.45 0.59 0.75 0.92 1.11 1.33
le Dia (in 1/2 5/1 3/8 7/1 1/2 9/1 5/8	ameter) 4 6 6 3 6 2 6 3 1 6 4 3	Hole E (0	(in) 250 313 375 438 500 563 625 688		0.05 0.08 0.11 0.15 0.20 0.25 0.31 0.37		n = 2 0.10 0.15 0.22 0.30 0.39 0.50 0.61 0.74		0.15 0.23 0.33 0.45 0.59 0.75 0.92 1.11
le Dia (in 1/2 5/1 3/8 7/1 1/2 9/1 5/8 11/2 3/4	ameter) 4 6 6 3 6 2 6 3 11 6 4 3	Hole [((0 () .	(in) 250 313 375 438 500 563 625 688 750 875		0.05 0.08 0.11 0.15 0.20 0.25 0.31 0.37 0.44 0.60		n = 2 0.10 0.15 0.22 0.30 0.39 0.50 0.61 0.74 0.88 1.20		0.15 0.23 0.33 0.45 0.59 0.75 0.92 1.11 1.33 1.80
le Dia (in 1/2 5/1 3/8 7/1 1/2 9/1 5/8 11/1 3/2 7/8	meter) 4 6 3 6 2 6 3 16 4 3 17 8	Hole [(((((((((((((((((((in) 250 313 375 438 500 563 625 688 750 875		0.05 0.08 0.11 0.15 0.20 0.25 0.31 0.37 0.44 0.60 0.79		n = 2 0.10 0.15 0.22 0.30 0.39 0.50 0.61 0.74 0.88 1.20 1.57		0.15 0.23 0.33 0.45 0.59 0.75 0.92 1.11 1.33 1.80 2.36
le Diaid (in 1/2 (in 1/2 5/11 3/8 5/11 3/8 7/11 1/2 9/11 1/2 3/2 11 1/2 1 1/2	meter) 4 6 8 8 6 2 6 8 16 4 8 8 /8 /8	Hole [((in) 250 313 375 438 500 563 625 688 750 875 000 125 250 375		0.05 0.08 0.11 0.15 0.20 0.25 0.31 0.37 0.44 0.60 0.79 0.99		n = 2 0.10 0.15 0.22 0.30 0.39 0.50 0.61 0.74 0.88 1.20 1.57 1.99		0.15 0.23 0.33 0.45 0.59 0.75 0.92 1.11 1.33 1.80 2.36 2.98
e Diai (in 1/4/2) (in	meter) 4 6 3 6 2 6 3 16 4 3 1/8	Hole [((0 () ((in) 250 313 375 438 500 563 625 688 750 875 000 125 250 375 500		0.05 0.08 0.11 0.15 0.20 0.25 0.31 0.37 0.44 0.60 0.79 0.99 1.23 1.48 1.77		n = 2 0.10 0.15 0.22 0.30 0.39 0.50 0.61 0.74 0.88 1.20 1.57 1.99 2.45 2.97 3.53		0.15 0.23 0.33 0.45 0.59 0.75 0.92 1.11 1.33 1.80 2.36 2.98 3.68 4.45 5.30
le Diaisi (in 1/4/2) (meter) 4 6 3 6 2 6 3 16 4 3 17 18 18 18 18 18 18 18 18 18	Hole [((0 () .	(in) 250 313 375 438 500 563 625 688 750 875 000 125 250 375 500 625		0.05 0.08 0.11 0.15 0.20 0.25 0.31 0.37 0.44 0.60 0.79 0.99 1.23 1.48 1.77 2.07		n = 2 0.10 0.15 0.22 0.30 0.39 0.50 0.61 0.74 0.88 1.20 1.57 1.99 2.45 2.97 3.53 4.15		0.15 0.23 0.33 0.45 0.59 0.75 0.92 1.11 1.33 1.80 2.36 2.98 3.68 4.45 5.30 6.22
le Diaisi (in 1/4/2) (meter) 4 6 3 6 2 6 3 16 4 3 17 18 18 18 18 18 18 18 18 18	Hole [((0 () ((in) 250 313 375 438 500 563 625 688 750 875 000 125 250 375 500 625 750		0.05 0.08 0.11 0.15 0.20 0.25 0.31 0.37 0.44 0.60 0.79 0.99 1.23 1.48 1.77 2.07 2.41		n = 2 0.10 0.15 0.22 0.30 0.39 0.50 0.61 0.74 0.88 1.20 1.57 1.99 2.45 2.97 3.53 4.15 4.81		0.15 0.23 0.33 0.45 0.59 0.75 0.92 1.11 1.33 1.80 2.36 2.98 3.68 4.45 5.30 6.22 7.22
le Diad (inn 1/4) (inn 1/4	Ameter) 14	Hole [((0 () ((in) 250 313 375 438 500 563 625 688 750 875 000 125 250 375 500 625 750 875		0.05 0.08 0.11 0.15 0.20 0.25 0.31 0.37 0.44 0.60 0.79 0.99 1.23 1.48 1.77 2.07 2.41 2.76		n = 2 0.10 0.15 0.22 0.30 0.39 0.50 0.61 0.74 0.88 1.20 1.57 1.99 2.45 2.97 3.53 4.15 4.81 5.52		0.15 0.23 0.33 0.45 0.59 0.75 0.92 1.11 1.33 1.80 2.36 2.98 3.68 4.45 5.30 6.22 7.22 8.28
e Diai (in 1/4/2) (in	Ameter) 14	Hole [((0 () ((in) 250 313 375 438 500 563 625 688 750 875 000 125 250 375 500 625 750 875 000	nhar of co	0.05 0.08 0.11 0.15 0.20 0.25 0.31 0.37 0.44 0.60 0.79 0.99 1.23 1.48 1.77 2.07 2.41 2.76 3.14		n = 2 0.10 0.15 0.22 0.30 0.39 0.50 0.61 0.74 0.88 1.20 1.57 1.99 2.45 2.97 3.53 4.15 4.81 5.52 6.28		0.15 0.23 0.33 0.45 0.59 0.75 0.92 1.11 1.33 1.80 2.36 2.98 3.68 4.45 5.30 6.22 7.22
e Dia (in 1/4)	ameter) 4 6 6 3 6 2 6 3 11 6 4 3 7 7 8 7 7 8 7 8 7 8 7 8 7 8 7 8 7 8 7	Hole [((0 () (250 313 375 438 500 563 625 688 750 875 000 125 250 375 500 625 750 875 000 n = Nur	nber of co	0.05 0.08 0.11 0.15 0.20 0.25 0.31 0.37 0.44 0.60 0.79 0.99 1.23 1.48 1.77 2.07 2.41 2.76	erforation	n = 2 0.10 0.15 0.22 0.30 0.39 0.50 0.61 0.74 0.88 1.20 1.57 1.99 2.45 2.97 3.53 4.15 4.81 5.52 6.28		0.15 0.23 0.33 0.45 0.59 0.75 0.92 1.11 1.33 1.80 2.36 2.98 3.68 4.45 5.30 6.22 7.22 8.28

City of Colorado Springs

Stormwater Quality

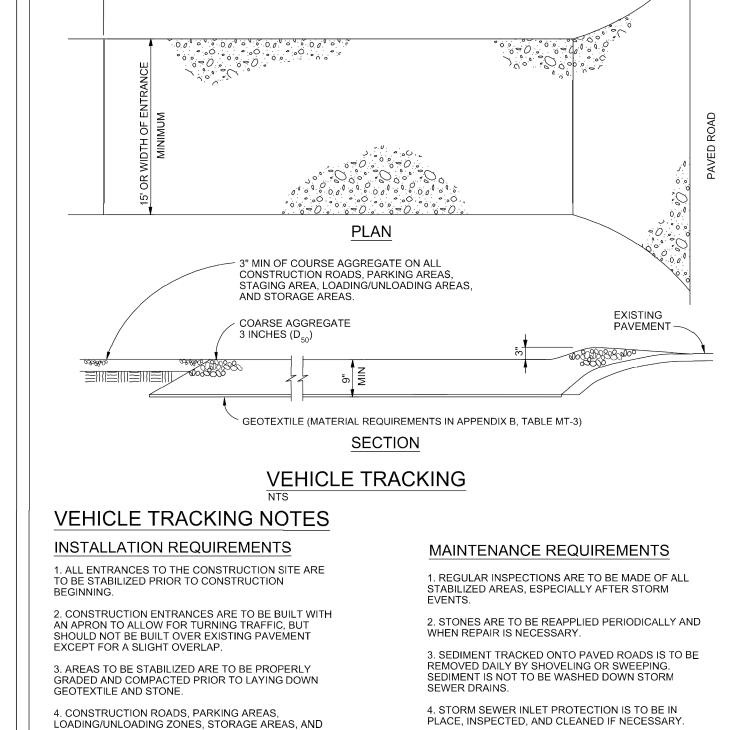

5. OTHER ASSOCIATED SEDIMENT CONTROL MEASURES

Figure VT-2

Vehicle Tracking

Application Examples

ARE TO BE INSPECTED TO ENSURE GOOD WORKING

STAGING AREAS ARE TO BE STABILIZED.

EXCESSIVELY STEEP.

Figure SB-2

Outlet Sizing

Application Techniques and Maintenance


5. CONSTRUCTION ROADS ARE TO BE BUILT TO

CONFORM TO SITE GRADES, BUT SHOULD NOT HAVE SIDE SLOPES OR ROAD GRADES THAT ARE

City of Colorado Springs


Stormwater Quality


75'-0' MIN

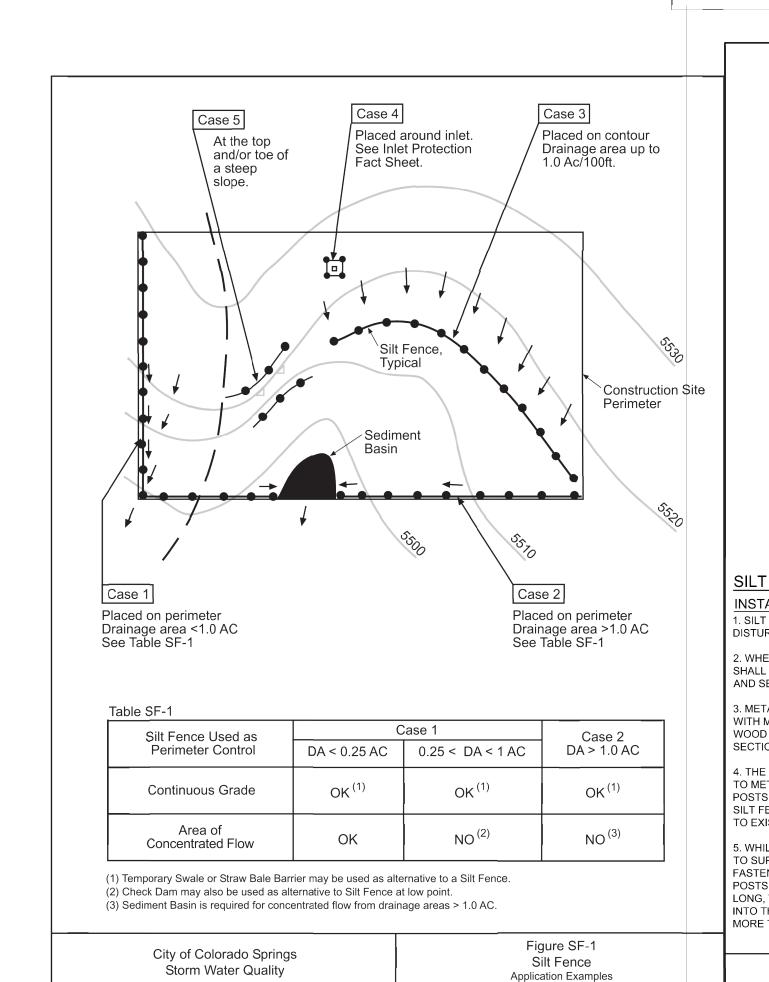

3-35

DEN/M/153722.CS.CB/FigSF-1/9-99

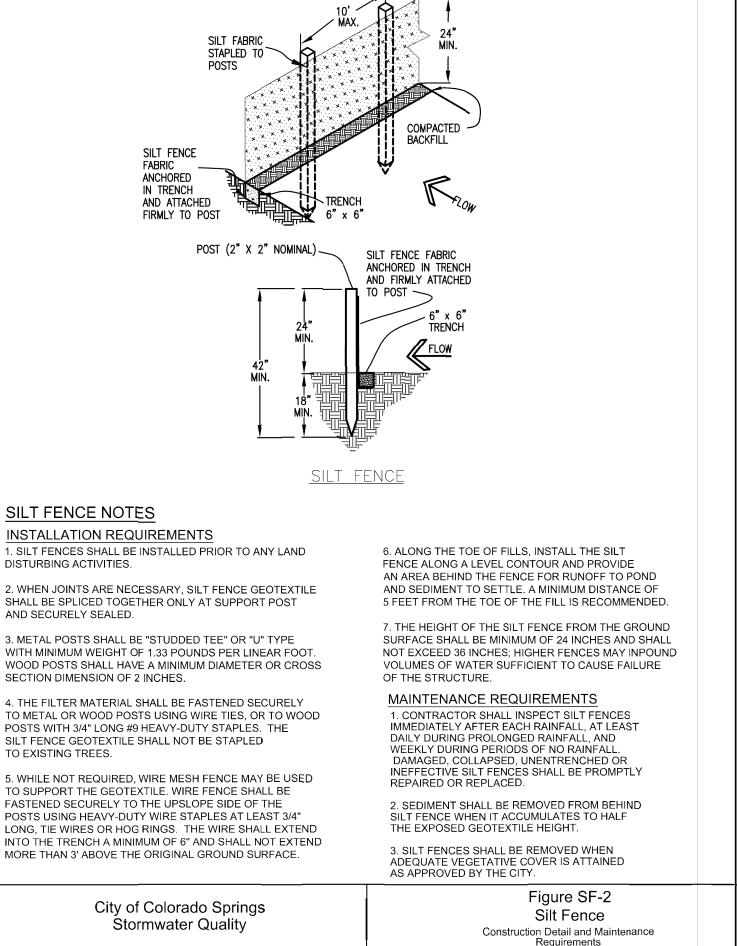

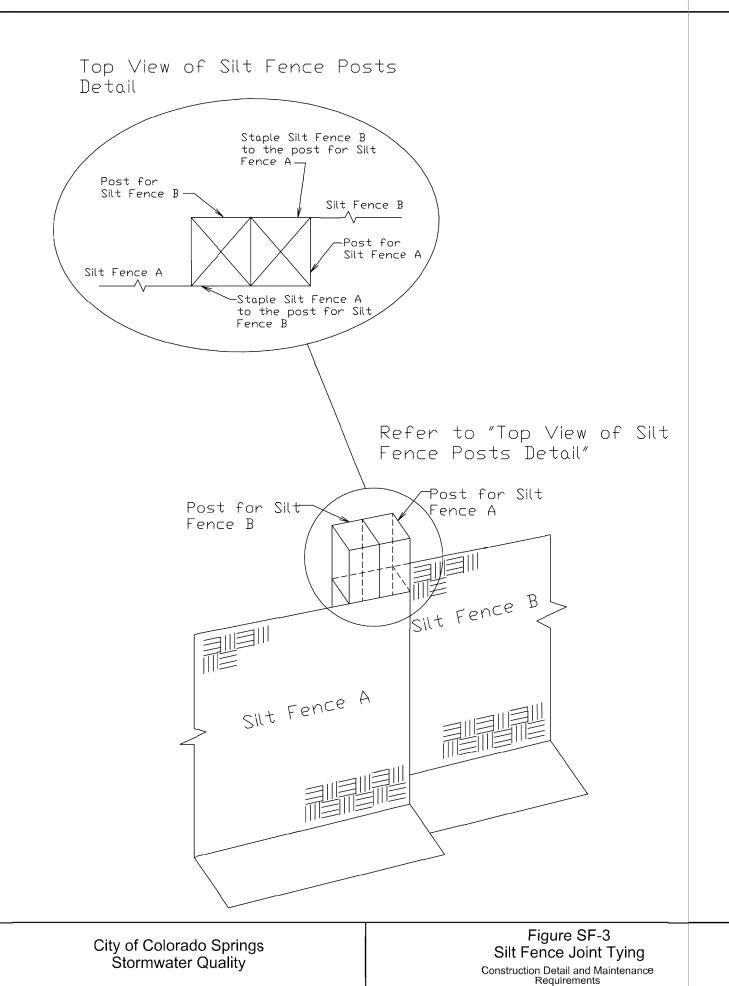

3-33



3-54

Galloway
Planning. Architecture. Engineering.

1755 Telstar Drive. Suite 107

Planning. Architecture. Engine
1755 Telstar Drive, Suite 107
Colorado Springs, Co 80920
719.900.7220 O
www.gallowayUS.com





COPYRIGHT

THESE PLANS ARE AN INSTRUMENT OF
SERVICE AND ARE THE PROPERTY OF
GALLOWAY, AND MAY NOT BE DUPLICATED,
DISCLOSED, OR REPRODUCED WITHOUT
THE WRITTEN CONSENT OF GALLOWAY.
COPYRIGHTS AND INFRINGEMENTS WILL
BE ENFORCED AND PROSECUTED.

HWAB TIRE CO.

NG DOCUMENTS

NN CROSSING FILING No.

Date | Issue / Description | O | 3/27/18 | CLIENT SET | SDP SUBMITTAL | 2 | 6/8/18 | 2ND SDP SUBMITTAL | BID SET | BID SET |

4 8/10/18 3RD SDP SUBMITTAL

 Project No:
 LST00067

 Drawn By:
 JRP

 Checked By:
 JDP

 Date:
 4/6/2018

EROSION CONTROL DETAILS

 $\overline{C3.5}$

Markup Summary

County (1)

STORMWATER MAI

1. THE CONTRACTOR ANDIOR AUTHORIZE POTENTIAL POLLUBRITS THAT MAY HA

Subject: Engineer Page Label: 3 Lock: Locked Author: dsdgrimm

Date: 9/6/2018 8:12:50 AM

Color: ■

provide the receiving creek (Falcon creek) (1)

PRIF SOL TRACORG.

DATURE SPREAS

SOLAR Provide the receiving creek (Falcon creek)

AUTH & GOMBAB P

EXERCISEMENTS

Subject: Engineer Page Label: 3 Lock: Locked Author: dsdgrimm

Date: 9/6/2018 8:12:51 AM

Color: ■

County

provide the receiving creek (Falcon creek)