
 




C0.0

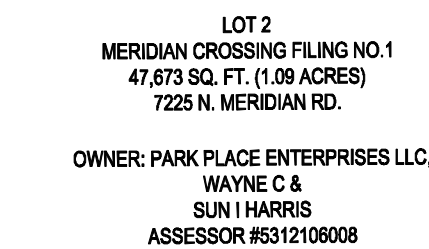



OWNER: PARK PLACE ENTERPRISES LLC,
WAYNE C & SUN I HARRIS
ASSESSOR #5312106011

LOT 6
MERIDIAN CROSSING FILING NO.1
70,864 SQ. FT. (1.63 ACRES)
7165-7189 N. MERIDIAN RD.
OWNER: PARK PLACE ENTERPRISES
LLC, WAYNE C &
SUN I HARRIS
ASSESSOR #5312106012



1. ALL UTILITY LOCATIONS SHOWN ARE BASED ON MAPS PROVIDED BY THE APPROPRIATE UTILITY COMPANY AND FIELD SURFACE EVIDENCE AT THE TIME OF SURVEY AND IS TO BE CONSIDERED AN APPROXIMATE LOCATION ONLY. IF IT IS THE CONTRACTOR'S RESPONSIBILITY TO FIELD VERIFY THE FIELD LOCATION OF ALL UTILITIES, PUBLIC OR PRIVATE, WHETHER SHOWN ON THE PLANS OR NOT, PRIOR TO CONSTRUCTION, REPORT ANY DISCREPANCIES TO THE ENGINEER PRIOR TO CONSTRUCTION.
2. WHERE A PROPOSED UTILITY CROSSES AN EXISTING UTILITY, IT IS THE CONTRACTOR'S RESPONSIBILITY TO FIELD VERIFY THE HORIZONTAL AND VERTICAL LOCATION OF SUCH EXISTING UTILITY, EITHER THROUGH POT-HOLING OR ALTERNATIVE METHOD. REPORT INFORMATION TO THE ENGINEER PRIOR TO CONSTRUCTION.




7105 N. MERIDIAN ROAD
FALCON, COLORADO


Project No:	LST00067
Drawn By:	JRP
Checked By:	JDP
Date:	4/6/2018

SITE ADA ROUTE

C1.2

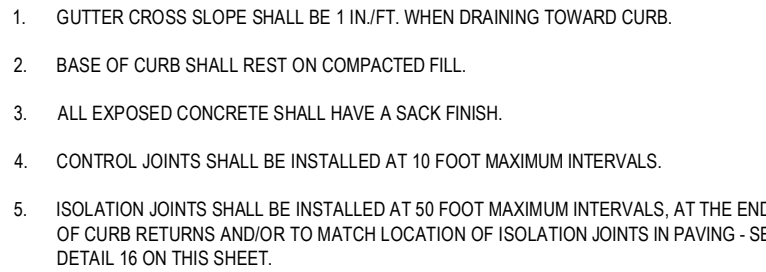

NOT TO SCALE

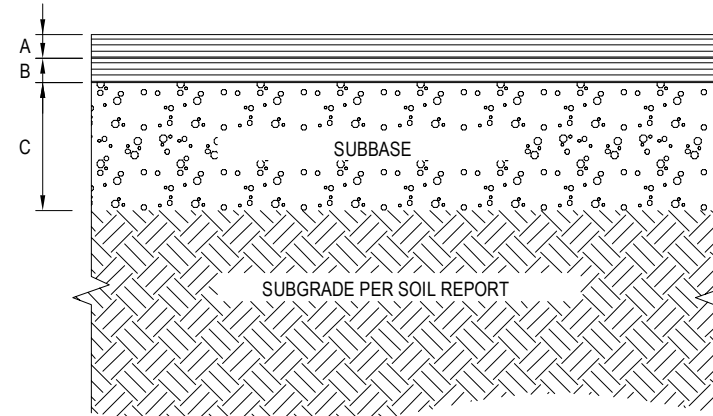

NOT TO SCALE




NOT TO SCALE

Ø0.562


NOT TO SCALE



NOT TO SCALE

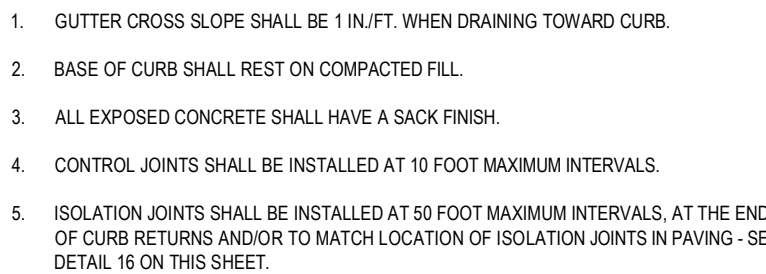


NOT TO SCALE

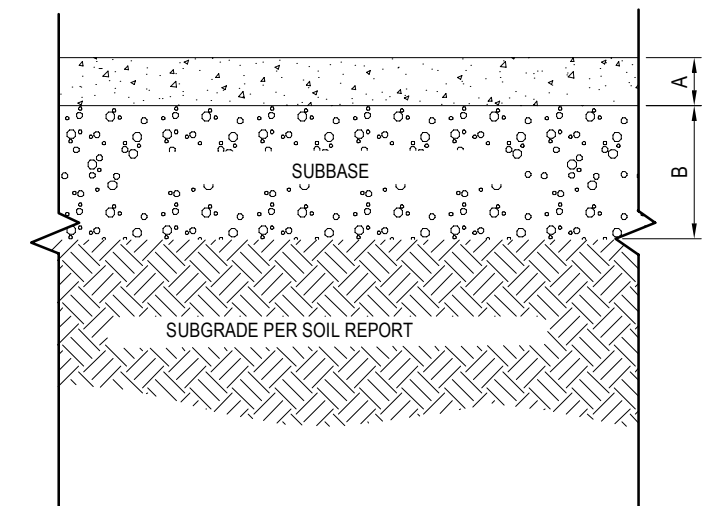


NOT TO SCALE



NOT TO SCALE

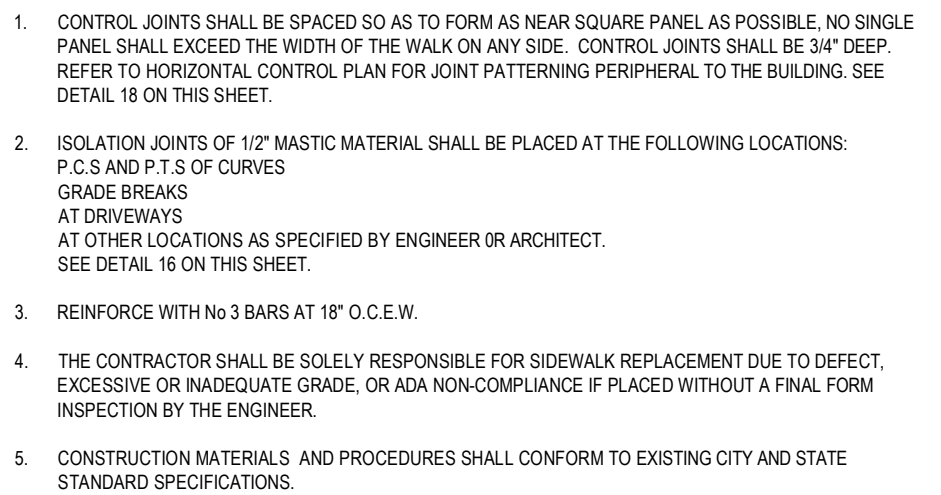


NOT TO SCALE

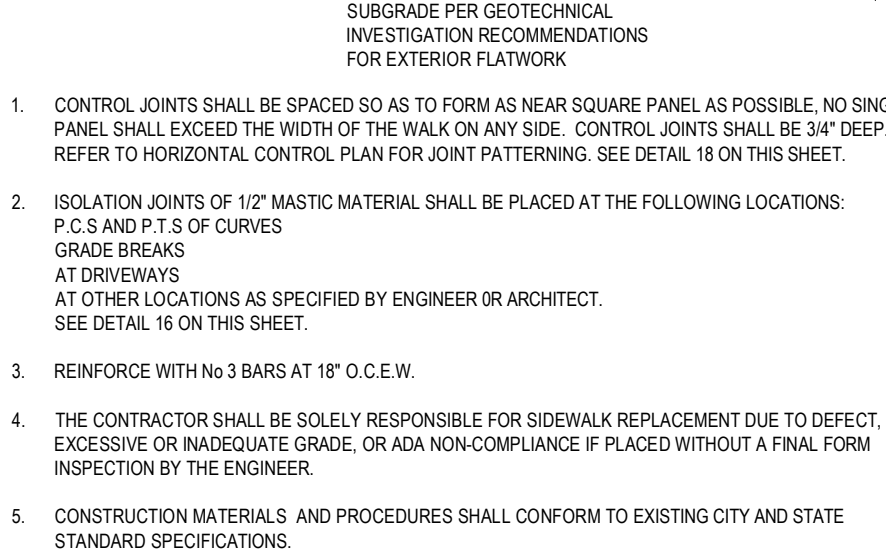


NOT TO SCALE


1. WABASH VALLEY MANUFACTURING INC.
"CITY LIMITS STRAIGHT BENCH"
2. PERFORATED 3 SEAT W/BACK
3. SURFACE MOUNT
4. DARK BRONZE
5. MODEL #CL321 BENCH, WITH MC103 PLATE
COVERS
6. UNLESS OTHERWISE SPECIFIED, ALL
DIMENSIONS ARE IN INCHES AND PER ASM
Y14.3M-1994.
7. ALL DIMENSIONS ARE AFTER PLASTISOL
COATING.

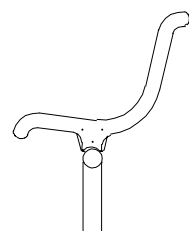


NOT TO SCALE

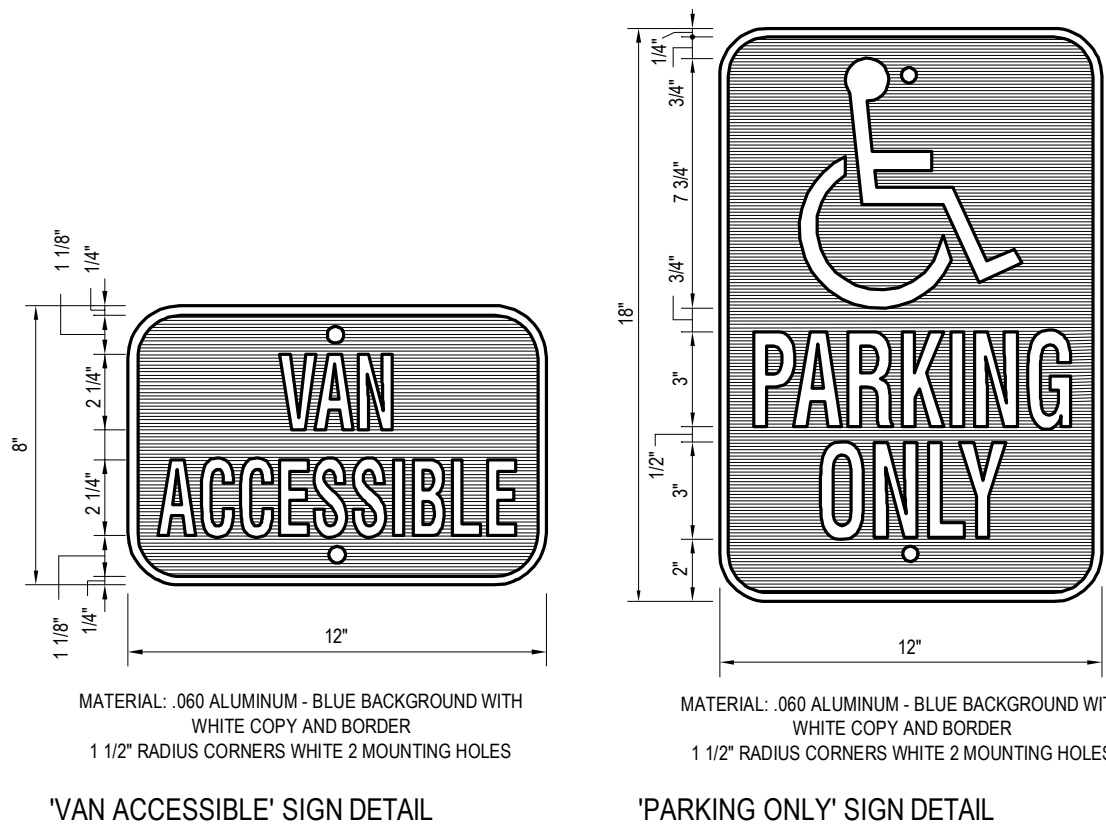


NOT TO SCALE

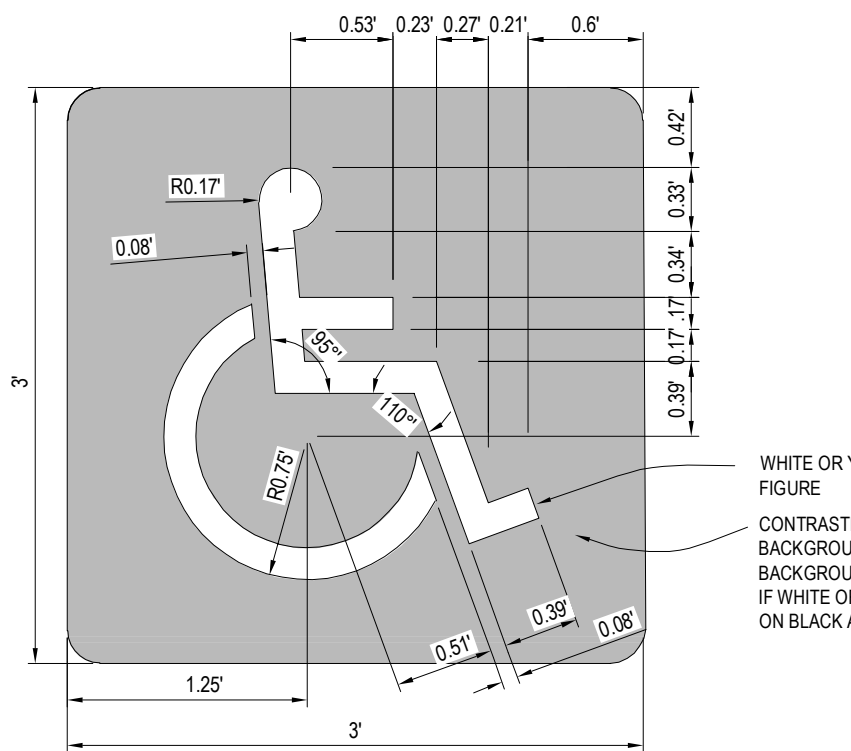

NOT TO SCALE

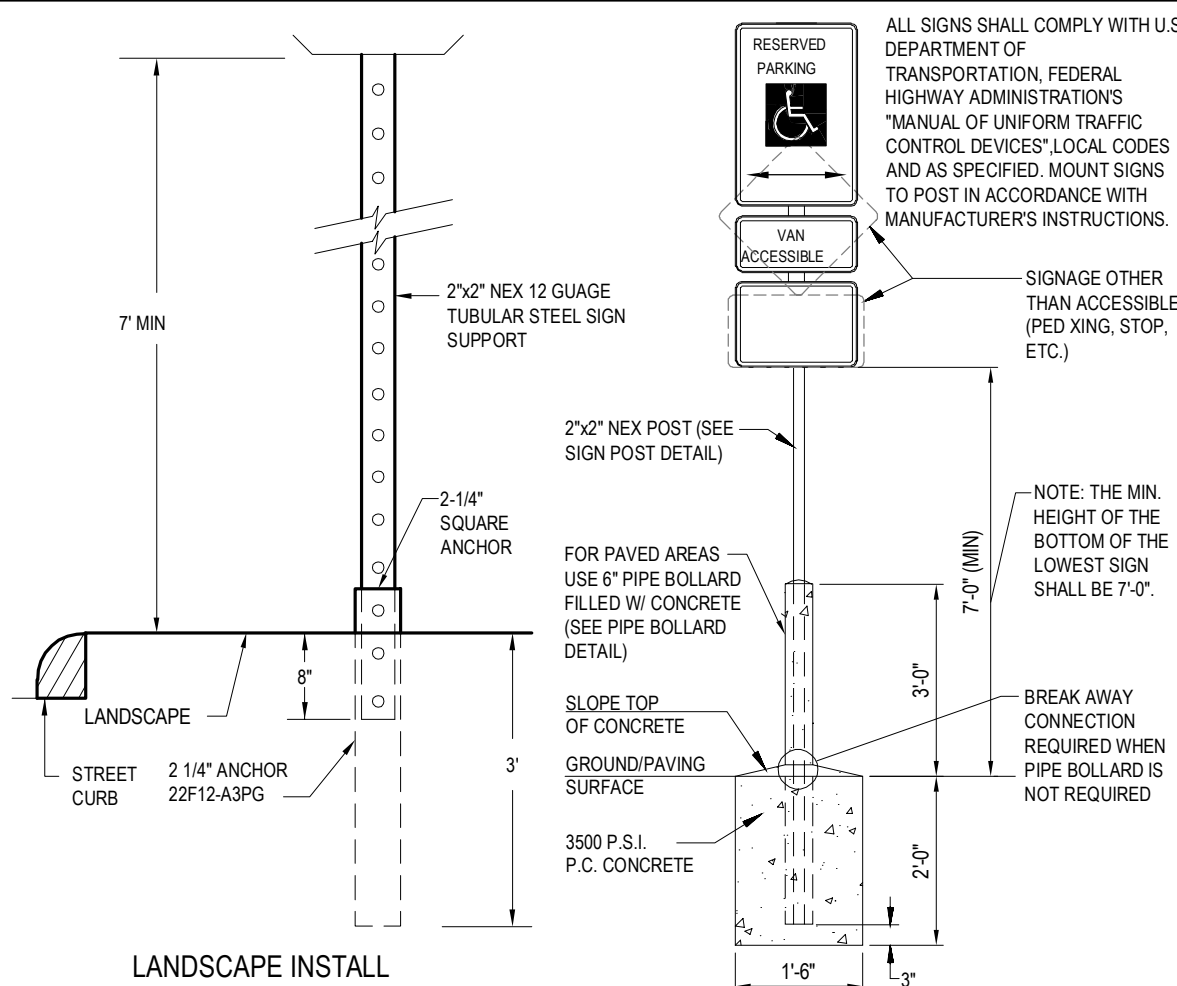


NOT TO SCALE


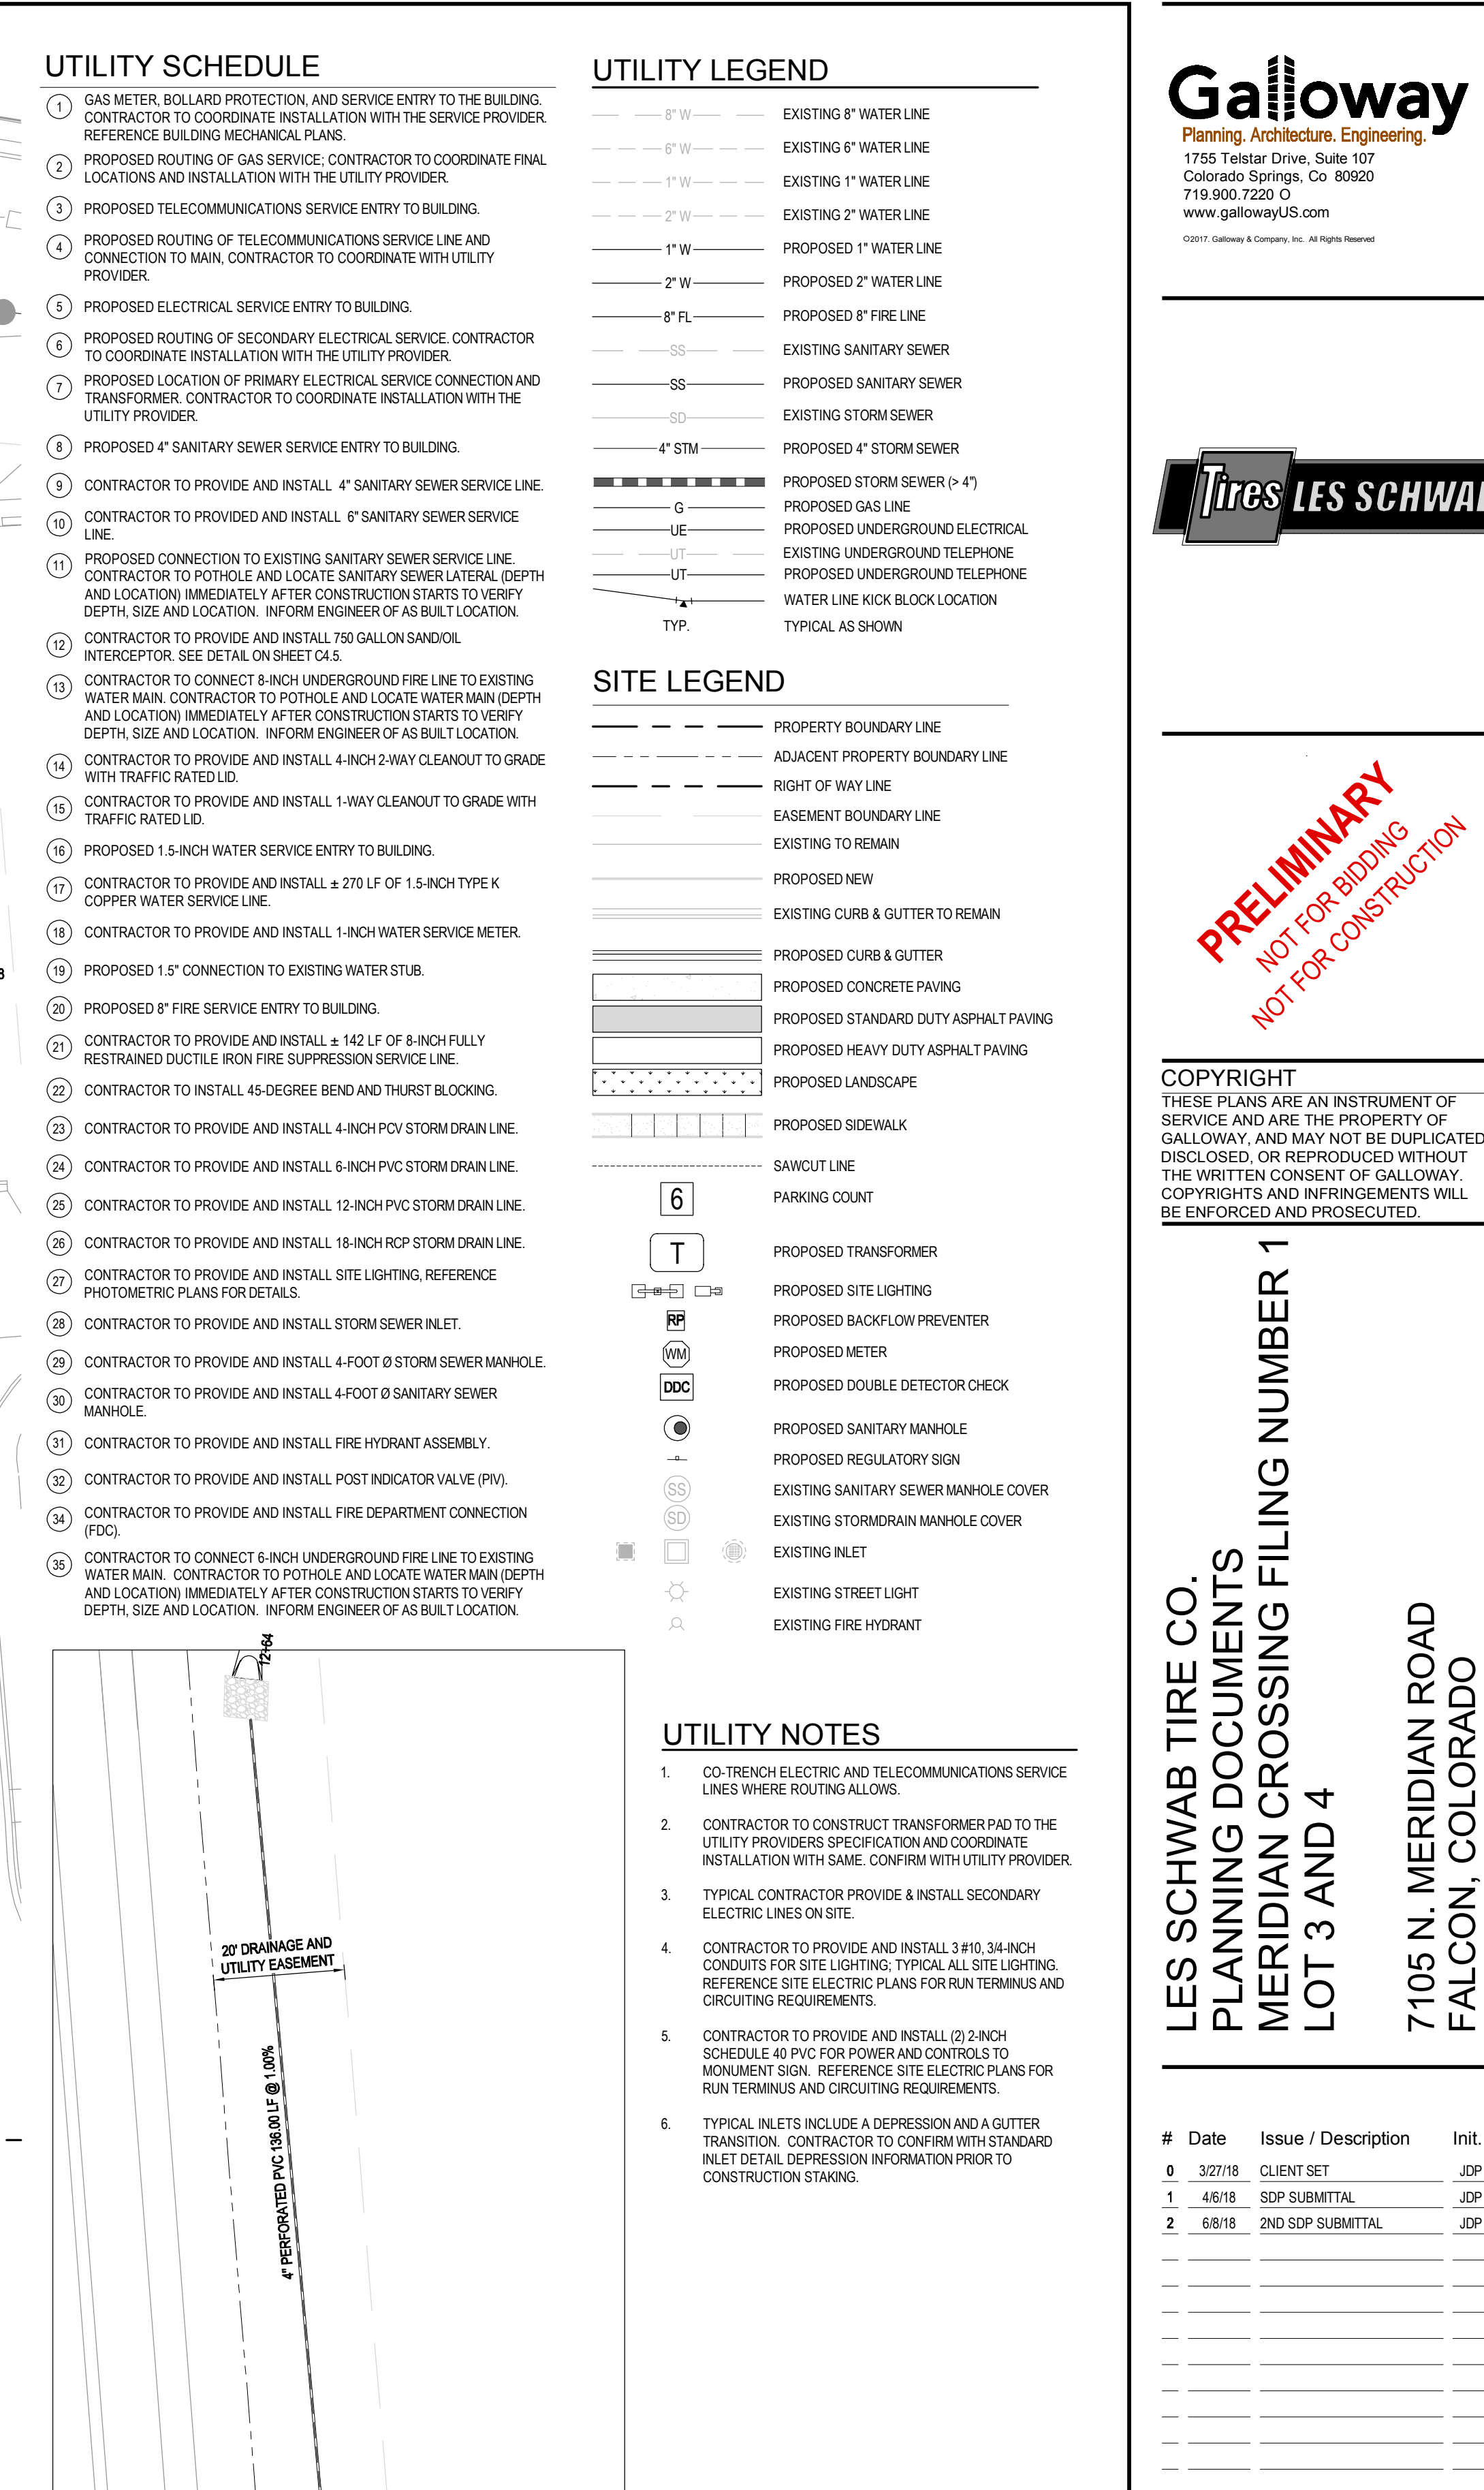


CAUTION - NOTICE TO CONTRACTOR

1. ALL UTILITY LOCATIONS SHOWN ARE BASED ON MAPS PROVIDED BY THE APPROPRIATE UTILITY COMPANY AND FIELD SURFACE EVIDENCE AT THE TIME OF SURVEY AND IS TO BE CONSIDERED AN APPROXIMATE LOCATION ONLY. IT IS THE CONTRACTOR'S RESPONSIBILITY TO FIELD VERIFY THE FIELD LOCATION OF ALL UTILITIES, PUBLIC OR PRIVATE, WHETHER SHOWN ON THE PLANS OR NOT, PRIOR TO CONSTRUCTION. REPORT ANY DISCREPANCIES TO THE ENGINEER PRIOR TO CONSTRUCTION.
2. WHERE A PROPOSED UTILITY CROSSES AN EXISTING UTILITY, IT IS THE CONTRACTOR'S RESPONSIBILITY TO FIELD VERIFY THE HORIZONTAL AND VERTICAL LOCATION OF SUCH EXISTING UTILITY, EITHER THROUGH POT-HOLING OR ALTERNATIVE METHOD. REPORT INFORMATION TO THE ENGINEER PRIOR TO CONSTRUCTION.



**Know what's below.
Call before you dig.**

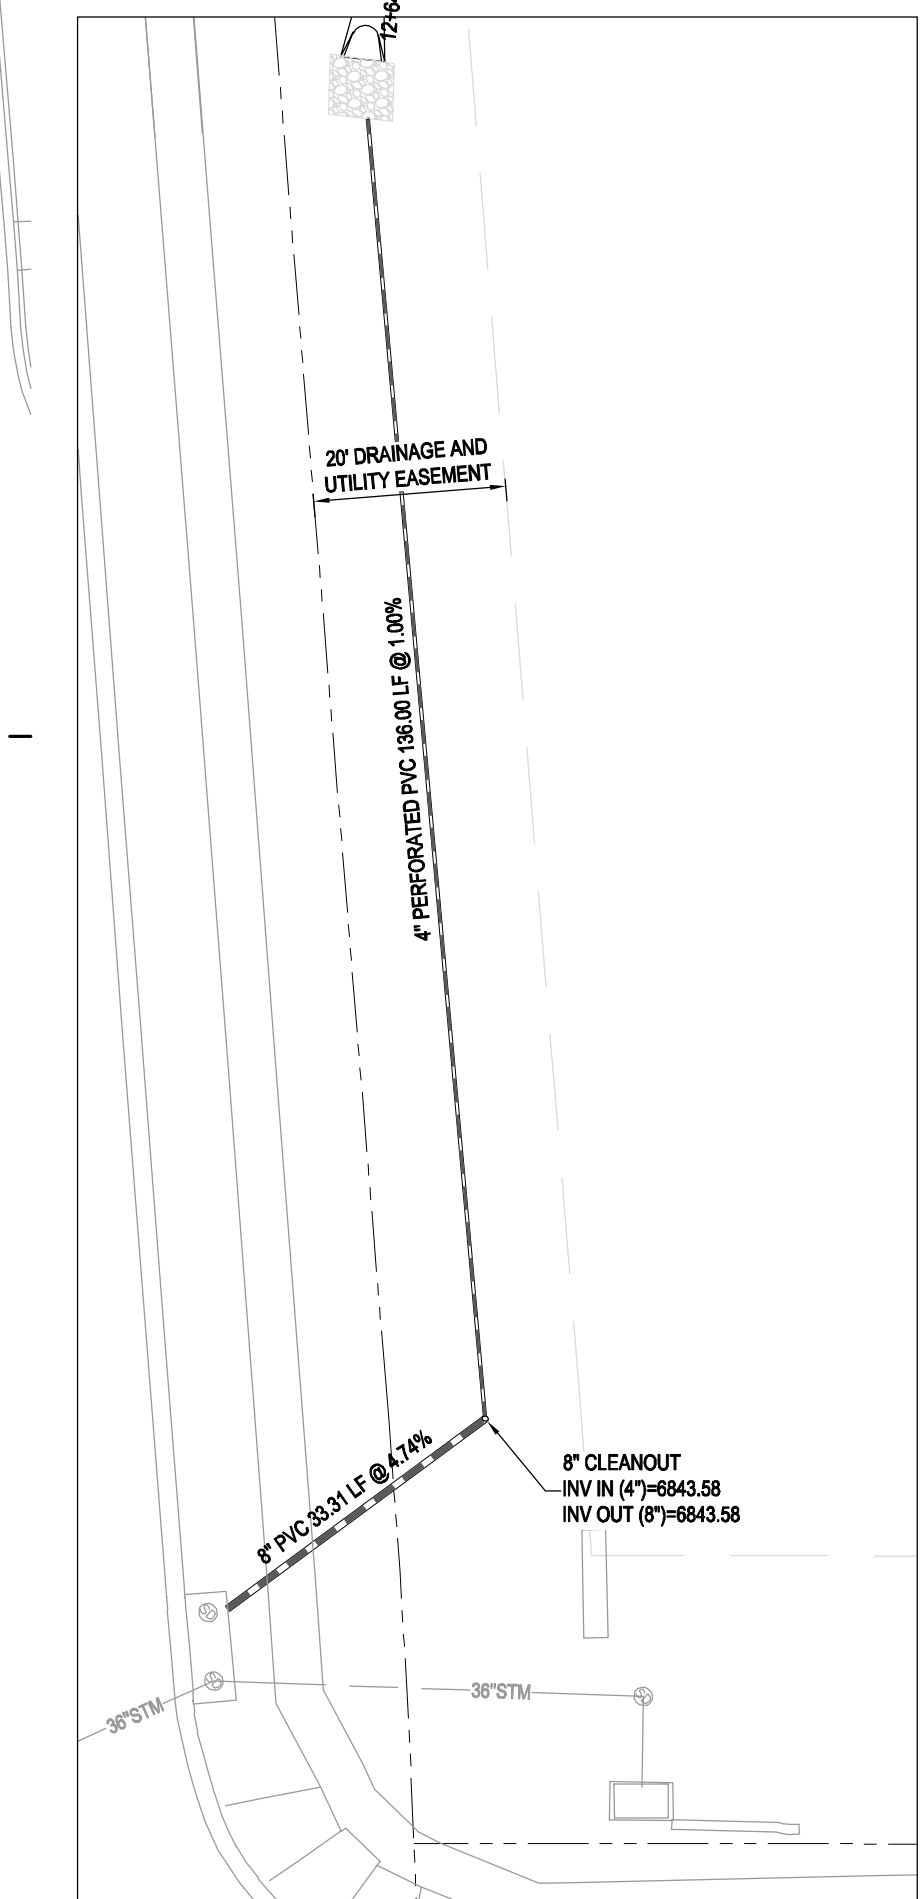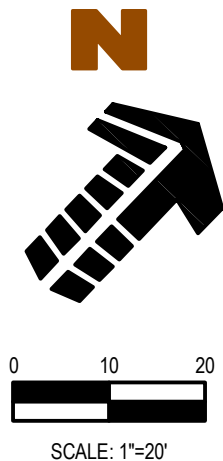



2. WHERE A PROPOSED UTILITY CROSSES AN EXISTING UTILITY, IT IS THE CONTRACTOR'S RESPONSIBILITY TO FIELD VERIFY THE HORIZONTAL AND VERTICAL LOCATION OF SUCH EXISTING UTILITY, EITHER THROUGH POT-HOLING OR ALTERNATIVE METHOD. REPORT INFORMATION TO THE ENGINEER PRIOR TO CONSTRUCTION.




GENERAL NOTES:

a SEE SPECIFICATIONS FOR ADDITIONAL REQUIREMENTS FOR LUMINAIRES, LAMPS, AND BALLASTS.

b CONTRACTOR TO VERIFY LIGHT FIXTURE CATALOG NUMBER AND INSTALLATION REQUIREMENTS PRIOR TO ORDERING.

c POLE TYPE DESCRIPTION (ABC): A - SHAPE, R-ROUND, S-SQUARE; B - PROFILE, S-STRAIGHT, T-TAPERED; C - MATERIAL, A-ALUMINUM, S-STEEL

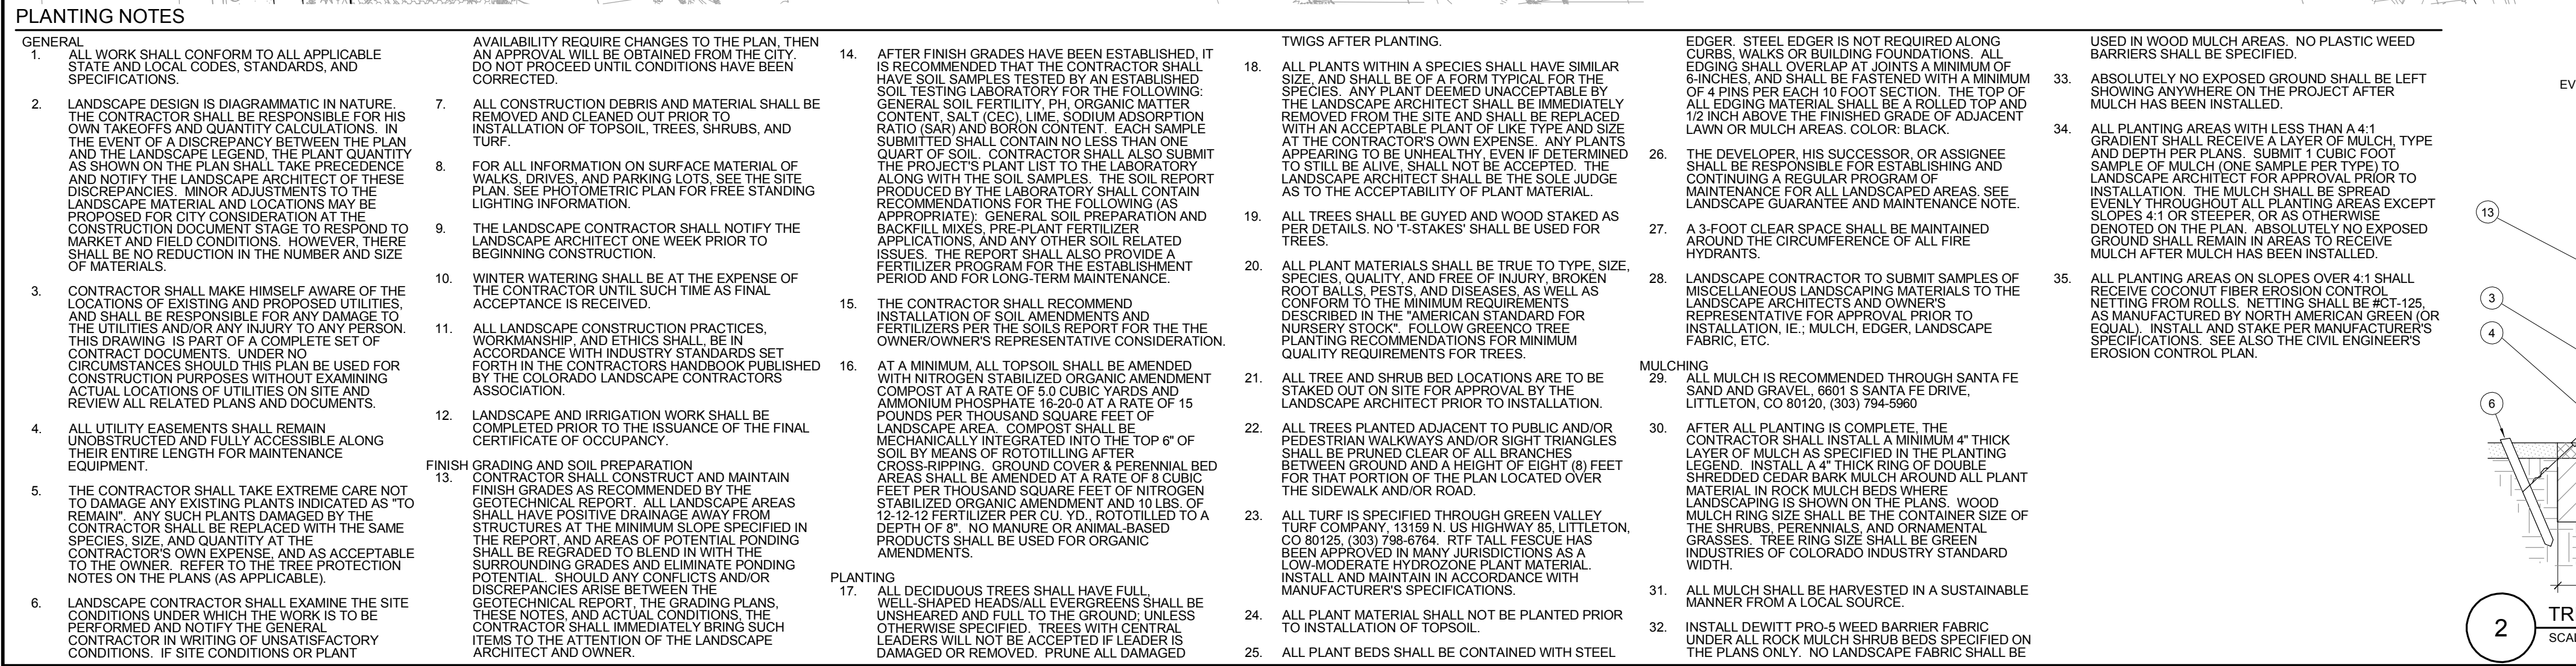

5% LANDSCAPE REQUIREMENT		
TOTAL SITE AREA: 108,187 SF	TOTAL LANDSCAPE AREA: 27,659 SF	% LANDSCAPE AREA: 25%

1. THE LANDSCAPE CONTRACTOR IS REQUIRED TO CONTACT THE COUNTY PUBLIC WORKS DEPARTMENT, AND ANY OTHER PUBLIC OR PRIVATE AGENCY NECESSARY FOR UTILITY LOCATION PRIOR TO ANY CONSTRUCTION.

2. THIS DRAWING IS A PART OF A COMPLETE SET OF BID DOCUMENTS, SPECIFICATIONS, ADDITIONAL DRAWINGS, AND EXHIBITS. UNDER NO CIRCUMSTANCES SHOULD THESE PLANS BE USED FOR CONSTRUCTION PURPOSES WITHOUT EXAMINING ACTUAL LOCATIONS OF UTILITIES ON SITE, AND REVIEWING ALL RELATED DOCUMENTS.



3. THE LOCATION OF THE ALL UNDERGROUND UTILITIES ARE LOCATED ON THE ENGINEERING DRAWINGS FOR THIS PROJECT. THE MOST CURRENT REVISION IS HEREIN MADE PART OF THIS DOCUMENT. UNDERGROUND UTILITIES EXIST THROUGHOUT THIS SITE AND MUST BE LOCATED PRIOR TO ANY CONSTRUCTION. THE CONTRACTOR SHALL BE RESPONSIBLE FOR VERIFYING THE LOCATION OF ALL UTILITIES. THE LANDSCAPE ARCHITECT IS NOT REPRESENTATIVE OF THE OWNER. NEITHER THE OWNER NOR THE LANDSCAPE ARCHITECT ASSUMES ANY RESPONSIBILITY WHATSOEVER, IN CONNECTION TO THE DESIGN OF ANY PLANT MATERIAL, AND UNDER NO CIRCUMSTANCES SHOULD THESE PLANS BE USED WITHOUT REFERENCING THE ABOVE MENTIONED DOCUMENTS.

1. AN AUTOMATIC IRRIGATION SYSTEM SHALL BE INSTALLED AND OPERATIONAL BY THE TIME OF FINAL INSPECTION. THE ENTIRE IRRIGATION SYSTEM SHALL BE INSTALLED BY A QUALIFIED IRRIGATION CONTRACTOR.
2. THE IRRIGATION SYSTEM SHALL TAKE OFF BUILDING'S POTABLE WATER SERVICE AFTER THE WATER METER, BEFORE BUILDING'S DOUBLE CHECK VALVE.
3. THE IRRIGATION SYSTEM WILL OPERATE ON POTABLE WATER, AND THE SYSTEM WILL HAVE APPROPRIATE BACKFLOW PREVENTION DEVICES INSTALLED TO PREVENT CONTAMINATION OF THE POTABLE SOURCE.
4. ALL NON-TURF/SEED PLANTED AREAS WILL BE DRIP IRRIGATED. TURF SOOSED SHALL RECEIVE POP-UP SPRAY IRRIGATION FOR HEAD TO HEAD COVERAGE.
5. ALL PLANTS SHOWING SIMILAR HYDROZONE CHARACTERISTICS SHALL BE PLACED ON A VALVE DEDICATED TO PROVIDE THE NECESSARY WATER REQUIREMENTS SPECIFIC TO THAT HYDROZONE.
6. THE IRRIGATION SYSTEM SHALL BE DESIGNED AND INSTALLED, TO THE MAXIMUM EXTENT POSSIBLE, TO CONSERVE WATER BY USING THE FOLLOWING DEVICES AND SYSTEMS: MATCHED IRRIGATION RATE TECHNOLOGY ON ROTOR AND SPRAY HEADS (WHEREVER POSSIBLE), RAIN SENSORS, AND WIND CONTROLLED IRRIGATION RATE CONTROLLERS FEATURING SENSORY INPUT CAPABILITY.

1. THE LANDSCAPE CONTRACTOR SHALL GUARANTEE ALL TREES, SHRUBS, PERENNIALS, SOIL, SEEDED AREAS, AND IRRIGATION SYSTEMS FOR A PERIOD OF ONE YEAR FROM THE DATE OF COMPLETION OF THE PROJECT. ANY DAMAGE TO OR DEATH OF ANY PLANT OR IRRIGATION SYSTEM AT HIS OWN EXPENSE, ANY PLANTS WHICH DIE IN THAT TIME OR REPAIR ANY PORTIONS OF THE IRRIGATION SYSTEM WHICH OPERATE IMPROPERLY.

2. THE LANDSCAPE CONTRACTOR SHALL MAINTAIN THE LANDSCAPE IN A NEAT, CLEAN, AND HEALTHY CONDITION FOR A PERIOD OF 90 DAYS. THIS SHALL INCLUDE PROPER PRUNING, MOWING AND AERATION OF LAWNS, WEEDING, REPLACEMENT OF MULCH, REMOVAL OF LITTER AND THE APPROPRIATE CARE OF ALL PLANTS. THE CONTRACTOR SHALL BE RESPONSIBLE FOR THE PROTECTION OF ALL EXISTING UTILITIES AND STRUCTURES. THE CONTRACTOR SHALL TAKE ALL PRECAUTIONS TO MAXIMIZE WATER CONSERVATION. IF SITE OPENS DURING WINTER, TO AVOID FREEZE DAMAGE ON PLANTINGS, THE 90 DAYS SHOULD BEGIN AFTER THE END OF THE MONTH OF FEBRUARY.

3. DURING THE LANDSCAPE MAINTENANCE PERIOD, THE LANDSCAPE CONTRACTOR SHALL MAINTAIN POSITIVE DRAINAGE AWAY FROM STRUCTURES IN ALL LANDSCAPE AREAS AT THE MINIMUM SLOPE SPECIFIED IN THE GEOTECHNICAL REPORT. LANDSCAPE AREAS WHICH SETTLE AND CREATE THE POTENTIAL FOR FLOODING OR FOR OTHER TYPES OF DAMAGE TO ADJACENT AREAS SHALL BE IMMEDIATELY REPAIRED. THE CONTRACTOR SHALL BE RESPONSIBLE FOR ANY CONFLICTS AND/OR DISCREPANCIES ARISE BETWEEN THE GEOTECHNICAL REPORT, THE GRADING PLANS, THESE NOTES, AND ACTUAL CONDITIONS. THE CONTRACTOR SHALL BE RESPONSIBLE FOR OBTAINING ALL NECESSARY PERMITS AND APPROVALS FROM THE CITY OF CHANDLER.

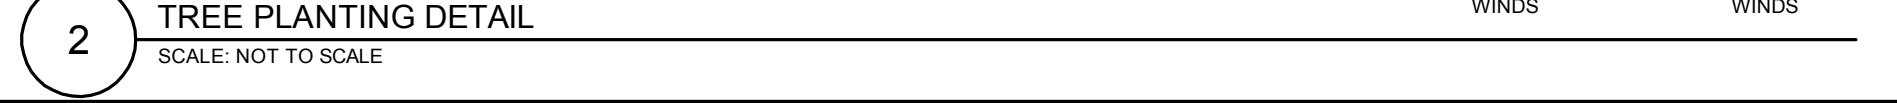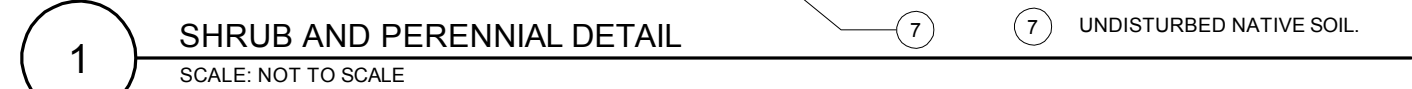


Markup Summary

Locked (4)




Subject: Group
Page Label: 3
Lock: Locked
Author: dsdseigny
Date: 7/12/2018 10:45:50 AM
Color: ■

all location where sidewalks cross a road will be required to provide ADA accessible pedestrian ramps.

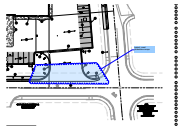

Subject: Group
Page Label: 3
Lock: Locked
Author: dsdseigny
Date: 7/12/2018 10:45:51 AM
Color: ■

typical, need pedestrian ramps

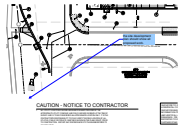

Subject: Engineer
Page Label: 3
Lock: Locked
Author: dsdseigny
Date: 7/12/2018 10:45:52 AM
Color: ■

the site development plan should show all proposed work.



Subject: Text Box
Page Label: 11
Lock: Locked
Author: dsdseigny
Date: 7/12/2018 10:45:53 AM
Color: ■

need to schedule a meeting to discuss the Landscaping. Now that property lines are established and per the Meridian Crossing Second Amendment to Meridian Crossing Maintenance Agreement and Declaration of Covenants, Conditions, and Restrictions, under (a) which includes landscaping that must be installed by Owners on their Lots, at their expense.