


1 SHRUB AND PERENNIAL DETAIL  
SCALE: NOT TO SCALE

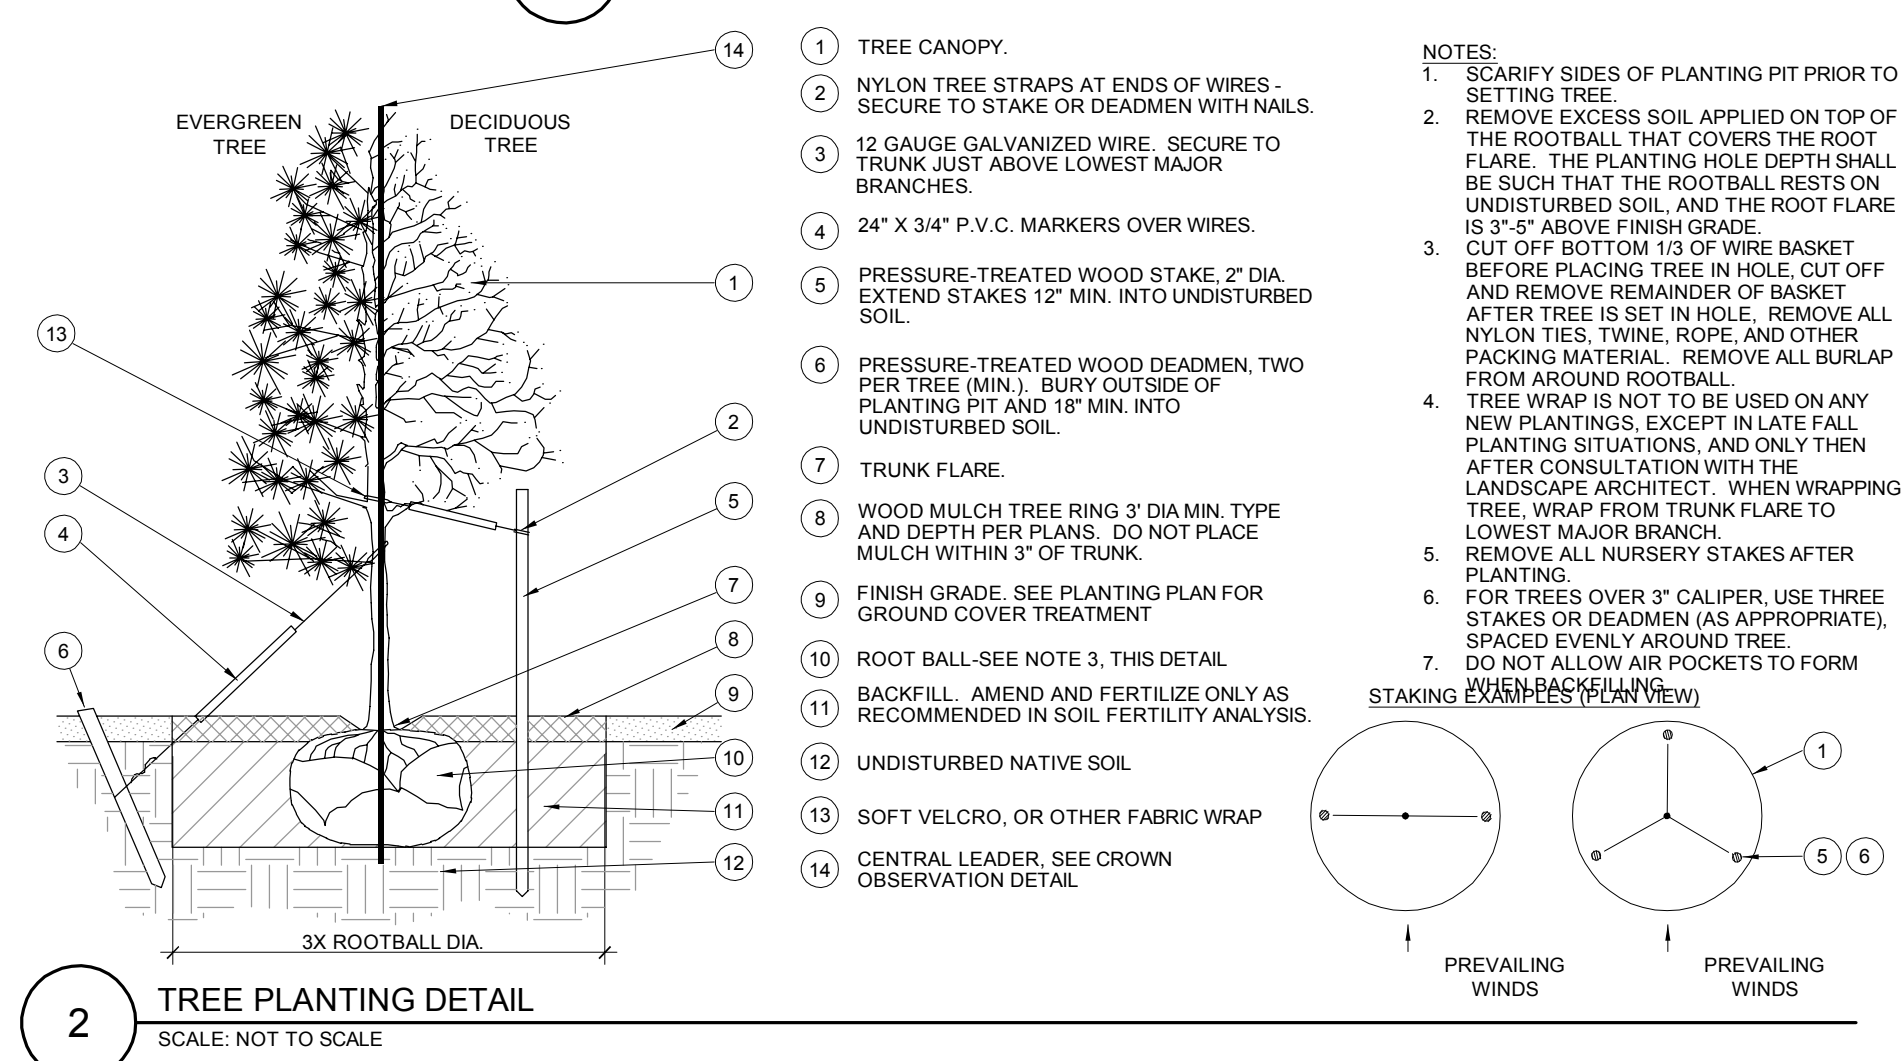

LES SCHWAB TIRE CO.  
PLANNING DOCUMENTS  
MERIDIAN CROSSING FILING NUMBER 1  
LOT 3 AND 4

7105 N. MERIDIAN ROAD  
FALCON, COLORADO

[illegible]


LANDSCAPE PLAN

## L1.1



# Markup Summary


based on previous remove this. (1)

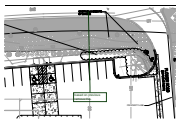

**Subject:** Callout  
**Page Label:** 1  
**Lock:** Locked  
**Author:** dsdsevigny  
**Date:** 9/6/2018 10:47:24 AM  
**Color:** ■

based on previous remove this.

Director will approve the Alternative Landscaping design once the "existing landscape by others" is removed based on earlier conv

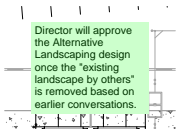

**Subject:** Text Box  
**Page Label:** 1  
**Lock:** Locked  
**Author:** dsdsevigny  
**Date:** 9/6/2018 10:47:24 AM  
**Color:** ■

Director will approve the Alternative Landscaping design once the "existing landscape by others" is removed based on earlier conversations.