

LES SCHWAB TIRE CENTER 7105 N. MERIDIAN ROAD FALCON, COLORADO 80831 SITE DEVELOPMENT PLAN

PROPERTY OWNER

PARK PLACE ENTERPRISES LLC 15 MIRANDA ROAD COLORADO SPRINGS, CO 80906

(541) 416-5238

ARCHITECT

ENTITLEMENT CONSULTANT

LANDSCAPE ARCHITECT

GALLOWAY & COMPANY 6162 S. WILLOW DRIVE, SUITE 320 GREENWOOD VILLAGE, CO 80111 TEL: (303) 770-8884 FAX: (303) 770-3636

ATTN: LYLE BISSEGGER, P.L.S. (SURVEY)

ATTN: AARON MCLEAN (ENTITLEMENTS) ATTN: KYLE J. MATTHEWS (ARCHITECT) ATTN: KERRI LILJEGREN, RLA (LANDSCAPE ARCHITECT) ATTN: JOE PARK, P.E. (CIVIL ENGINEERING)

DEVELOPER/APPLICANT

SFP-E P.O. BOX 5350 BEND, OR 97708 ATTN: GEORGE BUNTING

CIVIL ENGINEER / SURVEYOR GEOTECHNICAL ENGINEER

1070 W. 124TH AVENUE, SUITE 300 WESTMINSTER, CO 80234 TEL: (303) 996-2999 ATTN: GLENN D. OHLSEN, P.E.

PLANNING DEPARTMENT

EL PASO COUNTY-PLANNING 2880 INTERNATIONAL CIRCLE #110 COLORADO SPRINGS, CO 80910 TEL: (719) 520-6313 ATTN: NINA RUIZ

ENGINEERING DEPARTMENT

EL PASO COUNTY-ENGINEERING 2880 INTERNATIONAL CIRCLE COLORADO SPRINGS, CO 80910 TEL: (719) 520-6813 ATTN: ELIZABETH NIJKAMP

7030 OLD MERIDIAN ROAD FALCON, CO 80831 TEL: (719) 495-4050 ATTN: CHIEF TRENT HARWIG

UTILITY CONTACTS

•

FALCON, CO 80831 TEL: (800) 388-9881

WATER

FALCON HIGHLANDS METROPOLITAN DISTRICT 111 SOUTH TEJON STREET #705 COLORADO SPRINGS, CO 80903 TEL: (719) 635-0330 ATTN: CYNTHIA BEYER

SANITARY SEWER

WOODMAN HILLS METRO DISTRICT 8046 EASTON ROAD FALCON, CO 80831 TEL: (719) 495-2500 x111 ATTN: DANNY EVERETT

PICKERING, COLE & HIVNER

JURISDICTIONAL CONTACTS

BUILDING DEPARTMENT

PIKES PEAK REGIONAL BUILDING DEPARTMENT 2880 INTERNATIONAL CIRCLE COLORADO SPRINGS, CO 80910 TEL: (719) 327-2880

FIRE DEPARTMENT

FALCON FIRE DISTRICT

TELEPHONE CENTURYLINK TEL: (719) 633-2998 ATTN: JIM CONNELLY

GAS

COLORADO SPRINGS UTILITIES (719) 668-4462 ATTN: BEN SCHMITT

EAST WOODMEN ROAD VICINITY MAP

SITE MAP



FOR INFORMATION ONLY				
EARTHWORK SUMMARY TABLE				
CUT	FILL	EXPORT		
XXX CY	XXX CY	XXX CY		
PURPOSES ONLY RESPONSIBIL CONTRACTOR IS AND SHOULD NO SHOWN ON THES	Y AND ENGINE ITY FOR THEI RESPONSIBL IT RELY ON CI E CONSTRUC	DR PERMITTING EER ASSUMES NO R ACCURACY. E FOR TAKE-OFFS UT/FILL NUMBERS TION DOCUMENTS NO CLAIM WILL BE		

SHEET LIST TABLE

DEMO PLAN

SITE PLAN

SITE DETAILS

SITE DETAILS

GRADING PLAN

UTILITY PLAN

UTILITY DETAILS

LANDSCAPE PLAN

PHOTOMETRICS PLAN

PHOTOMETRICS DETAILS

EROSION CONTROL PLAN

EROSION CONTROL DETAILS

SHEET NUMBER | SHEET TITLE

C1.0

C1.5

C1.6

C2.0

NOTE: CONTRACTOR IS RESPONSIBLE FOR CALCULATING AND VERIFYING ALL QUANTITIES PROVIDED ON PLANS PRIOR TO BIDDING AND CONSTRUCTION.

NOTE: CONTRACTOR RESPONSIBLE FOR AS-BUILT DRAWINGS, TESTS, REPORTS AND/OR ANY OTHER CERTIFICATES OR INFORMATION AS REQUIRED FOR ACCEPTANCE OF WORK FROM CITY, UTILITY DISTRICTS OR ANY OTHER GOVERNING AGENCY.

CONSIDERED IF THE CONTRACTOR RELIES ON THIS

INFORMATION FOR BIDDING OR FOR CONSTRUCTION

SURVEYOR TO OBTAIN AUTOCAD FILE FROM ENGINEER AND VERIFY ALL HORIZONTAL CONTROL DIMENSIONING PRIOR TO CONSTRUCTION STAKING. SURVEYOR MUST VERIFY ALL BENCHMARK, BASIS OF BEARING AND DATUM INFORMATION TO ENSURE IMPROVEMENTS WILL BE AT THE SAME HORIZONTAL AND VERTICAL LOCATIONS SHOWN ON THE DESIGN CONSTRUCTION DRAWINGS. PRIOR TO CONSTRUCTION STAKING ANY DISCREPANCY MUST BE REPORTED TO OWNER AND ENGINEER PRIOR TO CONTINUATION OF ANY FURTHER STAKING OR CONSTRUCTION WORK

GENERAL CONSTRUCTION NOTES

- ALL CONSTRUCTION AND MATERIALS SHALL BE IN ACCORDANCE WITH THE LATEST EDITION OF THE CITY OF FALCON STANDARD CONSTRUCTION SPECIFICATIONS, IMPROVEMENT STANDARDS AND STANDARD DRAWINGS.
- 2. THE CONTRACTOR SHALL NOT BEGIN ANY WORK SHOWN ON THESE PLANS UNTIL THE CITY ENGINEER'S SIGNATURE OF APPROVAL IS AFFIXED HEREON AND ALL APPLICABLE PERMITS HAVE BEEN OBTAINED.
- CONTRACTOR SHALL ASSUME SOLE AND COMPLETE RESPONSIBILITY FOR CONSTRUCTION OF THIS PROJECT, INCLUDING SAFETY OF ALL PERSONS AND PROPERTY. THIS REQUIREMENT SHALL APPLY CONTINUOUSLY AND NOT BE LIMITED TO NORMAL WORKING HOURS. THE CONTRACTOR SHALL DEFEND, INDEMNIFY AND HOLD THE CITY, OWNER AND THE ENGINEER HARMLESS FROM AN AND ALL LIABILITY ARISING FROM THE SOLE NEGLIGENCE OF THE CITY, OWNER OR ENGINEER.
- THE LOCATIONS OF ALL UNDERGROUND FACILITIES SHOWN ON THIS PLAN ARE APPROXIMATE. A REASONABLE EFFORT HAS BEEN MADE TO LOCATE AND DELINEATE ALL UNDERGROUND FACILITIES HOWEVER, THE ENGINEER ASSUMES NO LIABILITY FOR THE ACCURACY OR COMPLETENESS OF THE EXISTING FACILITIES SHOWN HEREON OR FOR THE EXISTENCE OF OTHER UNDERGROUND UTILITIES OR OBJECTS WHICH THE CONTRACTOR MAY DISCOVER, BUT ARE NOT SHOWN ON THESE PLANS. THE CONTRACTOR SHALL VERIFY THE LOCATION OF ALL EXISTING FACILITIES AND IMMEDIATELY NOTIFY THE ENGINEER IF ANY SUCH FACILITIES INTERFERE WITH THE CONSTRUCTION OF THE IMPROVEMENTS. THE CONTRACTOR SHALL STOP WORK UNTIL MITIGATIONS CAN BE MADE. ANY COSTS INCURRED RESULTING FROM CONTRACTOR'S FAILURE TO STOP AS DIRECTED SHALL BE THE RESPONSIBILITY OF THE CONTRACTOR.
- 5. ALL MATERIALS, METHODS, AND WORKMANSHIP SHALL CONFORM TO THE SPECIFICATION OF THE AGENCIES INVOLVED AND ALL WORK IS SUBJECT THE APPROVAL OF THEIR DIRECTOR OR AUTHORIZED REPRESENTATIVE.
- 6. THE CONTRACTOR SHALL NOTIFY THE CITY OF FALCON'S PUBLIC SERVICES INSPECTORS MON.-FRI. 8:00 A.M. TO 4:00 P.M. AT (XXX) XXX-XXXX FOR A PRECONSTRUCTION MEETING 48 HOURS IN ADVANCE OF STARTING ANY CONSTRUCTION ACTIVITIES. TRI VIEW WATER AGENCY AND PIKES PEAK UTILITY DISTRICT REQUIRE AT LEAST 48-HOURS PRIOR TO ANY CONSTRUCTION REQUESTS FOR INSPECTION OF PUBLIC FACILITIES. THEREFORE. NOTICE SHALL BE GIVEN 48-HOURS IN ADVANCE AND BE PERFORMED BY THE AGENCY'S DESIGNATED AGENT.
- 7. THE CONTRACTOR SHALL OBTAIN ALL NECESSARY ENCROACHMENT PERMITS AND SHALL POSSESS APPROVED PLANS PRIOR TO BEGINNING OF CONSTRUCTION. A SET OF SIGNED AND APPROVED PLANS ARE TO BE ON THE JOB SITE AT ALL TIMES.
- 8. THE CONTRACTOR SHALL MAINTAIN THE EXISTING PUBLIC AND PRIVATE IMPROVEMENT WITHIN THE WORK AREA AND SHELL ADEQUATELY BARRICADE THE PROJECT SITE TO KEEP THE GENERAL PUBLIC FROM THE SITE. ANY IMPROVEMENTS DAMAGED DURING CONSTRUCTION SHALL BE REPLACED BY CONTRACTOR.
- 9. THE CONTRACTOR MUST EXPOSE THE END OF EXISTING GRAVITY LINES FOR THE SURVEYOR TO VERIFY LOCATION AND DEPTH OF FACILITIES PRIOR TO CONNECTION OF PROPOSED UTILITY. THE CONTRACTOR SHALL INCUR ALL COSTS FOR SUCH EXCAVATION.
- 10. THE CONTRACTOR SHALL AT ALL TIMES COORDINATE HIS WORK WITH THAT OF OTHERS ON THE SITE. THE CONTRACTOR SHALL HAVE A RESPONSIBLE PARTY, WHO SHALL HAVE THE AUTHORITY TO REPRESENT AND ACT FOR THE CONTRACTOR ON THE JOB SITE DURING ALL WORKING HOURS.
- 11. CONTRACTOR MUST NOTIFY "COLORADO 811" AT 811 (PHONE 800-922-1987) OR THROUGH THE WEBSITE AT HTTP://COLORADO811.ORG 48 HOURS IN ADVANCE BEFORE ANY
- 12. CONTRACTOR SHALL BE RESPONSIBLE FOR THE PROTECTION OF ALL EXISTING MONUMENTS AND/OR OTHER SURVEY MONUMENTS AND SHALL NOTIFY CITY OF FALCON OF PUBLIC SERVICES OF ANY DAMAGED OR REMOVED CITY, STATE, OR BUREAU MONUMENTS. CONTRACTOR SHALL BE RESPONSIBLE TO RESTORE ANY DAMAGED OR REMOVED MONUMENTS.
- 13. CONTRACTOR SHALL NOTIFY DEPARTMENT OF PUBLIC SERVICES UPON APPLICATION FOR PERMIT AND PAYMENT OF REQUIRED FEE.
- 14. THE CONTRACTOR SHALL VERIFY ALL STREETS NAMES AND THEIR CORRECT SPELLING WITH THE FIRE DEPARTMENT AND BUILDING DIVISION BEFORE ORDERING STREET SIGNS.
- 15. CONTRACTOR SHALL BE RESPONSIBLE FOR CONDUCTING HIS OPERATION ENTIRELY OUTSIDE OF ANY FLOODPLAIN BOUNDARIES. FLOODPLAIN BOUNDARIES SHALL BE CLEARLY DELINEATED IN THE FIELD WITH ORANGE ESA FENCING AND SIX FOOT (6') STAKES TEN FEET (10') OC PRIOR TO
- 16. CONTRACTOR SHALL BE RESPONSIBLE FOR CONDUCTING HIS OPERATION ENTIRELY WITHIN THE "LIMITS OF WORK." THESE AREAS SHALL BE CLEARLY DELINEATED IN THE FIELD PRIOR TO
- 17. WHERE WORK IS BEING DONE IN AN OFFSITE EASEMENT THE CONTRACTOR SHALL NOTIFY THE PROPERTY OWNER 48 HOURS PRIOR TO COMMENCING WORK.


The following note should be added to all site development plans or non-residential site plans, as applicable, prior to PCD approval:

The parties responsible for this plan have familiarized themselves with all current accessibility criteria and specifications and the proposed plan reflects all site elements required by the applicable ADA design standards and guidelines as published by the United States Department of Justice. Approval of this plan by El Paso County does not assure compliance with the ADA or any regulations or guidelines enacted or promulgated under or with respect to such laws.

A separate ADA route sheet needs to be included in the submittal application

Colorado Springs, Co 80920 719.900.7220 O www.gallowayUS.com



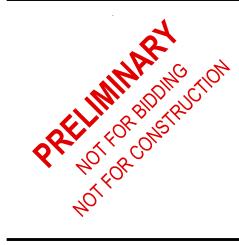


COPYRIGHT THESE PLANS ARE AN INSTRUMENT OF SERVICE AND ARE THE PROPERTY OF GALLOWAY, AND MAY NOT BE DUPLICATED, DISCLOSED, OR REPRODUCED WITHOUT THE WRITTEN CONSENT OF GALLOWAY. COPYRIGHTS AND INFRINGEMENTS WILL BE ENFORCED AND PROSECUTED.

Date Issue / Description Init. **0** 3/27/18 CLIENT SET 1 4/6/18 SDP SET

Checked By 4/6/2018

COVER

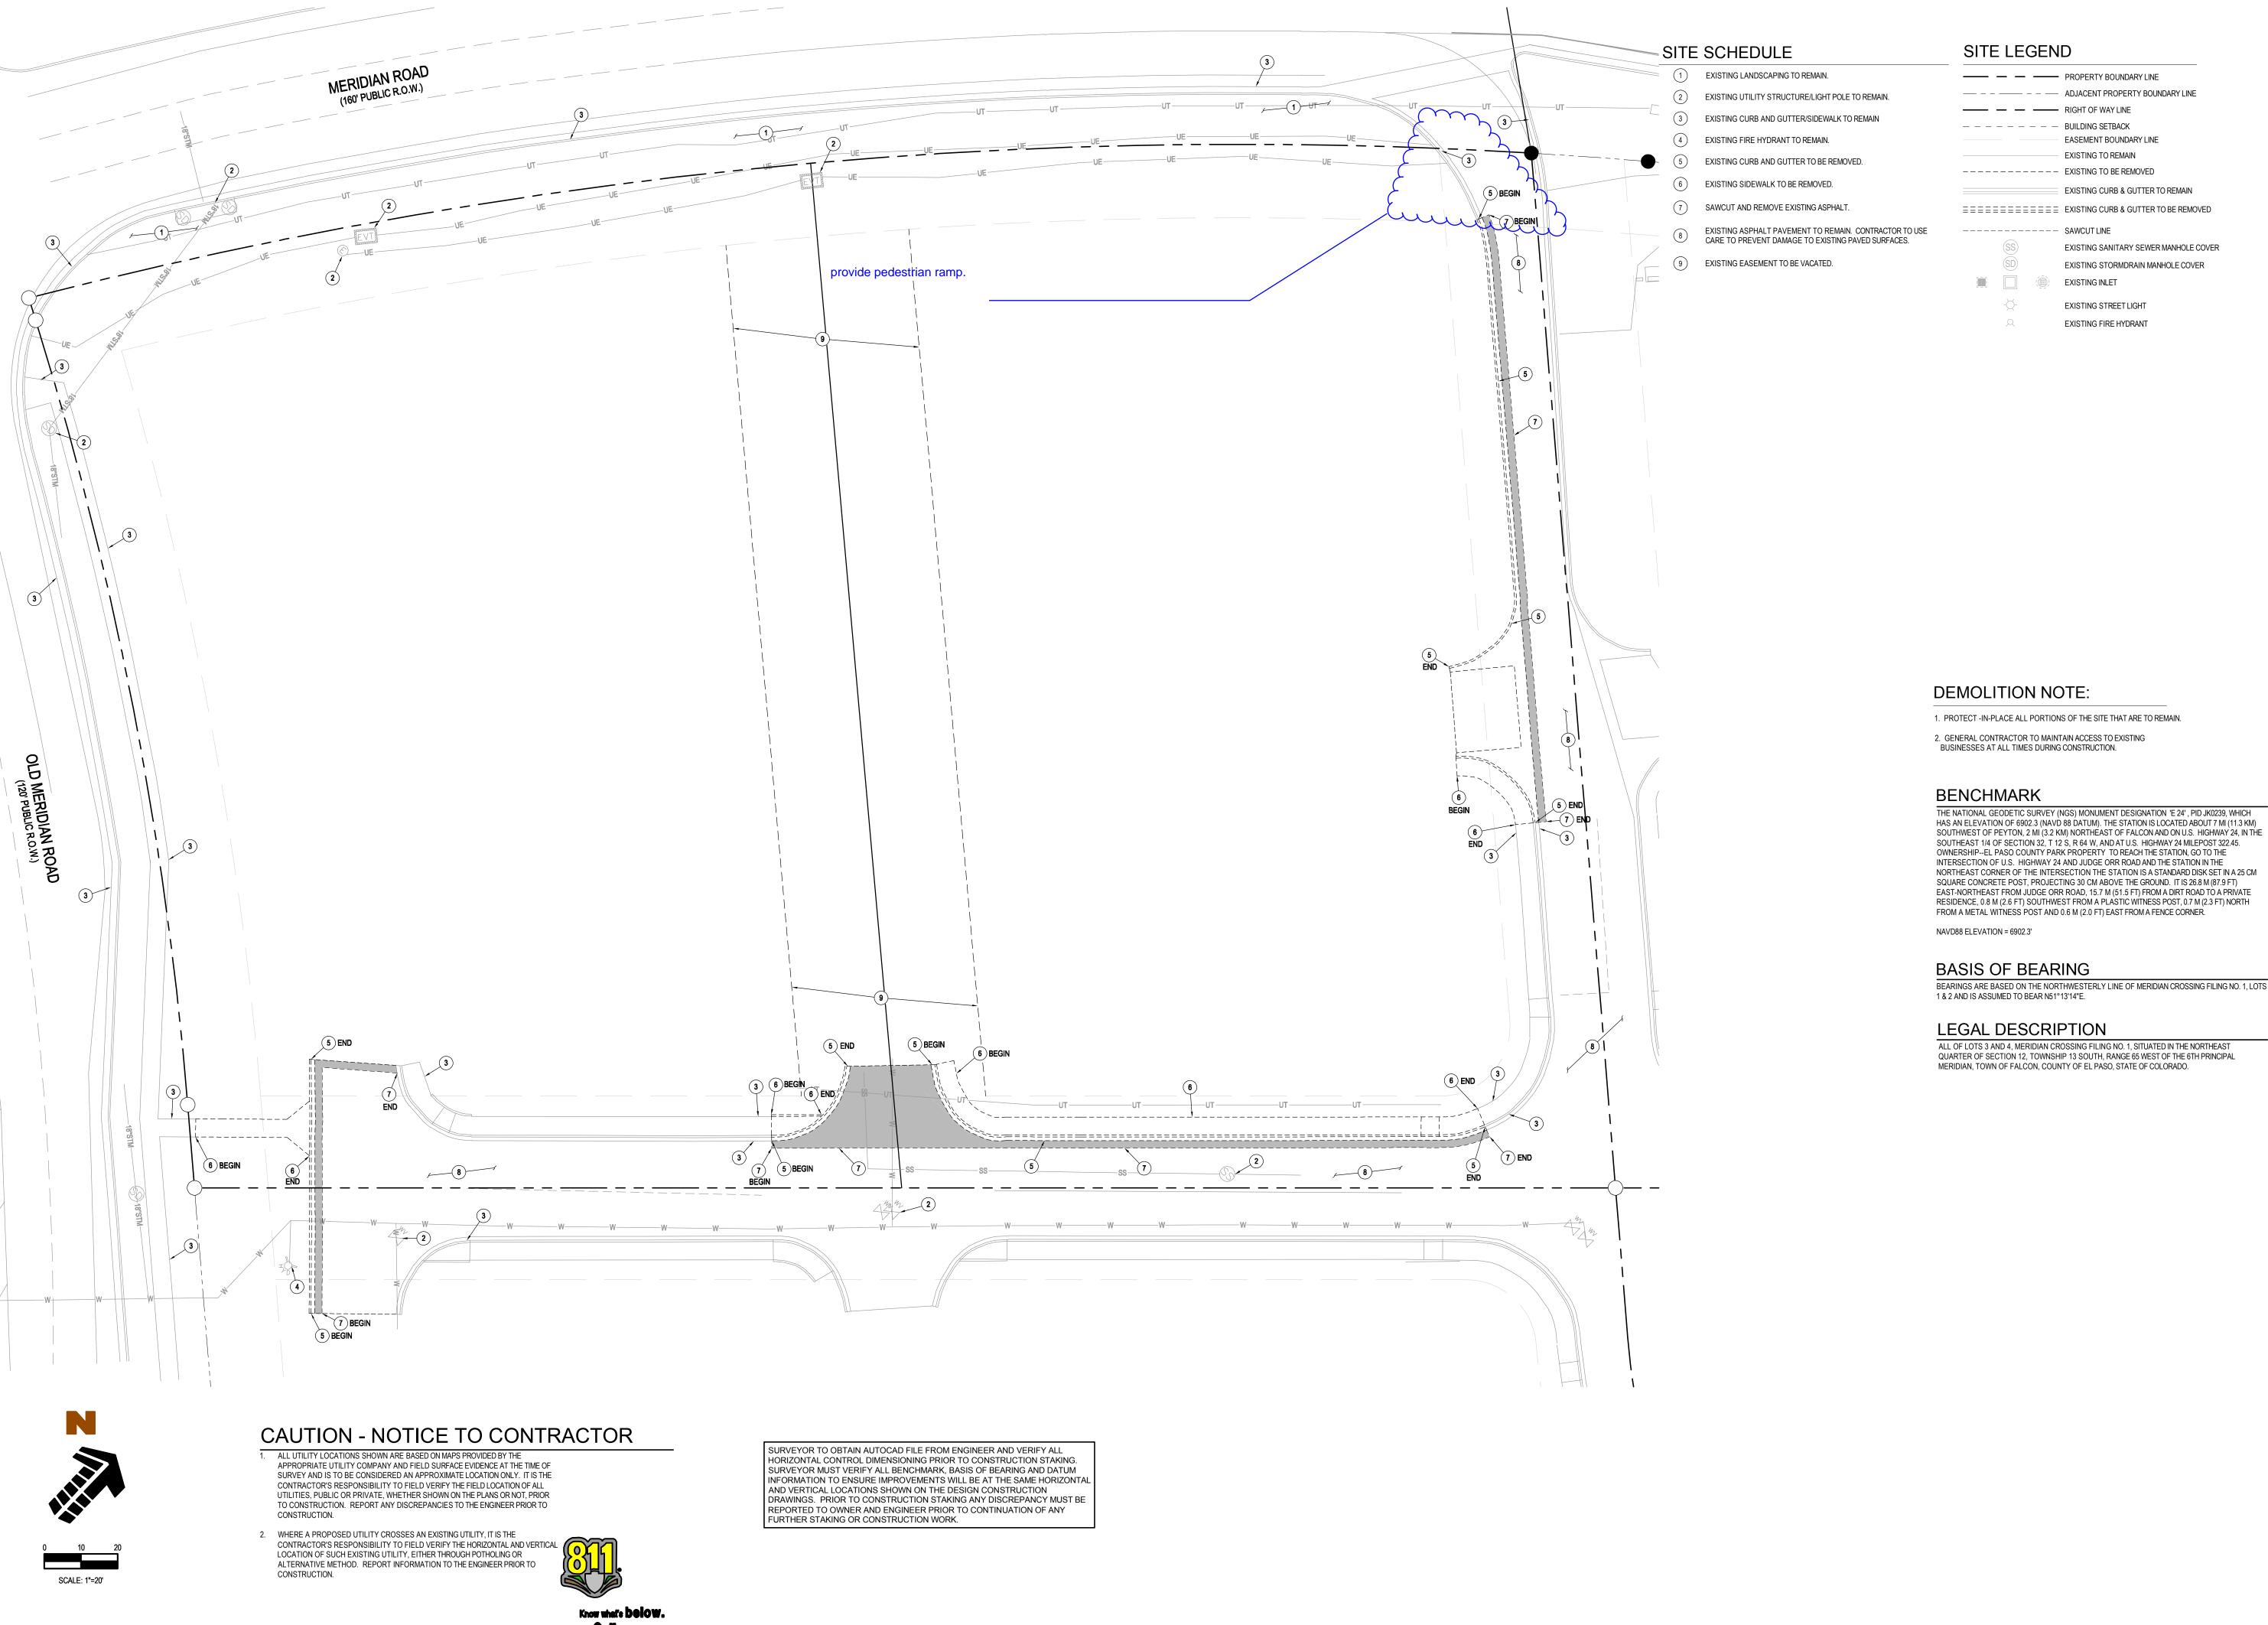

1755 Telstar Drive, Suite 107 Colorado Springs, Co 80920 719.900.7220 O www.gallowayUS.com O2017. Galloway & Company, Inc. All Rights Reserved



COPYRIGHT THESE PLANS ARE AN INSTRUMENT OF SERVICE AND ARE THE PROPERTY OF GALLOWAY, AND MAY NOT BE DUPLICATED, DISCLOSED, OR REPRODUCED WITHOUT THE WRITTEN CONSENT OF GALLOWAY. COPYRIGHTS AND INFRINGEMENTS WILL


BE ENFORCED AND PROSECUTED.

Date Issue / Description Init. **0** 3/27/18 CLIENT SET 1 4/6/18 SDP SET

Checked By:

4/6/2018

DEMO PLAN

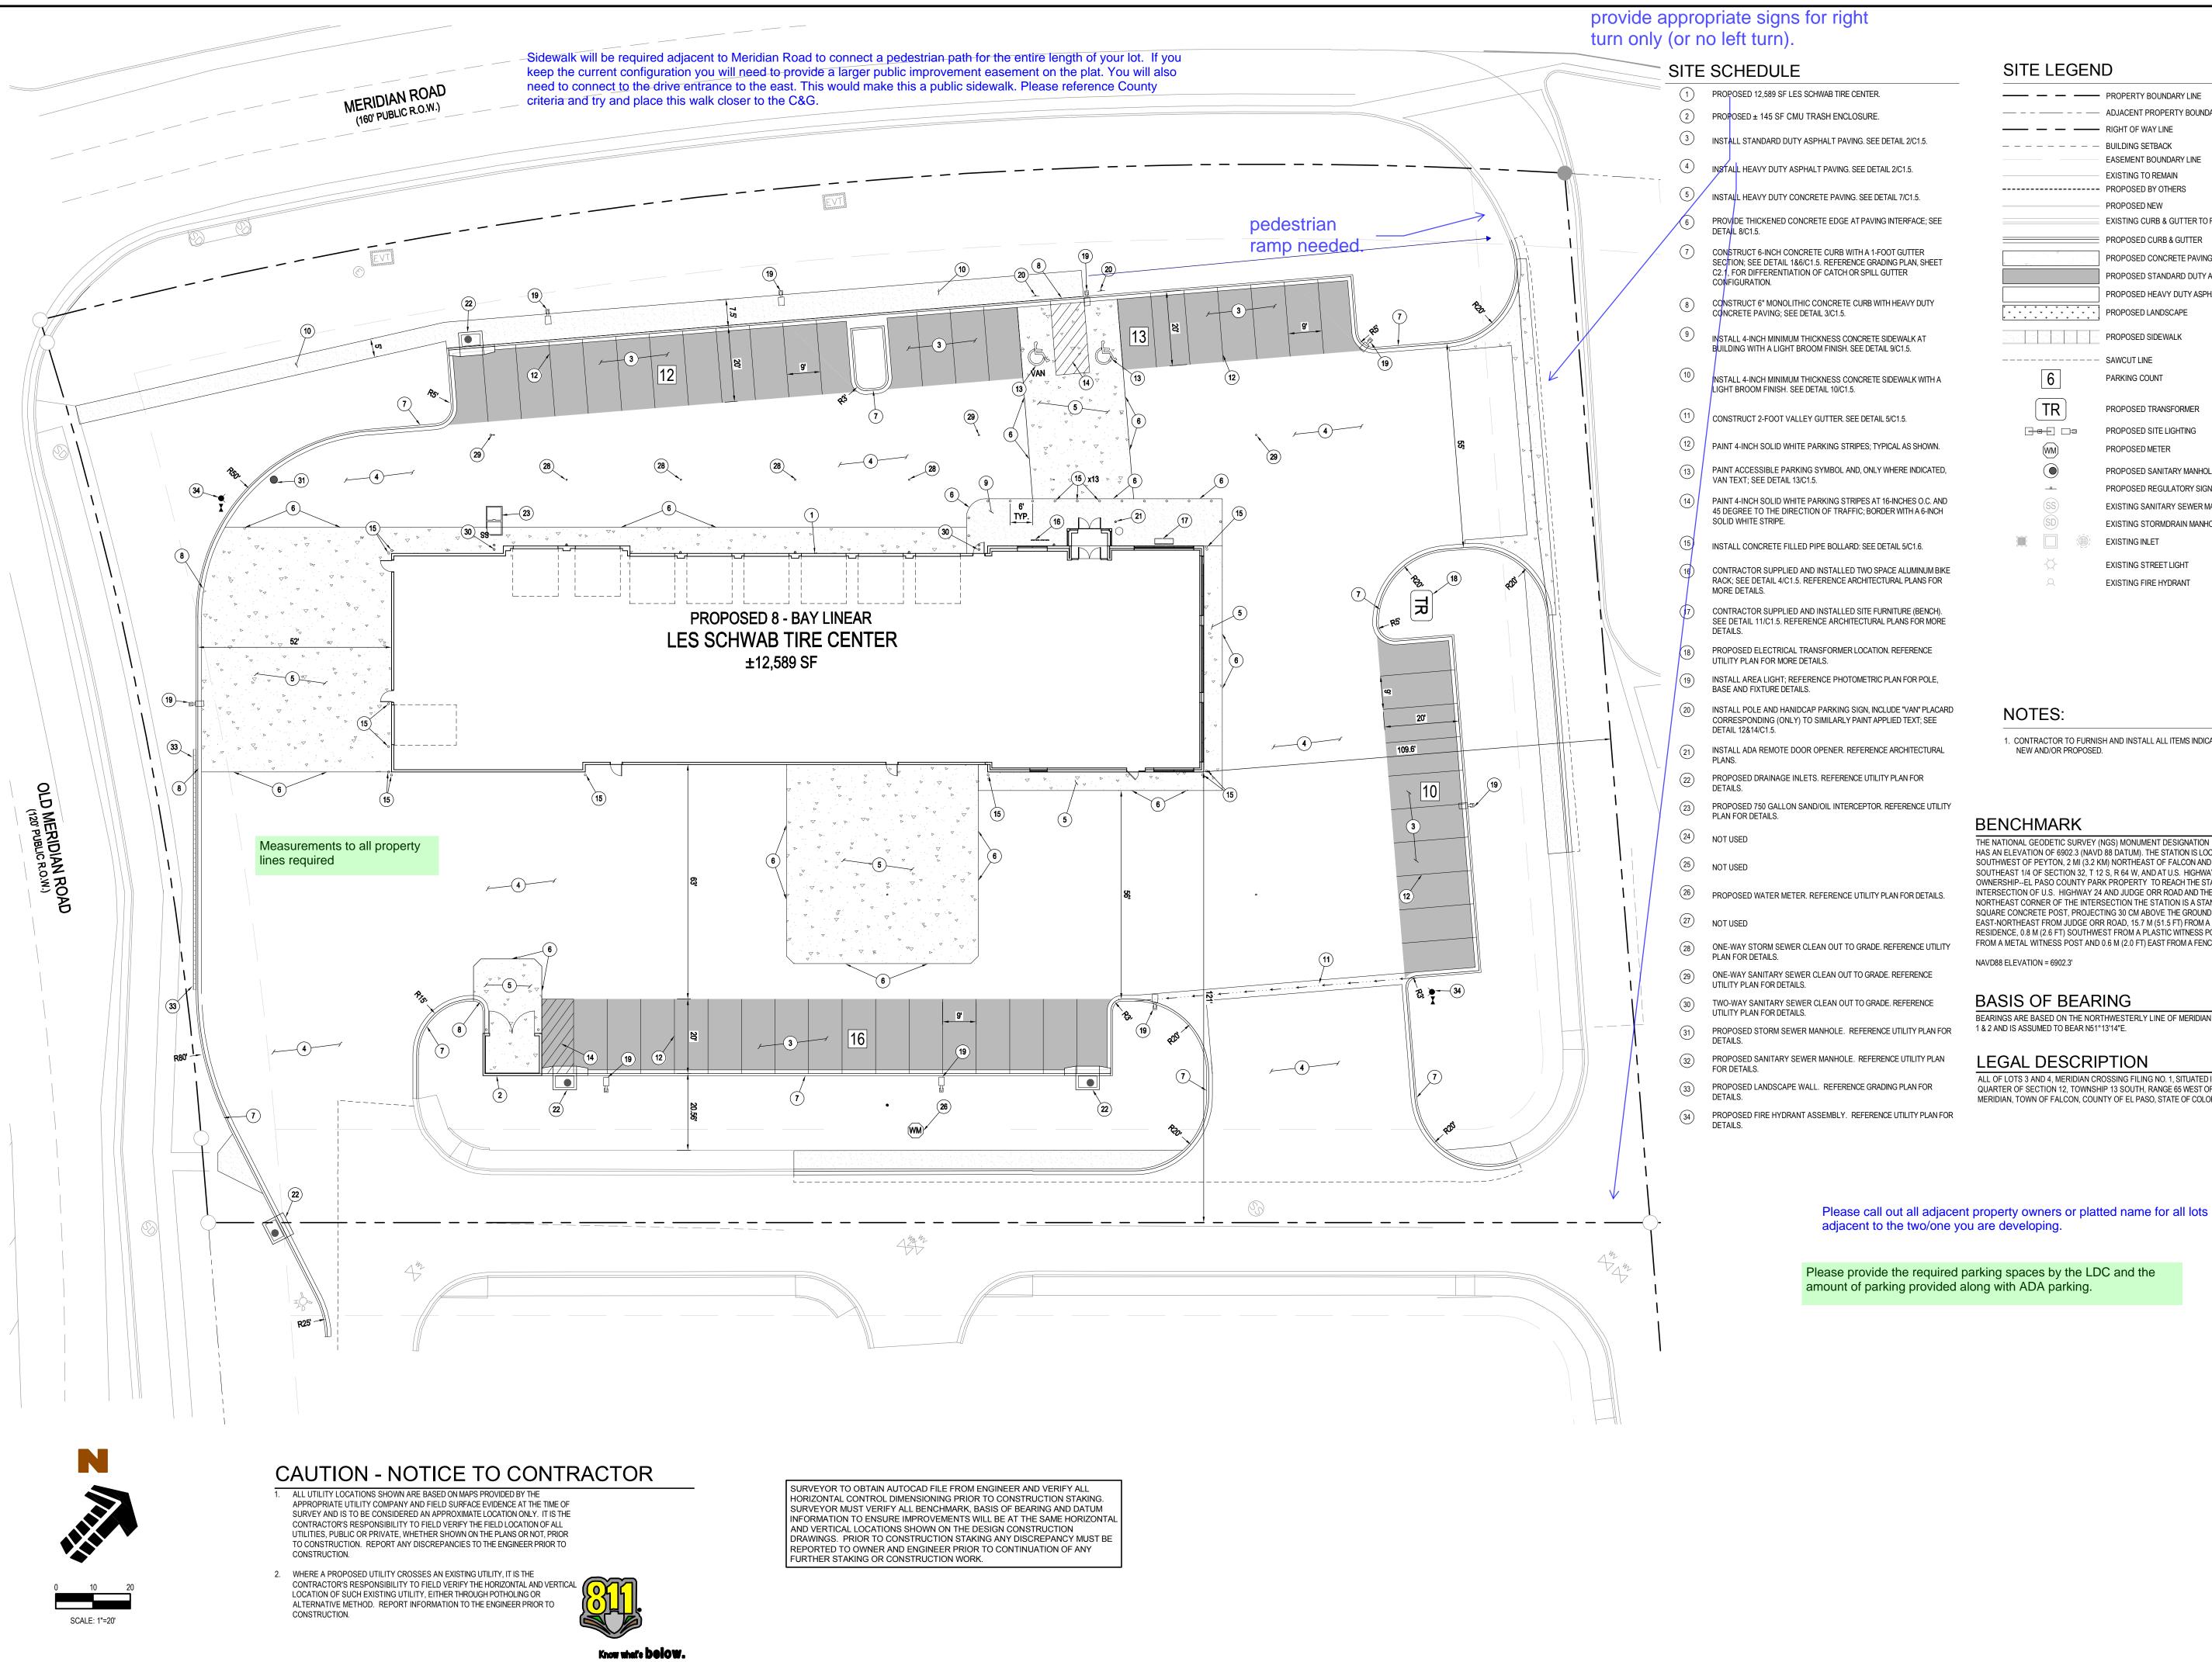

- 1 PROPOSED 12,589 SF LES SCHWAB TIRE CENTER.
- INSTALL STANDARD DUTY ASPHALT PAVING. SEE DETAIL 2/C1.5.
- INSTALL HEAVY DUTY ASPHALT PAVING. SEE DETAIL 2/C1.5.
- INSTALL HEAVY DUTY CONCRETE PAVING. SEE DETAIL 7/C1.5.
- PROVIDE THICKENED CONCRETE EDGE AT PAVING INTERFACE; SEE
- CONSTRUCT 6-INCH CONCRETE CURB WITH A 1-FOOT GUTTER SECTION; SEE DETAIL 1&6/C1.5. REFERENCE GRADING PLAN, SHEET C2.1, FOR DIFFERENTIATION OF CATCH OR SPILL GUTTER
- CONSTRUCT 6" MONOLITHIC CONCRETE CURB WITH HEAVY DUTY CONCRETE PAVING; SEE DETAIL 3/C1.5.
- INSTALL 4-INCH MINIMUM THICKNESS CONCRETE SIDEWALK AT BUILDING WITH A LIGHT BROOM FINISH. SEE DETAIL 9/C1.5.
- NSTALL 4-INCH MINIMUM THICKNESS CONCRETE SIDEWALK WITH A
- CONSTRUCT 2-FOOT VALLEY GUTTER. SEE DETAIL 5/C1.5.
- PAINT 4-INCH SOLID WHITE PARKING STRIPES; TYPICAL AS SHOWN.
- PAINT ACCESSIBLE PARKING SYMBOL AND, ONLY WHERE INDICATED,
- PAINT 4-INCH SOLID WHITE PARKING STRIPES AT 16-INCHES O.C. AND 45 DEGREE TO THE DIRECTION OF TRAFFIC; BORDER WITH A 6-INCH
- INSTALL CONCRETE FILLED PIPE BOLLARD: SEE DETAIL 5/C1.6.
- CONTRACTOR SUPPLIED AND INSTALLED TWO SPACE ALUMINUM BIKE RACK; SEE DETAIL 4/C1.5. REFERENCE ARCHITECTURAL PLANS FOR
- CONTRACTOR SUPPLIED AND INSTALLED SITE FURNITURE (BENCH). SEE DETAIL 11/C1.5. REFERENCE ARCHITECTURAL PLANS FOR MORE
- PROPOSED ELECTRICAL TRANSFORMER LOCATION. REFERENCE
- INSTALL AREA LIGHT; REFERENCE PHOTOMETRIC PLAN FOR POLE,
- INSTALL POLE AND HANIDCAP PARKING SIGN, INCLUDE "VAN" PLACARD CORRESPONDING (ONLY) TO SIMILARLY PAINT APPLIED TEXT; SEE
- INSTALL ADA REMOTE DOOR OPENER. REFERENCE ARCHITECTURAL
- PROPOSED DRAINAGE INLETS. REFERENCE UTILITY PLAN FOR
- PROPOSED 750 GALLON SAND/OIL INTERCEPTOR. REFERENCE UTILITY
- PROPOSED WATER METER. REFERENCE UTILITY PLAN FOR DETAILS.
- ONE-WAY STORM SEWER CLEAN OUT TO GRADE. REFERENCE UTILITY

- PROPOSED SANITARY SEWER MANHOLE. REFERENCE UTILITY PLAN
- PROPOSED LANDSCAPE WALL. REFERENCE GRADING PLAN FOR
- PROPOSED FIRE HYDRANT ASSEMBLY. REFERENCE UTILITY PLAN FOR

NOTES:

BENCHMARK

NAVD88 ELEVATION = 6902.3'

BASIS OF BEARING

1 & 2 AND IS ASSUMED TO BEAR N51°13'14"E.

LEGAL DESCRIPTION

NEW AND/OR PROPOSED.

SITE LEGEND — - - — ADJACENT PROPERTY BOUNDARY LINE - - - - - - BUILDING SETBACK EASEMENT BOUNDARY LINE EXISTING TO REMAIN --- PROPOSED BY OTHERS PROPOSED NEW EXISTING CURB & GUTTER TO REMAIN PROPOSED CURB & GUTTER PROPOSED CONCRETE PAVING PROPOSED STANDARD DUTY ASPHALT PAVING PROPOSED HEAVY DUTY ASPHALT PAVING PROPOSED LANDSCAPE PROPOSED SIDEWALK SAWCUT LINE PARKING COUNT PROPOSED TRANSFORMER

PROPOSED SITE LIGHTING

PROPOSED SANITARY MANHOLE

PROPOSED REGULATORY SIGN

EXISTING STORMDRAIN MANHOLE COVER

PROPOSED METER

EXISTING INLET

1. CONTRACTOR TO FURNISH AND INSTALL ALL ITEMS INDICATED AS

THE NATIONAL GEODETIC SURVEY (NGS) MONUMENT DESIGNATION 'E 24', PID JK0239, WHICH

SOUTHEAST 1/4 OF SECTION 32, T 12 S, R 64 W, AND AT U.S. HIGHWAY 24 MILEPOST 322.45. OWNERSHIP--EL PASO COUNTY PARK PROPERTY TO REACH THE STATION, GO TO THE INTERSECTION OF U.S. HIGHWAY 24 AND JUDGE ORR ROAD AND THE STATION IN THE

NORTHEAST CORNER OF THE INTERSECTION THE STATION IS A STANDARD DISK SET IN A 25 CM SQUARE CONCRETE POST, PROJECTING 30 CM ABOVE THE GROUND. IT IS 26.8 M (87.9 FT)

EAST-NORTHEAST FROM JUDGE ORR ROAD, 15.7 M (51.5 FT) FROM A DIRT ROAD TO A PRIVATE RESIDENCE, 0.8 M (2.6 FT) SOUTHWEST FROM A PLASTIC WITNESS POST, 0.7 M (2.3 FT) NORTH

BEARINGS ARE BASED ON THE NORTHWESTERLY LINE OF MERIDIAN CROSSING FILING NO. 1, LOTS

ALL OF LOTS 3 AND 4, MERIDIAN CROSSING FILING NO. 1, SITUATED IN THE NORTHEAST

MERIDIAN, TOWN OF FALCON, COUNTY OF EL PASO, STATE OF COLORADO.

QUARTER OF SECTION 12, TOWNSHIP 13 SOUTH, RANGE 65 WEST OF THE 6TH PRINCIPAL

FROM A METAL WITNESS POST AND 0.6 M (2.0 FT) EAST FROM A FENCE CORNER.

HAS AN ELEVATION OF 6902.3 (NAVD 88 DATUM). THE STATION IS LOCATED ABOUT 7 MI (11.3 KM)

EXISTING STREET LIGHT

EXISTING FIRE HYDRANT

EXISTING SANITARY SEWER MANHOLE COVER

1755 Telstar Drive, Suite 107

Colorado Springs, Co 80920

O2017. Galloway & Company, Inc. All Rights Reserve

719.900.7220 O www.gallowayUS.com

COPYRIGHT THESE PLANS ARE AN INSTRUMENT OF SERVICE AND ARE THE PROPERTY OF GALLOWAY, AND MAY NOT BE DUPLICATED, DISCLOSED, OR REPRODUCED WITHOUT THE WRITTEN CONSENT OF GALLOWAY. COPYRIGHTS AND INFRINGEMENTS WILL

BE ENFORCED AND PROSECUTED.


SOUTHWEST OF PEYTON, 2 MI (3.2 KM) NORTHEAST OF FALCON AND ON U.S. HIGHWAY 24, IN THE

#	Date	Issue / Description
0	3/27/18	CLIENT SET

0	3/27/18	CLIENT SET	
1	4/6/18	SDP SET	'
_		·	
_			
_			
Project No:	LST00067
Drawn By:	JRP
Checked By:	JDP
Date:	4/6/2018

SITE PLAN

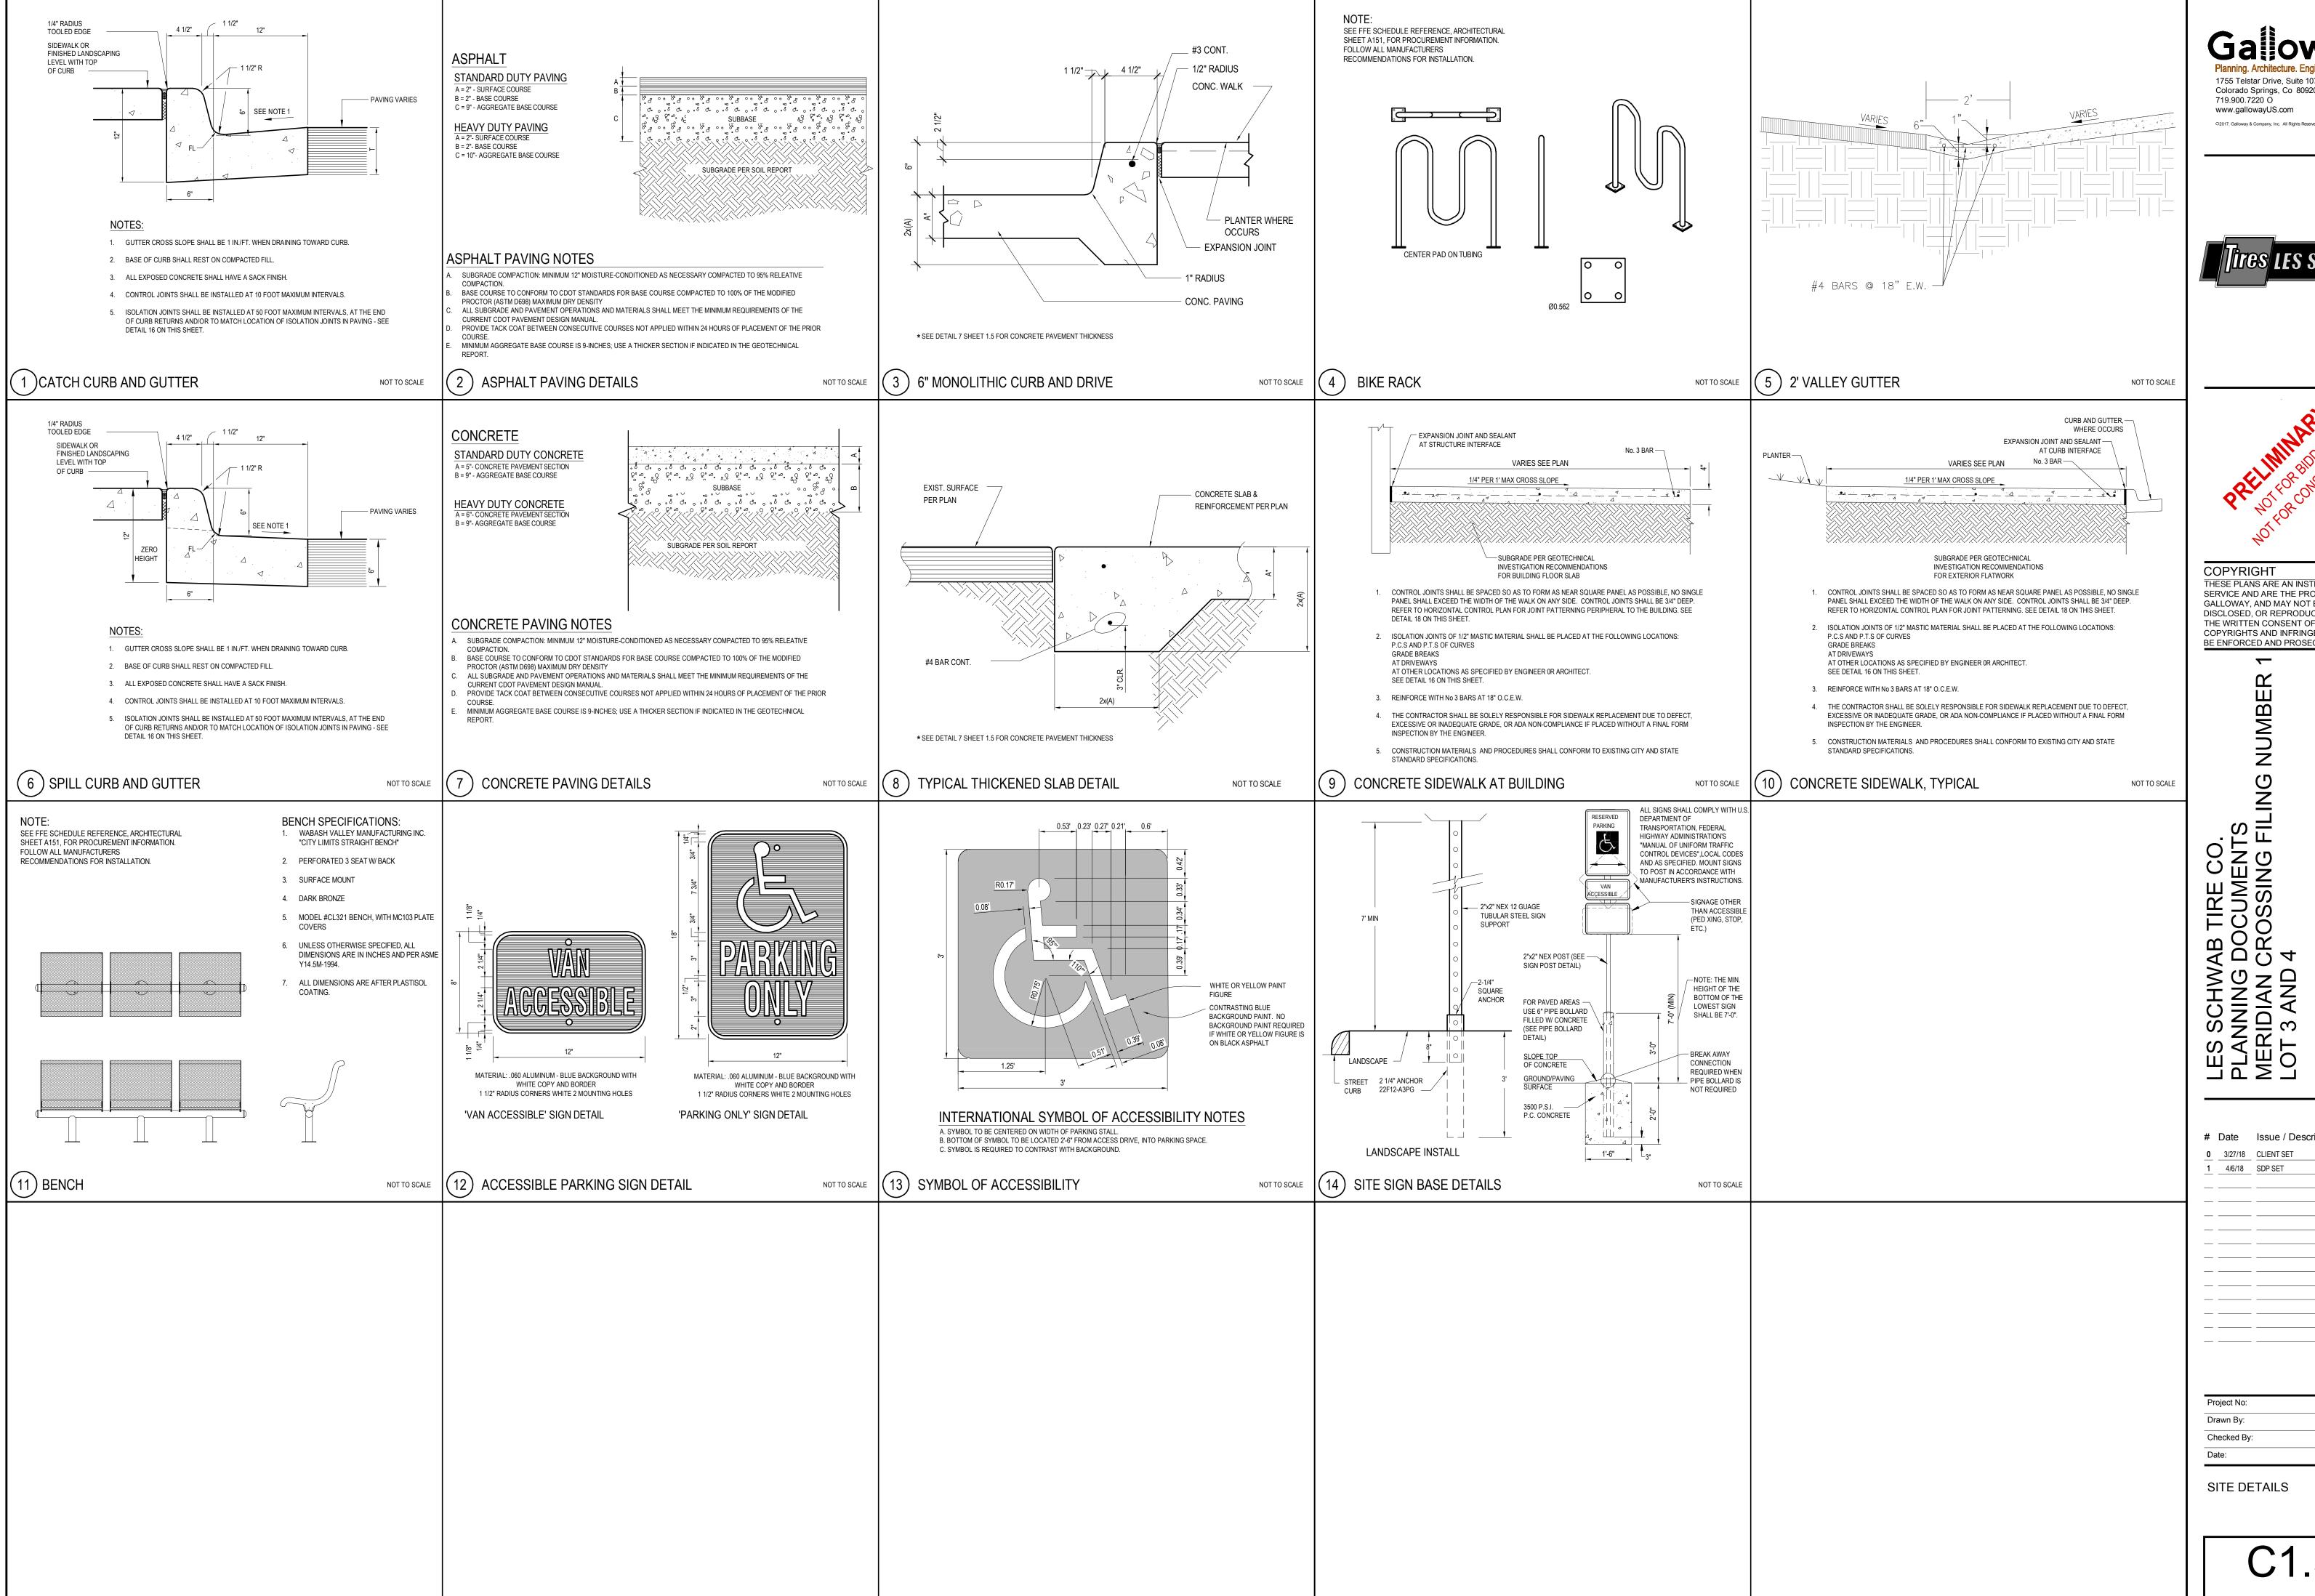

1755 Telstar Drive, Suite 107 Colorado Springs, Co 80920




COPYRIGHT THESE PLANS ARE AN INSTRUMENT OF SERVICE AND ARE THE PROPERTY OF GALLOWAY, AND MAY NOT BE DUPLICATED, DISCLOSED, OR REPRODUCED WITHOUT THE WRITTEN CONSENT OF GALLOWAY. COPYRIGHTS AND INFRINGEMENTS WILL

BE ENFORCED AND PROSECUTED.

Date Issue / Description **0** 3/27/18 CLIENT SET

LST00067 4/6/2018

SITE DETAILS

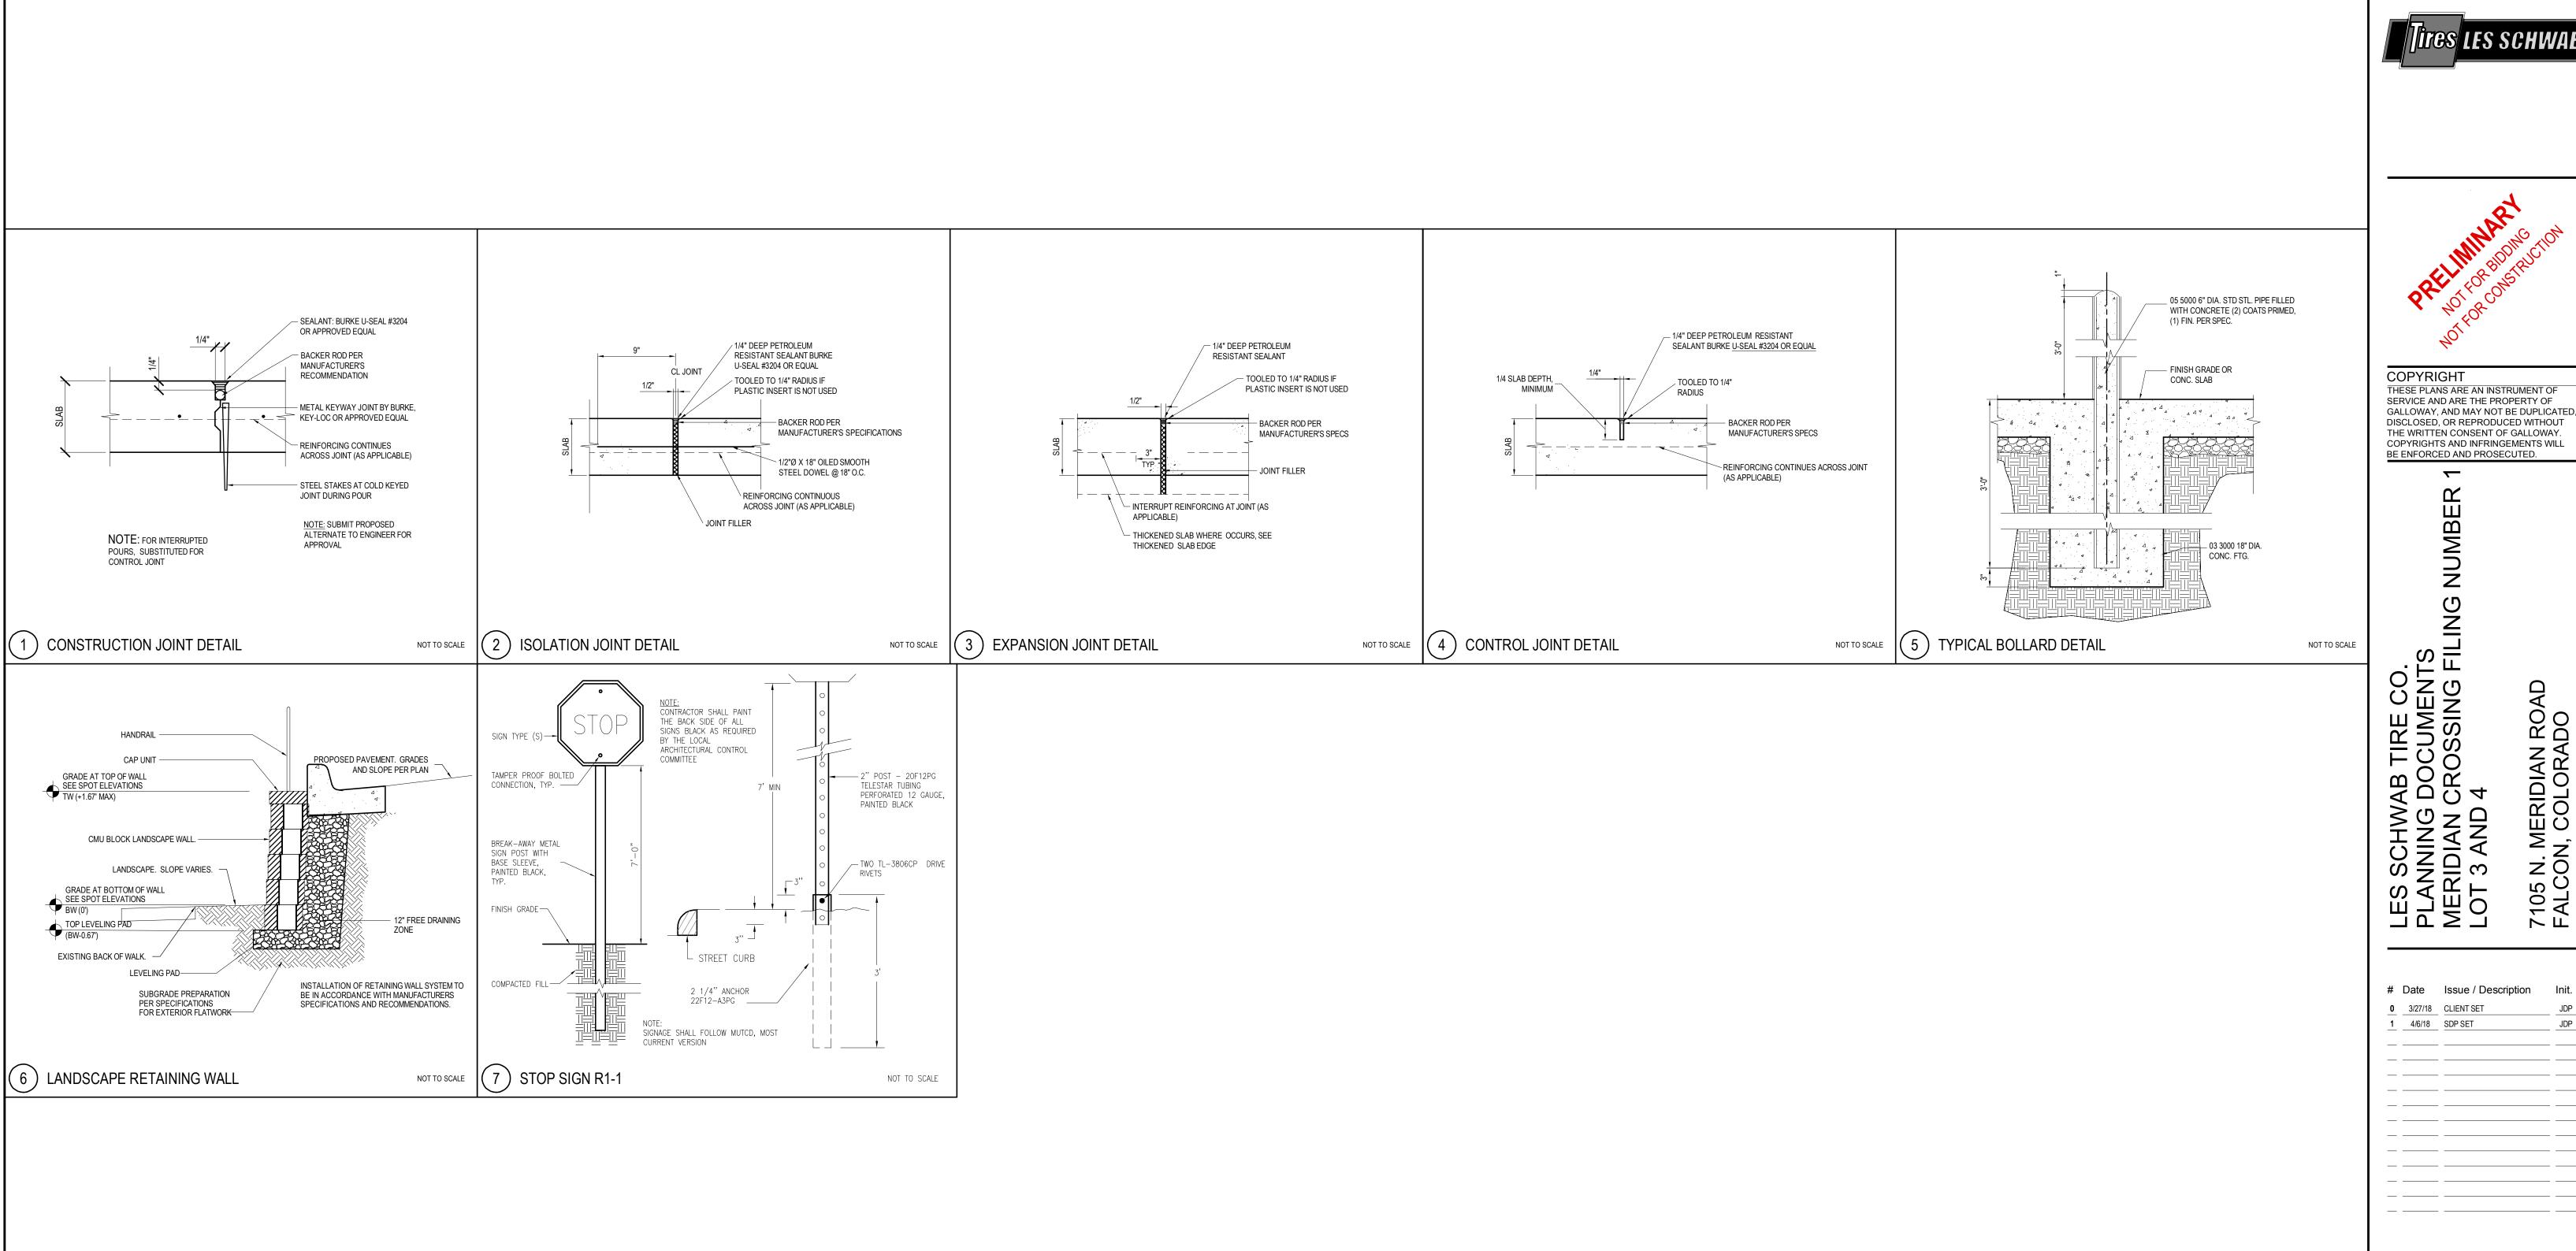







COPYRIGHT THESE PLANS ARE AN INSTRUMENT OF SERVICE AND ARE THE PROPERTY OF GALLOWAY, AND MAY NOT BE DUPLICATED, DISCLOSED, OR REPRODUCED WITHOUT THE WRITTEN CONSENT OF GALLOWAY. COPYRIGHTS AND INFRINGEMENTS WILL BE ENFORCED AND PROSECUTED.


NUMBE

7105 N. MERIDIAN RO FALCON, COLORADO

0 3/27/18 CLIENT SET JDP 1 4/6/18 SDP SET LST00067

Checked By: JDP 4/6/2018

SITE DETAILS

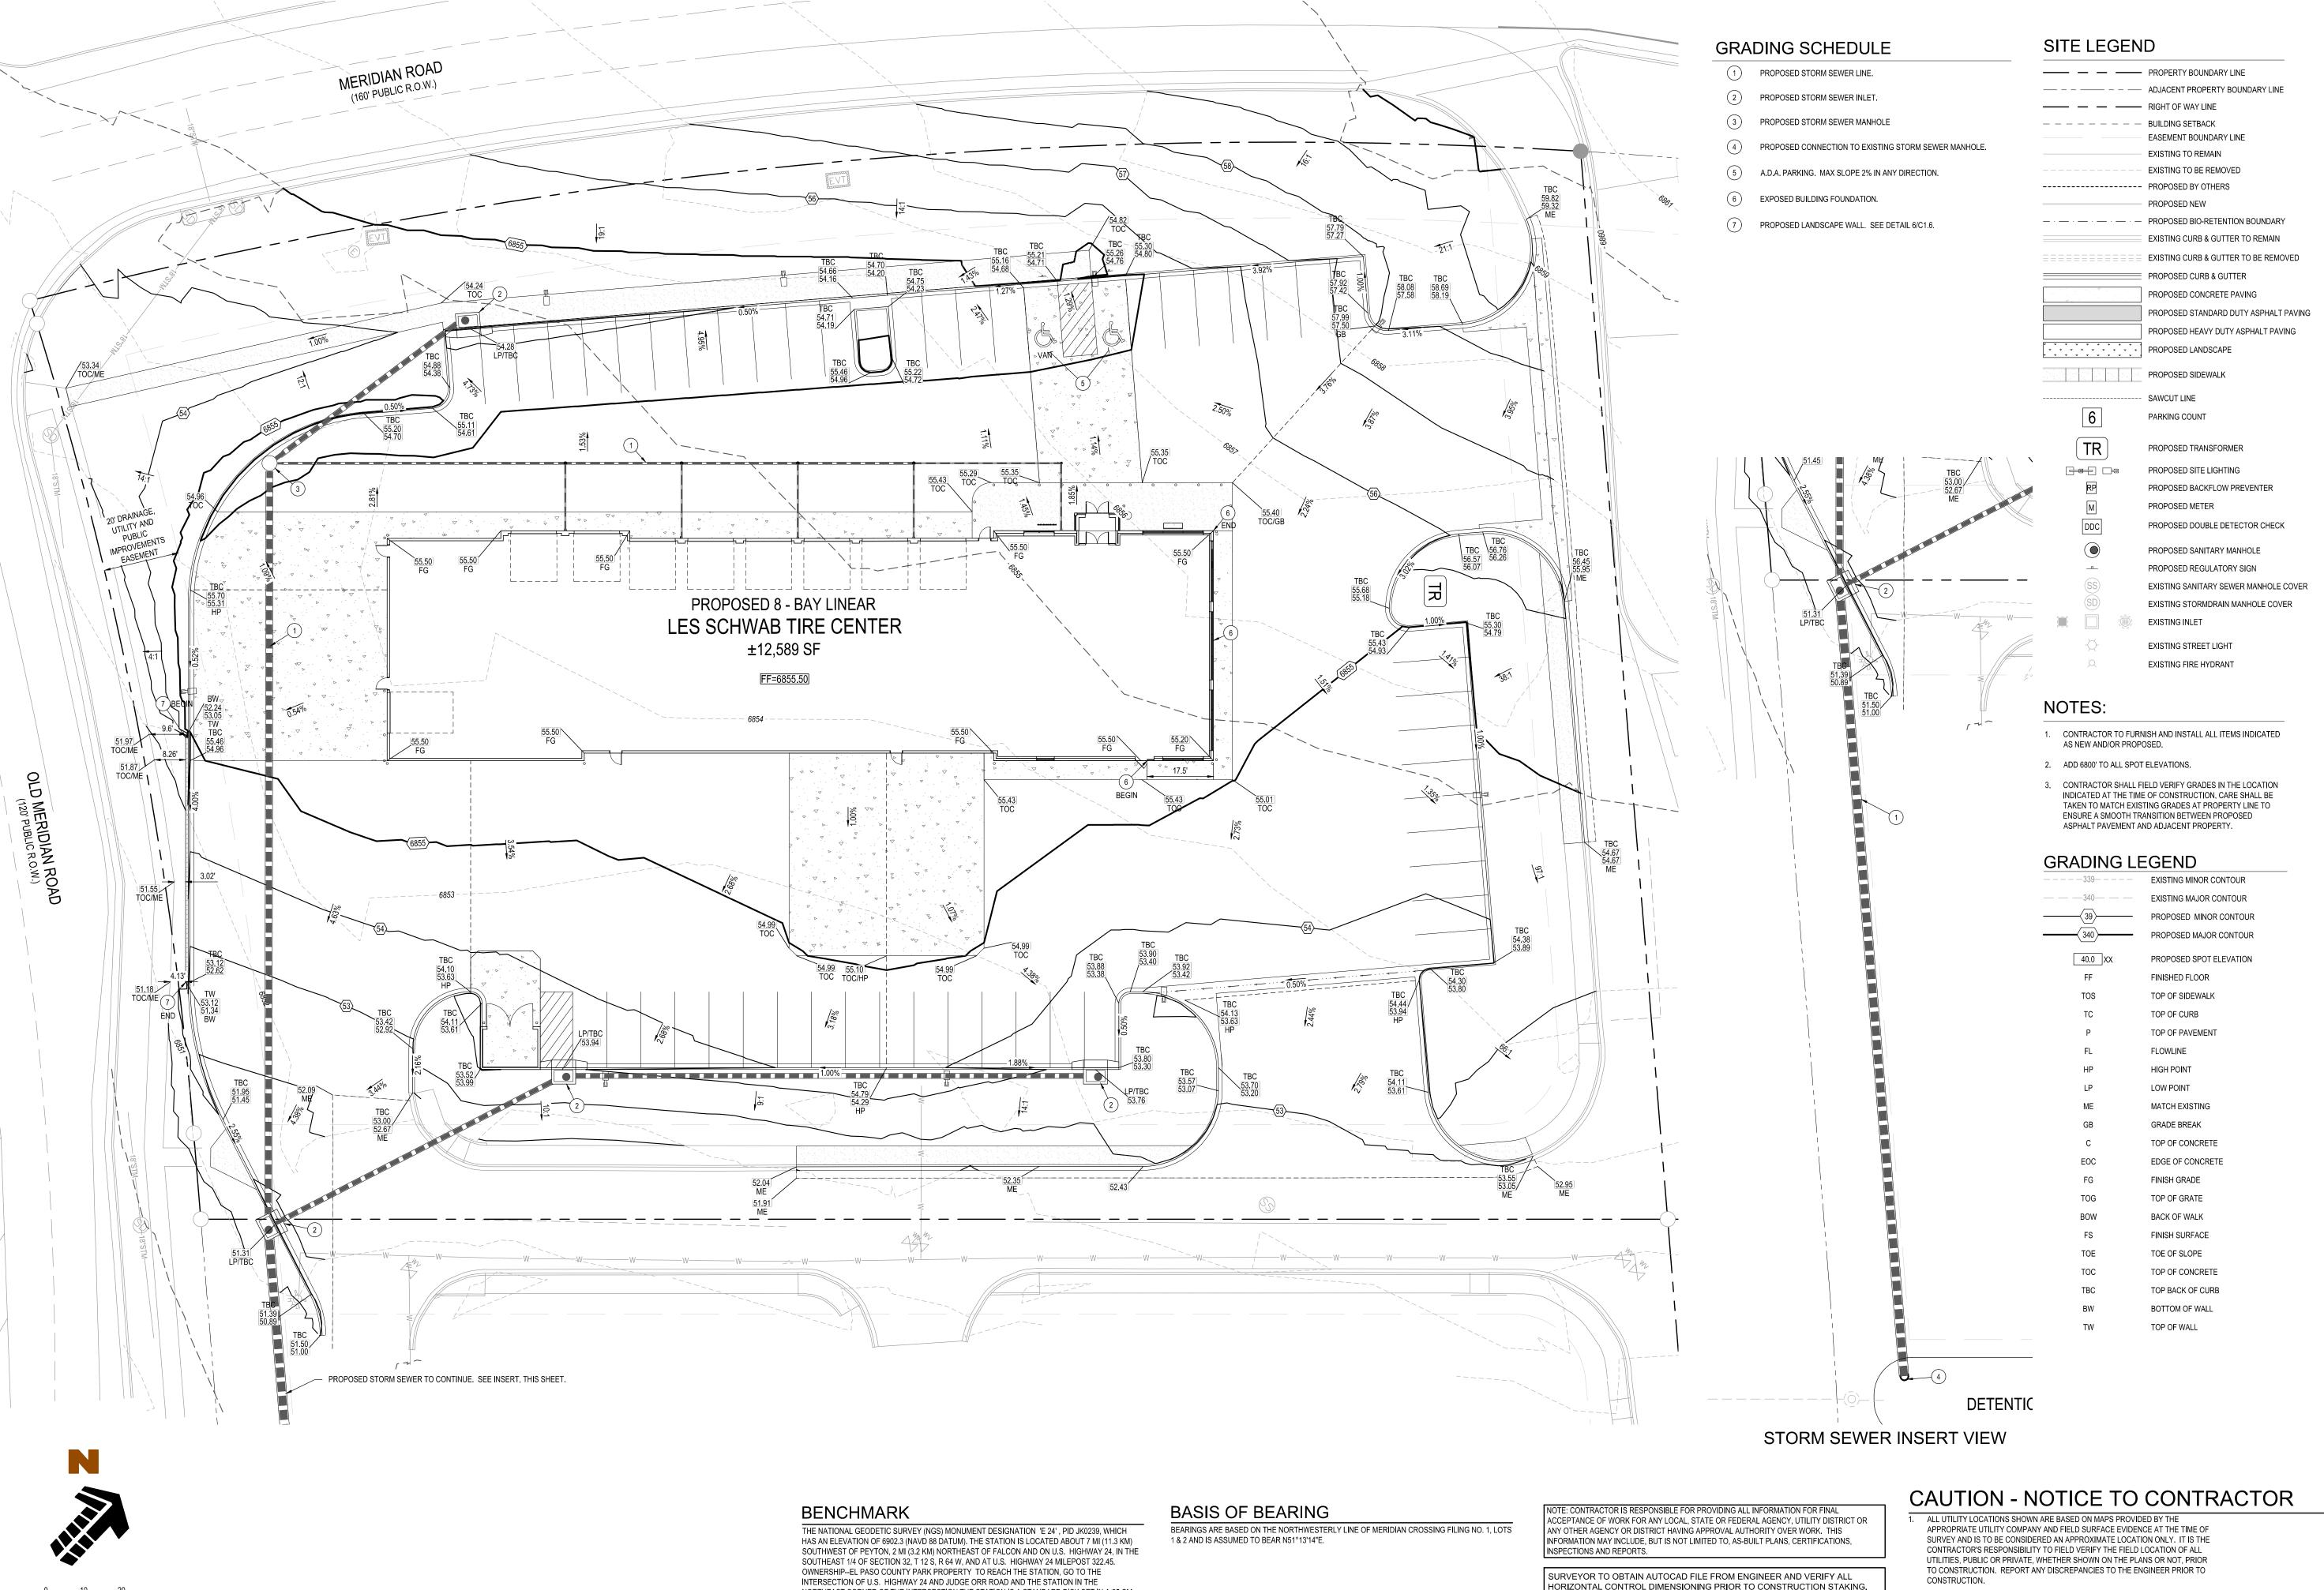

LEGAL DESCRIPTION

ALL OF LOTS 3 AND 4, MERIDIAN CROSSING FILING NO. 1, SITUATED IN THE NORTHEAST

MERIDIAN, TOWN OF FALCON, COUNTY OF EL PASO, STATE OF COLORADO.

QUARTER OF SECTION 12, TOWNSHIP 13 SOUTH, RANGE 65 WEST OF THE 6TH PRINCIPAL

NORTHEAST CORNER OF THE INTERSECTION THE STATION IS A STANDARD DISK SET IN A 25 CM

SQUARE CONCRETE POST, PROJECTING 30 CM ABOVE THE GROUND. IT IS 26.8 M (87.9 FT)

FROM A METAL WITNESS POST AND 0.6 M (2.0 FT) EAST FROM A FENCE CORNER.

NAVD88 ELEVATION = 6902.3'

SCALE: 1"=20'

EAST-NORTHEAST FROM JUDGE ORR ROAD, 15.7 M (51.5 FT) FROM A DIRT ROAD TO A PRIVATE

RESIDENCE, 0.8 M (2.6 FT) SOUTHWEST FROM A PLASTIC WITNESS POST, 0.7 M (2.3 FT) NORTH

1755 Telstar Drive, Suite 107 Colorado Springs, Co 80920 719.900.7220 O www.gallowayUS.com

O2017. Galloway & Company, Inc. All Rights Reserved





COPYRIGHT THESE PLANS ARE AN INSTRUMENT OF SERVICE AND ARE THE PROPERTY OF

GALLOWAY, AND MAY NOT BE DUPLICATED, DISCLOSED, OR REPRODUCED WITHOUT THE WRITTEN CONSENT OF GALLOWAY. COPYRIGHTS AND INFRINGEMENTS WILL BE ENFORCED AND PROSECUTED.

1 4/6/18 SDP SET

LST00067 Drawn By: Checked By:

GRADING PLAN

WHERE A PROPOSED UTILITY CROSSES AN EXISTING UTILITY, IT IS THE CONTRACTOR'S RESPONSIBILITY TO FIELD VERIFY THE HORIZONTAL AND VERTICAL LOCATION OF SUCH EXISTING UTILITY, EITHER THROUGH POTHOLING OR ALTERNATIVE METHOD. REPORT INFORMATION TO THE ENGINEER PRIOR TO CONSTRUCTION.

SURVEYOR MUST VERIFY ALL BENCHMARK, BASIS OF BEARING AND DATUM

AND VERTICAL LOCATIONS SHOWN ON THE DESIGN CONSTRUCTION

FURTHER STAKING OR CONSTRUCTION WORK.


INFORMATION TO ENSURE IMPROVEMENTS WILL BE AT THE SAME HORIZONTAL


DRAWINGS. PRIOR TO CONSTRUCTION STAKING ANY DISCREPANCY MUST BE

REPORTED TO OWNER AND ENGINEER PRIOR TO CONTINUATION OF ANY



Know what's **below.** Call before you dig.

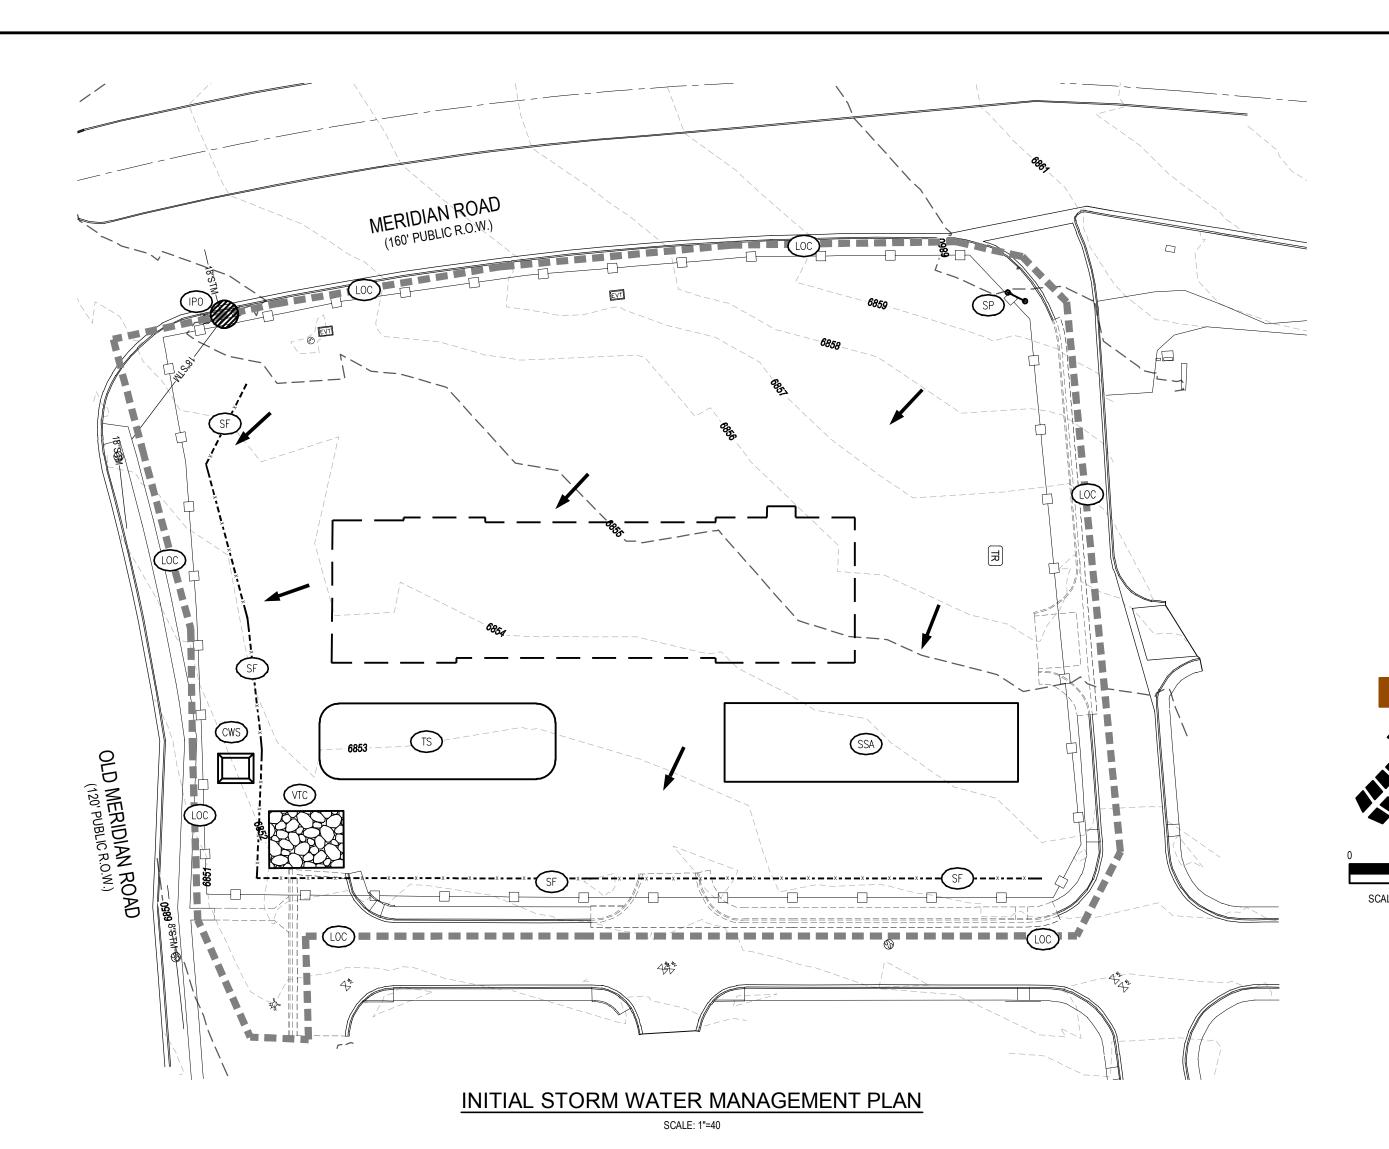

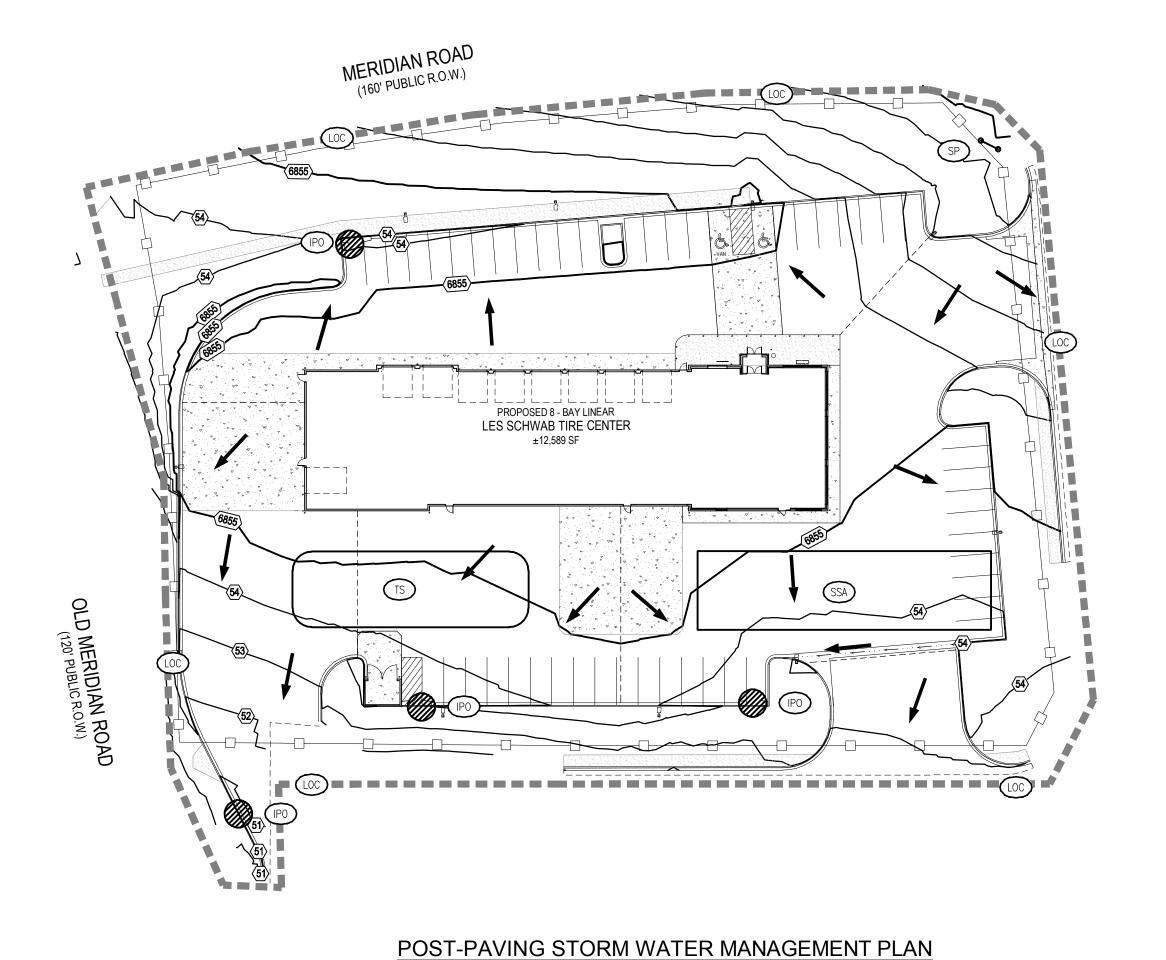

SCALE: 1"=40



FINAL EROSION CONTROL NOTE

PERMANENT LANDSCAPE MATERIALS PER THE ACCOMPANYING PLAN WILL BE USED TO STABLIZE ALL ON-SITE OPEN SPACE. ALL OTHER ON-SITE AREAS WILL BE STABILIZED WITH HARDSCAPE OR BUILDING CONSTRUCTION. DISTURBED OFF-SITE AREAS WILL BE PROVIDED WITH REPLACEMENT LANDSCAPE, HARDSCAPE OR FULLY ESTABLISHED NATIVE SEED REVEGETATION AS INDICATED ON THE INTERIM & FINAL EROSION CONTROL PLAN, THIS SHEET.

EROSION CONTROL LEGEND

	FLOW ARROW
	LIMITS OF CONSTRUCTION (AREA= 26,184 SF, 0.60 AC)
xx- (SF)	SILT FENCE
	CONSTRUCTION FENCE
CWS	SMALL SITE CONCRETE WASHOUT AREA
	TEMPORARY STOCKPILE
VIC VIC	VEHICLE TRACKING CONTROL/CONSTRUCTION ENTRA
ECB	EROSION CONTROL BLANKET
	INLET PROTECTION
→ (SP)	SWMP SITE POSTING
SSA	STABILIZED STAGING AREA
DD	DIVERSION DITCH/BERM
SDP	SILT DIKE ON PAVEMENT
	LANDSCAPE AREA
RES	PORTABLE RESTROOM

GRADING LEGEND

	EXISTING MINOR CONTOUR
- — —340— — —	EXISTING MAJOR CONTOU
39	PROPOSED MINOR CONTO
340	PROPOSED MAJOR CONTO
40.0 XX	PROPOSED SPOT ELEVATION
FF	FINISHED FLOOR
TOS	TOP OF SIDEWALK
TC	TOP OF CURB
Р	TOP OF PAVEMENT
FL	FLOWLINE
HP	HIGH POINT
LP	LOW POINT
ME	MATCH EXISTING
GB	GRADE BREAK
С	TOP OF CONCRETE
EOC	EDGE OF CONCRETE
FG	FINISH GRADE
TOG	TOP OF GRATE
BOW	BACK OF WALK
FS	FINISH SURFACE
TOE	TOE OF SLOPE

STORMWATER MANAGEMENT PLANS GENERAL NOTES 1. THE CONTRACTOR AND/OR AUTHORIZED AGENTS SHALL REMOVE ALL SEDIMENT, MUD, CONSTRUCTION DEBRIS, OR OTHER POTENTIAL POLLUTANTS THAT MAY HAVE BEEN DISCHARGED TO OR, ACCUMULATE IN, THE FLOW LINES AND PUBLIC RIGHTS OF WAYS OF THE CITY AS A RESULT OF CONSTRUCTION ACTIVITIES ASSOCIATED WITH THIS SITE DEVELOPMENT OR

CONSTRUCTION PROJECT. SAID REMOVAL SHALL BE CONDUCTED IN A TIMELY MANNER. 2. ADDITIONAL EROSION AND SEDIMENT CONTROL MEASURES MAY BE REQUIRED OF THE OWNER AND HIS OR HER AGENTS DUE TO UNFORESEEN EROSION PROBLEMS OR IF THE SUBMITTED PLAN DOES NOT FUNCTION AS INTENDED. THE REQUIREMENTS OF THIS PLAN SHALL BE THE OBLIGATION OF THE PERMIT HOLDER UNTIL SUCH TIME AS THE PLAN IS PROPERLY COMPLETED

AND THE PERMIT IS RELEASED. 3. THE CONTRACTOR SHALL PREVENT SEDIMENT, DEBRIS AND ALL OTHER POLLUTANTS FROM ENTERING THE STORM SEWER SYSTEM DURING ALL DEMOLITION, EXCAVATION, TRENCHING, BORING, GRADING OR OTHER CONSTRUCTION OPERATIONS THAT ARE PART OF THIS PROJECT. THE CONTRACTOR SHALL BE HELD RESPONSIBLE FOR REMEDIATION OF ANY ADVERSE

IMPACTS TO ADJACENT WATERWAYS, WETLANDS, ETC., RESULTING FROM WORK DONE AS PART OF THIS PROJECT.

- 4. THE CONTRACTOR SHALL LOCATE, INSTALL, AND MAINTAIN ALL EROSION CONTROL AND WATER QUALITY "BEST MANAGEMENT PRACTICES" AS INDICATED IN THE APPROVED STORMWATER MANAGEMENT PLAN.
- 5. THE DEVELOPER, GENERAL CONTRACTOR, GRADING CONTRACTOR AND/OR THEIR AUTHORIZED AGENTS SHALL INSURE THAT ALL LOADS OF CUT AND FILL MATERIAL IMPORTED TO OR EXPORTED FROM THIS SITE SHALL BE PROPERLY COVERED TO PREVENT LOSS OF THE MATERIAL DURING TRANSPORT ON PUBLIC RIGHTS OF WAY.
- 6. SOILS THAT WILL BE STOCKPILED FOR MORE THAN 30 DAYS SHALL BE PROTECTED FROM WIND AND WATER EROSION WITHIN 14 DAYS OF STOCKPILE CONSTRUCTION. IF STOCKPILES ARE LOCATED WITHIN 100 FEET OF A DRAINAGEWAY, ADDITIONAL SEDIMENT CONTROLS SUCH AS TEMPORARY DIKES OR SILT FENCE SHALL BE REQUIRED.
- 7. APPROVED EROSION AND SEDIMENT CONTROL BEST MANAGEMENT PRACTICES SHALL BE MAINTAINED AND KEPT IN GOOD REPAIR OF THE DURATION OF THIS PROJECT. ACCUMULATED SEDIMENT AND DEBRIS SHALL BE REMOVED FROM A BMP WHEN THE SEDIMENT OR DEBRIS ADVERSELY IMPACTS THE FUNCTIONING OF THE BMP.
- 8. THE CONTRACTOR SHALL PROTECT STORM DRAIN INLETS DIRECTLY DOWNSTREAM OF CONSTRUCTION AREA NOT NECESSARILY SHOWN ON THIS PLAN.

DUST CONTROL GENERAL NOTES

THE CITY ENGINEER MAY REQUIRE THE SUBMITTAL OF A DUST PREVENTION AND CONTROL PLAN FOR GRADING AND CONSTRUCTION AS DEEMED NECESSARY. AT THE VERY MINIMUM THE FOLLOWING CONDITIONS CONCERNING THE CONTROL OF GRADING AND CONSTRUCTION DUST SHALL BE ADHERED TO, AS WELL AS FOLLOWING SCAQMD REQUIREMENTS WITH REGARDS TO FUGITIVE DUST. FUGITIVE DUST EMISSIONS WILL BE CONTROLLED TWENTY-FOUR (24) HOURS A DAY, SEVEN (7) DAYS A WEEK, WHETHER OR NOT THERE IS CURRENT ACTIVITY ON THE SITE.

- THERE SHALL BE A 24-HOUR CONTACT NAME AND PHONE NUMBER FOR THE PERSON RESPONSIBLE FOR ENSURING THE CONTROL OF FUGITIVE DUST, WHETHER OR NOT THERE IS CURRENT ACTIVITY AT THE SITE.
- DUST CONTROL MEASURES SHALL INCLUDE, BUT ARE NOT LIMITED TO THE APPLICATION OF WATER OR DUST PALLIATIVES, THE INSTALLATION OF WIND FENCING, AND THE TREATMENT OF STAGING AREAS.
- WHEN AN ENTIRE PROJECT IS GRADED AND THE SUBSEQUENT CONSTRUCTION ON THE SITE IS TO BE COMPLETED IN PHASES, THE PORTION OF THE SITE NOT UNDER CONSTRUCTION SHALL BE TREATED WITH CHEMICAL STABILIZERS, OR PLANT MATERIALS AND AN IRRIGATION SYSTEM.

IF THE IMPORTING OR EXPORTING OF SOIL IS NECESSARY, DUST CONTROL SHALL INCLUDE PROCEDURES FOR THE CONTROL OF DUST RESULTING FROM THE LOADING, TRANSPORTATION AND UNLOADING OF SOIL FROM, TO OR WITHIN THE PROJECT AREA AND ON PUBLIC ROADWAYS.

BENCHMARK

THE NATIONAL GEODETIC SURVEY (NGS) MONUMENT DESIGNATION 'E 24', PID JK0239, WHICH HAS AN ELEVATION OF 6902.3 (NAVD 88 DATUM). THE STATION IS LOCATED ABOUT 7 MI (11.3 KM) SOUTHWEST OF PEYTON, 2 MI (3.2 KM) NORTHEAST OF FALCON AND ON U.S. HIGHWAY 24, IN THE SOUTHEAST 1/4 OF SECTION 32, T 12 S, R 64 W, AND AT U.S. HIGHWAY 24 MILEPOST 322.45. OWNERSHIP--EL PASO COUNTY PARK PROPERTY TO REACH THE STATION, GO TO THE INTERSECTION OF U.S. HIGHWAY 24 AND JUDGE ORR ROAD AND THE STATION IN THE NORTHEAST CORNER OF THE INTERSECTION THE STATION IS A STANDARD DISK SET IN A 25 CM SQUARE CONCRETE POST, PROJECTING 30 CM ABOVE THE GROUND. IT IS 26.8 M (87.9 FT) EAST-NORTHEAST FROM JUDGE ORR ROAD, 15.7 M (51.5 FT) FROM A DIRT ROAD TO A PRIVATE RESIDENCE, 0.8 M (2.6 FT) SOUTHWEST FROM A PLASTIC WITNESS POST, 0.7 M (2.3 FT) NORTH FROM A METAL WITNESS POST AND 0.6 M (2.0 FT) EAST FROM A FENCE CORNER.

NAVD88 ELEVATION = 6902.3'

LEGAL DESCRIPTION

ALL OF LOTS 3 AND 4, MERIDIAN CROSSING FILING NO. 1, SITUATED IN THE NORTHEAST QUARTER OF SECTION 12, TOWNSHIP 13 SOUTH, RANGE 65 WEST OF THE 6TH PRINCIPAL MERIDIAN, TOWN OF FALCON, COUNTY OF EL PASO, STATE OF COLORADO.

BASIS OF BEARING


BEARINGS ARE BASED ON THE NORTHWESTERLY LINE OF MERIDIAN CROSSING FILING NO. 1, LOTS 1 & 2 AND IS ASSUMED TO BEAR N51°13'14"E.

Please call all GEC plan sheets in this set as preliminary grading plan. note that this plan is not being reviewed as the official GEC plan.

1755 Telstar Drive, Suite 107 Colorado Springs, Co 80920 719.900.7220 O

www.gallowayUS.com ©2017. Galloway & Company, Inc. All Rights Reserved



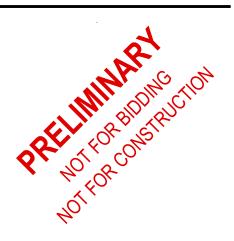



COPYRIGHT THESE PLANS ARE AN INSTRUMENT OF SERVICE AND ARE THE PROPERTY OF GALLOWAY, AND MAY NOT BE DUPLICATED, DISCLOSED, OR REPRODUCED WITHOUT THE WRITTEN CONSENT OF GALLOWAY. COPYRIGHTS AND INFRINGEMENTS WILL BE ENFORCED AND PROSECUTED.

#	Date	Issue / Description
0	3/27/18	CLIENT SET
1	4/6/18	SDP SET
_		
_		
_		
_		_
_		
_		
Checked By 4/6/2018

EROSION CONTROL PLAN

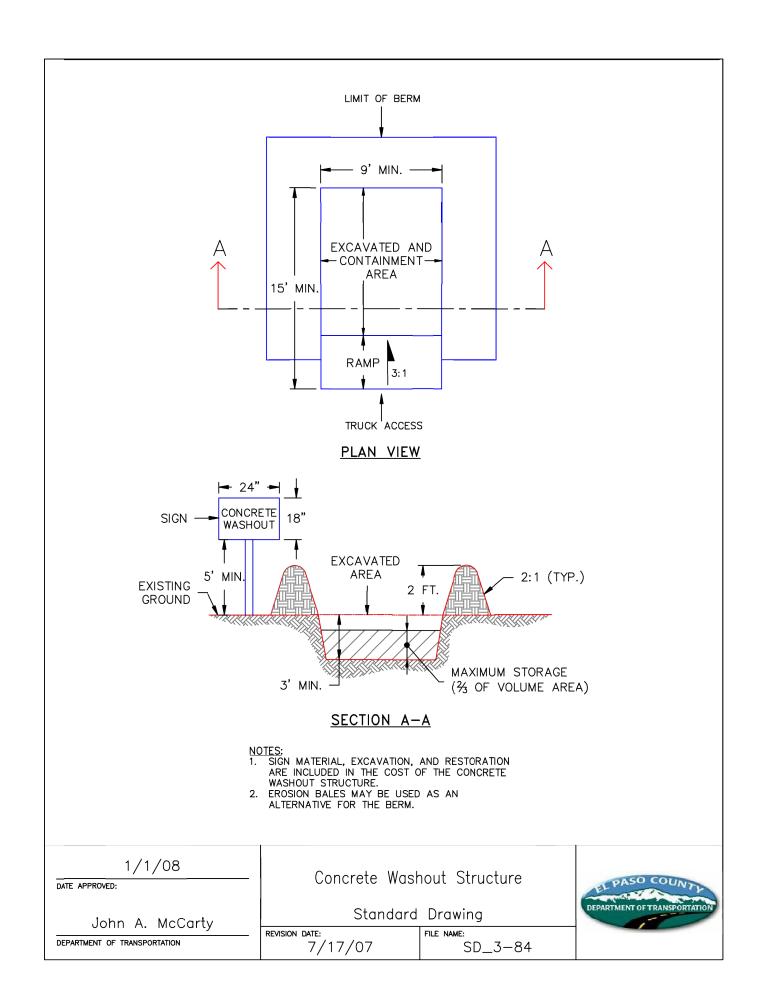

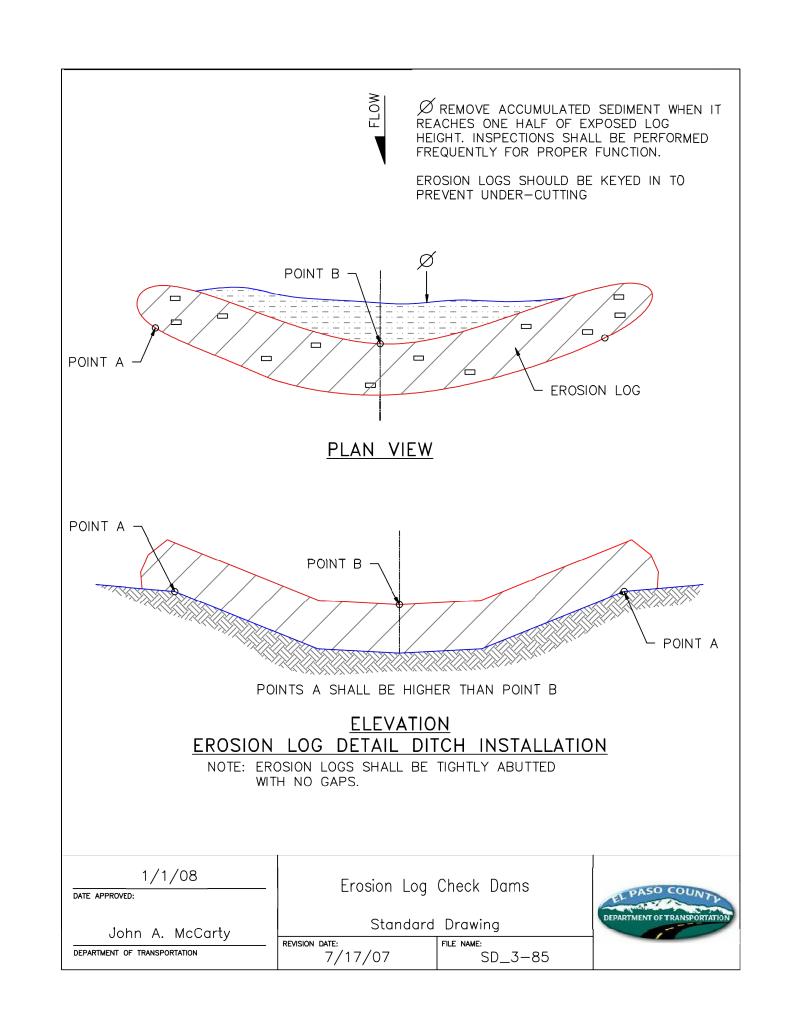



O2017. Galloway & Company, Inc. All Rights Reserved





COPYRIGHT
THESE PLANS ARE AN INSTRUMENT OF SERVICE AND ARE THE PROPERTY OF GALLOWAY, AND MAY NOT BE DUPLICATED, DISCLOSED, OR REPRODUCED WITHOUT THE WRITTEN CONSENT OF GALLOWAY. COPYRIGHTS AND INFRINGEMENTS WILL BE ENFORCED AND PROSECUTED.

SERVICE AND ARE THE PROPER GALLOWAY, AND MAY NOT BE IT DISCLOSED, OR REPRODUCED THE WRITTEN CONSENT OF GA COPYRIGHTS AND INFRINGEME BE ENFORCED AND PROSECUT

WHEN THE MENT OF THE WRITTEN CONSENT OF GA COPYRIGHTS AND INFRINGEME BE ENFORCED AND PROSECUT

WHEN THE WRITTEN CONSENT OF GA COPYRIGHTS AND INFRINGEME BE ENFORCED AND PROSECUT

WHEN THE WRONG THE PROPER OF THE WRONG THE PROPER OF THE WRONG THE WR

LOT 3 AND 4
7105 N. MERIDIAN ROAD


 Drawn By:
 JRP

 Checked By:
 JDP

 Date:
 4/6/2018

EROSION CONTROL DETAILS

 $\overline{C3.5}$

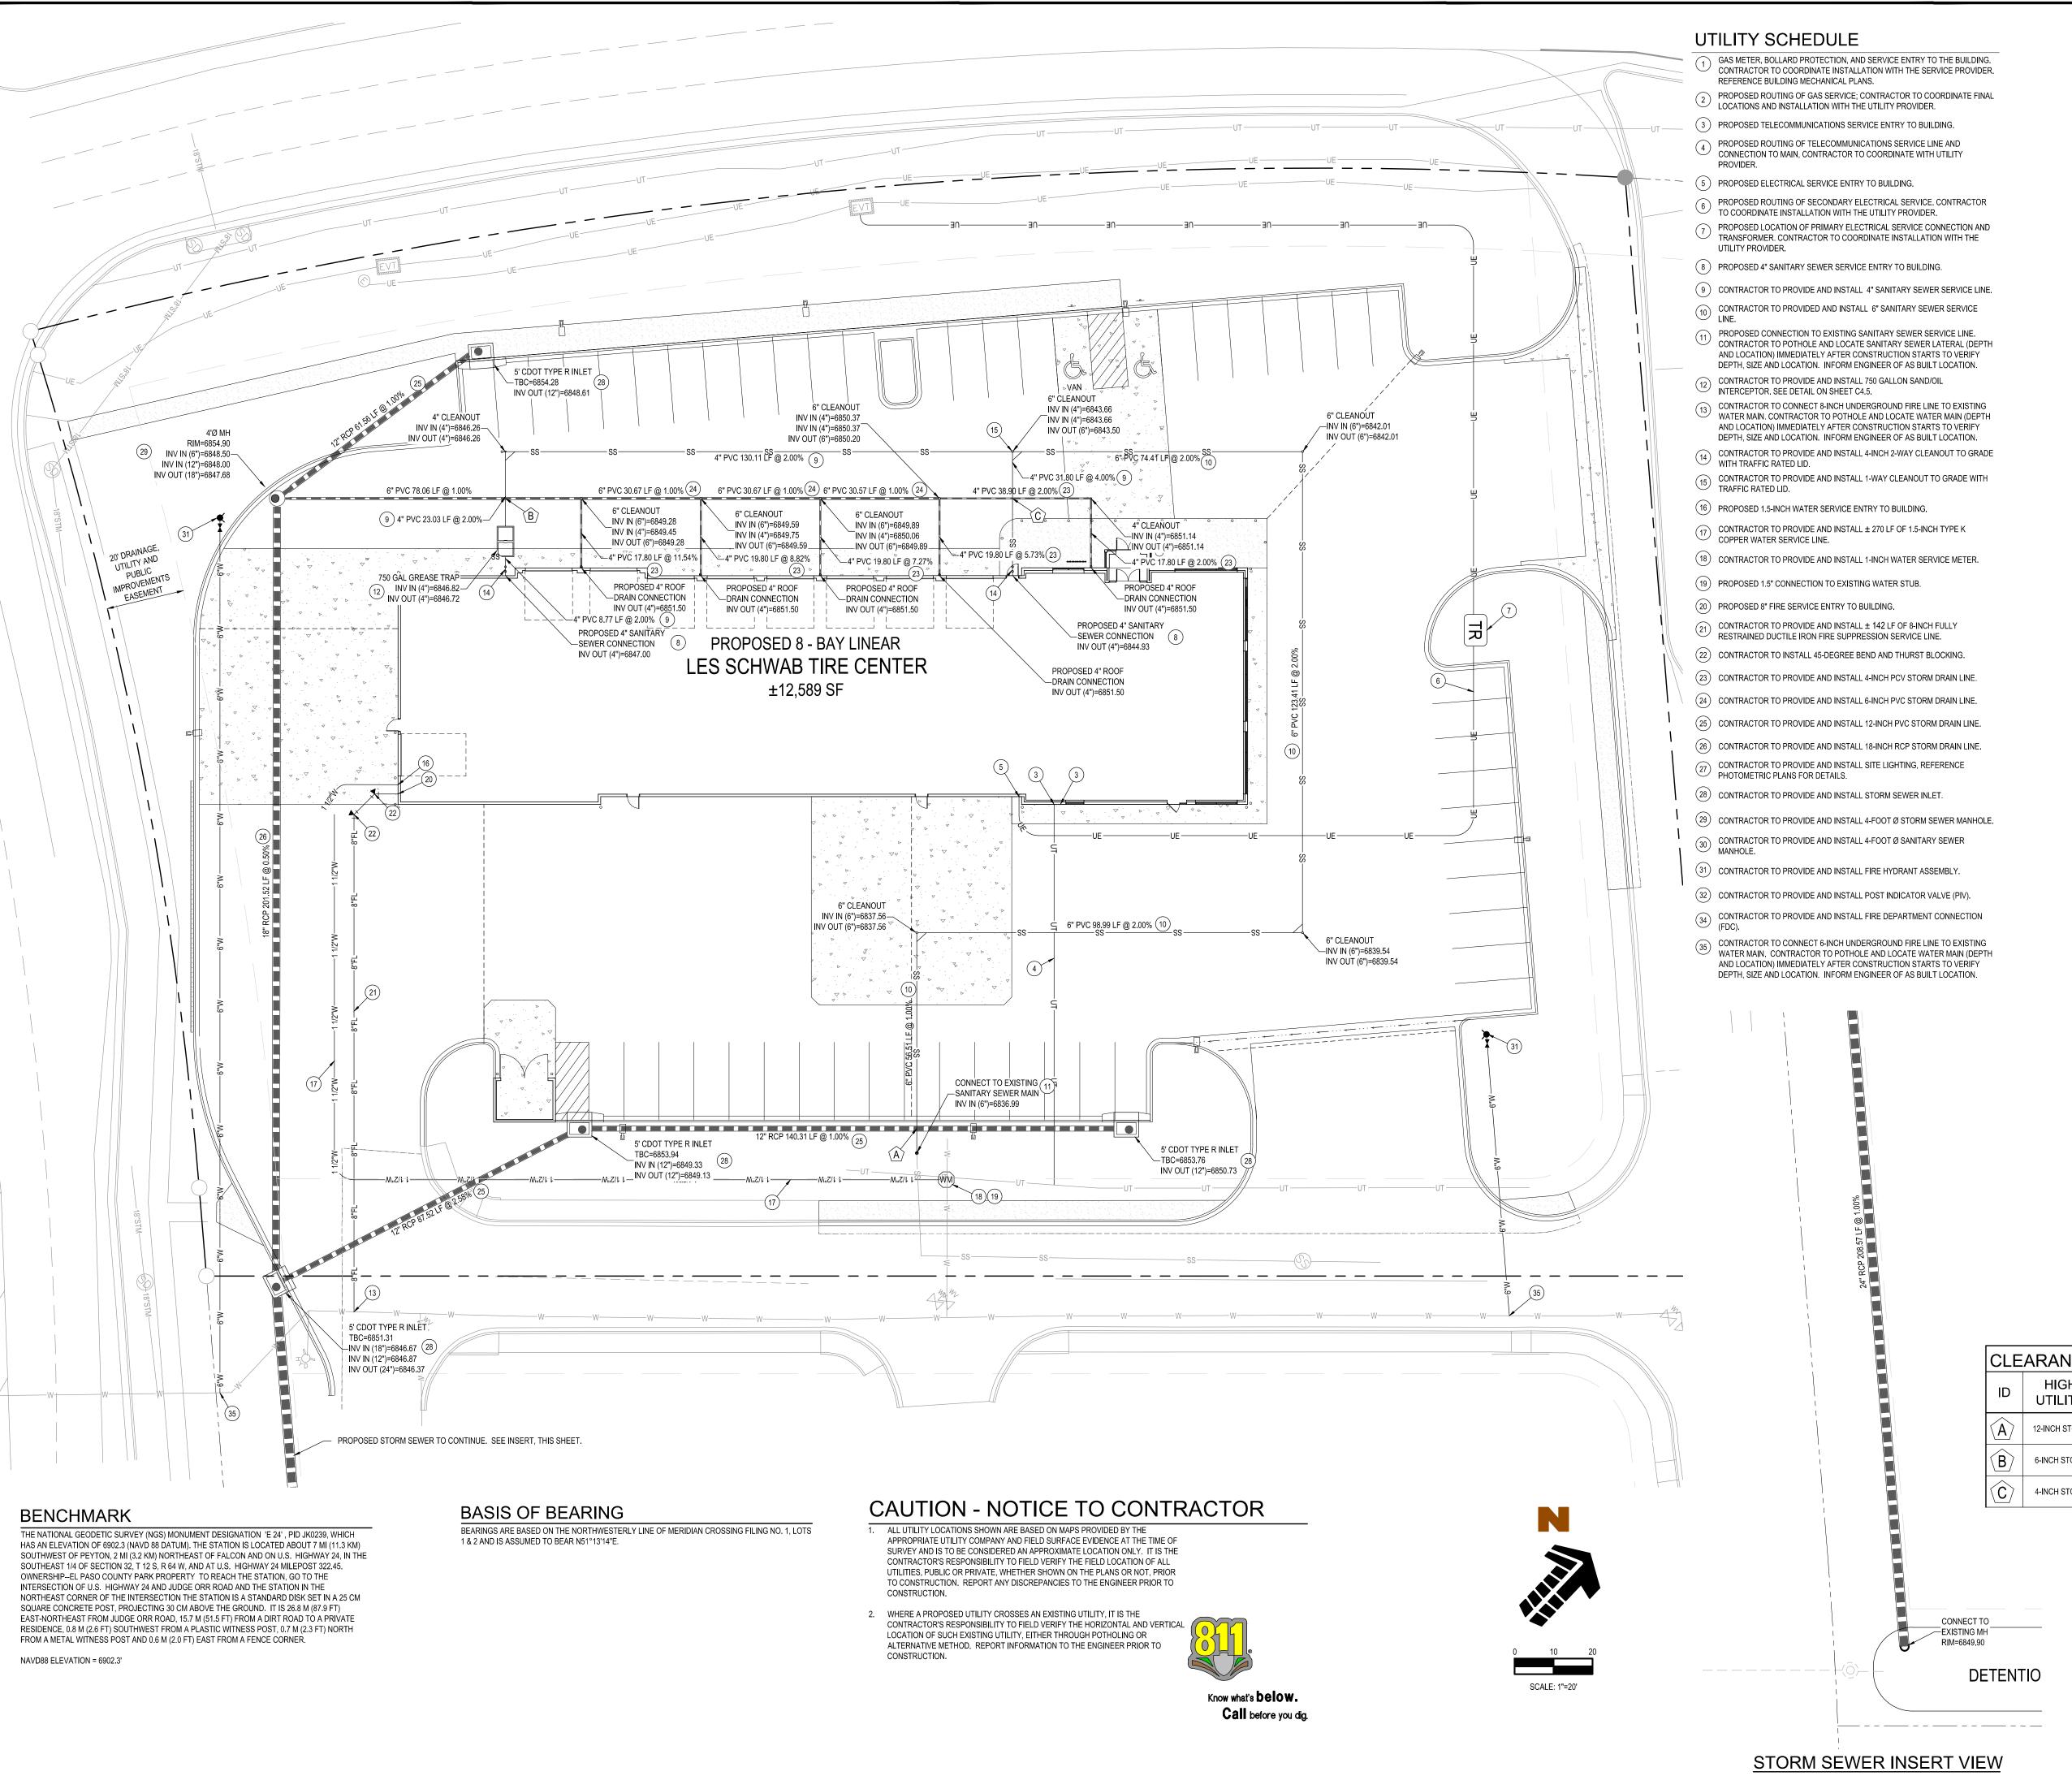

UTILITY LEGEND

EXISTING 6" WATER LINE — — 6" W — — — EXISTING 1" WATER LINE — — 1" W — — — EXISTING 2" WATER LINE PROPOSED 1" WATER LINE PROPOSED 2" WATER LINE EXISTING SANITARY SEWER SS——SS———PROPOSED SANITARY SEWER EXISTING STORM SEWER ------4" STM ------- PROPOSED 4" STORM SEWER PROPOSED STORM SEWER (> 4") PROPOSED GAS LINE PROPOSED UNDERGROUND ELECTRICAL EXISTING UNDERGROUND TELEPHONE —UT———— PROPOSED UNDERGROUND TELEPHONE - WATER LINE KICK BLOCK LOCATION

TYPICAL AS SHOWN

EXISTING 8" WATER LINE

SITE LEGEND

—— — PROPERTY BOUNDARY LINE



SAWCUT LINE PARKING COUNT

PROPOSED TRANSFORMER PROPOSED SITE LIGHTING PROPOSED BACKFLOW PREVENTER

PROPOSED METER PROPOSED DOUBLE DETECTOR CHECK

PROPOSED SANITARY MANHOLE PROPOSED REGULATORY SIGN

EXISTING SANITARY SEWER MANHOLE COVER EXISTING STORMDRAIN MANHOLE COVER

EXISTING INLET

EXISTING STREET LIGHT EXISTING FIRE HYDRANT

UTILITY NOTES

- 1. CO-TRENCH ELECTRIC AND TELECOMMUNICATIONS SERVICE LINES WHERE ROUTING ALLOWS.
- 2. CONTRACTOR TO CONSTRUCT TRANSFORMER PAD TO THE UTILITY PROVIDERS SPECIFICATION AND COORDINATE INSTALLATION WITH SAME. CONFIRM WITH UTILITY PROVIDER.
- 3. TYPICAL CONTRACTOR PROVIDE & INSTALL SECONDARY ELECTRIC LINES ON SITE.
- 4. CONTRACTOR TO PROVIDE AND INSTALL 3 #10, 3/4-INCH CONDUITS FOR SITE LIGHTING; TYPICAL ALL SITE LIGHTING. REFERENCE SITE ELECTRIC PLANS FOR RUN TERMINUS AND CIRCUITING REQUIREMENTS.
- 5. CONTRACTOR TO PROVIDE AND INSTALL (2) 2-INCH SCHEDULE 40 PVC FOR POWER AND CONTROLS TO MONUMENT SIGN. REFERENCE SITE ELECTRIC PLANS FOR RUN TERMINUS AND CIRCUITING REQUIREMENTS.
- 6. TYPICAL INLETS INCLUDE A DEPRESSION AND A GUTTER TRANSITION. CONTRACTOR TO CONFIRM WITH STANDARD INLET DETAIL DEPRESSION INFORMATION PRIOR TO

CONSTRUCTION STAKING.

CLE	CLEARANCE TABLE								
ID	HIGH UTILITY	INVERT	LOW UTILITY	SOFFIT	CLEARANCE				
(A)	12-INCH STORM	6850.19	6-INCH SANITARY	6837.70	12.3-FEET				
B	6-INCH STORM	6849.16	4-INCH SANITARY	6847.35	1.6-FEET				
$\langle \hat{\mathbf{C}} \rangle$	4-INCH STORM	6850.83	4-INCH SANITARY	6845.60	5.0-FEET				
					•				

LST00067 Drawn By: Checked By

UTILITY PLAN

1755 Telstar Drive, Suite 107

Colorado Springs, Co 80920


O2017. Galloway & Company, Inc. All Rights Reserve

719.900.7220 O

www.gallowayUS.com

THESE PLANS ARE AN INSTRUMENT OF SERVICE AND ARE THE PROPERTY OF GALLOWAY, AND MAY NOT BE DUPLICATED, DISCLOSED, OR REPRODUCED WITHOUT THE WRITTEN CONSENT OF GALLOWAY. COPYRIGHTS AND INFRINGEMENTS WILL BE ENFORCED AND PROSECUTED.

0 3/27/18 CLIENT SET __4/6/18 __SDP SET

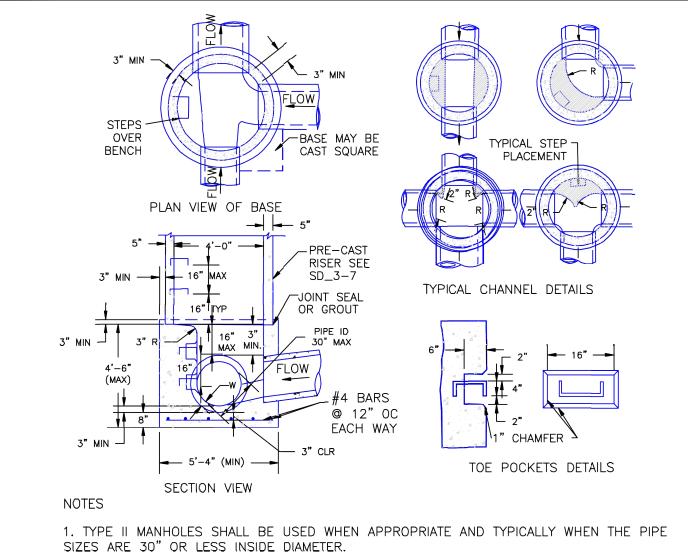

2. VIEW AND DETAILS ARE TYPICAL. DESIGN ENGINEER SHALL DETERMINE MANHOLE BASE CONFIGURATION AND DIMENSIONS FOR PARTICULAR PIPE SIZES AND ALIGNMENT.

3. EITHER LADDER OF STEPS SHALL BE INSTALLED WHEN MANHOLE DEPTH EXCEEDS 30". STEPS IN BASE SHALL BE INSTALLED IN "TOE POCKETS" (SEE DETAIL THIS SHEET). LOWEST STEP SHALL BE A MAXIMUM OF 16" ABOVE THE FLOOR.


4. PIPES SHALL BE TRIMMED TO FINAL SHAPE AND SET BEFORE MANHOLE IS POURED. 5. BENCH SHALL BE SLOPED TOWARD CENTER OF MANHOLE BASE (4:1 MAX., 1/2" PER


6. FLOOR OF MANHOLE SHALL BE TROWELLED TO A SMOOTH, HARD SURFACE AND SHALL SLOPE TOWARDS THE OUTLET (8:1., $\frac{1}{2}$ " PER FT. MIN.) . FLOOR SHALL BE SHAPED AND CHANNELED; SEE DETAILS THIS SHEET.

SCALE: NOT TO SCALE

	Storm	Sewer	Manhole	Detail	
DATE APPROVED:		Ту	pe II		4
Andrá D. Dradin		Standar	d Drawing		DEP
_ André P. Brackin	REVISION DATE:		FILE NAME:		
DEPARTMENT OF TRANSPORTATION	11/1	0/04	SD 3	3-2	

FOOT. MIN.).

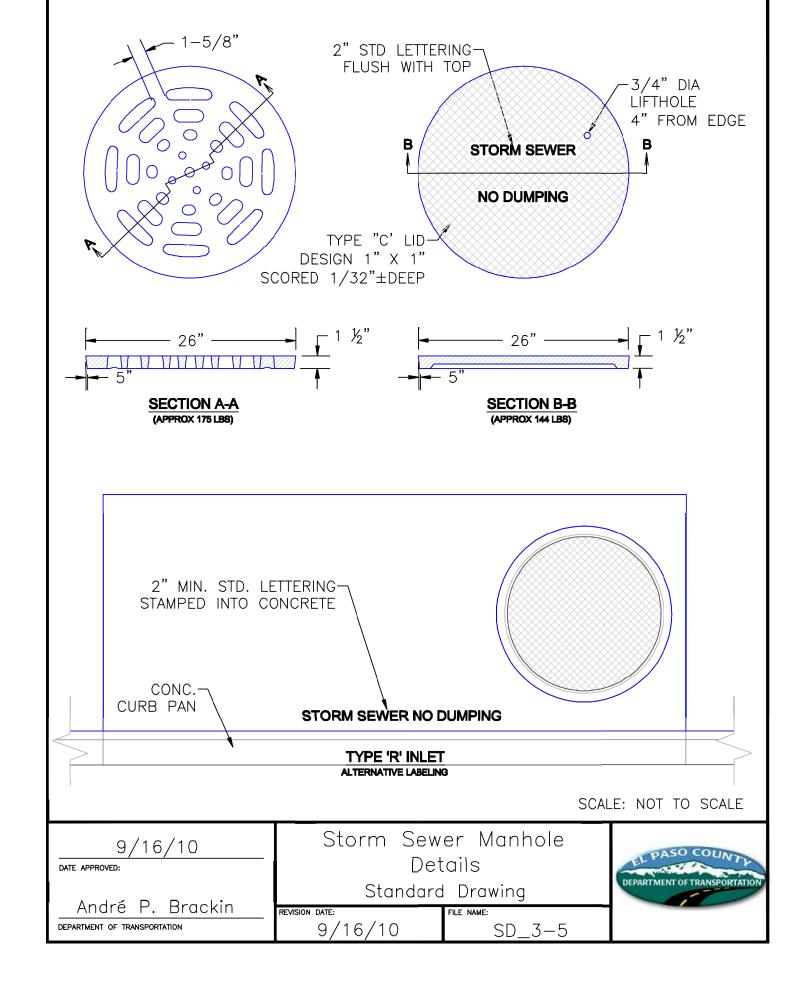

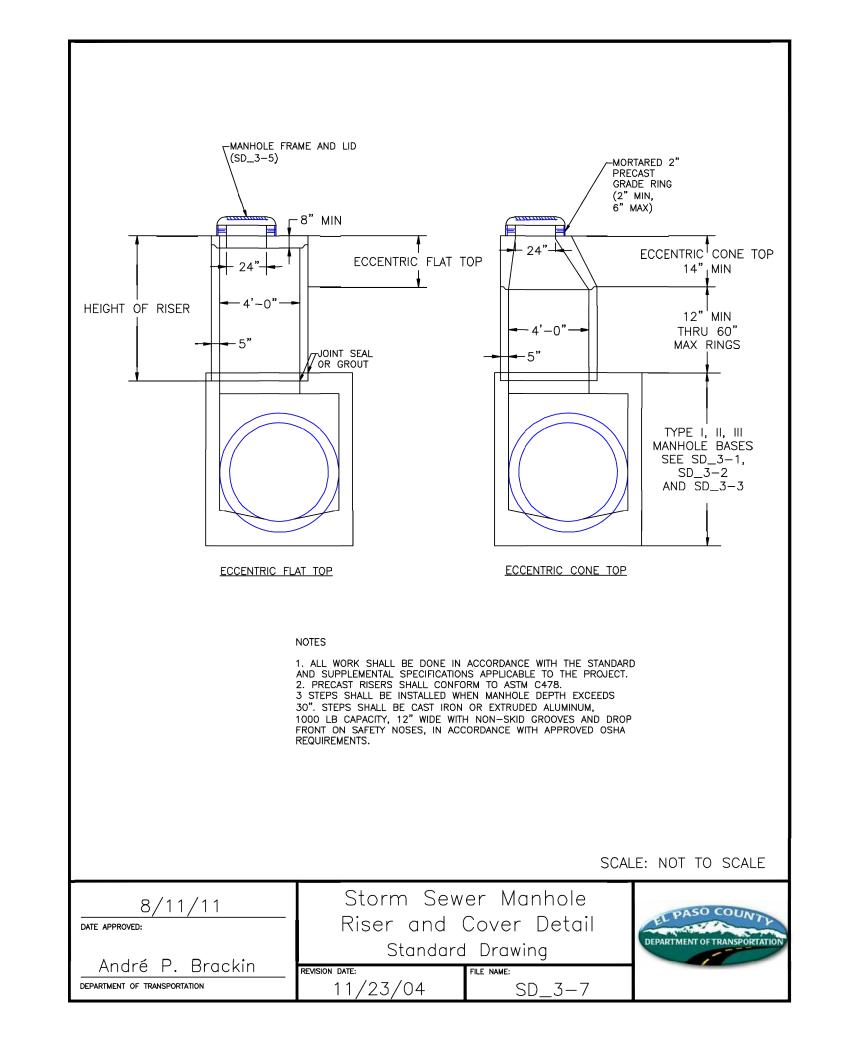



Colorado Springs, Co 80920 719.900.7220 O www.gallowayUS.com O2017. Galloway & Company, Inc. All Rights Reserved





COPYRIGHT THESE PLANS ARE AN INSTRUMENT OF SERVICE AND ARE THE PROPERTY OF GALLOWAY, AND MAY NOT BE DUPLICATED, DISCLOSED, OR REPRODUCED WITHOUT THE WRITTEN CONSENT OF GALLOWAY. COPYRIGHTS AND INFRINGEMENTS WILL BE ENFORCED AND PROSECUTED.

0 3/27/18 CLIENT SET 1 4/6/18 SDP SET

Date Issue / Description Init.

UTILITY DETAILS

LES SCHWAB TIRE CENTER ±12,589 SF S 3.5 2.0 2.2 1.8 2.5 W@ 18' 0.2 0.1 0.1 0.1 0.1 0.1 0.1 0.2 0.2 0.2 0.2 0.2 0.2 0.2 0.2 0.3 0.3 0.3 0.5 0.7 1.0 1.1 1.1 1.3 1.6 1.4 1.1 1.1 1.0 0.9 1.1 1.3 1.3 1.9 2.0 2.1 2.6 2.6 3.0 2.3 1.8 1.4 1.0 0.8 0.9 0.9 0.8 0.7 0.2 0.0 0.0 0.0

0	10	20	

SCALE: 1"=20'

CALCULATION SUMMARY (FC)					
LABEL	AVG	MAX	MIN	AVG/MIN	
PARKING	1.87	3.50	0.70	2.67	
DRIVEWAY	0.97	7.10	0.10	9.70	

			(SITE LIGH	TING SC	CHEDULE					
MARK	MANUFACTURER	CATALOG NO.	BEAM DISTRIB.	LAMPDATA	VOLTS	FIXTURE QUAN. PER POLE	FIXTURE AND POLE FINISH	MOUNTIN HT. (FT.)	POLE TYPE	DESCRIPTIO N	REMARKS
S	GALLEON	GLEON-AE-01-LED-E1-SL3	IV	LED PROVIDED W FIXTURE	120/277	1	BRONZE	20' - 0"	SSA	PARKING LOT LIGHT	
W	COOPER	XTOR3B	-	LED PROVIDED W/ FIXTURE	120/277	-	BRONZE	14' - 0" U.N.O.	1	BUILDING MOUNTED	

GENERAL NOTES:

a SEE SPECIFICATIONS FOR ADDITIONAL REQUIREMENTS FOR LUMINAIRES, LAMPS, AND BALLASTS.
 b CONTRACTOR TO VERIFY LIGHT FIXTURE CATALOG NUMBER AND INSTALLATION REQUIREMENTS PRIOR TO ORDERING.
 c POLE TYPE DESCRIPTION (ABC): A - SHAPE, R-ROUND, S-SQUARE; B - PROFILE, S-STRAIGHT, T-TAPERED; C - MATERIAL, A-ALUMINUM, S-STEEL







COPYRIGHT

THESE PLANS ARE AN INSTRUMENT OF SERVICE AND ARE THE PROPERTY OF GALLOWAY, AND MAY NOT BE DUPLICATED DISCLOSED, OR REPRODUCED WITHOUT THE WRITTEN CONSENT OF GALLOWAY. COPYRIGHTS AND INFRINGEMENTS WILL BE ENFORCED AND PROSECUTED.

LES SCHWAB TIRE CO.
PLANNING DOCUMENTS
MERIDIAN CROSSING FILING NUMBER '

#	Date	Issue / Description	Init.
0	3/27/18	CLIENT SET	JDP
1	4/6/18	SDP SET	JDP
_			
_			
_			
_	-		
_			
_			

7105 N. MERIDIAN FALCON, COLORA

Project No:	LST00067
Drawn By:	JTH
Checked By:	DNJ
Date:	4/6/2018

PHOTOMETRICS PLAN

PP1.1

REA LIGHT DETAIL	
ALE: NOT TO SCALE	

Know what's **below. Call** before you dig.

CONCRETE LIGHT POLE BASE, SACK-RUBBED WITH SMOOTH FINISH AND CHAMFERED TOP EDGE

----- LED FIXTURE, DARK BRONZE

NOTE: POLE LIGHTS AND BUILDING LIGHTS SHALL BE DOWN CAST FIXTURES. LIGHTS SHALL NOT IMPACT ADJACENT PROPERTIES. (TYP.


— DARK BRONZE POLE


ALL LIGHTS)

CAUTION - NOTICE TO CONTRACTOR

ALL UTILITY LOCATIONS SHOWN ARE BASED ON MAPS PROVIDED BY THE
APPROPRIATE UTILITY COMPANY AND FIELD SURFACE EVIDENCE AT THE TIME OF
SURVEY AND IS TO BE CONSIDERED AN APPROXIMATE LOCATION ONLY. IT IS THE
CONTRACTOR'S RESPONSIBILITY TO FIELD VERIFY THE FIELD LOCATION OF ALL
UTILITIES, PUBLIC OR PRIVATE, WHETHER SHOWN ON THE PLANS OR NOT, PRIOR
TO CONSTRUCTION. REPORT ANY DISCREPANCIES TO THE ENGINEER PRIOR TO
CONSTRUCTION.

2. WHERE A PROPOSED UTILITY CROSSES AN EXISTING UTILITY, IT IS THE CONTRACTOR'S RESPONSIBILITY TO FIELD VERIFY THE HORIZONTAL AND VERTICAL LOCATION OF SUCH EXISTING UTILITY, EITHER THROUGH POTHOLING OR ALTERNATIVE METHOD. REPORT INFORMATION TO THE ENGINEER PRIOR TO CONSTRUCTION.

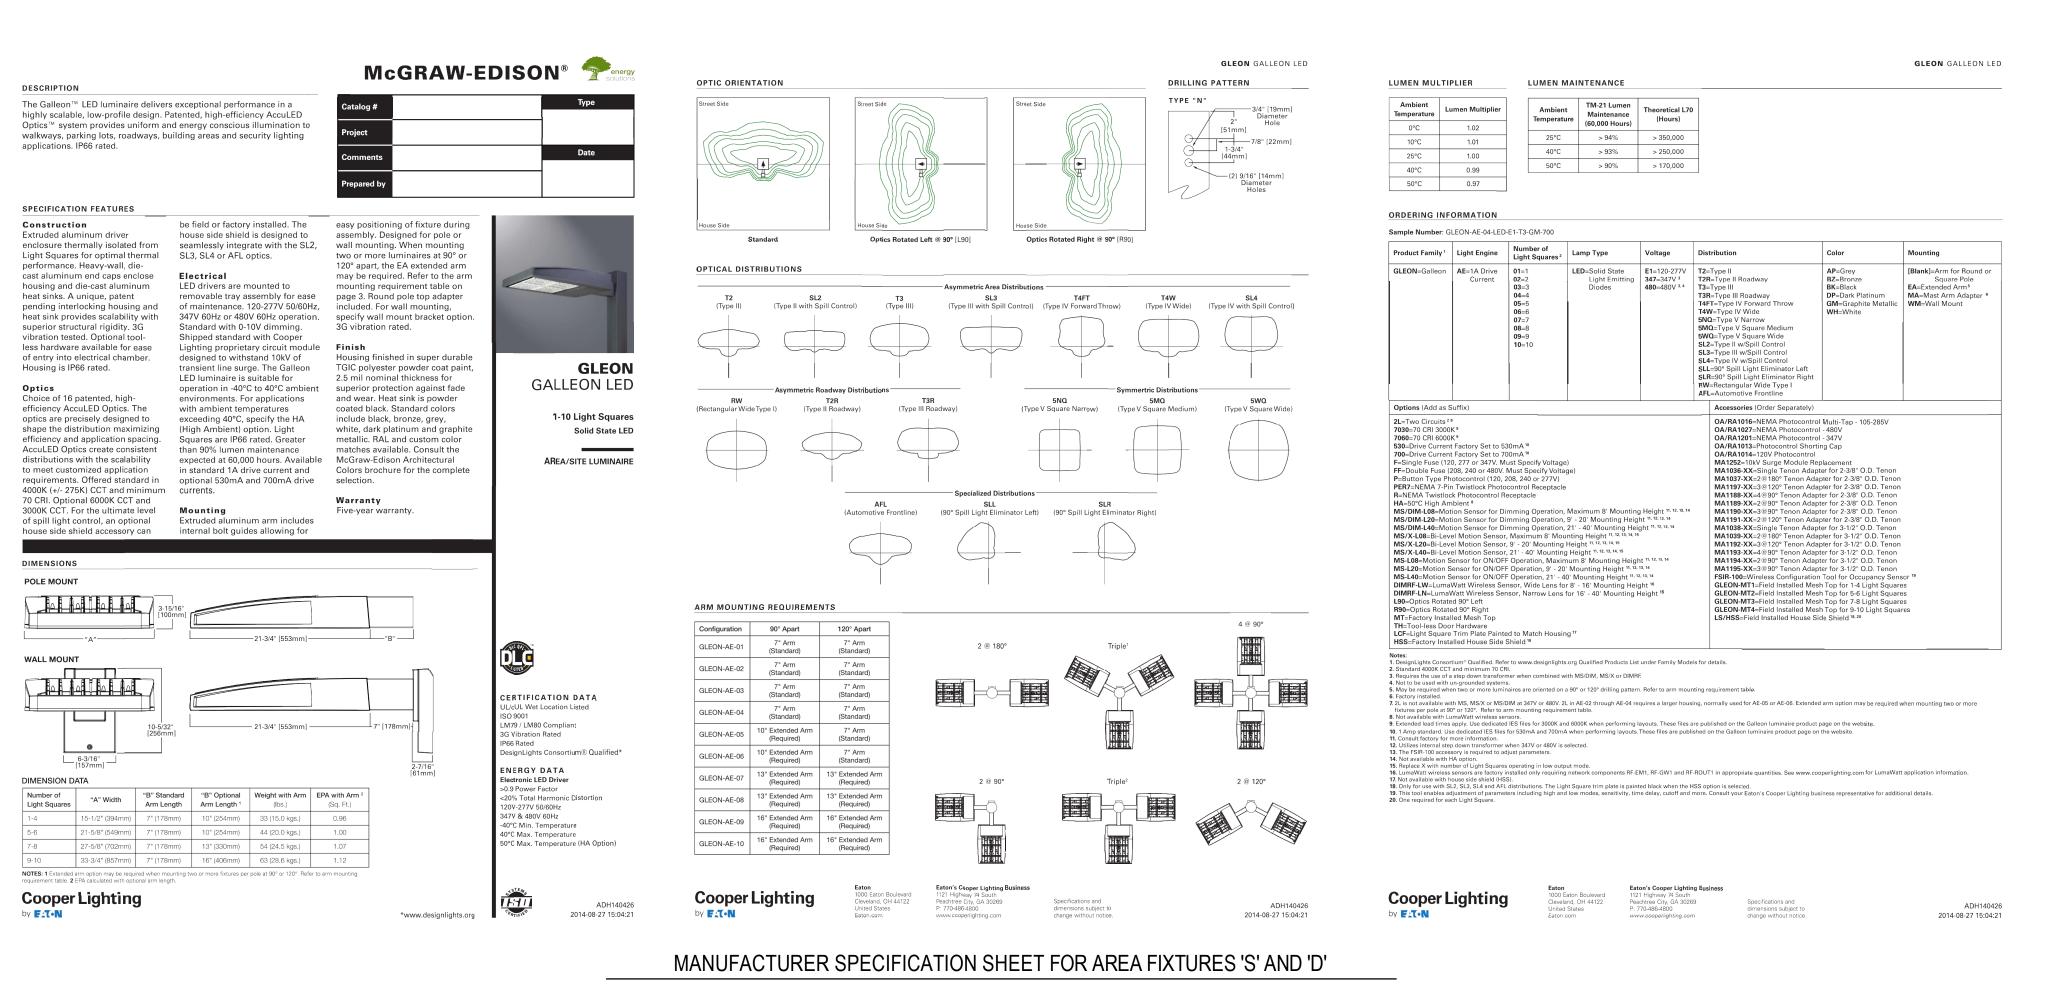

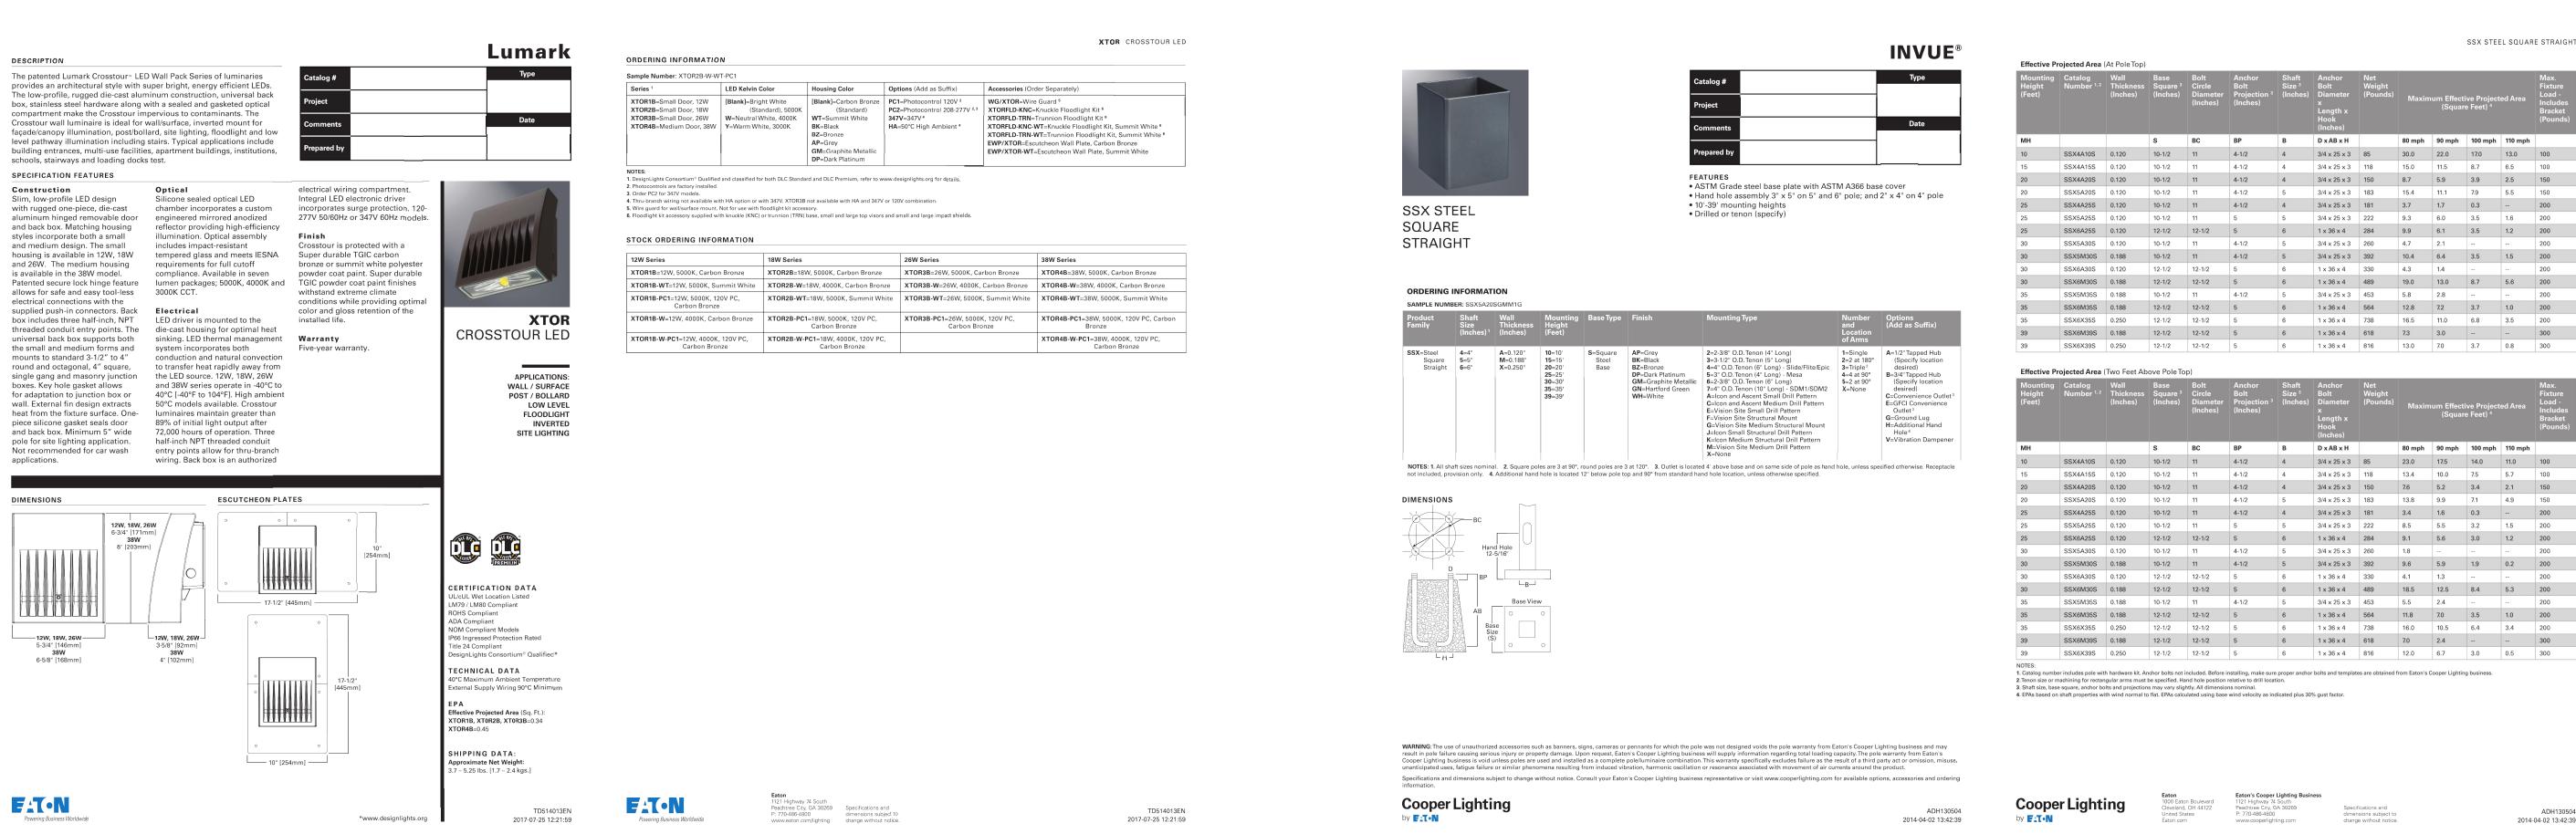

1755 Telstar Drive, Suite 107 Colorado Springs, Co 80920 719.900.7220 O www.gallowayUS.com

O2017. Galloway & Company, Inc. All Rights Reserved


COPYRIGHT THESE PLANS ARE AN INSTRUMENT OF SERVICE AND ARE THE PROPERTY OF GALLOWAY, AND MAY NOT BE DUPLICATED, DISCLOSED, OR REPRODUCED WITHOUT THE WRITTEN CONSENT OF GALLOWAY. COPYRIGHTS AND INFRINGEMENTS WILL BE ENFORCED AND PROSECUTED.

ES SCHWALLANNING AERIDIAN COT 3 AND 4 A

Date Issue / Description **0** 3/27/18 CLIENT SET 1 4/6/18 SDP SET JDP

LST00067 Checked By: DNJ 4/6/2018

PHOTOMETRICS DETAILS

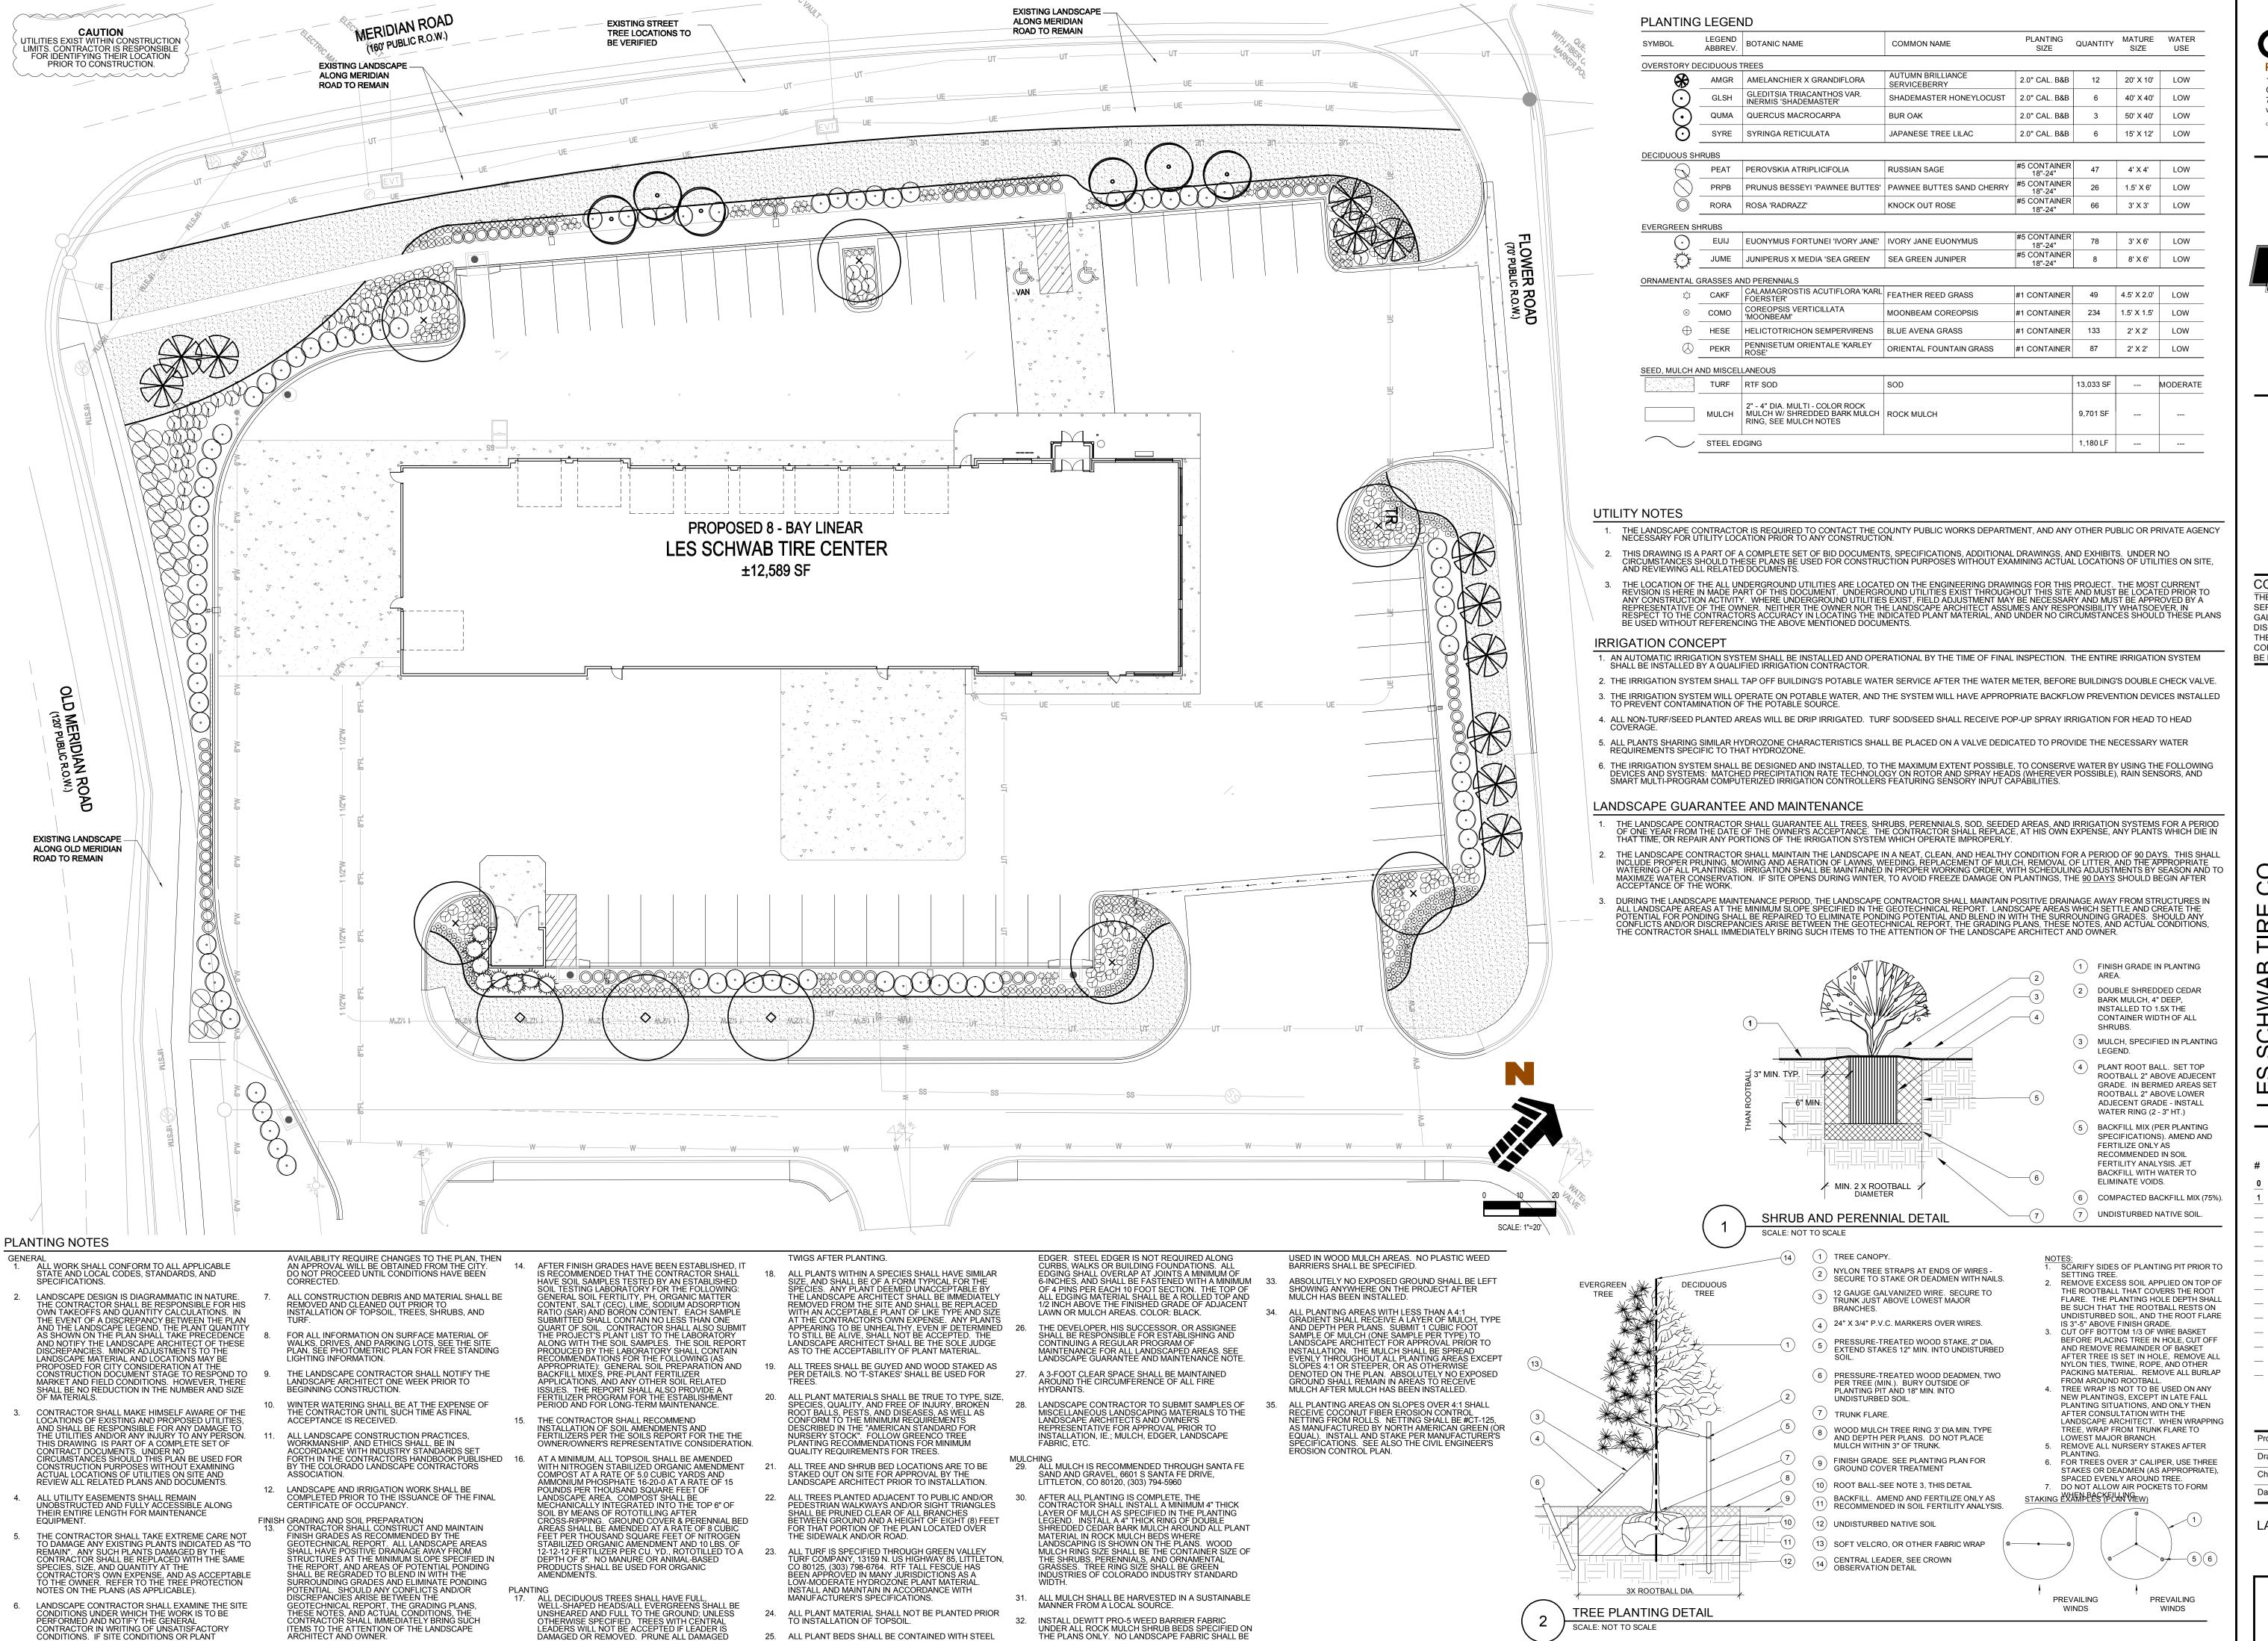

CONTRACTOR IN WRITING OF UNSATISFACTORY

CONDITIONS. IF SITE CONDITIONS OR PLANT

ITEMS TO THE ATTENTION OF THE LANDSCAPE ARCHITECT AND OWNER.

DAMAGED OR REMOVED. PRUNE ALL DAMAGED

25. ALL PLANT BEDS SHALL BE CONTAINED WITH STEEL

SCALE: NOT TO SCALE

1755 Telstar Drive, Suite 107 Colorado Springs, Co 80920 719.900.7220 O www.gallowayUS.com O2017. Galloway & Company, Inc. All Rights Reserv



COPYRIGHT THESE PLANS ARE AN INSTRUMENT OF SERVICE AND ARE THE PROPERTY OF GALLOWAY, AND MAY NOT BE DUPLICATED, DISCLOSED, OR REPRODUCED WITHOUT THE WRITTEN CONSENT OF GALLOWAY. COPYRIGHTS AND INFRINGEMENTS WILL

BE ENFORCED AND PROSECUTED.

TIRE C CUMEN OSSINC S SCHW/ NNING RIDIAN

Date Issue / Description 0 3/27/18 CLIENT SET 1 4/6/18 SDP SET

49

LST00067 Checked By JDP 4/6/2018

LANDSCAPE PLAN

Markup Summary

dsdnijkamp (9)



Subject: Cloud+ Page Label: 2 Lock: Locked Status:

Checkmark: Unchecked Author: dsdnijkamp Date: 5/7/2018 7:48:36 AM

Color:

provide pedestrian ramp.



Subject: Arrow Page Label: 3 Lock: Locked Status:

Checkmark: Unchecked Author: dsdnijkamp

Date: 5/7/2018 7:49:21 AM

Color:



Subject: Text Box Page Label: 3 Lock: Locked Status:

Checkmark: Unchecked Author: dsdnijkamp Date: 5/7/2018 7:48:39 AM

Color:

Please call out all adjacent property owners or platted name for all lots adjacent to the two/one

you are developing.



Subject: Callout Page Label: 3 Lock: Locked Status:

Checkmark: Unchecked Author: dsdnijkamp Date: 5/7/2018 7:48:40 AM

Color:

provide appropriate signs for right turn only (or no left turn).



Subject: Text Box Page Label: 3 Lock: Locked Status:

Checkmark: Unchecked Author: dsdnijkamp Date: 5/7/2018 7:48:37 AM

Color:

Sidewalk will be required adjacent to Meridian Road to connect a pedestrian path for the entire length of your lot. If you keep the current configuration you will need to provide a larger public improvement easement on the plat. You will also need to connect to the drive entrance to the east. This would make this a public sidewalk. Please reference County criteria and try and place this walk closer to the C&G.



Subject: Callout Page Label: 3 Lock: Locked Status:

Checkmark: Unchecked Author: dsdnijkamp Date: 5/7/2018 7:48:41 AM

Color:



Subject: Callout Page Label: 3

Lock: Locked Status:

Checkmark: Unchecked Author: dsdnijkamp Date: 5/7/2018 7:48:42 AM

Color:

pedestrian ramp needed.



Subject: Callout Page Label: 7 Lock: Locked Status:

Checkmark: Unchecked Author: dsdnijkamp Date: 5/7/2018 7:49:12 AM

Color:



Subject: Text Box Page Label: 7 Lock: Locked

Status:

Checkmark: Unchecked Author: dsdnijkamp Date: 5/7/2018 7:48:46 AM

Color:

Please call all GEC plan sheets in this set as preliminary grading plan.

note that this plan is not being reviewed as the

official GEC plan.

dsdsevigny (3)



Subject: Text Box Page Label: 1 Lock: Locked Status:

Checkmark: Unchecked Author: dsdsevigny Date: 5/7/2018 7:49:10 AM

Color:

The following note should be added to all site development plans or non-residential site plans, as applicable, prior to PCD approval:

The parties responsible for this plan have familiarized themselves with all current accessibility criteria and specifications and the proposed plan reflects all site elements required by the applicable ADA design standards and guidelines as published by the United States Department of Justice. Approval of this plan by El Paso County does not assure compliance with the ADA or any regulations or guidelines enacted or promulgated under or with respect to such laws.

A separate ADA route sheet needs to be included in the submittal application



Subject: Text Box Page Label: 3 Lock: Locked Status:

Checkmark: Unchecked Author: dsdsevigny Date: 5/7/2018 7:48:56 AM

Color:

Measurements to all property lines required



Subject: Text Box Page Label: 3 Lock: Locked Status:

Checkmark: Unchecked Author: dsdsevigny Date: 5/7/2018 7:48:57 AM

Color:

Please provide the required parking spaces by the LDC and the amount of parking provided along

with ADA parking.