

LANDSCAPE SETBACKS (LS)						
STREET NAME OR ZONE BOUNDARY (ELEV.)	STREET CLASSIFICATION	WIDTH (FT.) REQ./PROV.	LINEAR FOOTAGE	TREE/FEET REQUIRED	NO. OF TREES REQ./PROVIDED	SHRUB SUBSTITUTION REQ./PROVIDED
MEADOWBROOK	NON-ARTERIAL	10/10 FT	285	1/30 FT	10/7	30/30

MOTOR VEHICLE LOTS (MV)			
NO. OF VEHICLE SPACES PROVIDED	SHADE TREES (1/15 SPACES) REQ./PROV.	VEHICLE LOT FRONTAGE(S)	2/3 LENGTH OF FRONTAGE (FT)
16	1/1	NA	NA
MIN. 3' SCREENING PLANTS REQ./PROV.	EVERGREEN PLANTS REQ. 50%/PROV.		
NA	NA		

INTERNAL LANDSCAPING (IL)			
INTERNAL LANDSCAPE AREA INCLUDES ALL LANDSCAPE AREAS NOT INCLUDING SETBACKS, BUFFERS OR MOTOR VEHICLE ISLANDS.			
NET SITE AREA (SF) (LESS PUBLIC R.O.W.)	PERCENT MINIMUM INTERNAL AREA (5%)	INTERNAL AREA (SF) REQ./PROV.	INTERNAL TREES (1/500 SF) (EXCLUDING DRIVEWAYS)
37,905 SF	NON-RESIDENTIAL	1895/1900	4/4
SHRUB SUBSTITUTES (50%) REQ./PROV.	INTERNAL PLANT ABBR. DENOTED ON PLAN	PERCENT GROUND PLANE VEG. REQ./PROV.	
0	IL	50%/50%	


LANDSCAPE BUFFERS AND SCREENS (LS)				
STREET NAME OR PROPERTY LINE (ELEV.)	LINEAR FOOTAGE: 134 LF NORTH	SETBACK BUFFER REQ. / PROV.FENCE	BUFFER TREES (1/20') REQ./PROV. - NA	EVERGREEN TREES (1/3) REQ./PROV. - NA
OPAQUE FENCE REQUIREMENT: 6' HT. CHAINLINK FENCE WITH PVC SLATS ALONG ENTIRE NORTH BOUNDARY FOR BUFFER REQUIREMENT				
ALTERNATIVE BUFFER: NO TREES, WITH SCREEN FENCE AS NOTED				

CODE REQUIREMENTS

PLANT SCHEDULE

Symbol	Abbr.	Botanical Name	Common Name	Mature WidthX HT.	Planting Size
DECIDUOUS TREES:					
+	GTSB	5	Gleditsia triacanthos 'Sunburst'	Sunburst Honeylocust	30'X30'
	MS	5	Malus Spring Snow'	Spring Snow Crabapple	15'X15'
	CH	4	Crataegus crus-galli inermis 'Hawthorn'	Cockspur Hawthorn	20'X15'
EVERGREEN SHRUBS:					
☼	JA	11	Juniperus sabina 'Sierra Spreader'	Sierra Spreader Juniper	6-8'X18'
DECIDUOUS SHRUBS:					
⊙	PO	16	Spiraea x bumalda 'Goldflame'	Goldflame Spirea	3-4' x 2-3'
	SJ	17	Spiraea japonica 'Majic Carpet'	Majic Carpet, Spirea	1-2' x 1-2'
ORNAMENTAL GRASSES:					
⊙	CA	24	Calamagrostis acutiflora 'Karl Foerster'	Feather Reed Grass	1-3' x 2-3'

NOTE: QUANTITIES SHOWN IN SCHEDULE ARE FOR CONVENIENCE ONLY. CONTRACTOR IS RESPONSIBLE FOR INSTALLING ALL MATERIALS PER PLAN.

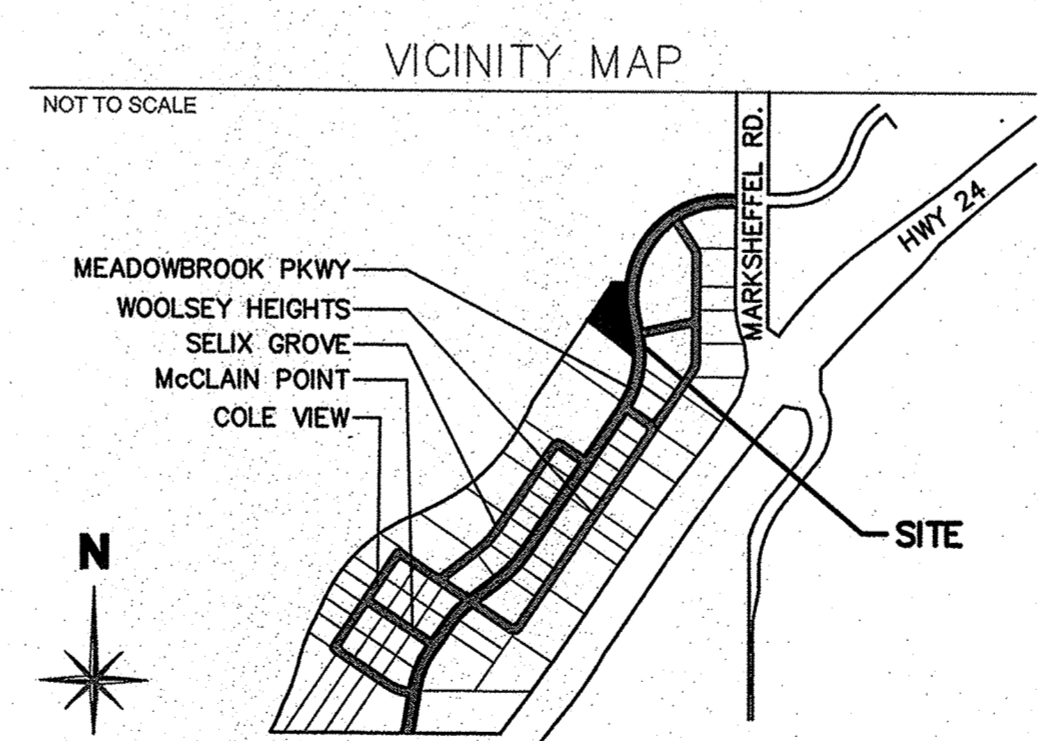

GROUND COVER LEGEND		
SYMBOL	DESCRIPTION	APPROX. SF
Blue/Gray River Rock: 2-4" Diameter (with weed barrier)	Verify Rock Type with Owner. Submit sample to Owner.	4,288 SF
Denver Granite: 1.5" Diameter (with weed barrier)	Verify Rock Type with Owner. Submit sample to Owner.	2,201 SF

NOTE: QUANTITIES SHOWN IN LEGEND ARE FOR CONVENIENCE ONLY. CONTRACTOR IS RESPONSIBLE FOR INSTALLING ALL MATERIALS PER PLAN.

LAYOUT NOTE

CONTRACTOR IS RESPONSIBLE FOR INSTALLING ALL LANDSCAPE SHOWN ON THIS PLAN. ANY DEVIATIONS FROM THIS PLAN ARE TO BE APPROVED BY OWNER'S REPRESENTATIVE OR LANDSCAPE ARCHITECT. DEVIATIONS FROM THE APPROVED PLAN WILL REQUIRE APPROVAL BY EL PASO COUNTY AND OWNER REPRESENTATIVE.

UTILITIES NOTE

VERIFY LOCATION AND DEPTH OF ALL UNDERGROUND UTILITIES PRIOR TO START OF WORK. CALL 811 FOR UTILITY LOCATES. ANY CONFLICT BETWEEN TREE LOCATIONS AND UTILITIES SHOWN ON PLANS SHALL BE RESOLVED WITH GENERAL CONTRACTOR PRIOR TO PLANTING. ALL ELECTRICAL VAULTS AND TRANSFORMERS SHALL BE KEPT CLEAR FROM PLANT MATERIAL PER LOCAL CODE AND ALL SHRUBS TO BE LOCATED MINIMUM 3' CLEAR OF ALL FIRE HYDRANTS AT MATURE SIZE. REFER TO LOCAL CODES.

DOCUMENT NOTE

IRRESPECTIVE OF ANY OTHER TERM IN THIS DOCUMENT, LANDSCAPE ARCHITECT SHALL NOT CONTROL OR BE RESPONSIBLE FOR CONSTRUCTION MEANS, METHODS, TECHNIQUES, SCHEDULES, SEQUENCES OR PROCEDURES, OR FOR CONSTRUCTION SAFETY OR ANY OTHER RELATED PROGRAMS, OR FOR ANY OTHER PARTIES' ERRORS OR OMISSIONS OR FOR ANOTHER PARTIES' FAILURE TO COMPLETE THEIR WORK OR SERVICES IN ACCORDANCE WITH LANDSCAPE ARCHITECT'S DOCUMENTS.

NOT FOR CONSTRUCTION OR PERMIT REVIEW. ORIGINAL DRAWINGS DONE BY HIGHER GROUND LANDSCAPE DESIGN FOR HAMMERS CONSTRUCTION. THESE DRAWINGS ONLY REPRESENT AS-BUILT SITE CONDITIONS FOR PLANNING REVIEW OF INSTALLED LANDSCAPE COVERAGE

1190 MEADOWBROOK PKWY
COLORADO SPRINGS, CO
EL PASO COUNTY, COLORADO

PREPARED FOR:
HAMMERS CONSTRUCTION

APPROVED FOR CONSTRUCTION

DATE: DEC 2 1 2018

REVISIONS	
9-10-18	PER COMMENTS
10-18-18	PER COMMENTS

ORIGINAL DATE 7-2-18

DRAWN BY JLM

DESCRIPTION LANDSCAPE PLAN