
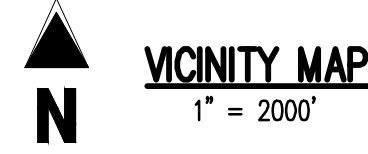


FALCON RANCHETTES FILING NO. 1A

A REPLAT OF LOTS 1 & 2, FALCON RANCHETTES
 LOCATED IN THE SOUTHEAST QUARTER OF SECTION 1,
 TOWNSHIP 13 SOUTH, RANGE 65 WEST OF THE 6TH PRINCIPAL MERIDIAN,
 COUNTY OF EL PASO, STATE OF COLORADO

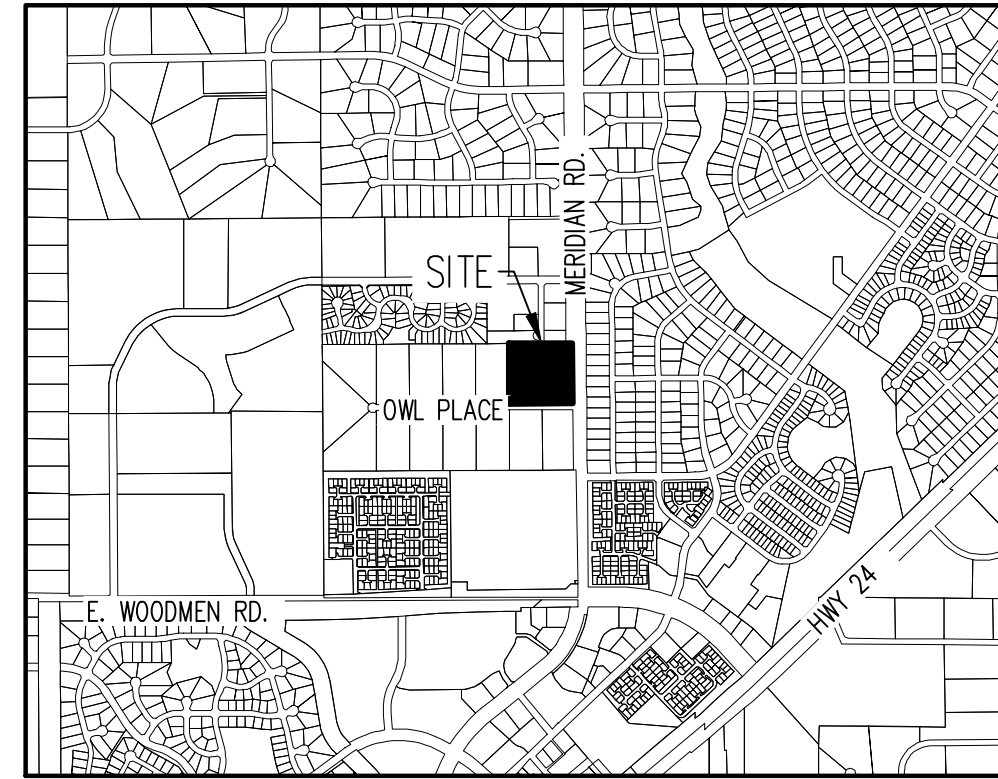

The Soil and Geology Conditions note on the Final Plat should be updated to reference UES's 2/22/2024 report.

BE IT KNOWN BY THESE PRESENTS:

THAT MIKE D. TEXER, AND BRITTANY A. TEXER, BEING THE OWNERS OF THE FOLLOWING DESCRIBED TRACT OF LAND TO WIT:

LEGAL DESCRIPTION:

A PARCEL OF LAND IN THE SOUTHEAST QUARTER OF SECTION 1, TOWNSHIP 13 SOUTH, RANGE 65 WEST, OF THE SIXTH PRINCIPAL MERIDIAN, COUNTY OF EL PASO, STATE OF COLORADO, MORE PARTICULARLY DESCRIBED AS FOLLOWS:

LOTS 1 & 2, FALCON RANCHETTES, ACCORDING TO THE PLAT THEREOF RECORDED IN PLAT BOOK V-2, PAGE 15, OF THE RECORDS OF EL PASO COUNTY, COLORADO.

CONTAINING 9.604 ACRES, MORE OR LESS.

DEDICATION:

THE UNDERSIGNED OWNER HAS CAUSED SAID TRACT OF LAND TO BE PLATTED INTO LOTS, PUBLIC RIGHT OF WAY AND EASEMENTS AS SHOWN HEREON. THE UNDERSIGNED DOES HEREBY DEDICATE, GRANT AND CONVEY TO THE COUNTY OF EL PASO ALL STREETS AND EASEMENTS FOR PUBLIC USE. THIS TRACT OF LAND AS PLATTED HEREIN SHALL BE KNOWN AS "FALCON RANCHETTES FILING NO. 1A" IN THE COUNTY OF EL PASO, COLORADO.

OWNER'S CERTIFICATE(S):

THE UNDERSIGNED, BEING ALL THE OWNERS, MORTGAGEES, BENEFICIARIES OF DEEDS OF TRUST AND HOLDERS OF OTHER INTERESTS IN THE LAND DESCRIBED HEREIN, HAVE LAID OUT, SUBDIVIDED, AND PLATTED SAID LANDS INTO LOTS, TRACTS, STREETS, AND EASEMENTS AS SHOWN HEREON UNDER THE NAME AND SUBDIVISION OF FALCON RANCHETTES FILING NO. 1A. ALL PUBLIC IMPROVEMENTS SO PLATTED ARE HEREBY DEDICATED TO PUBLIC USE AND SAID OWNER DOES HEREBY COVENANT AND AGREE THAT THE PUBLIC IMPROVEMENTS WILL BE CONSTRUCTED TO EL PASO COUNTY STANDARDS AND THAT PROPER DRAINAGE AND EROSION CONTROL FOR SAME WILL BE PROVIDED AT SAID OWNER'S EXPENSE, ALL TO THE SATISFACTION OF THE BOARD OF COUNTY COMMISSIONERS OF EL PASO COUNTY, COLORADO. UPON ACCEPTANCE BY RESOLUTION, ALL PUBLIC IMPROVEMENTS SO DEDICATED WILL BECOME MATTERS OF MAINTENANCE BY EL PASO COUNTY, COLORADO. THE UTILITY EASEMENTS SHOWN HEREON ARE HEREBY DEDICATED FOR PUBLIC UTILITIES AND COMMUNICATION SYSTEMS AND OTHER PURPOSES AS SHOWN HEREON. THE ENTITIES RESPONSIBLE FOR PROVIDING THE SERVICES FOR WHICH THE EASEMENTS ARE ESTABLISHED ARE HEREBY GRANTED THE PERPETUAL RIGHT OF INGRESS AND EGRESS FROM AND TO ADJACENT PROPERTIES FOR INSTALLATION, MAINTENANCE, AND REPLACEMENT OF UTILITY LINES AND RELATED FACILITIES.

OWNER:

THE AFOREMENTIONED, MIKE D. TEXER, HAVE EXECUTED THIS INSTRUMENT THIS ____DAY OF _____, 20____

BY: _____
 MIKE D. TEXER

STATE OF COLORADO)
) SS
 COUNTY OF EL PASO)

THE FOREGOING INSTRUMENT WAS ACKNOWLEDGED BEFORE ME THIS ____DAY OF _____, 20____ BY MIKE D. TEXER.

MY COMMISSION EXPIRES: _____

WITNESS MY HAND AND OFFICIAL SEAL,

NOTARY PUBLIC

OWNER:

THE AFOREMENTIONED, BRITTANY A. TEXER, HAVE EXECUTED THIS INSTRUMENT THIS ____DAY OF _____, 20____

BY: _____
 BRITTANY A. TEXER

STATE OF COLORADO)
) SS
 COUNTY OF EL PASO)

THE FOREGOING INSTRUMENT WAS ACKNOWLEDGED BEFORE ME THIS ____DAY OF _____, 20____ BY BRITTANY A. TEXER.

MY COMMISSION EXPIRES: _____

WITNESS MY HAND AND OFFICIAL SEAL,

NOTARY PUBLIC

BOARD OF COUNTY COMMISSIONERS CERTIFICATE:

THIS PLAT FOR FALCON RANCHETTES FILING NO. 1A WAS APPROVED BY THE BOARD OF COUNTY COMMISSIONERS OF EL PASO COUNTY, COLORADO ON _____ DAY OF _____, 20____, SUBJECT TO ANY NOTES OR ANY CONDITIONS INCLUDED IN THE RESOLUTION OF APPROVAL. THE BOARD OF COUNTY COMMISSIONERS HAS REVIEWED THE PLAT AND THE PUBLIC IMPROVEMENTS THEREON WILL NOT BECOME THE MAINTENANCE RESPONSIBILITY OF EL PASO COUNTY UNTIL PRELIMINARY ACCEPTANCE OF THE PUBLIC IMPROVEMENTS WITH THE REQUIREMENTS OF THE LAND DEVELOPMENT ENGINEERING CRITERIA MANUAL, AND THE SUBDIVISION IMPROVEMENTS AS SHOWN ON THE PLAT.

PREVIOUS PLAT NAME IN ENTIRETY IS VACATED AND AMENDED AS DESCRIBED BY THIS REPLAT SUBJECT TO ALL COVENANTS, CONDITIONS, AND EASEMENTS SHOWN ON THE PLAT. WATER AND WASTEWATER SERVICE FOR THIS SUBDIVISION IS PROVIDED BY THE WOODMEN HILLS METRO DISTRICT, SUBJECT TO THE DISTRICT'S RULES, REGULATIONS AND SPECIFICATIONS. (Combined note, which can be broken into separate notes for water or sewer in the case of different providers)

 CHAIR, BOARD OF COUNTY COMMISSIONERS

SOIL AND GEOLOGY CONDITIONS:

GEOLOGIC HAZARD NOTE:
 LOTS 1 AND 2 OF FALCON RANCHETTES FILING NO. 1A HAVE BEEN FOUND TO BE IMPACTED BY GEOLOGIC HAZARDS. MITIGATION MEASURES AND A MAP OF THE HAZARD AREA CAN BE FOUND IN THE REPORT "GEOTECHNICAL EXPLORATION REPORT - MERIDIAN STORAGE, 11690 AND 11750 OWL PLACE" BY UNIVERSAL ENGINEERING SCIENCES, DATED APRIL 18, 2023 AND REVISED JUNE 21, 2023 IN FILE FALCON RANCHETTES FILING NO. 1A, VR239, AVAILABLE AT THE EL PASO COUNTY PLANNING AND COMMUNITY DEVELOPMENT DEPARTMENT:

- COLLAPSIBLE AND EXPANSIVE SOILS (LOTS 1 & 2)
- FLOODING (LOTS 1 AND 2)

NO GROUNDWATER WAS ENCOUNTERED DURING DRILLING, IT IS NOT ANTICIPATED TO IMPACT THE PROPOSED DEVELOPMENT.

WASTEWATER:

SEWAGE TREATMENT IS THE RESPONSIBILITY OF EACH INDIVIDUAL PROPERTY OWNER. THE EL PASO COUNTY DEPARTMENT OF HEALTH AND ENVIRONMENT MUST APPROVE EACH SYSTEM AND, IN SOME CASES THE DEPARTMENT MAY REQUIRE AN ENGINEER DESIGNED SYSTEM PRIOR TO PERMIT APPROVAL. THESE SYSTEMS MAY COST MORE TO DESIGN, INSTALL, AND MAINTAIN.

SOILS AND GEOLOGY CONDITIONS ON SITE REQUIRE THAT ALL (OR CERTAIN LOTS) ON-SITE WASTEWATER SYSTEMS SHALL BE LOCATED AND DESIGNED BY A PROFESSIONAL ENGINEER, CURRENTLY REGISTERED IN THE STATE OF COLORADO.

WATER AND WASTEWATER SERVICE FOR THIS SUBDIVISION IS PROVIDED BY THE WOODMEN HILLS METRO DISTRICT, SUBJECT TO THE DISTRICT'S RULES, REGULATIONS AND SPECIFICATIONS.

UTILITIES:

THE SUBDIVIDER/DEVELOPER IS RESPONSIBLE FOR EXTENDING UTILITIES TO EACH LOT, TRACT OR BUILDING SITE.

GAS FOR THIS SUBDIVISION IS PROVIDED BY BLACK HILLS ENERGY, SUBJECT TO THE PROVIDER'S RULES, REGULATIONS AND SPECIFICATIONS.

ELECTRIC SERVICE FOR THIS SUBDIVISION IS PROVIDED BY MOUNTAIN VIEW ELECTRIC ASSOCIATION, SUBJECT TO THE PROVIDER'S RULES, REGULATIONS AND SPECIFICATIONS.

PLAT NOTES:

1. THE PURPOSE OF THIS PLAT IS TO CREATE 2 NEW LOTS, A TRACT, PUBLIC RIGHT OF WAY AND EASEMENTS.
2. FIELD WORK COMPLETED ON: NOVEMBER 11, 2022.
3. ALL DISTANCES SHOWN ON THIS MAP ARE U.S. SURVEY FEET.
4. ACCESS NOTE: NO DRIVEWAY SHALL BE ESTABLISHED UNLESS AN ACCESS PERMIT HAS BEEN GRANTED BY EL PASO COUNTY.
5. MAILBOXES: MAILBOXES SHALL BE INSTALLED IN ACCORDANCE WITH ALL EL PASO COUNTY AND UNITED STATES SERVICE REGULATIONS.
6. PUBLIC AND COMMON SUBDIVISION IMPROVEMENTS: NO LOT OR INTEREST THEREIN, SHALL BE SOLD, CONVEYED, OR TRANSFERRED WHETHER BY DEED OR BY CONTRACT, NOR SHALL BUILDING PERMITS BE ISSUED, UNTIL AND UNLESS EITHER THE REQUIRED PUBLIC AND COMMON DEVELOPMENT IMPROVEMENTS HAVE BEEN CONSTRUCTED AND COMPLETED AND PRELIMINARILY ACCEPTED IN ACCORDANCE WITH THE SUBDIVISION IMPROVEMENTS AGREEMENT BETWEEN THE APPLICANT/OWNER AND EL PASO COUNTY AS RECORDED UNDER RECEPTION NUMBER _____ IN THE OFFICE OF THE CLERK AND RECORDER OF EL PASO COUNTY, COLORADO OR, IN THE ALTERNATIVE, OTHER COLLATERAL IS PROVIDED TO MAKE PROVISION FOR THE COMPLETION OF SAID IMPROVEMENTS IN ACCORDANCE WITH THE EL PASO COUNTY LAND DEVELOPMENT CODE AND ENGINEERING CRITERIA MANUAL. ANY SUCH ALTERNATIVE COLLATERAL MUST BE APPROVED BY THE BOARD OF COUNTY COMMISSIONERS OR, IF PERMITTED BY THE SUBDIVISION IMPROVEMENTS AGREEMENT, BY THE PLANNING AND COMMUNITY DEVELOPMENT DEPARTMENT DIRECTOR AND MEET THE POLICY AND PROCEDURE REQUIREMENTS OF EL PASO COUNTY PRIOR TO THE RELEASE BY THE COUNTY OF ANY LOTS FOR SALE, CONVEYANCE OR TRANSFER. THIS PLAT RESTRICTION MAY BE REMOVED OR RESCINDED BY THE BOARD OF COUNTY COMMISSIONERS OR, IF PERMITTED BY THE SUBDIVISION IMPROVEMENTS AGREEMENT, BY THE PLANNING AND COMMUNITY DEVELOPMENT DEPARTMENT DIRECTOR UPON EITHER APPROVAL OF AN ALTERNATIVE FORM OF COLLATERAL OR COMPLETION AND PRELIMINARY ACCEPTANCE BY THE EL PASO BOARD OF COUNTY COMMISSIONERS OF ALL IMPROVEMENTS REQUIRED TO BE CONSTRUCTED AND COMPLETED IN ACCORDANCE WITH SAID SUBDIVISION IMPROVEMENTS AGREEMENT. THE PARTIAL RELEASE OF LOTS FOR SALE, CONVEYANCE OR TRANSFER MAY ONLY BE GRANTED IN ACCORDANCE WITH ANY PLANNED PARTIAL RELEASE OF LOTS AUTHORIZED BY THE SUBDIVISION IMPROVEMENTS AGREEMENT.
7. WILDFIRE NOTE: AT THE TIME OF APPROVAL OF THIS PROJECT, THIS PROPERTY IS LOCATED WITHIN THE FALCON FIRE PROTECTION DISTRICT. DUE TO WILDFIRE CONCERNS, HOMEOWNERS ARE ENCOURAGED TO INCORPORATE WILDFIRE FUEL BREAK PROVISIONS AS RECOMMENDED BY THE COLORADO STATE FOREST SERVICE AND ILLUSTRATED THROUGH PUBLICATIONS AVAILABLE THROUGH THE STATE FOREST SERVICE.
8. THE ADDRESSES EXHIBED ON THIS PLAT ARE FOR INFORMATIONAL PURPOSES ONLY. THEY ARE NOT THE LEGAL DESCRIPTION AND ARE SUBJECT TO CHANGE.
9. ALL PROPERTY OWNERS ARE RESPONSIBLE FOR MAINTAINING PROPER STORM WATER DRAINAGE IN AND THROUGH THEIR PROPERTY. PUBLIC DRAINAGE EASEMENTS AS SPECIFICALLY NOTED ON THE PLAT SHALL BE MAINTAINED BY THE INDIVIDUAL LOT OWNERS UNLESS OTHERWISE INDICATED. STRUCTURES, FENCES, MATERIALS OR LANDSCAPING THAT COULD IMPEDE THE FLOW OF RUNOFF SHALL NOT BE PLACED IN DRAINAGE EASEMENTS.
10. THIS PLAT HAS BEEN CHECK BY PPRBD, THE STAMPED APPROVAL IS RECORDED AT RECEPTION NUMBER _____
11. ENVIRONMENTAL: DEVELOPER SHALL COMPLY WITH FEDERAL AND STATE LAWS, REGULATIONS, ORDINANCES, REVIEW AND PERMIT REQUIREMENTS, AND OTHER AGENCY REQUIREMENTS, IF ANY, OF APPLICABLE AGENCIES INCLUDING, BUT NOT LIMITED TO, THE COLORADO DIVISION OF PARKS AND WILDLIFE, COLORADO DEPARTMENT OF TRANSPORTATION, U.S. ARMY CORPS OF ENGINEERS AND THE U.S. FISH AND WILDLIFE SERVICE REGARDING THE ENDANGERED SPECIES ACT, PARTICULARLY AS IT RELATES TO THE LISTED SPECIES (E.G., PREBLE'S MEADOW JUMPING MOUSE).
12. THE SUBDIVIDER AGREES ON BEHALF OF HIM/HERSELF AND ANY DEVELOPER OR BUILDER SUCCESSORS AND ASSIGNEES THAT SUBDIVIDER AND/OR ANY SUCCESSORS SHALL BE REQUIRED TO PAY ANY TRAFFIC IMPACT FEES IN ACCORDANCE WITH THE EL PASO COUNTY ROAD IMPACT FEE PROGRAM RESOLUTION (RESOLUTION NO. 19-471), OR ANY AMENDMENTS THERETO, AT OR PRIOR TO THE TIME OF BUILDING PERMIT SUBMITTALS. THE FEE OBLIGATIONS, IF NOT PAID AT FINAL PLAT RECORDING, SHALL BE DOCUMENTED ON ALL SALES DOCUMENTS AND ON PLAT NOTES TO ENSURE THAT A TITLE SEARCH WOULD FIND THE FEE OBLIGATION BEFORE SALE OF THE PROPERTY.
13. SPECIAL DISTRICT DISCLOSURE: A TITLE 32 SPECIAL DISTRICT ANNUAL REPORT AND DISCLOSURE FORM SATISFACTORY TO THE PLANNING AND COMMUNITY DEVELOPMENT DEPARTMENT SHALL BE RECORDED WITH EACH PLAT.
14. BASIS OF BEARING: ALL BEARINGS ARE GRID BEARINGS OF THE COLORADO STATE PLANE COORDINATE SYSTEM, CENTRAL ZONE, NORTH AMERICAN DATUM 1983. BEARINGS ARE BASED ON THE SOUTH LINE OF LOTS 2, 3, & 4 OF FALCON RANCHETTES, AND IS CONSIDERED TO BEAR S89°40'45"W. DEFINED BY FOUND MONUMENTS AS FOLLOWS: A NO. 4 REBAR WITH A 1-1/4" YELLOW PLASTIC CAP STAMPED "LS 2372", BEING THE SOUTHEAST CORNER OF LOT 2; AND A NO. 4 REBAR WITH A 1-1/4" YELLOW PLASTIC CAP STAMPED "LS 2372", BEING THE SOUTHWEST CORNER OF LOT 4.
15. FLOODPLAIN STATEMENT: PER THE FEMA FLOOD INSURANCE RATE MAP (FIRM), MAP NO. 08041C0553G WITH AN EFFECTIVE DATE OF DECEMBER 07, 2018, INDICATES THE SUBJECT PROPERTY IS DESIGNATED AS ZONE X (AREAS DETERMINED TO BE OUTSIDE 0.2% ANNUAL CHANCE FLOODPLAIN).
16. THE LOTS PLATTED HEREON SHALL NOT HAVE DIRECT ACCESS TO MERIDIAN ROAD.
17. OWL PLACE ACCESS TO MERIDIAN ROAD WILL BE CLOSED UPON THE CONNECTION OF MERIDIAN PARK PLACE SOUTHBOUND TO OWL PLACE.
18. TRACT A OF THIS PROPERTY IS SUBJECT TO A PRIVATE DETENTION BASIN/STORMWATER QUALITY BMP MAINTENANCE AGREEMENT AND EASEMENT AS RECORDED AT RECEPTION NO. _____ OF THE RECORDS OF EL PASO COUNTY. MERIDIAN STORAGE, LLC IS RESPONSIBLE FOR MAINTENANCE OF SUBJECT DRAINAGE FACILITIES.
19. THE FOLLOWING REPORTS HAVE BEEN SUBMITTED IN ASSOCIATION WITH THE VACATE AND REPLAT FOR THIS SUBDIVISION AND ARE ON FILE AT THE COUNTY PLANNING AND COMMUNITY DEVELOPMENT DEPARTMENT: TRANSPORTATION IMPACT MEMO; DRAINAGE REPORT-FINAL; STORMWATER MANAGEMENT PLAN; GEOLOGY AND SOILS REPORT; FIRE PROTECTION REPORT.
20. EL PASO COUNTY MAY REQUEST DEEDS CONVEYING THE FULL WIDTH OF THE DRAINAGE EASEMENT NECESSARY FOR RIGHT-OF-WAY PURPOSES TO EL PASO COUNTY AT NO COST TO THE COUNTY.

please remove this note as the southerly development has proposed a right in only.

please specify that this is the 30' drainage easement on the east side of the property along Meridian Road.

EASEMENTS:

UNLESS OTHERWISE INDICATED, ALL SIDE, FRONT, AND REAR LOT LINES ARE HEREBY PLATTED ON EITHER SIDE WITH A 10 FOOT PUBLIC IMPROVEMENT, UTILITY AND DRAINAGE EASEMENT UNLESS OTHERWISE INDICATED. ALL EXTERIOR SUBDIVISION BOUNDARIES ARE HEREBY PLATTED WITH A 20 FOOT PUBLIC IMPROVEMENT, UTILITY AND DRAINAGE EASEMENT. THE SOLE RESPONSIBILITY FOR MAINTENANCE OF THESE EASEMENTS IS HEREBY VESTED WITH THE INDIVIDUAL PROPERTY OWNERS.

SUMMARY:

2 LOTS	7.486 ACRES 77.95%
1 TRACT	0.732 ACRES 7.62%
RIGHT OF WAY	1.386 ACRES 14.43%
TOTAL	9.604 ACRES 100.00%

TRACT NO.	TRACT USE	ACREAGE	TRACT OWNER & MAINTENANCE
TRACT A	DETENTION POND (DRAINAGE)	0.732	MERIDIAN STORAGE, LLC

SURVEYOR'S STATEMENT:

I, WILLIAM BROOKS, A DULY REGISTERED PROFESSIONAL LAND SURVEYOR IN THE STATE OF COLORADO, DO HEREBY CERTIFY THAT THIS PLAT TRULY AND CORRECTLY REPRESENTS THE RESULTS OF A SURVEY MADE ON DATE OF SURVEY, BY ME OR UNDER MY DIRECT SUPERVISION AND THAT ALL MONUMENTS EXIST AS SHOWN HEREON; THAT MATHEMATICAL CLOSURE ERRORS ARE LESS THAN 1:10,000; AND THAT SAID PLAT HAS BEEN PREPARED IN FULL COMPLIANCE WITH ALL APPLICABLE LAWS OF THE STATE OF COLORADO DEALING WITH MONUMENTS, SUBDIVISION, OR SURVEYING OF LAND AND ALL APPLICABLE PROVISIONS OF THE EL PASO COUNTY LAND DEVELOPMENT CODE.

I ATTEST THE ABOVE ON THIS _____ DAY OF _____, 20____

 WILLIAM BROOKS, PLS
 COLORADO PROFESSIONAL LAND SURVEYOR NO. 37928
 FOR AND ON BEHALF OF GALLOWAY & COMPANY, INC.

NOTICE:

ACCORDING TO COLORADO LAW YOU MUST COMMENCE ANY LEGAL ACTION BASED UPON ANY DEFECT IN THIS SURVEY WITHIN THREE YEARS AFTER YOU FIRST DISCOVER SUCH DEFECT. IN NO EVENT, MAY ANY ACTION BASED UPON ANY DEFECT IN THIS SURVEY BE COMMENCED MORE THAN TEN YEARS FROM THE DATE OF THE CERTIFICATION SHOWN HEREON.

ANY PERSON WHO KNOWINGLY REMOVES, ALTERS, OR DEFACTS ANY PUBLIC LAND SURVEY MONUMENT, LAND BOUNDARY MONUMENT, OR ACCESSORY COMMITS A CLASS TWO (2) MISDEMEANOR, PURSUANT TO STATE STATUTE 18-4-508 OF THE COLORADO REVISED STATUTES.

CLERK AND RECORDER:

STATE OF COLORADO)
) ss.
 COUNTY OF EL PASO)

I HEREBY CERTIFY THAT THIS INSTRUMENT WAS FILED FOR RECORD IN MY OFFICE ON

THIS ____ DAY OF _____, 20____

AND WAS RECORDED AT RECEPTION NUMBER _____ OF THE RECORDS OF EL PASO COUNTY, COLORADO.

STEVE SCHLEIKER, RECORDER

EL PASO COUNTY CLERK AND RECORDER

FEES:

SCHOOL FEE: _____

BRIDGE FEE: _____

PARK FEE: _____

DRAINAGE FEE: _____

OWNER CONTACT INFORMATION

MIKE D. TEXER
 719-641-9261
 11750 OWL PLACE, PEYTON, CO 80831

BRITTANY A. TEXER
 719-641-9261
 11750 OWL PLACE, PEYTON, CO 80831

PCD FILE NO.: VR239



FALCON RANCHETTES FILING NO. 1A

A REPLAT OF LOT 1 & 2, FALCON RANCHETTES
 LOCATED IN THE SOUTHEAST QUARTER OF SECTION 1,
 TOWNSHIP 13 SOUTH, RANGE 65 WEST OF THE 6TH PRINCIPAL MERIDIAN,
 COUNTY OF EL PASO, STATE OF COLORADO

#	Date	Issue / Description	Init.
1	06/01/2023	ADDRESS COUNTY COMMENTS	MNB
2	10/19/2023	ADDRESS COUNTY COMMENTS	MNB
3	04/28/2024	ADDRESS COUNTY COMMENTS	MNB
4			
5			
Project No: MRS000002-10
 Drawn By: MNB
 Checked By: BB
 Date: 02.10.2023

