


PRELIMINARY FLOOR PLANS

FINAL FLOOR PLANS TO BE SUBMITTED AT LATER DATE

Please label the uses of the various rooms in the building.
Also list the number of seats in the sanctuary including those utilized by the ministry.

PRODUCED BY AN AUTODESK STUDENT VERSION


PRODUCED BY AN AUTODESK STUDENT VERSION

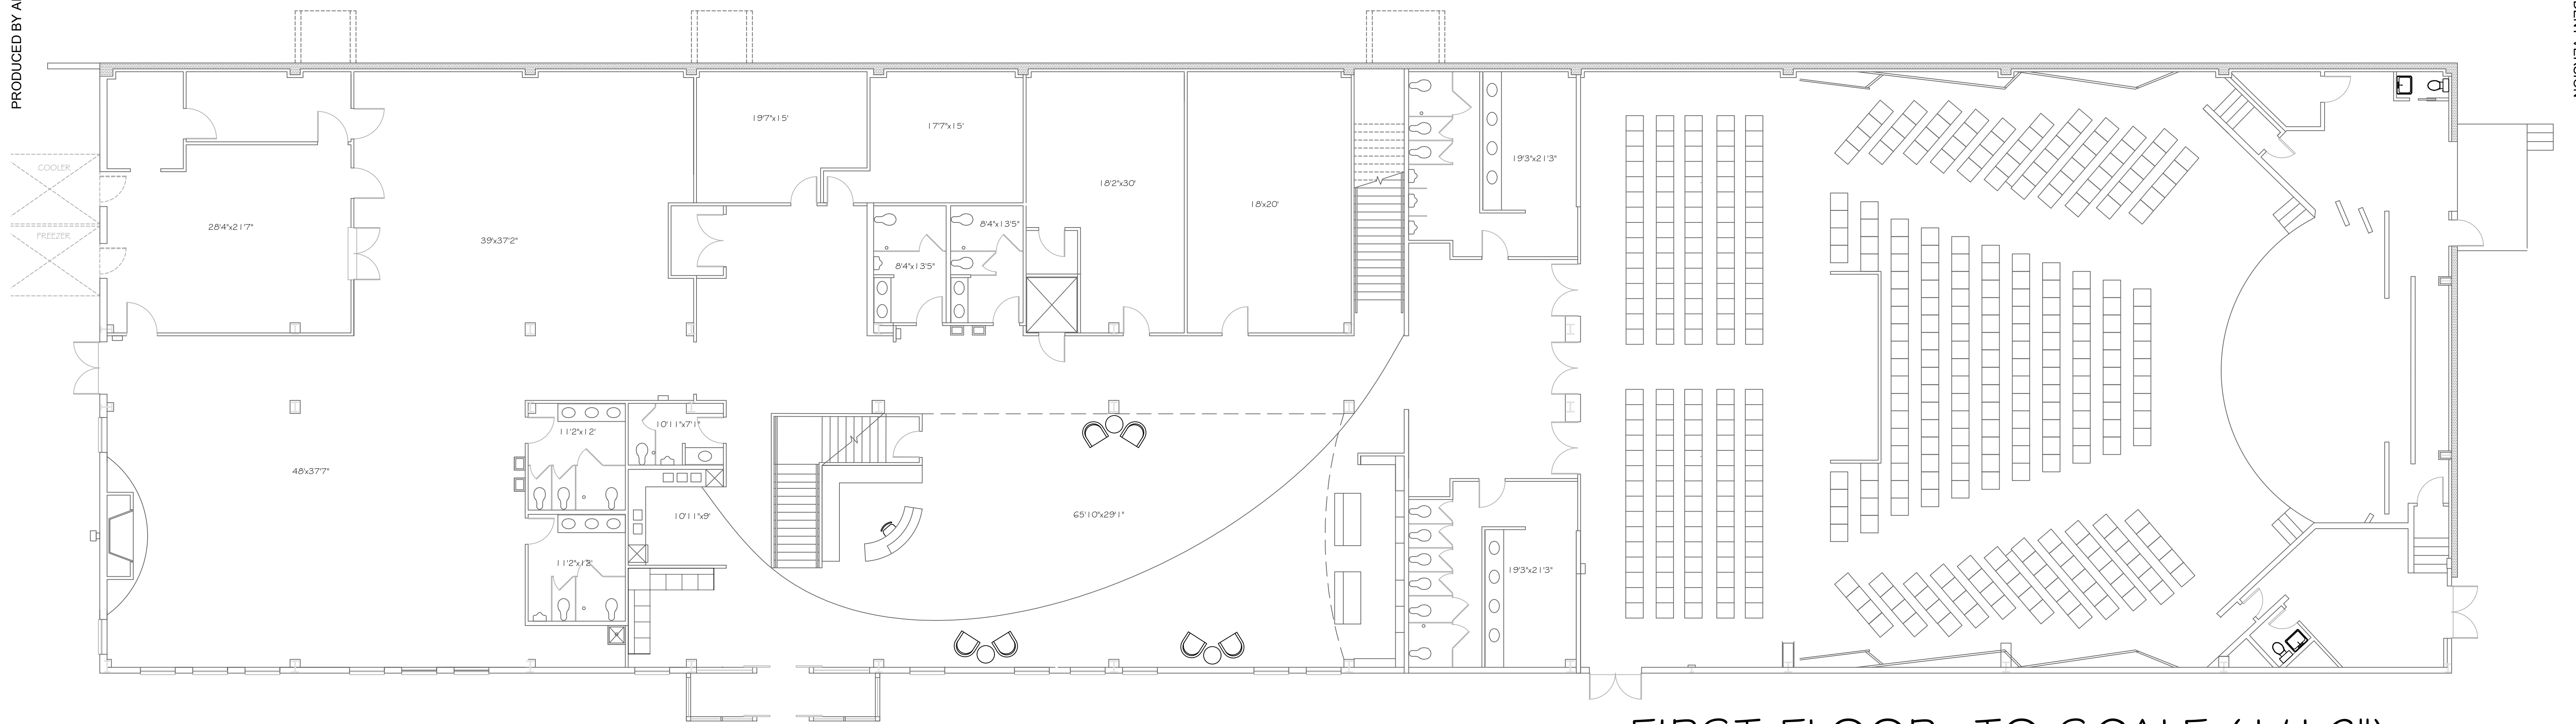

FIRST FLOOR- TO SCALE (1/16")

PRELIMINARY FLOOR PLANS

FINAL FLOOR PLANS TO BE SUBMITTED AT LATER DATE

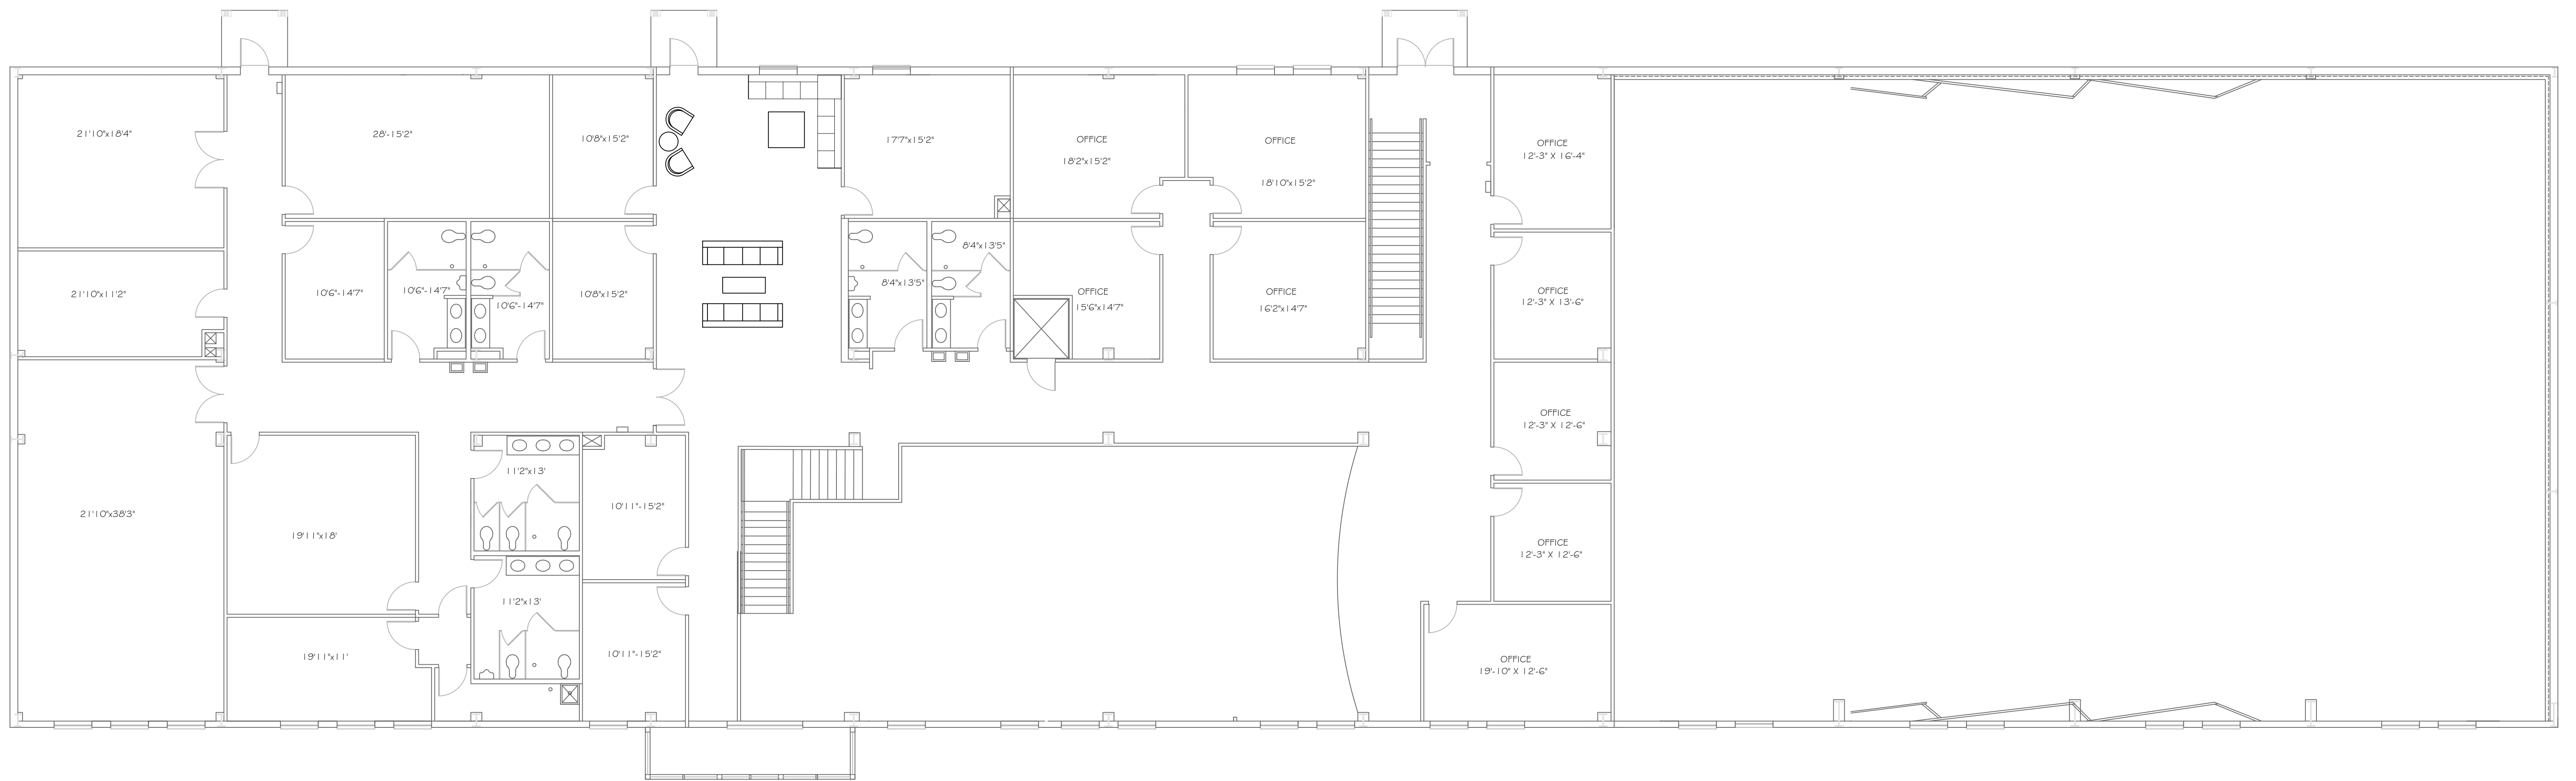

PRODUCED BY AN AUTODESK STUDENT VERSION

PRODUCED BY AN AUTODESK STUDENT VERSION

Markup Summary

8/18/2019 6:16:32 PM (1)



Subject: Text Box
Page Label: [1] Model
Author: Lindsay Darden
Date: 8/18/2019 6:16:32 PM
Color: ■

Please label the uses of the various rooms in the building.

Also list the number of seats in the sanctuary including those utilized by the ministry.