

LDC COMMENT RESPONSES 11-04-19  
 David V. Hostetler - DVH  
 dhostetler@ldc-inc.com (719) 528-6133

# Markup Summary

Locked (24)

 **Subject:** Text Box  
**Page Label:** 1  
**Lock:** Locked  
**Author:** Daniel Torres  
**Date:** 9/25/2019 12:09:06 PM  
**Color:** ■

Review 1: Add PCD File No. PPR1913 **ADDED - DVH**  
 Review 2: Unresolved **RESOLVED w/THIS REVISION - DVH**

 **Subject:** Callout  
**Page Label:** 1  
**Lock:** Locked  
**Author:** Daniel Torres  
**Date:** 9/25/2019 12:09:07 PM  
**Color:** ■

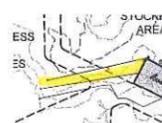
Per FEMA FIRM panel it appears that the the light gray hatch is zone X and the dark gray is zone AE. Please revise the text accordingly. **REVISED - DVH**

 **Subject:** Callout  
**Page Label:** 1  
**Lock:** Locked  
**Author:** Daniel Torres  
**Date:** 9/25/2019 12:09:08 PM  
**Color:** ■

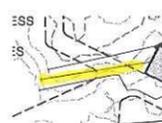
Please label the lines that have been highlighted. **LABELED - DVH**

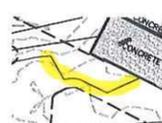
 **Subject:** Callout  
**Page Label:** 1  
**Lock:** Locked  
**Author:** Daniel Torres  
**Date:** 9/25/2019 12:09:09 PM  
**Color:** ■

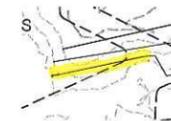
The recycled/crushed asphalt area does not match what is shown on the GEC. Please update so that they match. Please also indicate what is existing and what is proposed. **MATCHES NOW AND INDICATED IN LEGEND - DVH**

 **Subject:** Highlight  
**Page Label:** 1  
**Lock:** Locked  
**Author:** Daniel Torres  
**Date:** 9/25/2019 12:09:10 PM  
**Color:** ■

**ANNOTATED - DVH**

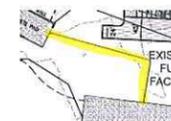
 **Subject:** Highlight  
**Page Label:** 1  
**Lock:** Locked  
**Author:** Daniel Torres  
**Date:** 9/25/2019 12:09:11 PM  
**Color:** ■

 **Subject:** Highlight  
**Page Label:** 1  
**Lock:** Locked  
**Author:** Daniel Torres  
**Date:** 9/25/2019 12:09:12 PM  
**Color:** ■

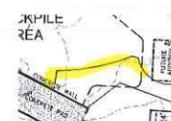
 **Subject:** Highlight  
**Page Label:** 1  
**Lock:** Locked  
**Author:** Daniel Torres  
**Date:** 9/25/2019 12:09:12 PM  
**Color:** ■

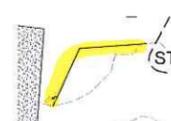
**ANNOTATED - DVH**

 **Subject:** Highlight  
**Page Label:** 1  
**Lock:** Locked  
**Author:** Daniel Torres  
**Date:** 9/25/2019 12:09:13 PM  
**Color:** ■

 **Subject:** Highlight  
**Page Label:** 1  
**Lock:** Locked  
**Author:** Daniel Torres  
**Date:** 9/25/2019 12:09:14 PM  
**Color:** ■

 **Subject:** Highlight  
**Page Label:** 1  
**Lock:** Locked  
**Author:** Daniel Torres  
**Date:** 9/25/2019 12:09:15 PM  
**Color:** ■

 **Subject:** Highlight  
**Page Label:** 1  
**Lock:** Locked  
**Author:** Daniel Torres  
**Date:** 9/25/2019 12:09:15 PM  
**Color:** ■

 **Subject:** Highlight  
**Page Label:** 1  
**Lock:** Locked  
**Author:** Daniel Torres  
**Date:** 9/25/2019 12:09:17 PM  
**Color:** ■

 **Subject:** Callout  
**Page Label:** 1  
**Lock:** Locked  
**Author:** Daniel Torres  
**Date:** 9/25/2019 12:09:22 PM  
**Color:** ■

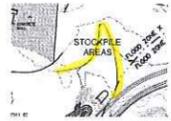
Per FEMA FIRM panel it appears that the the light gray hatch is zone X and the dark gray is zone AE. Please revise the text accordingly.

**REVISED - DVH**

 **Subject:** Highlight  
**Page Label:** 1  
**Lock:** Locked  
**Author:** Daniel Torres  
**Date:** 9/25/2019 12:09:25 PM  
**Color:** ■

**LABELED - DVH**





**Subject:** Highlight  
**Page Label:** 1  
**Lock:** Locked  
**Author:** Daniel Torres  
**Date:** 9/25/2019 12:09:26 PM  
**Color:** ■

ANNOTATED - DVH



**Subject:** Highlight  
**Page Label:** 1  
**Lock:** Locked  
**Author:** Daniel Torres  
**Date:** 9/25/2019 12:09:27 PM  
**Color:** ■



**Subject:** Highlight  
**Page Label:** 1  
**Lock:** Locked  
**Author:** Daniel Torres  
**Date:** 9/25/2019 12:09:28 PM  
**Color:** ■



**Subject:** Highlight  
**Page Label:** 1  
**Lock:** Locked  
**Author:** Daniel Torres  
**Date:** 9/25/2019 12:09:29 PM  
**Color:** ■

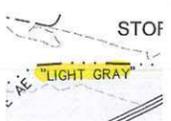


**Subject:** Highlight  
**Page Label:** 1  
**Lock:** Locked  
**Author:** Daniel Torres  
**Date:** 9/25/2019 12:09:31 PM  
**Color:** ■

REVISED - DVH



**Subject:** Highlight  
**Page Label:** 1  
**Lock:** Locked  
**Author:** Daniel Torres  
**Date:** 9/25/2019 12:09:32 PM  
**Color:** ■



**Subject:** Highlight  
**Page Label:** 1  
**Lock:** Locked  
**Author:** Daniel Torres  
**Date:** 9/25/2019 12:09:32 PM  
**Color:** ■



**Subject:** Highlight  
**Page Label:** 1  
**Lock:** Locked  
**Author:** Daniel Torres  
**Date:** 9/25/2019 12:09:33 PM  
**Color:** ■



**Subject:** Text Box  
**Page Label:** 1  
**Lock:** Locked  
**Author:** dsdsevigny  
**Date:** 9/25/2019 12:09:34 PM  
**Color:** ■

The following note should be added to all site development plans or non-residential site plans, as applicable, prior to PCD approval:

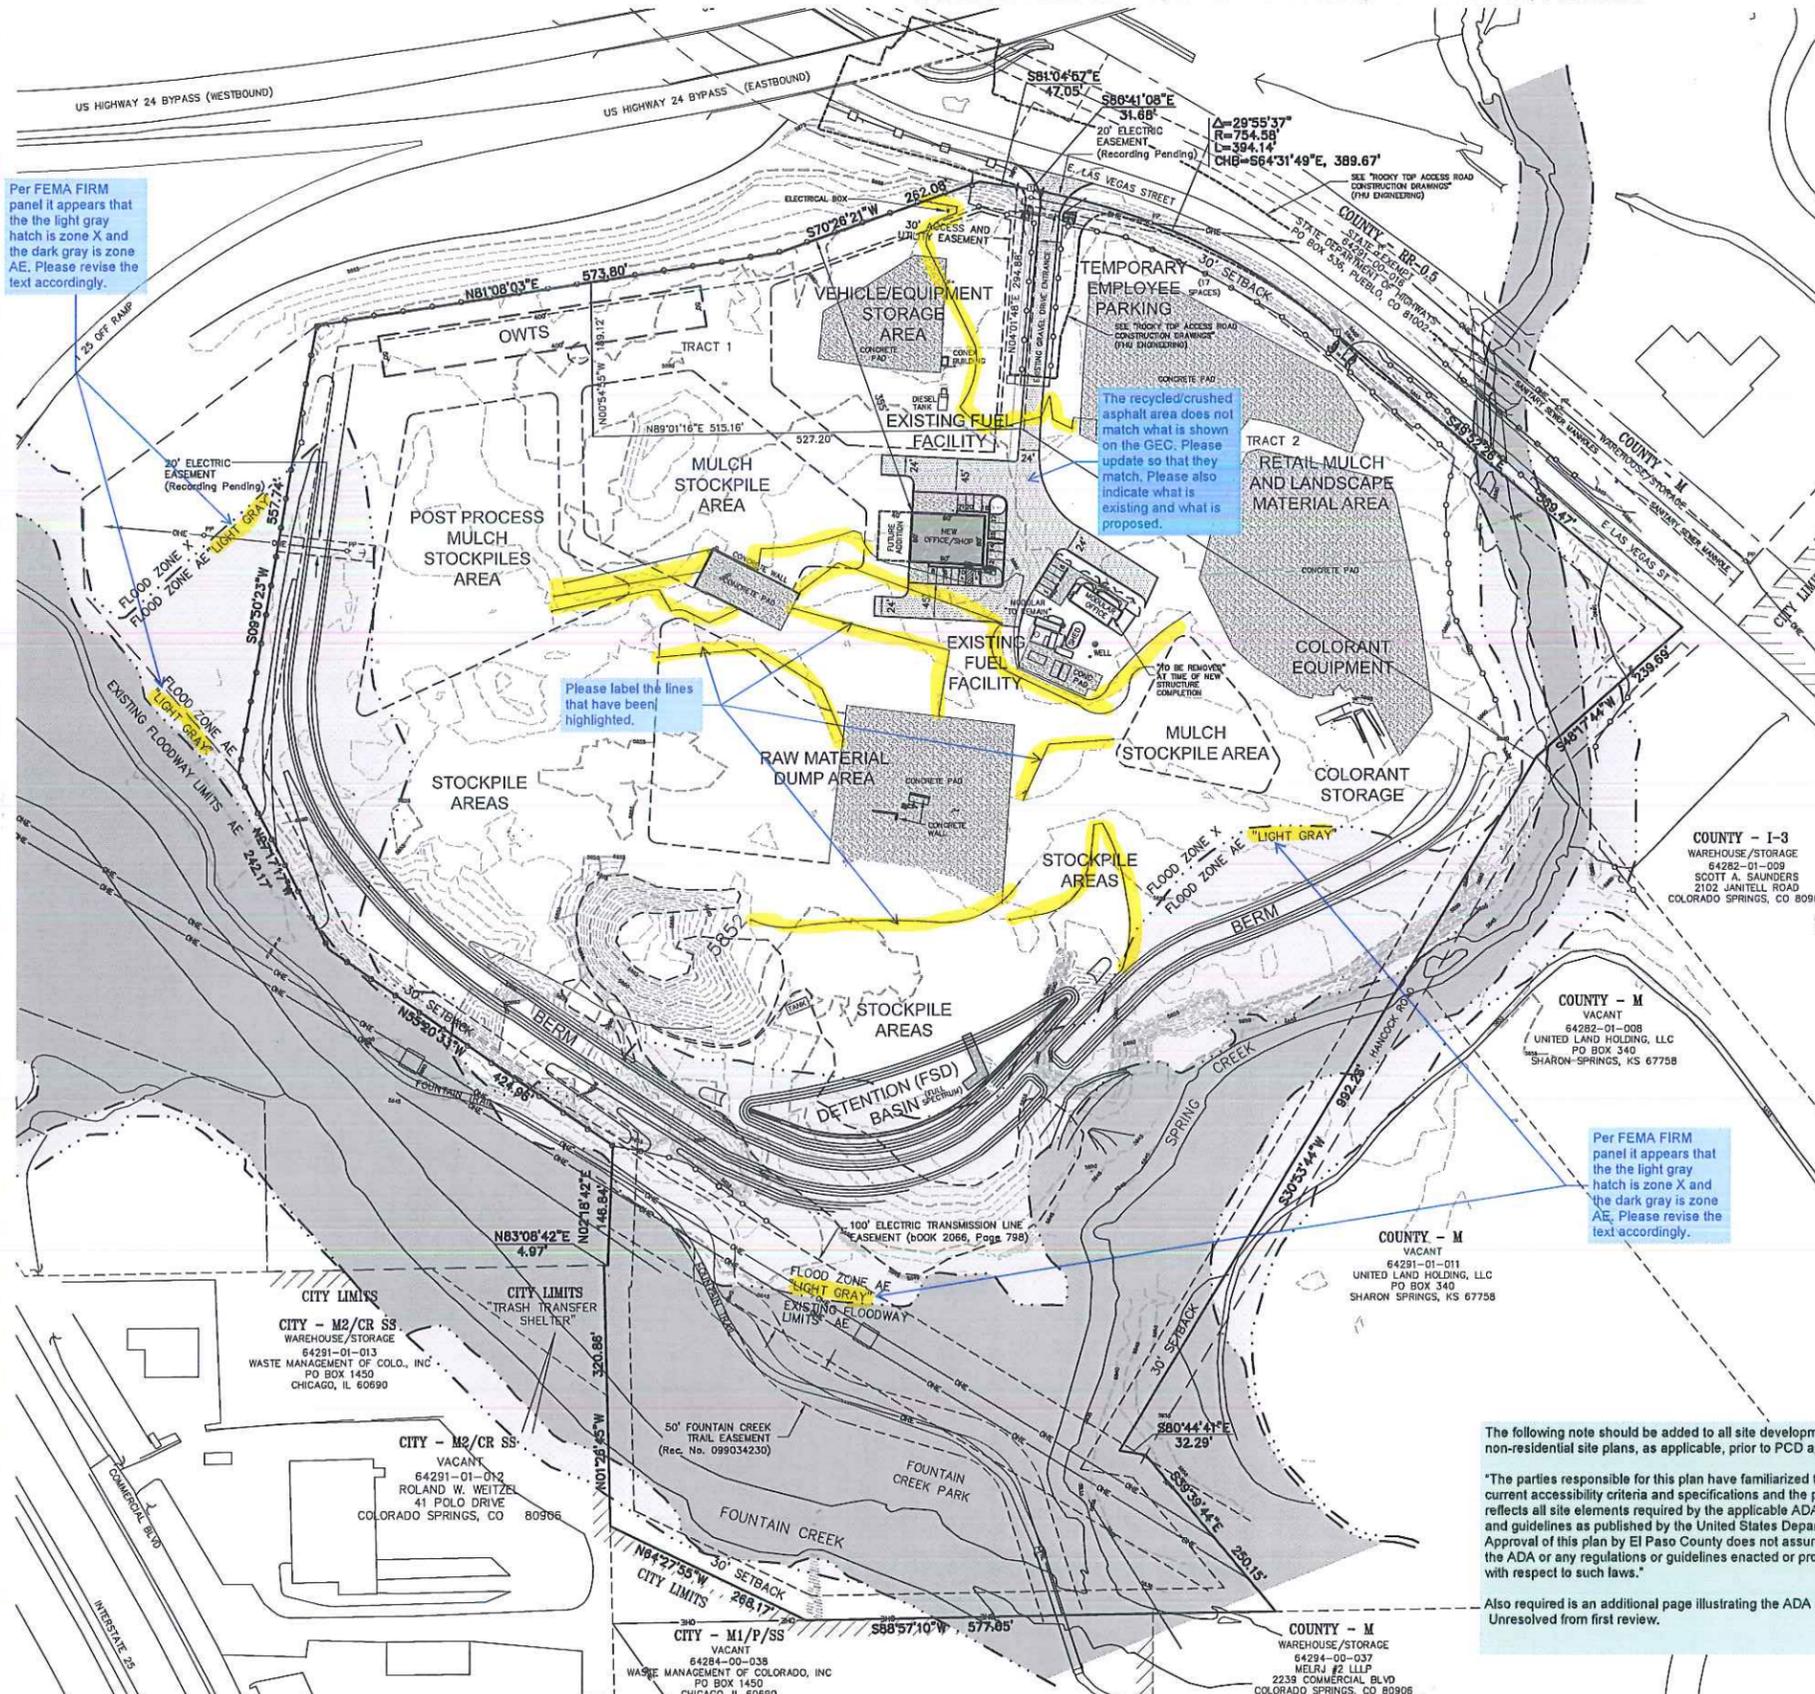
"The parties responsible for this plan have familiarized themselves with all current accessibility criteria and specifications and the proposed plan reflects all site elements required by the applicable ADA design standards and guidelines as published by the United States Department of Justice. Approval of this plan by El Paso County does not assure compliance with the ADA or any regulations or guidelines enacted or promulgated under or with respect to such laws."

Also required is an additional page illustrating the ADA route.  
 Unresolved from first review.

ADDED ON SHEET 1 OF 1 - DVH

# ROCKY TOP RESOURCES

SITE DEVELOPMENT PLAN  
1755 E. LAS VEGAS STREET, COLORADO SPRINGS, EL PASO COUNTY, COLORADO



Per FEMA FIRM panel it appears that the light gray hatch is zone X and the dark gray is zone AE. Please revise the text accordingly.

The recycled/crushed asphalt area does not match what is shown on the GEC. Please update so that they match. Please also indicate what is existing and what is proposed.

Please label the lines that have been highlighted.

Per FEMA FIRM panel it appears that the light gray hatch is zone X and the dark gray is zone AE. Please revise the text accordingly.

The following note should be added to all site development plans or non-residential site plans, as applicable, prior to PCD approval:

\*The parties responsible for this plan have familiarized themselves with all current accessibility criteria and specifications and the proposed plan reflects all site elements required by the applicable ADA design standards and guidelines as published by the United States Department of Justice. Approval of this plan by El Paso County does not assure compliance with the ADA or any regulations or guidelines enacted or promulgated under or with respect to such laws.\*

Also required is an additional page illustrating the ADA route. Unresolved from first review.

**OWNER/DEVELOPER:**  
ROCKY TOP RESOURCES, INC.  
ATTN: FREDRICK D. MARTIN  
1755 E. LAS VEGAS STREET  
COLORADO SPRINGS, CO 80903-4323  
(719) 579-9103

**PLANNING CONSULTANT:**  
LAND DEVELOPMENT CONSULTANTS, INC.  
ATTN: DAVID V. HOSTETLER  
3898 MAZELAND ROAD  
COLORADO SPRINGS, CO 80909  
(719) 528-6133

**PROPERTY DESCRIPTION:** 1755 E. LAS VEGAS STREET  
PARCEL 1: TRACTS 1 AND 2 IN VALLEY GARDENS, AND ALL THAT PORTION OF WEST STREET VACATED BY RESOLUTION NO. 04-845 RECORDED DECEMBER 12, 2008 UNDER RECEPTION NO. 208179579, BEING A PART OF THE EAST HALF OF THE NORTHWEST QUARTER OF SECTION 29, AND THE WEST HALF OF SECTION 28 IN TOWNSHIP 14 SOUTH, RANGE 66 WEST OF THE 6TH P.M., COUNTY OF EL PASO, STATE OF COLORADO, EXCEPT THAT PORTION CONVEYED TO THE COUNTY COMMISSIONERS OF EL PASO COUNTY, COLORADO RECORDED JANUARY 10, 1984 IN BOOK 3823 AT PAGE 439, AND EXCEPT THAT PORTION CONVEYED TO THE DEPARTMENT OF TRANSPORTATION STATE OF COLORADO RECORDED MAY 5, 1992 IN BOOK 5973 AT PAGE 205.

PARCEL 2: TRACTS 7, 8, 9 AND 12 IN VALLEY GARDENS, BEING A PART OF THE EAST HALF OF THE NORTHEAST QUARTER OF SECTION 29, AND THE WEST HALF OF THE NORTHWEST QUARTER OF SECTION 28 IN TOWNSHIP 14 SOUTH, RANGE 66 WEST OF THE 6TH P.M., COUNTY OF EL PASO, STATE OF COLORADO.

EXCEPTING FROM THE ABOVE DESCRIPTION THAT PORTION THEREOF CONVEYED BY B.W. BABCOCK TO A.G. PINELLO AND RECORDED IN BOOK 539 AT PAGE 485 IN THE OFFICE OF THE COUNTY CLERK AND RECORDER OF EL PASO COUNTY, COLORADO, AND FURTHER EXCEPTING THE RIGHT OF WAY CONVEYED TO THE CITY OF COLORADO SPRINGS BY DEED RECORDED IN BOOK 1000 AT PAGE 316 IN THE OFFICE OF THE COUNTY CLERK AND RECORDER OF EL PASO COUNTY, COLORADO, COUNTY OF EL PASO, STATE OF COLORADO.

TRACTS G AND H AND TRACTS E, I AND K, RYAN'S SUBDIVISION, COUNTY OF EL PASO, STATE OF COLORADO, EXCEPTING FROM ALL THE FOREGOING PARCELS THOSE PORTIONS CONTAINED IN FINDINGS, ORDER AND DECREE RECORDED IN BOOK 3823 AT PAGE 439, WARRANTY DEED TO THE DEPARTMENT OF TRANSPORTATION, STATE OF COLORADO RECORDED IN BOOK 5973 AT PAGE 205 AND IN WARRANTY DEED TO JAY A. RINGLER RECORDED IN BOOK 6354 AT PAGE 339, EL PASO COUNTY, COLORADO.

NOW KNOWN AS TRACT 7 IN VALLEY GARDENS IN ACCORDANCE WITH ADMINISTRATIVE VACATION OF INTERIOR LOT LINES AS RECORDED JANUARY 17, 2008 AT RECEPTION NO. 208006560 . . . CONTAINING 45 "GROSS" ACRES, MORE OR LESS.

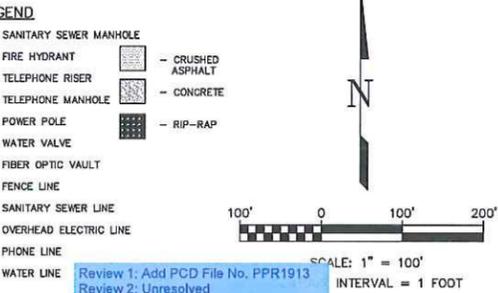
**SITE DATA:**  
AREA: 44.809 AC  
EXISTING ZONE: I-3 "HEAVY INDUSTRIAL"  
EXISTING USE: WOOD WASTE RECYCLING AND MULCH RETAIL  
PROPOSED BUILDING HEIGHT: EXTENDED SINGLE-STORY = 25'-30' (40' ALLOWED)  
BUILDING SETBACKS: 30' FRONT, SIDE AND REAR

**PARKING, REQUIRED:**  
OFFICES/SHOPS/EMPLOYEE LUNCH ROOM (PERMANENT STRUCTURE) - 5,400 SQ. FT. @ 1/300 SQ. FT. = 18  
**PARKING, PROVIDED:** 38 (INCLUDES 2 HANDICAP)

**TAX SCHEDULE NO.:** 64291-01-029, 030 AND 031

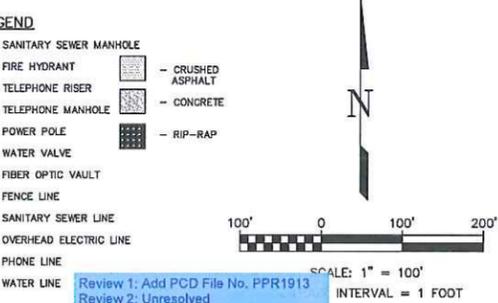
**NOTES:**

- FEDERAL EMERGENCY MANAGEMENT AGENCY, Flood Insurance Rate Map Number 08041C0741G, effective date December 7, 2018, indicates the area in the vicinity of this parcel of land to be Zone X (gray) (areas of 500-year flood; areas of 100-year flood with average depths of less than 1 foot or with drainage areas less than 1 square mile; and areas protected by levees from 100-year flood) and Zone AE (special flood hazard areas inundated by 100-year flood with base elevations determined).
- BENCHMARK: FIMS Monument Z-395 is a stainless steel rod inside an aluminum fayer stamped "Z 395 1983" set by the NGS 335 feet Northwest of the center of Royer Street, 50 feet Northeast of the center of E. Las Vegas Street, 27 feet Southwest of the rear roll of the Denver and Rio Grande Western tracks, 3 feet Northwest of a utility pole with 1 guy wire, 1 foot Southeast of a witness post, 4 feet below the tracks; Elevation = 5914.77 (FIMS datum) plus 3.465 foot adjustment to NAVD 88 datum per VERTCON adjustment = 5918.23.
- Lighting will consist of new building-mounted wall-packs.
- The developer shall obtain a driveway access permit from El Paso County Development Services Department prior to obtaining a building permit.
- The site will utilize a mobile scale for vehicle load weighing.
- Multiple piles of raw material dump areas, debris stockpiles, post process mulch stockpiles and fine mulch stockpiles will exist in various locations across this site, with corresponding dirt/gravel accessways also existing in various locations across this site.
- For more detailed site information regarding grading and erosion control and landscaping, see appropriate Site Development Plan supplemental submittal items. For detailed building, site improvements and utilities, see compiled Bid Plan Set and/or Construction Drawing Plan Set (submittal pending).



Review 1: Add PCD File No. PPR1913  
Review 2: Unresolved

Project No: 04048  
Sheet: 1 of 1



CALL BEFORE YOU DIG  
811  
DIAL 811  
FOR LOCATING AND MARKING GAS, ELECTRIC, WATER AND WASTEWATER

NO.	DATE	DESCRIPTION
1	12/15/18	DATA CLARIFICATION
2	01/11/19	CLIENT/CIVIL COMMENTS
3	02/20/19	BUILDING LOCATION
4	09/27/19	CLIENT COMMENTS
5	09/27/19	DATA CLARIFICATION

H Scale: 1" = 100'  
V Scale: N/A  
Designed By: N/A  
Drawn By: SLG  
Checked By: DVH  
Date: 10/10/2018

**Land Development Consultants, Inc.**  
PLANNING • SURVEYING  
www.ldc-inc.com • TEL: (719) 528-6133 • FAX: (719) 528-6846  
3898 MAZELAND ROAD • COLORADO SPRINGS, CO 80909

**ROCKY TOP RESOURCES**  
**SITE DEVELOPMENT PLAN**  
PORTIONS OF THE EAST HALF OF THE NORTHEAST QUARTER OF SECTION 29 AND THE WEST HALF OF SECTION 28, TOWNSHIP 14 SOUTH, RANGE 66 WEST OF THE 6TH P.M., EL PASO COUNTY, COLORADO

Project No: 04048  
Sheet: 1 of 1

F:\0404004048 - Rocky Top Resources\04048\_SDP - Revision 02-27-19.dwg