

QÜŒŒ/WPÀÛYÙVÒT ÅÖÒÛÔÛŒVWPÀPUNÒ

[illegible]

ŠŒŸUWÁPUVÒ

[illegible]

Õ Ò Þ Ò Û Õ Š À Ñ Ò Á Þ Û Ñ Ò Û

[illegible][illegible]

ΗΕ VΡΑΘΥΡ VΥΘΕ VΥ UΑΙΡ ΕΣΣΑΟΑΥΘΟΥΥΥ UΘΣΟΑΥ UΑΙΘ VΘΕΘ UΘ ΕΣΣΑΟΘΟΥ UΘ ΥΑΥΘΤ Q UΑΥ UΑΙ ΕΣΣΑΥ UΘΘ UΘΣΟ
 ΘΘΘ P ΘΘΘΕ


[illegible][illegible]

i È CESSA OZOUO POUAUA P YAMOSA P OOA VCE OCE OUA P OESSA OZOUA U A P O SCE OUV A OX O W P A U A U O O
UVCE OCE O E M P SOUUA U O O O O OESSA VCE OOA V P OUY O O E

[illegible]

ÕÜǾǾÒÁPUNÒ

0U0D0AUP0SS000VUCS0P000C0E00AUP0U0D0C0AUS0B0AYAVP0U0U0K0P0A0U0S0P0U0O0U0AT0B0U0CU0AU0U
US0B0AU0S0U0U0D0C0A/K0A0D0F0VU0U0C0E0U0AUP0SS00A0W0OSUY0A/U0U0Z0U0OY0CS0D0W0U0C0K0P0E0K0A/I0A
0D0F0VU0U0JU0SA0WS0PA0U0C0U0U0D0AUP0SS00A0W0OSUY0AU0OY0CS0D0W0U0C0K0P0E

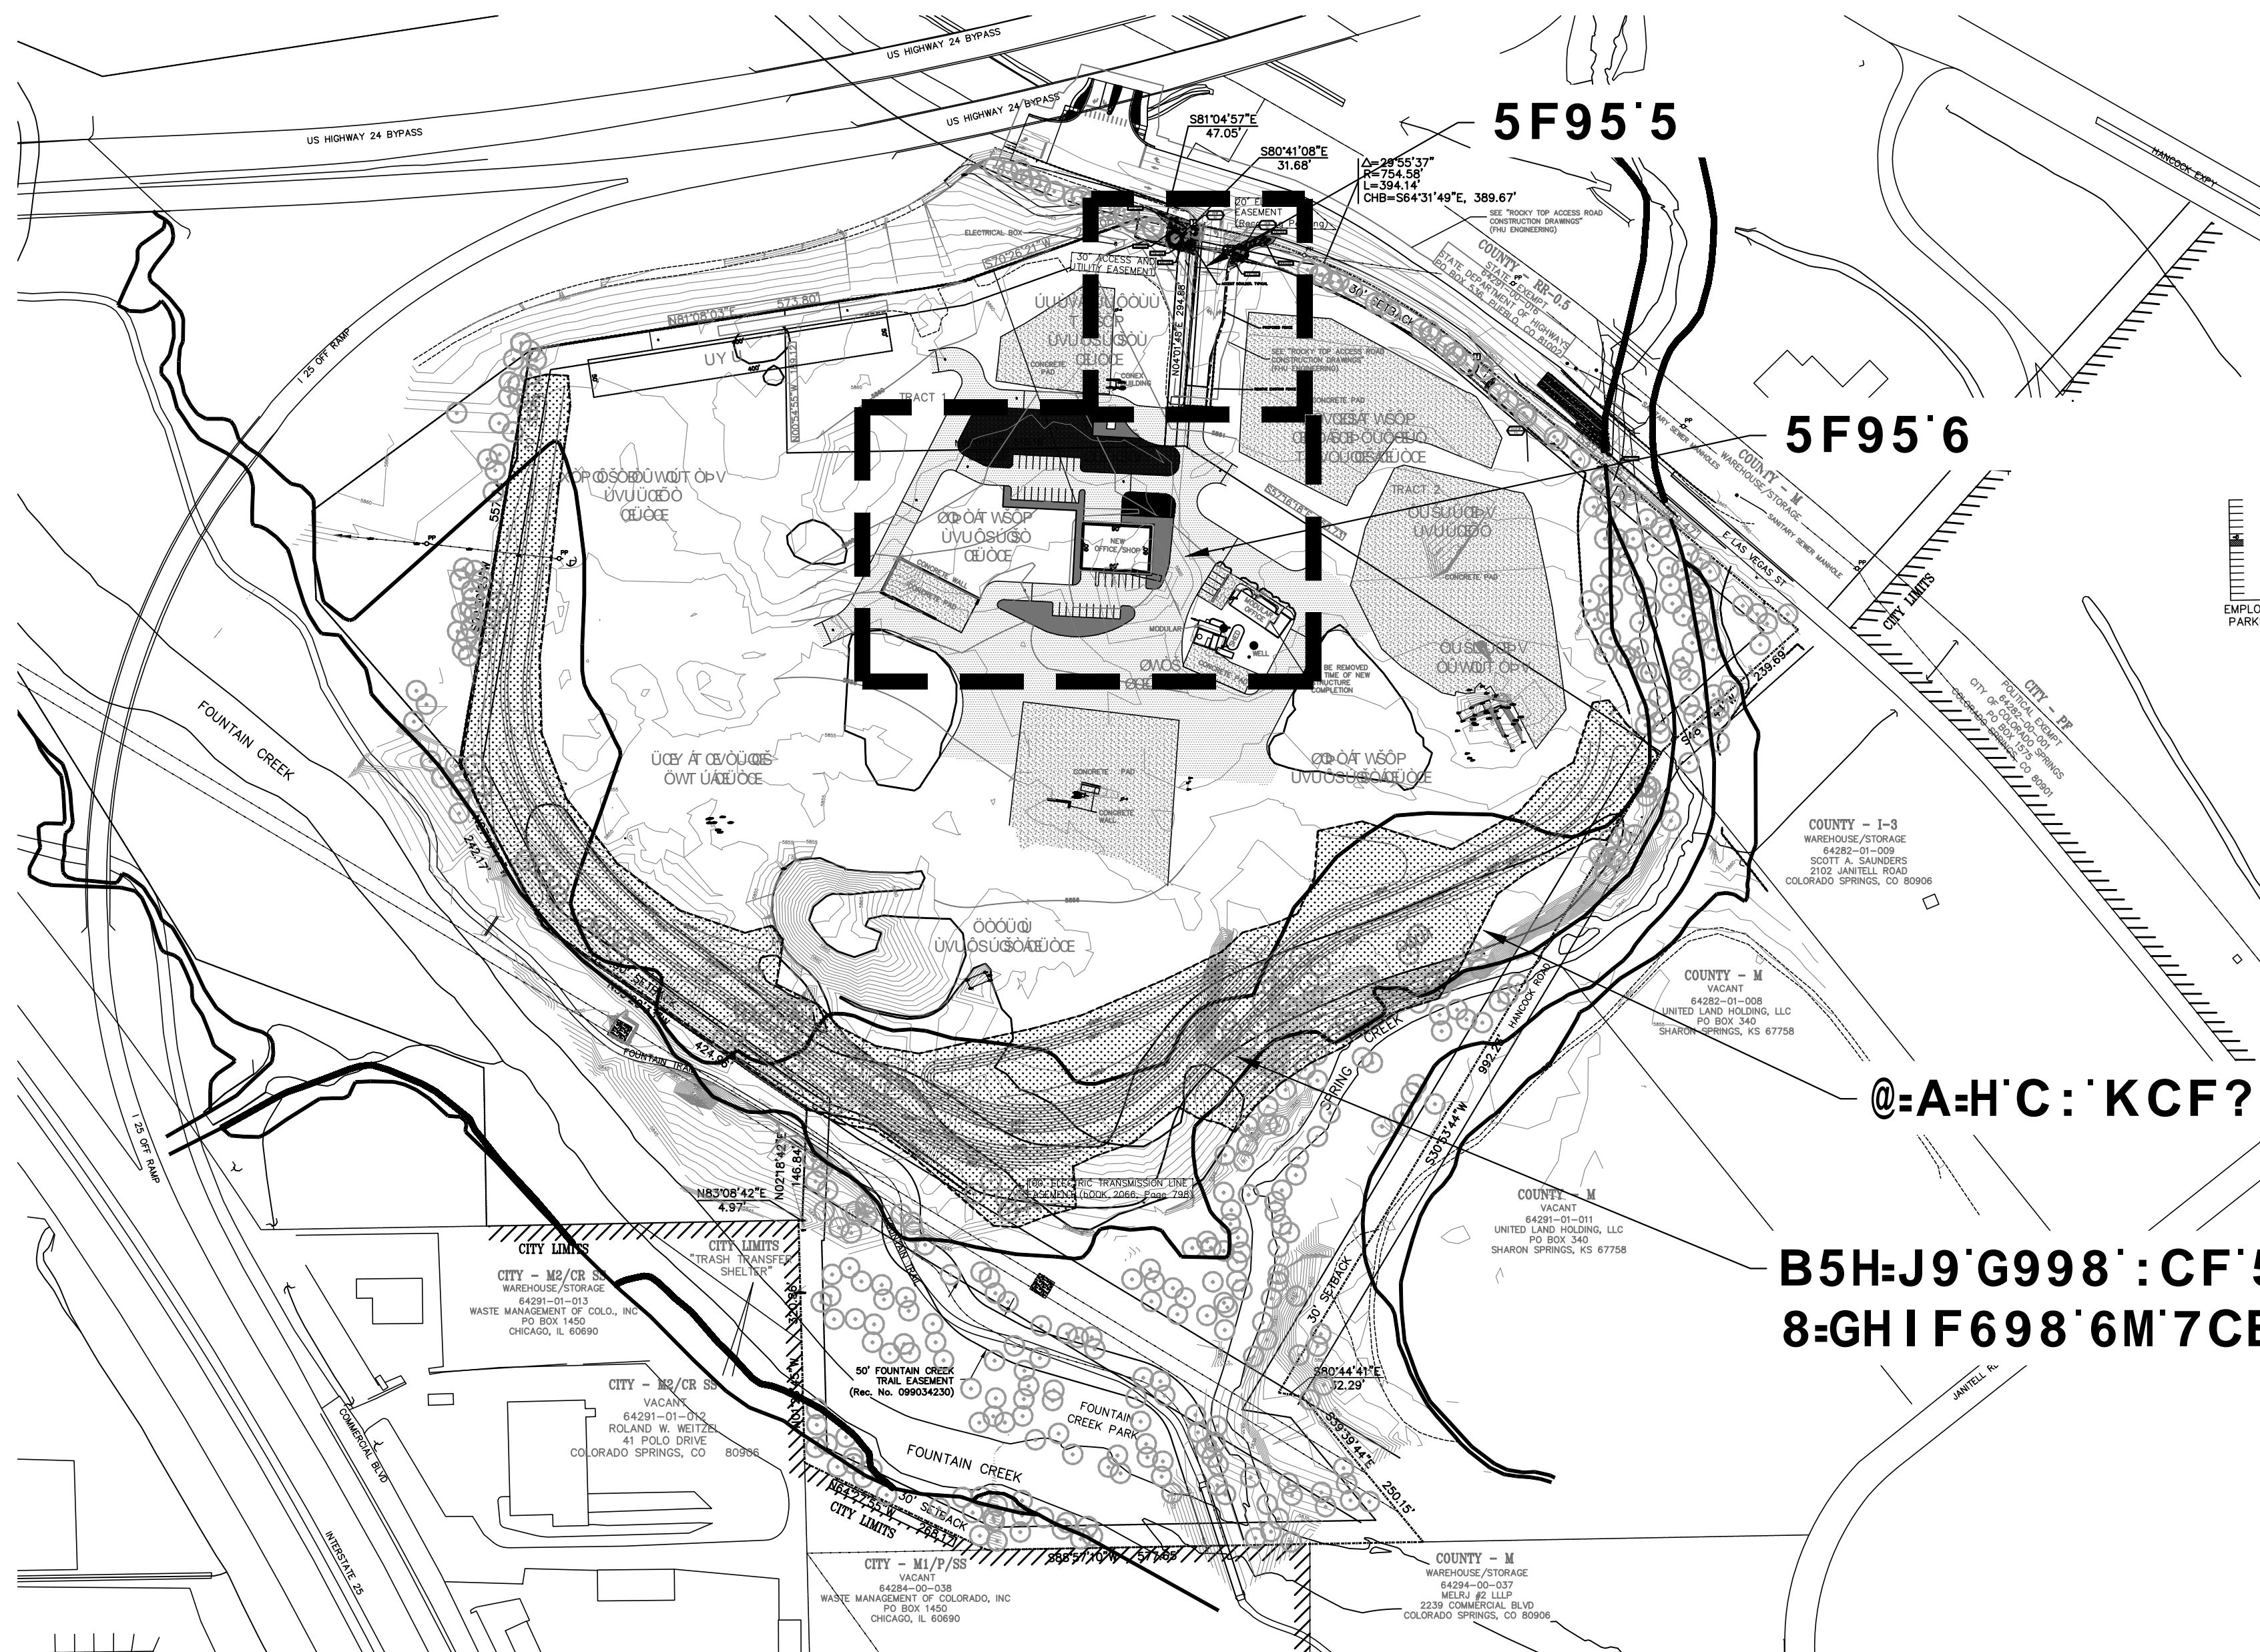

OVERALL LANDSCAPE PLAN



BCH'HC'G75@9

WVŠQOÙÁPUVÒ

YOUNG, R. C. and C. D. 1990. A preliminary study of the effects of the 1989-1990 El Niño event on the distribution and abundance of the Pacific halibut, *Hoplunnichthys pacificus*, in the Bering Sea. *Journal of the North American Benthological Society*, 9: 1-11.

ÖÜÔWT ÒP VÁP UVÒ

[illegible]

$\leq 9F$; $FCI\ B8'89G\overline{=}\ BG\overline{Z}\neq B7''$
 $\otimes 88G75D95F7<\neq 97HI\ F9XD06B8-B) \ / \neq F\neq\ 5HC8\ 89G\neq\ B$

D\cbY+%I(++I*(*
 -UI....%I&*I%&&



FC7?MHC D.F9GCI F79G

6.9% @ 5G; 9.5G.GH"

7C@CF58C.GDF#B: GZ7C

DF9D5F98:CF.
@87"-B7"

DF-905F 98 : CF.	<p> වරදකරුන් ගෙවිය යුතු පොදු සේවයන් සඳහා සහතිකයක් ලෙස භාවිතයට පත්වනු ලබන සේවාවන් සඳහා වන ප්‍රවේශයට අවසරය ලබා දෙන ලදී. </p>
@8 7 * 47 *	<p> වරදකරුන් ගෙවිය යුතු පොදු සේවයන් සඳහා සහතිකයක් ලෙස භාවිතයට පත්වනු ලබන සේවාවන් සඳහා වන ප්‍රවේශයට අවසරය ලබා දෙන ලදී. </p>

BCH: CF·7CBGHF | 7H€CB·

JOB NUMBER _____, \$+!%,

REVISIONS


ORIGINAL DATE	' ! & , ! % -
---------------	---------------

DRAWN BY	
DESCRIPTION	


@5B8G75D9'D@5B

SHEET NO.

@%''%

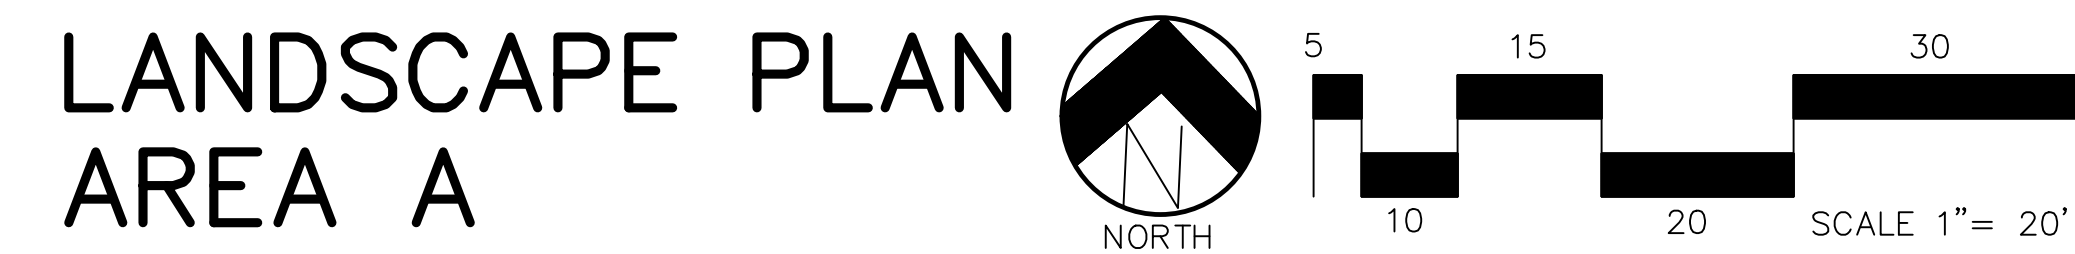

D@5BH`G7<98 I @9

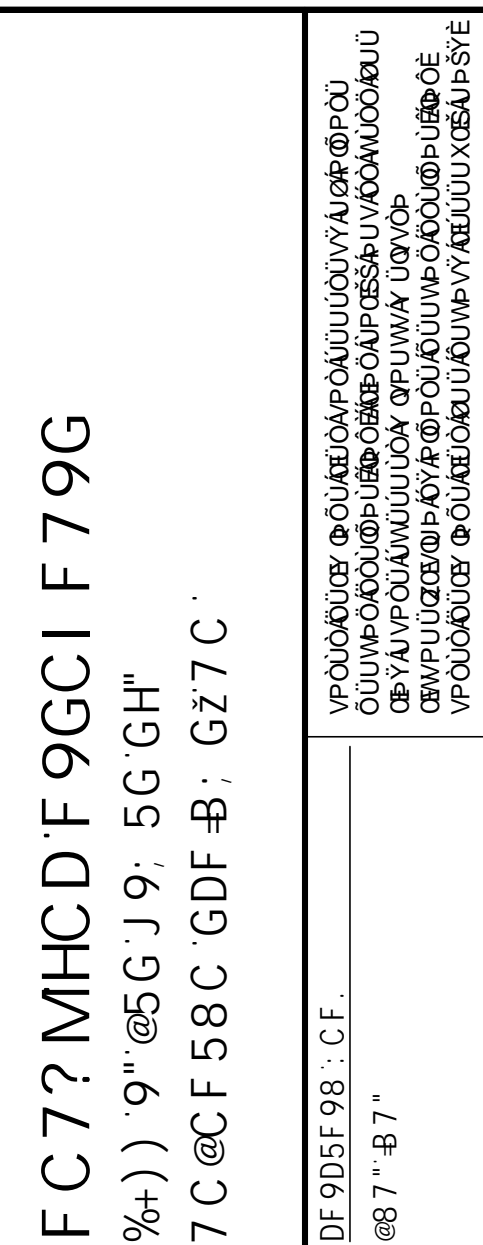[illegible][illegible][illegible]


'))\$BCFH<57589AM6@J8*GH9"&\$+
 77C@CF58C'GDF-B;Gz7C,\$-\$%
 D\cbY+%i(++!)*(*
 =UI....+%&I&*I%&&&&

7C@CF58C.GDF#B;GZ7C.
%+)) .9".@5G.J9; 5G.GH"

DF 9D5F 98 : CF.
@8 7 * -B 7 *


JOB NUMBER	
, \$+!%,	
REVIEWS	
ORIGINAL DATE ' !&, !%-	
DRAWN BY	
DESCRIPTION	
5F 95 5	
@5B8G75D9D@5B	
SHEET NO.	
@%/"&	

Section 6.2.2(C) Parking Lot Landscape Requirements. There are no trees indicated in this parking lot detail.

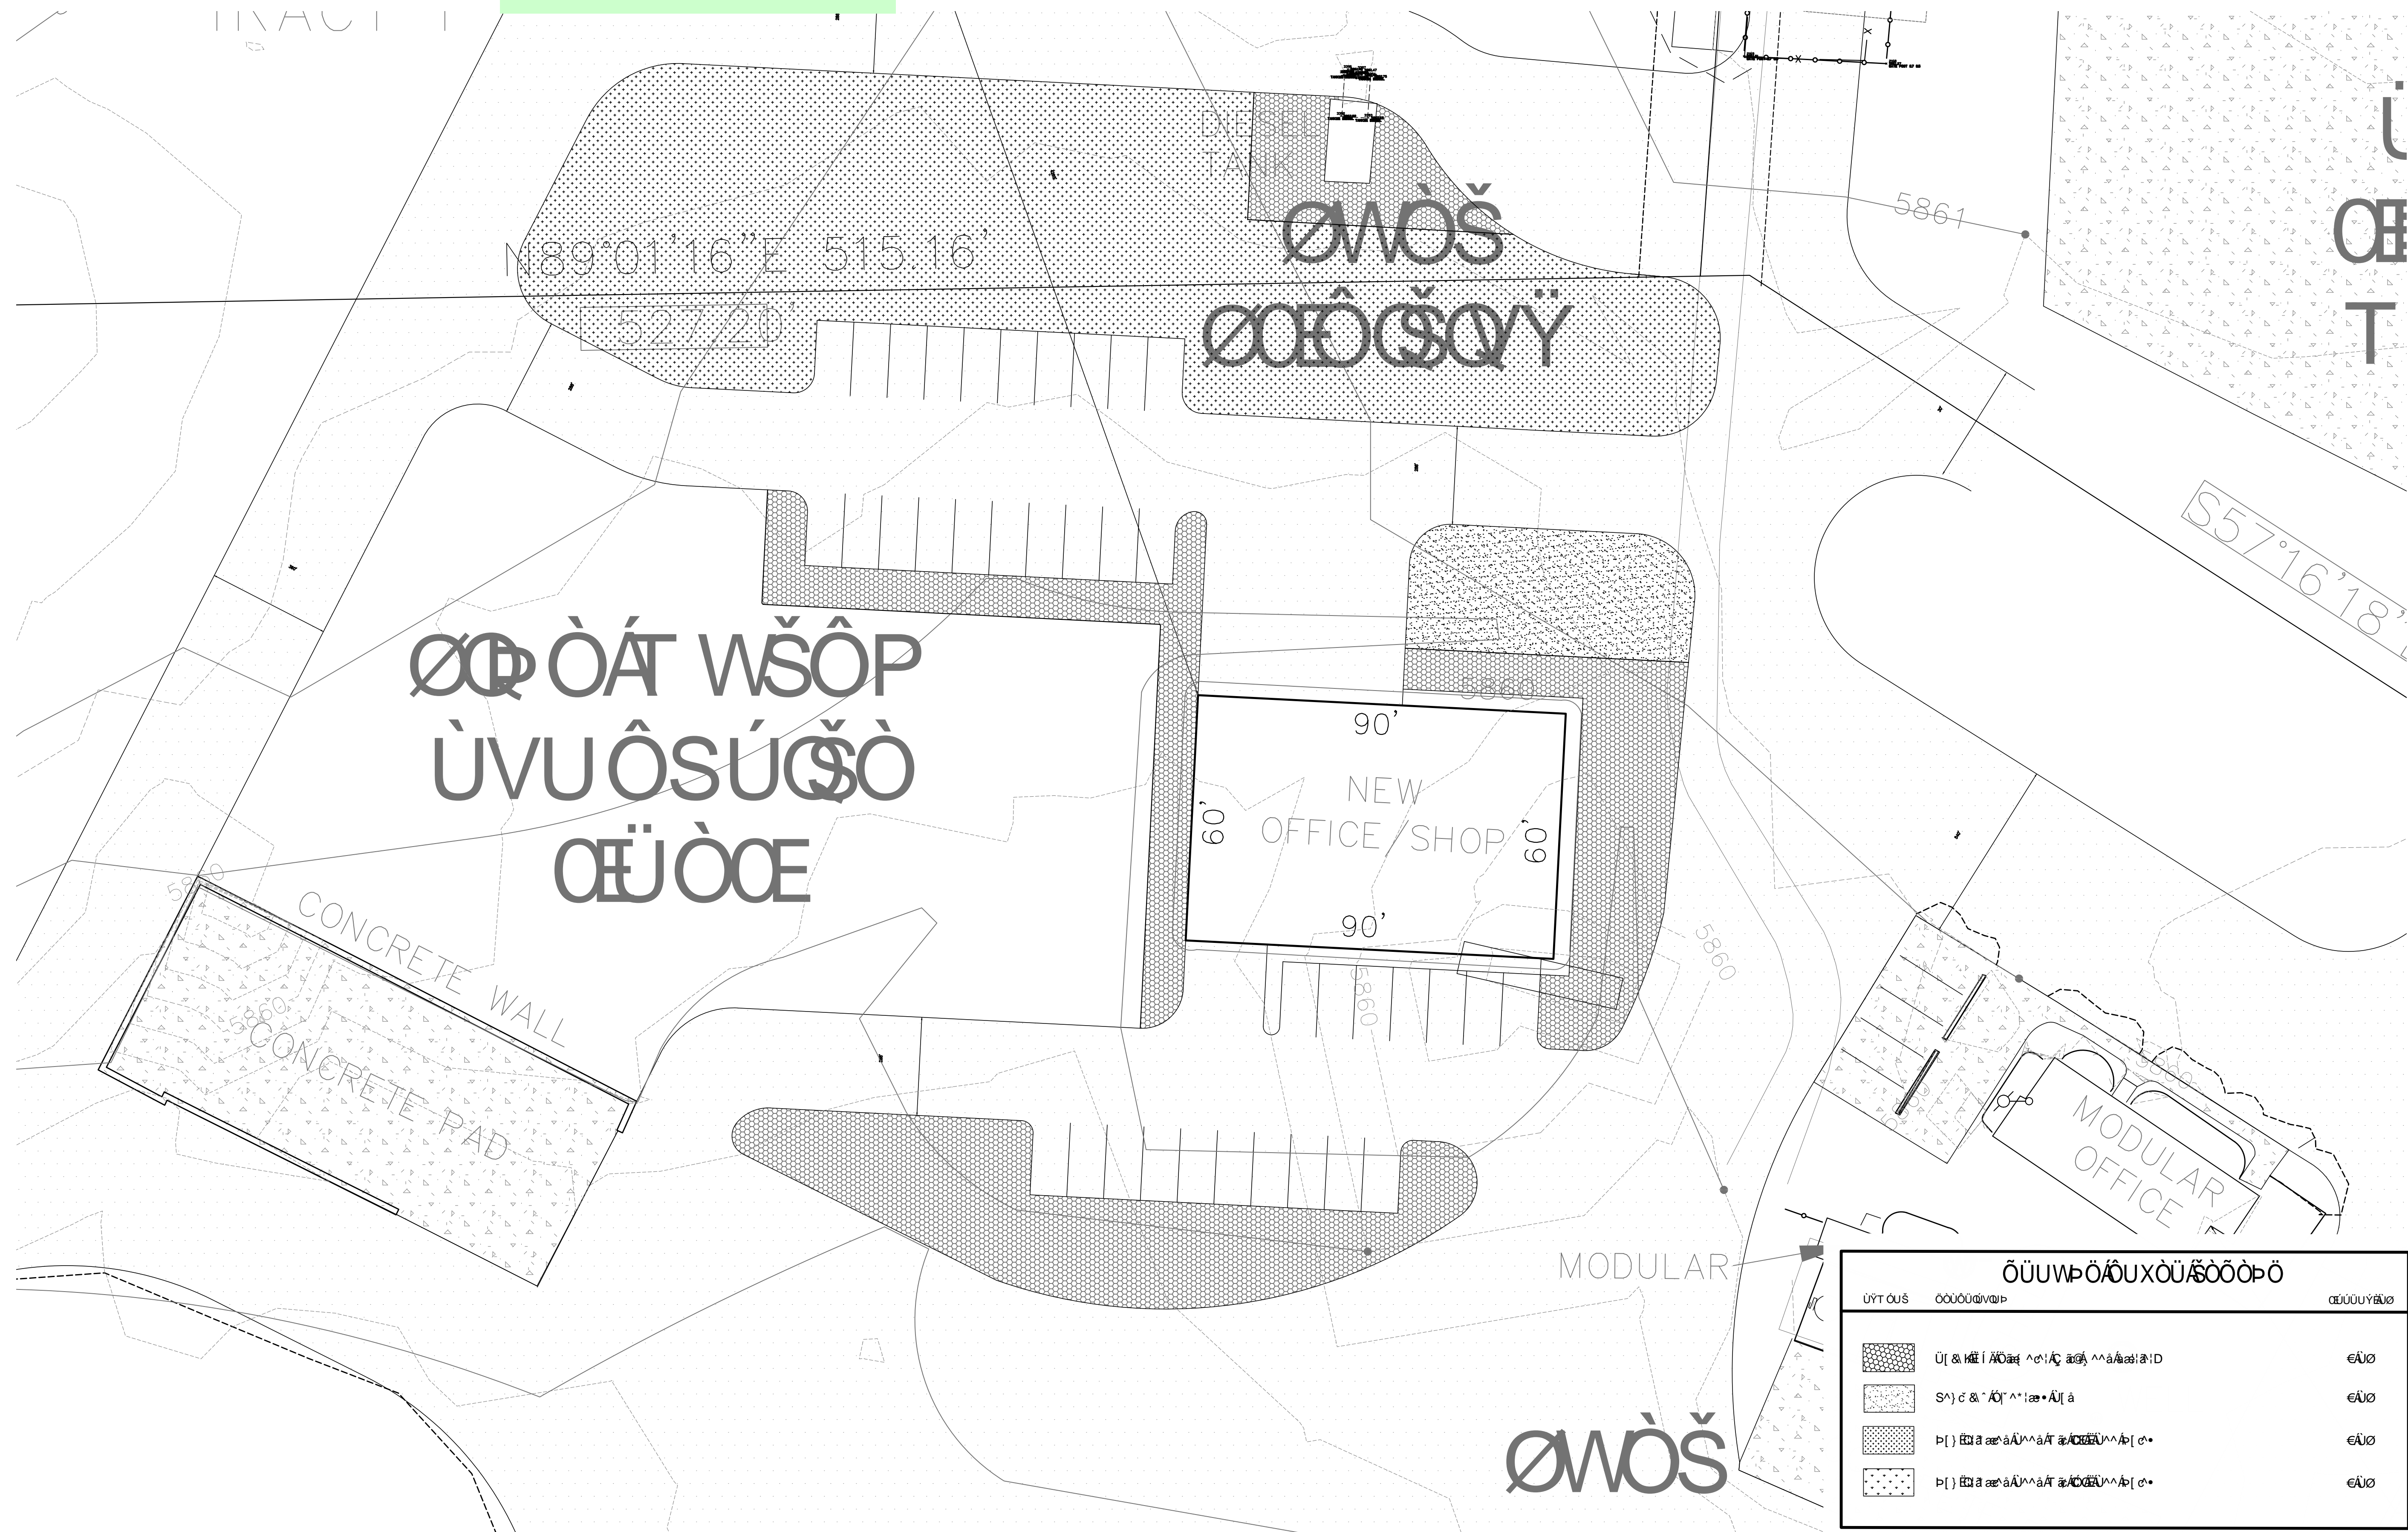

LANDSCAPE PLAN

AREA B

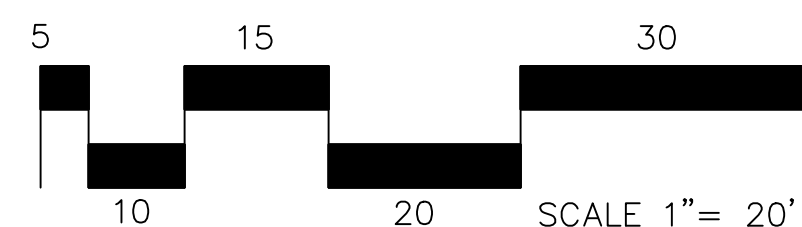

WVŠQOÙÁPUVÒ

[illegible]

ÖUÔWT ÒP VÁP UVC

[illegible]

08G8G75D95F7<H97HI F92D05BB-B; / 4F F# 5H-CB 89G=B

0')\$B C F H<'57589A M6@J8'2GH9"&\$+
7C@CF58C'GDF-B;Gz7C';\$-%,
D\cbY'+%-(+!+!*(*
UI....+%-!&*!%&&&



FC7?MHCD.F9GCI F79G

100%+)) .9".@5G.J9: 5G.GH"

7C@CF58C.GDF B: GZ7C.

DF 9D5F98:CF.

087"-B7"

[illegible]

BCH: CF 7 CBGHFI 7 H€CB

JOB NUMBER, \$+! %

REVISIONS

ORIGINAL DATE	' ! & , ! %
---------------	-------------

DRAWN BY


DESCRIPTION
5F 95 '6
@5B 8G7 5D9 'D@5B

SHEET NO.

@0"

Markup Summary

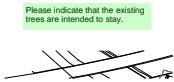


dsdsevigny (1)



Subject: Text Box
Page Label: 1
Lock: Locked
Author: dsdsevigny
Date: 4/24/2019 4:11:33 PM
Color:

Please indicate that the existing trees are intended to stay.

Markup Summary

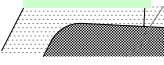 <p>Please indicate that the existing trees are intended to stay.</p>	<p>Subject: Text Box Page Label: 1 Lock: Locked Author: dsdseigny Date: 4/24/2019 4:11:33 PM Color: ■</p>	<p>Please indicate that the existing trees are intended to stay.</p>
 <p>Landscaping requirements pertain to the whole site. What are the required tree along Las Vegas and how many are being provided? Please provide information in the plant schedule. If the existing trees along Las Vegas are to remain, the plan must reference that information.</p>	<p>Subject: Text Box Page Label: 2 Lock: Locked Author: dsdseigny Date: 4/24/2019 4:17:17 PM Color: ■</p>	<p>Landscaping requirements pertain to the whole site. What are the required tree along Las Vegas and how many are being provided? Please provide information in the plant schedule. If the existing trees along Las Vegas are to remain, the plan must reference that information.</p>
 <p>Section 6.2.2(C) Parking Lot Landscape Requirements. There are no trees indicated in this parking lot detail.</p>	<p>Subject: Text Box Page Label: 3 Lock: Locked Author: dsdseigny Date: 4/24/2019 4:17:19 PM Color: ■</p>	<p>Section 6.2.2(C) Parking Lot Landscape Requirements. There are no trees indicated in this parking lot detail.</p>