

VICINITY MAP
N.T.S.

Site Coordinates (Lat/Long): 38.76473, -104.61765

Address: 11295 Bradley Rd, El Paso County, CO

Rolling Meadows Substation
Construction of a New Electrical Substation
including Grading, Drainage, and Surface Improvements
El Paso County, Colorado

PCD FILE NO. TBD

Construction Plans prepared in cooperation with:



DEL-MONT CONSULTANTS, INC.
ENGINEERING ▼ SURVEYING
125 Colorado Ave. ▼ Montrose, CO 81401 ▼ (970) 249-2251
www.del-mont.com ▼ service@del-mont.com

ENGINEER'S STATEMENT:

This grading and erosion control plan was prepared under my direction and supervision and is correct to the best of my knowledge and belief. said plan has been prepared according to the criteria established by the County for grading and erosion control plans. I accept responsibility for any liability caused by any negligent acts, errors or omissions on my part in preparing this plan.

EL PASO COUNTY:

County plan review is provided only for general conformance with County Design Criteria. The County is not responsible for the accuracy and adequacy of the design, dimensions, and/ or elevations which shall be confirmed at the job site. The County through the approval of this document assumes no responsibility for completeness and/ or accuracy of this document. Filed in accordance with the requirements of the El Paso County Land Development Code, Drainage Criteria Manual Volumes 1 and 2, and Engineering Criteria Manual, as amended. In accordance with EOM Section 1.12, these construction documents will be valid for construction for a period of 2 years from the date signed by the El Paso County Engineer. If construction has not started within those 2 years, the plans will need to be resubmitted for approval, including payment of review fees at the Planning and Community Development Director's discretion.

EPC STORMWATER REVIEW COMMENTS
IN ORANGE BOXES WITH BLACK TEXT

COORDINATE SYSTEM: Colorado State Plane Central Zone
SCALE FACTOR: 1.0003223877
VERTICAL DATUM = NAVD88
HORIZONTAL DATUM = NAD 83

NOTE:
ORIGINAL SITE COORDINATES HAVE BEEN ADJUSTED FROM GRID TO GROUND .

A HORIZONTAL ADJUSTMENT WAS MADE BY APPLYING A GROUND SCALE FACTOR OF 1.0003223877, WHICH IS EQUIVALENT TO A NORTHING OFFSET OF 432.070', AND AN EASTING OFFSET OF 1047.946',

A VERTICAL ADJUSTMENT OF +3.353' WAS APPLIED TO CONVERT VERTICAL DATUM FROM NGVD29.

Include Sheet Index

H. Steven Gray, Vice President
Tri-State Generation and Transmission Association, Inc.
1100 W. 116th Ave, Westminster, CO 80234

Date _____

David Schieldt, P.E. #47195

04-27-2026
Date

Joshua J. Palmer, P.E.
County Engineer Signature/ECM Administrator

Date _____

PPR2619

TRI-STATE
Generation and Transmission
Association, Inc.

A Touchstone Energy Cooperative

1100 W. 116th Ave.
P.O. Box 33695
Denver, Colorado 80233
303-452-6111

n:	Date:
1C	06/22/26
od:	Date:
VS	06/22/26


S1183-A-01-001

115/12.47kV
COVER SHEET

ED BY: WILDCAT	6/19/2026 9:37 AM	Contract: 4713
----------------	-------------------	----------------

PATH: \\DMS14\Projects\Active Projects\2024\24028-TSGT Rolling Meadows Substation\Facility\Civil\Sheets\S1183-A-01-SHEETS.dwg

[illegible]

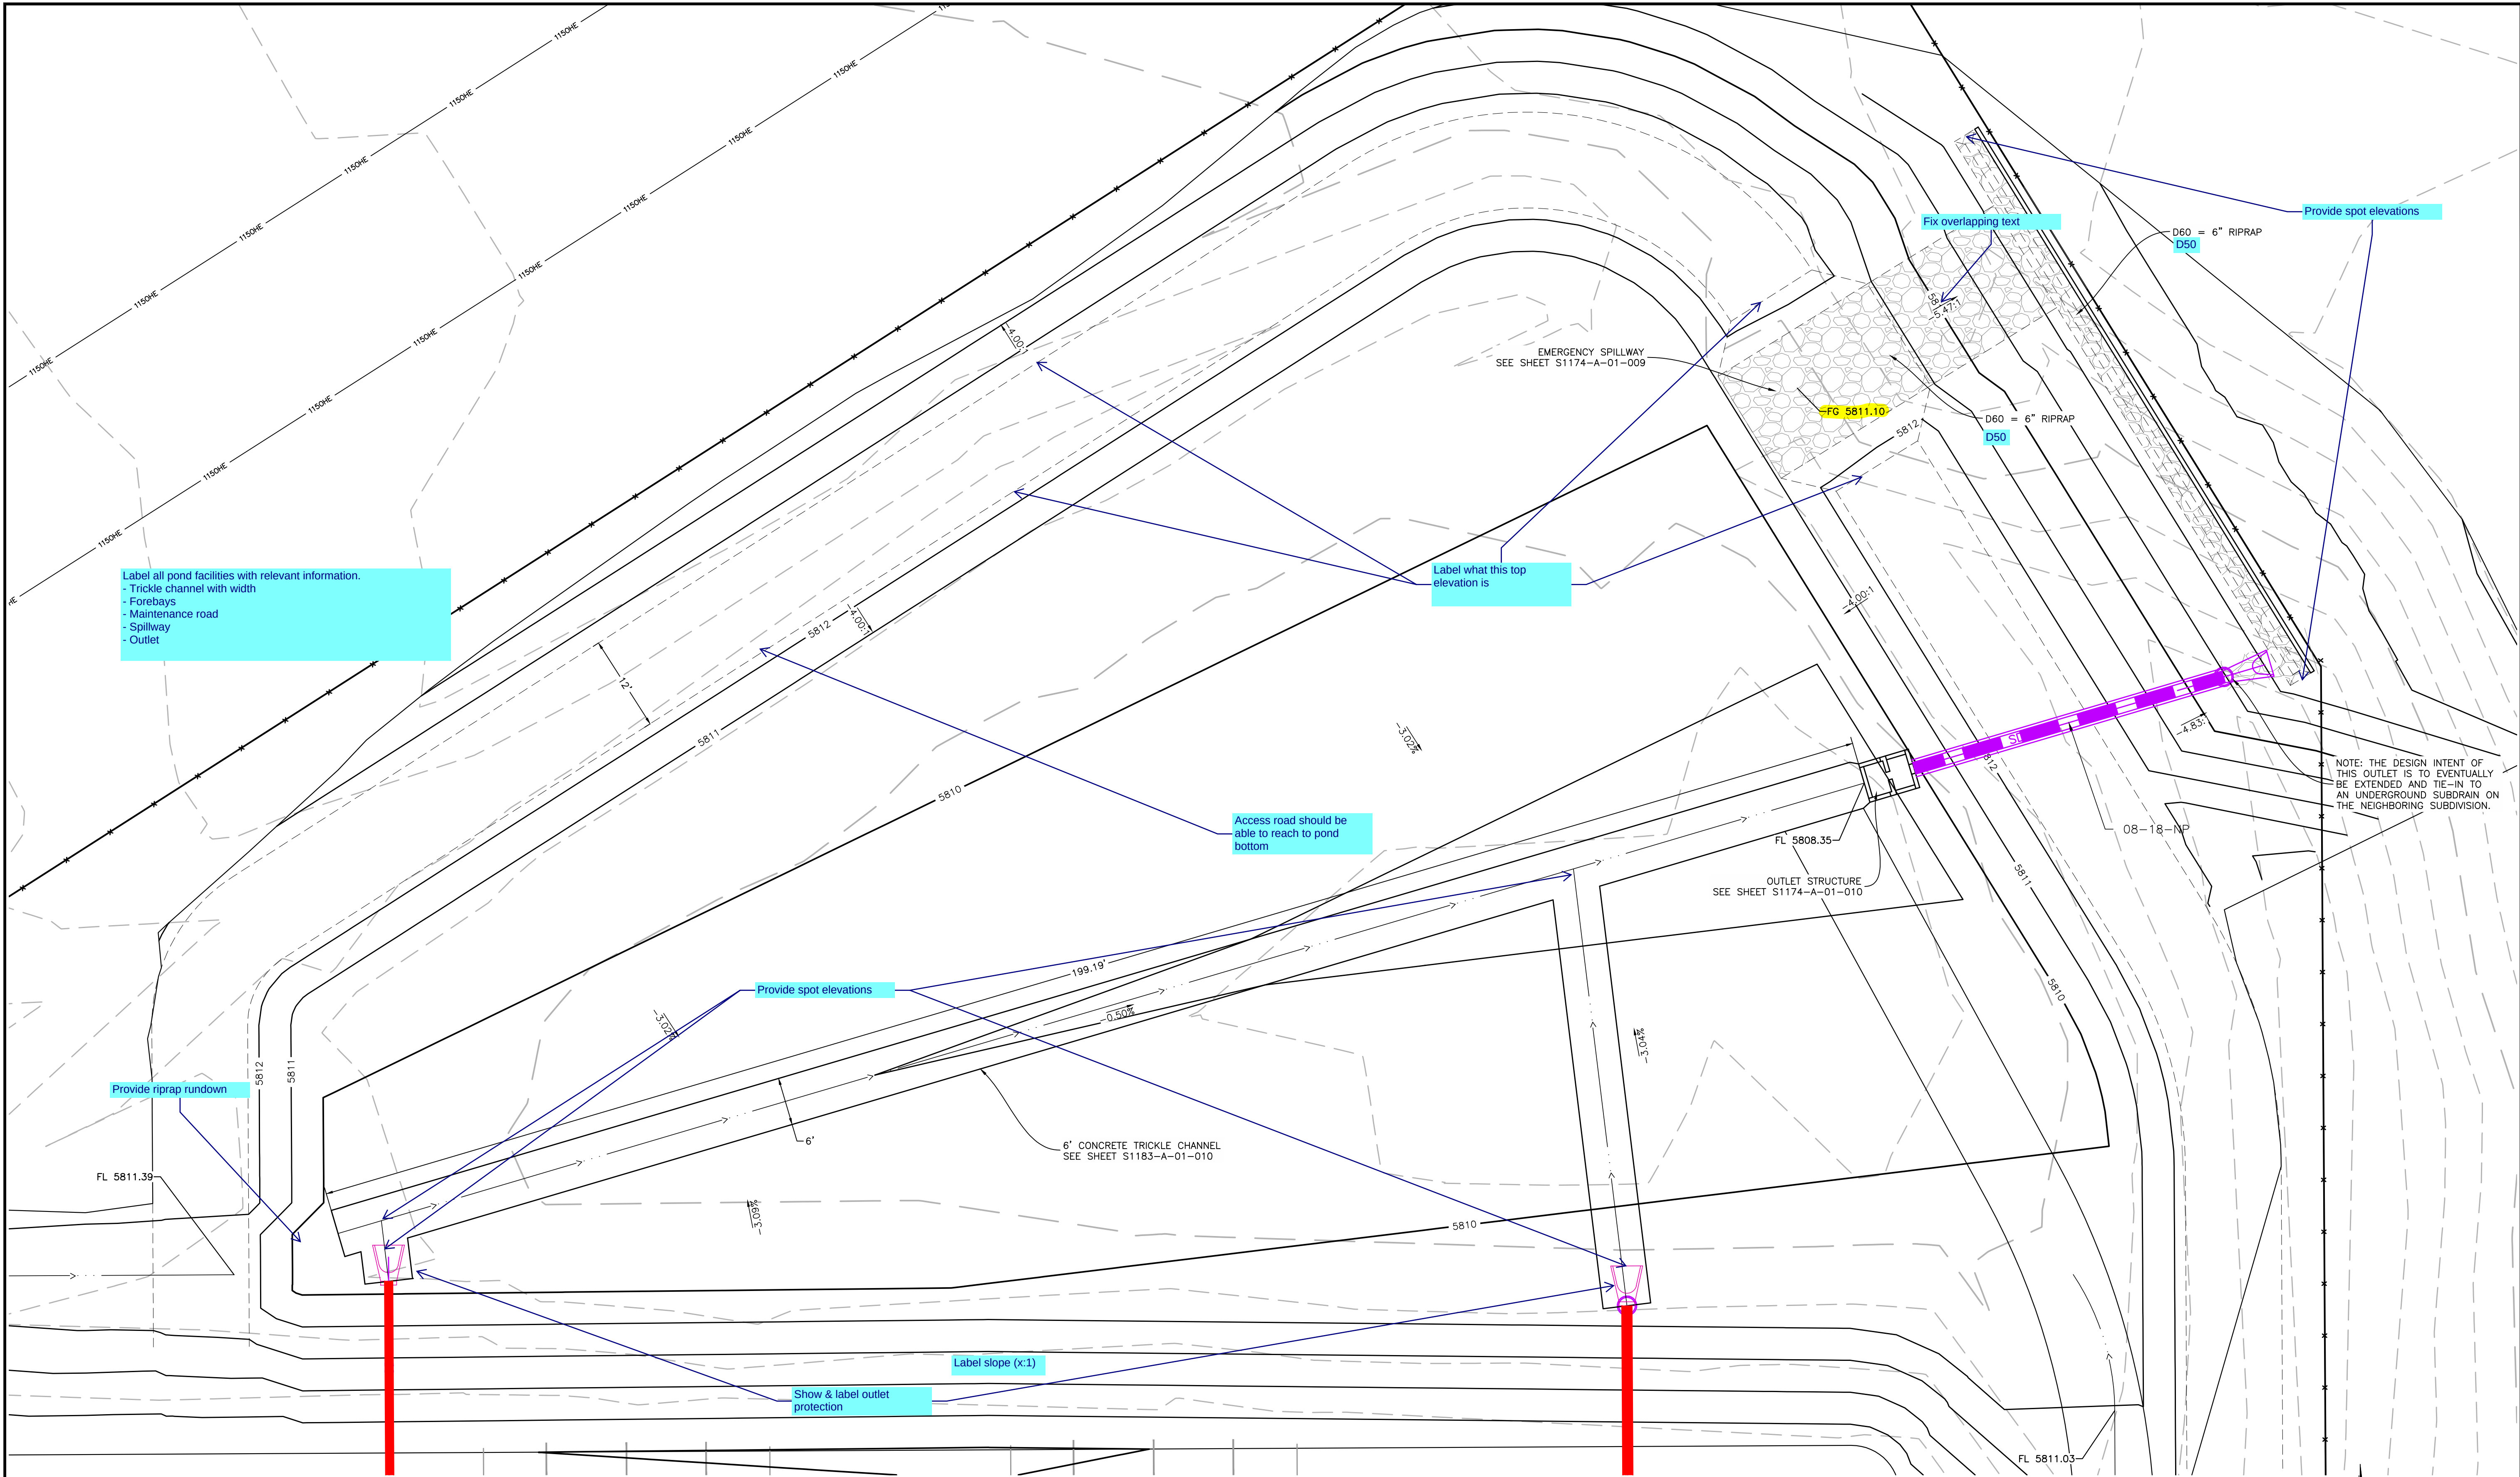


LEGEND

- | | |
|--|-------------------------------|
| | EXISTING INDEX CONTOUR |
| | EXISTING INTERMEDIATE CONTOUR |
| | EXISTING OVERHEAD POWER LINE |
| | EXISTING FENCE |
| | BASELINE |
| | PROPOSED INDEX CONTOUR |
| | PROPOSED INTERMEDIATE CONTOUR |
| | PROPOSED SUBDRAIN |
| | PROPOSED GRADE BRAKE LINE |
| | PROPOSED SUBSTATION FENCE |
| | PROPOSED DRAINAGE FLOWLINE |
| | PROPOSED RIPRAP |
| | PROPOSED SUBDRAIN CLEANOUT |

NOTE:

- THE HORIZONTAL LOCATION FOR THE CONTROL POINT AT THE INTERSECTION OF THE TWO BASELINES IS FIXED. LOCATIONS FOR OTHER CONTROL POINTS MAY BE ADJUSTED ALONG THE BASELINE AS NECESSARY TO PROVIDE FOR CLEAR LINES OF SIGHT AROUND EXISTING VEGETATION TO REMAIN.
- SURVEYOR SHALL SET THE CONTROL POINTS OUTSIDE THE SUBSTATION SECURITY FENCE IN-THE-FIELD, AND REPORT THE COORDINATES AND ELEVATIONS TO THE OWNER'S AUTHORIZED TECHNICAL REPRESENTATIVE (OATR).
- COORDINATE SYSTEM: COLORADO STATE PLANE CENTRAL ZONE
SCALE FACTOR = 1.0003223877
VERTICAL DATUM = NAVD89
HORIZONTAL DATUM = NAD 83

Show maintenance roadway in planview

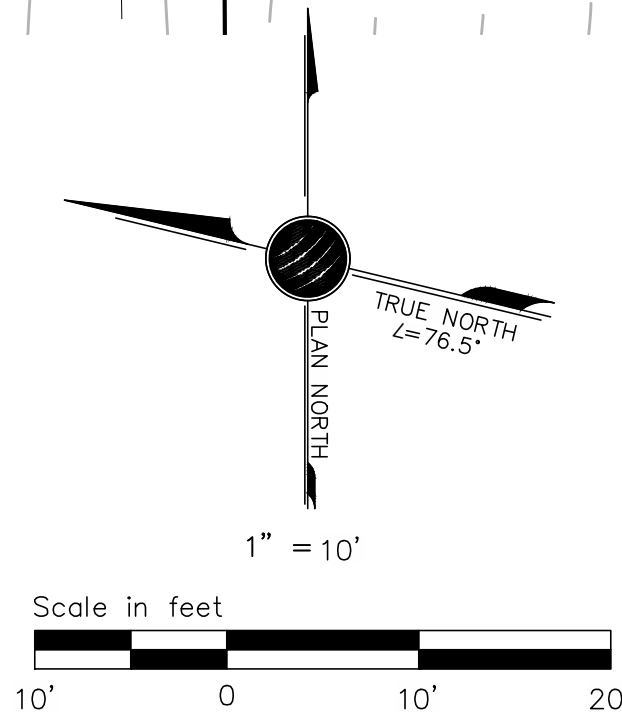

ROLLING MEADOWS SUBSTATION
115/12.47KV
EDB-1 GRADING

TRI-STATE
Generation and Transmission
Association, Inc.
A Touchstone Energy Cooperative
1100 W. 116th Ave.
P.O. Box 33895
Denver, Colorado 80233
303-452-6111


Dwn: TMC	Date: 06/22/26
Appd: DWS	Date: 06/22/26

S1183-A-01-007


No.	Date	Dwn.	Appd.	Revision	M.F.
7					
6					
5					
4					
3					
2					
1					

Dwg. No.	Mfr.	Reference Drawings


Drawing Title

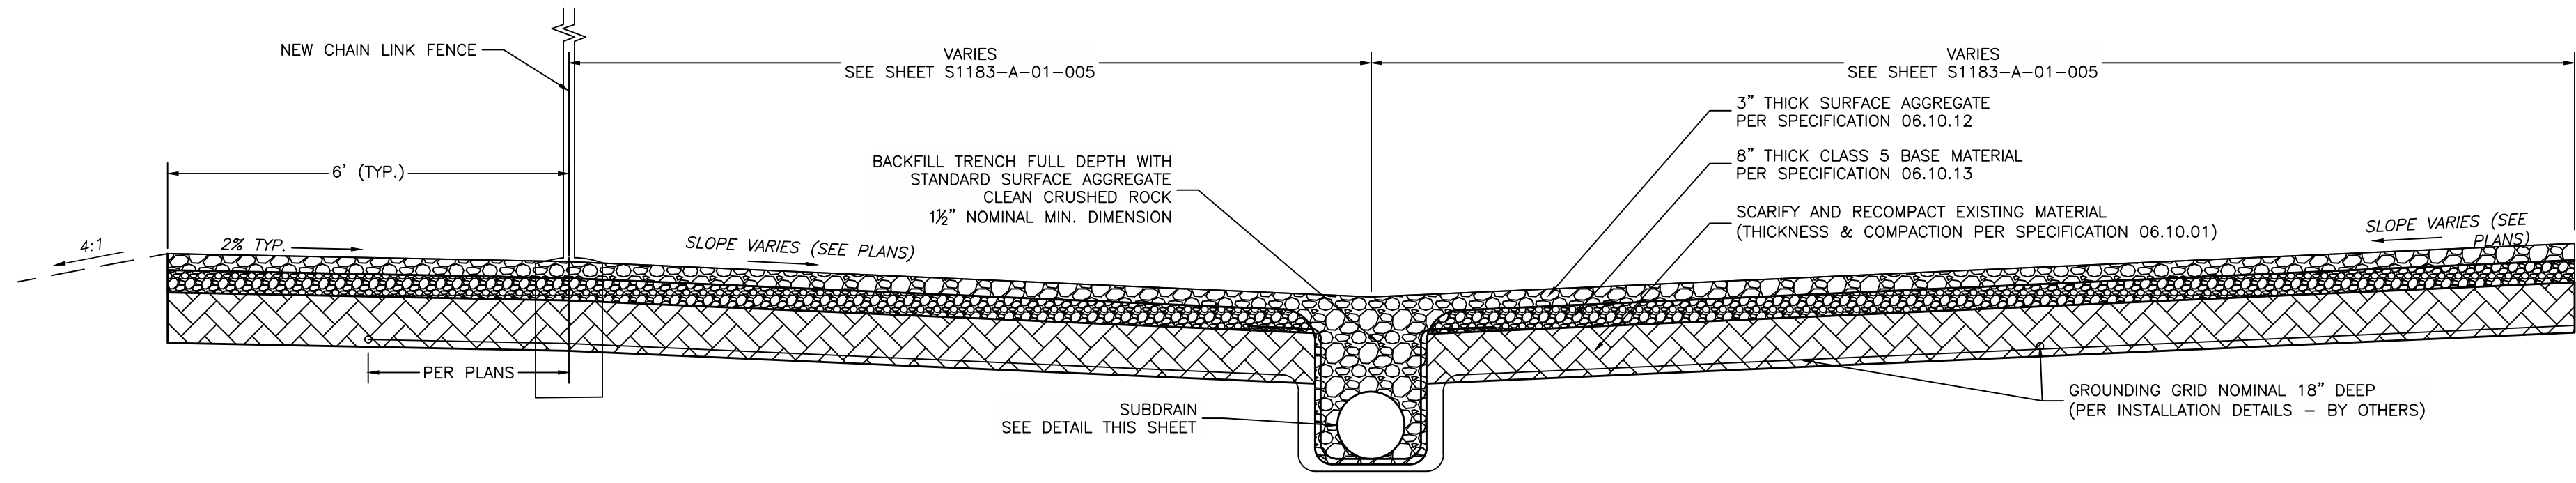


TYPICAL INTERIOR SUBDRAIN & YARD SECTION
N.T.S.

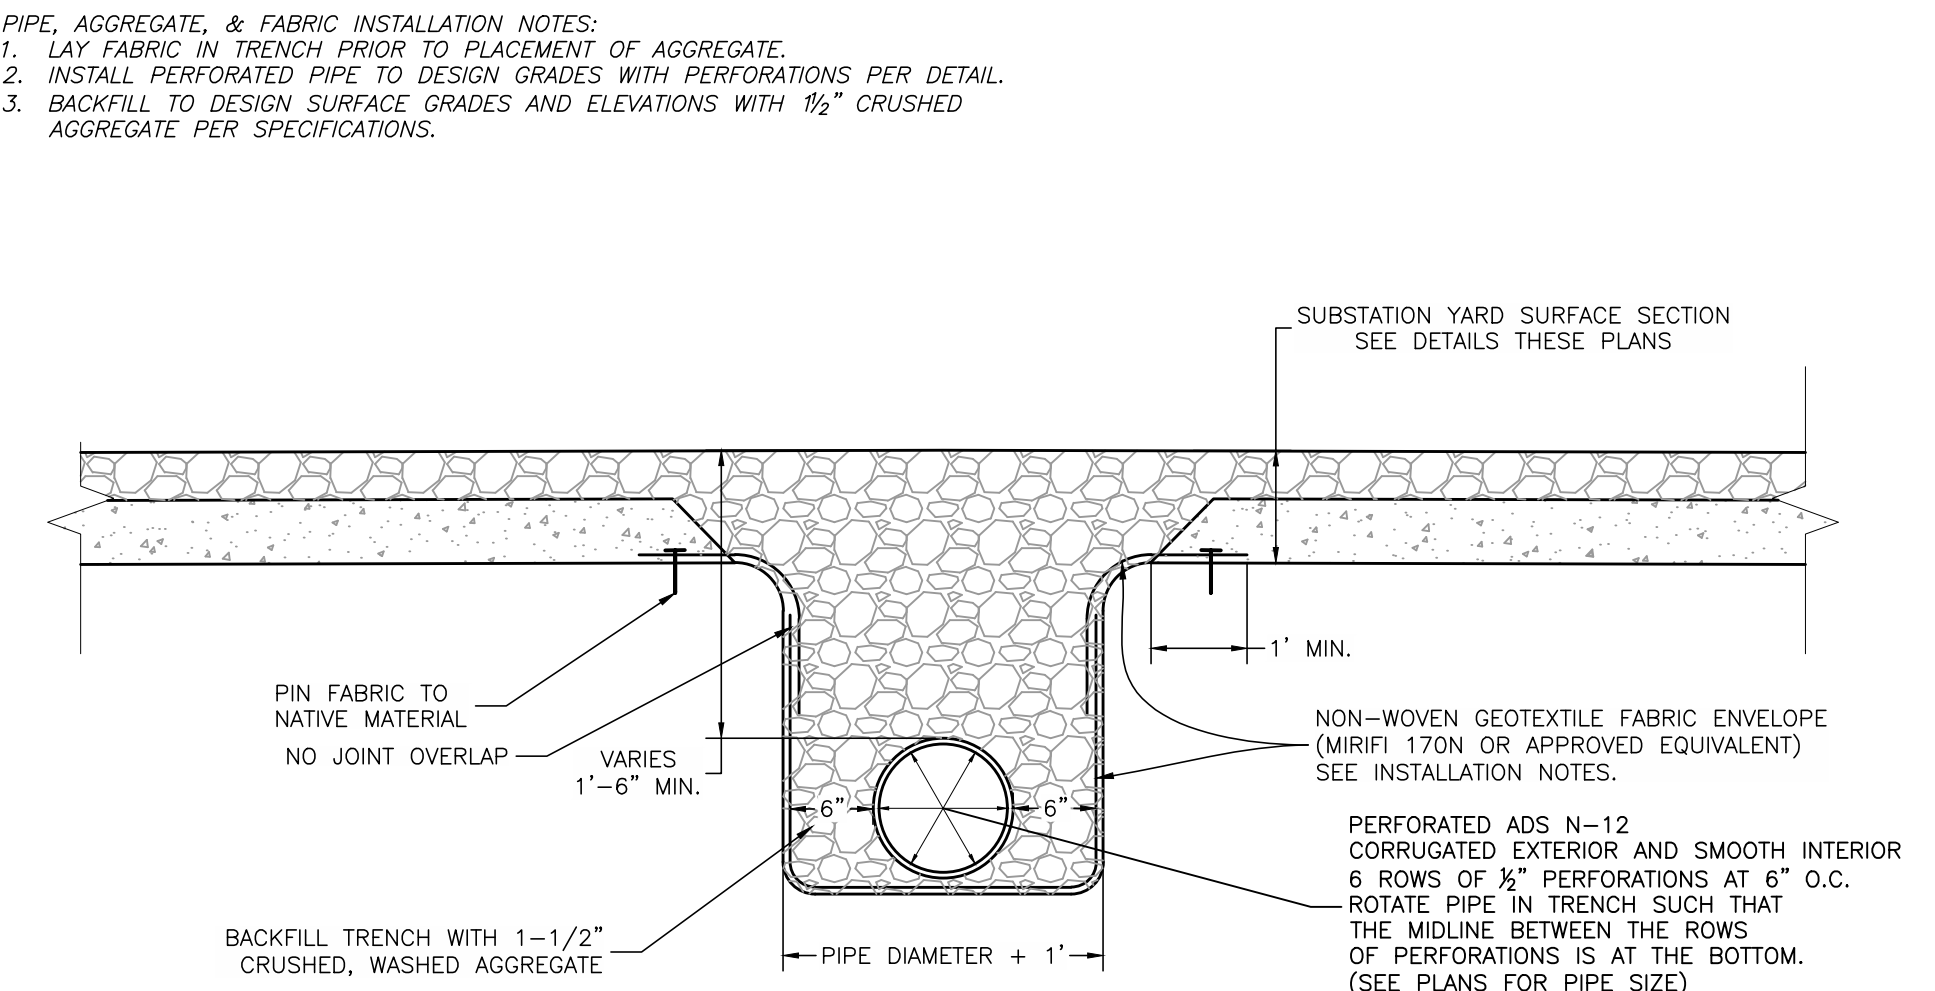


TYPICAL PERFORATED SUBDRAIN DETAIL
N.T.S.

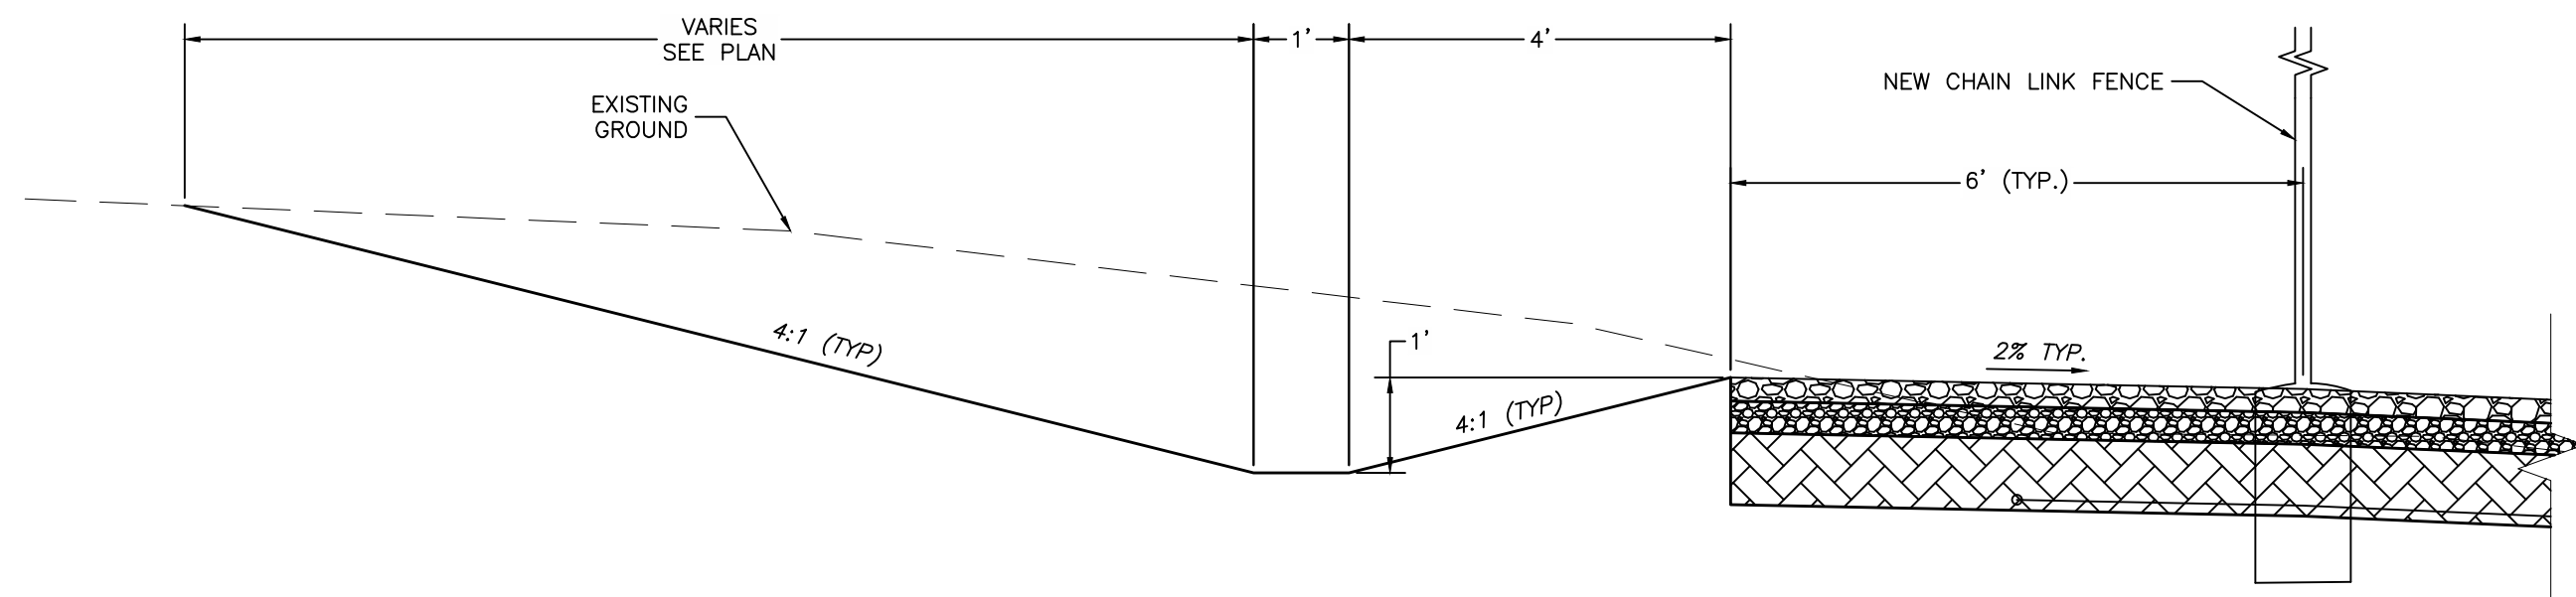

TYPICAL SWALE SECTION A-A
N.T.S.

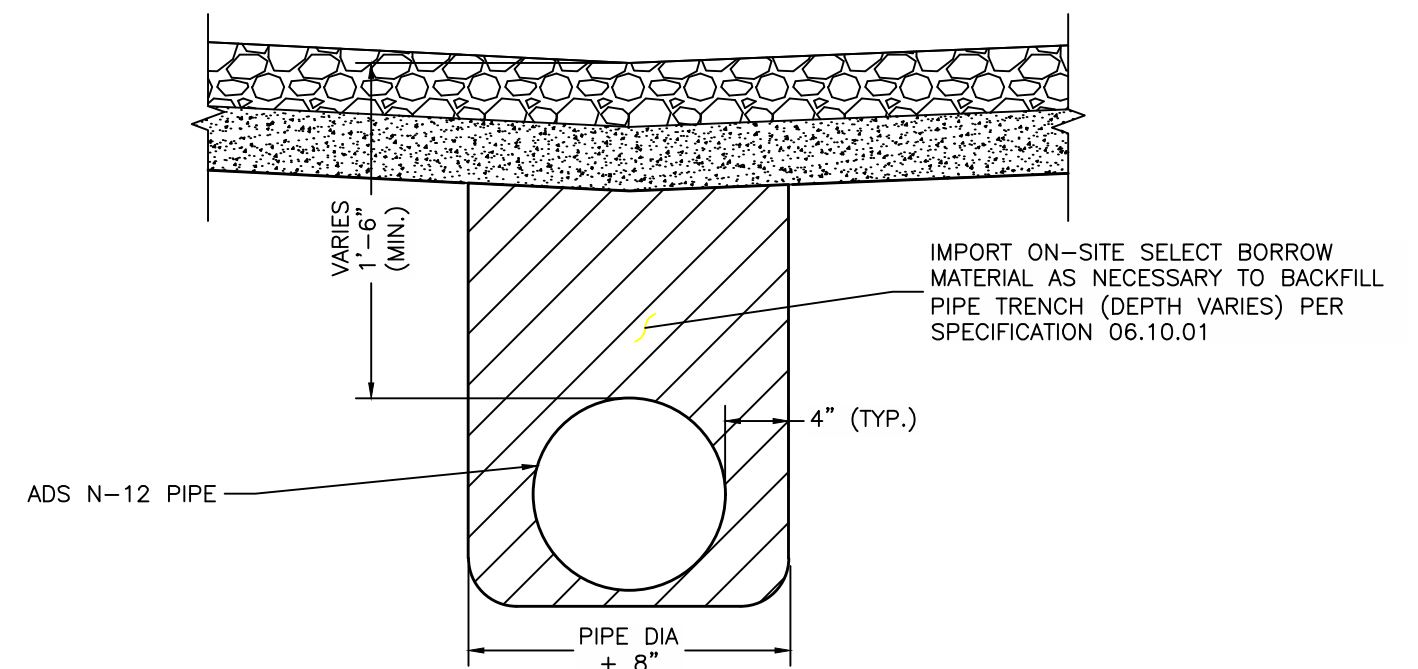

TYPICAL SOLID SUBDRAIN DRAIN DETAIL
N.T.S.

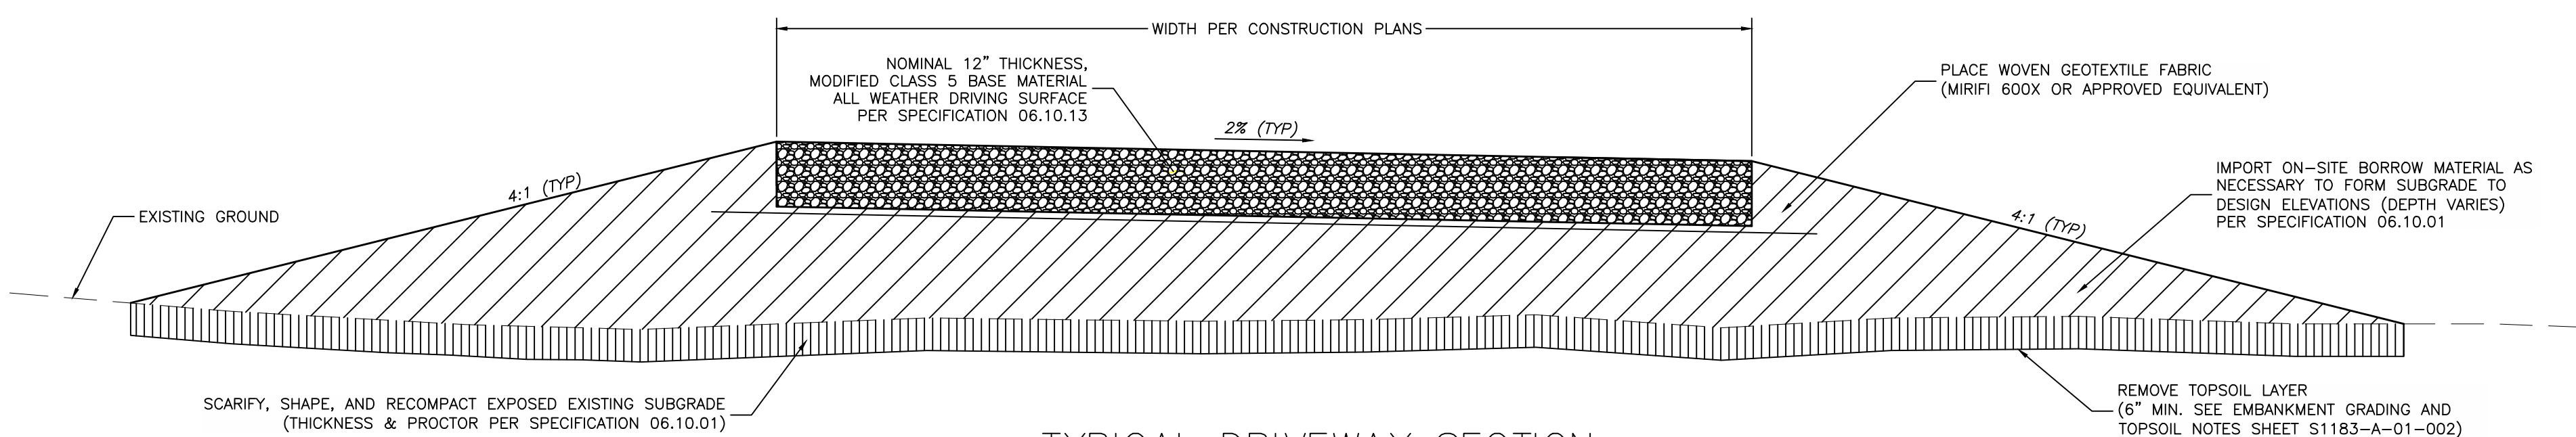

TYPICAL DRIVEWAY SECTION
N.T.S.

Provide driveway section for paved portion (first 50' of drive)

PIPE, AGGREGATE, & FABRIC INSTALLATION NOTES:
1. LAY FABRIC IN TRENCH PRIOR TO PLACEMENT OF AGGREGATE.
2. INSTALL PERFORATED PIPE TO DESIGN GRADES WITH PERFORATIONS PER DETAIL.
3. BACKFILL TO DESIGN SURFACE GRADES AND ELEVATIONS WITH 1/2\"/>

ROLLING MEADOWS SUBSTATION 115/12.47KV CIVIL DETAILS		TRI-STATE GENERATION & TRANSMISSION ASSOCIATION, INCORPORATED 1100 W. 116th Ave. P.O. Box 33695 Denver, Colorado 80233 303-452-6111		Dwn: TMC Appd: DWS		Date: 06/22/26	
S1183-A-01-009		S1183-A-01-009		S1183-A-01-009		S1183-A-01-009	

SECTION C

SECTION
NTS


ORIFICE PLATE NOTES:

1. PROVIDE CONTINUOUS NEOPRENE GASKET MATERIAL BETWEEN THE ORIFICE PLATE AND CONCRETE. THE GASKET SHALL BE MADE OF 1/4-INCH THICK, 60 DUROMETER EPDM RUBBER IN A CONTINUOUS SHEET THE SIZE OF THE ORIFICE PLATE. THE SHEET SHALL BE PLACED BETWEEN THE ORIFICE PLATE AND THE CONCRETE WALL, WITH THE WIDTH OF THE OVERLAP BETWEEN THE PLATE AND THE CONCRETE. OPENINGS SHALL BE CUT INTO THE SHEET CORRESPONDING TO THE PLATE BOLT HOLES AND THE CONCRETE WALL OPENINGS. CUTS MADE EITHER BY THE CONTRACTOR IN THE FIELD OR BY THE MANUFACTURER, OR EQUIVALENT GASKET APPROVED BY EPC. NOTE THAT CAULK IS NOT AN APPROVED EQUIVALENT AND WILL NOT BE ACCEPTED BY EPC.
2. BOLT PLATE TO CONCRETE 12" MAX. ON CENTER.


WQCV TRASH RACKS:

1. WELL-SCREEN TRASH RACKS SHALL BE STAINLESS STEEL AND SHALL BE ATTACHED BY INTERMITTENT WELDS ALONG THE EDGES OF THE MOUNTING FRAME.
 2. TRASH RACK OPEN AREAS ARE FOR SPECIFIED TRASH RACK MATERIALS. TOTAL TRASH RACK SIZE MAY NEED TO BE ADJUSTED FOR MATERIALS HAVING DIFFERENT OPEN AREA/GROSS AREA RATIO (R VALUE).
 3. STRUCTURAL DESIGN OF TRASH RACKS SHALL BE BASED ON FULL HYDROSTATIC HEAD WITH ZERO HEAD DOWNSTREAM OF THE RACK.
- OVERFLOW SAFETY GRATES:
1. ALL SAFETY GRATES SHALL BE MOUNTED USING STAINLESS STEEL HARDWARE AND PROVIDED WITH HINGED AND LOCKABLE OR BOLTABLE ACCESS PANELS.
 2. SAFETY GRATES SHALL BE STAINLESS STEEL, ALUMINUM, OR STEEL. STEEL GRATES SHALL BE HOT DIP GALVANIZED AND MAY BE HOT POWDER COATED AFTER GALVANIZING.
 3. SAFETY GRATES SHALL BE DESIGNED SUCH THAT THE DIAGONAL DIMENSION OF EACH OPENING IS SMALLER THAN THE DIAMETER OF THE OUTLET PIPE.
 4. STRUCTURAL DESIGN OF SAFETY GRATES SHALL BE BASED ON FULL HYDROSTATIC HEAD WITH ZERO HEAD DOWNSTREAM OF THE RACK.

ORIFICE PLATE AND TRASH RACK DETAILS AND NOTES

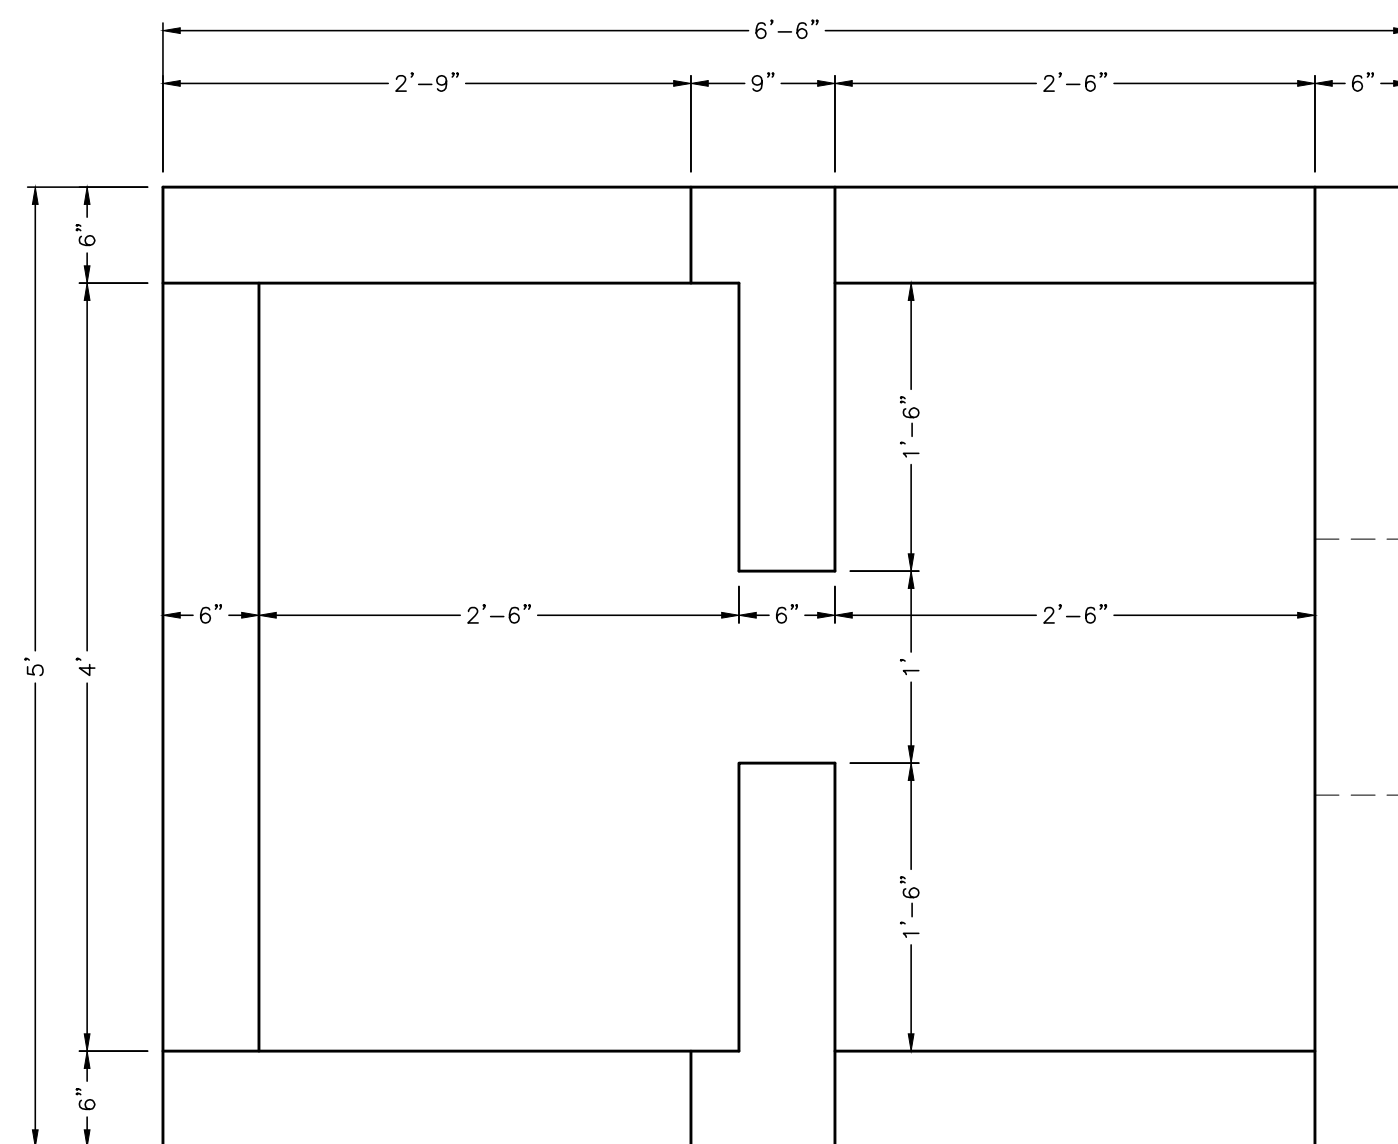


CONCRETE OUTLET STRUCTURE
TOP VIEW
N.T.S.

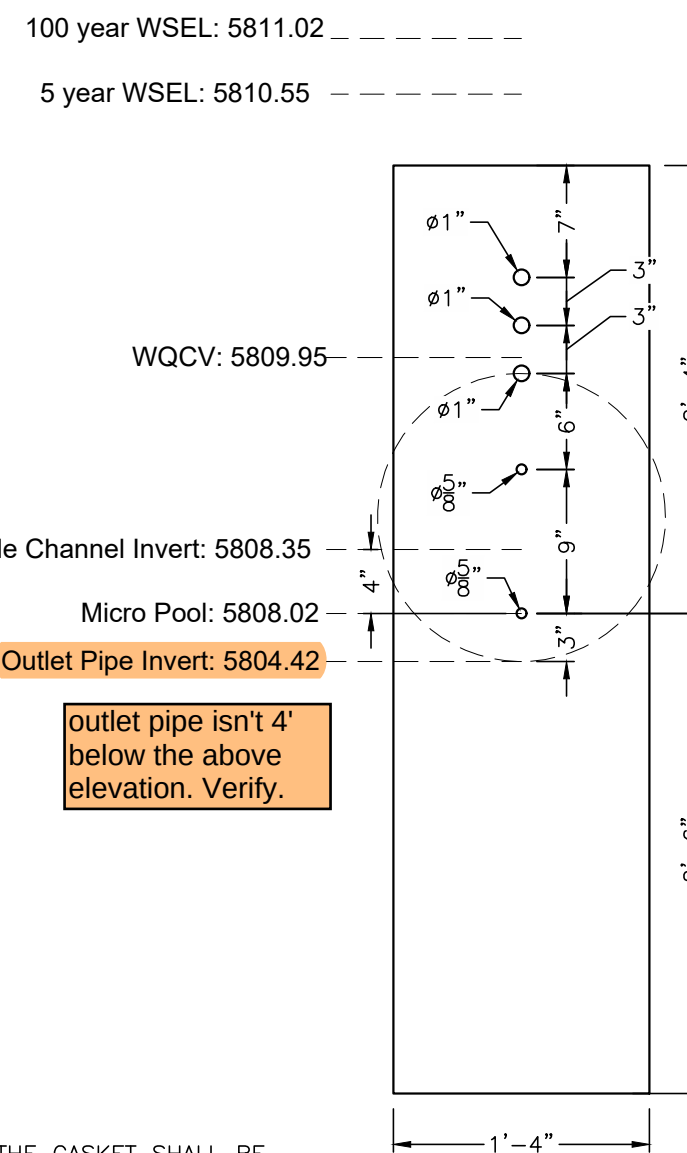


ORIFICE PLATE


Provide restrictor plate detail.

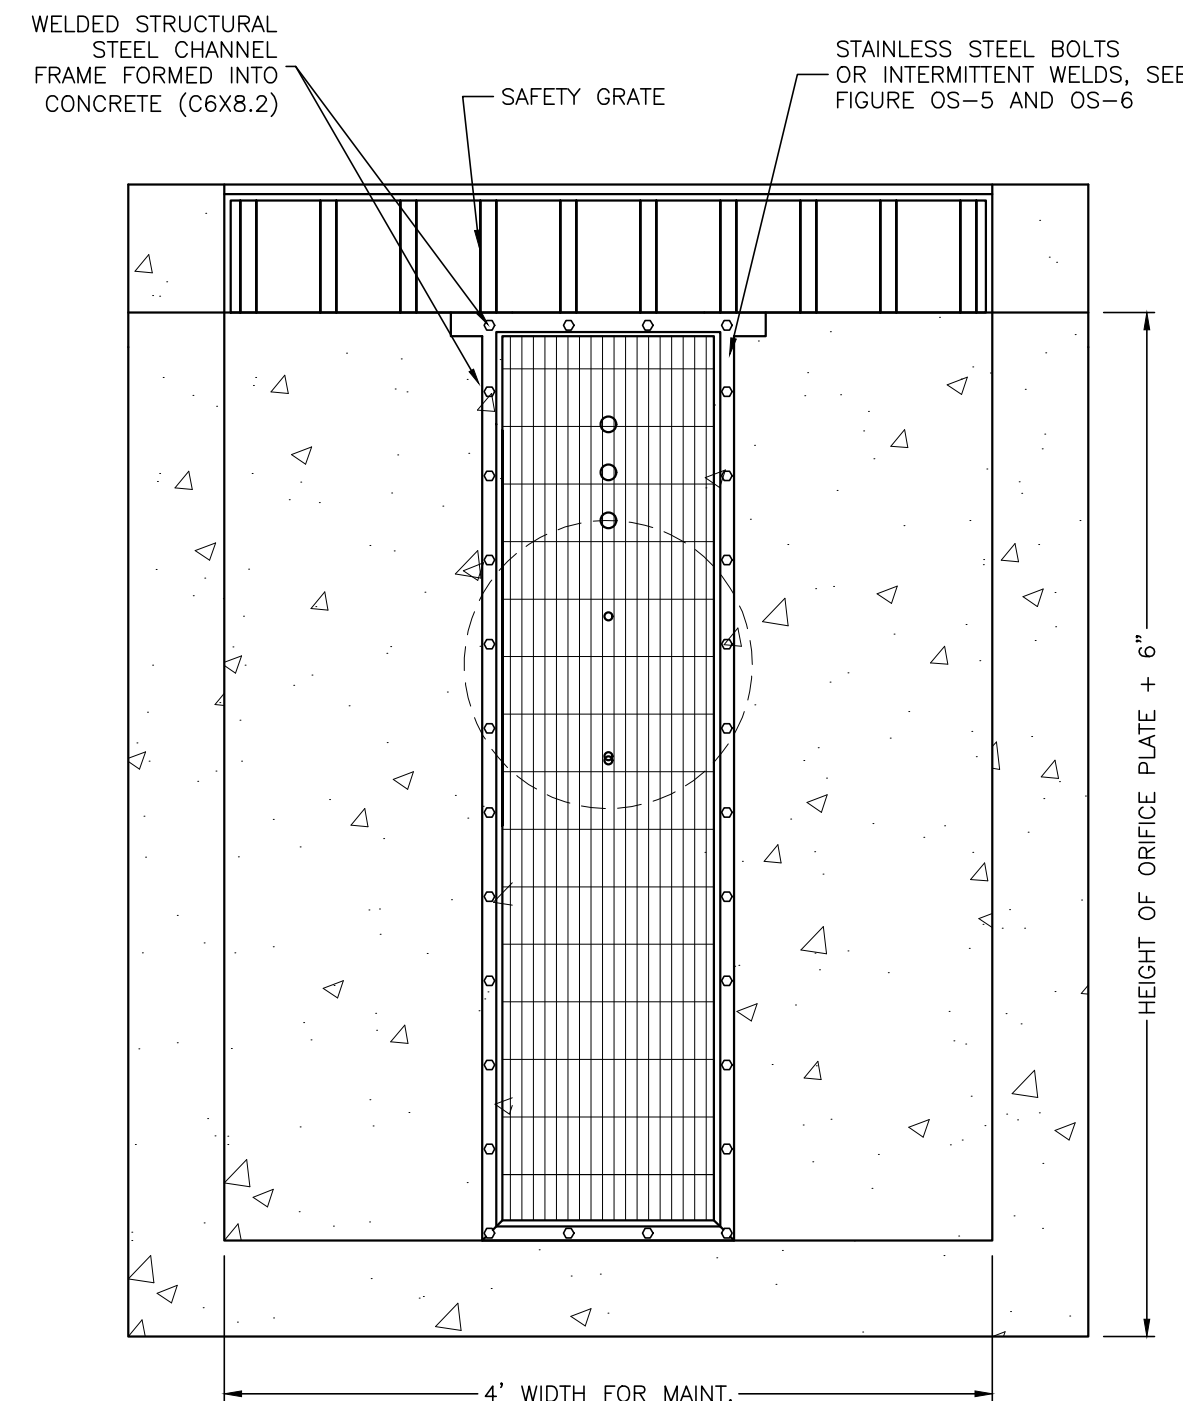

SECTION _____

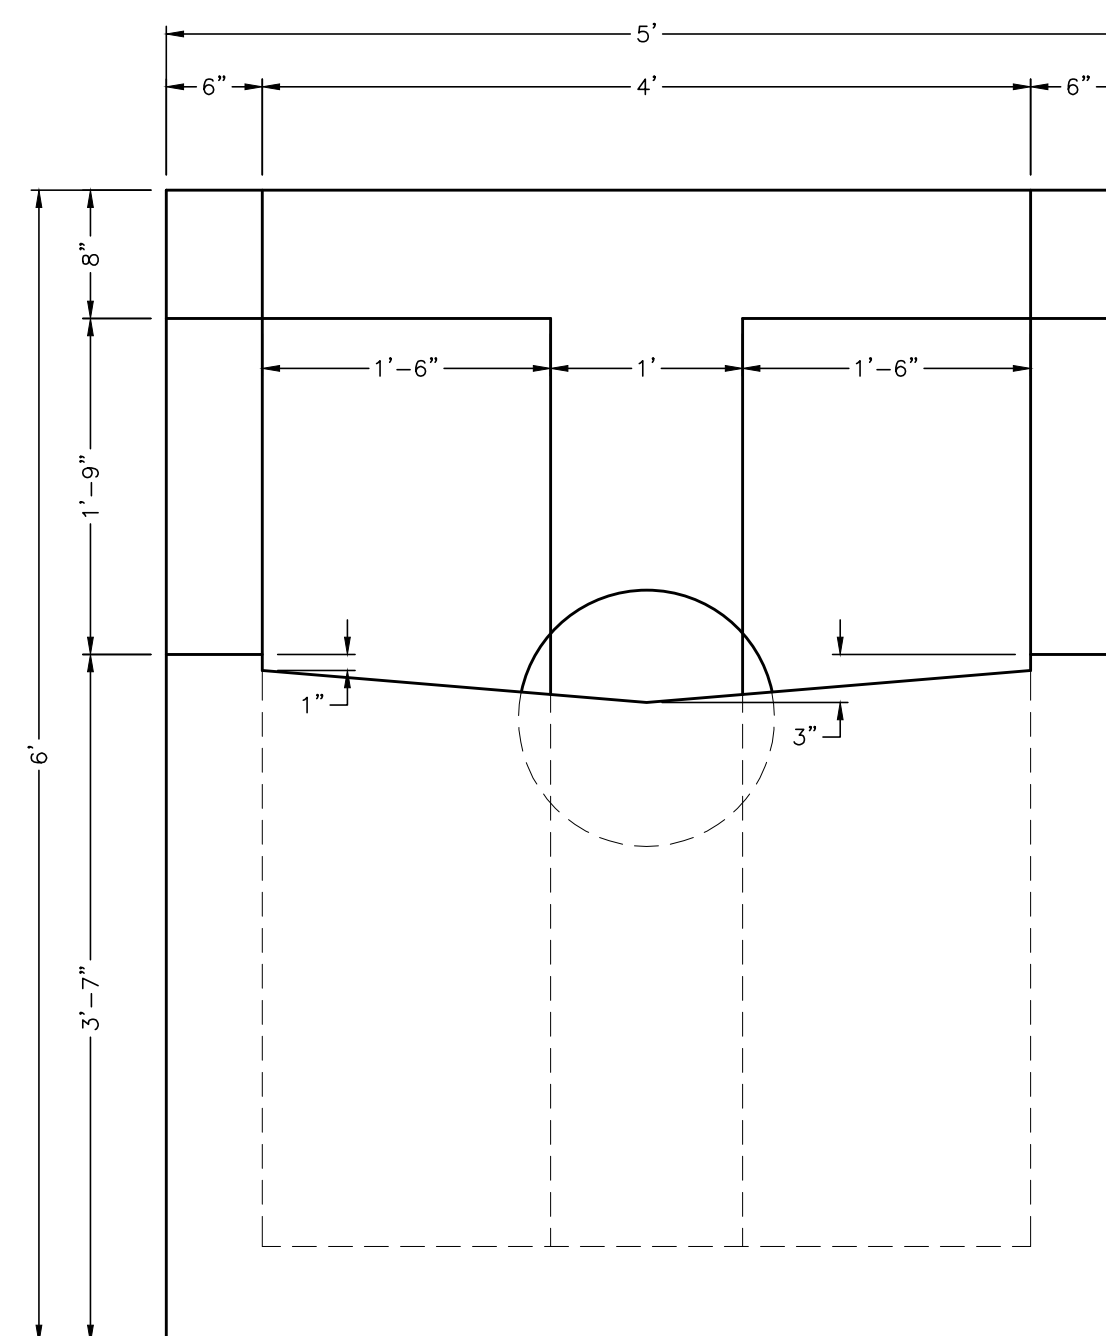


CONCRETE OUTLET STRUCTURE
FRONT VIEW
N.T.S.

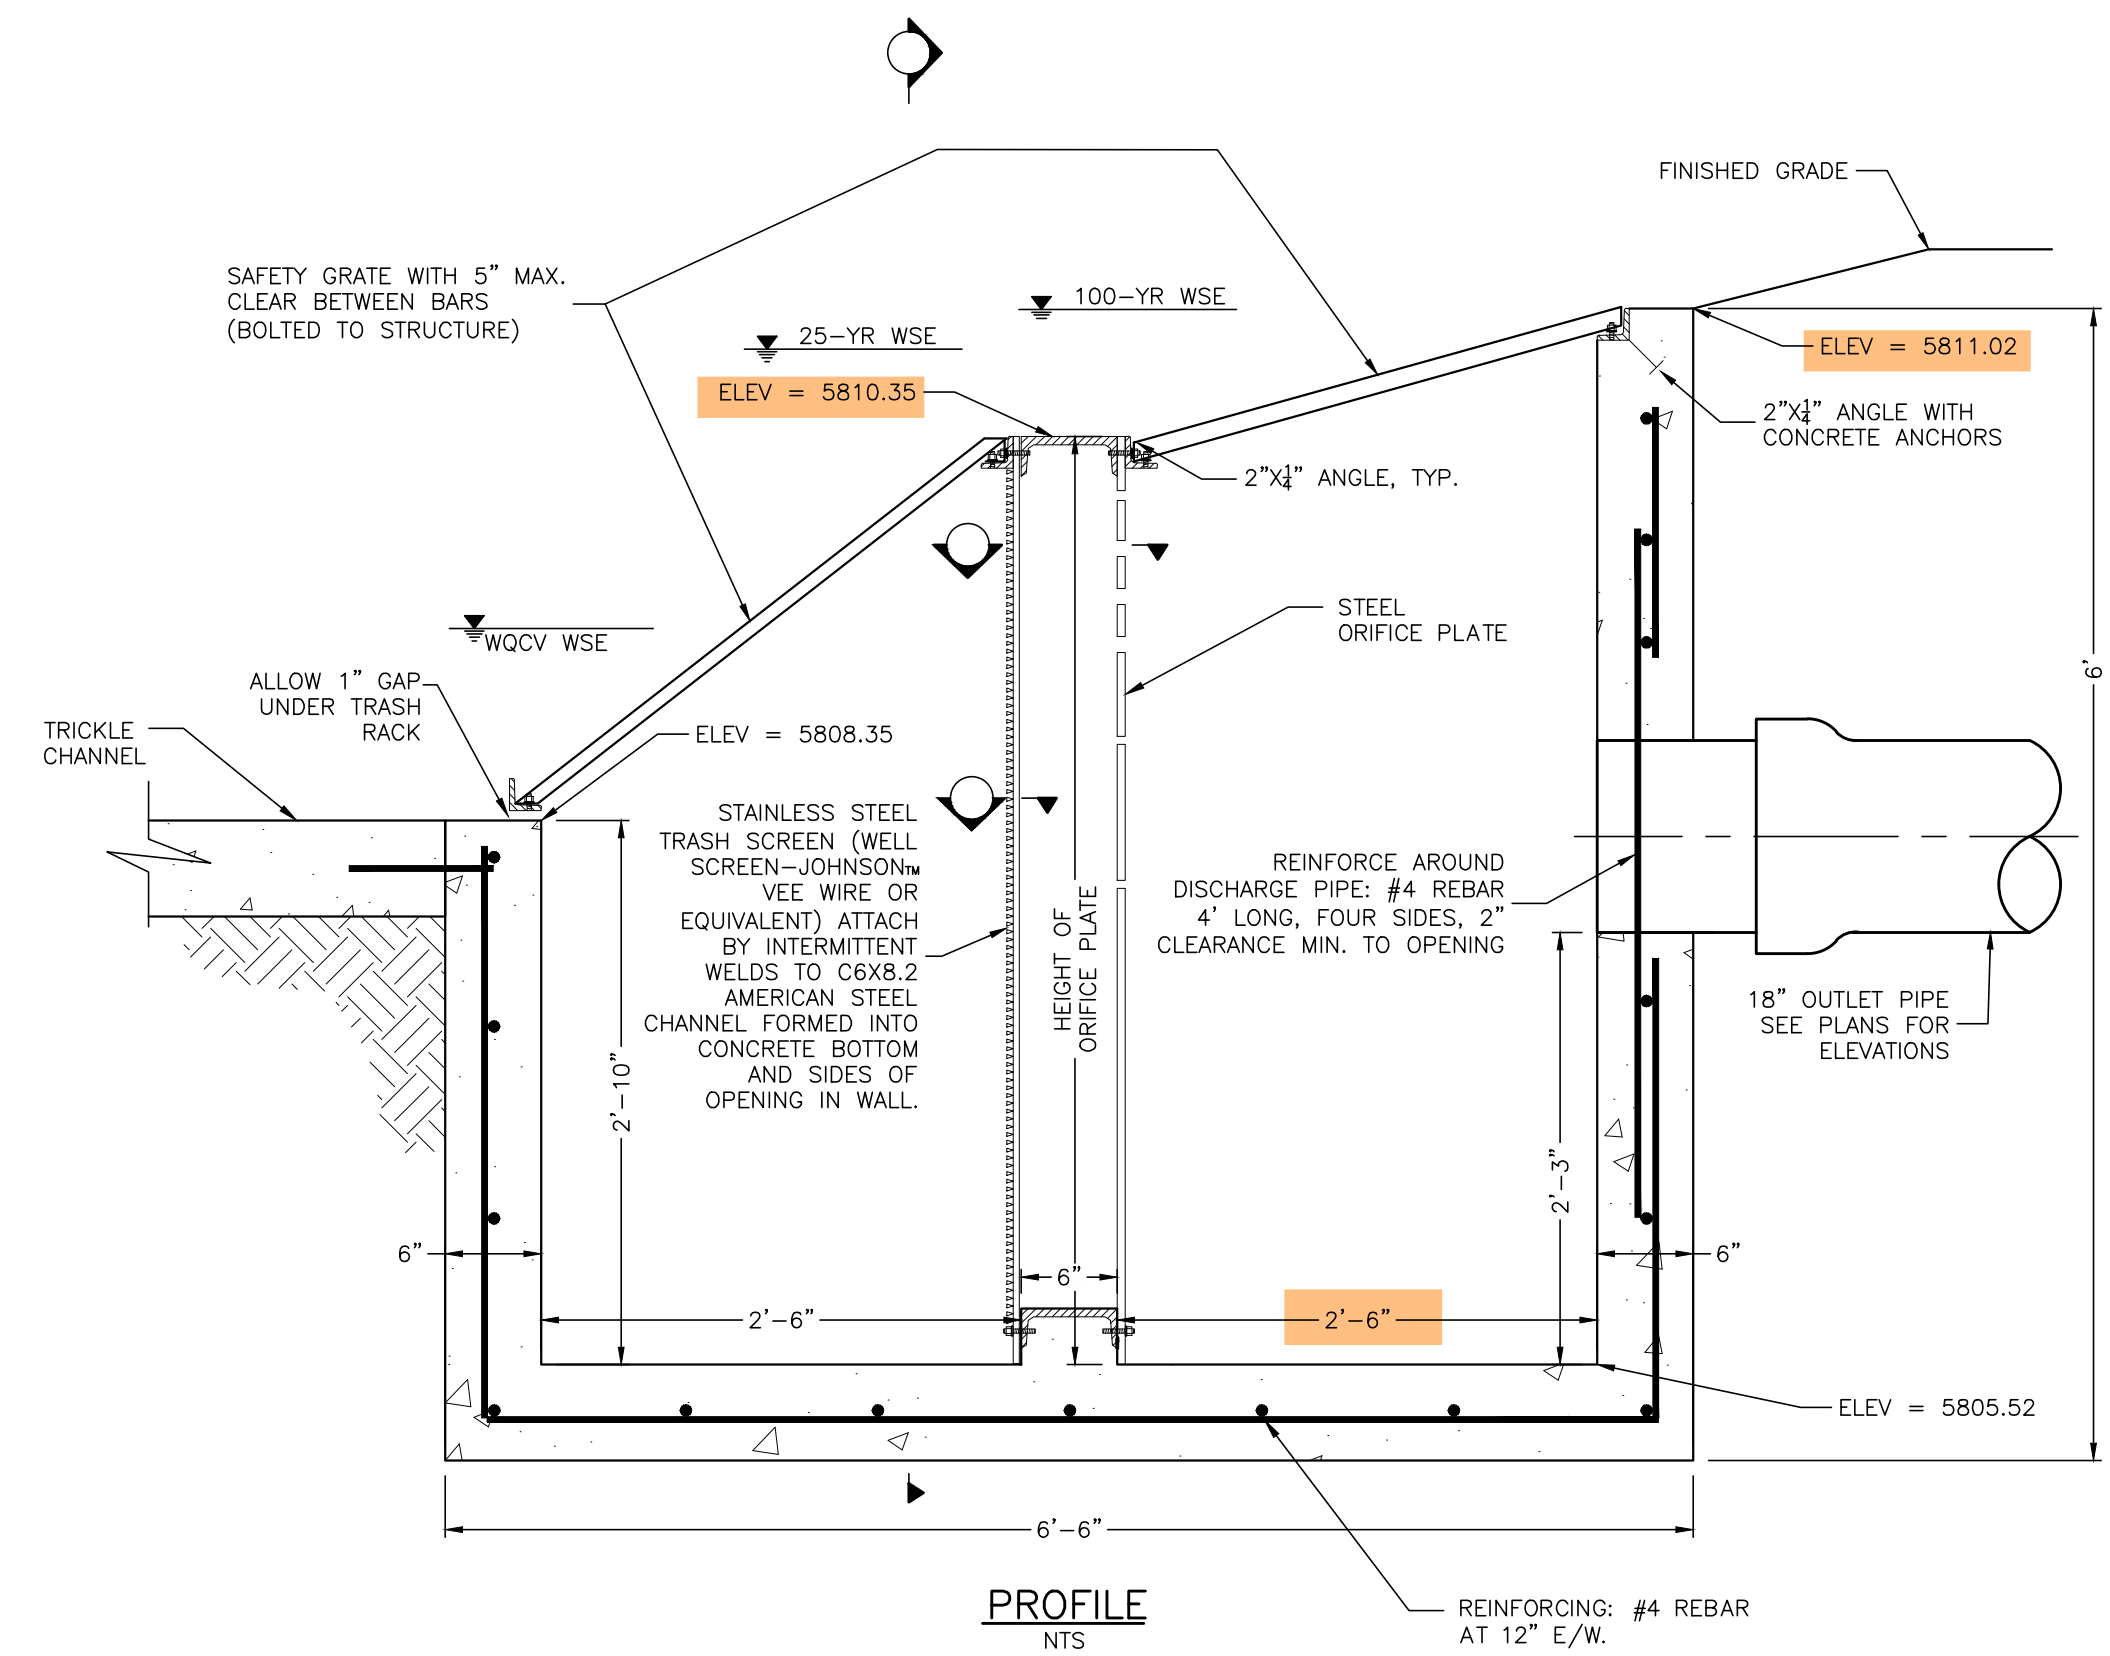

PROFILE
NTS

Provide detail for restrictor plat, as shown on MHFD spreadsheet

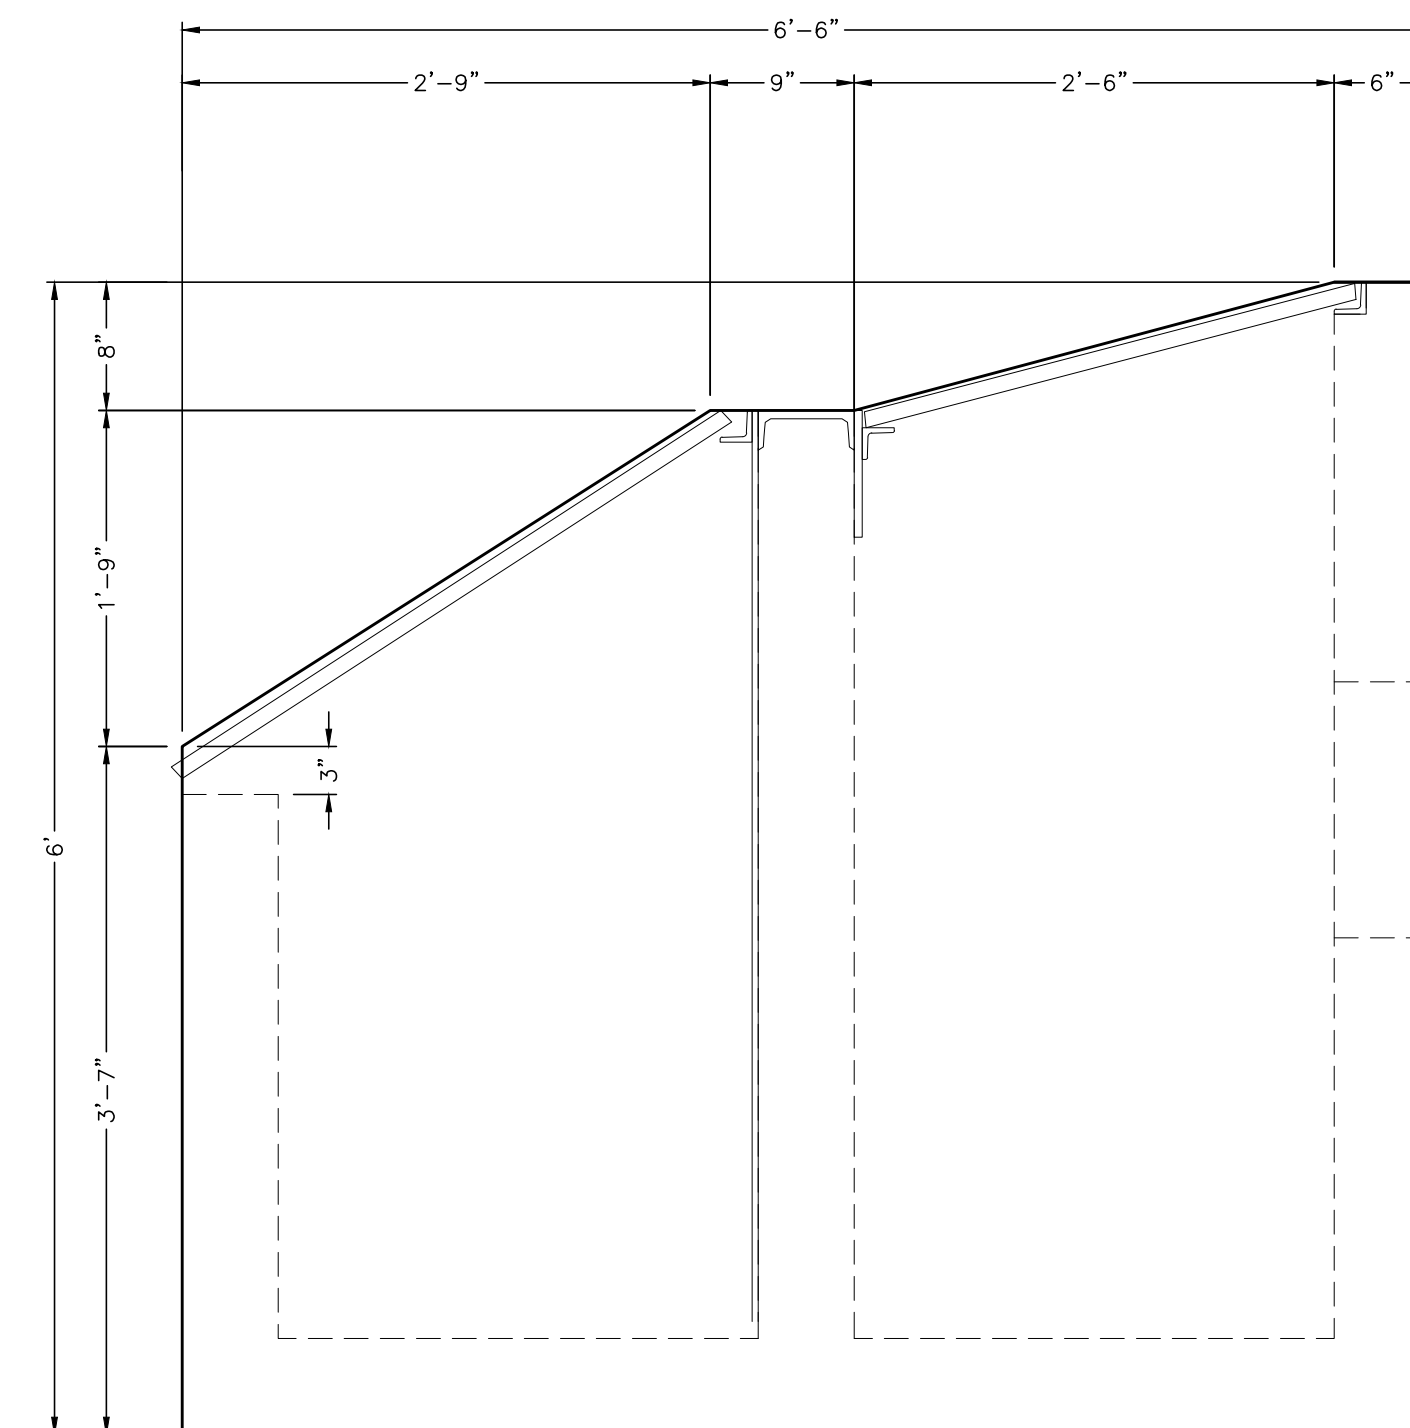

CONCRETE OUTLET STRUCTURE
SIDE VIEW
N.T.S.

 TRI-STATE Generation and Transmission Association, Inc. A Touchstone Energy Cooperative		1100 W. 116th Ave. P.O. Box 33695 Denver, Colorado 80233 303-452-6111		Dwn. TMC Appd. DWS		Date: 05/22/26 Date: 06/22/26		S1183-A-01-011	
ROLLING MEADOWS SUBSTATION 115/12.47kV OUTLET STRUCTURE DETAILS				TRI-STATE GENERATION & TRANSMISSION ASSOCIATION, INCORPORATED		UPDATED BY: WILDGATE 6/19/2026 9:37 AM Contract: 4713		No. 7 Date Dwn. Appd. Revision M.F. Drawing Title Mfr. Dwg. No. Reference Drawings	

LEGEND



PROPERTY BOUNDARY
LIMITS OF CONSTRUCTION / DISTURBANCE
TOE OF FILL SLOPE
TOP OF CUT SLOPE

EXISTING SILT FENCE (INITIAL - PREVIOUSLY INSTALLED BY OTHERS)
EXISTING TOPSOIL BERM (INITIAL - PREVIOUSLY INSTALLED BY OTHERS)
SEDIMENT TRAP (INITIAL/INTERIM)
SEEDING (FINAL)
GRAVEL (FINAL)
TRACKING PAD (INITIAL/INTERIM)
CONCRETE WASHOUT (WITH LOCATION SIGN)

EXISTING OVERHEAD POWER LINE
EXISTING SILT FENCE
EXISTING CULVERT
EXISTING UTILITY POLE
EXISTING GUY ANCHOR
EXISTING INDEX CONTOUR
EXISTING INTERMEDIATE CONTOUR
EXISTING DRAINAGE FLOWLINE

PROPOSED SUBDRAIN LINE
PROPOSED FENCE
PROPOSED CULVERT
PROPOSED INDEX CONTOUR
PROPOSED INTERMEDIATE CONTOUR
PROPOSED DRAINAGE FLOWLINE
PROPOSED DRAINAGE FLOW ARROW
EXISTING DRAINAGE FLOW ARROW

- NOTES:
- EXISTING VEGETATION CONSISTS OF NATIVE GRASSES AND WEEDS AT 50-60% GROUND COVER.
 - NO BATCH PLANTS WILL BE UTILIZED ON SITE.
 - NO PART OF THE SITE LIES WITHIN THE FEMA 100 YEAR FLOODPLAIN.
 - CONCRETE OUTLET STRUCTURE MUST BE INSTALLED IN ORDER TO USE DETENTION POND AS A TEMPORARY SEDIMENT POND DURING CONSTRUCTION.
 - SEEDING SHALL BE WEED-FREE HAY MULCH AT 5,000 LBS PER ACRE WHEN DISTRIBUTED UNIFORMLY. CONTRACTOR SHALL UTILIZE EL PASO COUNTY CONSERVATION DISTRICT'S NATIVE SHOTGUN MIX

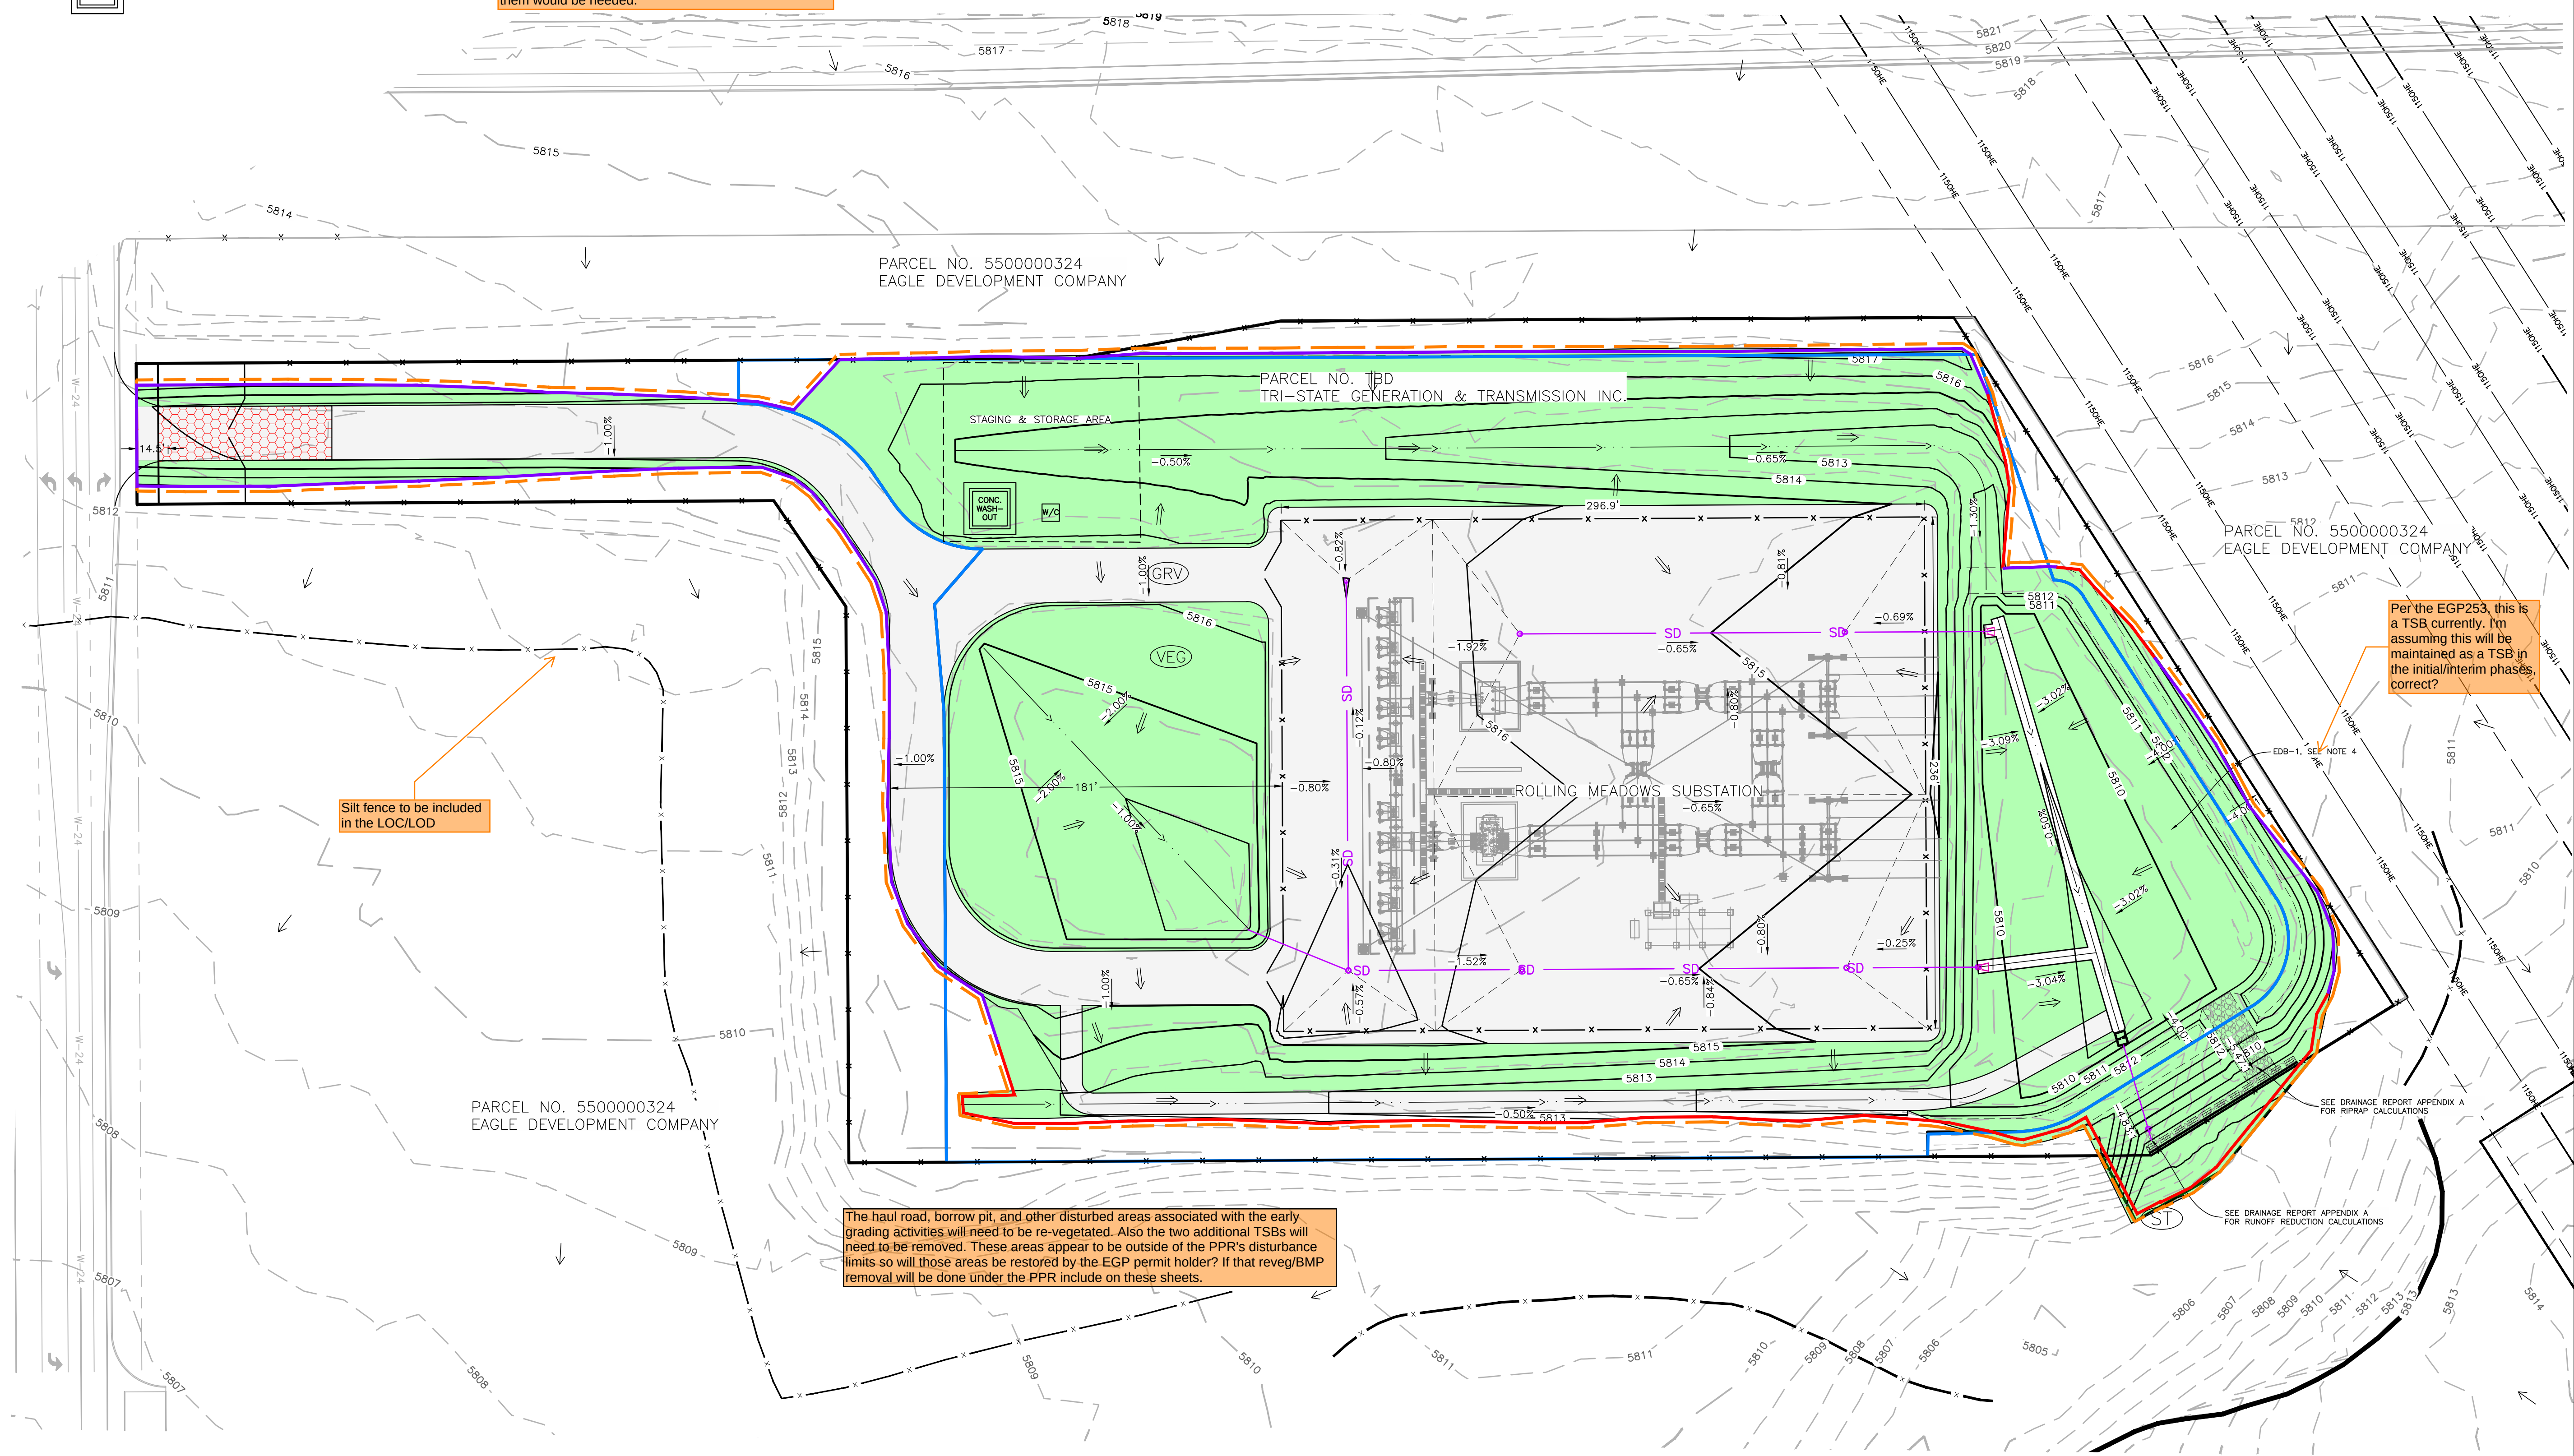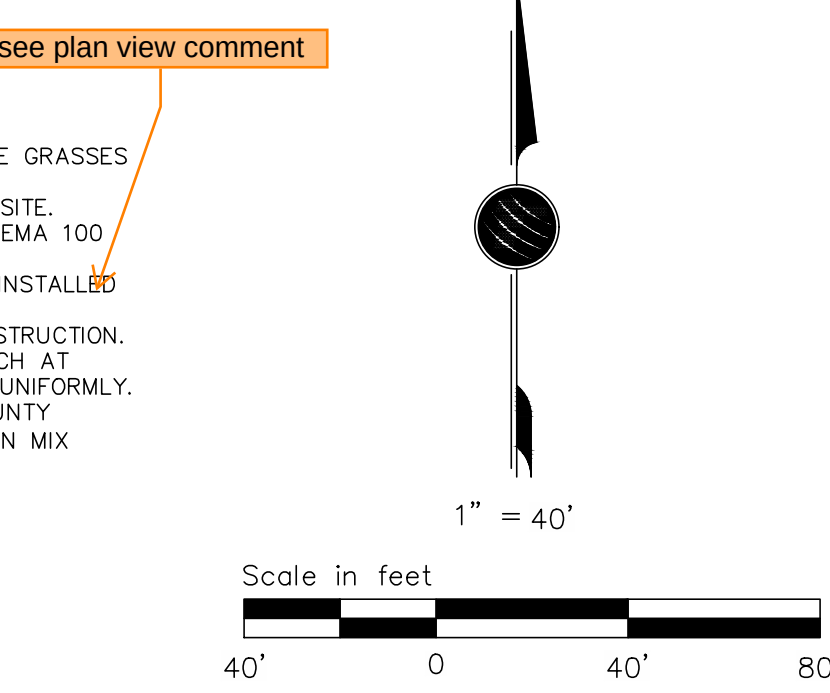

Silt fence to be included in the LOC/LOD

Per the EGP253, this is a TSB currently. I'm assuming this will be maintained as a TSB in the initial/interim phases, correct?

The haul road, borrow pit, and other disturbed areas associated with the early grading activities will need to be re-vegetated. Also the two additional TSBs will need to be removed. These areas appear to be outside of the PPR's disturbance limits so will those areas be restored by the EGP permit holder? If that reveg/BMP removal will be done under the PPR include on these sheets.

ROLLING MEADOWS SUBSTATION
115/12.47KV
EROSION CONTROL PLAN

TRI-STATE GENERATION & TRANSMISSION ASSOCIATION, INCORPORATED
1100 W. 116th Ave.
P.O. Box 33695
Denver, Colorado 80233
303-452-6111

UPDATED BY: WLDGATE 6/19/2026 9:37 AM Contract: 4713
PATH: \\DMS1\Projects\Active Projects\2024\24028-TSG Rolling Meadows Substation\Facility Civil\Sheets\S1183-A-01-SHEETS.dwg

No.	Date	Dwn.	Appd.	Revision	M.F.
7					
6					
5					
4					
3					
2					
1					

Dwn: TMC Date: 06/22/26
Appd: DWS Date: 06/22/26

S1183-A-01-012


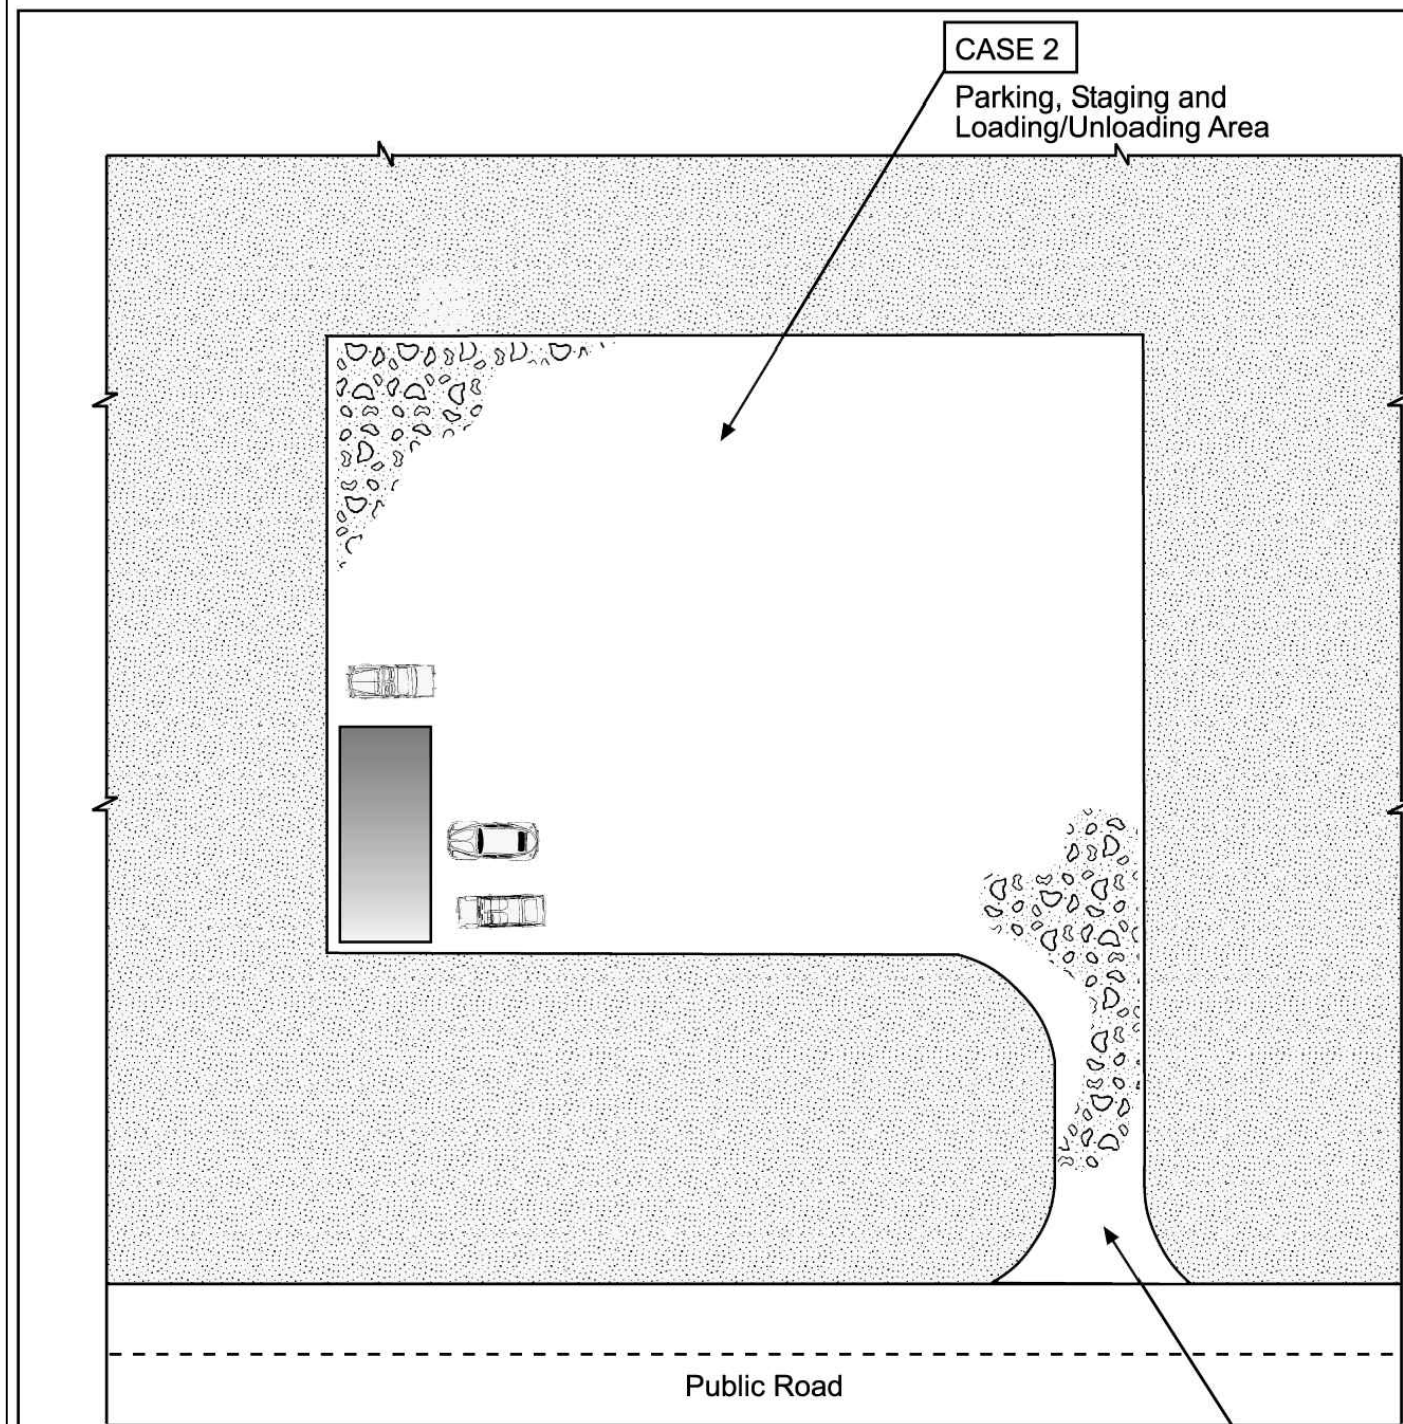


Table VT-1

	Case 1	Case 2
Gravel Thickness	9"	3"
Filter Fabric	YES	NO

City of Colorado Springs
Storm Water Quality

Figure VT-1
Vehicle Tracking
Application Examples

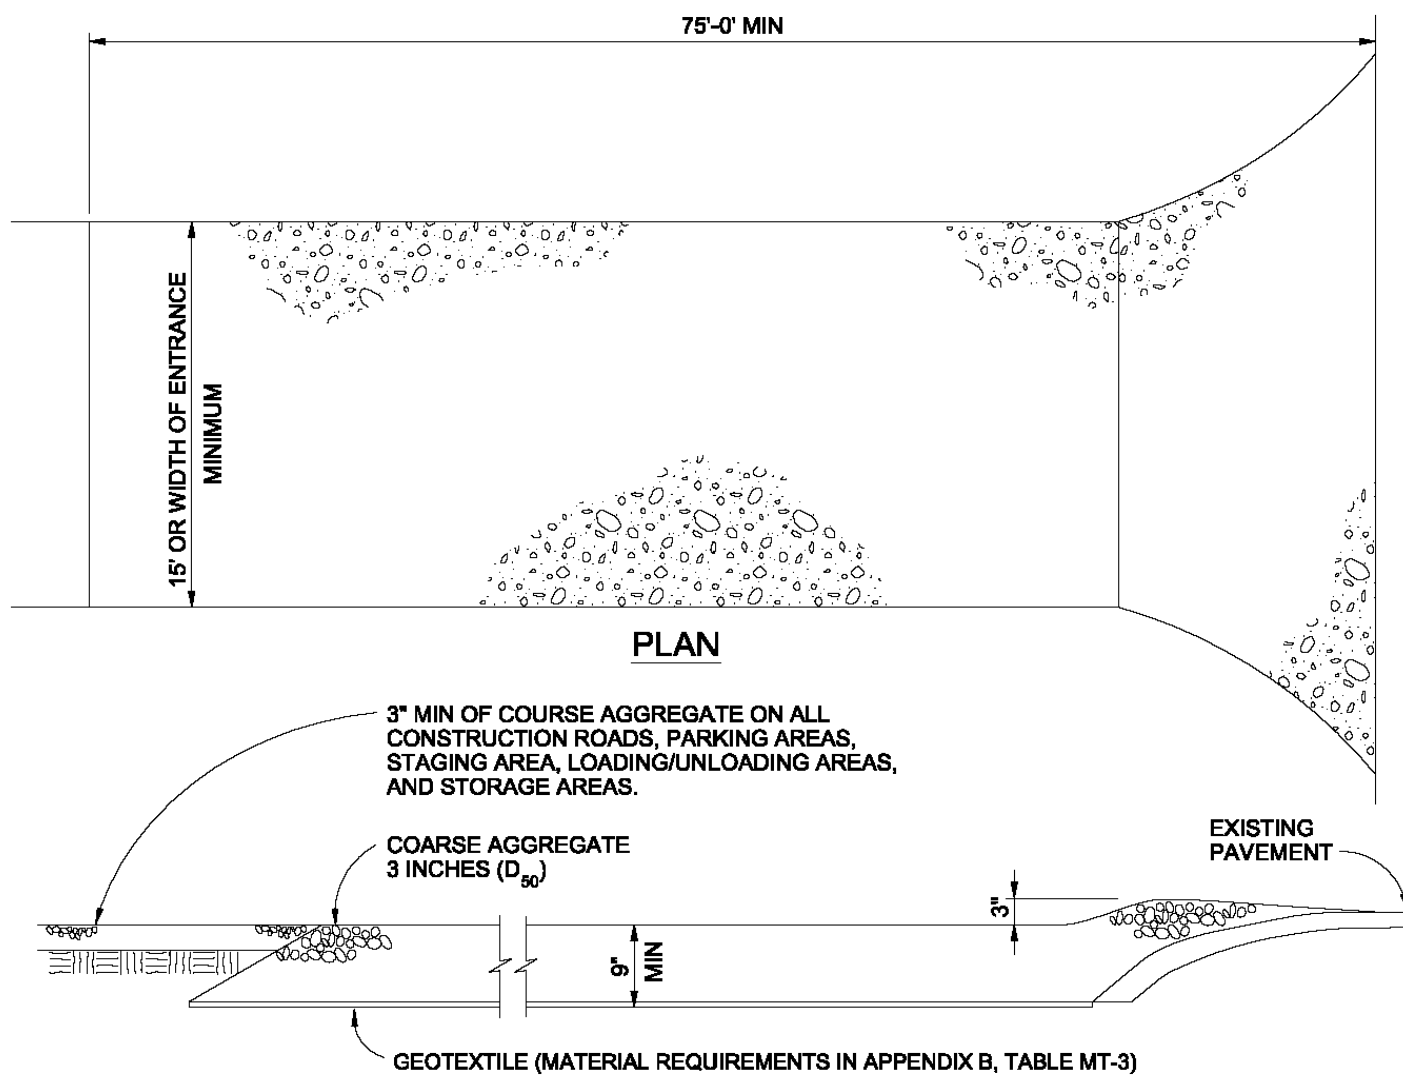

VEHICLE TRACKING NOTES

INSTALLATION REQUIREMENTS

1. ALL ENTRANCES TO THE CONSTRUCTION SITE ARE TO BE STABILIZED PRIOR TO CONSTRUCTION BEGINNING.
2. CONSTRUCTION ENTRANCES ARE TO BE BUILT WITH AN APRON TO ALLOW FOR TURNING TRAFFIC, BUT SHOULD NOT BE BUILT OVER EXISTING PAVEMENT EXCEPT FOR A SLIGHT OVERLAP.
3. AREAS TO BE STABILIZED ARE TO BE PROPERLY GRADED AND COMPACTED PRIOR TO LAYING DOWN GEOTEXTILE AND STONE.
4. CONSTRUCTION ROADS, PARKING AREAS, LOADING/UNLOADING ZONES, STORAGE AREAS, AND STAGING AREAS ARE TO BE STABILIZED.
5. CONSTRUCTION ROADS ARE TO BE BUILT TO CONFORM TO SITE GRADES, BUT SHOULD NOT HAVE SIDE SLOPES OR ROAD GRADES THAT ARE EXCESSIVELY STEEP.

MAINTENANCE REQUIREMENTS


1. REGULAR INSPECTIONS ARE TO BE MADE OF ALL STABILIZED AREAS, ESPECIALLY AFTER STORM EVENTS.
2. STONES ARE TO BE REAPPLIED PERIODICALLY AND WHEN REPAIR IS NECESSARY.
3. SEDIMENT TRACKED ONTO PAVED ROADS IS TO BE REMOVED DAILY BY SHOVELING OR SWEEPING. SEDIMENT IS NOT TO BE WASHED DOWN STORM SEWER DRAINS.
4. STORM SEWER INLET PROTECTION IS TO BE IN PLACE, INSPECTED, AND CLEANED IF NECESSARY.
5. OTHER ASSOCIATED SEDIMENT CONTROL MEASURES ARE TO BE INSPECTED TO ENSURE GOOD WORKING CONDITION.

City of Colorado Springs
Stormwater Quality

Figure VT-2
Vehicle Tracking
Application Examples

Stabilized Staging Area (SSA)

SM-6

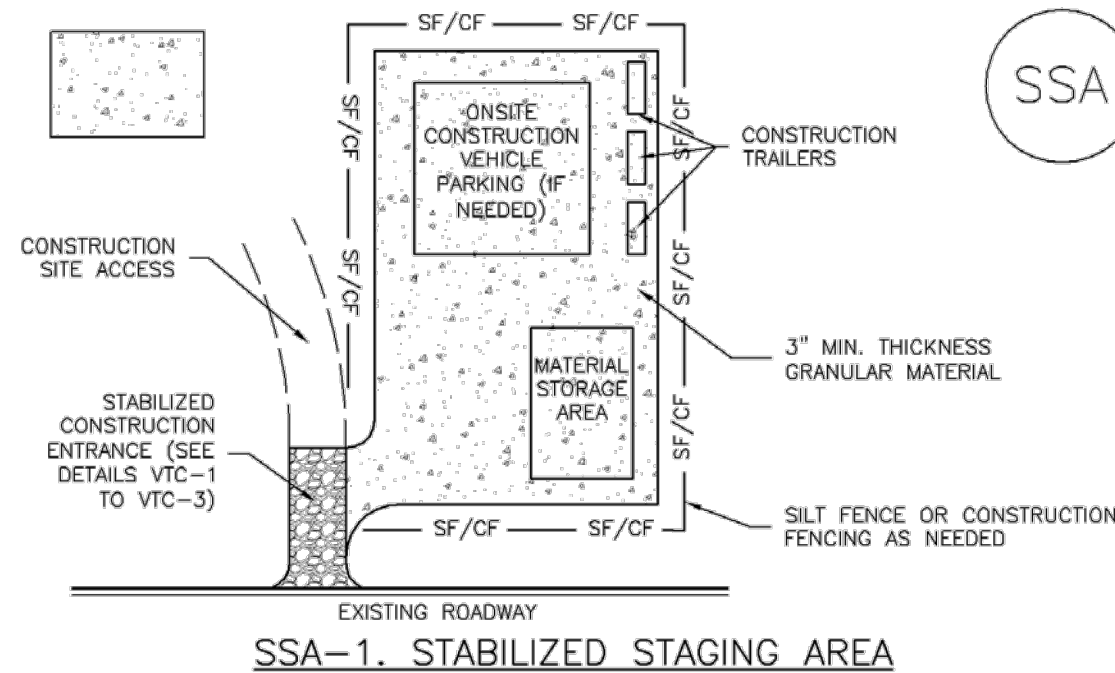

SSA-1. STABILIZED STAGING AREA

STABILIZED STAGING AREA INSTALLATION NOTES

1. SEE PLAN VIEW FOR:
 - LOCATION OF STAGING AREA(S).
 - CONTRACTOR MAY ADJUST LOCATION AND SIZE OF STAGING AREA WITH APPROVAL FROM THE LOCAL JURISDICTION.
2. STABILIZED STAGING AREA SHOULD BE APPROPRIATE FOR THE NEEDS OF THE SITE. OVERSIZING RESULTS IN A LARGER AREA TO STABILIZE FOLLOWING CONSTRUCTION.
3. STAGING AREA SHALL BE STABILIZED PRIOR TO OTHER OPERATIONS ON THE SITE.
4. THE STABILIZED STAGING AREA SHALL CONSIST OF A MINIMUM 3" THICK GRANULAR MATERIAL.
5. UNLESS OTHERWISE SPECIFIED BY LOCAL JURISDICTION, ROCK SHALL CONSIST OF DOT SECT. #703, AASHTO #3 COARSE AGGREGATE OR 6" (MINUS) ROCK.
6. ADDITIONAL PERIMETER BMPs MAY BE REQUIRED INCLUDING BUT NOT LIMITED TO SILT FENCE AND CONSTRUCTION FENCING.

STABILIZED STAGING AREA MAINTENANCE NOTES

1. INSPECT BMPs EACH WORKDAY, AND MAINTAIN THEM IN EFFECTIVE OPERATING CONDITION. MAINTENANCE OF BMPs SHOULD BE PROACTIVE, NOT REACTIVE. INSPECT BMPs AS SOON AS POSSIBLE (AND ALWAYS WITHIN 24 HOURS) FOLLOWING A STORM THAT CAUSES SURFACE EROSION, AND PERFORM NECESSARY MAINTENANCE.
2. FREQUENT OBSERVATIONS AND MAINTENANCE ARE NECESSARY TO MAINTAIN BMPs IN EFFECTIVE OPERATING CONDITION. INSPECTIONS AND CORRECTIVE MEASURES SHOULD BE DOCUMENTED THOROUGHLY.
3. WHERE BMPs HAVE FAILED, REPAIR OR REPLACEMENT SHOULD BE INITIATED UPON DISCOVERY OF THE FAILURE.
4. ROCK SHALL BE REAPPLIED OR REGRADED AS NECESSARY IF RUTTING OCCURS OR UNDERLYING SUBGRADE BECOMES EXPOSED.

November 2010

Urban Drainage and Flood Control District
Urban Storm Drainage Criteria Manual Volume 3

SSA-3

SM-6

Stabilized Staging Area (SSA)

STABILIZED STAGING AREA MAINTENANCE NOTES

5. STABILIZED STAGING AREA SHALL BE ENLARGED IF NECESSARY TO CONTAIN PARKING, STORAGE, AND UNLOADING/LOADING OPERATIONS.
 6. THE STABILIZED STAGING AREA SHALL BE REMOVED AT THE END OF CONSTRUCTION. THE GRANULAR MATERIAL SHALL BE REMOVED OR, IF APPROVED BY THE LOCAL JURISDICTION, USED ON SITE, AND THE AREA COVERED WITH TOPSOIL, SEEDED AND MULCHED OR OTHERWISE STABILIZED IN A MANNER APPROVED BY LOCAL JURISDICTION.
- NOTE: MANY MUNICIPALITIES PROHIBIT THE USE OF RECYCLED CONCRETE AS GRANULAR MATERIAL FOR STABILIZED STAGING AREAS DUE TO DIFFICULTIES WITH RE-ESTABLISHMENT OF VEGETATION IN AREAS WHERE RECYCLED CONCRETE WAS PLACED.
- NOTE: MANY JURISDICTIONS HAVE BMP DETAILS THAT VARY FROM UDFCD STANDARD DETAILS. CONSULT WITH LOCAL JURISDICTIONS AS TO WHICH DETAIL SHOULD BE USED WHEN DIFFERENCES ARE NOTED.

(DETAILS ADAPTED FROM DOUGLAS COUNTY, COLORADO, NOT AVAILABLE IN AUTOCAD)

NOTE: FOR RE-SEEDING, CONTRACTOR SHALL UTILIZE EL PASO COUNTY CONSERVATION DISTRICT'S NATIVE SHOTGUN MIX. CONTRACTOR SHALL UTILIZE BELOW TABLE FOR APPLICATION RATES.

DISTURBED AREAS SHALL BE MULCHED AFTER SEEDING WITH WEED-FREE HAY MULCH AT 5,000 LBS PER ACRE WHEN DISTRIBUTED UNIFORMLY.

Chapter 5
Native Vegetation Requirements and Guidelines

Table 5-1. El Paso County Conservation District All-Purpose Mix for Upland, Transition and Permanent Control Measure Areas

Common Name	Scientific Name	Growth Season / Form	% of Mix	Pounds PLS		
				Irrigated broadcast Irrigated hydroseeded 80 seeds/sq ft	Non-irrigated broadcast Non-irrigated hydroseeded Irrigated drilled 40 seeds/sq ft	Non-irrigated drilled 20 seeds/sq ft
Bluestem, big	<i>Andropogon gerardii</i>	Warm, sod	20	4.4	2.2	1.1
Gramma, blue	<i>Bouteloua gracilis</i>	Warm, bunch	10	0.5	0.25	0.13
Green needlegrass ²	<i>Nassella viridula</i>	Cool, bunch	10	2	1	0.5
Wheatgrass, western ²	<i>Pascopyrum smithii</i>	Cool, sod	20	6.4	3.2	1.6
Gramma, sideoats	<i>Bouteloua curtipendula</i>	Warm, bunch	10	2	1	0.5
Switchgrass ²	<i>Panicum virgatum</i>	Warm, bunch/sod	10	0.8	0.4	0.2
Prairie sandreed	<i>Calamovilfa longifolia</i>	Warm, sod	10	1.2	0.6	0.3
Yellow indiangrass ²	<i>Sorghastrum nutans</i>	Warm, sod	10	2	1	0.5
Seed rate (lbs PLS/acre)				19.3	9.7	4.8

¹For portions of facilities located near or on the bottom or where wet soil conditions occur. Planting of potted nursery stock wetland plants 2-foot on-center is recommended for sites with wetland hydrology.

²Species that will do well in the bottom of pond areas.


City of Colorado Springs
Stormwater Enterprise



Stormwater Construction Manual
December 2020

Concrete Washout Area (CWA)

MM-1

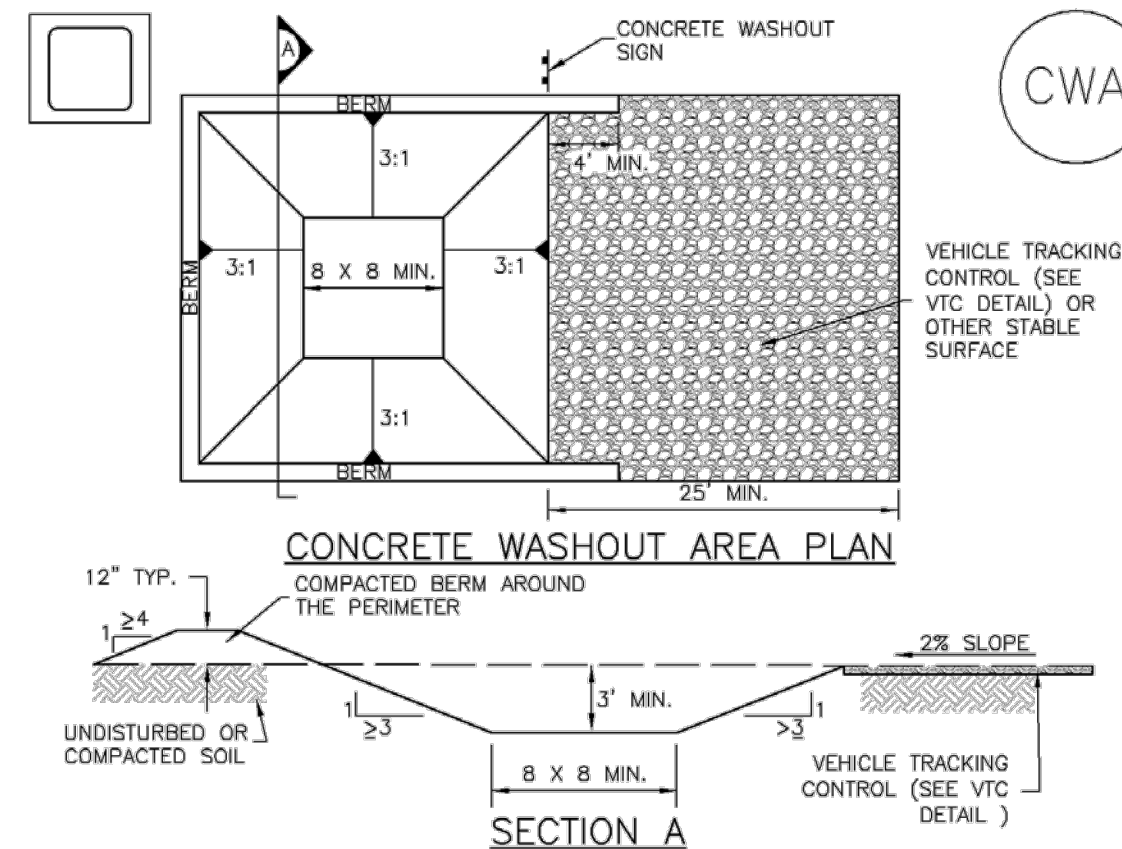

CWA-1. CONCRETE WASHOUT AREA

CWA INSTALLATION NOTES

1. SEE PLAN VIEW FOR:
 - CWA INSTALLATION LOCATION.
2. DO NOT LOCATE AN UNLINED CWA WITHIN 400' OF ANY NATURAL DRAINAGE PATHWAY OR WATERBODY. DO NOT LOCATE WITHIN 1,000' OF ANY WELLS OR DRINKING WATER SOURCES. IF SITE CONSTRAINTS MAKE THIS INFEASIBLE, OR IF HIGHLY PERMEABLE SOILS EXIST ON SITE, THE CWA MUST BE INSTALLED WITH AN IMPERMEABLE LINER (16 MIL MIN. THICKNESS) OR SURFACE STORAGE ALTERNATIVES USING PREFABRICATED CONCRETE WASHOUT DEVICES OR A LINED ABOVE GROUND STORAGE ARE SHOULD BE USED.
3. THE CWA SHALL BE INSTALLED PRIOR TO CONCRETE PLACEMENT ON SITE.
4. CWA SHALL INCLUDE A FLAT SUBSURFACE PIT THAT IS AT LEAST 8' BY 8' SLOPES LEADING OUT OF THE SUBSURFACE PIT SHALL BE 3:1 OR FLATTER. THE PIT SHALL BE AT LEAST 3' DEEP.
5. BERM SURROUNDING SIDES AND BACK OF THE CWA SHALL HAVE MINIMUM HEIGHT OF 1'.
6. VEHICLE TRACKING PAD SHALL BE SLOPED 2% TOWARDS THE CWA.
7. SIGNS SHALL BE PLACED AT THE CONSTRUCTION ENTRANCE, AT THE CWA, AND ELSEWHERE AS NECESSARY TO CLEARLY INDICATE THE LOCATION OF THE CWA TO OPERATORS OF CONCRETE TRUCKS AND PUMP RIGS.
8. USE EXCAVATED MATERIAL FOR PERIMETER BERM CONSTRUCTION.

SSA-4

Urban Drainage and Flood Control District
Urban Storm Drainage Criteria Manual Volume 3

November 2010

November 2010

Urban Drainage and Flood Control District
Urban Storm Drainage Criteria Manual Volume 3

CWA-3

ROLLING MEADOWS SUBSTATION

EROSION CONTROL DETAILS

TRI-STATE
Generation and Transmission
Association, Inc.



1100 W. 116th Ave.
P.O. Box 33695
Denver, Colorado 80233
303-452-6111

S1183-A-01-013