


JUDGE ORR RANCHETTES

PRELIMINARY PLAN

EL PASO COUNTY, COLORADO

Add section, township, range

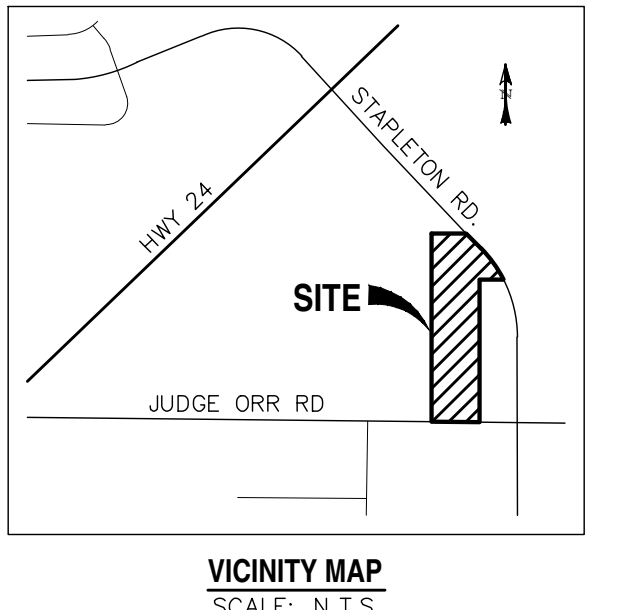


ADJACENT OWNERS LIST			
ID NO.	OWNER	POINT OF CONTACT	MAILING ADDRESS
1	PETER J. HAGEN	PETER J. HAGEN	704 SILVER OAK GROVE COLORADO SPRINGS, CO 80906
2	ANDREW K. MANIATIS TRUST	GEORGE & LINDA TASOULIS	227 W. SYLVESTER PLACE LITTLETON, CO 80129
3	ANDREW K. MANIATIS TRUST	GEORGE & LINDA TASOULIS	227 W. SYLVESTER PLACE LITTLETON, CO 80129
4	STATIC LINE, LLC	RUSTY R. RUNZELMAN	14980 STAPLETON DRIVE CALHAN, CO 80806
5	JANE DAVIS LIVING TRUST	JANE DAVIS	9060 ELBERT ROAD PEYTON, CO 80831
6	J. D. ENGHAS	J. D. ENGHAS	14775 JUDGE ORR ROAD PEYTON, CO 80831
7	WILLIAM R. BUNN	WILLIAM R. BUNN	26531 SARATOGA AVENUE BIG PINE KEY, FL 33043
8	DANIEL R. & TAMMY J. FIELDS	DANIEL R. & TAMMY J. FIELDS	14400 JUDGE ORR ROAD PEYTON, CO 80831
9	STEVENS P. & MICHELLE LAZOR	STEVENS P. & MICHELLE LAZOR	13975 E. US HIGHWAY 24 PEYTON, CO 80831

Add notes for services, fees to be paid (park, school, drainage, traffic). If building sites have been determined, please add.

please relocate indicator so it cannot be confused with the floodplain

Add net acreage calculations for lots impacted by no build.

indicate ROW dedication width

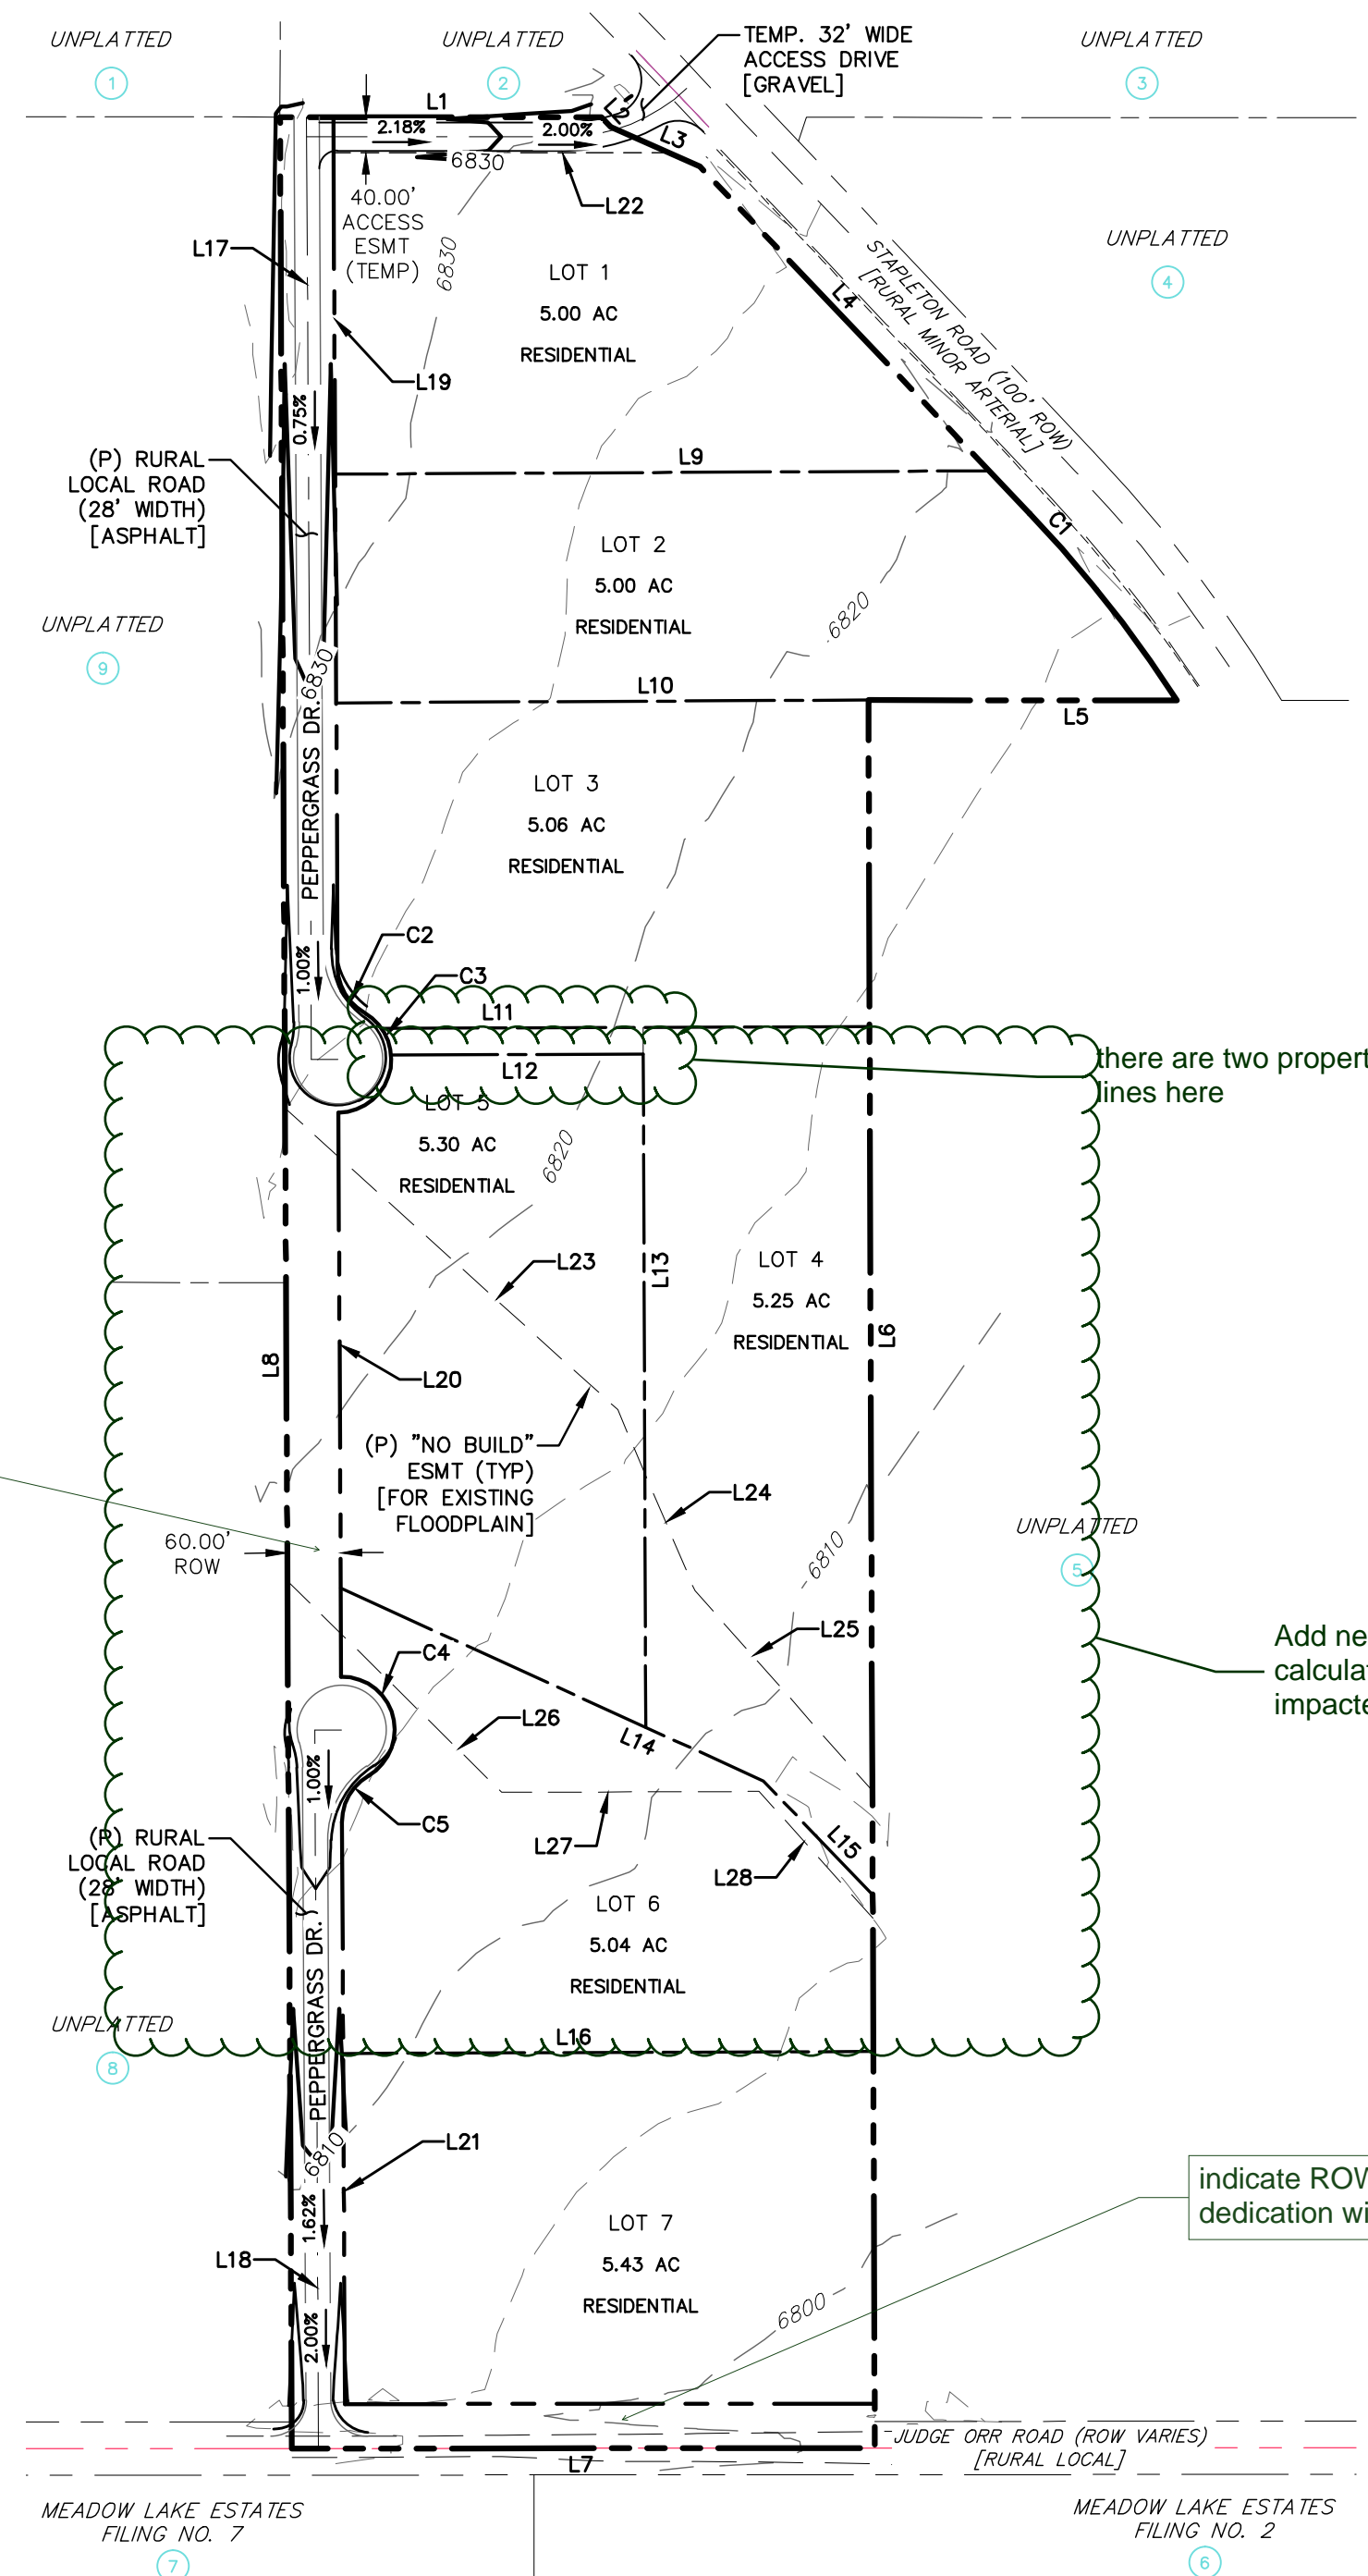

LINE TABLE		
LINE	BEARING	DISTANCE
L1	N89° 58' 12"W	362.17
L2	N43° 20' 31"W	15.01
L3	N66° 01' 31"W	110.00
L4	N43° 33' 49"W	539.12
L5	S89° 57' 45"E	347.60
L6	N0° 12' 22"W	1968.89
L7	N89° 57' 26"E	656.66
L8	S0° 17' 32"E	2626.21
L9	N89° 42' 28"E	736.89
L10	N89° 42' 28"E	599.61
L11	N89° 48' 28"E	550.00
L12	N89° 48' 28"E	284.13
L13	N0° 12' 28"W	758.35
L14	N65° 28' 55"W	523.21
L15	N43° 52' 42"W	177.82
L16	N89° 47' 13"E	597.27
L19	N0° 17' 32"W	957.38
L20	N0° 17' 32"W	635.44
L21	N0° 17' 32"W	655.49
L22	S89° 58' 12"E	377.76
L23	S47° 49' 53"E	505.78
L24	S23° 05' 58"E	221.38
L25	S41° 31' 51"E	301.51
L26	S45° 21' 51"E	339.21
L27	N89° 47' 23"E	289.96
L28	S41° 55' 20"E	191.74

CURVE TABLE			
CURVE	DELTA	RADIUS	LENGTH
C1	10°34'32"	1455.00	268.56
C2	59°59'12"	60.00	62.82
C3	149°57'47"	60.00	157.04
C4	149°58'11"	60.00	157.05
C5	59°59'21"	60.00	62.82

OWNER:
JOHN JENNINGS
2030 TABOR COURT
COLORADO SPRINGS, CO 80919
(719) 440-2824

CIVIL ENGINEER:
CATAMOUNT ENGINEERING
P.O. BOX 692
DIVIDE, CO 80814
CONTACT: DAVID MIJARES, PE
(719) 426-2124


LEGAL DESCRIPTION:
THE WEST HALF OF THE EAST HALF OF THE SOUTHEAST QUARTER, AND THE NORTHEAST QUARTER OF THE NORTHEAST QUARTER, BOTH OF THE SOUTHEAST QUARTER OF SECTION 33, TOWNSHIP 12 SOUTH, RANGE 64 WEST, OF THE 6TH P.M., IN EL PASO COUNTY, COLORADO EXCEPT THOSE TRACTS OF LAND DESCRIBED IN INSTRUMENTS AT RECEPTION NUMBERS 215067235 AND 216044524, BOTH OF THE RECORDS OF EL PASO COUNTY, COLORADO, ALL MORE PARTICULARLY DESCRIBED AS FOLLOWS:

BEGINNING AT THE NORTHWEST CORNER OF THE NORTHEAST QUARTER OF THE SOUTHEAST QUARTER OF SAID SECTION 33; THENCE S 89°58'12" E, ALONG THE NORTHERLY LINE OF SAID NORTHEAST QUARTER OF THE SOUTHEAST QUARTER, 362.17 FEET TO THE NORTHWEST CORNER OF THAT TRACT OF LAND DESCRIBED IN INSTRUMENT RECORDED AT RECEPTION NO. 215067235 OF THE RECORDS OF EL PASO COUNTY, COLORADO; THENCE S 43°20'31" E, ALONG THE SOUTHERLY LINE THEREOF, SAID LINE BEING ALSO THE SOUTHERLY RIGHT OF WAY LINE OF STAPLETON DRIVE, 15.01 FEET; THENCE S 66°01'31" E, ALONG SAID SOUTHERLY LINE, 110.00 FEET; THENCE S 43°33'49" E, (BASIS OF BEARING) ALONG SAID SOUTHERLY LINE, 539.12 FEET TO A POINT OF CURVE; THENCE SOUTHEASTERLY, ALONG SAID SOUTHERLY LINE AND ON A CURVE TO THE RIGHT, HAVING A RADIUS OF 1455.00 FEET AND A CENTRAL ANGLE OF 10°34'41", AN ARC DISTANCE OF 268.62 FEET TO A POINT ON THE SOUTHERLY LINE OF THE NORTHEAST QUARTER OF THE NORTHEAST QUARTER OF THE SOUTHEAST QUARTER OF AFORESAID SECTION 33; THENCE N 89°57'45" W, ALONG SAID SOUTHERLY LINE, 347.70 FEET TO THE SOUTHWEST CORNER OF NORTHEAST QUARTER OF THE NORTHEAST QUARTER OF THE SOUTHEAST QUARTER; THENCE S 00°12'22" E, ALONG THE EASTERLY LINE OF THE WEST HALF OF THE EAST HALF OF THE SOUTHEAST QUARTER OF SAID SECTION 33, A DISTANCE OF 1968.89 FEET TO THE SOUTHEAST CORNER OF THE WEST HALF OF THE EAST HALF OF THE SOUTHEAST QUARTER OF SAID SECTION 33; THENCE S 89°57'23" W, ALONG THE SOUTHERLY LINE THEREOF, 656.66 FEET TO THE SOUTHWEST CORNER THEREOF; THENCE N 00°17'32" W, ALONG THE WESTERLY LINE THEREOF, 2626.22 FEET TO THE POINT OF BEGINNING.

CONTAINING 1,771,394 SQUARE FEET (40.6656 ACRES), MORE OR LESS.

LEGEND

EXISTING	(E)
PROPOSED	(P)
ADJACENT OWNER TABLE ID NUMBER	①
BOUNDARY	---
RIGHT-OF-WAY	---
LOT LINE	---
EASEMENT	---
(E) CONTOUR, INDEX	---8820---
(E) CONTOUR	---
(P) CONTOUR, INDEX	---8820---
(P) CONTOUR	---

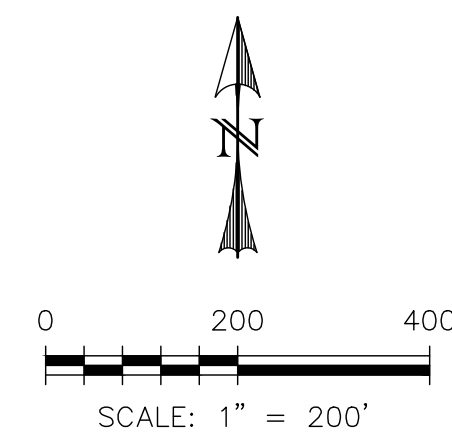


Add SP-17-011

REV.	DESCRIPTION	DATE



PREPARED FOR:
JOHN JENNINGS
2030 TABOR CT.
COLORADO SPRINGS, CO 80919

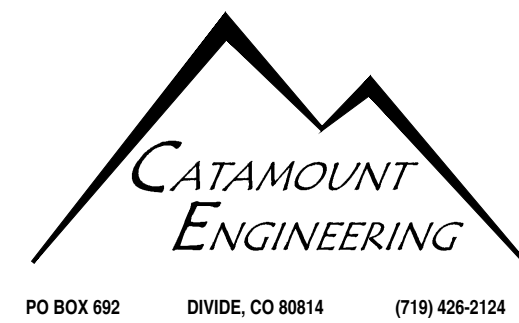

JUDGE ORR RANCHETTES
PRELIMINARY PLAN

DESIGNED BY: MGP	DRAWN BY: MGP
SCALE: 1"=200'	DATE: 09/20/17
JOB NUMBER: 16-093	SHEET: 1 OF 1

Markup Summary

dsdruiz (7)

Add notes for services, fees to be paid (park, school, drainage, traffic). If building sites have been determined, please add.


Subject: Text Box
Page Label: 1
Lock: Locked
Author: dsdruiz

Add notes for services, fees to be paid (park, school, drainage, traffic).
If building sites have been determined, please add.

Add SP-17-011


Subject: Text Box
Page Label: 1
Lock: Locked
Author: dsdruiz

Add SP-17-011

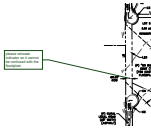

Subject: Callout
Page Label: 1
Lock: Locked
Author: dsdruiz

please relocate indicator so it cannot be confused with the floodplain

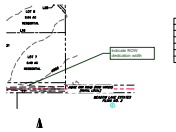


Subject: Callout
Page Label: 1
Lock: Locked
Author: dsdruiz

indicate ROW dedication width



Subject: Cloud+
Page Label: 1
Lock: Locked
Author: dsdruiz

there are two property lines here

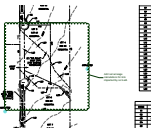

Subject: Cloud+
Page Label: 1
Lock: Locked
Author: dsdruiz

Add net acreage calculations for lots impacted by no build.



Subject: Callout
Page Label: 1
Lock: Locked
Author: dsdruiz

Add section, township, range