
BUGENHAGEN SEPTIC SPECIALISTS

4/22/19

Mr. Mike McCarthy, R.E.H.S. Environmental Health Division
El Paso County Public health
1675 W Garden of the Gods Road, Ste, 2044

Colorado Springs, CO 80907RE: Onsite Wastewater Treatment System (OWTS)
Certification for 6045 Old Cowpoke Road

Mr. McCarthy,

Pursuant to a directive by Jeff Dunn with the City of Colorado Springs Water Resources Division, I completed a survey of the existing OWTS on 4/18/19. The locations of the septic tank, distribution box and leachate fields were marked such that an as-built survey could be completed by others. I hereby attest that I am a licensed and certified Tier II On-site Wastewater Treatment System installer/contractor in El Paso County, CO.


Sincerely,



Phillip Bugenhagen

16275 Connies Dr.
Peyton, CO 80831

PHONE (719) 355-0082
EMAIL TheSepticSpecialist@gmail.com

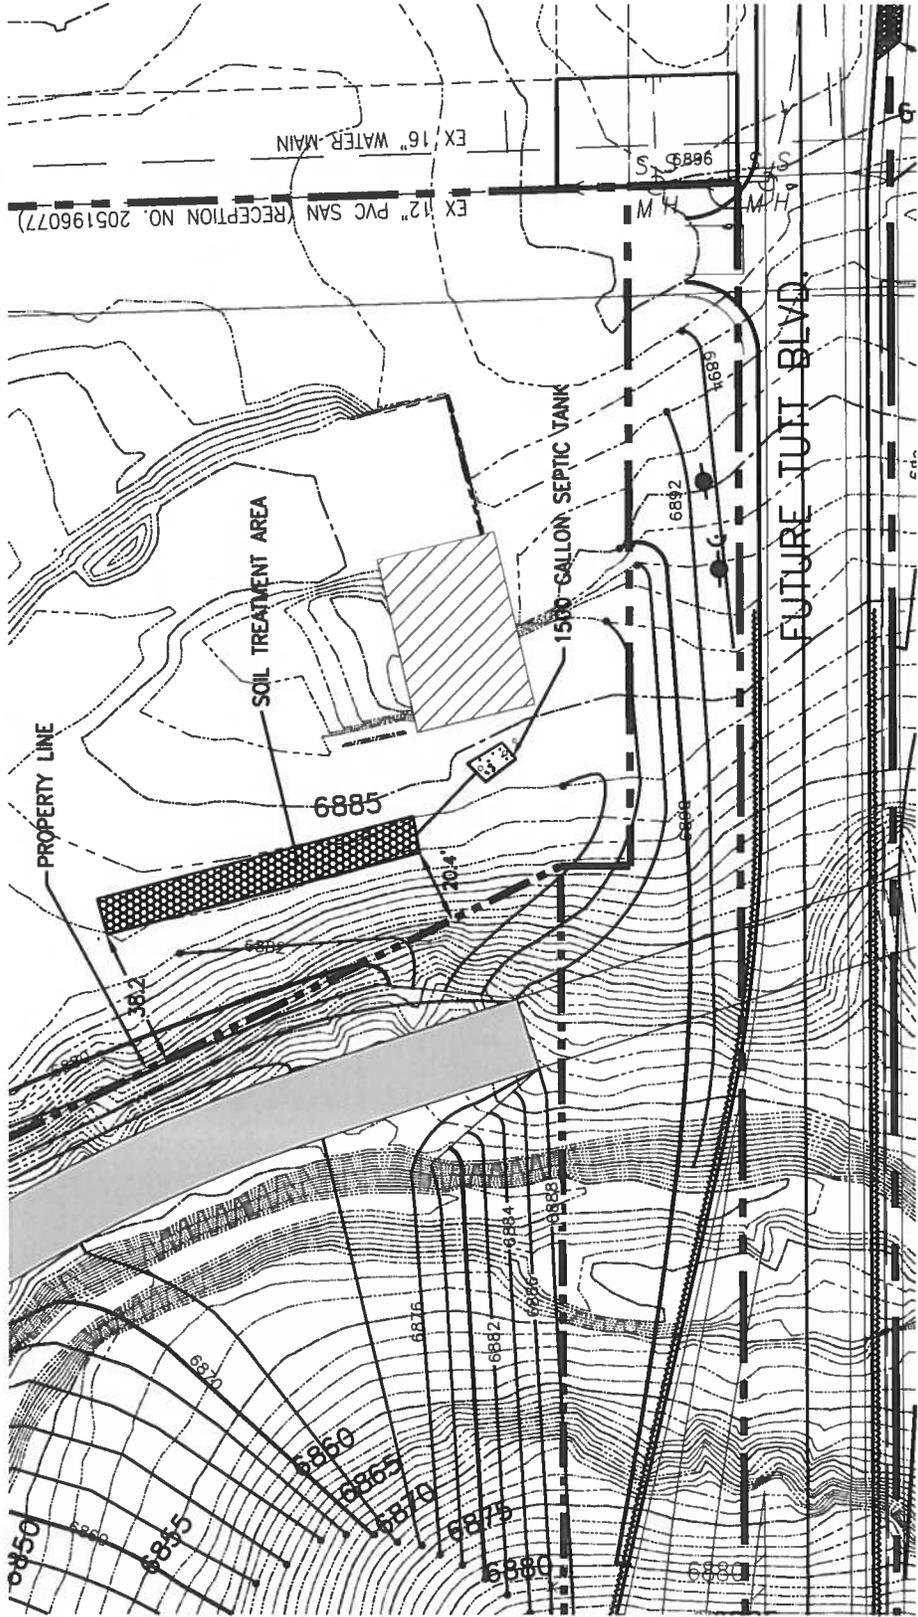


FILE: 17023.dwg
DATE: 4/23/19

ENGINEERING - SURVEYING
1955 N UNION BLVD., SUITE 200
COLORADO SPRINGS, CO 80909
(719) 475-2575 • FAX (719) 475-9223



JOB NO. 17-023

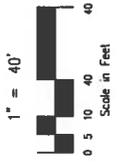

1" = 40'



AS-BUILT DRAWING OF O.W.T.S.
6045 COMPOKE ROAD