
ENG-EGP22006-R1-GEC.pdf Markup Summary

1 (3)		
Know wit	Subject: Stormwater Comments Color Page Index: 1 Date: 3/14/2023 4:42:40 PM Author: dotprete Color: Layer: Space: Page Label: [1] 1 2514207CV02 - CV01	
FILE NO. EGPXXX	Subject: Callout Page Index: 1 Date: 3/21/2023 12:58:05 PM Author: Jeff Rice - EPC Engineering Review Color: Layer: Space: Page Label: [1] 1 2514207CV02 - CV01	226
3 # 4.1	Subject: Page Index: 1 Date: 3/21/2023 12:58:29 PM Author: Jeff Rice - EPC Engineering Review Color: Layer: Space: Page Label: [1] 1 2514207CV02 - CV01	
4 (1)		
Land a light of the source of	Subject: Text Box Page Index: 4 Date: 3/14/2023 4:50:12 PM Author: dotprete Color: Layer: Space: Page Label: [6] 5 F5 GEC1	Label adjacent city/town/jurisdictional boundaries, subdivision names, and property parcel numbers
6 (10)		
	Subject: Cloud+ Page Index: 6 Date: 3/13/2023 5:32:44 PM Author: dotprete Color: Layer: Space: Page Label: [9] 8 DT03	since this is an EGP, remove this bullet and keep BMPs in place for subsequent construction
The start is a set of the set of	Subject: Text Box Page Index: 6 Date: 3/14/2023 4:18:20 PM Author: dotprete Color: Color: Color: Color:	show the TSB spillway location

Color: Layer: Space: Page Label: [9] 8 DT03



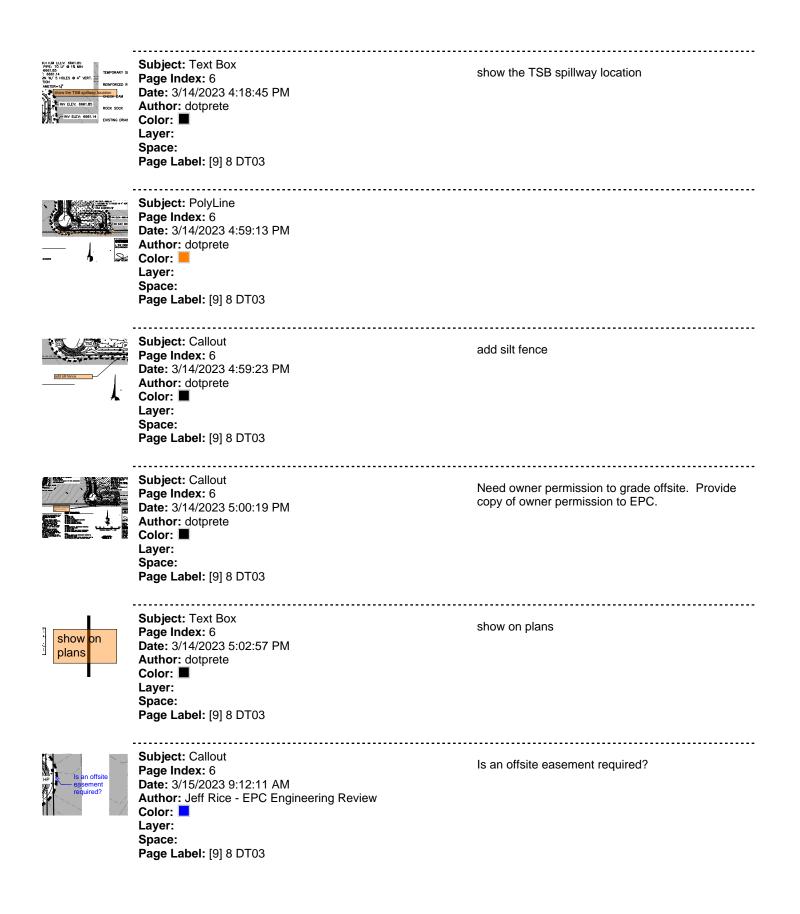

Subject: Callout Page Index: 6 Date: 3/15/2023 9:14:59 AM Author: Jeff Rice - EPC Engineering Review Color: Layer: Space: Page Label: [9] 8 DT03

Spillway should be on this side to minimize impacts to downstream property

.....

Subject: Callout Page Index: 6 Date: 3/21/2023 1:01:00 PM Author: Jeff Rice - EPC Engineering Review Color: Layer: Space: Page Label: [9] 8 DT03 _____

Call out grading in the SFHA and discuss permitting with the Regional Floodplain Administrator

8 (1)



Subject: Text Box Page Index: 8 Date: 3/13/2023 5:35:55 PM Author: dotprete Color: ■ Layer: Space: Page Label: [9] 8 DT03

Replace with EPC approved VTC detail (VT-1 and VT-2 in DCMv2, Chap 3.3) or revise to be 75ft min length.