

MVEA YODER SUBSTATION



EL PASO COUNTY

SITE PLAN

APRIL 2018

LEGEND

EXISTING CONTOURS - MINOR	--- 6132
EXISTING CONTOURS - MAJOR	--- 6130
PROPOSED CONTOURS - MAJOR	— 6132
PROPOSED CONTOURS - MAJOR	— 6130
LIMITS OF CONSTRUCTION	— — — —
EXISTING FINISHED GROUND	EX-FG
PROPOSED FINISHED GROUND	FG
PROPOSED FLOWLINE	FL
LOW POINT	LP
HIGH POINT	HP
GRADE & DIRECTION	2.2%

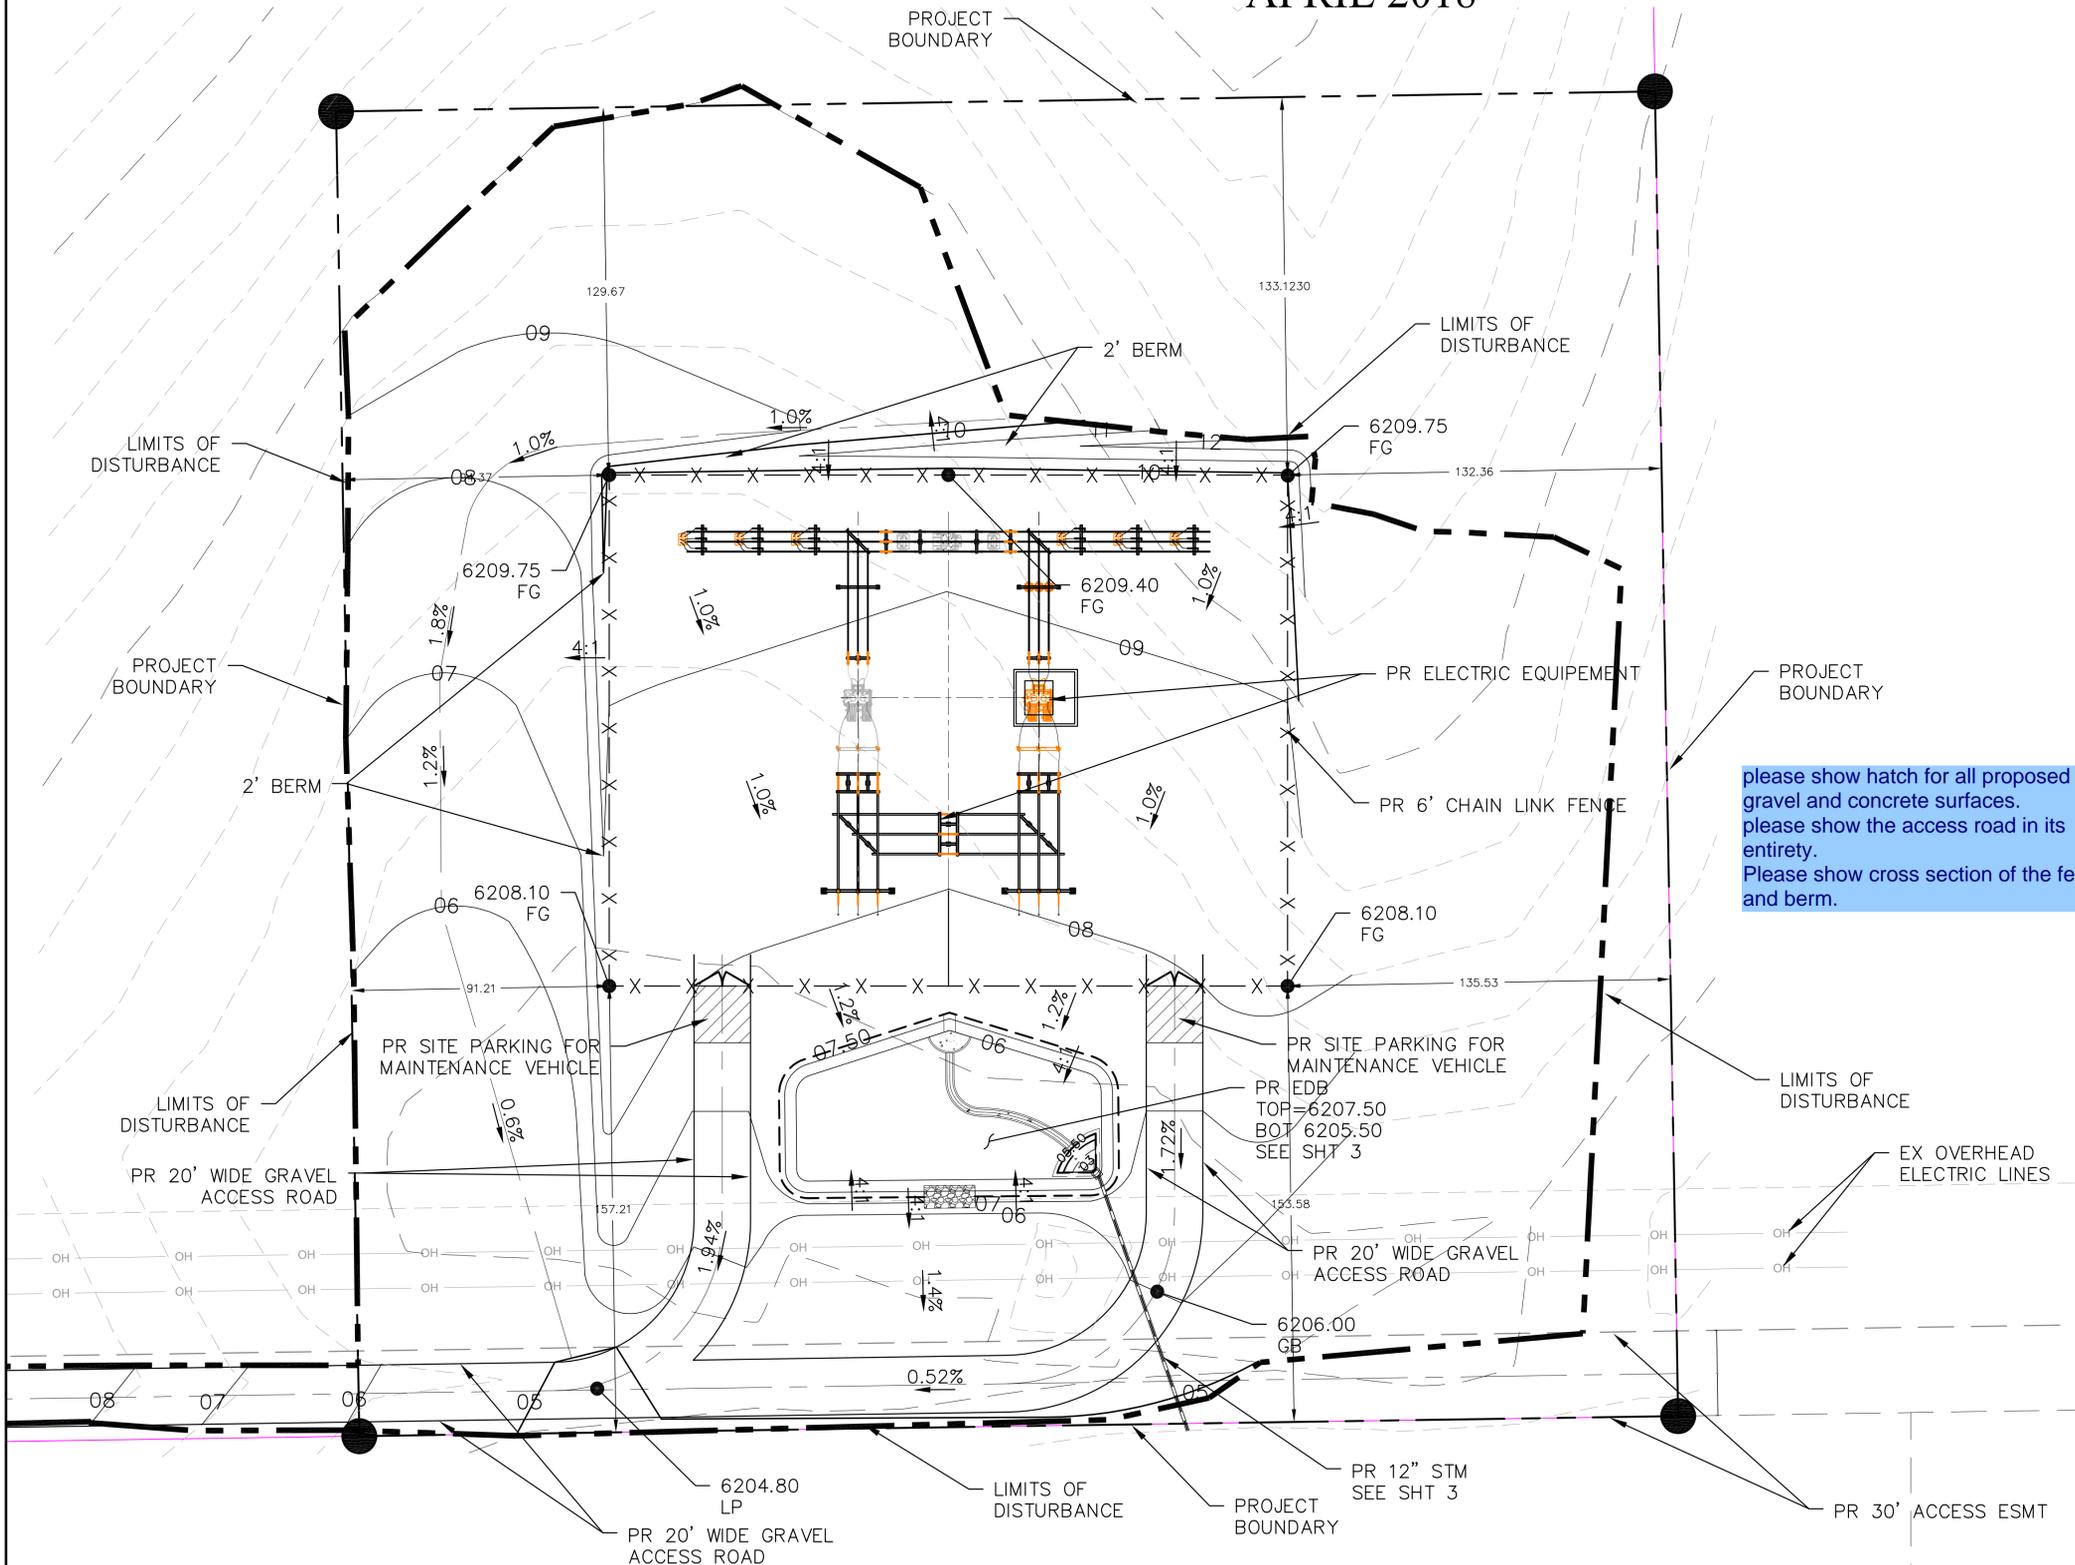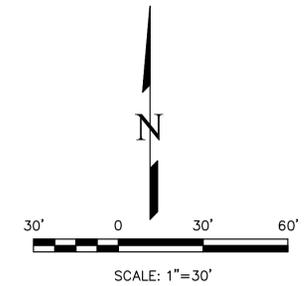

please show hatch for all proposed gravel and concrete surfaces.
 please show the access road in its entirety.
 Please show cross section of the fence and berm.

please show all existing fences on the southerly property line.

REVISIONS	NO.	DESCRIPTION	DATE

UNTIL SUCH TIME AS THESE DRAWINGS ARE APPROVED BY THE LOCAL JURISDICTION REVIEWING AGENCIES, TERRA NOVA ENGINEERING, INC. APPROVES THEIR USE ONLY FOR THE PROJECT AND COSTS AUTHORIZED BY WRITTEN AUTHORIZATION.

PREPARED FOR:
MVEA
 ATTN: DAVID WALDNER
 11140 E. WOODMAN RD.
 PEYTON, CO 80931
 719-495-2283



721 S. 2900 STREET
 COLORADO SPRINGS, CO 80904
 OFFICE: 719-635-6422
 FAX: 719-635-6426
 www.tnainc.com

MVEA YODER SUBSTATION
 SITE PLAN

DESIGNED BY QNA
 DRAWN BY QNA
 CHECKED BY
 H-SCALE 1"=50'
 V-SCALE NA
 JOB NO. 1802.00
 DATE ISSUED 4/18/18
 SHEET NO. 1 OF 1


Markup Summary

Locked (3)




Subject: Engineer
Page Label: 1
Lock: Locked
Author: dsdnijkamp
Date: 7/10/2018 3:34:06 PM
Color: ■

please show hatch for all proposed gravel and concrete surfaces.
please show the access road in its entirety.
Please show cross section of the fence and berm.

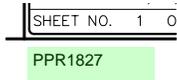

Subject: Text Box
Page Label: 1
Lock: Locked
Author: dsdsevigny
Date: 7/10/2018 3:34:09 PM
Color: ■

PPR1827

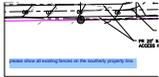

Subject: Engineer
Page Label: 1
Lock: Locked
Author: dsdnijkamp
Date: 7/10/2018 3:34:09 PM
Color: ■

please show all existing fences on the southerly property line.