


# MVEA YODER SUBSTATION

## EL PASO COUNTY

### SITE PLAN

### AUGUST 2018

LEGEND	
EXISTING CONTOURS - MINOR	6132
EXISTING CONTOURS - MAJOR	6130
PROPOSED CONTOURS - MAJOR	6132
PROPOSED CONTOURS - MAJOR	6130
LIMITS OF CONSTRUCTION	---
EXISTING FINISHED GROUND	EX-FG
PROPOSED FINISHED GROUND	FG
PROPOSED FLOWLINE	FL
LOW POINT	LP
HIGH POINT	HP
PROPOSED	PR
EXISTING	EX
GRADE & DIRECTION	2.2%

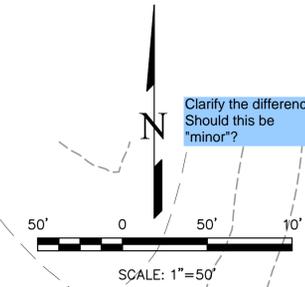

Clarify the difference. Should this be "minor"?

What is the purple line referencing?

This will be Tract L of the Subdivision Exemption Plat?

Provide a cross section of the berm


YODER ROAD  
(60' R.O.W.)

UNPLATTED  
OWNER MARK J KNEIS

UNPLATTED  
OWNER MARK J KNEIS

UNPLATTED  
TRACT B  
REC. NO. 208900014  
OWNERS MARVIN SCHOBEL/  
RANDALYNE BALLE-MASON

UNPLATTED  
NW 1/4 NW 1/4  
SEC 10, T14S, R61W  
OWNERS AMY DIANE SMITH

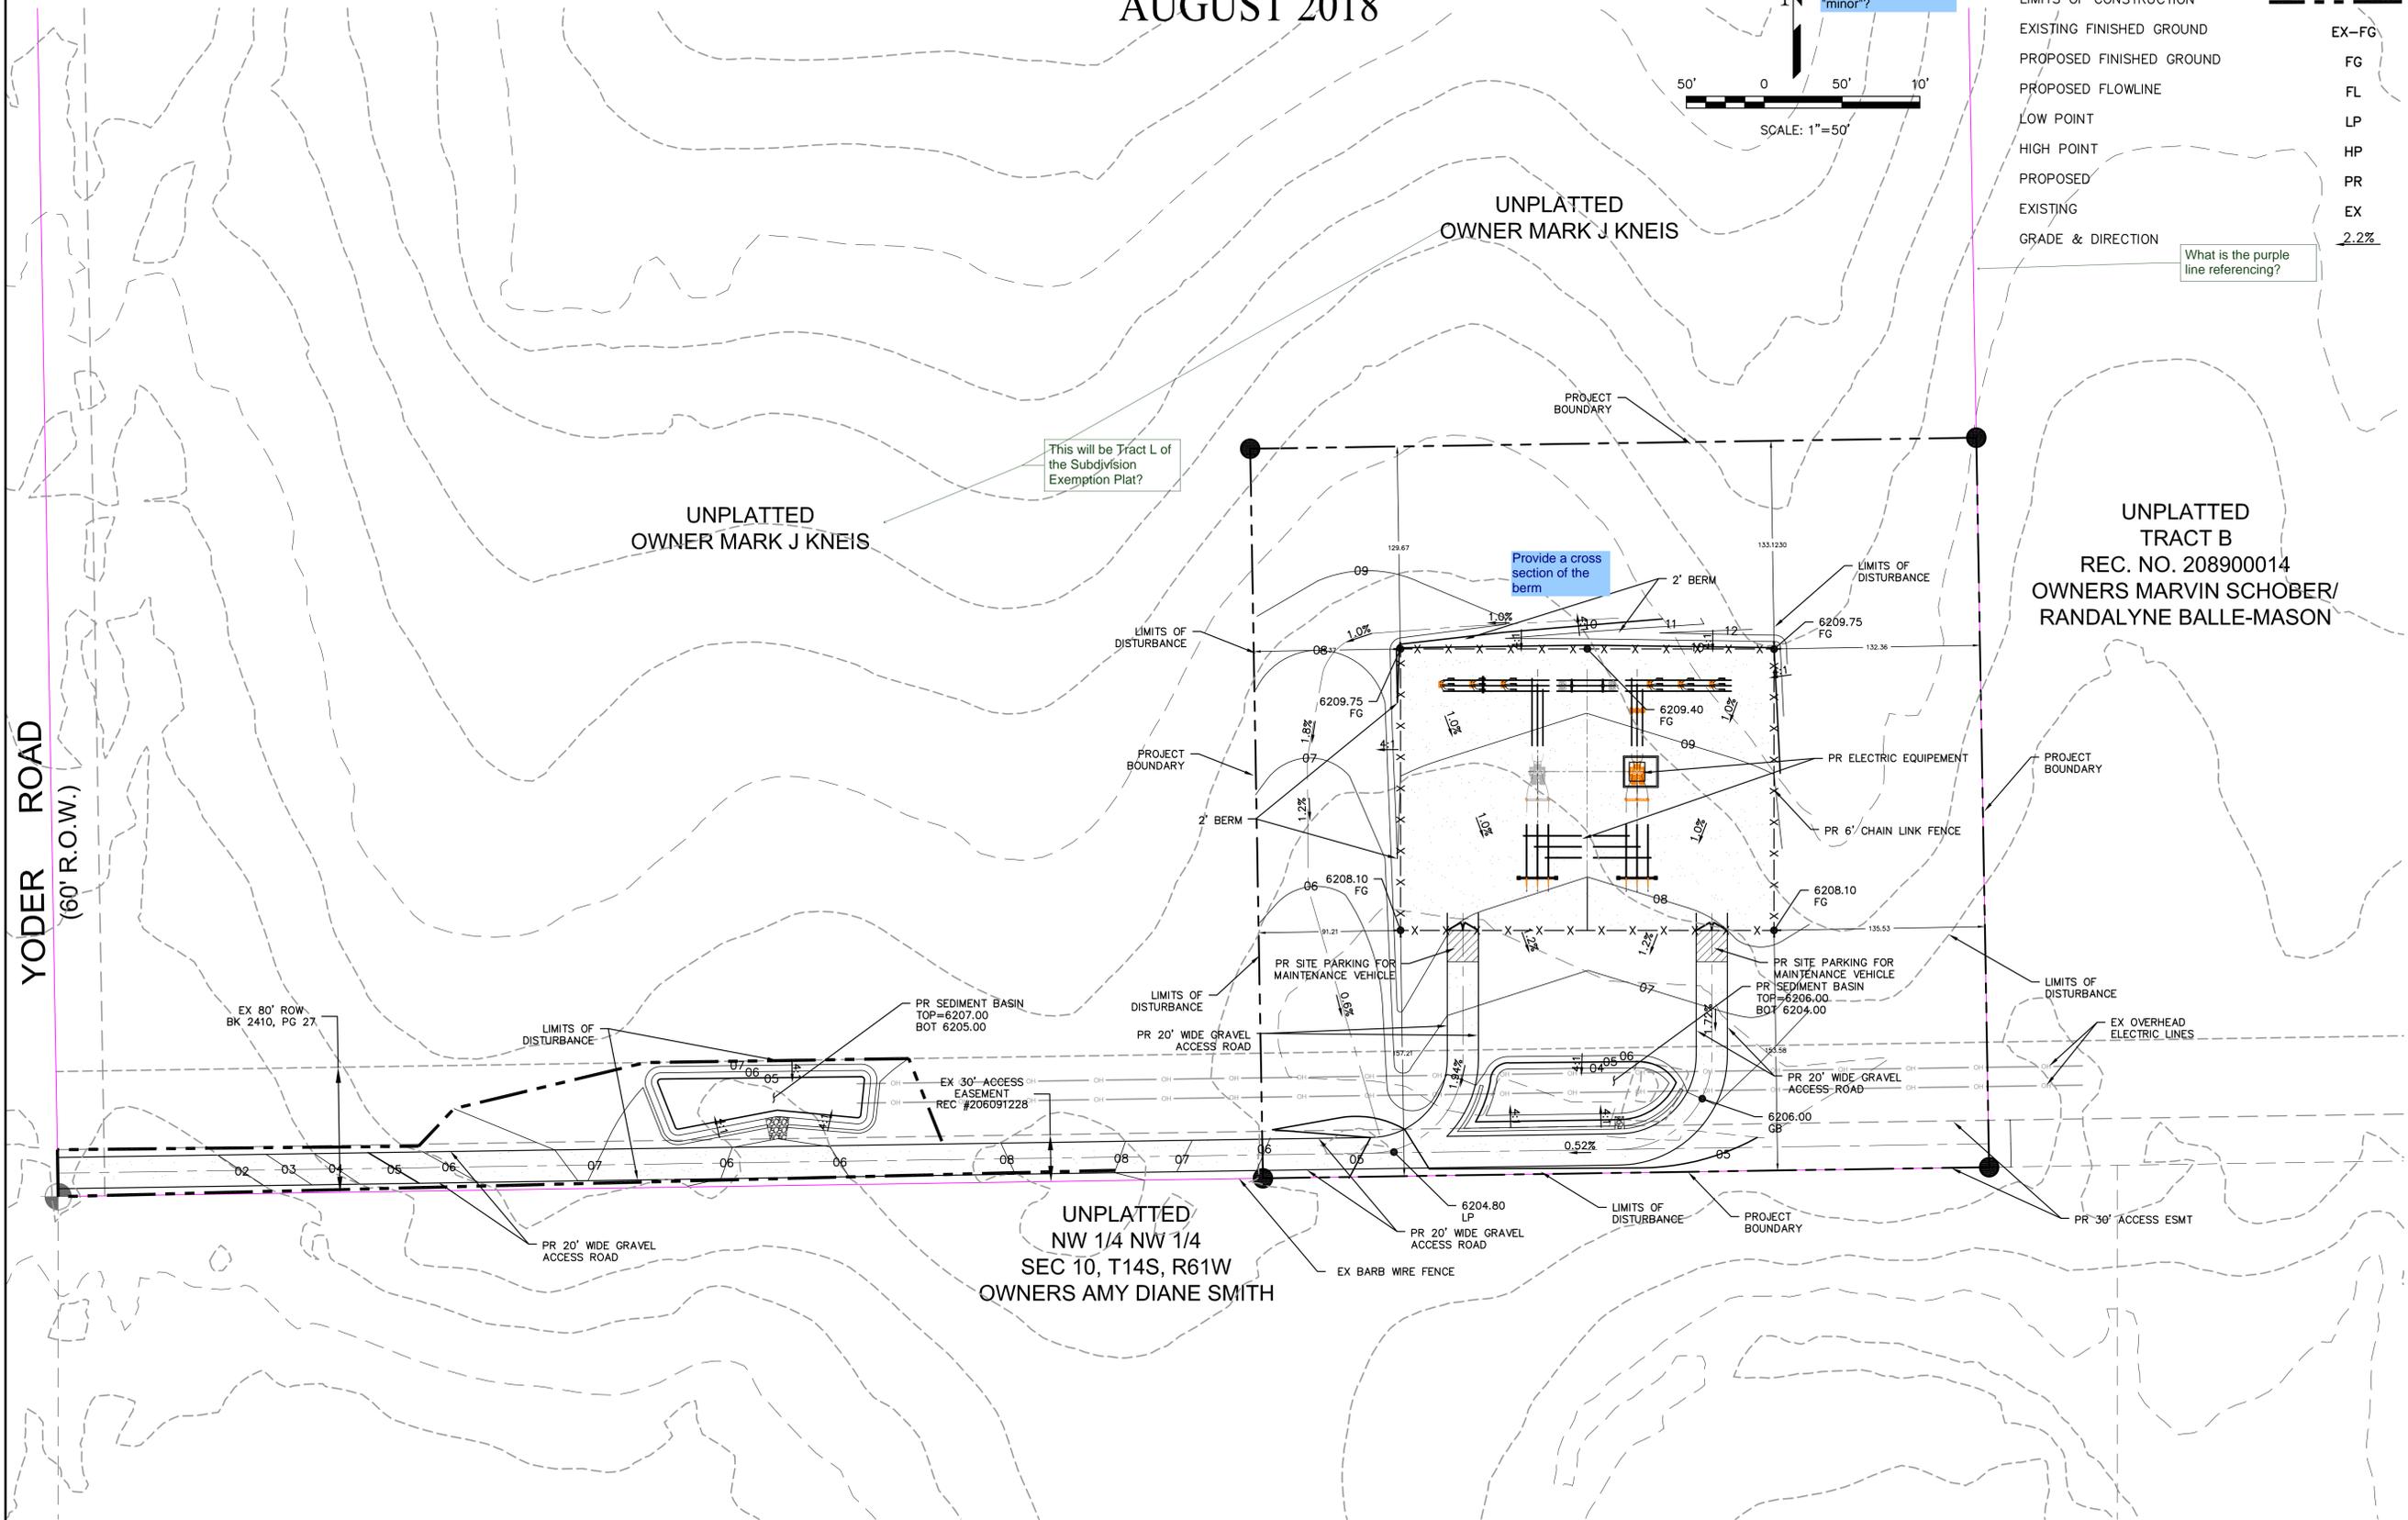

REVISIONS	NO.	DESCRIPTION	DATE
UNTIL SUCH TIME AS THESE DRAWINGS ARE APPROVED FOR THE PROJECT BY THE ENGINEER, TERRA NOVA ENGINEERING, INC. APPROVES THEIR USE ONLY FOR THE PROJECT AND FOR THE PURPOSES OF THE WRITTEN AUTHORIZATION.			

PREPARED FOR:  
**MVEA**  
ATTN: DAVID WALDNER  
11140 E. WOODMAN RD.  
PEYTON, CO 80931  
719-495-2283

  
 Terra Nova  
Engineering, Inc.  
Professional Civil Engineer No. 118115

721 S. 2900 STREET  
 COLORADO SPRINGS, CO 80904  
 OFFICE: 719-635-6422  
 FAX: 719-635-6426  
 www.tnaseinc.com

MVEA YODER SUBSTATION
SITE PLAN

DESIGNED BY QNA
DRAWN BY QNA
CHECKED BY
H-SCALE 1"=50'
V-SCALE NA
JOB NO. 1802.00
DATE ISSUED 8/2/18
SHEET NO. 1 OF 1


N:\pos\1802.00\drawings\cadd\180200 SITE PLAN.dwg, 8/7/2018 8:57:04 AM, Bluebeam PDF

# Markup Summary

---

Clarify the difference. Should this be "minor"? (1)

---

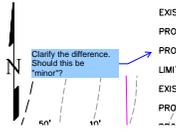


**Subject:** Engineer  
**Page Label:** 1  
**Lock:** Locked  
**Author:** dsdgrimm  
**Date:** 9/6/2018 3:16:48 PM  
**Color:** ■

Clarify the difference. Should this be "minor"?

---

Provide a cross section of the berm (1)

---

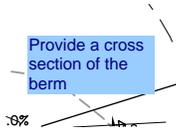


**Subject:** Engineer  
**Page Label:** 1  
**Lock:** Locked  
**Author:** dsdgrimm  
**Date:** 9/6/2018 3:16:49 PM  
**Color:** ■

Provide a cross section of the berm

---

This will be Tract L of the Subdivision Exemption Plat? (1)

---

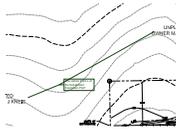


**Subject:** Callout  
**Page Label:** 1  
**Lock:** Locked  
**Author:** dsdseigny  
**Date:** 9/6/2018 3:16:49 PM  
**Color:** ■

This will be Tract L of the Subdivision Exemption Plat?

---

What is the purple line referencing? (1)

---

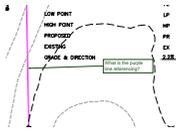

**Subject:** Callout  
**Page Label:** 1  
**Lock:** Locked  
**Author:** dsdseigny  
**Date:** 9/6/2018 3:16:50 PM  
**Color:** ■

What is the purple line referencing?