

**FINAL DRAINAGE REPORT  
FOR  
YODER ELECTRIC SUBSTATION  
EL PASO COUNTY, COLORADO**

for clarity and consistency please make this name the same as the project. (ie, add MVEA)

**FEBRUARY 2016**

Prepared For:  
**MOUNTAIN VIEW ELECTRIC ASSOCIATION**  
David Waldner  
11140 E Woodmen Rd, Peyton, CO 80831  
(719) 495-2283

Prepared By:  
**TERRA NOVA ENGINEERING, INC.**  
721 S 23<sup>rd</sup> Street  
Colorado Springs, CO 80904  
(719) 635-6422

Job No. 1802.00

Please provide file numbers:  
PPR-18-027  
U-18-002

**FINAL DRAINAGE REPORT  
FOR  
YODER ELECTRIC SUBSTATION**

**TABLE OF CONTENTS**

Engineer's Statement	Page 3
Purpose	Page 4
General Description	Page 4
Floodplain Statement	Page 4
Existing Drainage Conditions	Page 5
Proposed Drainage Conditions	Page 6
Hydrologic Calculations	Page 7
Hydraulic Calculations	Page 8
Erosion Control	Page 8
Maintenance	Page 8
Construction Cost Opinion	Page 8
Drainage Fees	Page 9
Summary	Page 9
Bibliography	Page 10

**REQUIRED MAPS AND DRAWINGS**

VICINITY MAP

S.C.S. SOILS MAP

FEMA FIRM MAP

HYDROLOGIC CALCULATIONS

HYDRAULIC CALCULATIONS

DETENTION CALCULATIONS

DRAINAGE PLAN

**CERTIFICATION STATEMENT:**

**Engineers Statement**

This attached drainage plan and report were prepared under my direction and supervision and are correct to the best of my knowledge and belief. Said drainage report has been prepared according to the criteria established by the County for drainage reports and said report is in conformity with the master plan of the drainage basin. I accept responsibility for any liability caused by any negligent acts, errors or omissions on my part in preparing this report.

\_\_\_\_\_  
Quentin Armijo, P.E. 37170

\_\_\_\_\_  
Seal

**Developers Statements**

I, Mountain View Electric Association, the developer have read and will comply with all of the requirements specified in this drainage report and plan.

**Mountain View Electric Association**

Business Name

By: \_\_\_\_\_

Title: \_\_\_\_\_

Address: \_\_\_\_\_

\_\_\_\_\_

El Paso County Approval:

Filed in accordance with the requirements of the Drainage Criteria Manual, Volumes 1 & 2, El Paso County Engineering Criteria Manual and Land Development Code as amended.

\_\_\_\_\_  
Jennifer Irvine,  
County Engineer / ECM Administrator

\_\_\_\_\_  
Date

Conditions:

Please describe the four step process as outlined in the ECM appendix I.

**FINAL DRAINAGE REPORT  
FOR  
YODER ELECTRIC SUBSTATION**

this FDR must address the access road (and its flow) as well.

**PURPOSE**

The purpose of this Final Drainage Report is to identify and analyze the proposed drainage patterns, determine proposed runoff quantities, size drainage structures for conveyance of developed runoff, and present solutions to drainage impacts on-site and off-site resulting from this development.

**GENERAL DESCRIPTION**

This Final Drainage Report (FDR) is an analysis of approximately 5.0 acres of undeveloped land located just east of the residential house at 1625 N. Yoder Road. This site is being developed by our client to include an electric substation. The development will also include improving the dirt access road to gravel. The site is located in the southwest quarter of Section 3, Township 14 South, Range 61 West of the 6<sup>th</sup> Principal Meridian currently within El Paso County, Colorado. The site is bounded to the north, west, & south by a 5 acres single family lots, and to the east by undeveloped open space. The site is contained within the Upper Pond Creek Basin.

Soils for this project are delineated by the map in the appendix as Bresser sandy loam (11) 0 to 3 percent slopes and Truckton sandy loam (97), 3 to 9 percent slopes. Soils in the study area are shown as mapped by S.C.S. in the “Soils Survey of El Paso County Area” and contains soils of Hydrologic Group B and A respectively.

**FLOODPLAIN STATEMENT**

No portion of this site is within a designated F.E.M.A. floodplain, as determined by Flood Insurance Rate Map No. 08041C0875 F, dated March 17, 1997 (see appendix).

## EXISTING DRAINAGE CONDITIONS

call out on plan

The site has not been previously developed and is currently part of a 40 acre single family parcel. The site consists mostly of natural vegetative grass and weeds, with some areas of bare ground. There is a natural ridge that runs north south through the site and splits it. The site has been broken down into two existing design points 1 & 2, two existing onsite basins EXA & EXB and two existing offsite basins OS-1 & OS-2 in order to show the historic drainage flows. Below is a description of them. See appendix for calculations.

Offsite Basin OS-1 (11.85 acres;  $Q_5=2.7$  cfs and  $Q_{100}=17.4$  cfs) consist of undeveloped open space prairie. Drainage in this basin sheet flows from north to south and drains onto Basin EXA.

see ex drainage map for inconsistency.

Basin EXA (3.83 acres;  $Q_5=1.1$  cfs and  $Q_{100}=7.4$  cfs) consist of undeveloped open space prairie. Drainage in this basin sheet flows from north to south. The combined flow ( $Q_5=3.5$  cfs and  $Q_{100}=23.0$  cfs) of Basin OS-1 and EXA sheet flows south in an existing broad swale and then to a low point at the south boundary (Design Point 1) where it ponds and then overtops offsite.

overtops what? are you missing some contours?

Offsite Basin OS-2 (0.33 acres;  $Q_5=0.1$  cfs and  $Q_{100}=0.7$  cfs) consist of undeveloped open space prairie. Drainage in this basin sheet flows from northwest to southeast and partially drains onto Basin EXB.

ditto

Basin EXB (1.17 acres;  $Q_5=0.4$  cfs and  $Q_{100}=2.7$  cfs) consist of undeveloped open space prairie. Drainage in this basin sheet flows from northwest to southeast. The combined flow ( $Q_5=0.5$  cfs and  $Q_{100}=3.4$  cfs) of Basin OS-2 and EXB sheet flows southeast into an existing offsite natural channel (Design Point 2).

Include Basin B

## PROPOSED DRAINAGE CONDITIONS

Runoff in the developed conditions will closely follow the historic drainage patterns with the exception of adding an Extended Detention Basin to capture and treat the runoff from the developed substation yard. For analysis the site has been broken down into three design points 1, 2, & 1A, four onsite basins A, A1 & A2, and the same two existing offsite basins OS-1 & OS-2. Below is a description of the runoff in the developed conditions and how it will be safely routed and treated. See appendix for calculations.

Offsite Basin OS-1 (11.85 acres;  $Q_5=2.7$  cfs and  $Q_{100}=17.4$  cfs) consist of undeveloped open space prairie. Drainage in this basin sheet flows from north to south and drains onto Basin A1.

Basin A1 (1.70 acres;  $Q_5=0.5$  cfs and  $Q_{100}=3.4$  cfs) consist of undeveloped open space prairie that will be inside the site boundary but will not have any improvements other than placing a 2' high berm on the north side of the yard to direct runoff to a broad swale, so the offsite flow can be routed around the substation yard. Drainage in this basin sheet flows to the broad swale (Design Point 1A). The combined flow ( $Q_5=3.1$  cfs and  $Q_{100}=19.9$  cfs) of Basin OS-1 and A1 is directed south in the broad swale and then to a low point at the south boundary (Design Point 1).

please define

Basin A (1.38 acres;  $Q_5=1.2$  cfs and  $Q_{100}=3.8$  cfs) will consist of the proposed substation yard and is comprised of loose gravel. Drainage in this basin sheet flows south to the proposed Extended Detention Basin (EDB). At the 0.221 acre EDB the inflow point consists of concrete rundown into concrete lined forebay, with a 1' high wall. A 2" slit in the wall routes the minor flow to 2' concrete trickle channels then the runoff is routed to the 2.5' deep micropool which has a 0.004 ac-ft Initial Surcharge Volume. The 1.38 acres tributary to EDB are 40.74% impervious. Based upon this we need a WQCV of 0.021 ac-ft, an ERUV volume of 0.004 ac-ft and 100-year volume of 0.045 ac-ft for a total volume needed of 0.105 ac-ft. An outlet structure will release the flows. The Micropool bottom elevation is 6203.00, the top is at 6205.50 while the ISV elevation is at 6205.83. The

.16" inches

do you have a swale to get the water into the pond? or is the flow just sheet flow over all sides? if you are designing the flow to gently flow over all sides of the pond (and design to prevent rilling) you may delete the forebay. a forebay is for a point source inflow.

please elaborate.

apart. The 2'x2' outlet structure grate is set at 6206.29, which corresponds to the EURV elevation. The 100-year elevation tops out at 6206.66. No restrictor plate is needed for the 12" outlet pipe, which releases  $Q_5=0.0$  cfs and  $Q_{100}=0.8$  cfs. Pipe Run 1 a 12" storm drain routes the discharge to the south boundary where the historic drainage flowed (Design Point 1). A 10' long emergency spillway set at 6207.16 will safely pass the 100' developed storm in case of failure in the outlet structure.

Basin A2 (0.75 acres;  $Q_5=0.4$  cfs and  $Q_{100}=1.8$  cfs) will consist undeveloped land with some gravel drive in the area just south of the proposed EDB. Drainage in this basin sheet flows south to Design Point 1. The combined flow of Basins OS-1, A, A1, & A2 at Design Point 1 is  $Q_5=3.3$  cfs and  $Q_{100}=21.9$  cfs

please state that this is below historic.

As in the historic condition Offsite Basin OS-2 (0.33 acres;  $Q_5=0.1$  cfs and  $Q_{100}=0.7$  cfs) consist of undeveloped open space prairie. Drainage in this basin sheet flows from northwest to southeast and partially drains onto Basin EXB.

Basin B (1.17 acres;  $Q_5=0.4$  cfs and  $Q_{100}=2.7$  cfs) consist of undeveloped open space prairie inside the property, but is not being improved. Drainage in this basin sheet flows from northwest to southeast. The combined flow ( $Q_5=0.5$  cfs and  $Q_{100}=3.4$  cfs) of Basin OS-2 and EXB sheet flows southeast into an existing offsite natural channel (Design Point 2).

## HYDROLOGIC CALCULATIONS

Hydrologic calculations were performed using the El Paso County Storm Drainage Design Criteria Manual - Volumes 1 & 2, latest editions. The Rational Method was used to estimate storm water runoff anticipated from design storms with 5-year and 100-year recurrence intervals. The Urban Drainage Criteria Manual was used to calculate the detention and water quality volume.

**HYDRAULIC CALCULATIONS**

Hydraulic calculations were estimated using the Manning’s Formula and the methods described in the El Paso County Storm Drainage Design Criteria Manual – Volumes 1 & 2, latest editions. The pertinent data sheets are included in the appendix of this report.

**EROSION CONTROL**

An erosion control plan is included with this drainage report. Vehicle Tracking Control (VTC) will be placed at any entrance to the site. A Concrete Washout (CW) will be placed on site, as well as a Materials Staging Area (SSA) and a Dirt Stockpile (SP) location. Silt Fence (SF) will be placed around the SP and Sediment Control Logs (SCL) are to be placed at the southern border of the site to keep runoff in place.

**MAINTENANCE**

The Extended Detention Basins and the storm drain systems are private and therefore must be maintained by the owner. These should be cleaned and checked after any significant precipitation event and at least once every three months. The proposed erosion control measures will be repaired and maintained by the property owner or owner’s representative as required.

Only one basin is shown. Please clarify.

none shown

an O&M plan is required to be submitted.

**CONSTRUCTION COST OPINION**

**Public Non Reimbursable**

**NOT APPLICABLE**

Include this in the Financial Assurance Estimate.

**Private Non Reimbursable**

1. 12” HDPE	95 LF	\$ 35	\$ 3,325
2. EDB	1 EA	\$ 10,000	\$ 10,000
3. Concrete channel	65 LF	\$ 25	\$ 1,625
4. 2’x2’ Dual Outlet	1 EA	\$ 2,500	<u>\$ 2,500</u>
			<b>Total \$ 17,450</b>

proposed conditions map shows RCP, please clarify.



## **DRAINAGE FEES**

The existing site is in the Upper Pond Creek Basin. It appears this is an unstudied basin and therefore no basin fees are due at the time of final plat.

## **SUMMARY**

Development of this site will not adversely affect the surrounding development. Proposed flows, as detailed in this report, will follow the drainage patterns outlined in this report showing how runoff will be safely routed downstream. The Extended Detention Basins will control developed flow to historic levels and provide water quality for this site. These water features will need to be periodically maintained by the owner in order to maintain their effectiveness in cleaning the discharge from the site.

**PREPARED BY:**  
**TERRA NOVA ENGINEERING, INC.**

Quentin Armijo, P.E.  
Senior Project Manager  
Jobs/1802.00/drainage/180200 - FDR.doc

please remove 'appears' and 'therefore'. It is unstudied, but that is not the reason that it is a no fee basin. Please just state that it has no established fee.


## **REFERENCE**

“El Paso County Drainage Criteria Manual-Volumes 1 & 2, latest edition”

SCS Soils Map for El Paso County

Federal Emergency Management Agency (FEMA) flood maps


## **VICINITY MAP**

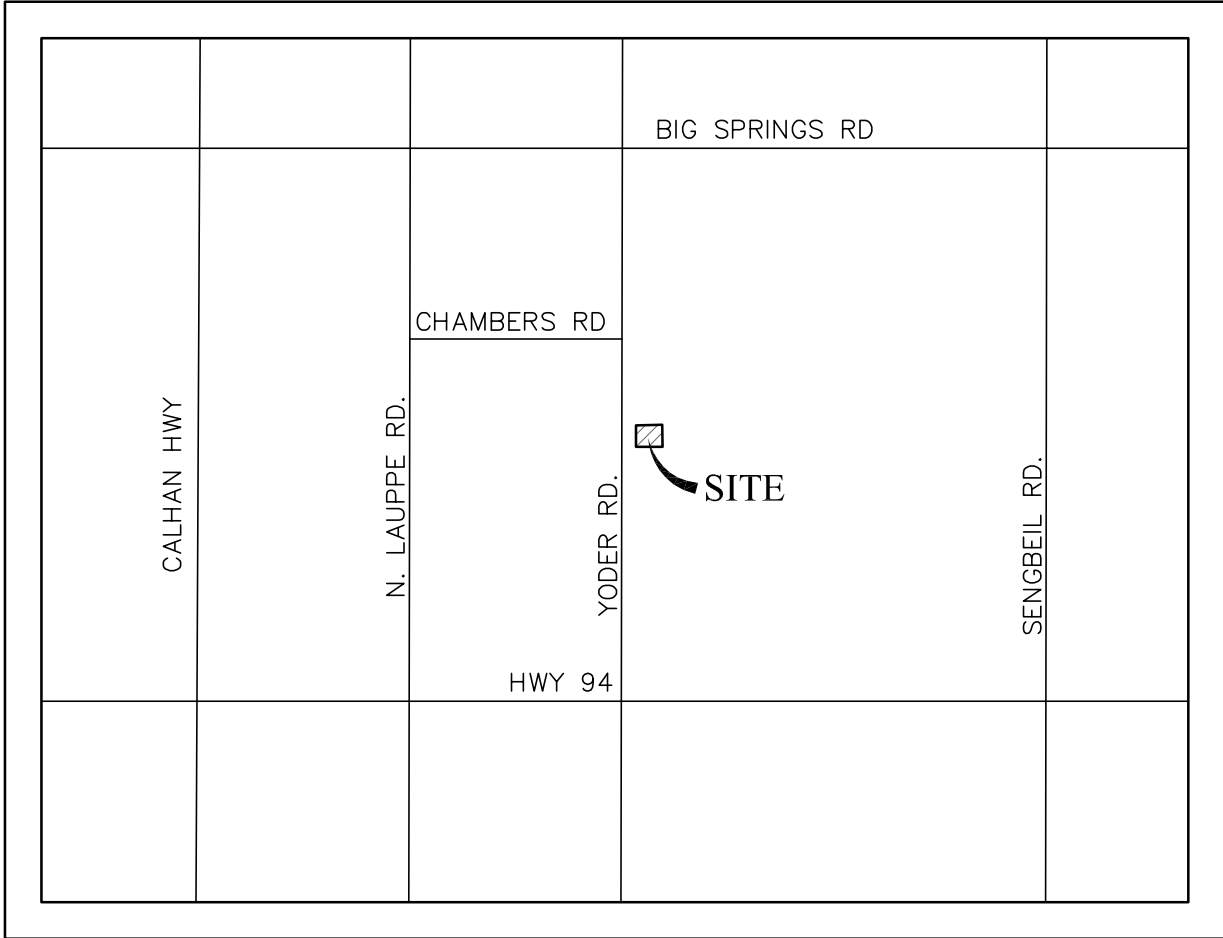

 






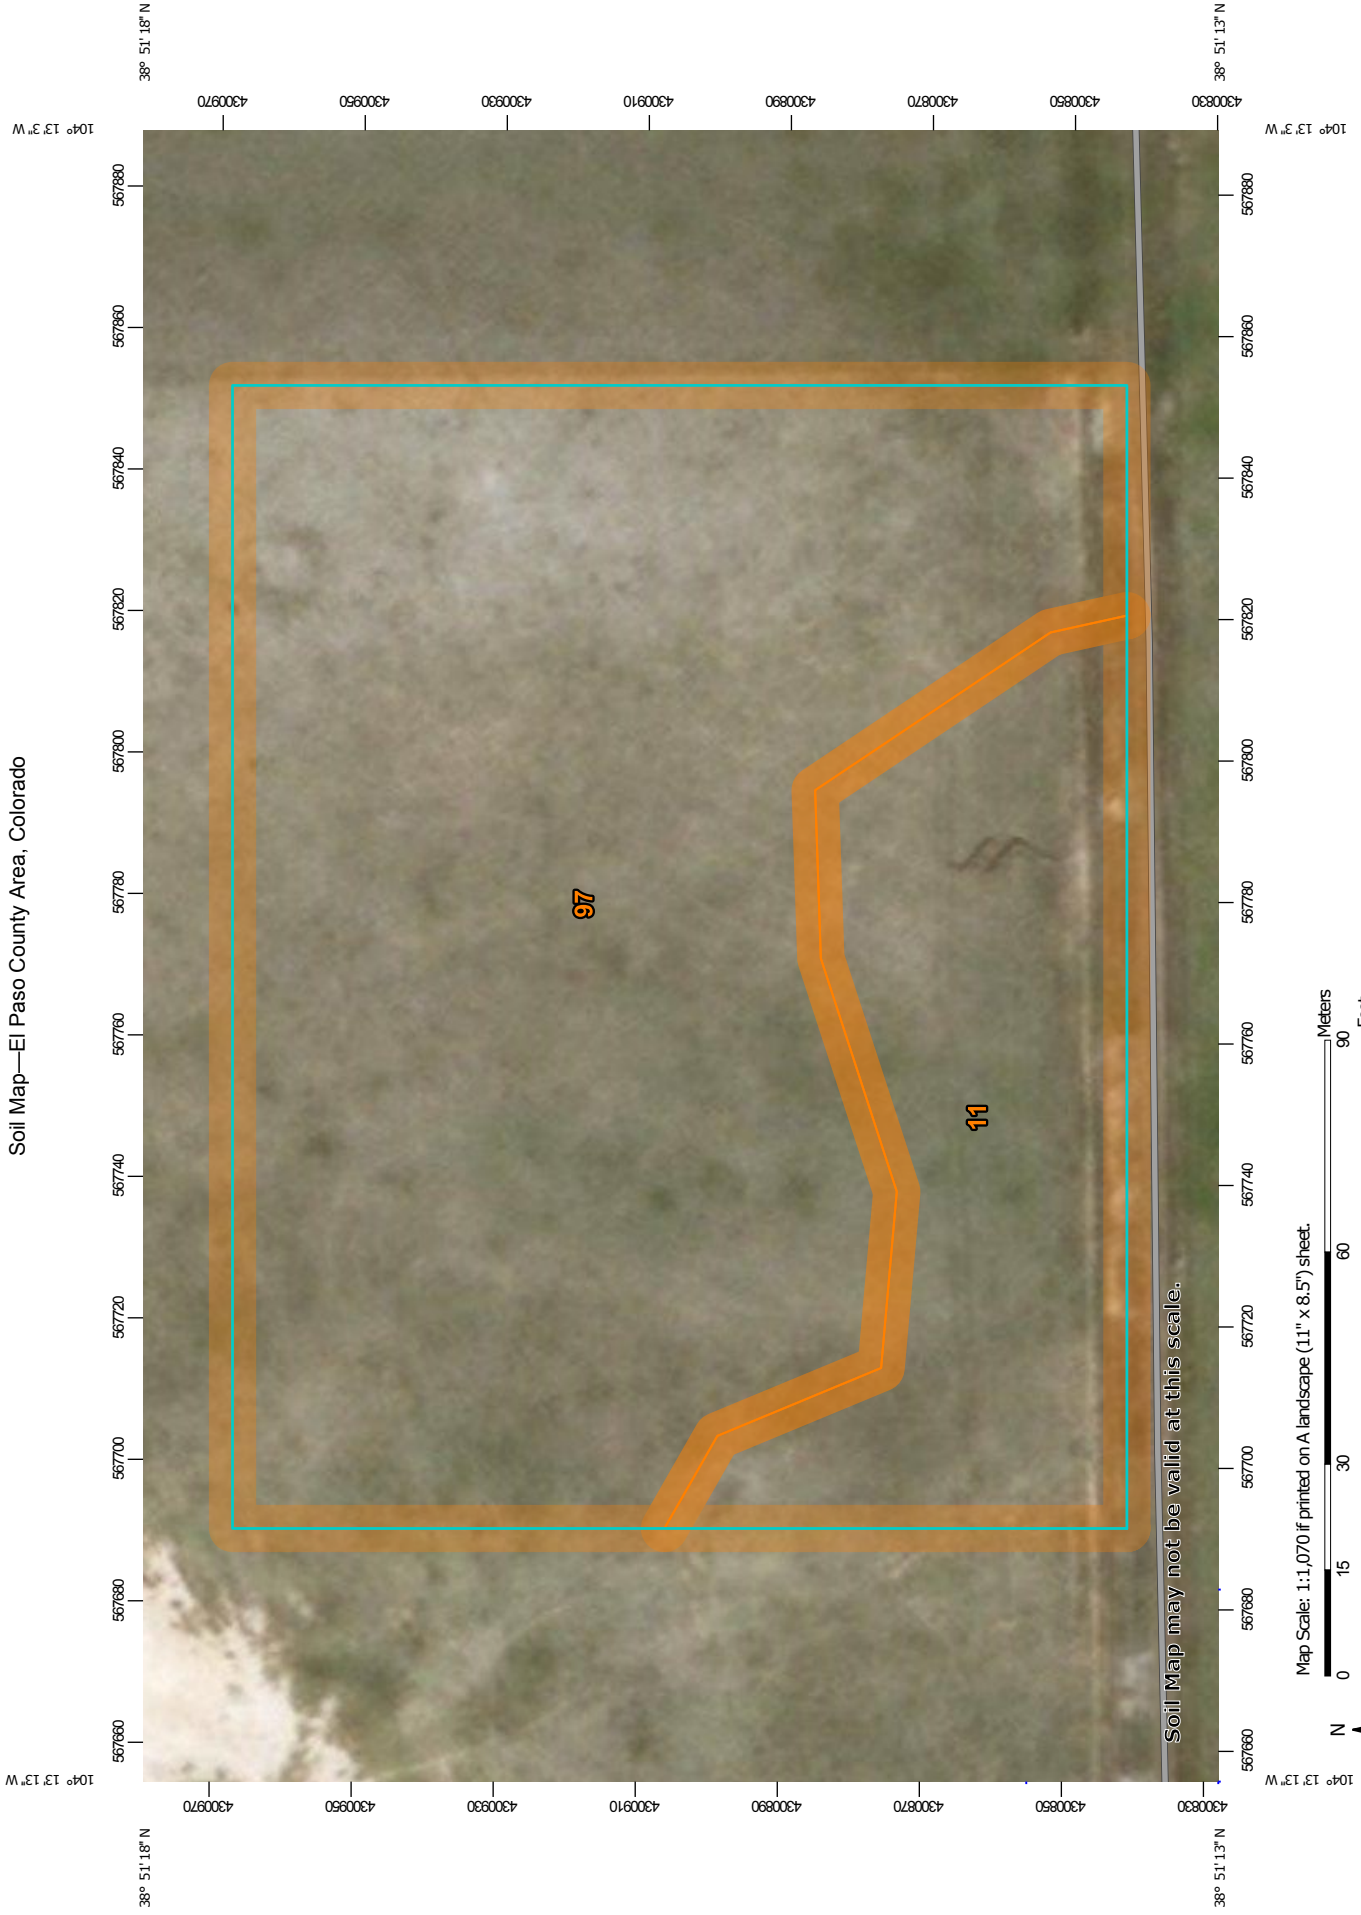 





























VICINITY MAP  
N.T.S.

**S.C.S. SOILS MAP**

Soil Map—El Paso County Area, Colorado



## MAP LEGEND

-  Area of Interest (AOI)
-  Area of Interest (AOI)
- Soils**
-  Soil Map Unit Polygons
-  Soil Map Unit Lines
-  Soil Map Unit Points
- Special Point Features**
-  Blowout
-  Borrow Pit
-  Clay Spot
-  Closed Depression
-  Gravel Pit
-  Gravelly Spot
-  Landfill
-  Lava Flow
-  Marsh or swamp
-  Mine or Quarry
-  Miscellaneous Water
-  Perennial Water
-  Rock Outcrop
-  Saline Spot
-  Sandy Spot
-  Severely Eroded Spot
-  Sinkhole
-  Slide or Slip
-  Sodic Spot
-  Spoil Area
-  Stony Spot
-  Very Stony Spot
-  Wet Spot
-  Other
-  Special Line Features
- Water Features**
-  Streams and Canals
- Transportation**
-  Rails
-  Interstate Highways
-  US Routes
-  Major Roads
-  Local Roads
- Background**
-  Aerial Photography

## MAP INFORMATION

The soil surveys that comprise your AOI were mapped at 1:24,000.

Warning: Soil Map may not be valid at this scale.

Enlargement of maps beyond the scale of mapping can cause misunderstanding of the detail of mapping and accuracy of soil line placement. The maps do not show the small areas of contrasting soils that could have been shown at a more detailed scale.

Please rely on the bar scale on each map sheet for map measurements.

Source of Map: Natural Resources Conservation Service  
 Web Soil Survey URL:  
 Coordinate System: Web Mercator (EPSG:3857)

Maps from the Web Soil Survey are based on the Web Mercator projection, which preserves direction and shape but distorts distance and area. A projection that preserves area, such as the Albers equal-area conic projection, should be used if more accurate calculations of distance or area are required.

This product is generated from the USDA-NRCS certified data as of the version date(s) listed below.

Soil Survey Area: El Paso County Area, Colorado  
 Survey Area Data: Version 15, Oct 10, 2017

Soil map units are labeled (as space allows) for map scales 1:50,000 or larger.

Date(s) aerial images were photographed: May 22, 2016—Mar 9, 2017


The orthophoto or other base map on which the soil lines were compiled and digitized probably differs from the background imagery displayed on these maps. As a result, some minor shifting of map unit boundaries may be evident.

## Map Unit Legend

Map Unit Symbol	Map Unit Name	Acres in AOI	Percent of AOI
11	Bresser sandy loam, cool, 0 to 3 percent slopes	1.2	24.5%
97	Truckton sandy loam, 3 to 9 percent slopes	3.8	75.5%
<b>Totals for Area of Interest</b>		<b>5.0</b>	<b>100.0%</b>



**FEMA FIRM MAP**

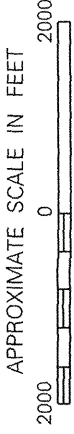

APPROXIMATE SCALE IN FEET


**NATIONAL FLOOD INSURANCE PROGRAM**

**FIRM**  
**FLOOD INSURANCE RATE MAP**  
 EL PASO COUNTY,  
 COLORADO AND  
 INCORPORATED AREAS

**PANEL 875 OF 1300**  
 (SEE MAP INDEX FOR PANELS NOT PRINTED)


CONTAINS:  
 COMMUNITY \_\_\_\_\_ NUMBER PANEL SUFFIX \_\_\_\_\_  
 EL PASO COUNTY, UNINCORPORATED AREAS 080059 0875 F

**MAP NUMBER 08041C0875 F**  
**EFFECTIVE DATE: MARCH 17, 1997**



Federal Emergency Management Agency

This is an official copy of a portion of the above referenced flood map. It was extracted using F-MIT On-Line. This map does not reflect changes or amendments which may have been made subsequent to the date on the title block. For the latest product information about National Flood Insurance Program flood maps, check the FEMA Flood Map Store at [www.msc.fema.gov](http://www.msc.fema.gov)

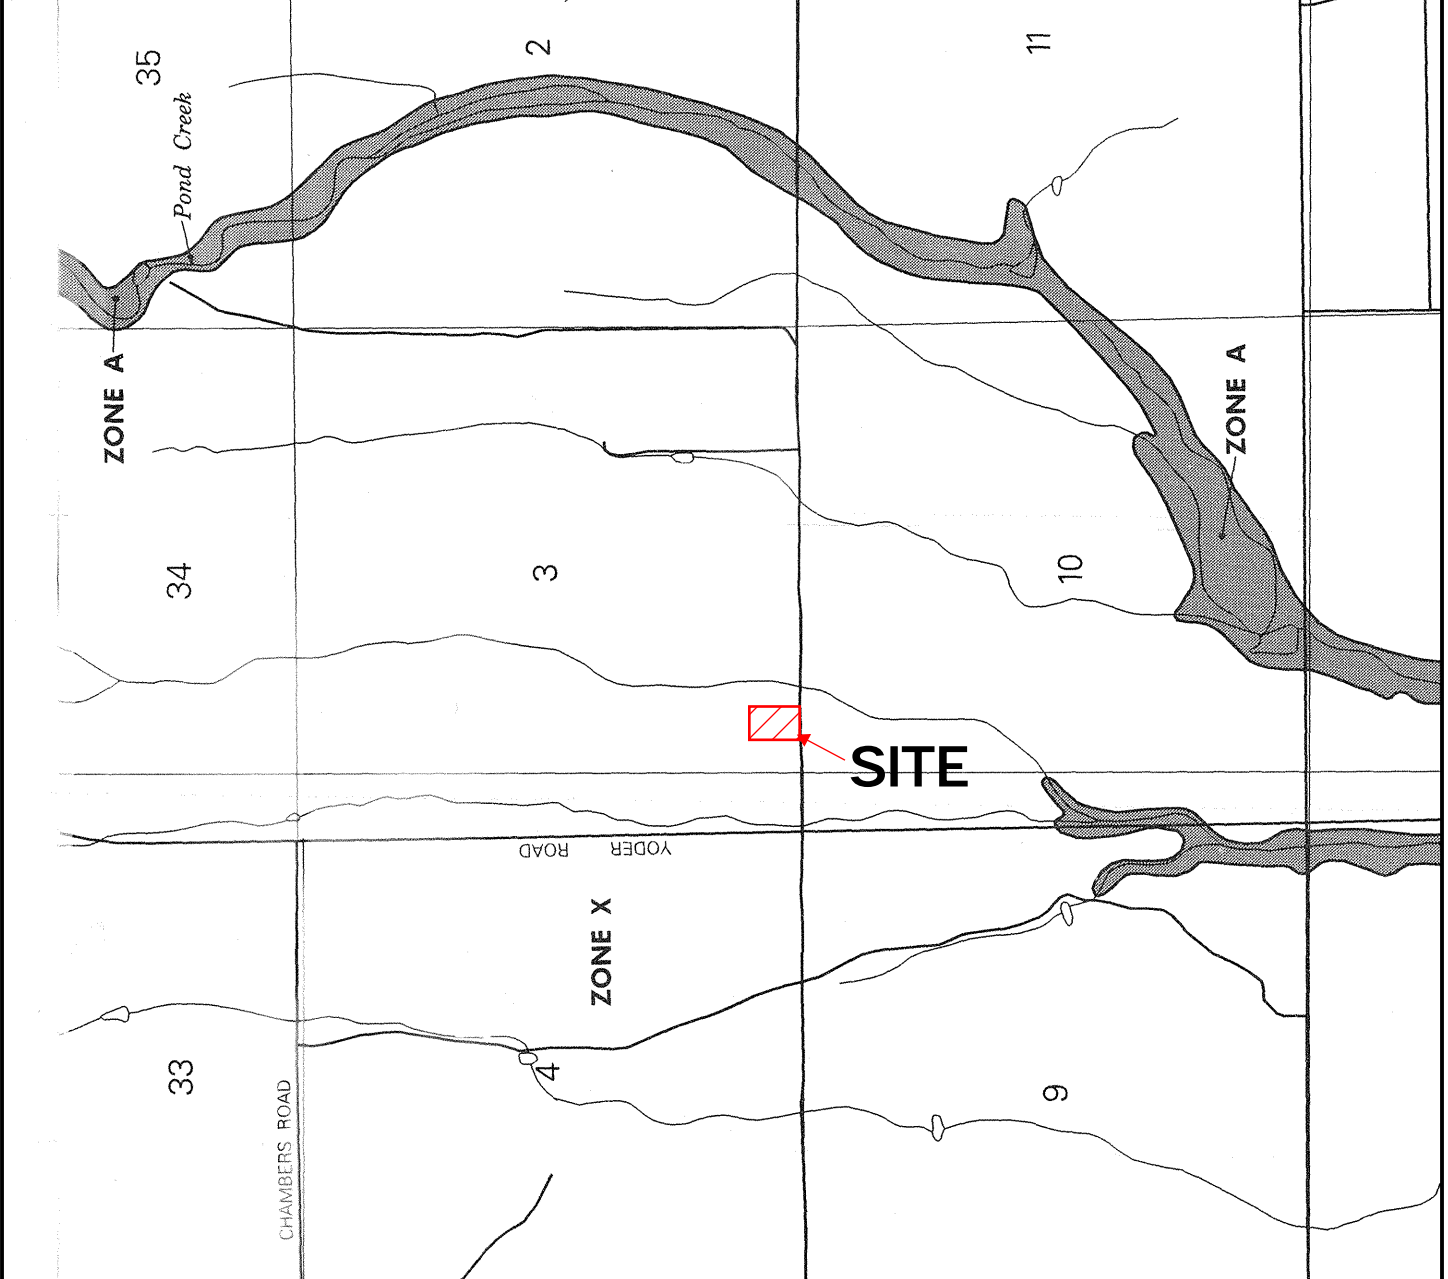

## **HYDROLOGIC CALCULATIONS**

**MVEA YODER SUBSTATION**  
**(Area Runoff Coefficient Summary)**

**HISTORIC**

BASIN	DEVELOPED			UNDEVELOPED			WEIGHTED		
	TOTAL AREA (Acres)	AREA (Acres)	C <sub>5</sub>	C <sub>100</sub>	AREA (Acres)	C <sub>5</sub>	C <sub>100</sub>	C <sub>5</sub>	C <sub>100</sub>
OS-1	11.85	0.00	0.30	0.50	11.85	0.09	0.36	0.09	0.36
OS-2	0.33	0.00	0.30	0.50	0.33	0.09	0.36	0.09	0.36
EXA	3.83	0.00	0.30	0.50	3.83	0.09	0.36	0.09	0.36
EXB	1.17	0.00	0.30	0.50	1.17	0.09	0.36	0.09	0.36

QNA

Date: 2/16/2018

Checked by: \_\_\_\_\_

**DEVELOPED**

BASIN	DEVELOPED			UNDEVELOPED			WEIGHTED		
	TOTAL AREA (Acres)	AREA (Acres)	C <sub>5</sub>	C <sub>100</sub>	AREA (Acres)	C <sub>5</sub>	C <sub>100</sub>	C <sub>5</sub>	C <sub>100</sub>
OS-1	11.85	0.00	0.30	0.50	11.85	0.09	0.36	0.09	0.36
OS-2	0.33	0.00	0.30	0.50	0.33	0.09	0.36	0.09	0.36
A	1.38	1.02	0.30	0.50	0.36	0.09	0.36	0.25	0.46
A1	1.70	0.06	0.30	0.50	1.65	0.09	0.36	0.10	0.36
A2	0.75	0.16	0.30	0.50	0.59	0.09	0.36	0.14	0.39
B	1.17	0.00	0.30	0.50	1.17	0.09	0.36	0.09	0.36

QNA

Date: 2/16/2018

Checked by: \_\_\_\_\_

# MVEA YODER SUBSTATION AREA DRAINAGE SUMMARY

## HISTORIC

BASIN	AREA TOTAL (Acrey)	WEIGHTED		OVERLAND			STREET / CHANNEL FLOW				INTENSITY		TOTAL FLOWS		
		C <sub>5</sub>	C <sub>100</sub>	Length (ft)	Height (ft)	T <sub>c</sub> (min)	Length (ft)	Slope (%)	Velocity (fps)	T <sub>t</sub> (min)	T <sub>t</sub> TOTAL (min)	I <sub>5</sub> (in/hr)	I <sub>100</sub> (in/hr)	Q <sub>5</sub> (cfs)	Q <sub>100</sub> (cfs)
OS-1	11.85	0.09	0.36	100	1.2	17.8	1565	2.8%	2.2	11.9	29.6	2.5	4.1	2.7	17.4
OS-2	0.33	0.09	0.36	100	5.0	11.1	205	1.7%	2.1	1.6	12.7	3.7	6.4	0.1	0.7
EXA	3.83	0.09	0.36	86	1.9	13.5	531	1.3%	2.0	4.4	17.9	3.2	5.4	1.1	7.4
EXB	1.17	0.09	0.36	100	5.0	11.1	170	2.4%	2.6	1.1	12.2	3.8	6.5	0.4	2.7

Calculated by: QNA

Date: 2/16/2018

Checked by: \_\_\_\_\_

## DEVELOPED

BASIN	AREA TOTAL (Acrey)	WEIGHTED		OVERLAND			STREET / CHANNEL FLOW				INTENSITY		TOTAL FLOWS		
		C <sub>5</sub>	C <sub>100</sub>	Length (ft)	Height (ft)	T <sub>c</sub> (min)	Length (ft)	Slope (%)	Velocity (fps)	T <sub>t</sub> (min)	T <sub>t</sub> TOTAL (min)	I <sub>5</sub> (in/hr)	I <sub>100</sub> (in/hr)	Q <sub>5</sub> (cfs)	Q <sub>100</sub> (cfs)
OS-1	11.85	0.09	0.36	100	1.2	17.8	1565	2.8%	2.2	11.9	29.6	2.5	4.1	2.7	17.4
OS-2	0.33	0.09	0.36	100	5.0	11.1	205	1.7%	2.0	1.7	12.8	3.7	6.3	0.1	0.7
A	1.38	0.25	0.46	100	1.3	13.7	125	1.0%	2.0	1.0	14.8	3.5	5.9	1.2	3.8
A1	1.70	0.10	0.36	100	5.0	11.1	550	0.9%	1.5	6.1	17.2	3.3	5.5	0.5	3.4
A2	0.75	0.14	0.39	89	2.0	13.6	68	1.5%	2.1	0.5	14.2	3.6	6.1	0.4	1.8
B	1.17	0.09	0.36	100	3.0	13.1	63	5.4%	3.7	0.3	13.4	3.6	6.2	0.4	2.6

Calculated by: QNA

Date: 2/16/2018

Checked by: \_\_\_\_\_

**MVEA YODER SUBSTATION  
SURFACE ROUTING SUMMARY**

<b>HISTORIC</b>									
<b>Design Point(s)</b>	<b>Contributing Basins</b>	<b>Area (Acres)</b>	<b>Equivalent CA<sub>5</sub></b>	<b>Equivalent CA<sub>100</sub></b>	<b>Maximum T<sub>C</sub></b>	<b>Intensity</b>		<b>Flow</b>	
						<b>I<sub>5</sub></b>	<b>I<sub>100</sub></b>	<b>Q<sub>5</sub></b>	<b>Q<sub>100</sub></b>
1	OS-1 & EXA	15.69	1.41	5.65	29.6	2.5	4.1	3.5	23.0
2	OS-2, & EXB	1.49	0.13	0.54	12.7	3.7	6.4	0.5	3.4

<b>DEVELOPED</b>									
<b>Design Point(s)</b>	<b>Contributing Basins</b>	<b>Area (Acres)</b>	<b>Equivalent CA<sub>5</sub></b>	<b>Equivalent CA<sub>100</sub></b>	<b>Maximum T<sub>C</sub></b>	<b>Intensity</b>		<b>Flow</b>	
						<b>I<sub>5</sub></b>	<b>I<sub>100</sub></b>	<b>Q<sub>5</sub></b>	<b>Q<sub>100</sub></b>
1A	OS-1 & A1	13.55	1.23	4.89	29.6	2.5	4.1	3.1	19.9
1	OS-1, A1, & A2 EDB Release	15.69	1.34	5.38	29.6	2.5	4.1	3.3	21.9
2	OS-1, & B	1.49	0.13	0.54	12.8	3.7	6.3	0.5	3.4

Date: 2/16/2018.

Checked by: \_\_\_\_\_

## **HYDRAULIC CALCULATIONS**

# Free Online Manning Pipe Flow Calculator

>> Nationalism not welcome here. <<

## Manning Formula Uniform Pipe Flow at Given Slope and Depth

Can you help me translate, program, or host these calculators? (./contact.php) [Hide this request]

Check out our newest spreadsheet update: [Download Spreadsheet \(spreadsheet/Manning-Pipe-Flow.xlsx\)](#) [Open Google Sheets version \(spreadsheet/Manning-Pipe-Flow.php\)](#) [View All Spreadsheets \(http://www.hawsedc.com/engcalcs/SpreadsheetLibrary.php\)](#)

--CAUTION: If you have downloaded the spreadsheet prior to September 24, you may have received incorrect results!--

<b>Pipe Run 1</b>			
<b>12" Pond outlet</b>			
Set units:	<input type="text" value="m"/> <input type="text" value="mm"/> <input type="text" value="ft"/> <input type="text" value="in"/>		
Pipe diameter, d <sub>0</sub>	<input type="text" value="12"/> <input type="text" value="in"/>	Flow, Q	<input type="text" value="0.8104"/> <input type="text" value="cfs"/>
Manning roughness, n ? ( <a href="http://www.engineeringtoolbox.com/mannings-roughness-d_799.html">http://www.engineeringtoolbox.com/mannings-roughness-d_799.html</a> )	<input type="text" value=".013"/>	Velocity, v	<input type="text" value="2.8575"/> <input type="text" value="ft/sec"/>
Pressure slope (possibly ? (./pressureslope.php) equal to pipe slope), S <sub>0</sub>	<input type="text" value=".5"/> <input type="text" value="% rise/run"/>	Velocity head, h <sub>v</sub>	<input type="text" value="0.1269"/> <input type="text" value="ft"/>
Percent of (or ratio to) full depth (100% or 1 if flowing full)	<input type="text" value="39"/> <input type="text" value=""/>	Flow area	<input type="text" value="0.2836"/> <input type="text" value="ft^2"/>
	<input type="text" value=""/>	Wetted perimeter	<input type="text" value="1.3490"/> <input type="text" value="ft"/>
	<input type="text" value=""/>	Hydraulic radius	<input type="text" value="0.2102"/> <input type="text" value="ft"/>
	<input type="text" value=""/>	Top width, T	<input type="text" value="0.9755"/> <input type="text" value="ft"/>
	<input type="text" value=""/>	Froude number, F	<input type="text" value="0.93"/>
	<input type="text" value=""/>	Shear stress (tractive force), tau	<input type="text" value="0.1218"/> <input type="text" value="psf"/>

Results

Flow, Q	0.8104	cfs
Velocity, v	2.8575	ft/sec
Velocity head, h <sub>v</sub>	0.1269	ft
Flow area	0.2836	ft <sup>2</sup>
Wetted perimeter	1.3490	ft
Hydraulic radius	0.2102	ft
Top width, T	0.9755	ft
Froude number, F	0.93	
Shear stress (tractive force), tau	0.1218	psf



## **DETENTION CALCULATIONS**




## Detention Basin Outlet Structure Design

UD-Detention, Version 3.07 (February 2017)

Project: \_\_\_\_\_

Basin ID: \_\_\_\_\_

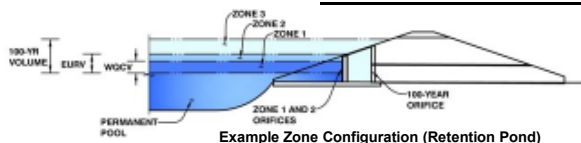

Example Zone Configuration (Retention Pond)

	Stage (ft)	Zone Volume (ac-ft)	Outlet Type
Zone 1 (WQCV)	0.44	0.021	Orifice Plate
Zone 2 (EURV)	0.79	0.040	Orifice Plate
Zone 3 (100-year)	1.16	0.045	Weir&Pipe (Restrict)
		0.105	Total

User Input: Orifice at Underdrain Outlet (typically used to drain WQCV in a Filtration BMP)

Underdrain Orifice Invert Depth =  ft (distance below the filtration media surface)  
 Underdrain Orifice Diameter =  inches

Calculated Parameters for Underdrain

Underdrain Orifice Area =  ft<sup>2</sup>  
 Underdrain Orifice Centroid =  feet

User Input: Orifice Plate with one or more orifices or Elliptical Slot Weir (typically used to drain WQCV and/or EURV in a sedimentation BMP)

Invert of Lowest Orifice =  ft (relative to basin bottom at Stage = 0 ft)  
 Depth at top of Zone using Orifice Plate =  ft (relative to basin bottom at Stage = 0 ft)  
 Orifice Plate: Orifice Vertical Spacing =  inches  
 Orifice Plate: Orifice Area per Row =  sq. inches (diameter = 5/8 inch)

Calculated Parameters for Plate

WQ Orifice Area per Row =  ft<sup>2</sup>  
 Elliptical Half-Width =  feet  
 Elliptical Slot Centroid =  feet  
 Elliptical Slot Area =  ft<sup>2</sup>

User Input: Stage and Total Area of Each Orifice Row (numbered from lowest to highest)

	Row 1 (required)	Row 2 (optional)	Row 3 (optional)	Row 4 (optional)	Row 5 (optional)	Row 6 (optional)	Row 7 (optional)	Row 8 (optional)
Stage of Orifice Centroid (ft)	0.00	0.30	0.60					
Orifice Area (sq. inches)	0.30	0.30	0.30					

	Row 9 (optional)	Row 10 (optional)	Row 11 (optional)	Row 12 (optional)	Row 13 (optional)	Row 14 (optional)	Row 15 (optional)	Row 16 (optional)
Stage of Orifice Centroid (ft)								
Orifice Area (sq. inches)								

User Input: Vertical Orifice (Circular or Rectangular)

	Not Selected	Not Selected	
Invert of Vertical Orifice =	<input type="text" value="N/A"/>	<input type="text" value="N/A"/>	ft (relative to basin bottom at Stage = 0 ft)
Depth at top of Zone using Vertical Orifice =	<input type="text" value="N/A"/>	<input type="text" value="N/A"/>	ft (relative to basin bottom at Stage = 0 ft)
Vertical Orifice Diameter =	<input type="text" value="N/A"/>	<input type="text" value="N/A"/>	inches

Calculated Parameters for Vertical Orifice

	Not Selected	Not Selected	
Vertical Orifice Area =	<input type="text" value="N/A"/>	<input type="text" value="N/A"/>	ft <sup>2</sup>
Vertical Orifice Centroid =	<input type="text" value="N/A"/>	<input type="text" value="N/A"/>	feet

User Input: Overflow Weir (Dropbox) and Grate (Flat or Sloped)

	Zone 3 Weir	Not Selected	
Overflow Weir Front Edge Height, Ho =	1.16	N/A	ft (relative to basin bottom at Stage = 0 ft)
Overflow Weir Front Edge Length =	2.00	N/A	feet
Overflow Weir Slope =	0.00	N/A	H:V (enter zero for flat grate)
Horiz. Length of Weir Sides =	2.00	N/A	feet
Overflow Grate Open Area % =	70%	N/A	% grate open area/total area
Debris Clogging % =	50%	N/A	%

Calculated Parameters for Overflow Weir

	Zone 3 Weir	Not Selected	
Height of Grate Upper Edge, H <sub>1</sub> =	1.16	N/A	feet
Over Flow Weir Slope Length =	2.00	N/A	feet
Grate Open Area / 100-yr Orifice Area =	3.57	N/A	should be ≥ 4
Overflow Grate Open Area w/o Debris =	2.80	N/A	ft <sup>2</sup>
Overflow Grate Open Area w/ Debris =	1.40	N/A	ft <sup>2</sup>

User Input: Outlet Pipe w/ Flow Restriction Plate (Circular Orifice, Restrictor Plate, or Rectangular Orifice)

	Zone 3 Restrictor	Not Selected	
Depth to Invert of Outlet Pipe =	0.52	N/A	ft (distance below basin bottom at Stage = 0 ft)
Outlet Pipe Diameter =	12.00	N/A	inches
Restrictor Plate Height Above Pipe Invert =	12.00		inches

Calculated Parameters for Outlet Pipe w/ Flow Restriction Plate

	Zone 3 Restrictor	Not Selected	
Outlet Orifice Area =	0.79	N/A	ft <sup>2</sup>
Outlet Orifice Centroid =	0.50	N/A	feet
Half-Central Angle of Restrictor Plate on Pipe =	3.14	N/A	radians

User Input: Emergency Spillway (Rectangular or Trapezoidal)

Spillway Invert Stage =  ft (relative to basin bottom at Stage = 0 ft)  
 Spillway Crest Length =  feet  
 Spillway End Slopes =  H:V  
 Freeboard above Max Water Surface =  feet

Calculated Parameters for Spillway

Spillway Design Flow Depth =  feet  
 Stage at Top of Freeboard =  feet  
 Basin Area at Top of Freeboard =  acres

### Routed Hydrograph Results

	WQCV	EURV	2 Year	5 Year	10 Year	25 Year	50 Year	100 Year	500 Year
Design Storm Return Period =									
One-Hour Rainfall Depth (in) =	0.53	1.07	1.19	1.50	1.75	2.00	2.25	2.52	3.00
Calculated Runoff Volume (acre-ft) =	0.021	0.061	0.043	0.057	0.074	0.099	0.126	0.159	0.224
OPTIONAL Override Runoff Volume (acre-ft) =									
Inflow Hydrograph Volume (acre-ft) =	0.020	0.060	0.042	0.057	0.073	0.099	0.125	0.159	0.224
Predevelopment Unit Peak Flow, q (cfs/acre) =	0.00	0.00	0.00	0.01	0.06	0.18	0.37	0.65	1.19
Predevelopment Peak Q (cfs) =	0.0	0.0	0.0	0.0	0.1	0.2	0.5	0.9	1.6
Peak Inflow Q (cfs) =	0.4	1.0	0.7	1.0	1.2	1.7	2.1	2.6	3.7
Peak Outflow Q (cfs) =	0.0	0.0	0.0	0.0	0.0	0.0	0.2	0.8	1.9
Ratio Peak Outflow to Predevelopment Q =	N/A	N/A	N/A	1.5	0.3	0.1	0.4	0.9	1.1
Structure Controlling Flow =	Plate	Plate	Plate	Plate	Plate	Plate	Overflow Grate 1	Overflow Grate 1	Overflow Grate 1
Max Velocity through Grate 1 (fps) =	N/A	N/A	N/A	N/A	N/A	N/A	0.0	0.3	0.6
Max Velocity through Grate 2 (fps) =	N/A	N/A	N/A	N/A	N/A	N/A	N/A	N/A	N/A
Time to Drain 97% of Inflow Volume (hours) =	43	72	62	70	78	88	91	89	84
Time to Drain 99% of Inflow Volume (hours) =	45	77	65	75	83	95	99	98	96
Maximum Ponding Depth (ft) =	0.41	0.76	0.61	0.73	0.87	1.07	1.21	1.29	1.39
Area at Maximum Ponding Depth (acres) =	0.09	0.12	0.11	0.12	0.12	0.12	0.13	0.13	0.13
Maximum Volume Stored (acre-ft) =	0.019	0.056	0.039	0.054	0.069	0.095	0.111	0.121	0.135

this number should be less than 1.0

## **DRAINAGE MAPS**

# MVEA YODER SUBSTATION

## EL PASO COUNTY, CO

# DEVELOPED DRAINAGE MAP

## FEBRUARY 2018

### PIPE RUN SUMMARY



PIPE RUN	CONTRIBUTING DESIGN POINTS	AREA AC.	Q5 CFS	Q100 CFS	MIN. SLOPE	SIZE
1	POND RELEASE	1.38	0.0	0.8	0.50%	12"

### DESIGN POINT SUMMARY





DP	CONTRIBUTING BASINS	AREA AC.	Q5 CFS	Q100 CFS
1A	OS-A & A1	13.55	3.1	19.9
1	OS-A, A, A1, & A2	15.69	3.3	21.9
2	OS-1 & OS-B	1.49	0.5	3.4

### PROPOSED CONDITIONS

BASIN	ACRES	Q5 CFS	Q100 CFS
OS-1	11.85	2.7	17.4
OS-2	0.33	0.1	0.7
A	1.38	1.2	3.8
A1	1.70	0.5	3.4
A2	0.75	0.4	1.8
B	1.17	0.4	2.6

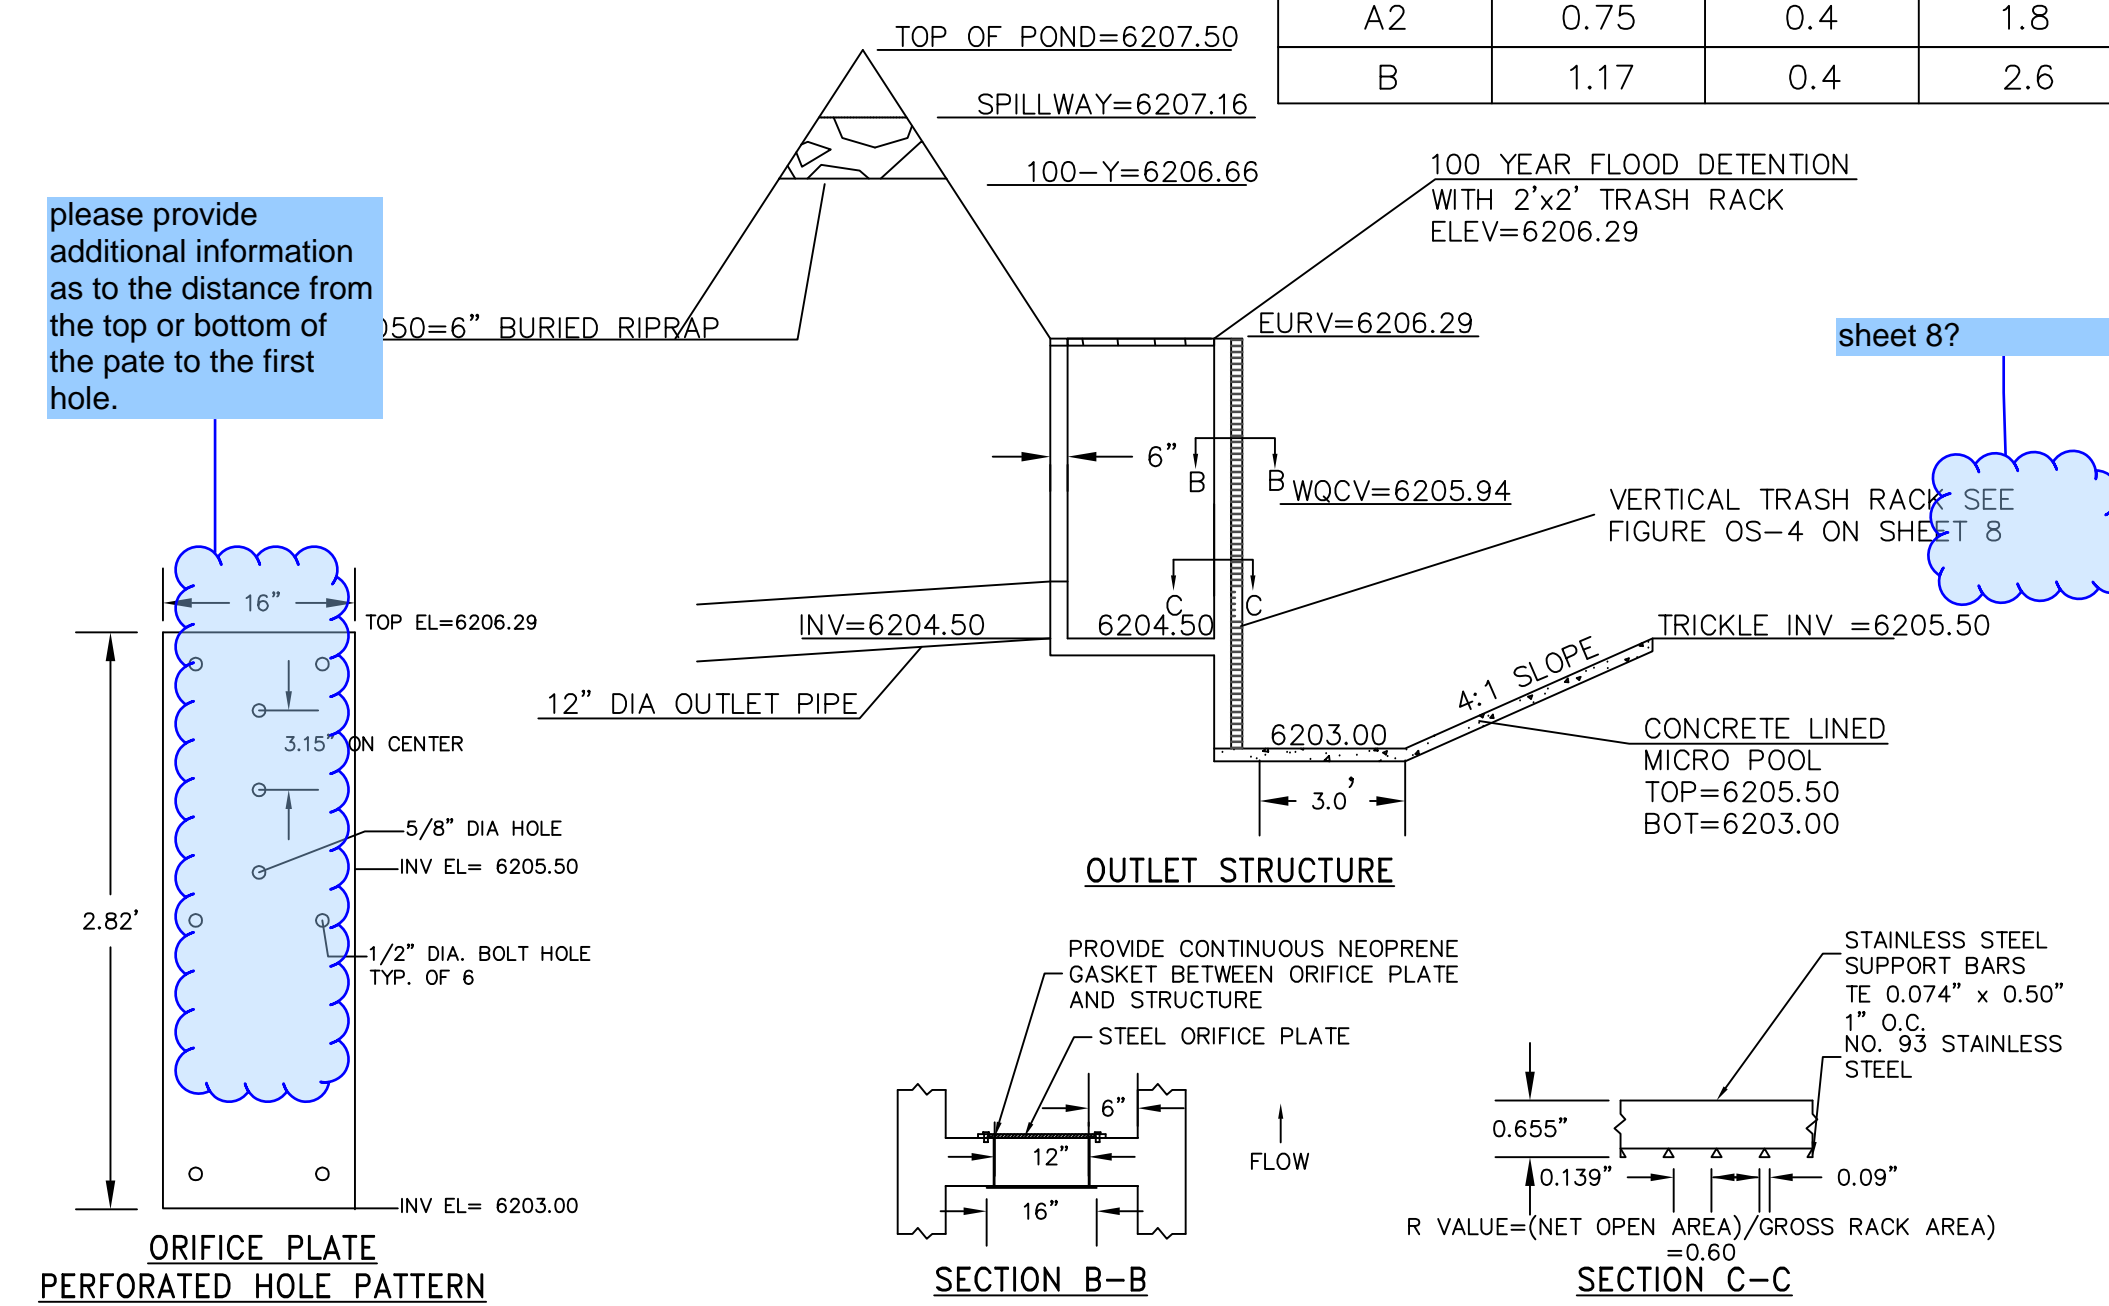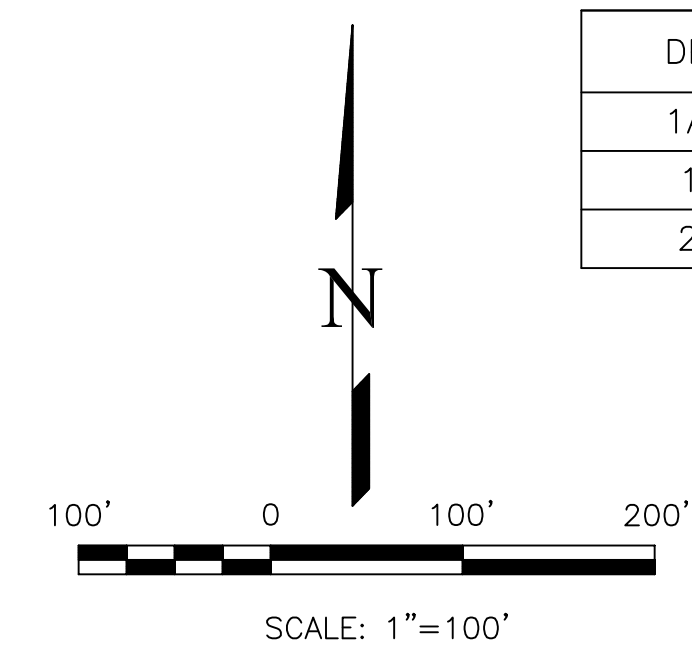

### POND OUTLET OVERALL DETAIL

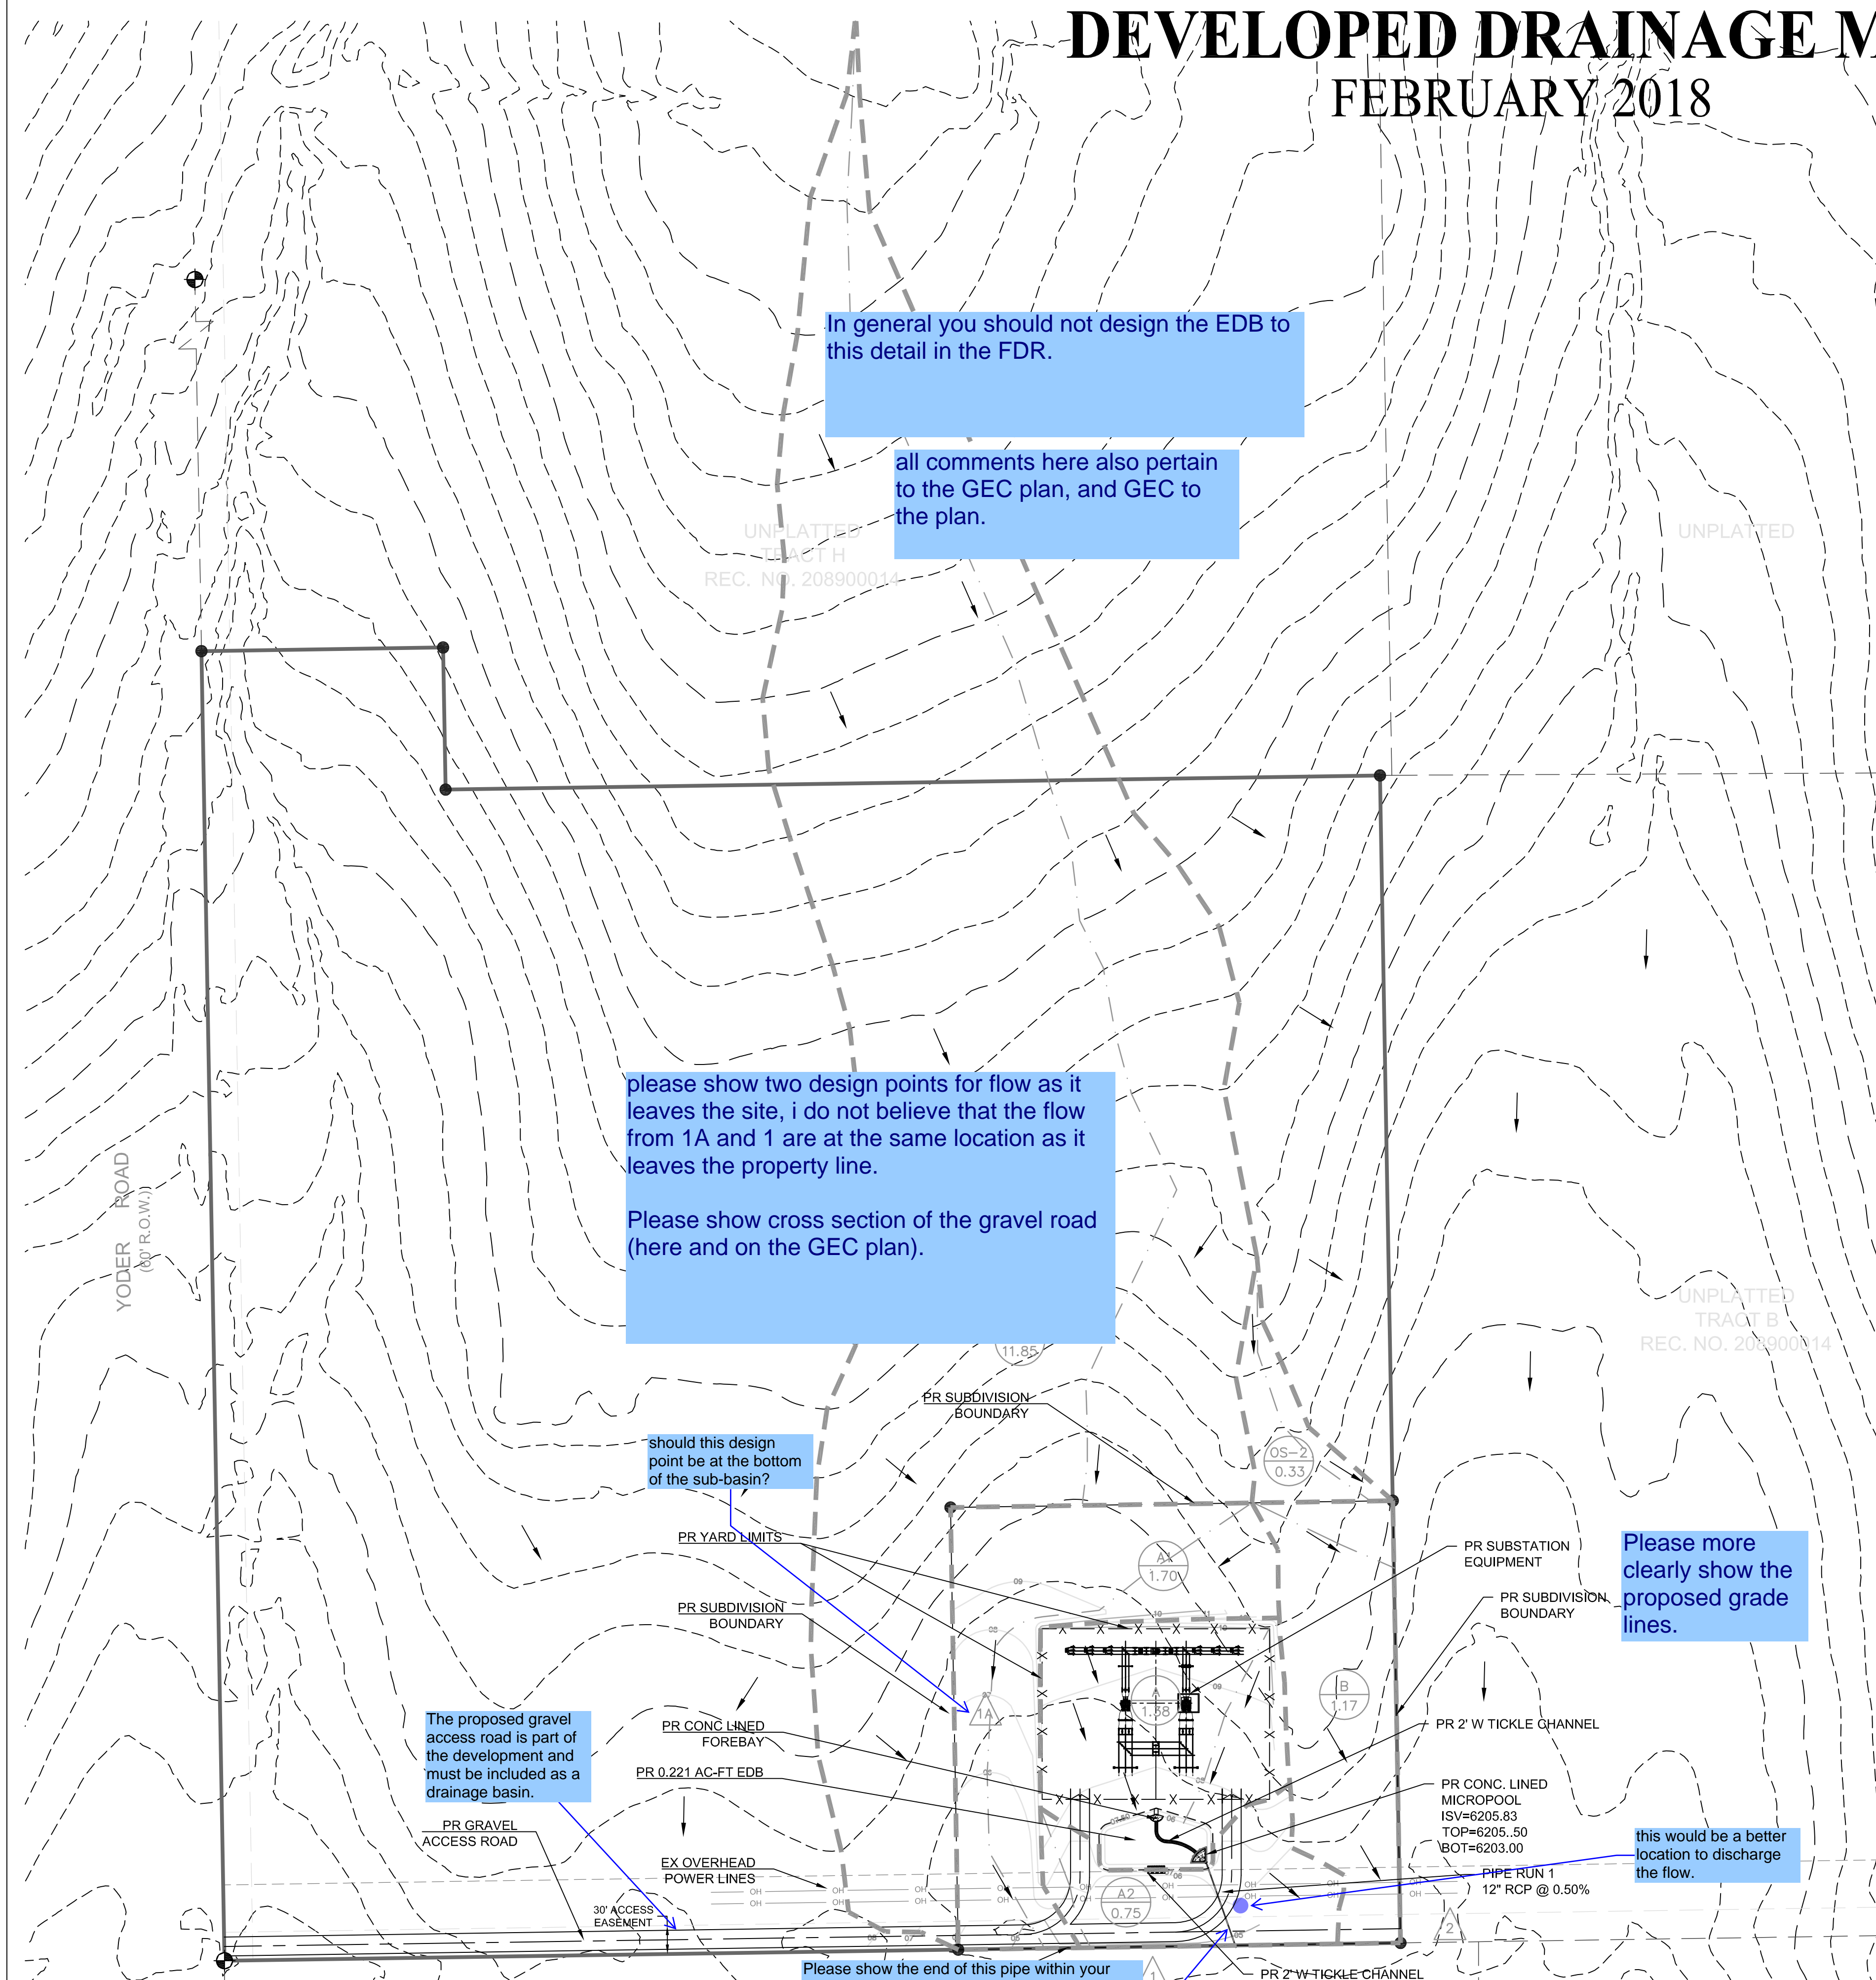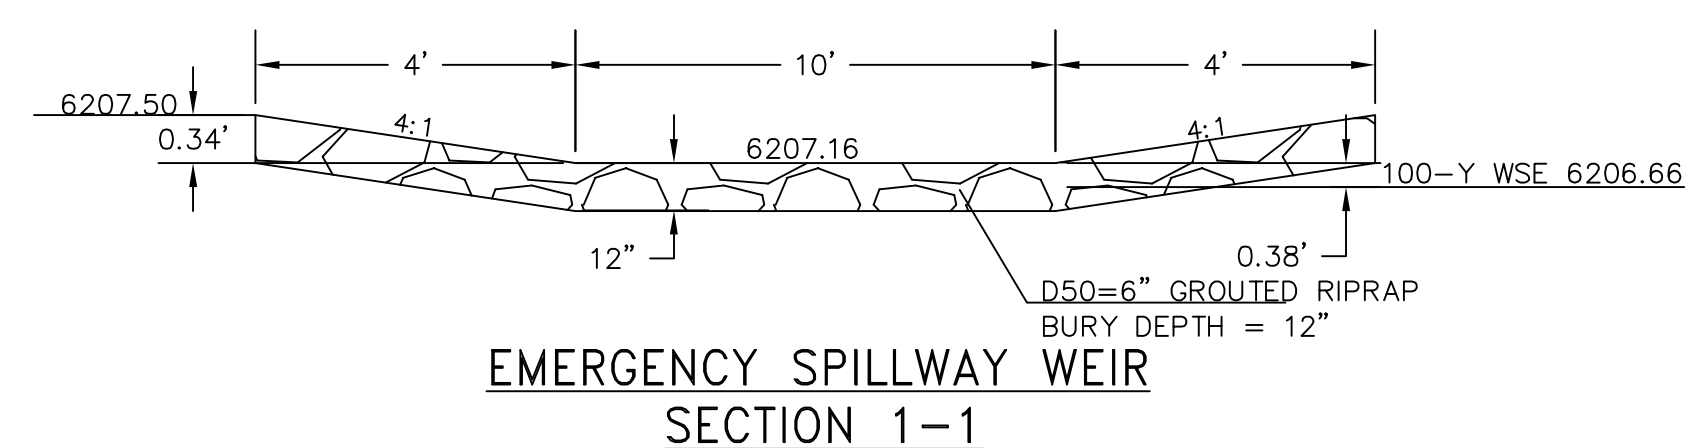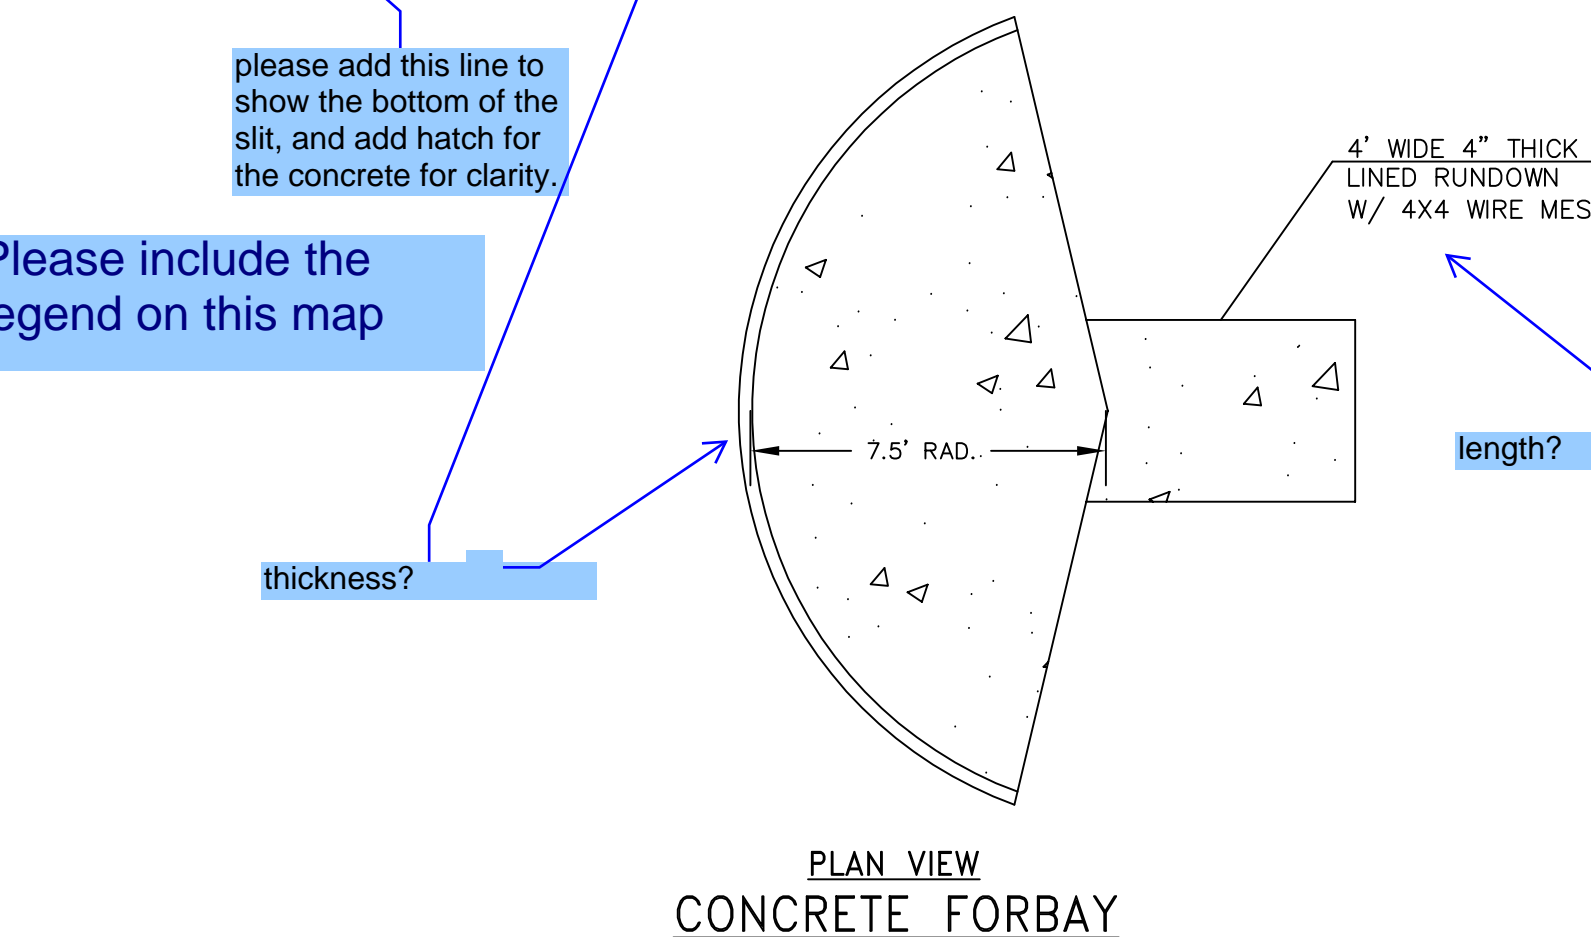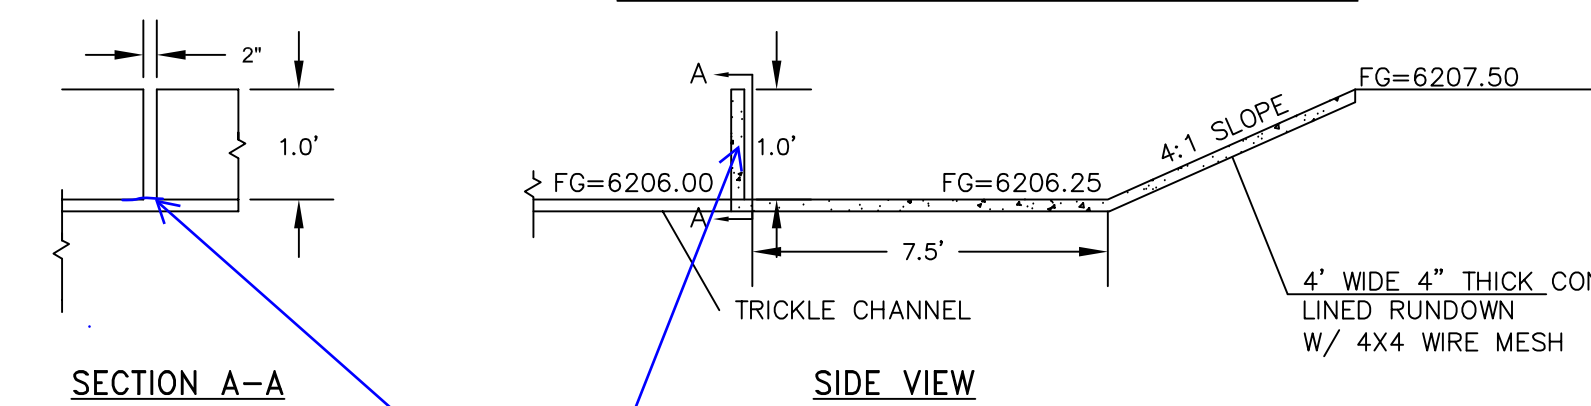

please show two design points for flow as it leaves the site, i do not believe that the flow from 1A and 1 are at the same location as it leaves the property line.

Please show cross section of the gravel road (here and on the GEC plan).

Please more clearly show the proposed grade lines.

The proposed gravel access road is part of the development and must be included as a drainage basin.

Please show the end of this pipe within your property, as well show FES, erosion protection, and how you intend to spread the flow to avoid damage to adjacent property.

Is this a typo and should be called out as the spillway? if so, please correct.

NO.	REVISIONS	DESCRIPTION	DATE

UNTIL SUCH TIME AS THESE DRAWINGS ARE APPROVED BY THE REVIEWING AGENCY, TERRA NOVA ENGINEERING, INC. APPROVES THEIR USE ONLY FOR THE PROJECT AND FOR WHICH THEY HAVE WRITTEN AUTHORIZATION.

PREPARED FOR:  
MVEA  
ATTN: DAVE WALDNER  
11140 E. WOODMEN RD  
PEYTON, CO 80831  
(719) 495-2283

Terra Nova Engineering, Inc.  
Professional Civil Engineer No. 11515

721 S. 2900 STREET  
COLORADO SPRINGS, CO 80904  
OFFICE: 719-635-6422  
FAX: 719-635-6426  
www.tnengine.com


MVEA YODER SUBSTATION	DEVELOPED DRAINAGE MAP
DESIGNED BY QNA	DRAWN BY QNA
CHECKED BY	
H-SCALE 1"=100'	V-SCALE NA
JOB NO. 1802.00	DATE ISSUED 2/17/18
SHEET NO. 1 OF 1	

# MVEA YODER SUBSTATION

## EL PASO COUNTY, CO

# EXISTING DRAINAGE MAP

## FEBRUARY 2018

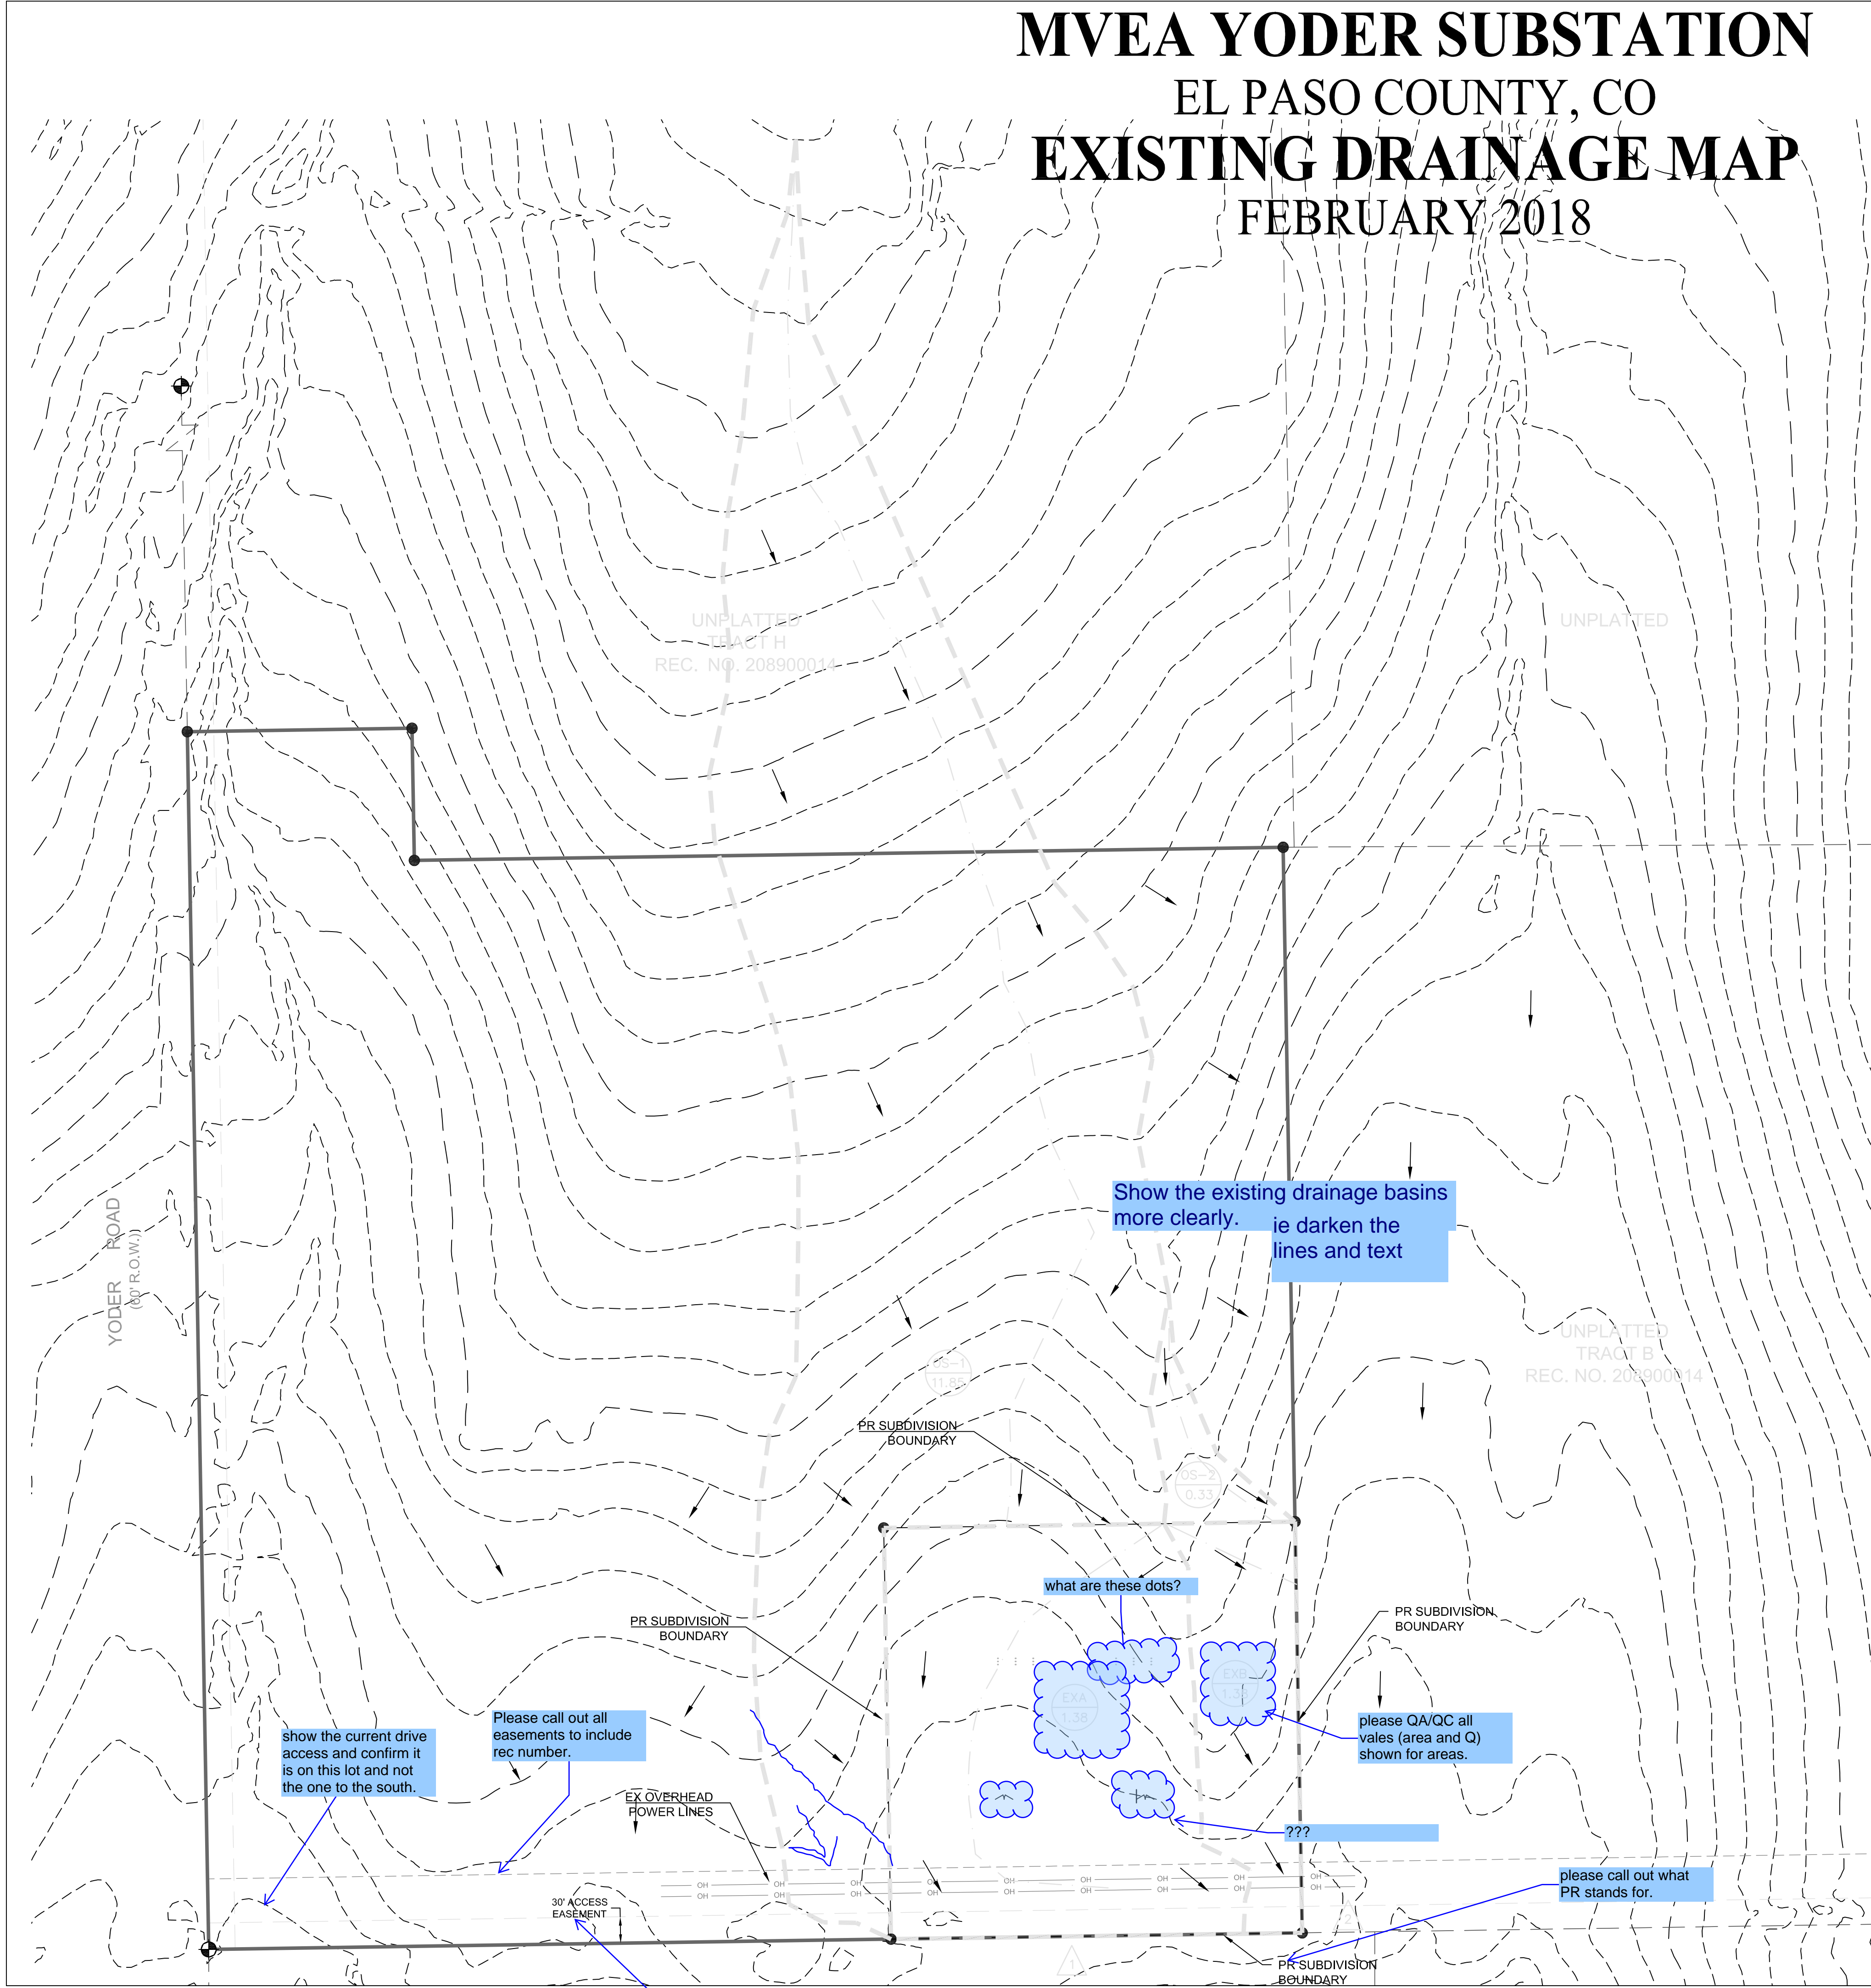

DESIGN POINT SUMMARY

DP	CONTRIBUTING BASINS	AREA AC.	Q5 CFS	Q100 CFS
1	OS-1 & EXA	15.69	3.5	23.0
2	OS-2 & EXB	1.49	0.5	3.4

PROPOSED CONDITIONS


BASIN	ACRES	Q5 CFS	Q100 CFS
OS-1	11.85	2.7	17.4
OS-2	0.33	0.1	0.7
A	1.38	1.2	3.8
A1	1.70	0.5	3.4
A2	0.75	0.4	1.8
B	1.17	0.4	2.6

- LEGEND**
- 10' EX CONTOUR      - - - - - 6810
  - 2' EX CONTOUR      - - - - - 6802
  - 10' PROP. CONTOUR      - - - - - 6810
  - 2' PROP. CONTOUR      - - - - - 6802
  - PROPOSED FLOW DIRECTION      →
  - BASIN BOUNDARY      - - - - -
  - TIME OF CONCENTRATION      - - - - -
  - BASIN ID      ○ A
  - ACREAGE      ○ 0.37
  - DESIGN POINT      △ 3

REVISIONS NO.	DESCRIPTION	DATE

UNTIL SUCH TIME AS THESE DRAWINGS ARE APPROVED BY THE REVIEWING AGENCIES, TERRA NOVA ENGINEERING, INC. APPROVES THEIR USE ONLY FOR THE PROJECT AND FOR THE PURPOSES SPECIFIED BY WRITTEN AUTHORIZATION.

PREPARED FOR:  
MVEA  
ATTN: DAVE WALDNER  
11140 E. WOODMEN RD  
PEYTON, CO 80831  
(719) 495-2283

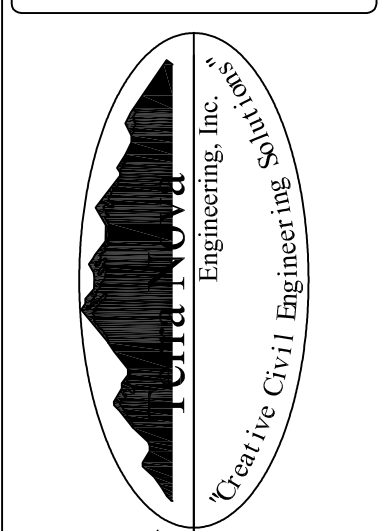

721 S. 2900 STREET  
COLORADO SPRINGS, CO 80904  
OFFICE: 719-635-6422  
FAX: 719-635-6426  
www.tnaseinc.com

MVEA YODER SUBSTATION  
EXISTING DRAINAGE MAP

DESIGNED BY QNA  
DRAWN BY QNA  
CHECKED BY  
H-SCALE 1"=100'  
V-SCALE NA  
JOB NO. 1802.00  
DATE ISSUED 2/17/18  
SHEET NO. 1 OF 1

show the current drive access and confirm it is on this lot and not the one to the south.

Please call out all easements to include rec number.

proposed or existing? please provide rec number.


Show the existing drainage basins more clearly. i.e. darken the lines and text

what are these dots?

please QA/QC all vales (area and Q) shown for areas.

please call out what PR stands for.

call out all adjacent property owners.

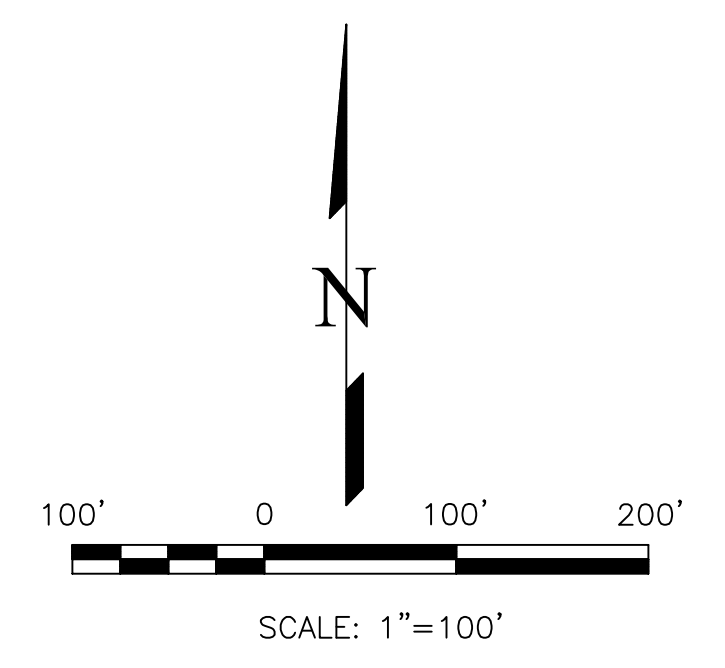

# Markup Summary

Locked (60)

Please provide file numbers: PPR-18-027 U-18-002

**Subject:** Engineer  
**Page Label:** 1  
**Lock:** Locked  
**Author:** dsdgrimm  
**Date:** 7/9/2018 10:57:00 AM  
**Color:** ■

Please provide file numbers: PPR-18-027 U-18-002

1

**Subject:** Arrow  
**Page Label:** 1  
**Lock:** Locked  
**Author:** dsdgrimm  
**Date:** 7/9/2018 10:57:01 AM  
**Color:** ■

YODER ELE EL PASO CC  
for clarity and consistency please make this name the same as the project. (ie, add MVEA)

**Subject:** Engineer  
**Page Label:** 1  
**Lock:** Locked  
**Author:** dsdnijkamp  
**Date:** 7/9/2018 10:57:02 AM  
**Color:** ■

for clarity and consistency please make this name the same as the project. (ie, add MVEA)

Please describe the four step process as outlined in the ECM appendix I.  
DRAINAGE REPORT FOR ELECTRIC SUBSTATION

**Subject:** Engineer  
**Page Label:** 4  
**Lock:** Locked  
**Author:** dsdnijkamp  
**Date:** 7/9/2018 10:57:09 AM  
**Color:** ■

Please describe the four step process as outlined in the ECM appendix I.

I. DRAINAGE REPORT FOR ELECTRIC SUBSTATION  
this FDR must address the access road (and its flow) as well.  
Report is to identify and analyze the proposed pond runoff quantities, size drainage structures for and present solutions to drainage impacts on-site and adjacent.

**Subject:** Engineer  
**Page Label:** 4  
**Lock:** Locked  
**Author:** dsdnijkamp  
**Date:** 7/9/2018 10:57:10 AM  
**Color:** ■

this FDR must address the access road (and its flow) as well.

n EXA (3.83 acres; Q  
ie. Drainage in this t

**Subject:** Engineer  
**Page Label:** 5  
**Lock:** Locked  
**Author:** dsdnijkamp  
**Date:** 7/9/2018 10:57:12 AM  
**Color:** ■

(11.85 acres; Q=2.7 cfs and Q10=17.4 cfs) out  
Drainage in this basin sheet flows from north to  
see ex drainage map for inconsistency.  
acres; Q=1.1 cfs and Q10=7.4 cfs) consist of um  
n this basin sheet flows from north to south. Th  
se=23.0 cfs) of Basin OS-1 and EXA sheet flow:

**Subject:** Engineer  
**Page Label:** 5  
**Lock:** Locked  
**Author:** dsdnijkamp  
**Date:** 7/9/2018 10:57:13 AM  
**Color:** ■

see ex drainage map for inconsistency.

EXB (1.17 acres, Q<sub>5</sub>=  
Drainage in this basi

**Subject:** Engineer  
**Page Label:** 5  
**Lock:** Locked  
**Author:** dsdnijkamp  
**Date:** 7/9/2018 10:57:20 AM  
**Color:** ■

asin EXB.  
ditto

**Subject:** Engineer  
**Page Label:** 5  
**Lock:** Locked  
**Author:** dsdnijkamp  
**Date:** 7/9/2018 10:57:21 AM  
**Color:** ■

ditto

Basin B is a 1.17 acre detention basin located on the east side of the site. The basin is designed to capture and treat the runoff from the 1.17 acre drainage area. The basin is designed to have a 100% storage capacity and a 100% treatment efficiency. The basin is designed to have a 100% storage capacity and a 100% treatment efficiency. The basin is designed to have a 100% storage capacity and a 100% treatment efficiency.

**Subject:** Engineer  
**Page Label:** 5  
**Lock:** Locked  
**Author:** dsdnijkamp  
**Date:** 7/9/2018 10:57:21 AM  
**Color:** ■

overtops what? are you missing some contours?

call out on plan  
is currently part of a 40 acre single family  
ative grass and woods, with some areas of  
orth south through the site and splits it.  
g design points 1 & 2, two existing onsite

**Subject:** Engineer  
**Page Label:** 5  
**Lock:** Locked  
**Author:** dsdnijkamp  
**Date:** 7/9/2018 10:57:22 AM  
**Color:** ■

call out on plan

Include Basin B  
will closely flow the historic drainage patt  
Detention Basin to capture and treat the n  
lysis the site has been broken down into  
xins A, A1 & A2, and the same two exi

**Subject:** Engineer  
**Page Label:** 6  
**Lock:** Locked  
**Author:** dsdgrimm  
**Date:** 7/9/2018 10:57:34 AM  
**Color:** ■

Include Basin B

Basin B is a 1.17 acre detention basin located on the east side of the site. The basin is designed to capture and treat the runoff from the 1.17 acre drainage area. The basin is designed to have a 100% storage capacity and a 100% treatment efficiency. The basin is designed to have a 100% storage capacity and a 100% treatment efficiency. The basin is designed to have a 100% storage capacity and a 100% treatment efficiency.

**Subject:** Engineer  
**Page Label:** 6  
**Lock:** Locked  
**Author:** dsdnijkamp  
**Date:** 7/9/2018 10:57:35 AM  
**Color:** ■

do you have a swale to get the water into he pond?  
or is the flow just sheet flow over all sides? if you  
are designing the flow to gently flow over all sides  
of the pond (and design to prevent rilling) you may  
delete the forebay. a forebay is for a point source  
inflow.

Basin B is a 1.17 acre detention basin located on the east side of the site. The basin is designed to capture and treat the runoff from the 1.17 acre drainage area. The basin is designed to have a 100% storage capacity and a 100% treatment efficiency. The basin is designed to have a 100% storage capacity and a 100% treatment efficiency. The basin is designed to have a 100% storage capacity and a 100% treatment efficiency.

**Subject:** Engineer  
**Page Label:** 6  
**Lock:** Locked  
**Author:** dsdnijkamp  
**Date:** 7/9/2018 10:57:36 AM  
**Color:** ■

please define

Basin B is a 1.17 acre detention basin located on the east side of the site. The basin is designed to capture and treat the runoff from the 1.17 acre drainage area. The basin is designed to have a 100% storage capacity and a 100% treatment efficiency. The basin is designed to have a 100% storage capacity and a 100% treatment efficiency. The basin is designed to have a 100% storage capacity and a 100% treatment efficiency.

**Subject:** Engineer  
**Page Label:** 7  
**Lock:** Locked  
**Author:** dsdnijkamp  
**Date:** 7/9/2018 10:57:37 AM  
**Color:** ■

please elaborate.



e=1.8 cfs) will consist undeveloped land with  
 f the proposed EDB. Drainage in this basin sheet  
 used flow of Basins OS-1, A, A1, & A2 at  
 .9 cfs  
 please state that this is  
 below historic.  
 OS-2 (0.33 acres, Q<sub>o</sub>=0.1 cfs and Q<sub>so</sub>=0.7 cfs)  
 : Drainage in this basin sheet flows from  
 s onto Basin EXB.

**Subject:** Engineer  
**Page Label:** 7  
**Lock:** Locked  
**Author:** dsdnijkamp  
**Date:** 7/9/2018 10:57:38 AM  
**Color:** ■

please state that this is below historic.

OPINION  
 include this in the  
 Financial Assurance  
 Estimate.  
 95 LF \$ 335 \$ 3,325  
 1 EA \$ 10,000 \$ 10,000  
 4.1 EA \$ 41,000 \$ 41,000

**Subject:** Engineer  
**Page Label:** 8  
**Lock:** Locked  
**Author:** dsdgrimm  
**Date:** 7/9/2018 10:57:38 AM  
**Color:** ■

Include this in the Financial Assurance Estimate.

s, as well as a Materials Staging Area (MSA).  
 ence (SF) will be placed around the SP and  
 d at the southern border of the site to keep run  
 Only one basin is  
 shown. Please clarify.  
 NCE  
 Detention Basins and the storm drain system  
 maintained by the owner. These should be checked  
 precipitation event and at least once every three

**Subject:** Engineer  
**Page Label:** 8  
**Lock:** Locked  
**Author:** dsdgrimm  
**Date:** 7/9/2018 10:57:39 AM  
**Color:** ■

Only one basin is shown. Please clarify.

ing Area (SSA) and a Dirt Stockpile (SP)  
 of the SP and Sediment Control Logs (SCL)  
 site to keep runoff in place.  
 none shown  
 rm drain systems are private and therefore  
 should be cleaned and checked after any  
 or every three months. The proposed erosion  
 standard by the property owner or owner's

**Subject:** Engineer  
**Page Label:** 8  
**Lock:** Locked  
**Author:** dsdnijkamp  
**Date:** 7/9/2018 10:57:40 AM  
**Color:** ■

none shown

ation Basins and the storm drain systems are private and therefore  
 ed by the owner. These should be cleaned and checked after  
 any event and at least once every three months. The proposed ones  
 will be required and maintained by the property owner or owner  
 representative.  
 an O&M plan is  
 required to be  
 submitted.  
 N COST OPINION  
 variable  
 I.E.  
 ..

**Subject:** Engineer  
**Page Label:** 8  
**Lock:** Locked  
**Author:** dsdnijkamp  
**Date:** 7/9/2018 10:57:41 AM  
**Color:** ■

an O&M plan is required to be submitted.

Private New Reimbursable  
 1. 12" HDPE 95 LF  
 2. EDDB 1 EA  
 3. Concrete Channel 40 LF  
 4. 2"x2" Dual Outlet 1 EA  
 proposed conditions  
 map shows RCP,  
 please clarify.

**Subject:** Engineer  
**Page Label:** 8  
**Lock:** Locked  
**Author:** dsdnijkamp  
**Date:** 7/9/2018 10:57:42 AM  
**Color:** ■

proposed conditions map shows RCP, please clarify.

please remove 'appears' and 'therefore'. It is  
 unstudied, but that is not the reason that it is a no  
 fee basin. Please just state that it has no  
 established fee.

**Subject:** Engineer  
**Page Label:** 9  
**Lock:** Locked  
**Author:** dsdnijkamp  
**Date:** 7/9/2018 10:57:43 AM  
**Color:** ■

please remove 'appears' and 'therefore'. It is unstudied, but that is not the reason that it is a no fee basin. Please just state that it has no established fee.

this number should be  
 less than 1.0


**Subject:** Engineer  
**Page Label:** 27  
**Lock:** Locked  
**Author:** dsdnijkamp  
**Date:** 7/9/2018 10:58:18 AM  
**Color:** ■

this number should be less than 1.0

Please include the legend on this map


**Subject:** Engineer  
**Page Label:** 29  
**Lock:** Locked  
**Author:** dsdgrimm  
**Date:** 7/9/2018 10:58:19 AM  
**Color:** ■

Please include the legend on this map

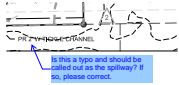


**Subject:** Engineer  
**Page Label:** 29  
**Lock:** Locked  
**Author:** dsdgrimm  
**Date:** 7/9/2018 10:58:20 AM  
**Color:** ■

Is this a typo and should be called out as the spillway? If so, please correct.

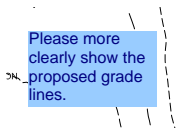


**Subject:** Engineer  
**Page Label:** 29  
**Lock:** Locked  
**Author:** dsdgrimm  
**Date:** 7/9/2018 10:58:21 AM  
**Color:** ■

Please more clearly show the proposed grade lines.

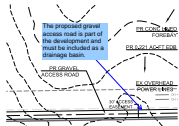


**Subject:** Engineer  
**Page Label:** 29  
**Lock:** Locked  
**Author:** dsdgrimm  
**Date:** 7/9/2018 10:58:22 AM  
**Color:** ■

The proposed gravel access road is part of the development and must be included as a drainage basin.

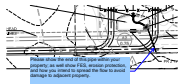

**Subject:** Engineer  
**Page Label:** 29  
**Lock:** Locked  
**Author:** dsdnijkamp  
**Date:** 7/9/2018 10:58:23 AM  
**Color:** ■

Please show the end of this pipe within your property; as well show FES, erosion protection, and how you intend to spread the flow to avoid damage to adjacent property.

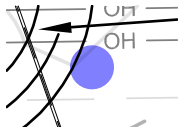


**Subject:** Engineer  
**Page Label:** 29  
**Lock:** Locked  
**Author:** dsdnijkamp  
**Date:** 7/9/2018 10:58:26 AM  
**Color:** ■

this would be a better location to discharge the flow.




**Subject:** Engineer  
**Page Label:** 29  
**Lock:** Locked  
**Author:** dsdnijkamp  
**Date:** 7/9/2018 10:58:27 AM  
**Color:** ■

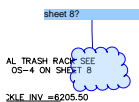


**Subject:** Group  
**Page Label:** 29  
**Lock:** Locked  
**Author:** dsdnijkamp  
**Date:** 7/9/2018 10:58:28 AM  
**Color:** ■

sheet 8?

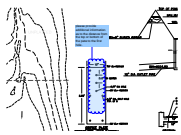

**Subject:** Group  
**Page Label:** 29  
**Lock:** Locked  
**Author:** dsdnijkamp  
**Date:** 7/9/2018 10:58:29 AM  
**Color:** ■

please provide additional information as to the distance from the top or bottom of the pate to the first hole.

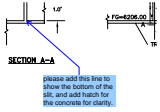

**Subject:** Engineer  
**Page Label:** 29  
**Lock:** Locked  
**Author:** dsdnijkamp  
**Date:** 7/9/2018 11:00:00 AM  
**Color:** ■

please add this line to show the bottom of the slit, and add hatch for the concrete for clarity.




**Subject:** Pen  
**Page Label:** 29  
**Lock:** Locked  
**Author:** dsdnijkamp  
**Date:** 7/9/2018 11:00:01 AM  
**Color:** ■

—




**Subject:** Pen  
**Page Label:** 29  
**Lock:** Locked  
**Author:** dsdnijkamp  
**Date:** 7/9/2018 11:00:02 AM  
**Color:** ■

.

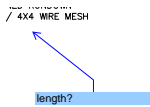


**Subject:** Engineer  
**Page Label:** 29  
**Lock:** Locked  
**Author:** dsdnijkamp  
**Date:** 7/9/2018 11:00:03 AM  
**Color:** ■

length?

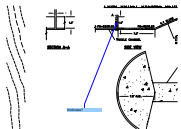


**Subject:** Engineer  
**Page Label:** 29  
**Lock:** Locked  
**Author:** dsdnijkamp  
**Date:** 7/9/2018 11:00:04 AM  
**Color:** ■

thickness?

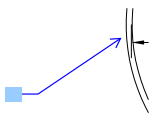

**Subject:** Engineer  
**Page Label:** 29  
**Lock:** Locked  
**Author:** dsdnijkamp  
**Date:** 7/9/2018 11:00:05 AM  
**Color:** ■

all comments here also pertain to the GEC plan, and GEC to the plan.

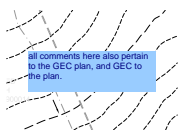


**Subject:** Engineer  
**Page Label:** 29  
**Lock:** Locked  
**Author:** dsdnijkamp  
**Date:** 7/9/2018 11:00:06 AM  
**Color:** ■




**Subject:** Engineer  
**Page Label:** 29  
**Lock:** Locked  
**Author:** dsdnijkamp  
**Date:** 7/9/2018 11:00:07 AM  
**Color:** ■

In general you should not design the EDB to this detail in the FDR.

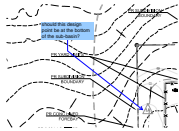

**Subject:** Engineer  
**Page Label:** 29  
**Lock:** Locked  
**Author:** dsdnijkamp  
**Date:** 7/9/2018 11:00:09 AM  
**Color:** ■

should this design point be at the bottom of the sub-basin?

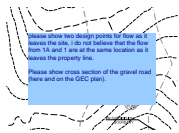

**Subject:** Engineer  
**Page Label:** 29  
**Lock:** Locked  
**Author:** dsdnijkamp  
**Date:** 7/9/2018 11:00:10 AM  
**Color:** ■


please show two design points for flow as it leaves the site, i do not believe that the flow from 1A and 1 are at the same location as it leaves the property line.

Please show cross section of the gravel road (here and on the GEC plan).




**Subject:** Engineer  
**Page Label:** 30  
**Lock:** Locked  
**Author:** dsdgrimm  
**Date:** 7/9/2018 11:00:14 AM  
**Color:** ■

Show the existing drainage basins more clearly.

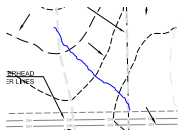


**Subject:** Pen  
**Page Label:** 30  
**Lock:** Locked  
**Author:** dsdnijkamp  
**Date:** 7/9/2018 11:00:15 AM  
**Color:** ■

.

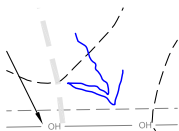

**Subject:** Pen  
**Page Label:** 30  
**Lock:** Locked  
**Author:** dsdnijkamp  
**Date:** 7/9/2018 11:00:16 AM  
**Color:** ■

a

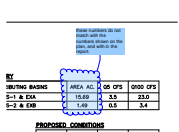


**Subject:** Group  
**Page Label:** 30  
**Lock:** Locked  
**Author:** dsdnijkamp  
**Date:** 7/9/2018 11:00:17 AM  
**Color:** ■

these numbers do not match with the numbers shown on the plan, and with in the report.




**Subject:** Group  
**Page Label:** 30  
**Lock:** Locked  
**Author:** dsdnijkamp  
**Date:** 7/9/2018 11:00:18 AM  
**Color:** ■


what are these dots?

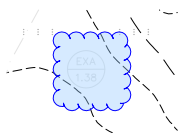


**Subject:** Engineer  
**Page Label:** 30  
**Lock:** Locked  
**Author:** dsdnijkamp  
**Date:** 7/9/2018 11:00:19 AM  
**Color:** ■

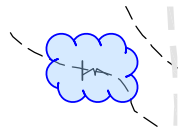


**Subject:** Engineer  
**Page Label:** 30  
**Lock:** Locked  
**Author:** dsdnijkamp  
**Date:** 7/9/2018 11:00:20 AM  
**Color:** ■

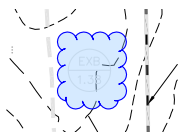

**Subject:** Engineer  
**Page Label:** 30  
**Lock:** Locked  
**Author:** dsdnijkamp  
**Date:** 7/9/2018 11:00:20 AM  
**Color:** ■

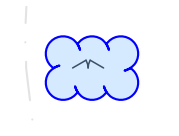

**Subject:** Engineer  
**Page Label:** 30  
**Lock:** Locked  
**Author:** dsdnijkamp  
**Date:** 7/9/2018 11:00:22 AM  
**Color:** ■

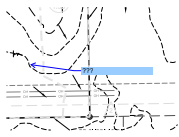


**Subject:** Engineer  
**Page Label:** 30  
**Lock:** Locked  
**Author:** dsdnijkamp  
**Date:** 7/9/2018 11:00:23 AM  
**Color:** ■

???




**Subject:** Engineer  
**Page Label:** 30  
**Lock:** Locked  
**Author:** dsdnijkamp  
**Date:** 7/9/2018 11:00:24 AM  
**Color:** ■

please QA/QC all vales (area and Q) shown for areas.

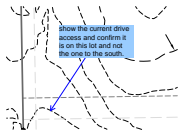


**Subject:** Engineer  
**Page Label:** 30  
**Lock:** Locked  
**Author:** dsdnijkamp  
**Date:** 7/9/2018 11:00:25 AM  
**Color:** ■

show the current drive access and confirm it is on this lot and not the one to the south.

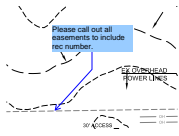


**Subject:** Engineer  
**Page Label:** 30  
**Lock:** Locked  
**Author:** dsdnijkamp  
**Date:** 7/9/2018 11:00:26 AM  
**Color:** ■

Please call out all easements to include rec number.

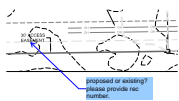


**Subject:** Engineer  
**Page Label:** 30  
**Lock:** Locked  
**Author:** dsdnijkamp  
**Date:** 7/9/2018 11:00:27 AM  
**Color:** ■

proposed or existing? please provide rec number.

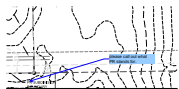


**Subject:** Engineer  
**Page Label:** 30  
**Lock:** Locked  
**Author:** dsdnijkamp  
**Date:** 7/9/2018 11:00:28 AM  
**Color:** ■

please call out what PR stands for.

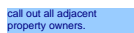


**Subject:** Engineer  
**Page Label:** 30  
**Lock:** Locked  
**Author:** dsdnijkamp  
**Date:** 7/9/2018 11:00:29 AM  
**Color:** ■

call out all adjacent property owners.

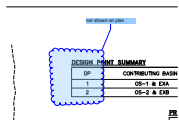

**Subject:** Group  
**Page Label:** 30  
**Lock:** Locked  
**Author:** dsdnijkamp  
**Date:** 7/9/2018 11:00:30 AM  
**Color:** ■

not shown on plan

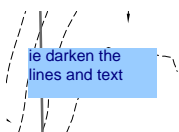

**Subject:** Engineer  
**Page Label:** 30  
**Lock:** Locked  
**Author:** dsdnijkamp  
**Date:** 7/9/2018 11:00:36 AM  
**Color:** ■

ie darken the lines and text