





SC-18-063

EL PASO COUNTY PLANNING & COMMUNITY DEVELOPMENT
SIGN APPLICATION

DATE:	<u>Vicinity Map</u> Tax Schedule # _____ Please show major intersections.	<u>Sign Plan</u> (Please indicate dimensions and sign copy)
<u>Business</u> Name: <u>STARBUCKS</u> Address: <u>209 GLENDALE GATE VIEW</u> Zone: <u>CS</u> Legal Description: <u>LOT 2 ACADEMY GATEWAY SUB FIL NO 1</u>		<p><u>NEW SIGN ON WEST ELEVATION</u></p>
<u>Type of Sign</u> Illuminated: <input checked="" type="checkbox"/> Non-Illuminated: _____ Valuation: <u>\$2,600</u> Storefront Length &/or Width: <u>72 x 36'</u> Proposed Sign Sq. Ft. <u>27.49</u> Existing Sign Sq. Ft. <u>111.96</u> Total Sign Sq. Ft. <u>139.45</u>	<u>Elevation Drawing</u> Indicate storefront length & placement of sign.	<div data-bbox="1133 1213 1448 1339" style="border: 1px solid black; padding: 5px;"> <p>Approved By: <u>Gabe Sevigny</u> Date: <u>11/26/2018</u> El Paso County Planning & Community Development</p>  </div>
<u>Contractor Information</u> Name: <u>APEX SIGNS & GRAPHICS</u> Address: <u>505 N. LINK LN #2 FT. COLLINS, CO 80524</u> Phone: <u>970-980-6106</u> Type of License: <u>B-D-5A (SIGN)</u> Contractor ID# <u>21735</u>	<u>For Planning & Community Development Use Only</u> Approved Date: _____ Resubmittal? Yes _____ No _____ Denied _____ Comments: _____	
Fee of \$262.00 must accompany this Application. Additional signs at time _____		

CR zoning district allows attached signage of 1.5 sqft of sign per linear foot of wall frontage or 300 sqft, whichever is less

ELEVATION

- A** SIREN WALL SIGN TO REMAIN
- B** 22" CHANNEL LETTERS TO REMAIN
- C** 48" DT WALL SIGN TO REMAIN
- D** 71" SIREN WALL SIGN

QID 18-43137

JOB NAME

Starbucks #51410

LOCATION

209 Gleneagle Gate View
 Colorado Springs, CO 80921

CUSTOMER CONTACT

SALESMAN / PM

Christie Pruitt

DESIGNER

Greg Sloan

DWG. DATE

8-22-18

REV. DATE / REVISION

SCALE

As Noted


FILE

2018/Starbucks/Colorado
 Springs CO/18-43137

DESIGN SPECIFICATIONS ACCEPTED BY:

EST:	CLIENT:
SLS/PM:	LANDLORD:

THE INTENT OF THIS DRAWING IS TO SHOW A CONCEPTUAL REPRESENTATION OF THE PROPOSED SIGNAGE. DUE TO VARIATIONS IN PRINTING DEVICES AND SUBSTRATES, THE FINISHED PRODUCT MAY DIFFER SLIGHTLY FROM DRAWING.

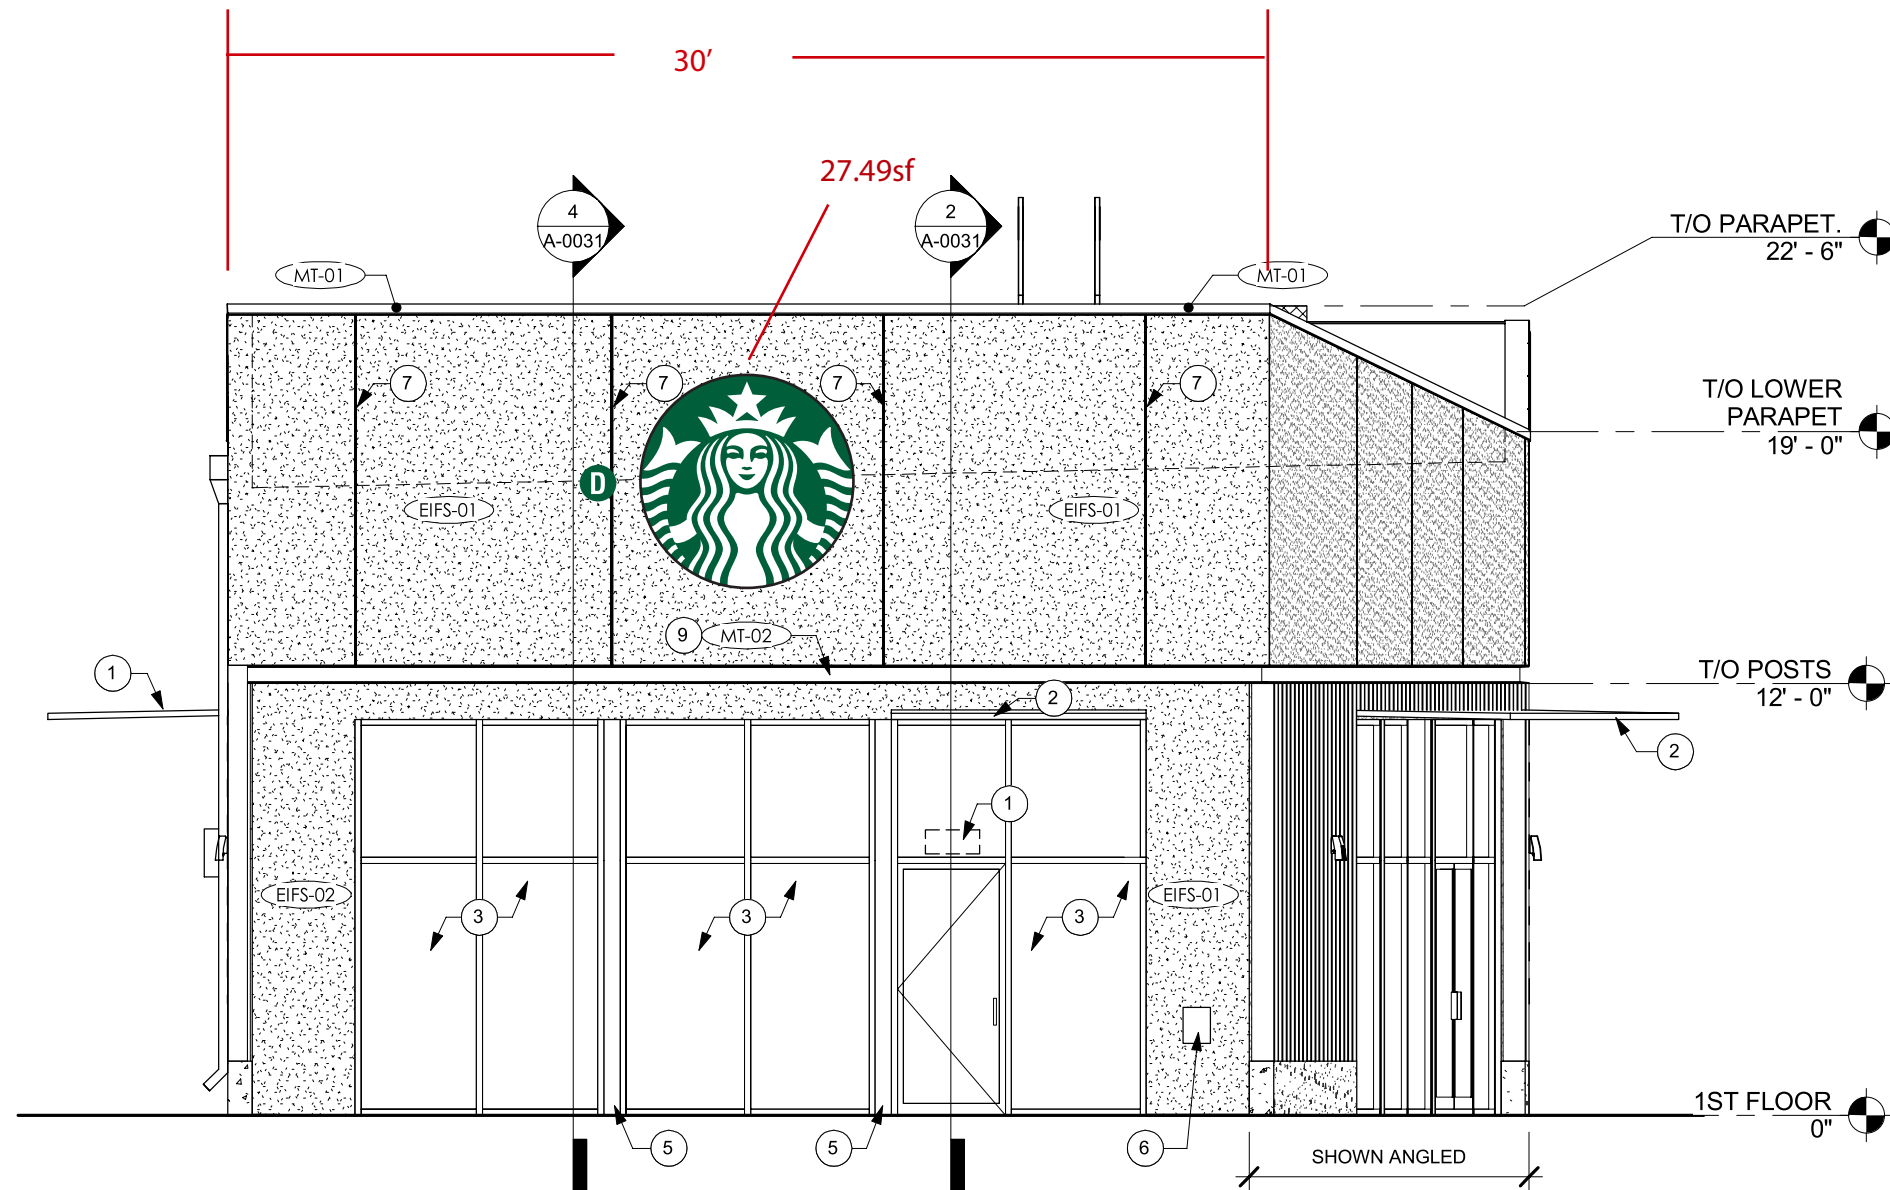

ELEVATION @ ENTRY WEST ELEVATION

Scale: 3/16" = 1'

COLOR LEGEND		
	PMS/PAIN	VINYL
	PMS 3425 C	3M 3630-76
	RAL 7021M	3M 3630-22
	PMS WHITE	3M 3630-20/ 7725-10 TRANSLUCENT OPAQUE
	PMS 369 C	NA
	REFL. WHITE	3M 680-10