

CHERRY CREEK CROSSING, FILING NO. 1 LOT 111 OVERLOT GRADING & EROSION CONTROL PLAN EL PASO COUNTY, COLORADO

GENERAL NOTES

- ALL NEW CONSTRUCTION TO CONFORM TO THE SPECIFICATIONS OF THE EL PASO COUNTY DEPARTMENT OF PUBLIC SERVICES. ANY ASPHALT REMOVED IS TO BE REPLACED TO MEET THE SPECIFICATIONS OF THE EL PASO COUNTY DEPARTMENT OF PUBLIC SERVICES.
- A PRE-CONSTRUCTION MEETING SHALL BE HELD WITH THE EL PASO COUNTY DEPARTMENT OF DEVELOPMENT SERVICES PRIOR TO ANY CONSTRUCTION.
- APPROVED PLANS, EL PASO COUNTY ENGINEERING CRITERIA MANUAL, ETC. IS REQUIRED TO BE ON-SITE AT ALL TIMES.
- ALL NECESSARY PERMITS, SUCH AS WORKING IN THE RIGHT-OF-WAY, SWMP, FUGITIVE DUST, ESQCP, ACCESS, C.O.E. 404, ETC. SHALL BE OBTAINED PRIOR TO CONSTRUCTION.
- PROFILE DESIGN LINES AND HORIZONTAL STATIONING ARE BASED ON CENTERLINE, AS SHOWN, UNLESS OTHERWISE NOTED.
- FOR CENTERLINE DESIGN, CURB AND GUTTER, ROAD SIDE DITCH LOCATIONS AND SIDEWALK SEE INDIVIDUAL PLAN AND PROFILE SHEETS. PAVEMENT DESIGN TO BE BASED ON RESISTANCE VALUE 'R' DERIVED FROM HVEEM TESTS AND ARE TO BE APPROVED BY THE EL PASO COUNTY DEPARTMENT OF DEVELOPMENT SERVICES PRIOR TO WORK ABOVE SUBGRADE.
- ALL VERTICAL DESIGN AND TOP OF CURB ARE BASED ON THE DESIGN POINT AS SHOWN IN THE TYPICAL CROSS SECTION.
- AT INTERSECTIONS, ALL RADII TO EDGE OF ASPHALT SHALL BE 20-FOOT UNLESS OTHERWISE NOTED.
- THE LOCATIONS OF THE EXISTING UTILITIES HAVE BEEN SHOWN ACCORDING TO THE BEST AVAILABLE INFORMATION. THE CONTRACTOR IS RESPONSIBLE FOR FIELD LOCATION AND VERIFICATION OF EXISTING UTILITIES PRIOR TO BEGINNING WORK. IF IT APPEARS THAT THERE COULD BE A CONFLICT WITH ANY UTILITIES, WHETHER INDICATED ON THE PLANS OR NOT, THE CONTRACTOR IS TO NOTIFY THE ENGINEER AND OWNER IMMEDIATELY. THE CONTRACTOR IS RESPONSIBLE FOR THE PROTECTION AND REPAIR (IF NECESSARY) OF ALL UTILITIES.
- WHERE APPROPRIATE, NEATLY SAW CUT ALL EXISTING CONCRETE AND ASPHALT. REPAIR/REPLACE ALL DISTURBED EXISTING ITEMS WITH LIKE MATERIALS AND THICKNESSES. MINIMUM ASPHALT THICKNESS SHALL BE 4-INCHES.
- ALL DISTURBED AREAS SHALL BE REVEGETATED WITH NATIVE GRASSES WITHIN 21 DAYS OF EXCAVATION PER EROSION CONTROL PLAN.
- THE PREPARED EROSION/SEDIMENT CONTROL PLAN IS TO BE CONSIDERED A PART OF THESE PLANS AND ITS REQUIREMENTS ADHERED TO DURING THE CONSTRUCTION OF THIS PROJECT.
- ALL STORM AND SANITARY SEWER PIPE LENGTHS AND SLOPES ARE FIGURED FROM CENTER OF MANHOLE OR BEND. CULVERT PIPE LENGTHS ARE DETERMINED FROM THE END OF THE FLARED END SECTIONS. PIPE LENGTHS ARE GIVEN AS A HORIZONTAL LENGTH.
- ALL STORM SEWER BEDDING TO BE PER CDOT STANDARDS.
- ALL STORM SEWER PIPE CLASS AND TYPE IS CALLED OUT ON THE PLAN AND PROFILE SHEETS.
- CONCRETE PIPE JOINT FASTENERS ARE REQUIRED ON THE FIRST TWO PIPE JOINTS FROM THE DOWNSTREAM FLARED END SECTION OF A DRAINAGE PIPE.
- ALL WYES AND BENDS USED IN CONSTRUCTION OF STORM SEWER FACILITIES SHALL BE FACTORY FABRICATED, UNLESS APPROVED BY THE EL PASO COUNTY DEPARTMENT OF DEVELOPMENT SERVICES.
- CONSTRUCTION AND MATERIALS USED IN ALL STORM AND SANITARY SEWER MANHOLES SHALL BE PER SPECIFICATIONS. STORM SEWER RADIAL DEFLECTIONS TO BE GROUDED OR INSTALLED PER MANUFACTURERS RECOMMENDATIONS.
- STORM SEWER MANHOLE SIZES AS FOLLOWS UNLESS OTHERWISE SHOWN:
 - 18" THRU 36" USE 48" I.D. MANHOLE
 - 42" THRU 48" USE 60" I.D. MANHOLE
 - 54" THRU 60" USE 72" I.D. MANHOLE
 NOTE: MANHOLE SIZES TABULATED HERE SHALL BE INCREASED, IF NECESSARY, TO ACCOMMODATE INCOMING LATERALS.
- DESIGN SPEED HODGEN ROAD - 40MPH.
- ALL EARTHWORK, MATERIALS AND INSTALLATION ASSOCIATED WITH THE EXCAVATION, EMBANKMENT AND ASPHALT PAVING TO BE CARRIED OUT IN THIS PROJECT ARE TO BE COMPLETED IN CONFORMANCE WITH THE EL PASO COUNTY ECM AND THE PIKES PEAK ASPHALT PAVING SPECIFICATIONS.


BENCHMARK: BRASS CAP IN CONCRETE NEAR THE SE COR LOT 111 - NGS MONUMENT *48B RESET 1984* ELEV. 7566.57

BASIS OF BEARING: THE BEARINGS & DISTANCES SHOWN ON FILING 1, CHERRY CREEK CROSSING

STANDARD CONSTRUCTION NOTES

- ALL DRAINAGE AND ROADWAY CONSTRUCTION SHALL MEET THE STANDARDS AND SPECIFICATIONS OF THE EL PASO COUNTY DRAINAGE CRITERIA MANUAL, VOLUMES 1 AND 2, AND THE EL PASO COUNTY ENGINEERING CRITERIA MANUAL.
- CONTRACTOR SHALL BE RESPONSIBLE FOR THE NOTIFICATION AND FIELD NOTIFICATION OF ALL EXISTING UTILITIES, WHETHER SHOWN ON THE PLANS OR NOT, BEFORE BEGINNING CONSTRUCTION. LOCATION OF EXISTING UTILITIES SHALL BE VERIFIED BY THE CONTRACTOR PRIOR TO CONSTRUCTION. CALL 811 TO CONTACT THE UTILITY NOTIFICATION CENTER OF COLORADO (UNCC).
- CONTRACTOR SHALL KEEP A COPY OF THESE APPROVED PLANS, THE GRADING AND EROSION CONTROL PLAN, THE STORMWATER MANAGEMENT PLAN (SWMP), THE SOILS AND GEOTECHNICAL REPORT, AND THE APPROPRIATE DESIGN AND CONSTRUCTION STANDARDS AND SPECIFICATIONS AT THE JOB SITE AT ALL TIMES, INCLUDING THE FOLLOWING:
 - EL PASO COUNTY ENGINEERING CRITERIA MANUAL (ECM)
 - COLORADO DEPARTMENT OF TRANSPORTATION (CDOT) STANDARD SPECIFICATIONS FOR ROAD AND BRIDGE CONSTRUCTION
 - CDOT M & S STANDARDS
- NOTWITHSTANDING ANYTHING DEPICTED IN THESE PLANS IN WORDS OR GRAPHIC REPRESENTATION, ALL DESIGN AND CONSTRUCTION RELATED TO ROADS, STORM DRAINAGE AND EROSION CONTROL SHALL CONFORM TO THE STANDARDS AND REQUIREMENTS OF THE MOST RECENT VERSION OF THE RELEVANT ADOPTED EL PASO COUNTY STANDARDS, INCLUDING THE LAND DEVELOPMENT CODE, THE ENGINEERING CRITERIA MANUAL, THE DRAINAGE CRITERIA MANUAL, AND THE DRAINAGE CRITERIA MANUAL VOLUME 2. ANY DEVIATIONS FROM REGULATIONS AND STANDARDS MUST BE REQUESTED, AND APPROVED, IN WRITING. ANY MODIFICATIONS NECESSARY TO MEET CRITERIA AFTER-THE-FACT WILL BE ENTIRELY THE DEVELOPER'S RESPONSIBILITY TO RECTIFY.
- IT IS THE DESIGN ENGINEER'S RESPONSIBILITY TO ACCURATELY SHOW EXISTING CONDITIONS, BOTH ONSITE AND OFFSITE, ON THE CONSTRUCTION PLANS. ANY MODIFICATIONS NECESSARY DUE TO CONFLICTS, OMISSIONS, OR CHANGED CONDITIONS WILL BE ENTIRELY THE DEVELOPER'S RESPONSIBILITY TO RECTIFY.
- CONTRACTOR SHALL SCHEDULE A PRE-CONSTRUCTION MEETING WITH EL PASO COUNTY PUBLIC SERVICES DEPARTMENT - INSPECTIONS, PRIOR TO STARTING CONSTRUCTION.
- IT IS THE CONTRACTOR'S RESPONSIBILITY TO UNDERSTAND THE REQUIREMENTS OF ALL JURISDICTIONAL AGENCIES AND TO OBTAIN ALL REQUIRED PERMITS, INCLUDING BUT NOT LIMITED TO EL PASO COUNTY EROSION AND STORMWATER QUALITY CONTROL PERMIT (ESQCP), REGIONAL BUILDING FLOODPLAIN DEVELOPMENT PERMIT, U.S. ARMY CORPS OF ENGINEERS-ISSUED 401 AND/OR 404 PERMITS, AND COUNTY AND STATE FUGITIVE DUST PERMITS.
- CONTRACTOR SHALL NOT DEVIATE FROM THE PLANS WITHOUT FIRST OBTAINING WRITTEN APPROVAL FROM THE DESIGN ENGINEER AND DSD. CONTRACTOR SHALL NOTIFY THE DESIGN ENGINEER OR THE AUTHORITY HAVING JURISDICTION IMMEDIATELY UPON DISCOVERY OF ANY ERRORS OR INCONSISTENCIES.
- ALL STORM DRAIN PIPE SHALL BE CLASS III RCP UNLESS OTHERWISE NOTED AND APPROVED BY DSD.
- CONTRACTOR SHALL COORDINATE GEOTECHNICAL TESTING PER ECM STANDARDS. PAVEMENT DESIGN SHALL BE APPROVED BY EL PASO COUNTY DSD PRIOR TO PLACEMENT OF CURB AND GUTTER AND PAVEMENT.
- ALL CONSTRUCTION TRAFFIC MUST ENTER/EXIT THE SITE AT APPROVED CONSTRUCTION ACCESS POINTS.
- SIGHT VISIBILITY TRIANGLES AS IDENTIFIED IN THE PLANS SHALL BE PROVIDED AT ALL INTERSECTIONS. OBSTRUCTIONS GREATER THAN 18 INCHES ABOVE FLOWLINE ARE NOT ALLOWED WITHIN SIGHT TRIANGLES.
- SIGNING AND STRIPING SHALL COMPLY WITH EL PASO COUNTY DOT AND MUTCD CRITERIA. [IF APPLICABLE, ADDITIONAL SIGNING AND STRIPING NOTES WILL BE PROVIDED.]
- CONTRACTOR SHALL OBTAIN ANY PERMITS REQUIRED BY EL PASO COUNTY PUBLIC SERVICES DEPARTMENT, INCLUDING WORK WITHIN THE RIGHT-OF-WAY AND SPECIAL TRANSPORT PERMITS.

THE LIMITS OF CONSTRUCTION SHALL REMAIN WITHIN THE PROPERTY LINE UNLESS OTHERWISE NOTED. THE OWNER/DEVELOPER SHALL OBTAIN WRITTEN PERMISSION AND EASEMENTS, WHERE REQUIRED, FROM ADJOINING PROPERTY OWNER(S) PRIOR TO ANY OFF-SITE DISTURBANCE, GRADING, OR CONSTRUCTION.

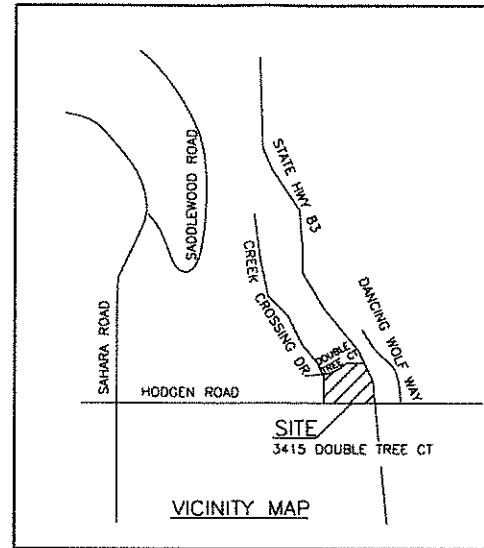

Add as a 3rd paragraph:
"In accordance with ECM Section 1.12, these construction documents will be valid for construction for a period of 2 years from the date signed by the El Paso County Engineer. If construction has not started within those 2 years, the plans will need to be resubmitted for approval, including payment of review fees at the Planning and Community Development Directors discretion."

OWNER'S STATEMENT
THE OWNER WILL COMPLY WITH THE REQUIREMENTS OF THE GRADING AND EROSION CONTROL PLAN.

BY: _____ DATE _____
TITLE: _____
ADDRESS: COLORADO SPRINGS 382 LTD. PARTNERSHIP
6070 N. CAMINO ALMONTE
TUCSON, AZ 85719-1703

ENGINEER'S STATEMENT
THIS GRADING AND EROSION CONTROL PLAN WAS PREPARED UNDER MY DIRECTION AND SUPERVISION AND IS CORRECT TO THE BEST OF MY KNOWLEDGE AND BELIEF. SAID PLAN HAS BEEN PREPARED ACCORDING TO THE CRITERIA ESTABLISHED BY THE COUNTY FOR GRADING AND EROSION CONTROL PLANS. I ACCEPT RESPONSIBILITY FOR ANY LIABILITY CAUSED BY ANY NEGLIGENCE, ACTS, ERRORS OR OMISSIONS ON MY PART IN PREPARING THIS PLAN.

RICHARD N. WRAY P.E. 19310 DATE _____
FOR AND ON BEHALF OF KIOWA ENGINEERING CORPORATION

EL PASO COUNTY
COUNTY PLAN REVIEW IS PROVIDED ONLY FOR GENERAL CONFORMANCE WITH COUNTY DESIGN CRITERIA. THE COUNTY IS NOT RESPONSIBLE FOR THE ACCURACY AND ADEQUACY OF THE DESIGN, DIMENSIONS, AND/OR ELEVATIONS WHICH SHALL BE CONFIRMED AT THE JOB SITE. THE COUNTY THROUGH THE APPROVAL OF THIS DOCUMENT ASSUMES NO RESPONSIBILITY FOR COMPLETENESS AND/OR ACCURACY OF THIS DOCUMENT.

FILED IN ACCORDANCE WITH THE REQUIREMENTS OF THE EL PASO COUNTY LAND DEVELOPMENT CODE, DRAINAGE CRITERIA AND ENGINEERING CRITERIA MANUAL, AS AMENDED.

JENNIFER IRVINE P.E. DATE _____
COUNTY ENGINEER/ECM ADMINISTRATOR

Add "PCD Project No.
CDR-17-003"

ABBREVIATIONS

ASST = ASSEMBLY	WH = MANHOLE
BNDY = BOUNDARY	MIN = MINIMUM
B.O.P. = BOTTOM OF PIPE	NTS = NOT TO SCALE
C = CENTERLINE	O.D. = OUTSIDE DIAMETER
CL = CLASS	PC = POINT OF HORIZONTAL CURVATURE
CRA = CONCRETE REVERSE ANCHOR	PCHC = POINT OF CURVATURE ON HORIZ. CURVE
CTRB = CONCRETE THRUST BLOCK	PP = PROPOSED
CR = POINT OF CURB RETURN	PT = POINT OF HORIZONTAL TANGENCY
DIP = DUCTILE IRON PIPE	PTHC = POINT OF TANGENCY ON HORIZ. CURVE
EL = ELEVATION	PVC = POLY VINYL CHLORIDE PIPE
ESMT = EASEMENT	PVC = POINT OF VERTICAL CURVATURE
EX = EXISTING	PIA = POINT OF VERTICAL INTERSECTION
FC = FACE OF CURB	PVI = POINT OF VERTICAL TANGENCY
FES = FLARED END SECTION	RCCB = REINFORCED CONCRETE BOX
FLG = FLANGE	RCP = REINFORCED CONCRETE PIPE
FL = FLOWLINE	ROW = RIGHT OF WAY
GB = GRADE BREAK	RT = RIGHT
HP = HIGH POINT	SMT = SHEET
HORIZ. = HORIZONTAL	SS = SANITARY SEWER
HYD = HYDRANT	STA. = STATION
I.D. = INSIDE DIAMETER	STD. = STANDARD
LT = LEFT	T.O.P. = TOP OF PIPE
LF = LINEAR FEET	TYP. = TYPICAL
LP = LOW POINT	VC = VERTICAL CURVE
MAX. = MAXIMUM	VERT. = VERTICAL

PREPARED BY:

Kiowa
Engineering Corporation

1604 South 21st Street
Colorado Springs, Colorado 80904
(719) 530-7342

DEVELOPER:

NATHAN MILLER
COLORADO SPRINGS 382 LTD. PARTNERSHIP
6070 CAMINO ALMONTE
TUCSON, AZ 85718

INDEX OF SHEETS


- COVER SHEET
- OVERLOT GRADING & EROSION CONTROL PLAN
- EROSION CONTROL DETAILS
- EROSION CONTROL DETAILS
- EROSION CONTROL DETAILS
- CULVERT EXTENSION & DETAILS

*A.G.A.I.P.W.A. STANDARD UTILITY MARKING COLOR CODE

NATURAL GAS	YELLOW
ELECTRIC	RED
WATER	BLUE
WASTEWATER	GREEN

CALL BEFORE YOU DIG...
OR HOURS BEFORE YOU DIG, CALL UTILITY LOCATING AND MARKING SERVICE FOR GAS, ELECTRIC, WATER AND WASTEWATER
1-800-922-1987

Project No.:	14028
Date:	JULY 25, 2017
Design:	RNW
Drawn:	EAK
Check:	RNW
Revisions:	

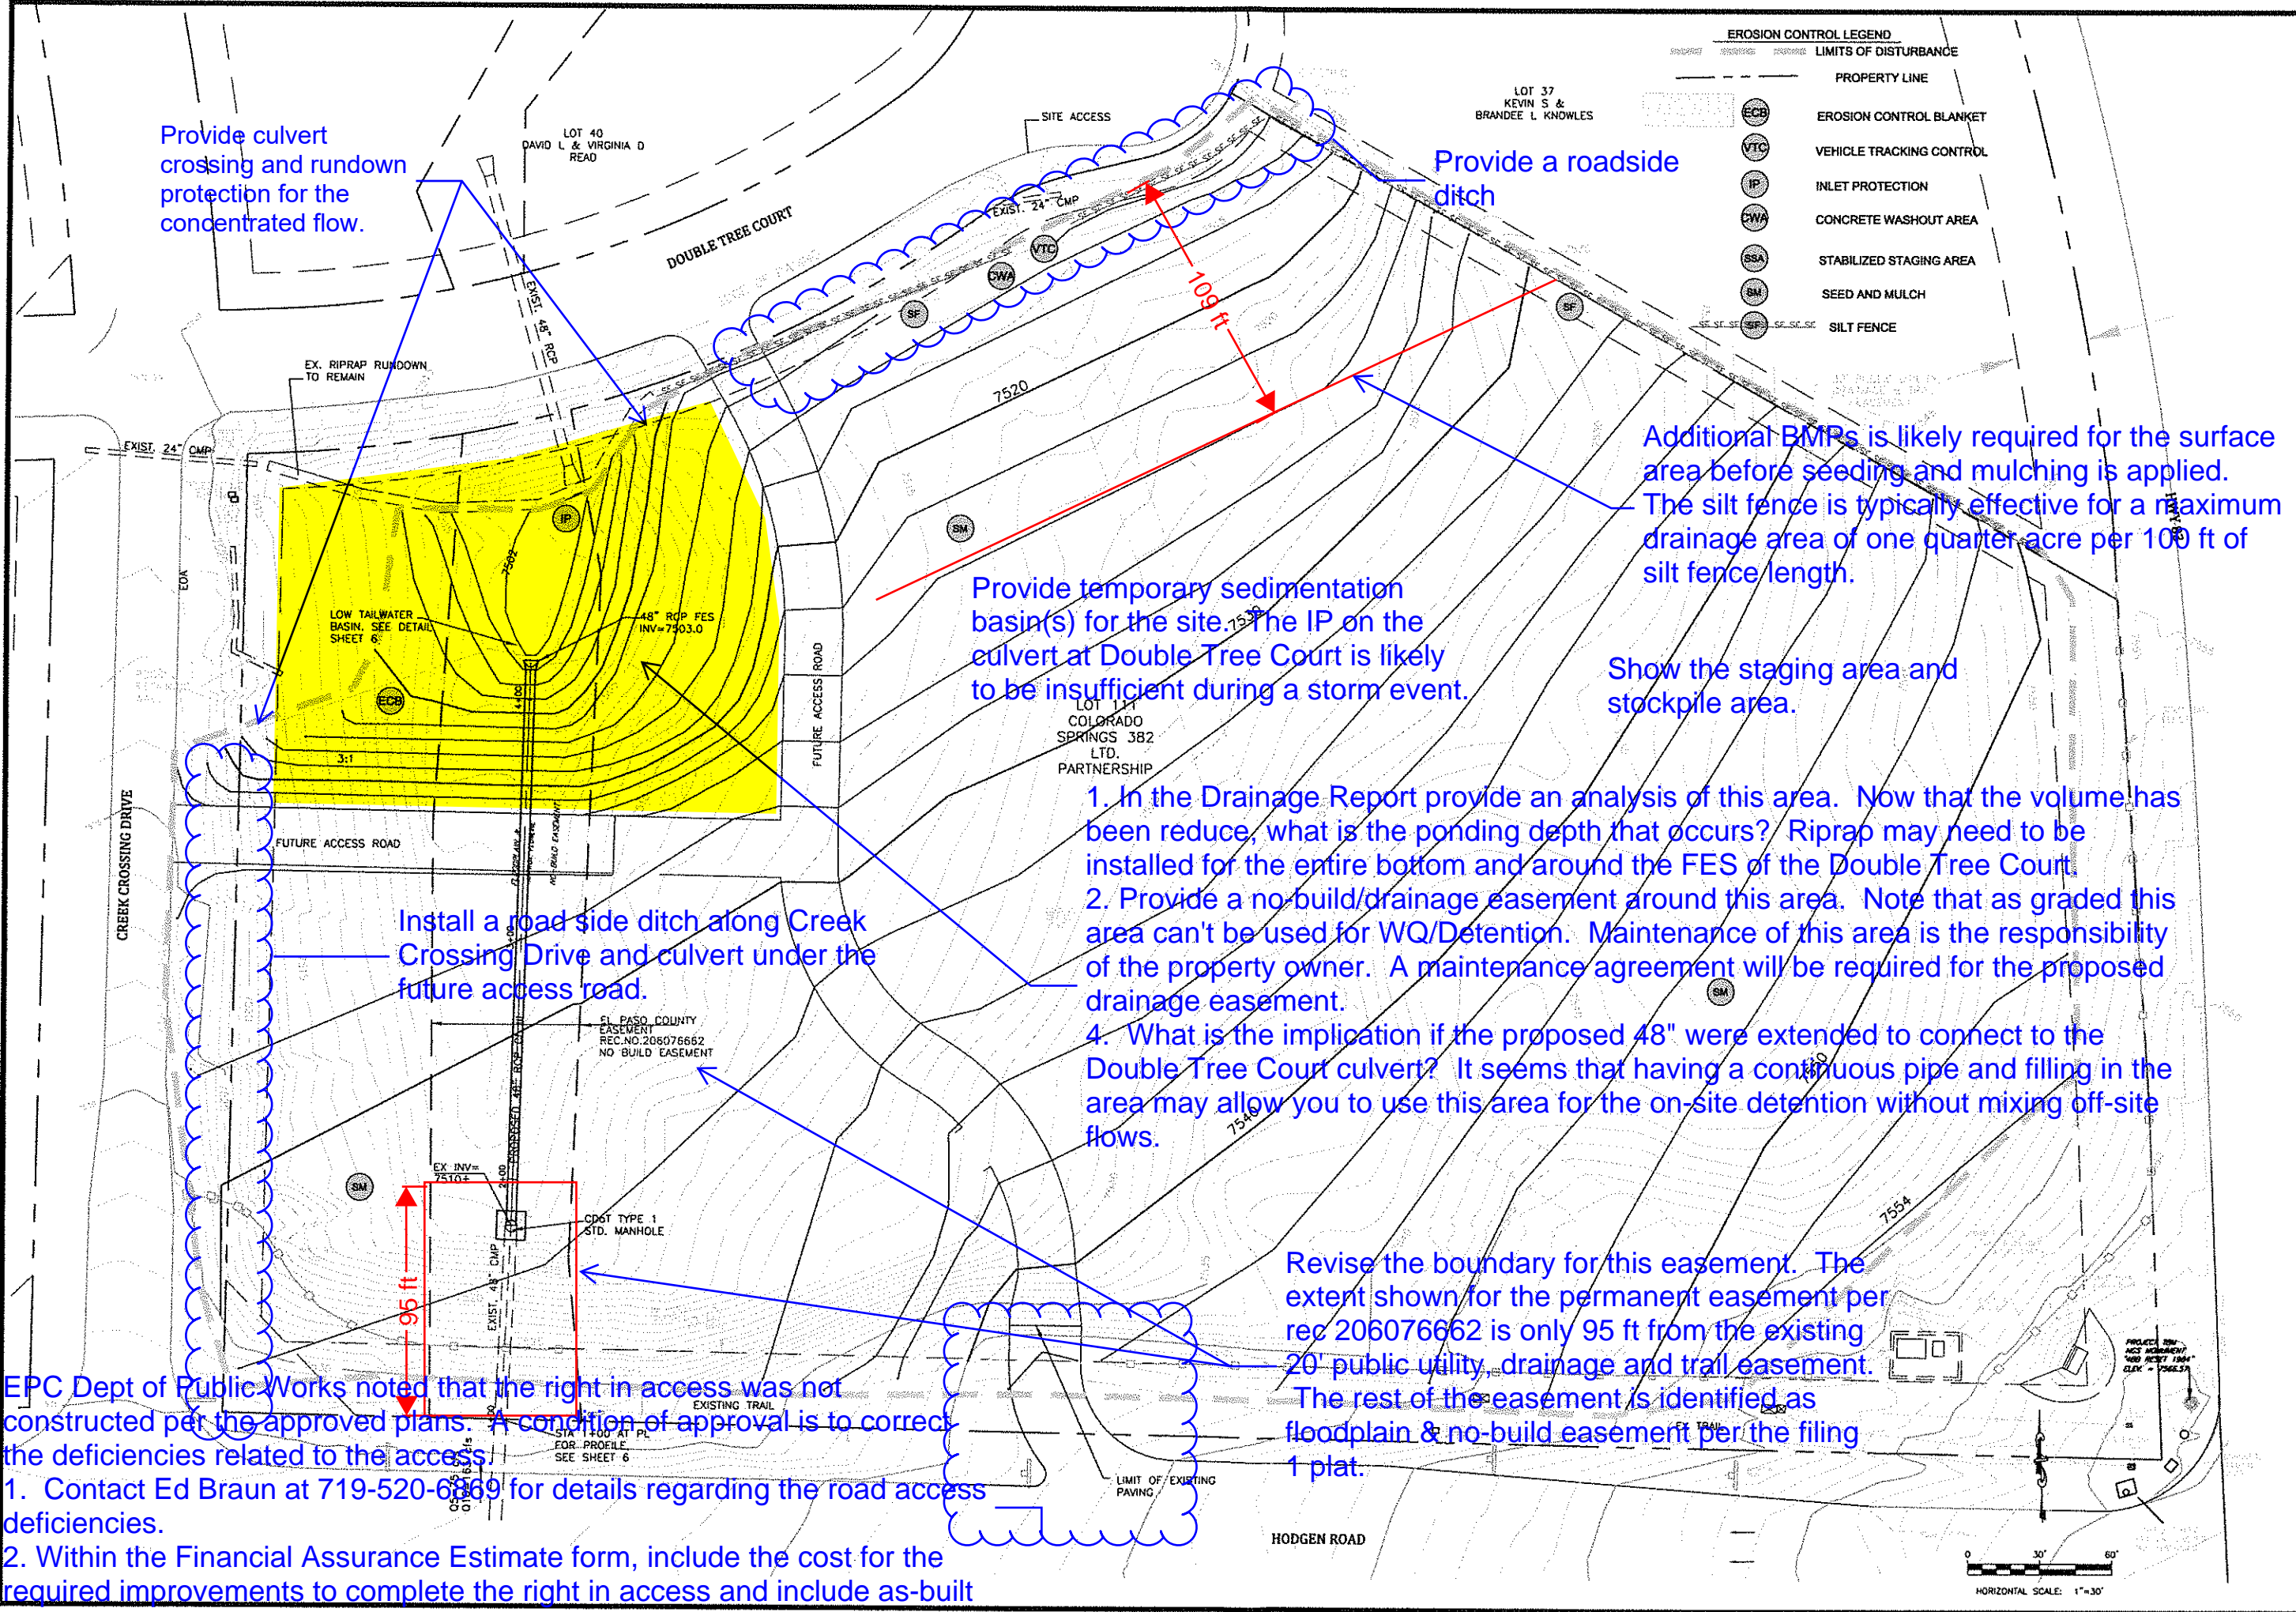

Provide culvert crossing and rundown protection for the concentrated flow.

Provide a roadside ditch

Additional BMPs is likely required for the surface area before seeding and mulching is applied. The silt fence is typically effective for a maximum drainage area of one quarter acre per 100 ft of silt fence length.

Provide temporary sedimentation basin(s) for the site. The IP on the culvert at Double Tree Court is likely to be insufficient during a storm event.

Show the staging area and stockpile area.

Install a road side ditch along Creek Crossing Drive and culvert under the future access road.


1. In the Drainage Report provide an analysis of this area. Now that the volume has been reduce, what is the ponding depth that occurs? Riprap may need to be installed for the entire bottom and around the FES of the Double Tree Court.
2. Provide a no-build/drainage easement around this area. Note that as graded this area can't be used for WQ/Detention. Maintenance of this area is the responsibility of the property owner. A maintenance agreement will be required for the proposed drainage easement.
4. What is the implication if the proposed 48" were extended to connect to the Double Tree Court culvert? It seems that having a continuous pipe and filling in the area may allow you to use this area for the on-site detention without mixing off-site flows.

Revise the boundary for this easement. The extent shown for the permanent easement per rec 206076662 is only 95 ft from the existing 20' public utility, drainage and trail easement. The rest of the easement is identified as floodplain & no-build easement per the filing 1 plat.


EPC Dept of Public Works noted that the right in access was not constructed per the approved plans. A condition of approval is to correct the deficiencies related to the access.

1. Contact Ed Braun at 719-520-6869 for details regarding the road access deficiencies.

2. Within the Financial Assurance Estimate form, include the cost for the required improvements to complete the right in access and include as-built cost at the last page of the form.

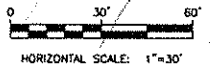

Concrete Washout Area (CWA) MM-1

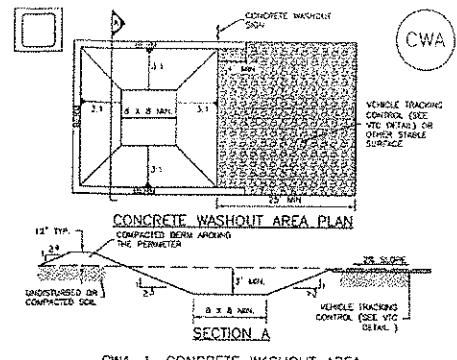

- CWA-1. CONCRETE WASHOUT AREA**
- CWA INSTALLATION NOTES**
1. SEE PLAN VIEW FOR -CWA INSTALLATION LOCATION
 2. DO NOT LOCATE AN UNLINED CWA WITHIN 400' OF ANY NATURAL DRAINAGE PATHWAY OR WATERBODY. DO NOT LOCATE WITHIN 1000' OF ANY WELLS OR DRINKING WATER SOURCE. IF SITE CONDITIONS MAKE THIS UNFEASIBLE, OR IF IMPROPERLY SITED, THE CWA MUST BE INSTALLED WITH AN IMPERVIOUS LAYER (18 MIL. THICKNESS) OR DISTANCE MAINTAINED USING IMPROVED CONCRETE WASHOUT DEVICES OR A LINED ABOVE GROUND STORAGE AND SHOULD BE USED.
 3. THE CWA SHALL BE INSTALLED PRIOR TO CONCRETE PLACEMENT ON SITE.
 4. CWA SHALL INCLUDE A FLAT SURFACE WITH FINISH AT LEAST 8\"/>

November 2010 Urban Drainage and Flood Control District Urban Storm Drainage Criteria Manual Volume 3 CWA-2

Concrete Washout Area (CWA) MM-1

- CWA MAINTENANCE NOTES**
1. INSPECT BMPs EACH MONTH, AND MAINTAIN THEM IN EFFECTIVE OPERATING CONDITION. MAINTENANCE OF BMPs SHOULD BE PROACTIVE, NOT REACTIVE. INSPECT BMPs AS SOON AS POSSIBLE (AND ALWAYS WITHIN 24 HOURS) FOLLOWING A STORM THAT CAUSES SURFACE EROSION, AND PERFORM NECESSARY MAINTENANCE.
 2. FREQUENT OBSERVATIONS AND MAINTENANCE ARE NECESSARY TO MAINTAIN BMPs IN EFFECTIVE OPERATING CONDITION. INSPECTIONS AND CORRECTIVE MEASURES SHOULD BE DOCUMENTED THOROUGHLY.
 3. WHERE BMPs HAVE FAILED, REPAIR OR REPLACEMENT SHOULD BE INITIATED UPON DISCOVERY OF THE FAILURE.
 4. THE CWA SHALL BE REPAIRED, CLEANED, OR CLEANED AS NECESSARY TO MAINTAIN CAPACITY FOR CONCRETE WASTE. CONCRETE MATERIALS, ACCUMULATED IN PITS, SHALL BE REMOVED ONCE THE MATERIALS HAVE REACHED A DEPTH OF 2\"/>

CWA-4 Urban Drainage and Flood Control District Urban Storm Drainage Criteria Manual Volume 3 November 2010


STANDARD EPC GRADING AND EROSION CONTROL NOTES

1. Construction may not commence until a Construction Permit is obtained from Planning and Community Development Department (PCD) and a Preconstruction Conference is held with PCD Inspectors.
2. Stormwater discharges from construction sites shall not cause or threaten to cause pollution, contamination, or degradation of State Waters. All work and earth disturbance shall be done in a manner that minimizes pollution of any on-site or off-site waters, including wetlands.
3. Notwithstanding anything depicted in these plans in words or graphic representation, all design and construction related to roads, storm drainage and erosion control shall conform to the standards and requirements of the most recent version of the relevant adopted El Paso County standards, including the Land Development Code, the Engineering Criteria Manual, the Drainage Criteria Manual, and the Drainage Criteria Manual Volume 2. Any deviations to regulations and standards must be requested, and approved in writing.
4. A separate Stormwater Management Plan (SWMP) for this project shall be completed and an Erosion and Sediment Control Permit (ESQCP) issued prior to commencing construction. During construction the SWMP is the responsibility of the designated Stormwater Manager. The SWMP shall be located on site at all times and shall be kept up to date with work progress and changes in the field.
5. Once the ESQCP has been issued, the contractor may install the initial stage erosion and sediment control BMP's as indicated on the GEC. A preconstruction meeting between the contractor, engineer, and El Paso County will be held prior to any construction. It is the responsibility of the applicant to coordinate the meeting time and place with County PCD inspectors staff.
6. Soil erosion control measures for all slopes, channels, ditches, or any disturbed land area shall be completed within 21 calendar days after final grading, or earth disturbance, has been completed. Disturbed areas and stockpiles, which are not at final grade but will remain dormant for longer than 30 days, shall also be mulched within 21 days after interim grading. Any area that is going to remain an interim for more than 60 days shall also be seeded. All temporary soil erosion control measures and BMP's shall be maintained until permanent soil erosion control measures are implemented and established.
7. Temporary soil erosion control facilities shall be removed and earth disturbance areas graded and stabilized with permanent soil erosion control measures pursuant to standards and specification prescribed in the DCM Volume II and the Engineering Criteria Manual (ECM) appendix I.
8. All persons engaged with earth disturbance shall implement and maintain acceptable soil erosion and sediment control measures including BMP's in conformance with the erosion control technical standards of the Drainage Criteria Manual (DCM) Volume II and in accordance with the Stormwater Management Plan (SWMP).
9. All temporary erosion control facilities including BMP's and all permanent facilities intended to control erosion of any earth disturbance operations shall be installed as defined in the approved plans, the SWMP and the DCM Volume II and maintained throughout the duration of the earth disturbance operation.
10. Any earth disturbance shall be conducted in such a manner so as to effectively reduce accelerated soil erosion and resulting sedimentation. All disturbances shall be designed, constructed, and completed so that the exposed area of any disturbed land shall be limited to the shortest practical period of time.
11. Any temporary or permanent facility designed and constructed for the conveyance of stormwater around, through, or from the earth disturbance area shall be designed to limit the discharge to a non-erosive velocity.
12. Concrete wash water shall be contained and disposed of in accordance with the SWMP. No wash water shall be discharged to or allowed to runoff to State Waters, including any surface or subsurface storm drainage system or facilities.
13. Erosion control blanketing is to be used on slopes steeper than 3:1.
14. Building, construction, excavation, or other waste materials shall not be temporarily placed or stored in the street, alley, or other public way, unless in accordance with an approved Traffic Control Plan. BMP's may be required by El Paso County Department of Public Works if deemed necessary, based on specific conditions and circumstances.
15. Vehicle tracking of soils and construction debris off-site shall be minimized. Materials tracked off-site shall be cleaned up and properly disposed of immediately.
16. Contractor shall be responsible for the removal of all waste from the construction site for disposal in accordance with local and State regulatory requirements. No construction debris, tree slash, building material wastes or unused building materials shall be buried, dumped, or discharged at the site.
17. The owner, site developer, contractor, and/or their authorized agents shall be responsible for the removal of all construction debris, dirt, trash, rock, sediment, and sand that may accumulate in the storm sewer or other drainage conveyance and stormwater appurtenances as a result of site development.
18. The quantity of materials stored on the project site shall be limited, as much as practical, to that quantity required to perform the work in an orderly sequence. All materials stored on-site shall be stored in a neat, orderly manner, in their original containers, with original manufacturer's labels.
19. No chemicals are to be used by the contractor, which have the potential to be released in stormwater unless permission for the use of a specific chemical is granted in writing by the ECM Administrator. In granting the use of such chemicals, special conditions and monitoring may be required.
20. Bulk storage structures for petroleum products and other chemicals shall have adequate protection so as to contain all spills and prevent any spilled material from entering State Waters, including any surface or subsurface storm drainage system or facilities.
21. No person shall cause the impediment of stormwater flow in the flow line of the curb and gutter or in the ditch.
22. Individuals shall comply with the "Colorado Water Quality Control Act" (Title 25, Article 8, C.R.S.) and the Clean Water Act (33 USC 1344), in addition to the requirements included in the DCM Volume II and the ECM Appendix I. All appropriate permits must be obtained by the Contractor prior to the construction (NPDES, Floodplain, 404, fugitive dust, etc.). In the event of conflicts between these requirements and regulations shall apply.
23. All construction traffic must enter/leave the site at approved construction access points.
24. Prior to actual construction the permittee shall verify the location of existing utilities.
25. A water source shall be available on site during earthwork operations and utilized as required to minimize dust from earthwork equipment and wind.
26. At least ten days prior to the anticipated start of construction, for projects that will disturb 1 acre or more, the owner or operator of construction activity shall submit a permit application for stormwater discharge to the Colorado Department of Public Health and Environment, Water Quality Division. The application contains certification of completion of a stormwater management plan (SWMP), of which this grading and erosion control plan may be a part. For information or application materials contact:
Colorado Department of Public Health and Environment
Water Quality Control Division
WQCD - Permits
4300 Cherry Creek Drive South
Denver, Colorado 80246-1530
Attn: Permits Unit

PROJECT SPECIFIC GRADING AND EROSION CONTROL NOTES

1. All earthwork required of this construction shall be completed in accordance with all applicable sections of the Project Specifications and Soil Investigation Report (Geotechnical Report)
2. Rubbish including timber, concrete rubble, trees, brush, and asphalt shall not be backfilled adjacent to any of the structures or be in the placement of any unclassified fill. The Contractor shall be responsible for the removal and hauling of such materials to a suitable spoil area. Costs associated with the removal of such materials shall be paid for as documented in the Project Specifications.
3. Excess excavation shall become the property of the Contractor and shall be disposed of at the Contractor's expense. The cost of hauling and spoiling of excess excavated materials shall be paid for as documented in the Project Specifications.
4. Water shall be used as a dust palliative as required and shall be included in the cost for earthwork items. No separate payment will be made for dust control associated with the site construction.
5. The road grades shall be cleared of vegetation and the topsoil stockpiled for later use.
6. All grading shall be in conformance with the Geotechnical Report for the area.
7. Placement of fill for roadway embankments shall be completed in conformance with the Geotechnical Report.
8. Grading contours shown on this plan are to final grade.
9. Compaction under filled areas, including roadway and detention basin embankments, shall be 95 percent of the maximum Standard Proctor Density (ASTM D698) at two (2) percent optimum moisture content.
10. No rubble or debris shall be placed in the backfill under any of the proposed buildings, streets, curb & gutter, sidewalk and drainage structures or within five (5) feet of a building footprint. Properly graded rubble may be used in some locations as specified and verified by the Geotechnical Engineer.
11. Contractor is responsible for reviewing the site prior to bidding to verify site conditions.
12. Contractor is responsible for providing erosion control measures as approved by the El Paso County PCD Engineering Division and as may be required by the El Paso County Inspector.
13. All slopes equal to or greater than 3:1 shall require anchored soil retention blanket (SRB), Geocor 700 or equal.
14. The Developer is responsible for maintaining erosion control measures until a mature stage of vegetation is established.
15. All soils used for fill must be approved by a representative of the Geotechnical Engineer.
16. All natural ground to receive fill must be properly scarified, watered and compacted prior to placing fill.
17. The Contractor is solely responsible for the design, maintenance and operation of any required dewatering system. The Contractor shall perform such independent investigation as he deems necessary to satisfy himself as to the subsurface groundwater conditions and unstable soil conditions to be encountered throughout the construction. Contractor shall coordinate the dewatering system with El Paso County when associated with public facilities.
18. No fill shall be placed, spread or rolled while it is frozen, thawing or during unfavorable weather conditions. When the work is interrupted by heavy rain, fill operations shall not be resumed until a representative of the Geotechnical Engineer indicates that the moisture content and density of the previously placed fill are as specified. Fill surfaces may be scarified and recompacted after rainfall if necessary, to obtain proper moisture density relation.
19. Additional erosion control structures and/or grading may be required at the time of construction.
20. Sediment removal for erosion control facilities shall be performed continuously for proper function.
21. Base mapping was provided by 4M Group Inc. The date of the last survey update was May, 2014.
22. Proposed Construction Schedule:
Begin Construction: pending
End Construction: pending
Total Site Area = 7.5 Acres
23. Area to be disturbed = 7.5 Acres (est.)
Existing 100-year runoff coefficient = 0.25
Proposed 100-year runoff coefficient = 0.25
Existing Hydrologic Soil Groups: A/B
(B) Gruckton SANDY LOAM) (B Peyton Pining Complex)
(A) Elmore COURSE SAND)
24. Site is currently undeveloped and covered with native grasses on moderate to steep slopes (3%-6%).
25. Site is located in the East Cherry Creek Drainage Basin.

Inlet Protection (IP) SC-6

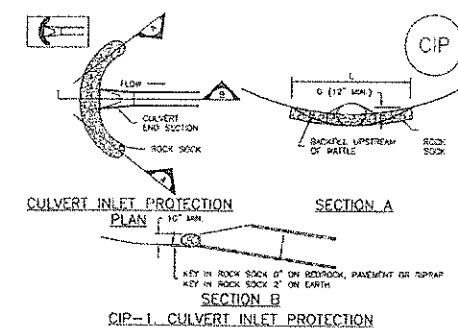

- CIP-1. CULVERT INLET PROTECTION**
- CULVERT INLET PROTECTION INSTALLATION NOTES**
1. SEE PLAN VIEW FOR -LOCATION OF CULVERT INLET PROTECTION.
 2. SEE ROCK SOCK SOCK DETAIL FOR ROCK SOCK DETAIL REQUIREMENTS AND JOINTING DETAIL.
- CULVERT INLET PROTECTION MAINTENANCE NOTES**
1. INSPECT BMPs EACH MONTH, AND MAINTAIN THEM IN EFFECTIVE OPERATING CONDITION. MAINTENANCE OF BMPs SHOULD BE PROACTIVE, NOT REACTIVE. INSPECT BMPs AS SOON AS POSSIBLE (AND ALWAYS WITHIN 24 HOURS) FOLLOWING A STORM THAT CAUSES SURFACE EROSION, AND PERFORM NECESSARY MAINTENANCE.
 2. FREQUENT OBSERVATIONS AND MAINTENANCE ARE NECESSARY TO MAINTAIN BMPs IN EFFECTIVE OPERATING CONDITION. INSPECTIONS AND CORRECTIVE MEASURES SHOULD BE DOCUMENTED THOROUGHLY.
 3. WHERE BMPs HAVE FAILED, REPAIR OR REPLACEMENT SHOULD BE INITIATED UPON DISCOVERY OF THE FAILURE.
 4. SEDIMENT ACCUMULATED UPSTREAM OF THE CULVERT SHALL BE REMOVED WHEN THE SEDIMENT DEPTH IS 1/2 THE HEIGHT OF THE ROCK SOCK.
 5. CULVERT INLET PROTECTION SHALL REMAIN IN PLACE UNTIL THE UPSTREAM DISTURBED AREA IS PERMANENTLY STABILIZED AND APPROVED BY THE LOCAL JURISDICTION.
- (NOTE: ADAPTED FROM TOWN OF FREDERICK, COLORADO AND CITY OF PUEBLO, COLORADO, NOT AVAILABLE IN AUTOCAD)
NOTE: MANY JURISDICTIONS HAVE BMP DETAILS THAT VARY FROM LISTED STANDARD DETAILS. CONSULT WITH LOCAL JURISDICTIONS AS TO WHICH DETAIL SHOULD BE USED WHEN DIFFERENCES ARE NOTED.

August 2013 Urban Drainage and Flood Control District Urban Storm Drainage Criteria Manual Volume 3 IP-7

SC-6 Inlet Protection (IP)

- CULVERT INLET PROTECTION INSTALLATION NOTES**
1. SEE PLAN VIEW FOR -LOCATION OF INLET PROTECTION.
 2. SEE ROCK SOCK SOCK DETAIL FOR ROCK SOCK DETAIL REQUIREMENTS AND JOINTING DETAIL.
- CULVERT INLET PROTECTION MAINTENANCE NOTES**
1. INSPECT BMPs EACH MONTH, AND MAINTAIN THEM IN EFFECTIVE OPERATING CONDITION. MAINTENANCE OF BMPs SHOULD BE PROACTIVE, NOT REACTIVE. INSPECT BMPs AS SOON AS POSSIBLE (AND ALWAYS WITHIN 24 HOURS) FOLLOWING A STORM THAT CAUSES SURFACE EROSION, AND PERFORM NECESSARY MAINTENANCE.
 2. FREQUENT OBSERVATIONS AND MAINTENANCE ARE NECESSARY TO MAINTAIN BMPs IN EFFECTIVE OPERATING CONDITION. INSPECTIONS AND CORRECTIVE MEASURES SHOULD BE DOCUMENTED THOROUGHLY.
 3. WHERE BMPs HAVE FAILED, REPAIR OR REPLACEMENT SHOULD BE INITIATED UPON DISCOVERY OF THE FAILURE.
 4. SEDIMENT ACCUMULATED UPSTREAM OF INLET PROTECTION SHALL BE REMOVED AS NECESSARY TO MAINTAIN BMP EFFECTIVENESS. TYPICALLY WHEN STORAGE VOLUME REACHES 50% OF CAPACITY, A DEPTH OF 6\"/>
- (NOTE: ADAPTED FROM TOWN OF FREDERICK, COLORADO AND CITY OF PUEBLO, COLORADO, NOT AVAILABLE IN AUTOCAD)
NOTE: THE DETAILS INCLUDED WITH THIS FACT SHEET SHOW CONVENTIONAL, CONVENTIONAL INLET PROTECTION IN THE CENTER OF THE CULVERT. HOWEVER, MANY JURISDICTIONS USE PROPRIETARY INLET PROTECTION METHODS ON THE MARKET. LISTED HEREIN EXPRESSES OUR DISAPPROVED USE OF PROPRIETARY INLET PROTECTION. HOWEVER, IF THE OWNER PROPRIETARY METHODS ARE USED, THE APPROPRIATE DETAIL FROM THE MANUFACTURER MUST BE INCLUDED IN THE SWMP AND THE BMP MUST BE INSTALLED AND MAINTAINED AS SHOWN IN THE MANUFACTURER'S DETAILS.
NOTE: SOME JURISDICTIONS DISCOURAGE OR PROHIBIT THE USE OF STRAP BARS FOR INLET PROTECTION. CHECK WITH LOCAL JURISDICTION TO DETERMINE IF STRAP BAR INLET PROTECTION IS ACCEPTABLE.

IP-8 Urban Drainage and Flood Control District Urban Storm Drainage Criteria Manual Volume 3 August 2013

SEEDING AND MULCHING INSTALLATION NOTES

- SEE PLAN VIEW FOR:
- AREA OF SEEDING AND MULCHING
- TYPE OF SEED MIX
- ALL BRANDS FURNISHED SHALL BE FREE FROM SUCH NOXIOUS SEEDS AS RUSSIAN OR CANADIAN THISTLE, COARSE FESCUE, EUROPEAN BIRDNEED, JOHNSON GRASS, KNAF WEED AND LEAFY SPURGE.
- THE SEEDER SHALL FURNISH TO THE CONTRACTOR A SIGNED STATEMENT CERTIFYING THAT THE SEED FURNISHED IS FROM A LOT THAT HAS BEEN TESTED BY A RECOGNIZED LABORATORY. SEED WHICH HAS BECOME WET, MOLDY OR OTHERWISE DAMAGED IN TRANSIT OR IN STORAGE WILL NOT BE ACCEPTABLE. SEED TICKETS SHALL BE PROVIDED TO REGULATING AGENCY UPON REQUEST.
- DRILL SEEDING MIX SHALL CONFORM TO THE TABLE ON THE RIGHT.
- IF THE SEED AVAILABLE ON THE MARKET DOES NOT MEET THE MINIMUM PURITY AND GERMINATION PERCENTAGES SPECIFIED, THE SUBCONTRACTOR MUST COMPENSATE FOR A LESSER PERCENTAGE OF PURITY OR GERMINATION BY FURNISHING SUFFICIENT ADDITIONAL SEED TO EQUAL THE SPECIFIED PRODUCT. THE TAGS FROM THE SEED MIXES MUST BE SUPPLIED TO CONTRACTOR AND FORWARDED TO THE REGULATING AGENCY'S GESC INSPECTOR.
- THE FORMULA USED FOR DETERMINING THE QUANTITY OF PURE LIVE SEED (PLS) SHALL BE (POUNDS OF SEED) X (PURITY) X (GERMINATION) = POUNDS OF PURE LIVE SEED (PLS).
- PERMANENT SEED MIX SHALL BE USED UNLESS OTHERWISE APPROVED BY THE REGULATING AGENCY.
- ALL AREAS TO BE SEEDING AND MULCHED SHALL HAVE NATIVE TOPSOIL OR APPROVED SOIL AMENDMENTS SPREAD TO A DEPTH OF AT LEAST 6 INCHES (LOOSE DEPTH). HAUL ROADS AND OTHER COMPACTED AREAS SHALL BE LOOSENEED TO A DEPTH OF 6 INCHES PRIOR TO SPREADING TOPSOIL.
- SOIL IS TO BE THOROUGHLY LOOSENEED (TILLED) TO A DEPTH OF AT LEAST 8 INCHES PRIOR TO SEEDING. THE TOP 8 INCHES OF THE SEED BED SHALL BE FREE OF ROCKS GREATER THAN 4 INCHES AND SOIL CLODS GREATER THAN 2 INCHES. SEEDING OVER ANY COMPACTED AREAS THAT HAVEN'T BEEN THOROUGHLY LOOSENEED SHALL BE REJECTED.
- SEED IS TO BE APPLIED USING A MECHANICAL DRILL TO A DEPTH OF 1/4 INCH. ROW SPACING SHALL BE NO MORE THAN 6 INCHES. MATERIAL USED FOR MULCH SHALL CONSIST OF LONG-STEMMED STRAW AT LEAST 90 PERCENT OF THE MULCH, BY WEIGHT, SHALL BE 10 INCHES OR MORE IN LENGTH. MULCH SHALL BE APPLIED AND MECHANICALLY ANCHORED TO A DEPTH OF AT LEAST 2 INCHES. MULCH SHALL BE APPLIED AT A RATE OF 4000 LB. OF STRAW PER ACRE.
- IF THE PERMITTEE DEMONSTRATES TO THE REGULATING AGENCY THAT IT IS NOT POSSIBLE TO DRILL SEED, SEED IS TO BE UNIFORMLY BROADCAST AT TWO TIMES THE DRILLED RATE, THEN LIGHTLY HARROWED TO PROVIDE A SEED DEPTH OF APPROXIMATELY 1/4 INCH, THEN ROLLED TO COMPACT, THEN MULCHED AS SPECIFIED ABOVE.
- SEEDING AND MULCHING SHALL BE COMPLETED WITHIN 30 DAYS OF INITIAL EXPOSURE OR 7 DAYS AFTER GRADING IS SUBSTANTIALLY COMPLETE IN A GIVEN AREA (AS DEFINED BY THE REGULATING AGENCY). THIS MAY REQUIRE MULTIPLE MOBILIZATIONS FOR SEEDING AND MULCHING.
- MULCH SHALL BE APPLIED WITHIN 24 HOURS OF SEEDING.
- TACKLIFIER SHOULD BE UTILIZED TO HELP WITH STRAW DISPLACEMENT.


SEEDING AND MULCHING MAINTENANCE NOTES

- SEEDING AND MULCHED AREAS SHALL BE INSPECTED FOR REQUIRED COVERAGE MONTHLY FOR A PERIOD OF TWO YEARS FOLLOWING INITIAL SEEDING. REPAIRS AND RE-SEEDING AND MULCHING SHALL BE UNDERTAKEN AFTER THE FIRST GROWING SEASON FOR ANY AREAS FAILING TO MEET THE REQUIRED COVERAGE.
- REQUIRED COVERAGE FOR STANDARD, OPEN SPACE AND LOW GROWTH SEED MIXES SHALL BE DEFINED AS FOLLOWS:
1. THREE (3) PLANTS PER SQUARE FOOT WITH A MINIMUM HEIGHT OF 3 INCHES. THE 3 PLANTS PER SQUARE FOOT SHALL BE OF THE VARIETY AND SPECIES FOUND IN THE DOUGLAS COUNTY-APPROVED MIX.
2. NO BARE AREAS LARGER THAN 4 SQUARE FEET (TWO-FOOT BY TWO-FOOT OR EQUIVALENT).
3. FREE OF ERODED AREAS.
4. FREE FROM INFESTATION OF NOXIOUS WEEDS IN ACCORDANCE WITH SECTION 6.4 OF THE GESC CRITERIA MANUAL.
- REQUIRED COVERAGE FOR TURF GRASS AREAS SHALL BE DEFINED AS FOLLOWS:
1. AT LEAST 80% VEGETATIVE COVER OF GRASS SPECIES PLANTED.
2. NO BARE AREAS LARGER THAN 4 SQUARE FEET (TWO-FOOT BY TWO-FOOT OR EQUIVALENT).
3. FREE OF ERODED AREAS.
4. FREE FROM INFESTATION OF NOXIOUS WEEDS IN ACCORDANCE WITH SECTION 6.4 OF THE GESC CRITERIA MANUAL.
- RILL AND GULLY EROSION SHALL BE FILLED WITH TOPSOIL PRIOR TO RESEEDING. THE RESEEDING METHOD SHALL BE APPROVED BY THE COUNTY.

SEED MIX		
AREAS DISTURBED BY THE EARTHWORK SHALL BE PERMANENTLY REVEGETATED WITH NATIVE GRASSES. NATIVE SEED MIX FOR THIS PROJECT SHALL BE AS FOLLOWS:		
SPECIES	PLS/acre	lbs/acre
WESTERN WHEAT GRASS	<i>Panicum smithii</i>	3.0
STREETS GRAMA	<i>Bouteloua curtipendula</i>	2.0
SLENDER WHEAT GRASS	<i>Elymus trachycaulus</i>	2.0
LITTLE BLUESTEM	<i>Schizachyrium scoparium</i>	2.0
BLUE GRAMA	<i>Bouteloua gracilis</i>	0.5
SWITCH GRASS	<i>Panicum virgatum</i>	2.0
JUNE GRASS	<i>Abelaria cristata</i>	0.5
SAND DROPSEED	<i>Sporobolus cryptandrus</i>	0.5
		125 lbs
SEEDING APPLICATION: DRILL SEED 1/4" TO 1/2" INTO TOPSOIL. IN AREAS UNACCESSIBLE TO A DRILL, HAND BROADCAST AT DOUBLE THE RATE AND RAKE 1/4" TO 1/2" INTO THE TOPSOIL.		
MULCHING APPLICATION: 1-1/2 TONS NATIVE HAY PER ACRE, MECHANICALLY CRIMPED INTO THE TOPSOIL OR HYDROMULCH.		


SEEDING AND MULCH
NTS

Silt Fence (SF) SC-1

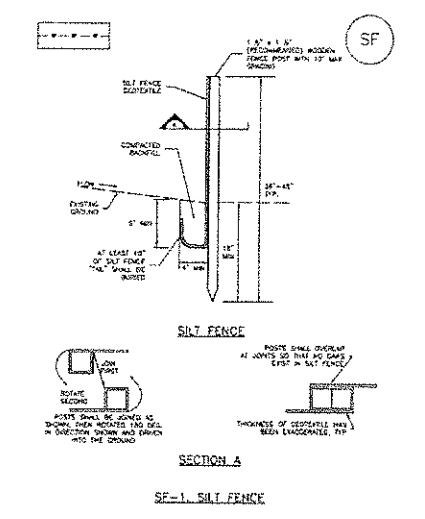

November 2010 Urban Drainage and Flood Control District Urban Storm Drainage Criteria Manual Volume 3


Silt Fence (SF) SC-1

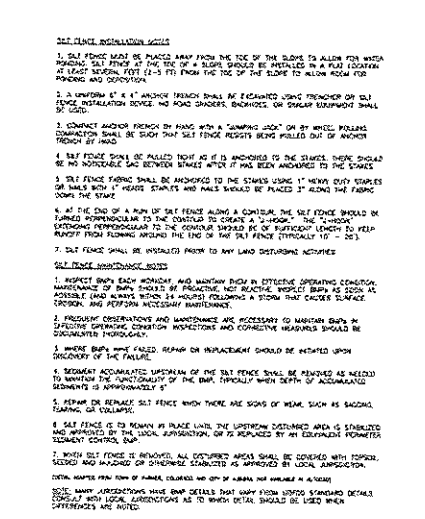

November 2010 Urban Drainage and Flood Control District Urban Storm Drainage Criteria Manual Volume 3

Resubmit document as full size or higher resolution. Some text are not legible on this scanned document.


Vehicle Tracking Control (VTC) SM-4

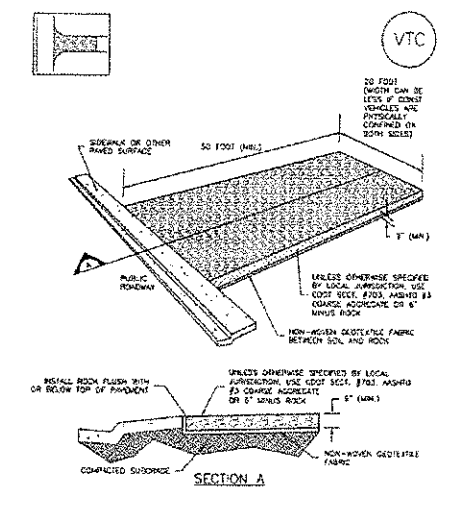

VTC-1. AGGREGATE VEHICLE TRACKING CONTROL

November 2010 Urban Drainage and Flood Control District Urban Storm Drainage Criteria Manual Volume 3


Vehicle Tracking Control (VTC) SM-4

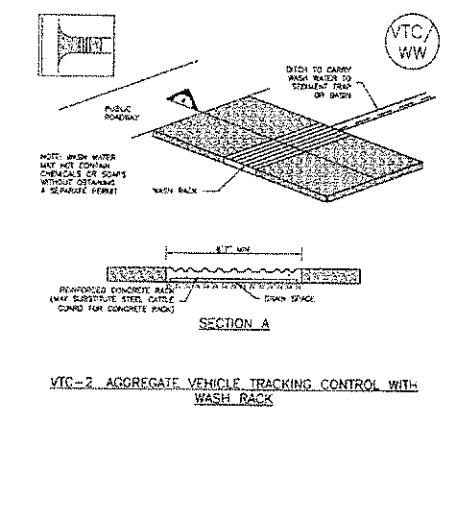

VTC-2. AGGREGATE VEHICLE TRACKING CONTROL WITH WASH BASIN

November 2010 Urban Drainage and Flood Control District Urban Storm Drainage Criteria Manual Volume 3


Vehicle Tracking Control (VTC) SM-4

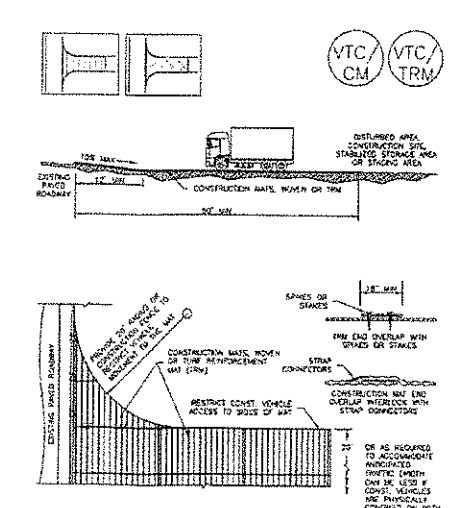

VTC-3. VEHICLE TRACKING CONTROL W/ CONSTRUCTION MAT OR TURF REINFORCEMENT MAT (TRM)

November 2010 Urban Drainage and Flood Control District Urban Storm Drainage Criteria Manual Volume 3

Vehicle Tracking Control (VTC) SM-4

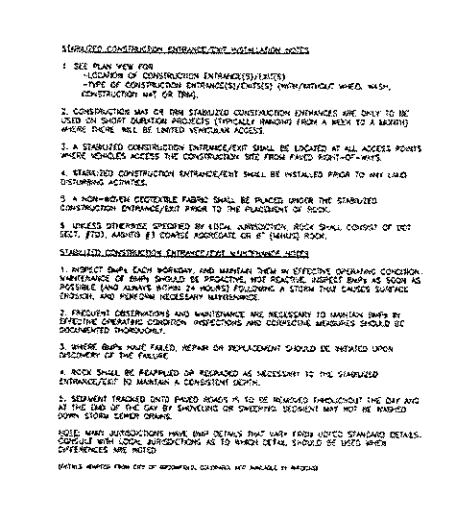


VTC-4. VEHICLE TRACKING CONTROL W/ CONSTRUCTION MAT OR TURF REINFORCEMENT MAT (TRM)

November 2010 Urban Drainage and Flood Control District Urban Storm Drainage Criteria Manual Volume 3

**CHERRY CREEK CROSSING, FILING NO. 1 LOT 111
OVERLOT GRADING and EROSION CONTROL PLAN
EROSION CONTROL DETAILS
EL PASO COUNTY, COLORADO**

Project No: 14028
Date: JULY 25, 2017
Design: RNW
Drawn: EAK
Check: RNW
Revisions:

Stabilized Staging Area (SSA) SM-6

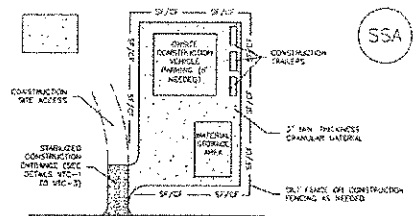


SSA-1. STABILIZED STAGING AREA

- STABILIZED STAGING AREA INSTALLATION NOTES**
1. SEE PLAN VIEW FOR LOCATION OF STAGING AREAS. CONSTRUCTION MAY ADJUST LOCATION AND SIZE OF STAGING AREA WITH APPROVAL FROM THE LOCAL JURISDICTION.
 2. STABILIZED STAGING AREA SHOULD BE APPROPRIATE FOR THE NEEDS OF THE SITE. OVERSIZING AREAS IN A LARGER AREA IS STRONGLY DISCOURAGED.
 3. STAGING AREA SHALL BE STABILIZED PRIOR TO OTHER OPERATIONS ON THE SITE.
 4. THE STABILIZED STAGING AREA SHALL CONSIST OF A MINIMUM 3" THICK GRANULAR MATERIAL.
 5. UNLESS OTHERWISE SPECIFIED BY LOCAL JURISDICTION, ROCK SHALL CONSIST OF DOT SPEC. #573. AGRICULTURAL GRADE AGGREGATE OR 6" DIAMETER ROCK.
 6. ADDITIONAL IMPROVEMENTS MAY BE REQUIRED INCLUDING BUT NOT LIMITED TO SUEF TRENCH AND CONSTRUCTION FENCING.
- STABILIZED STAGING AREA MAINTENANCE NOTES**
1. INSPECT ROPS EACH WEEKLY, AND MAINTAIN THEM IN EFFECTIVE OPERATING CONDITION. MAINTENANCE OF ROPS SHOULD BE PROACTIVE, NOT REACTIVE. INSPECT ROPS AS SOON AS POSSIBLE (AND ALWAYS WITHIN 24 HOURS) FOLLOWING A STORM THAT CAUSES SURFACE EROSION, AND PROVIDE NECESSARY MAINTENANCE.
 2. FREQUENT OBSERVATIONS AND MAINTENANCE ARE NECESSARY TO MAINTAIN ROPS IN EFFECTIVE OPERATING CONDITION. INSPECTIONS AND CORRECTIVE MEASURES SHOULD BE DOCUMENTED IMMEDIATELY.
 3. ROPS THAT HAVE FAILED, REPAIR OR REPLACEMENT SHOULD BE INITIATED UPON OCCURRENCE OF THE FAILURE.
 4. ROCK SHALL BE REPLACED OR RECREASED AS NECESSARY IF PAVING OCCURS OR UNDERLYING SURFACE BECOMES EXPOSED.


SM-6 Stabilized Staging Area (SSA)

- STABILIZED STAGING AREA INSTALLATION NOTES**
3. STABILIZED STAGING AREA SHALL BE CREATED IF NECESSARY TO CONTROL PAVING, STORMS, AND UNDESIRABLE/UNSAFE OPERATIONS.
 4. THE STABILIZED STAGING AREA SHALL BE PROVIDED AT THE END OF CONSTRUCTION. THE GRANULAR MATERIAL SHALL BE REMOVED OR, IF APPROVED BY THE LOCAL JURISDICTION, USED ON SITE, AND THE AREA COVERED WITH TOPSOIL, SEEDS, AND MULCH OR OTHERWISE STABILIZED IN A MANNER APPROVED BY LOCAL JURISDICTION.
- NOTE:** MANY JURISDICTIONS PROHIBIT THE USE OF RECYCLED CONCRETE AS GRANULAR MATERIAL FOR STABILIZED STAGING AREAS. IN DIFFERENCES WITH THE ESTABLISHMENT OF VEGETATION IN AREAS WHERE RECYCLED CONCRETE WAS PLACED.
- NOTE:** MANY JURISDICTIONS HAVE ROPS DETAILS THAT DIFFER FROM LISTED STANDARD DETAILS. CONSULT WITH LOCAL JURISDICTIONS AS TO WHICH DETAIL SHOULD BE USED WHEN DIFFERENCES ARE NOTED.
- DETAILS ADAPTED FROM SOURCE: CDOT, EROSION CONTROL MANUAL, 2008.**

EC-6 Rolled Erosion Control Products (RECP) ECB

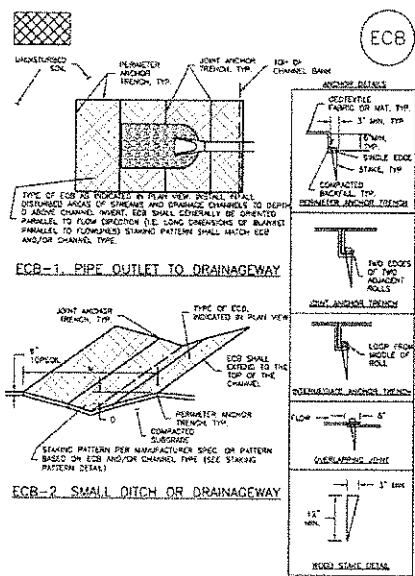

Rolled Erosion Control Products (RECP) EC-6

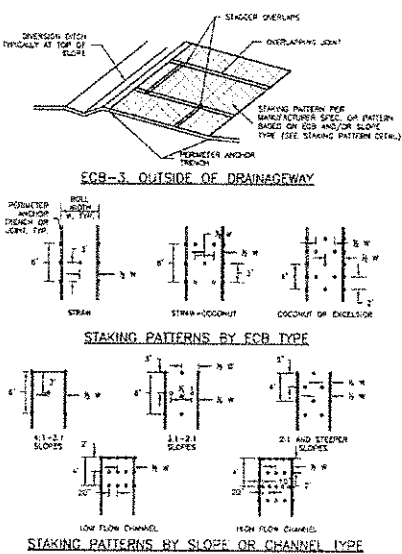

EC-6 Rolled Erosion Control Products (RECP)

- EROSION CONTROL BLANKET INSTALLATION NOTES**
1. SEE PLAN VIEW FOR:
 - LOCATION OF ECB
 - TYPE OF ECB (STRAIN, STRAIN-COCONUT, COCONUT, OR EXCELSDOR)
 - AREA, A, IN SQUARE FEET OF EACH TYPE OF ECB
 2. LOCAL MATERIAL AND DIMENSIONABLE MATERIALS ARE PREFERRED FOR ROPS. ALTHOUGH SOME JURISDICTIONS MAY ALLOW OTHER MATERIALS IN SOME APPLICATIONS.
 3. IN AREAS WHERE EROSION IS SHOWN ON THE PLAN, THE ROPS SHALL BE PLACED TO PROTECT AND PERFORM FINAL GRADING, SURFACE PREPARATION, AND SEEDING AND MULCHING. SURFACE SHALL BE SMOOTH AND LEVEL PRIOR TO ECB INSTALLATION AND THE ECB SHALL BE IN FULL CONTACT WITH SUBGRADE. NO CURBS OR VESSELS SHALL EXIST UNDER THE BLANKET.
 4. PERIMETER ANCHOR TRENCH SHALL BE USED ALONG THE OUTSIDE PERIMETER OF ALL BLANKET AREAS.
 5. JOINT ANCHOR TRENCH SHALL BE USED TO JOIN ROLLS OF ECB TOGETHER (LONGITUDINALLY AND TRANSVERSELY) FOR ALL ECB EXCEPT STRAIN WHICH MAY USE AN OVERLAPPING JOINT.
 6. INTERMEDIATE ANCHOR BROWNSHALL BE USED AT SPACING OF ONE-HALF ROLL LENGTH FOR PROTECT AND EXCELSDOR ECB.
 7. OVERLAPPING JOINT DETAIL SHALL BE USED TO JOIN ROLLS OF ECB TOGETHER FOR ECB ON SLOPES.
 8. MATERIAL SPECIFICATIONS OF ECB SHALL CONFORM TO TABLE EC6-1.
 9. ANY AREAS OF SEEDING AND MULCHING DESCRIBED IN THE PROCESS OF INSTALLING ECB SHALL BE RESEEDING AND MULCHING.
 10. DETAILS ON DESIGN PLANS FOR MAJOR DRAINAGEWAY STABILIZATION WILL COVER IF DIFFERENT FROM THOSE SHOWN HERE.


TABLE EC6-1. ECB MATERIAL SPECIFICATIONS

TYPE	COCONUT CONTENT	STRAIN CONTENT	EXCELSDOR CONTENT	RECOMMENDED APPLICATION
STRAIN	-	100%	-	DOUBLY/ TRIPLY
STRAIN-COCONUT	50% MIN	70% MAX	-	DOUBLY/ TRIPLY
COCONUT	100%	-	-	DOUBLY/ TRIPLY
EXCELSDOR	-	-	100%	DOUBLY/ TRIPLY

TYPE AND CONTENT OF ECB SHALL BE AS SPECIFIED IN THE CONTRACT DOCUMENTS. MATERIALS MUST BE ACCEPTABLE TO THE LOCAL JURISDICTION.


Rolled Erosion Control Products (RECP) EC-6

- EROSION CONTROL BLANKET MAINTENANCE NOTES**
1. INSPECT ROPS EACH WEEKLY, AND MAINTAIN THEM IN EFFECTIVE OPERATING CONDITION. MAINTENANCE OF ROPS SHOULD BE PROACTIVE, NOT REACTIVE. INSPECT ROPS AS SOON AS POSSIBLE (AND ALWAYS WITHIN 24 HOURS) FOLLOWING A STORM THAT CAUSES SURFACE EROSION, AND PROVIDE NECESSARY MAINTENANCE.
 2. FREQUENT OBSERVATIONS AND MAINTENANCE ARE NECESSARY TO MAINTAIN ROPS IN EFFECTIVE OPERATING CONDITION. INSPECTIONS AND CORRECTIVE MEASURES SHOULD BE DOCUMENTED IMMEDIATELY.
 3. WHERE ROPS HAVE FAILED, REPAIR OR REPLACEMENT SHOULD BE INITIATED UPON OCCURRENCE OF THE FAILURE.
 4. ECB SHALL BE LEFT IN PLACE TO EVENTUALLY BIODEGRADE, UNLESS REQUESTED TO BE REMOVED BY THE LOCAL JURISDICTION.
 5. ANY ECB PULLED OUT, TORN, OR OTHERWISE DAMAGED SHALL BE REPAIRED OR REPLACED. ANY SUBGRADE AREAS BELOW THE ECB THAT HAVE ERODED TO EXPOSED SHOULD ALSO UNDER THE BLANKET. IF THAT REMAIN CURBS OR VESSELS SHALL BE REPAIRED, PRESEEDED AND MULCHED AND THE ECB REINSTALLED.
- NOTE:** MANY JURISDICTIONS HAVE ROPS DETAILS THAT DIFFER FROM LISTED STANDARD DETAILS. CONSULT WITH LOCAL JURISDICTIONS AS TO WHICH DETAIL SHOULD BE USED WHEN DIFFERENCES ARE NOTED.
- DETAILS ADAPTED FROM SOURCE: CDOT, EROSION CONTROL MANUAL, 2008.**

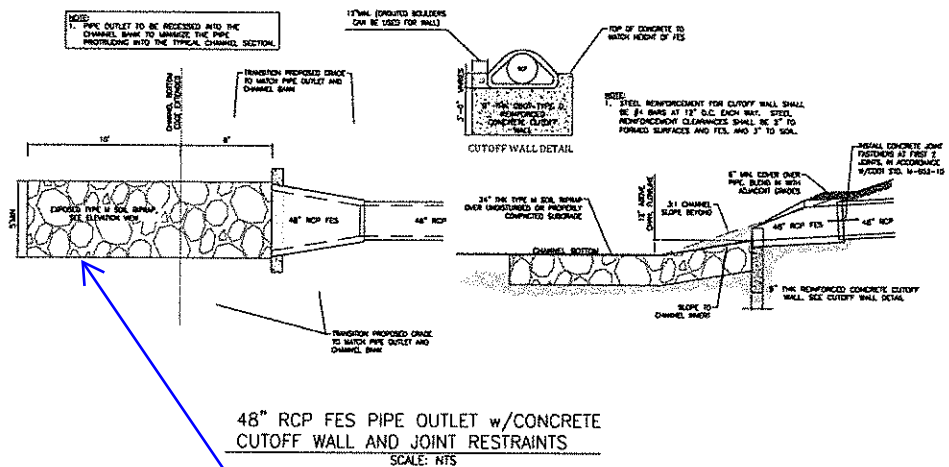


48" RCP FES PIPE OUTLET w/CONCRETE CUTOFF WALL AND JOINT RESTRAINTS
SCALE: NTS

Dimensions are not legible. Resubmit document with higher resolution.

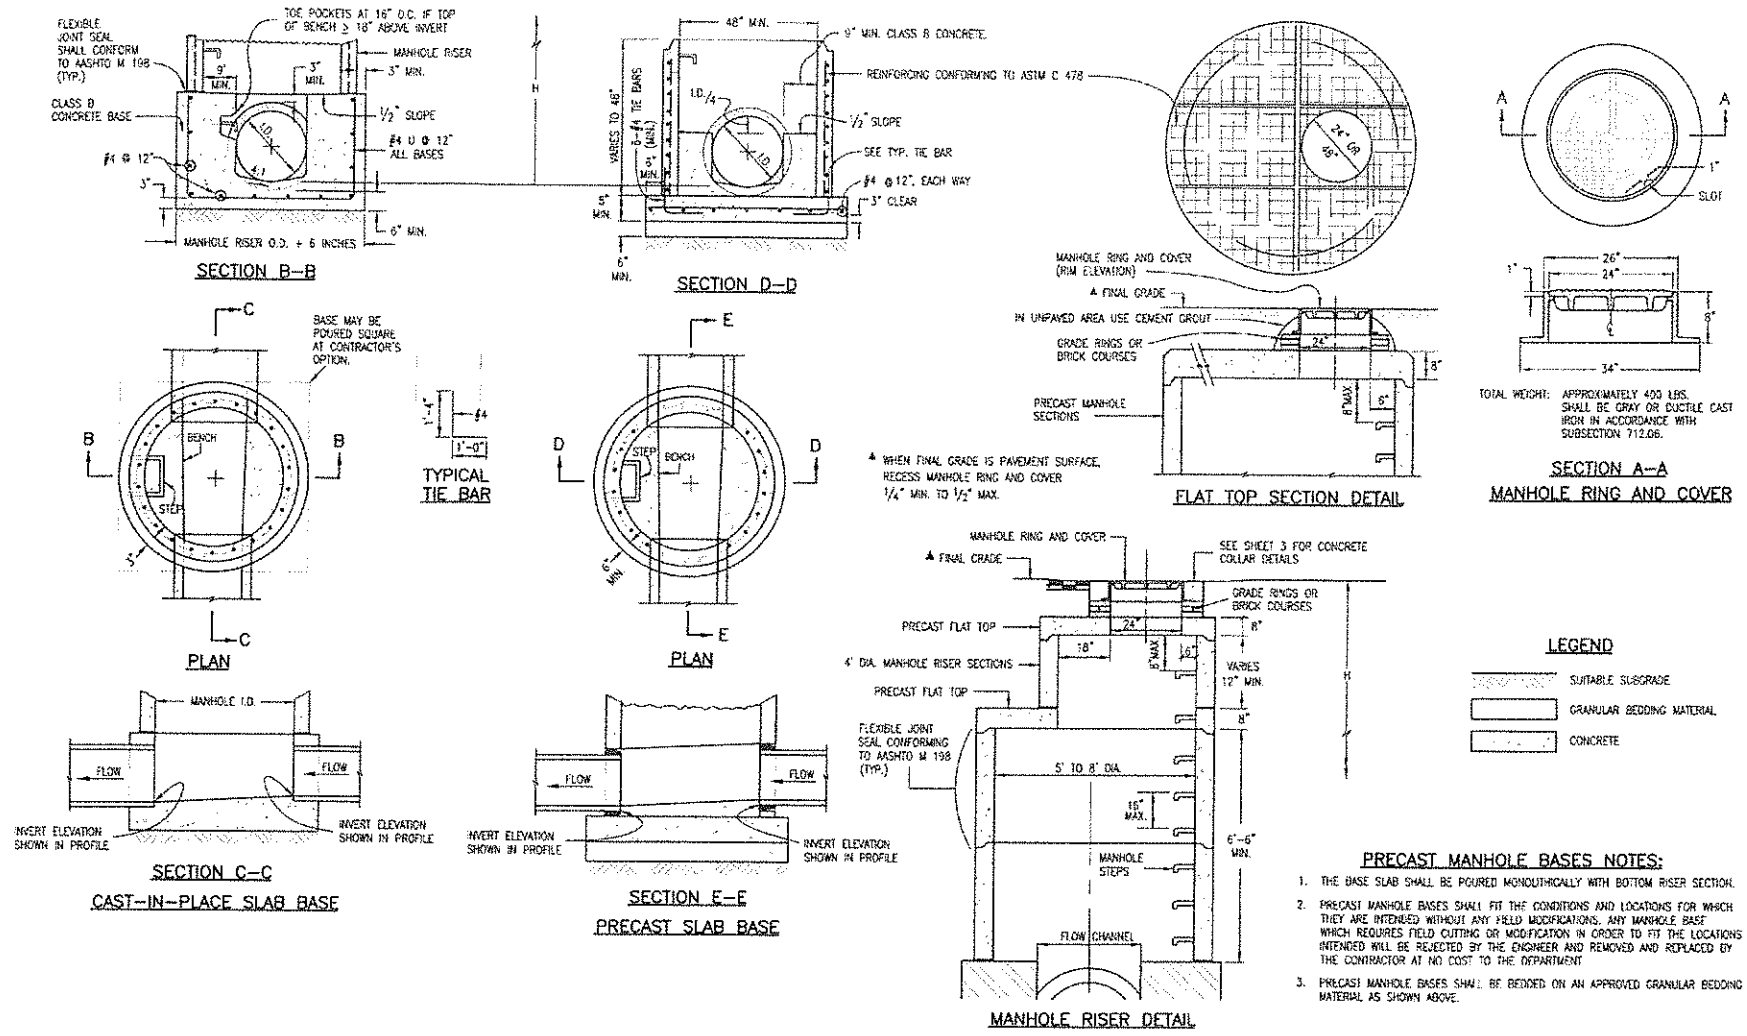

- PRECAST MANHOLE BASES NOTES:**
1. THE BASE SLAB SHALL BE POURED MONOLITHICALLY WITH BOTTOM RISER SECTION.
 2. PRECAST MANHOLE BASES SHALL FIT THE CONDITIONS AND LOCATIONS FOR WHICH THEY ARE INTENDED WITHOUT ANY FIELD MODIFICATIONS. ANY MANHOLE BASE WHICH REQUIRES FIELD CUTTING OR MODIFICATION IN ORDER TO FIT THE LOCATIONS INTENDED WILL BE REJECTED BY THE ENGINEER AND REMOVED AND REPLACED BY THE CONTRACTOR AT NO COST TO THE DEPARTMENT.
 3. PRECAST MANHOLE BASES SHALL BE BEDDED ON AN APPROVED GRANULAR BEDDING MATERIAL AS SHOWN ABOVE.

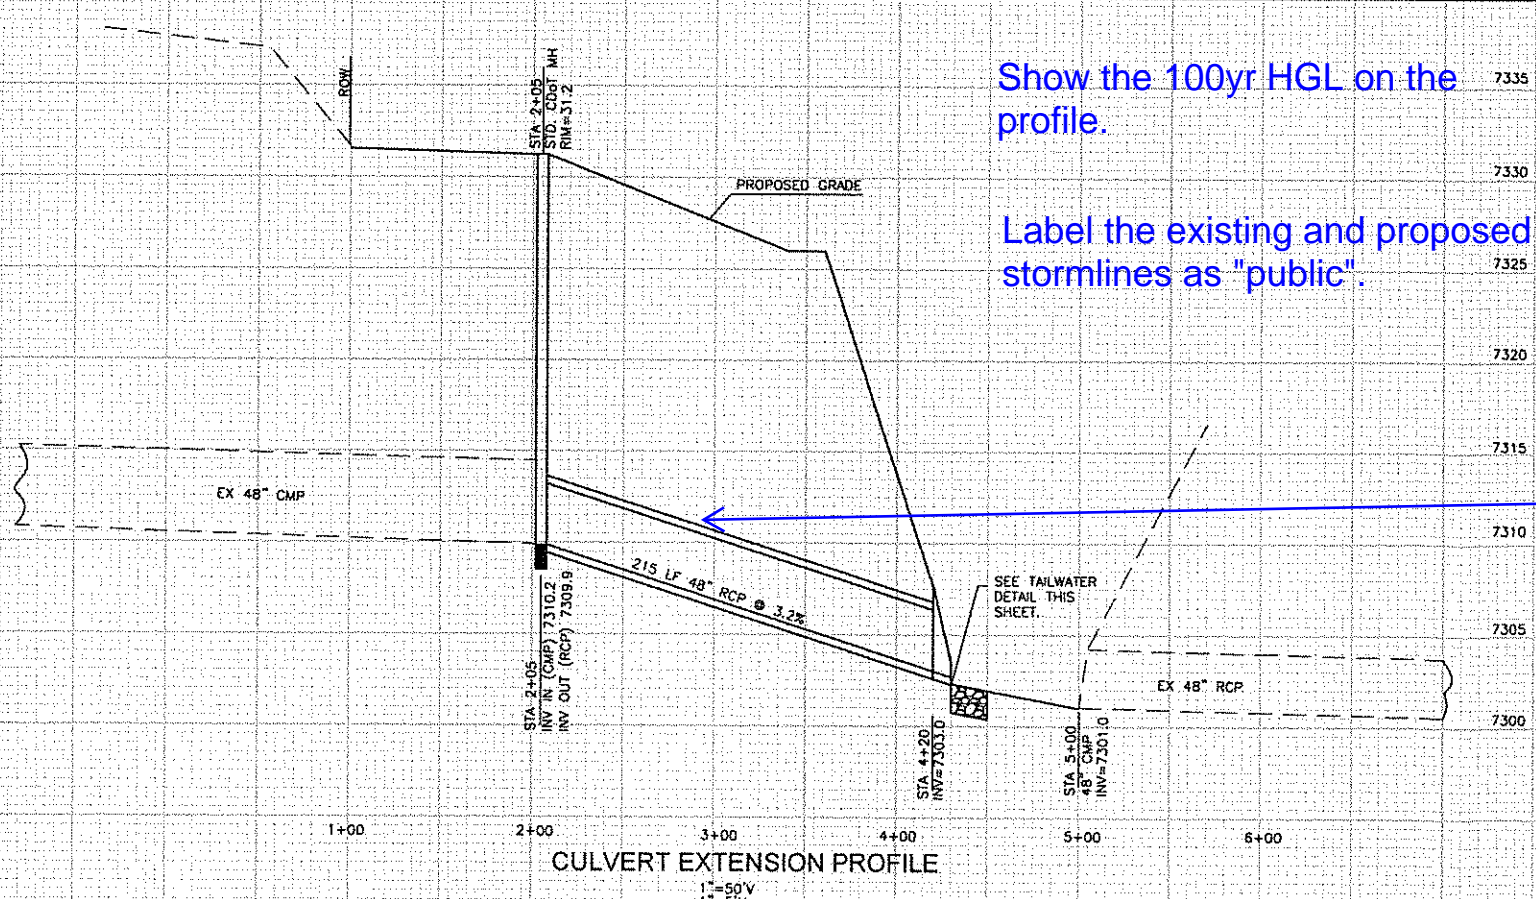

- Since the depth of cover exceeds 15 feet the service life for the storm sewer shall be increased to 100 years.
1. Callout the specific class and wall thickness that meets the 100 year service life.
 2. Add a note to provide the PCD Inspector with the product specifications verifying the material meets the 100 year service life.

Project No.:	14028
Date:	JULY 25, 2017
Design:	RNW
Drawn:	EAK
Check:	RNW
Revisions:	