KNOW ALL MEN BY THESE PRESENTS:

THAT MIDCO INVESTMENTS, LLC A COLORADO LIMITED LIABILITY COMPANY AND FOUNTAIN MUTUAL METROPOLITAN DISTRICT BEING THE OWNERS OF THE FOLLOWING DESCRIBED TRACTS OF LAND:

**LEGAL DESCRIPTION:** (SEE SURVEY NOTES 6 & 7)

PARCEL A (MIDCO INVESTMENTS, LLC PARCEL)

THE NORTH HALF OF THE NW 1/4 OF THE NW 1/4 OF SECTION 12, TOWNSHIP 15 SOUTH, RANGE 66 WEST OF THE 6TH P.M., EXCEPT THAT PORTION CONVEYED IN A WARRANTY DEED RECORDED NOVEMBER 25, 1959 N BOOK 1779 AT PAGE 409 AND EXCEPTING THAT PORTION CONVEYED IN A WARRANTY DEED RECORDED JUNE 21, 1988 IN BOOK 5522, PAGE 19 OF THE CLERK AND RECORDERS OFFICE OF THE COUNTY OF EL PASO, STATE OF COLORADO AND EXCEPT THAT PORTION LYING WITHIN THE EXISTING RIGHT OF WAY OF FORMER BRADLEY ROAD, NOW DESIGNATED AS CABLE LANE, COUNTY OF EL PASO, STATE OF COLORADO.

PARCEL B (FOUNTAIN MUTUAL METROPOLITAN DISTRICT PARCEL)

A PORTION OF THAT PARCEL OF LAND AS DESCRIBED IN THAT SPECIAL WARRANTY DEED RECORDED AT RECEPTION NO. 201078268 OF THE CLERK AND RECORDERS OFFICE OF THE COUNTY OF EL PASO, STATE OF COLORADO.

THE ABOVE-DESCRIBED PARCELS OF LAND BEING MORE PARTICULARLY DESCRIBED AS FOLLOWS:

COMMENCING AT THE NORTHWEST CORNER OF SAID SECTION 12 AND CONSIDERING THE NORTH LINE OF THE NW 1/4 OF THE NW 1/4 OF SECTION 12 TO BEAR S89'44'12"E, 1058.43 FEET, WITH ALL BEARINGS CONTAINED HEREIN RELATIVE THERETO. SAID LINE MONUMENTED AT THE WESTERLY TERMINUS BY A FOUND 2.5" ALUMINUM PIPE WITH A 3.25" ALUMINUM CAP STAMPED "T16S R66W 2 1 11 12 1995 RMLS NO. 19625" AND AT THE EASTERLY TERMINUS BY A FOUND #4 REBAR WITH A 1" YELLOW PLASTIC CAP STAMPED

"WKC & ASSOC PLS 14611"; THENCE ALONG SAID NORTH LINE, S89'44'12"E, 539.85 FEET TO THE TRUE POINT OF BEGINNING; THENCE CONTINUING ALONG THE NORTH LINE OF SAID NW 1/4 OF THE NW 1/4, S89'44'12"E, 518.58 FEET TO THE SOUTHERLY RIGHT-OF-WAY LINE OF CABLE LANE; THENCE ALONG SAID SOUTHERLY RIGHT-OF-WAY LINE THE FOLLOWING FOUR (4) COURSES:

- 1) S70°41'33"E, 58.84 FEET;
- 2) S60°02'56"E, 241.03 FEET TO A POINT OF CURVE TO THE RIGHT;

3) 211.27 FEET ALONG THE ARC OF SAID CURVE TO THE RIGHT, SAID ARC HAVING A RADIUS OF 203.92 FEET, A CENTRAL ANGLE OF 59'21'44", AND BEING SUBTENDED BY A CHORD BEARING S30'20'58"E, 201.95 FEET;

4) S00°40'06"E, 18.98 FEET TO THE NORTHEAST CORNER OF LOT 43 OF PHEASANT RUN RANCH FILING NO. THE PLAT THEREOF RECORDED IN PLAT BOOK X3 AT PAGE 18 OF THE RECORDS OF THE COUNTY OF EL PASO. STATE OF COLORADO;

THENCE ALONG THE NORTH LINE OF SAID LOT 43, S89'19'54"W, 100.00 FEET TO THE WEST LINE OF SAID PHEASANT RUN RANCH FILING NO. 1,

THENCE ALONG SAID WEST LINE SO0'40'06"E, 324.99 FEET TO THE NORTH LINE OF SAID PHEASANT RUN RANCH FILING NO. 1 AND THE NORTHEAST CORNER OF LOT 37 OF PHEASANT RUN RANCH FILING NO. 1; THENCE ALONG SAID NORTH LINE OF PHEASANT RUN RANCH FILING NO. 1 AND ALONG THE NORTH LINE OF THE "SUBDIVISION OF TRACT NO. 1 REFILING OF THE SECURITY, COLORADO ADDITION NO. 4 EL PASO COUNTY, COLORADO", THE PLAT THEREOF RECORDED IN PLAT BOOK Z AT PAGE 76 OF THE RECORDS OF THE COUNTY OF EL PASO, STATE OF COLORADO, S89'58'19"W, 779.82 FEET TO THE EAST LINE OF THAT TRACT OF LAND AS DESCRIBED IN BOOK 1779 AT PAGE 409 OF THE RECORDS OF THE COUNTY OF EL PASO, STATE OF COLORADO;

THENCE ALONG SAID EAST LINE NO0°47'43"W, 662.00 FEET TO THE TRUE POINT OF BEGINNING

THE ABOVE-DESCRIBED TRACT OF LAND CONTAINS 11.767 ACRES OR 512,560 SQUARE FEET, MORE OR LESS.

### OWNERS CERTIFICATE:

THE UNDERSIGNED, BEING ALL THE OWNERS, MORTGAGEES, BENEFICIARIES OF DEEDS OF TRUST AND HOLDERS OF OTHER INTERESTS IN THE LAND DESCRIBED HEREIN, HAVE LAID OUT, SUBDIVIDED, AND PLATTED SAID LANDS INTO LOTS, TRACTS AND EASEMENTS FOR PUBLIC IMPROVEMENTS, UTILITIES AND DRAINAGE PURPOSES AS SHOWN OR NOTED HEREON UNDER THE NAME AND SUBDIVISION OF "HAVEN VALLEY". ALL PUBLIC IMPROVEMENTS SO PLATTED ARE HEREBY DEDICATED TO PUBLIC USE AND SAID OWNER DOES HEREBY COVENANT AND AGREE THAT THE PUBLIC IMPROVEMENTS WILL BE CONSTRUCTED TO EL PASO COUNTY STANDARDS AND THAT PROPER DRAINAGE AND EROSION CONTROL FOR SAME WILL BE PROVIDED AT SAID OWNER'S EXPENSE. ALL TO THE SATISFACTION OF THE BOARD OF COUNTY COMMISSIONERS OF EL PASO COUNTY, COLORADO. UPON ACCEPTANCE BY RESOLUTION, ALL PUBLIC IMPROVEMENTS SO DEDICATED WILL BECOME MATTERS OF MAINTENANCE BY EL PASO COUNTY, COLORADO. THE UTILITY EASEMENTS SHOWN HEREON ARE HEREBY DEDICATED FOR PUBLIC UTILITIES AND COMMUNICATION SYSTEMS AND OTHER PURPOSES AS SHOWN HEREON. THE ENTITIES RESPONSIBLE FOR PROVIDING THE SERVICES FOR WHICH THE EASEMENTS ARE ESTABLISHED ARE HEREBY GRANTED THE PERPETUAL RIGHT OF INGRESS AND EGRESS FROM AND TO ADJACENT PROPERTIES FOR INSTALLATION, MAINTENANCE, AND REPLACEMENT OF UTILITY LINES AND RELATED FACILITIES.

IN WITNESS THEREOF: MIDCO INVESTMENTS, LLC A COLORADO LIMITED LIABILITY COMPANY, HAS CAUSED THESE PRESENTS TO BE EXECUTED THIS \_\_\_\_\_ DAY OF \_\_\_\_\_, 2024.

ΒY	:									
	AS	MANAG	<b>E</b> R							
	OF	MIDCO	INVEST	MENTS,	LLC	А	COLORADO	LIMITED	LIABILITY	COMPANY.

ACKNOWLEDGMENT

STATE OF

COUNTY OF

THIS INSTRUMENT WAS ACKNOWLEDGED BEFORE ME THIS\_\_\_\_\_DAY OF\_\_\_\_\_ . 2024 BY \_\_\_\_\_ \_\_\_\_\_ AS MANAGER OF MIDCO INVESTMENTS, LLC A COLORADO LIMITED

LIABILITY COMPANY.

WITNESS MY HAND AND OFFICIAL SEAL:

NOTARY PUBLIC

MY COMMISSION EXPIRES:

## SURVEY NOTES:

- OF THE CERTIFICATION SHOWN HEREON".
- IS MONUMENTED AS SHOWN HEREON.
- EASEMENTS OF RECORD.
- §18-4-508.

- ON BEHALF OF DREXEL BARRELL & Co.
- WARRANTY DEED AS PARCELS B AND C.

## PLAT NOTES:

- REPORT AND NATURAL FEATURES REPORT.
- DISTRICT BY SEPARATE DOCUMENT.
- DRAINAGE IMPROVEMENTS WITHIN THE TRACTS.
- HAVEN VALLEY METROPOLITAN DISTRICT.
- CHOOSES. THIS IS NOT A REQUIREMENT.
- SERVICE REGULATIONS.
- FOR SALE, CONVEYANCE OR TRANSFER.

THIS PLAT RESTRICTION MAY BE REMOVED OR RESCINDED BY THE BOARD OF COUNTY COMMISSIONERS OR, IF PERMITTED BY THE SUBDIVISION IMPROVEMENTS AGREEMENT. BY THE PLANNING AND COMMUNITY DEVELOPMENT DEPARTMENT DIRECTOR UPON EITHER APPROVAL OF AN ALTERNATIVE FORM OF COLLATERAL OR COMPLETION AND PRELIMINARY ACCEPTANCE BY THE EL PASO BOARD OF COUNTY COMMISSIONERS OF ALL IMPROVEMENTS REQUIRED TO BE CONSTRUCTED IN ACCORDANCE WITH SAID SUBDIVISION IMPROVEMENTS AGREEMENT. THE PARTIAL RELEASE OF LOTS FOR SALE, CONVEYANCE OR TRANSFER MAY ONLY BE GRANTED IN ACCORDANCE WITH ANY PLANNED PARTIAL RELEASE OF LOTS AUTHORIZED BY THE SUBDIVISION IMPROVEMENTS AGREEMENT.

IN WITNESS THEREOF:
FOUNTAIN MUTUAL METROPOL
EXECUTED THIS DA
BY:
AS MANAGER
OF FOUNTAIN MUTUAL METRO
ACKNOWLEDGMENT
STATE OF
COUNTY OF
THIS INSTRUMENT WAS ACK
BY
D'
WITNESS MY HAND AND

NOTARY PUBLIC

# HAVEN VALLEY SUBDIVISION

A SUBDIVISION OF LAND LOCATED IN THE NORTHWEST 1/4 OF SECTION 12, TOWNSHIP 15 SOUTH, RANGE 66 WEST OF THE SIXTH PRINCIPAL MERIDIAN, COUNTY OF EL PASO, STATE OF COLORADO AREA =11.767 ACRES MORE OR LESS

### 1. "NOTICE: ACCORDING TO COLORADO LAW YOU MUST COMMENCE ANY LEGAL ACTION BASED UPON ANY DEFECT IN THIS SURVEY WITHIN THREE YEARS AFTER YOU FIRST DISCOVER SUCH DEFECT. IN NO EVENT, MAY ANY ACTION BASED UPON ANY DEFECT IN THIS SURVEY BE COMMENCED MORE THAN TEN YEARS FROM THE DATE

2. THE BEARINGS AS SHOWN HEREON ARE BASED UPON THE CONSIDERATION THAT THE NORTH LINE OF THE NW1/4 OF THE NW1/4 OF SECTION 12, TOWNSHIP 16 SOUTH, RANGE 66 WEST OF THE SIXTH P.M. HAVING A BEARING OF SOUTH 89'44'12" EAST, BEING A GRID BEARING OF THE COLORADO STATE PLAIN COORDINATE SYSTEM, CENTRAL ZONE, DERIVED FROM RTK GPS OBSERVATIONS OF 180 EPOCHS, ON 1/21/2021, SAID LINE

3. THE LINEAL UNIT OF MEASURE IS THE U.S. SURVEY FOOT. ALL DISTANCES AND BEARINGS BETWEEN SET AND FOUND MONUMENTS ARE AS MEASURED UNLESS OTHERWISE NOTED. THE TOTAL AREA OF THE SUBDIVISION IS BASED ON THE MEASURED DIMENSIONS AS SHOWN HEREON

4. THE UNDERSIGNED HAS RELIED UPON COMMONWEALTH LAND TITLE INSURANCE COMPANY. COMMITMENT NO.. HS0824072, COMMITMENT DATE OF SEPTEMBER 14, 2023 AT 8:00 A.M., FOR OWNERSHIP AND FOR THE PURPOSE OF SHOWING RECORDED EASEMENTS AND RIGHTS-OF-WAY ACROSS SAID PREMISES. THE SURVEY DOES NOT CONSTITUTE A TITLE SEARCH BY DREXEL, BARRELL & CO. TO DETERMINE OWNERSHIP AND

5. ANY PERSON WHO KNOWINGLY REMOVES, ALTERS OR DEFACES ANY PUBLIC LAND SURVEY MONUMENT OR LAND BOUNDARY MONUMENT OR ACCESSORY COMMITS A CLASS TWO (2) MISDEMEANOR PURSUANT TO C.R.S.

6. THE PARCEL "A" DESCRIPTION HEREON IS THE SAME AS THAT "PARCEL A" AS DESCRIBED IN RECEPTION NO. 21213859 OF THE RECORDS OF EL PASO COUNTY AND THE ABOVE TITLE COMMITMENT.

7. THE PARCEL B DESCRIPTION HEREON IS THAT PORTION OF THE LAND DESCRIBED IN EXHIBIT A OF RECEPTION NO. 201078268. SAID PORTION LYING NORTH OF LOT 43. PHEASANT RUN RANCH FILING NO. 1 AND SOUTHWEST OF THE THE WESTERLY RIGHT-OF-WAY LINE OF CABLE LANE AS DESCRIBED IN THAT DOCUMENT RECORDED AT RECEPTION NUMBER 202228876 OF THE RECORDS OF EL PASO COUNTY.

8. THE "...MORE PARTICULARLY DESCRIBED ... " PORTION WAS PREPARED BY JOHN C. DAY, PLS 29413 FOR AND

9. THESE ARE APPURTENANT EASEMENTS PER THE ABOVE TITLE COMMITMENT AND THAT SPECIAL WARRANTY DEED RECORDED AT RECEPTION NO. 21213859 OF THE RECORDS OF EL PASO COUNTY. REFERRED TO IN SAID

1. THE FOLLOWING REPORTS HAVE BEEN SUBMITTED WITH THE PRELIMINARY PLAN FOR THIS SUBDIVISION AND ARE ON FILE AT THE COUNTY PLANNING AND COMMUNITY DEVELOPMENT DEPARTMENT: TRANSPORTATION IMPACT STUDY, DRAINAGE REPORT, WATER RESOURCES REPORT, WASTEWATER DISPOSAL REPORT, GEOLOGY AND SOILS

2. NO LOTS WILL HAVE DIRECT ACCESS PERMITTED TO CABLE LANE.

3. ALL PROPERTY OWNERS ARE RESPONSIBLE FOR MAINTAINING PROPER STORM WATER DRAINAGE IN AND THROUGH THEIR PROPERTY. PRIVATE DRAINAGE EASEMENTS AS SPECIFICALLY NOTED ON THE PLAT SHALL BE MAINTAINED BY THE INDIVIDUAL LOT OWNERS UNLESS OTHERWISE NOTED. STRUCTURES, FENCES, MATERIALS, OR LANDSCAPING THAT COULD IMPEDE THE FLOW OF RUNOFF SHALL NOT BE PLACED IN DRAINAGE EASEMENTS.

4. PRIVATE DRAINAGE EASEMENTS TO BE DEDICATED TO THE HAVEN VALLEY HOA OR HAVEN VALLEY METROPOLITAN

5. TRACTS A, B & C SHALL BE UTILIZED AS PRIVATE DRAINAGE, PUBLIC UTILITY, SIDEWALK AND LANDSCAPE TRACTS. OWNERSHIP OF THESE TRACTS SHALL BE DEEDED TO THE HAVEN VALLEY HOA OR HAVEN VALLEY METROPOLITAN DISTRICT BY SEPARATE DOCUMENT. MAINTENANCE OF TRACTS A, B, & C SHALL BE BY HAVEN VALLEY HOA OR HAVEN VALLEY METROPOLITAN DISTRICT AFTER PRELIMINARY ACCEPTANCE OF THE CONSTRUCTED

6. TRACT D SHALL BE UTILIZED AS PRIVATE DRAINAGE, PUBLIC UTILITY, SIDEWALK AND LANDSCAPE TRACT. TRACT D TO BE OWNED BY FOUNTAIN MUTUAL METROPOLITAN DISTRICT AND MAINTAINED BY HAVEN VALLEY HOA OR

7. EL PASO COUNTY PARKS RECOMMEND A SMALL POCKET PARK IN TRACT C OR D. IF THE DEVELOPER SO

8. NOTICE THIS PROPERTY WILL BE INCLUDED WITHIN A SPECIAL TAXING DISTRICT, FOUNTAIN MUTUAL METROPOLITAN DISTRICT, CREATED FOR THE PURPOSE OF CONSTRUCTING AND MAINTAINING CERTAIN DRAINAGE AND PARK AND RECREATION IMPROVEMENTS. SPECIAL TAXING DISTRICTS ARE SUBJECT TO A GENERAL OBLIGATION INDEBTEDNESS THAT IS PAID BE REVENUES PRODUCED FROM ANNUAL TAX LEVIES ON THE TAXABLE PROPERTY WITHIN SUCH DISTRICTS. THE BUYER SHOULD FAMILIARIZE HIMSELF/HERSELF WITH THIS POTENTIALITY AND RAMIFICATIONS

9. MAILBOXES SHALL BE INSTALLED IN ACCORDANCE WITH ALL EL PASO COUNTY AND UNITED STATE POSTAL

10. NO LOT OR INTEREST THEREIN, SHALL BE SOLD. CONVEYED. OR TRANSFERRED WHETHER BY DEED OR BY CONTRACT, NOR SHALL BUILDING PERMITS BE ISSUED, UNTIL AND UNLESS EITHER THE REQUIRED PUBLIC AND COMMON DEVELOPMENTS HAVE BEEN CONSTRUCTED AND COMPLETED AND PRELIMINARILY ACCEPTED IN ACCORDANCE WITH THE SUBDIVISION IMPROVEMENTS AGREEMENT BETWEEN THE APPLICANT/OWNER AND EL PASO COUNTY AS RECORDED IN UNDER RECEPTION NO. \_\_\_\_\_\_ IN THE OFFICE OF THE CLERK AND RECORDER OF EL PASO COUNTY, COLORADO OR, IN THE ALTERNATIVE, OTHER COLLATERAL IS PROVIDED TO MAKE PROVISION FOR THE COMPLETION OF SAID IMPROVEMENTS IN ACCORDANCE WITH THE EL PASO COUNTY LAND DEVELOPMENT CODE AND ENGINEERING CRITERIA MANUAL. ANY SUCH ALTERNATIVE COLLATERAL MUST BE APPROVED BY THE BOARD OF COUNTY COMMISSIONERS OR, IF PERMITTED BY THE SUBDIVISION IMPROVEMENTS AGREEMENT. BY THE PLANNING AND COMMUNITY DEVELOPMENT DEPARTMENT DIRECTOR AND MEET THE POLICY AND PROCEDURE REQUIREMENTS OF EL PASO COUNTY PRIOR TO THE RELEASE BY THE COUNTY OF ANY LOTS

> LITAN DISTRICT, HAS CAUSED THESE PRESENTS TO BE AY OF\_\_\_\_\_, 2024.

OPOLITAN DISTRICT, HAS CAUSED THESE PRESENTS TO BE

(NOWLEDGED BEFORE ME THIS \_\_\_\_\_ DAY OF \_\_\_\_\_ , 2024 AS MANAGER OF FOUNTAIN MUTUAL METROPOLITAN DISTRICT.

OFFICIAL SEAL:

MY COMMISSION EXPIRES:

# PLAT NOTES CONTINUED:

11. GEOLOGIC HAZARD NOTE: THE FOLLOWING LOTS HAVE BEEN FOUND TO BE IMPACTED BY GEOLOGIC HAZARDS. MITIGATION MEASURES AND A MAP OF THE HAZARD AREA CAN BE IN THE GEOLOGIC HAZARD EVALUATION AND DUE DILIGENCE GEOTECHNICAL INVESTIGATIO PREPARED BY CTL THOMPSON INC, DATED OCTOBER 8, 2019 AND REVISED AUGUST 5, AND IS HELD IN THE HAVEN VALLEY PUD PRELIMINARY PLAN FILE (PUDSP217) AT THE COUNTY PLANNING AND COMMUNITY DEVELOPMENT DEPARTMENT.

-ARTIFICIAL/UNDOCUMENTED FILL LOTS: 17-21, 35-38, 44-41, 55-70 AND 91-96 THESE CONDITIONS CAN BE MITIGATED BY REGRADING. PROPERLY ENGINEERED FOUNDATI AND RECOGNIZED CONSTRUCTION TECHNIQUES. UNDOCUMENTED FILL SHOULD BE REMOVE REWORKED OR REPLACED. DESIGN-LEVEL GEOTECHNICAL STUDIES SHOULD BE UNDERTAK CONFIRM THE PRESENCE OF FILL AND DEPTH OF FILL AND TO PROVIDE RECOMMENDATIO REWORKING. NO BASEMENTS WILL BE PERMITTED.

12. THE ADDRESSES EXHIBITED ON THIS PLAT ARE FOR INFORMATIONAL PURPOSES ONLY. ARE NOT THE LEGAL DESCRIPTION AND ARE SUBJECT TO CHANGE.

- 13. THE NUMBER OF LOTS HEREBY PLATTED ARE 98. THE NUMBER OF TRACTS ARE 4.
- 14. ALL PROPERTY WITHIN THIS SUBDIVISION IS SUBJECT TO A DECLARATION OF COVENANTS \_\_\_\_\_, OF THE RECORDS OF THE EL F RECORDED AT RECEPTION No.\_ COUNTY CLERK AND RECORDER.
- 15. DEVELOPER SHALL COMPLY WITH FEDERAL AND STATE LAWS, REGULATIONS, ORDINANCES REVIEW AND PERMIT REQUIREMENTS, IF ANY, OF APPLICABLE AGENCIES INCLUDING, BUT LIMITED TO, THE COLORADO DIVISION OF PARKS AND WILDLIFE, COLORADO DEPARTMENT TRANSPORTATION, U.S. ARMY CORPS OF ENGINEERS AND THE U.S. FISH AND WILDLIFE S REGARDING THE ENDANGERED SPECIES ACT, PARTICULARLY AS IT RELATES TO THE LIST SPECIES (e.g., PREBLE'S MEADOW JUMPING MOUSE).
- 16. ALL EASEMENTS SHOWN OR DEDICATED HEREON FOR PUBLIC UTILITY PURPOSES SHALL I SUBJECT TO THOSE TERMS AND CONDITIONS AS SPECIFIED IN THE INSTRUMENT RECORDE RECEPTION NO. 212112548 OF THE RECORDS OF EL PASO COUNTY, COLORADO. ALL OTH EASEMENTS OR INTERESTS OF RECORD AFFECTING ANY OF THE PLATTED PROPERTY DEP HEREON SHALL NOT BE AFFECTED AND SHALL REMAIN IN FULL FORCE AND EFFECT.
- 17. THE SIGHT TRIANGLES AS SHOWN HEREON ARE NON-EXCLUSIVE SIGHT VISIBILITY EASEME DEDICATED TO EL PASO COUNTY COUNTY. NO OBSTRUCTIONS GREATER THAN 30 INCHES FLOWLINE ELEVATION ARE ALLOWED IN THE SIGHT VISIBILITY EASEMENTS. MAINTENANCE SIGHT VISIBILITY EASEMENTS SHALL BE THE RESPONSIBILITY OF THE PROPERTY OWNER ( HAVEN VALLEY HOA OR HAVEN VALLEY METROPOLITAN DISTRICT.
- 18. THE RETAINING WALL EASEMENTS AS SHOWN ON THIS PLAT WILL BE MAINTAINED BY THE VALLEY HOA OR HAVEN VALLEY METROPOLITAN DISTRICT.
- 19. THE PRIVATE ROADS AS SHOWN ON THIS PLAT WILL NOT BE MAINTAINED BY EL PASO ( UNTIL AND UNLESS THE ROADS ARE CONSTRUCTED IN CONFORMANCE WITH EL PASO COL STANDARDS IN EFFECT AT THE DATE OF THE REQUEST FOR DEDICATION AND MAINTENAN PRIVATE ROADS SHALL BE MAINTAINED BY THE HAVEN VALLEY HOA OR HAVEN VALLEY METROPOLITAN DISTRICT.
- 20. EL PASO COUNTY DOES NOT OWN AND IS NOT RESPONSIBLE FOR THE UNDERDRAINS OR GROUNDWATER DISCHARGE SYSTEMS PROVIDED WITHIN THIS SUBDIVISION AND ASSUMES LIABILITY FOR WATER RIGHTS ADMINISTRATION BY APPROVING THIS PLAT. MAINTENANCE WATER RIGHTS ARE THE RESPONSIBILITY OF THE DEVELOPER AND THE HAVEN VALLEY H HAVEN VALLEY METROPOLITAN DISTRICT.
- 21. THE SUBDIVIDER/DEVELOPER HAS FAMILIARIZED ITSELF WITH CURRENT AMERICANS WITH DISABILITIES ACT (ADA) LAWS AND ACCESSIBILITY STANDARDS AND HAS LAID OUT THE AND ASSOCIATED GRADING AND CONSTRUCTION PLANS SO THAT ALL SITE ELEMENTS ME APPLICABLE ADA DESIGN STANDARDS AS PUBLISHED BY THE UNITED STATES DEPARTMENT JUSTICE. APPROVAL OF THIS PLAT AND ASSOCIATED CONSTRUCTION DOCUMENTS BY EL COUNTY DOES NOT ASSURE COMPLIANCE WITH THE ADA OR ANY REGULATIONS OR GUID ENACTED OR PROMULGATED UNDER OR WITH RESPECT TO SUCH LAWS. IT IS THE RESPONSIBILITY OF THE DEVELOPER/HOME BUILDER TO ENSURE ADA ACCESSIBILITY DURI CONSTRUCTION OF THE PRIVATE SIDEWALKS.
- 22. THE SUBDIVIDER/DEVELOPER (OR SPECIFIC NAME) IS RESPONSIBLE FOR EXTENDING UTILIT EACH LOT, TRACT OR BUILDING SITE.
- 23. WATER AND WASTEWATER SERVICE IS PROVIDED BY SECURITY WATER & SANITATION DIST SUBJECT TO THE PROVIDERS RULES, REGULATIONS AND SPECIFICATIONS.
- 24. ELECTRIC AND GAS SERVICE FOR THIS SUBDIVISION IS PROVIDED BY, COLORADO SPRINGS UTILITIES, SUBJECT TO THE PROVIDERS RULES, REGULATIONS AND SPECIFICATIONS.
- 25. NOTICE OF POTENTIAL AIRCRAFT OVERFLIGHT AND NOISE IMPACT ASSOCIATED WITH AIRPO THIS SERVES AS NOTICE OF POTENTIAL AIRCRAFT OVERFLIGHT AND NOISE IMPACTS ON PROPERTY DUE TO ITS CLOSE PROXIMITY TO AN AIRPORT, WHICH IS BEING DISCLOSED T PROSPECTIVE PURCHASERS CONSIDERING THE USE OF THIS PROPERTY FOR RESIDENTIAL OTHER PURPOSES. THIS PROPERTY IS SUBJECT TO THE OVERFLIGHT AND ASSOCIATED N OF ARRIVING AND DEPARTING AIRCRAFT DURING THE COURSE OF NORMAL AIRPORT OPER.

ACCEPTANCE CERTIFICATE FOR TRACTS (ACCEPTING ENTITY IN EXISTANCI THE DEDICATION OF TRACTS A, B & C ARE HEREBY ACCEPTED FOR OWNERSHIP AND MAINT BY THE (NAME) DISTRICT/HOMEOWNER'S ASSOCIATION.

BY: NAME TITLE			
STATE OF COLORADO	)		
COUNTY OF	) ss )		
ACKNOWLEDGED BEFORE ME THIS BY AS	S	DAY OF	, 20


WITNESS MY HAND AND OFFICIAL SEAL:

NOTARY PUBLIC


MY COMMISSION EXPIRES:

ND ASO OR OR	this note will need to be updated to reflect that in addition to adding that ground water was present in 9 of 11 borings. proper measures should be taken for landscaping and irrigation
CE	Vicinity Map Scale: 1" = 1000'
T D DVE	SURVEYOR'S STATEMENT: I, JOHN C. DAY, A DULY REGISTERED PROFESSIONAL LAND SURVEYOR, LICENSED IN THE STATE OF COLORADO, DO HEREBY STATE THAT THIS PLAT TRULY AND CORRECTLY REPRESENTS THE RESULTS OF A SURVEY MADE ON 
ie Ven TY	BEEN PREPARED IN FULL COMPLIANCE WITH ALL APPLICABLE LAWS OF THE STATE OF COLORADO DEALING WITH MONUMENTS, SUBDIVISIONS. OR SURVEYING OF LAND AND ALL APPLICABLE PROVISIONS OF THE EL PASO COUNTY LAND DEVELOPMENT CODE. I ATTEST THE ABOVE ON THIS DAY OF, 20,
R	PLS NUMBER 29413 FOR AND BEHALF OF DREXEL BARRELL & CO.
0 5 70	PASO COUNTY PLANNING AND COMMUNITY DEVELOPMENT DEPARTMENT ON THIS DAY OF , 20, SUBJECT TO ANY NOTES SPECIFIED HEREON AND ANY CONDITIONS INCLUDED IN THE RECORD OF ADMINISTRATIVE ACTION. THE DEDICATIONS OF LAND TO THE PUBLIC FOR EASEMENTS FOR UTILITIES AND DRAINAGE ARE ACCEPTED, BUT PUBLIC IMPROVEMENTS THEREON WILL NOT BECOME MAINTENANCE
0 5 70	THIS PLAT FOR "HAVEN VALLEY" SUBDIVISION WAS APPROVED FOR FILING BY THE EXECUTIVE DIRECTOR OF THE PASO COUNTY PLANNING AND COMMUNITY DEVELOPMENT DEPARTMENT ON THIS DAY OF X0, SUBJECT TO ANY NOTES SPECIFIED HEREON AND ANY CONDITIONS INCLUDED IN THE RECORD OF ADMINISTRATIVE ACTION. THE DEDICATIONS OF LAND TO THE PUBLIC FOR EASEMENTS FOR UTILITIES
- О S ТО	THIS PLAT FOR "HAVEN VALLEY" SUBDIVISION WAS APPROVED FOR FILING BY THE EXECUTIVE DIRECTOR OF THE PASO COUNTY PLANNING AND COMMUNITY DEVELOPMENT DEPARTMENT ON THIS DAY OF
- OS TO - NS.	THIS PLAT FOR "HAVEN VALLEY" SUBDIVISION WAS APPROVED FOR FILING BY THE EXECUTIVE DIRECTOR OF THE PASO COUNTY PLANNING AND COMMUNITY DEVELOPMENT DEPARTMENT ON THIS DAY OF
HE FO S TO , L MS.	THIS PLAT FOR "HAVEN VALLEY" SUBDIVISION WAS APPROVED FOR FILING BY THE EXECUTIVE DIRECTOR OF THE PASO COUNTY PLANNING AND COMMUNITY DEVELOPMENT DEPARTMENT ON THIS

DREAEL, DARKELL  $\alpha$  UU. and Certificates Engineers • Surveyors Sheet 2 - Plat Graphic, Lots & Tracts 101 S. SAHWATCH ST. SUITE 100 COLORADO SPRINGS, COLORADO 80903 (719) 260-0887 Fax: (719) 260-8352 FILE NUMBER: SF2323 Job No. 21085-03

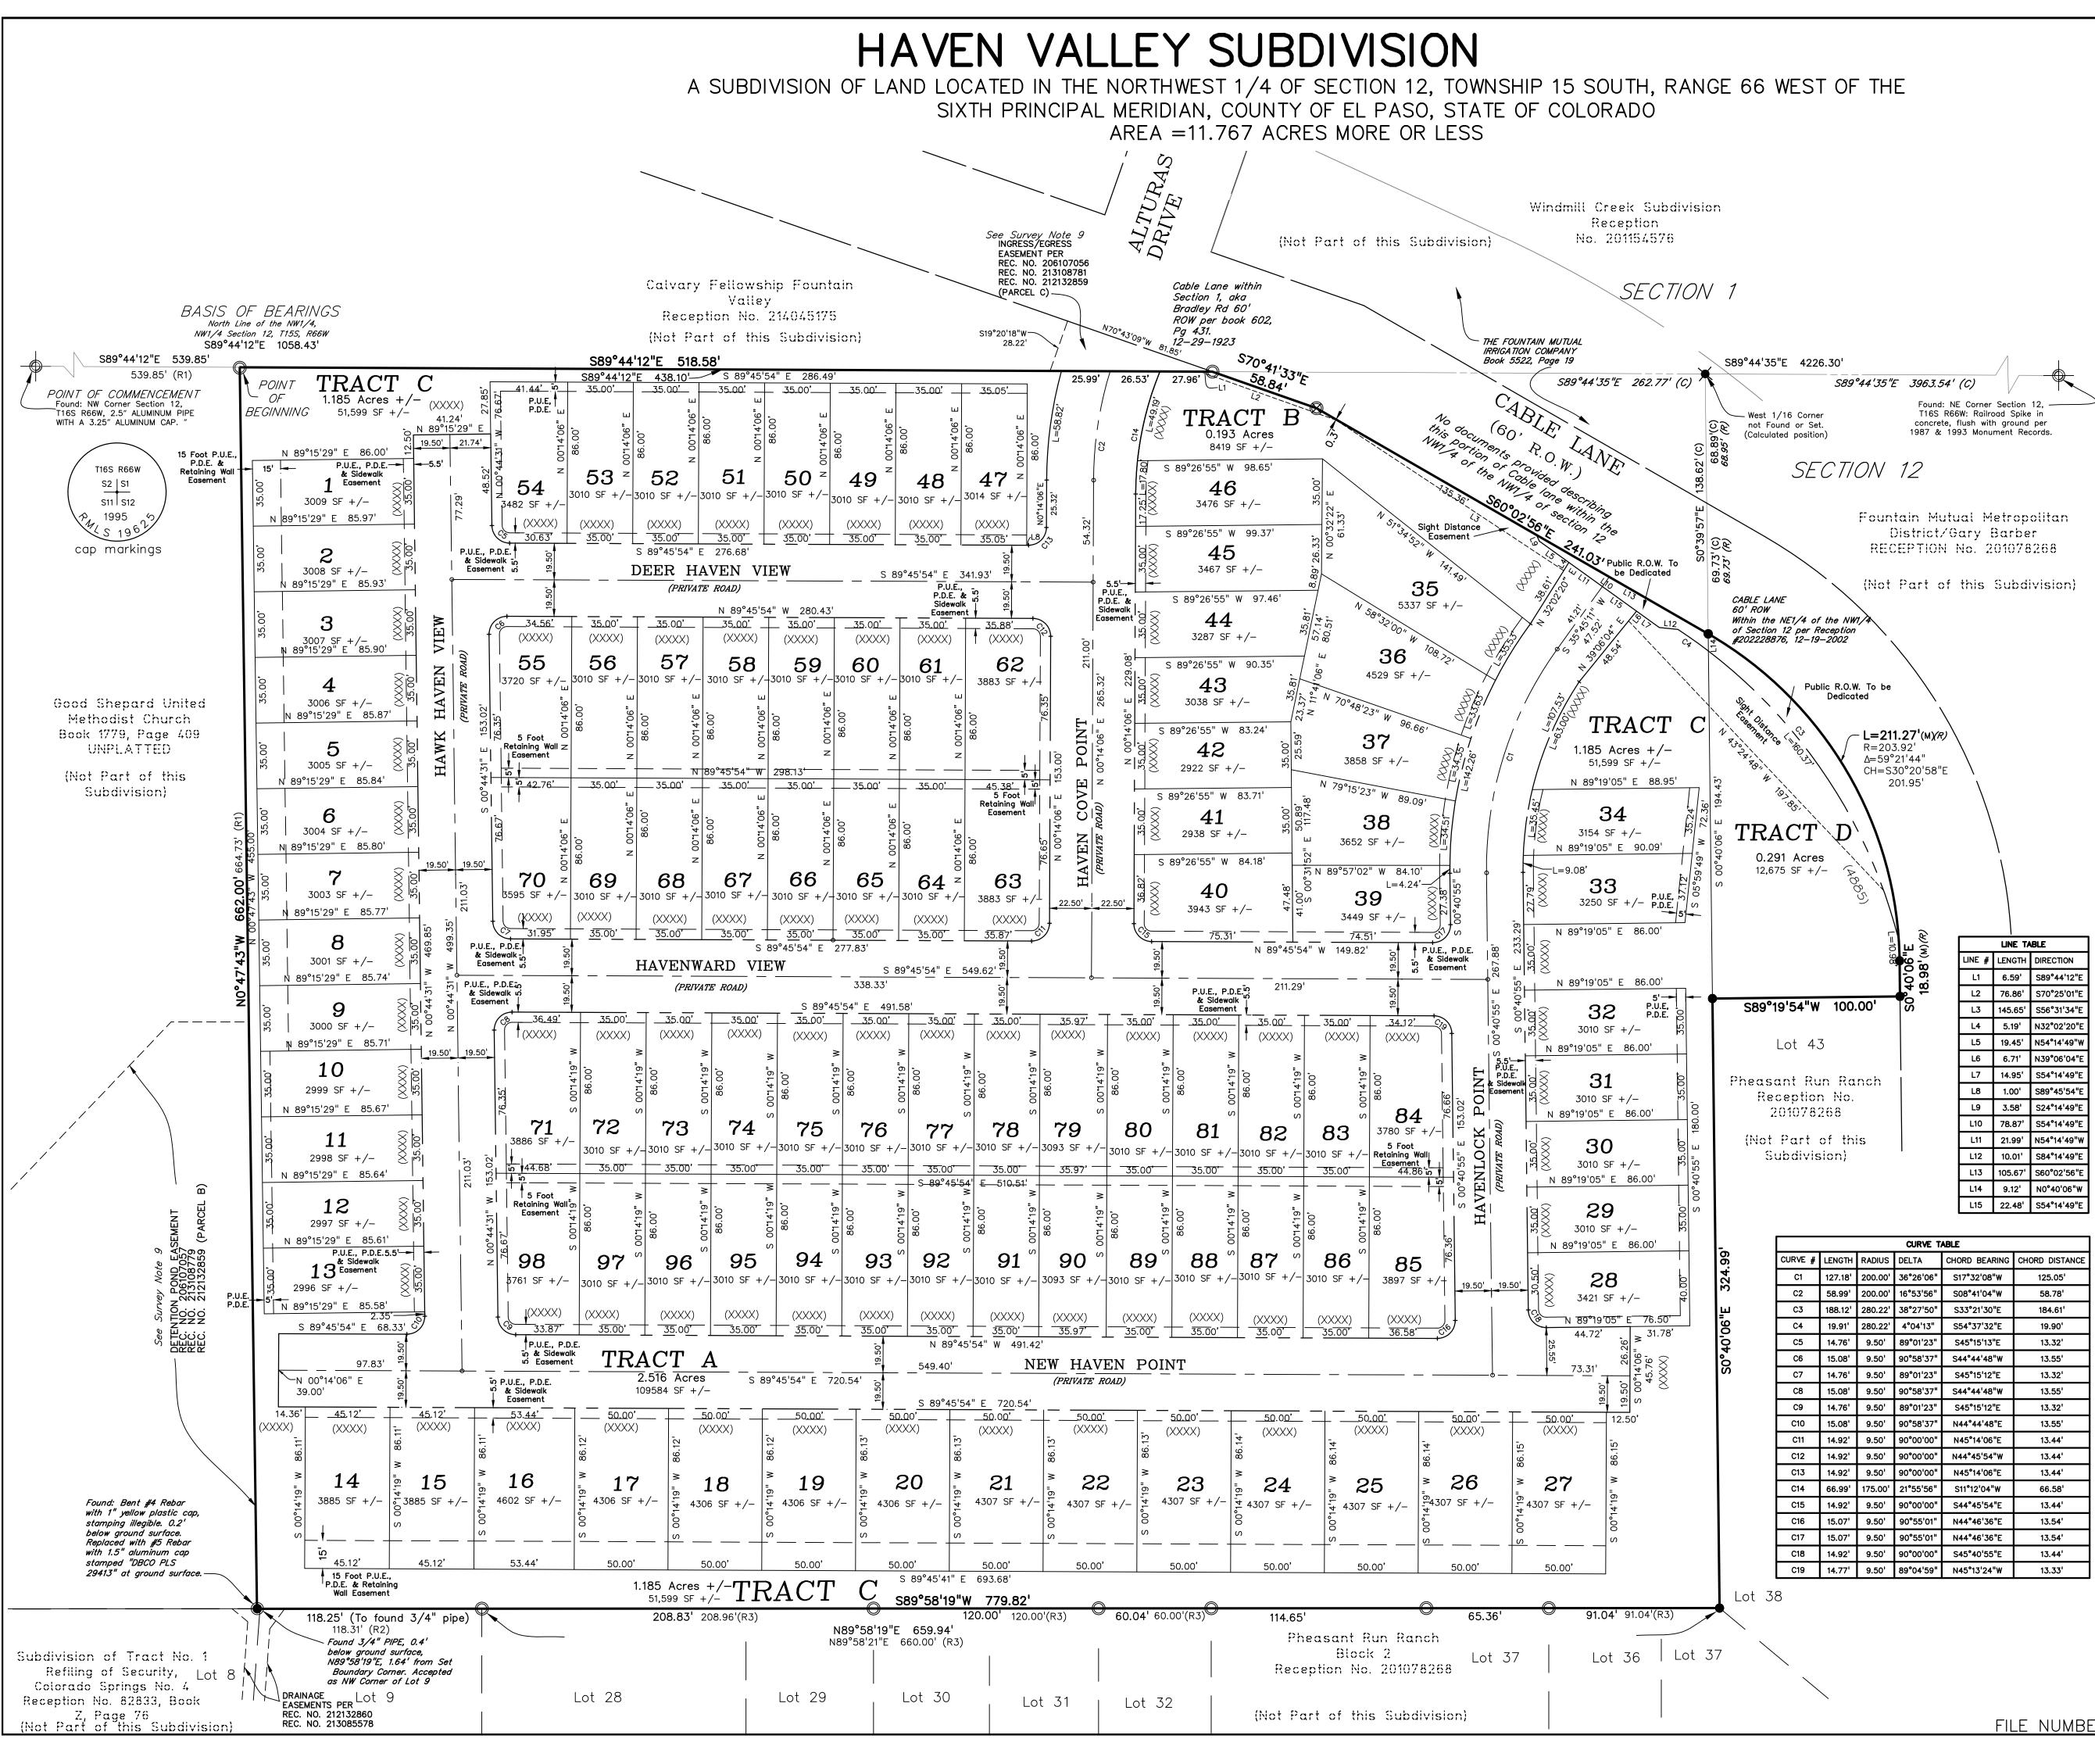

CURVE #	LENGTH	RADIUS	DELTA	CHORD BEARING	CHORD DISTANCE
C1	127.18'	200.00'	36°26'06"	S17°32'08"W	125.05'
C2	58.99'	200.00'	16°53'56"	S08°41'04"W	58.78'
C3	188.12'	280.22'	38°27'50"	S33°21'30"E	184.61'
C4	19.91'	280.22'	4°04'13"	S54°37'32"E	19.90'
C5	14.76'	9.50'	89°01'23"	S45°15'13"E	13.32'
C6	15.08'	9.50'	90°58'37"	S44°44'48"W	13.55'
C7	14.76'	9.50'	89°01'23"	S45°15'12"E	13.32'
C8	15.08'	9.50'	90°58'37"	S44°44'48"W	13.55'
C9	14.76'	9.50'	89°01'23"	S45°15'12"E	13.32'
C10	15.08'	9.50'	90°58'37"	N44°44'48"E	13.55'
C11	14.92'	9.50'	90°00'00"	N45°14'06"E	13.44'
C12	14.92'	9.50'	90°00'00"	N44°45'54"W	13.44'
C13	14.92'	9.50'	90°00'00"	N45°14'06"E	13.44'
C14	66.99'	175.00'	21°55'56"	S11°12'04"W	66.58'
C15	14.92'	9.50'	90°00'00"	S44°45'54"E	13.44'
C16	15.07'	9.50'	90°55'01"	N44°46'36"E	13.54'
C17	15.07'	9.50'	90°55'01"	N44°46'36"E	13.54'
C18	14.92'	9.50'	90°00'00"	S45°40'55"E	13.44'
C19	14.77'	9.50'	89°04'59"	N45°13'24"W	13.33'

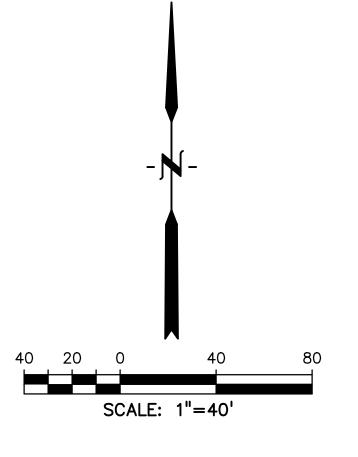

LEGEND	
ET #5 REBAR WITH 1.5" ALUMINUM CAP STAMPED "DBCO PLS 29413"	•
FOUND #4 REBAR WITH 1" YELLOW PLASTIC CAP STAMPED "WKC & ASSOC PLS 14611	Ø
<u>ACCEPTED AS BOUNDARY CORNER</u> A FOUND #4 REBAR WITH 1" YELLOW PLASTIC CAP STAMPED"WKC" (THE REST OF THE STAMF WAS ILLEGIBLE). N42°21'27"W, 0.23' FROM ACCEPTED BOUNDARY CORNER WAS FOUND #5 REBAR WITH 1.5" YELLOW PLASTIC CAP STAMPED "RM 19625"	PING
FOUND: BENT #4 REBAR WITH 1" YELLOW PLASTIC CAP, 0.2 BELOW GROUND SURFACE STAMPING ILLEGIBLE. REPLACED WITH #5 REBAR WITH 1.5" ALUMINUM CAP STAMPED "DBCO PLS 29413", AT GROUND SURFACE.	, ,
SECTION CORNER MONUMENT AS INDICATED	
CALCULATED POSITION, CORNER NOT SET,	×
RECORD DIMENSION: RECEPTION NUMBER	(R)
RECORD DIMENSION: BOOK 1779, PAGE 409 RECORD DIMENSION: SUBDIVISION OF TRACT PLAT BOOK Z, PAGE 76	(R1) 1, (R2)
RECORD DIMENSION: PHEASANT RUN RANCH FILING NO. 1, RECEPTION NUMBER 1173110.	(R3)
CALCULATED DIMENSION	(C)
RECEPTION NUMBER	Rec. No
PUBLIC UTILITY EASEMENT	P.U.E.
PRIVATE DRAINAGE EASEMENT	P.D.E.
PLUS OR MINUS (MORE OR LESS) RIGHT OF WAY	+/- R.O.W.
SQUARE FEET	SF
ASSIGNED STREET ADDRESS	(XXXX)
SITE TRIANGLE EASEMENTS	
PUBLIC UTILITY, PRIVATE DRAINAGE, SIDEWALK AND	
EXISTING EASEMENTS	
ROAD CENTERLINE	
EXISTING R.O.W.	
DEDICATED R.O.W.	
PRIVATE ROAD R.O.W	
SUBDIVISION BOUNDARY	
LOT LINES	
JULY 22 2024	SHEET 2

FILE NUMBER: SF2323 JOB NO. 21085-03

Engineers • Surveyors

101 S. SAHWATCH ST. SUITE 100

COLORADO SPRINGS, COLORADO 80903

(719) 260-0887 Fax: (719) 260-8352