


THIS IS NOT A LEGAL SURVEY, NOR IS IT INTENDED TO BE OR REPLACE ONE
This work product represents only generalized locations of
features, objects or boundaries and should not be relied upon
as being legally authoritative for the precise location of any
feature, object or boundary.



Please include:
Local Public 60' ROW

Burrows Rd

Property Line

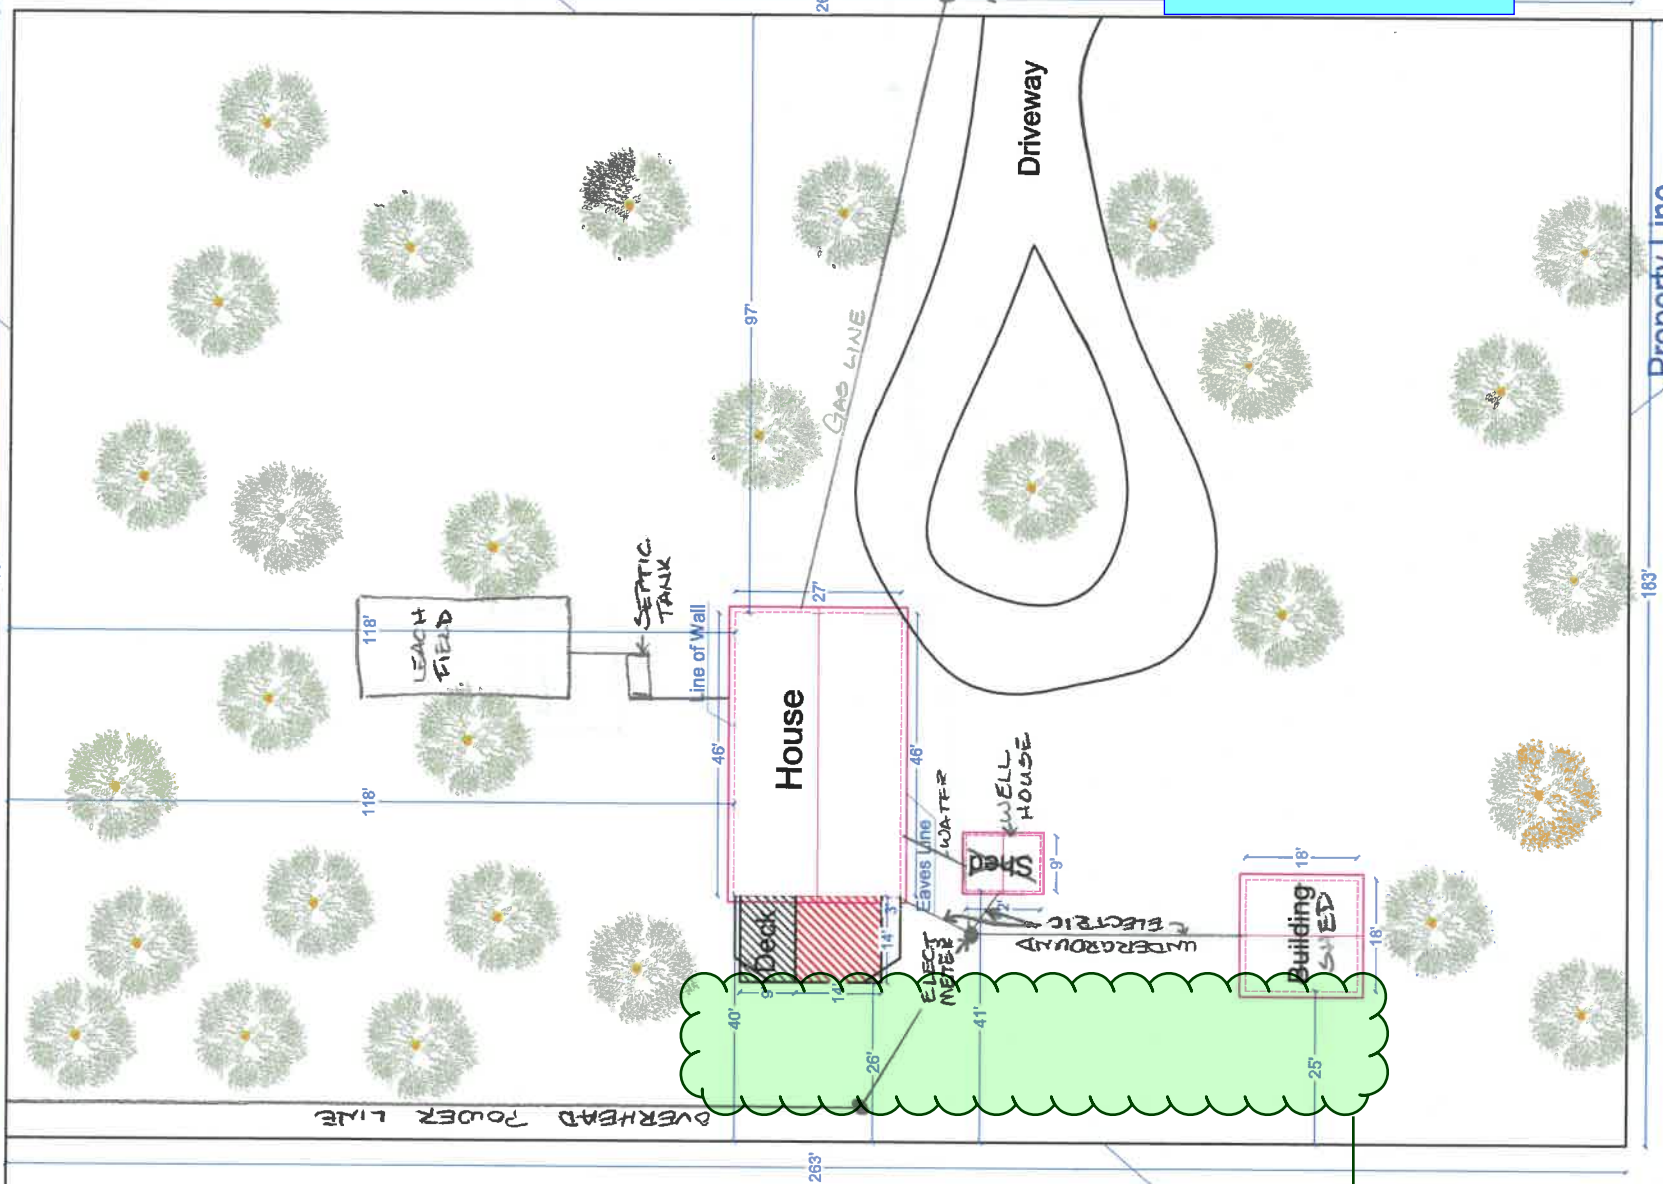

Please include:
Local Public 60' ROW

Drawing is no longer to
scale, please revise
drawing to be accurate.

Property Line

these measurements
seem to have shifted
by exactly 6 feet from
the 1st submittal. If
these are the true
measurement, this
will negate the
necessity of this
application. Please
confirm.

Plot Plan for:

Owner: LAFITTE, JEFFERSON W

Lot size: 1.12 AC

Submitted by:

Address: 11770 Ada Ln

Subdivision:

Scale: 1"=20'

Parcel/Locator: 5218000025

Add. Info: Lafitte_5050005761_CO Springs