



Scale	AS SHOWN	Drawn by TKK	Checked by RG	Date MAR 2021	DETENTION POND PLAN HAGLER RANCH REGIONAL DETENTION POND AS-BUILT			TECH CONTRACTORS 11886 STAPLETON DRIVE FALCON, CO 80831 TELEPHONE: 719.495.7444 FAX: 719.495.3349			Revisions			Date		
					No.			Date			Date					
					-			-			-					


MERIDIAN RANCH

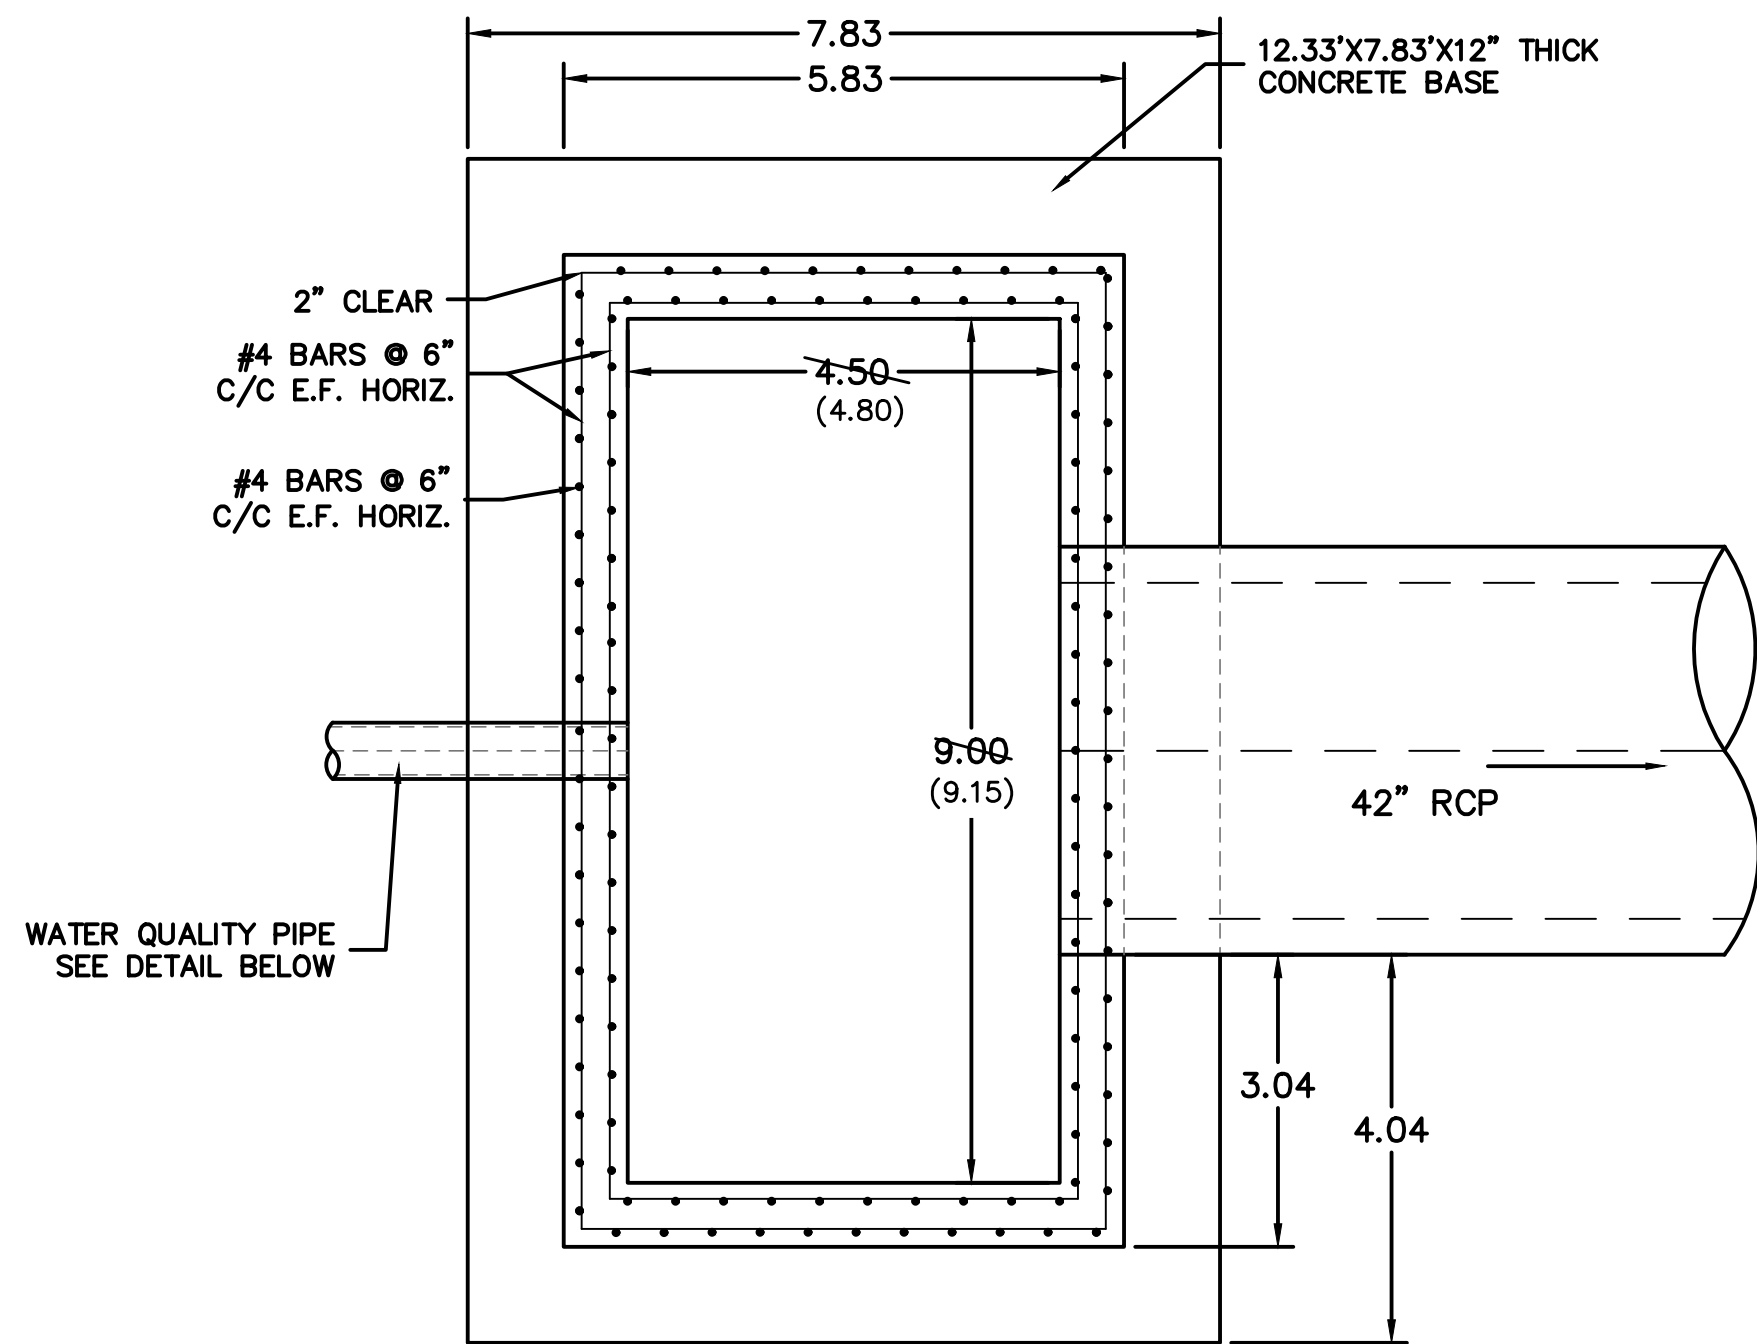


DETAIL 1.1
POND H
CONTROL STRUCTURE
PLAN VIEW
NTS

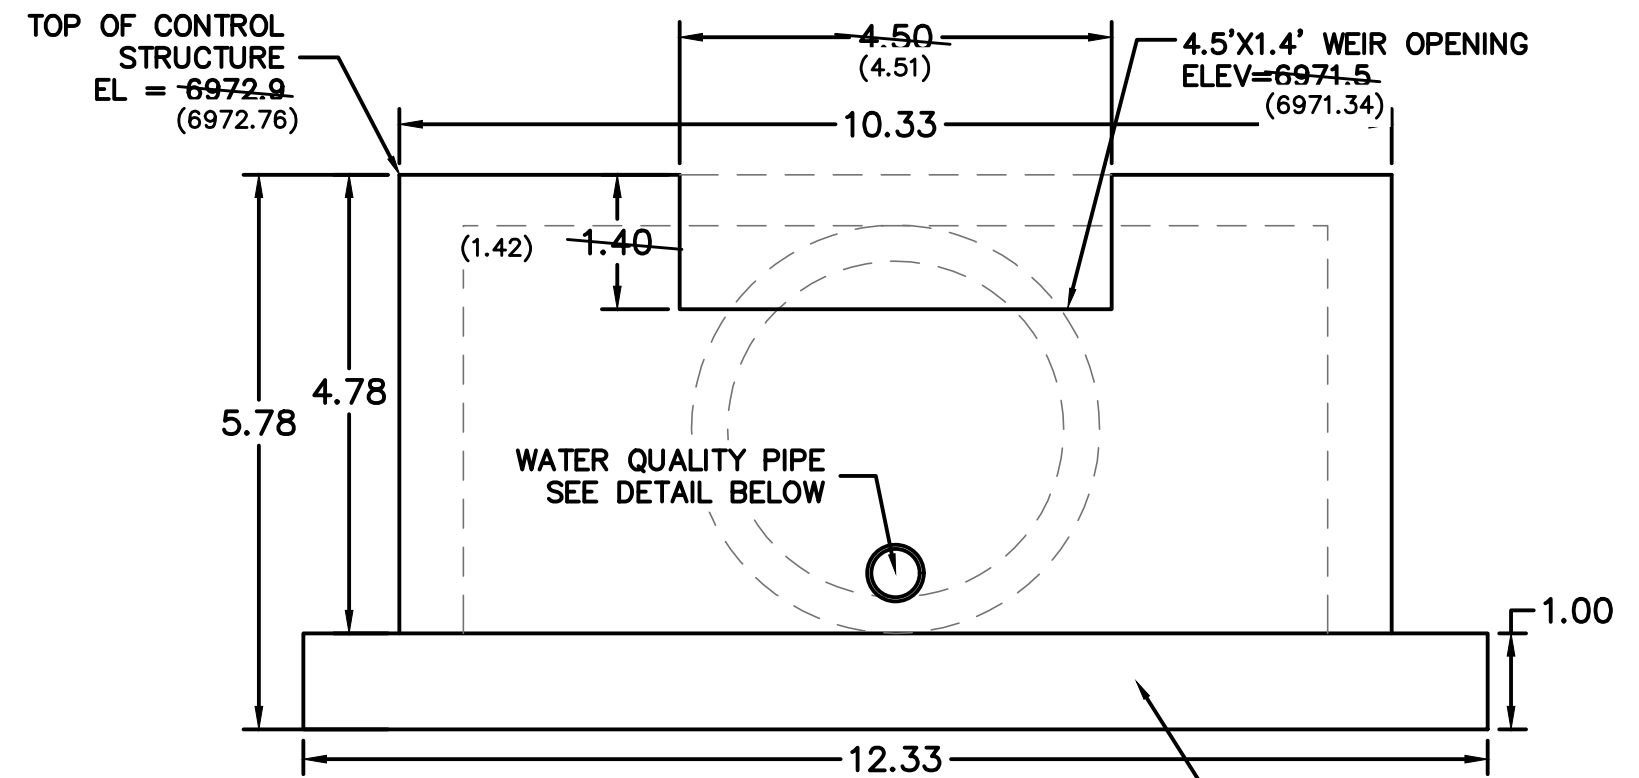



DETAIL 1.2
CONTROL STRUCTURE
NTS

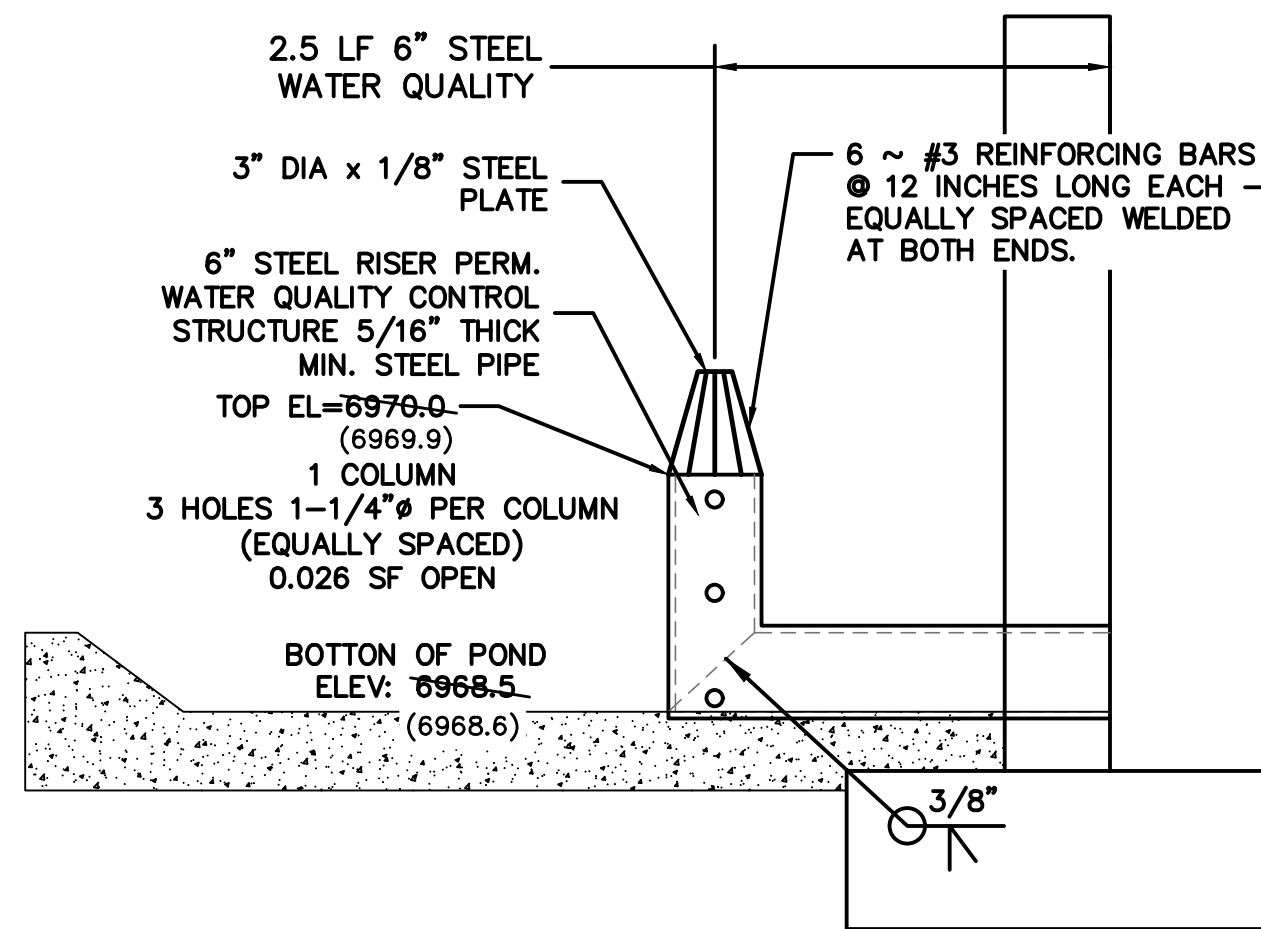


DETAIL 1.4
PERM. WATER QUALITY PIPE
NTS

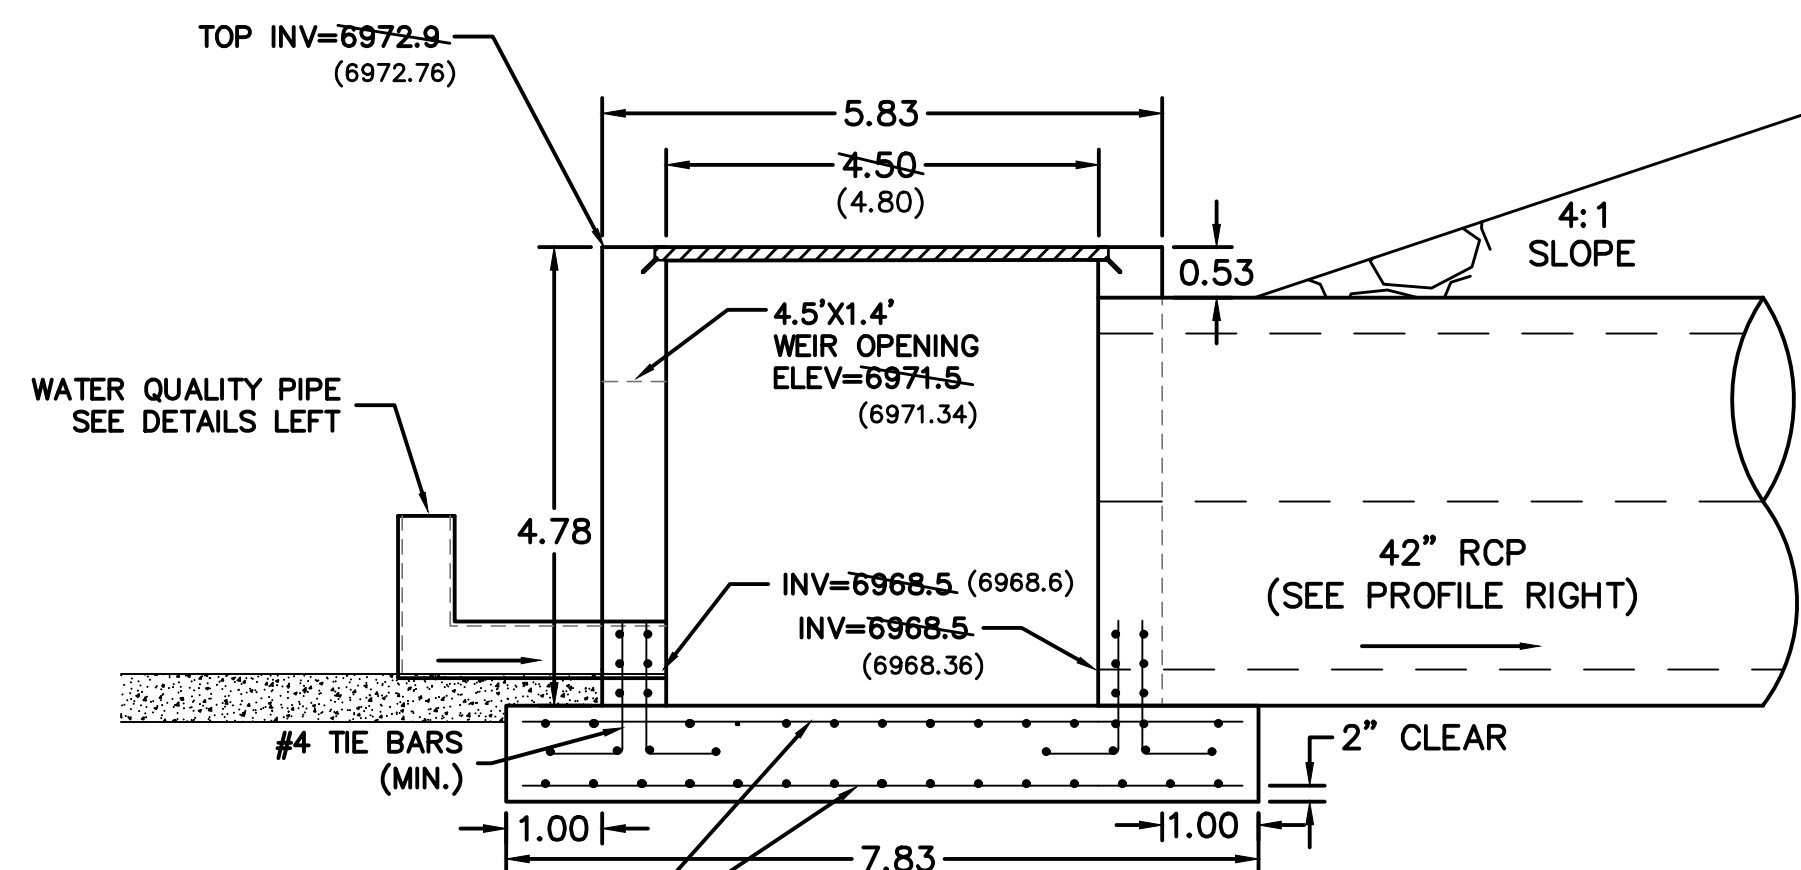

DETAIL 1.3
POND H
CONTROL STRUCTURE
NTS

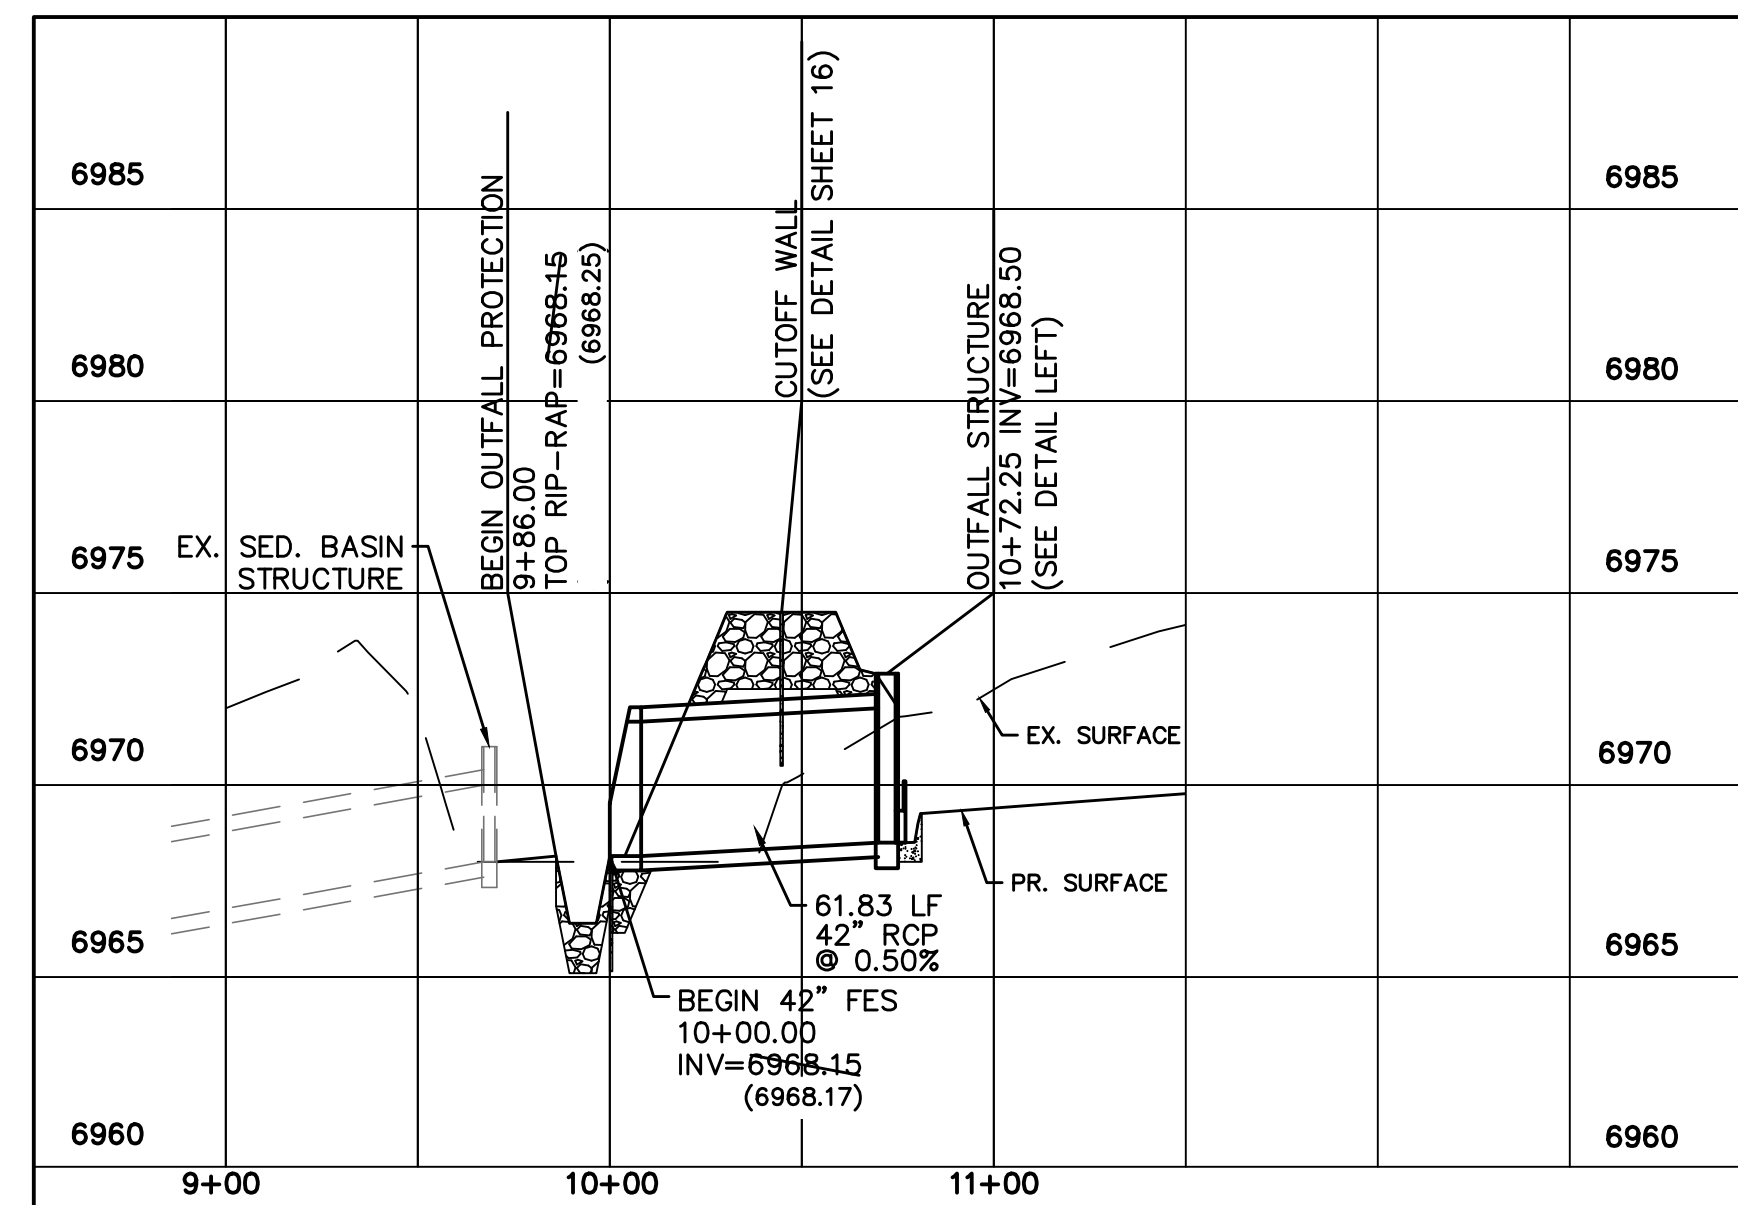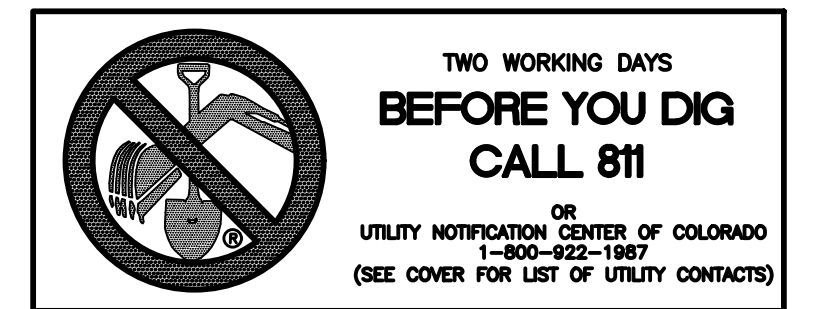

Revisions		No.	Date	Inst.	Appr.	Date
-	-	-	-	-	-	-
TECH CONTRACTORS 11886 STAPLETON DRIVE FALCON, CO 80831 TELEPHONE: 719.495.7444 FAX: 719.495.3349						
 MERIDIAN RANCH						
DETENTION POND DETAILS HAGLER RANCH REGIONAL DETENTION POND A9-BUILT						
Scale	AS SHOWN	Drawn by	TAK	Checked by	RG	Date
	2 of 2					MAR 2021