

LOT 4, OWL MARKETPLACE

Filing No.1

11745 OWL PLACE
EL PASO COUNTY, COLORADO
SITE DEVELOPMENT PLAN

LEGAL DESCRIPTION:

LOT 4, OWL MARKETPLACE

Add parcel # once plat is approved and recorded. SDP cannot be approved until plat is approved.

FLOODPLAIN STATEMENT:

THE EFFECTIVE FLOODPLAIN ZONE A LIMITS ARE DEFINED ON THE FIRM FOR EL PASO COUNTY, COLORADO AND UNINCORPORATED AREAS, MAP NUMBER 08041C0553G, EFFECTIVE DATE DECEMBER 7, 2018.

A LOMR TO MODIFY THE FLOODPLAIN HAS BEEN APPROVED BY FEMA, CASE NO. 21-08-0534P (OCT 7, 2021) WITH AN EFFECTIVE DATE OF FEBRUARY 22, 2022.

This LOMR is not approved for this area. CLOMR was submitted under Case 22-08-066R Dec 21, 2022. Please update this note.

ADA DESIGN PROFESSIONAL STANDARDS:

1. THE PARTIES RESPONSIBLE FOR THIS PLAN HAVE FAMILIARIZED THEMSELVES WITH ALL CURRENT ACCESSIBILITY CRITERIA AND SPECIFICATIONS AND THE PROPOSED PLAN REFLECTS ALL SITE ELEMENTS REQUIRED BY THE APPLICABLE ADA DESIGN STANDARD AND GUIDELINES AS PUBLISHED BY THE UNITED STATES DEPARTMENT OF JUSTICE.
2. APPROVAL OF THIS PLAN BY EL PASO COUNTY DOES NOT ASSURE COMPLIANCE WITH THE ADA OR ANY OTHER FEDERAL OR STATE ACCESSIBILITY LAWS OR ANY REGULATIONS OR GUIDELINES ENACTED OR PROMULGATED UNDER OR WITH RESPECT TO SUCH LAWS.
3. SOLE RESPONSIBILITY FOR COMPLIANCE WITH FEDERAL AND STATE ACCESSIBILITY LAWS LIES WITH THE PROPERTY OWNER.

NOTES:

1. A SEPARATE SIGN PERMIT IS REQUIRED.
2. ALL "STOP SIGNS" WILL BE INSTALLED BY THE DEVELOPER AT THE LOCATIONS SHOWN ON THE DEVELOPMENT PLAN TO MEET MUTCD STANDARDS.
3. THE ADA PARKING SPACES AND ACCESS AISLES SHALL BE LEVEL WITH SURFACE SLOPES NOT EXCEEDING ONE TO FIFTY (1:50) (2 PERCENT) IN ALL DIRECTIONS.

GENERAL NOTES:

1. ALL LIGHTING FIXTURES SHALL BE FULL CUT-OFF OR HAVE SHIELDING TO REDUCE OFF-SITE LIGHTING IMPACTS ONTO ADJACENT PROPERTIES AND ROADWAYS.
2. THE GENERAL DRAINAGE PATTERNS ARE TO THE SOUTHERLY DIRECTION.
3. THIS DEVELOPMENT IS PROPOSED IN ONE PHASE.
4. LANDSCAPE MAINTENANCE OF THE PROPERTY IS THE OWNER'S RESPONSIBILITY.
5. ALL DRIVEWAYS AND PARKING SPACES TO BE ASPHALT UNLESS OTHERWISE SHOWN.
6. ALL INTERNAL DRIVEWAYS, PARKING SPACES AND ISLANDS ARE TO BE CONSTRUCTED WITH TYPE 3 CURB AND GUTTER.


APPROXIMATE SCHEDULE OF DEVELOPMENT:

BEGIN SPRING 2025 COMPLETE FALL 2025

Please include a note stating:

The owner agrees on behalf of him/herself and any developer or builder successors and assignees that Subdivider and/or said successors and assigns shall be required to pay traffic impact fees in accordance with the El Paso County Road Impact Fee Program Resolution (Resolution No. 19-471), or any amendments thereto, at or prior to the time of building permit submittals. The fee obligation, if not paid at final plat recording, shall be documented on all sales documents and on plat notes to ensure that a title search would find the fee obligation before sale of the property.

Add note: At such time that the County is prepared to widen Meridian Road per 2024 El Paso County Master Transportation Corridor Plan (MTCP) as indicated in the 2045 Roadway Improvement Plan, it shall be the property owner's responsibility for relocation of all private improvements that fall within the designated public improvement easement.

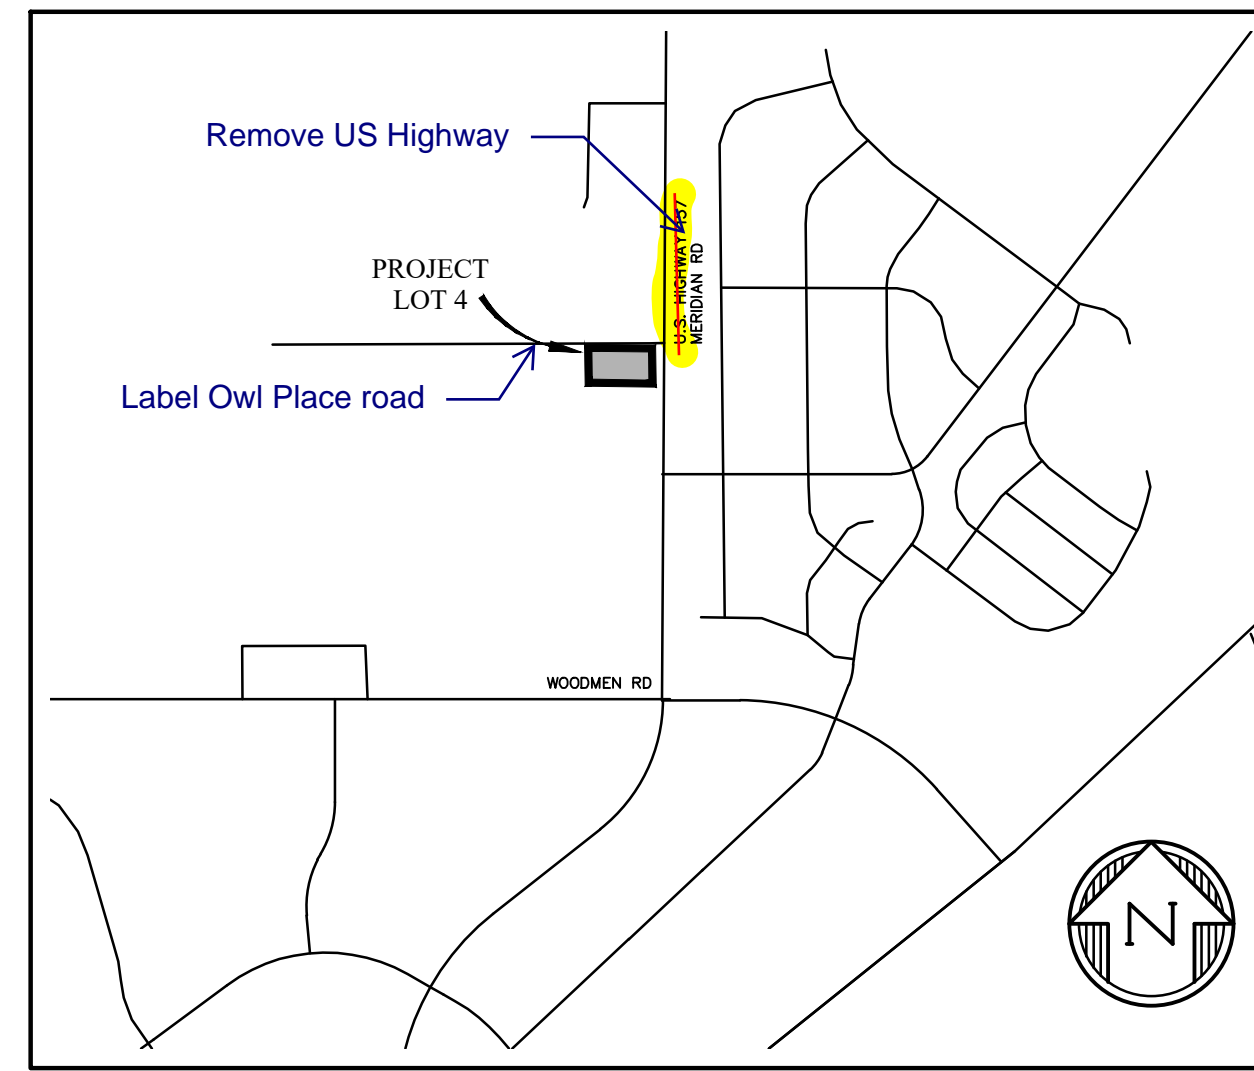

VICINITY MAP
NTS

SITE/BUILDING DATA:

OWNER/CONTRACTOR: BH RE INVESTMENTS, LLC
450 McCLINTOCK DRIVE, CHANDLER, AZ 85226

TAX SCHEDULE NUMBER: 5301001015

DEVELOPMENT PLAN/LOT AREA: 1.02 AC +/-
LOT AREA COVERAGE: 78.21% (0.80 AC.)
OPEN SPACE: 4.38%
LANDSCAPING: 17.41%
IMPERMEABLE SURFACE: 78.21%

ZONING: (EXISTING & PROPOSED) CR

LAND USE: DRIVE-IN/COFFEE RESTAURANT

DRAINAGE BASIN: FALCON

BUILDING CONSTRUCTION TYPE: V, SPRINKLED

BUILDING AREA: 2,489 SF

BUILDING HEIGHT: 50'
ALLOWED: 24'
PROPOSED: 24'

BUILDING SETBACKS: FRONT: EXISTING & PROPOSED 25'
SIDE: EXISTING & PROPOSED 25'
REAR: EXISTING & PROPOSED 25'

PARKING:

TOTAL REQUIRED	
FAST FOOD RESTAURANT	1 PER 100 = 25
ADA STALLS	1 PER 25 = 1
TOTAL PROVIDED	
STANDARD STALLS	30
ADA STALLS PROVIDED	2
TOTAL PROPOSED	32

SHEET INDEX

SHT1	CV	DEVELOPMENT PLAN COVER SHEET
SHT2	USP	UTILITY & SITE PLAN

Provide Utility plan sheets with service provider signature

PREPARED BY:

DREXEL, BARRELL & CO.
Engineers • Surveyors
101 SAWATCH STREET, #100
COLORADO SPGS, COLORADO 80903
CONTACT: TIM D. MCCONNELL, P.E.
(719)260-0887
COLORADO SPRINGS • LAFAYETTE

CLIENT:

BH RE INVESTMENTS, LLC
450 N McCLINTOCK DRIVE
CHANDLER, AZ 85226
(480)-313-2724

CONSTRUCTION PLANS FOR:
LOT 4, OWL MARKETPLACE
EL PASO COUNTY, COLORADO

ISSUE	DATE
INITIAL ISSUE	10/21/2024
DESIGNED BY:	CGH
DRAWN BY:	CGH
CHECKED BY:	KGV
FILE NAME:	21611-03-CV

PREPARED UNDER MY DIRECT SUPERVISION FOR AND ON BEHALF OF DREXEL, BARRELL & CO.

DRAWING SCALE:
HORIZONTAL: N/A
VERTICAL: N/A

COVER SHEET

PROJECT NO. 21611-03CSCV
DRAWING NO.

CV

SHEET: 1 OF 2

label sidewalk as proposed or installed by others reference plat VR2321 CDs

label

Please see plat for easement details which must be depicted on the SDP

Correct ROW width per plat 62ft


Label missing easements and widths to include 32ft public improvement easement and 8ft ROW dedication per plat

ABBREVIATION

C&G	CURB AND GUTTER
EOA	EDGE OF ASPHALT
EX	EXISTING
MH	MANHOLE
PED	PEDESTRIAN
PP	PROPOSED
STM	STORM
SW	SIDEWALK
TELE	TELEPHONE
TYP	TYPICAL

LEGEND

PROPERTY LINE	---
ROW	---
EASEMENT	---
STOP SIGN	⊥
SANITARY SERVICE LINE	SS
GAS SERVICE LINE	G
WATER SERVICE LINE	W
ELECTRIC SERVICE LINE	E
TELE SERVICE LINE	E
ADA ACCESSIBLE ROUTE TO PUBLIC ROW	
NUMBER OF PARKING STALLS	2
HANDICAP PARKING	♿

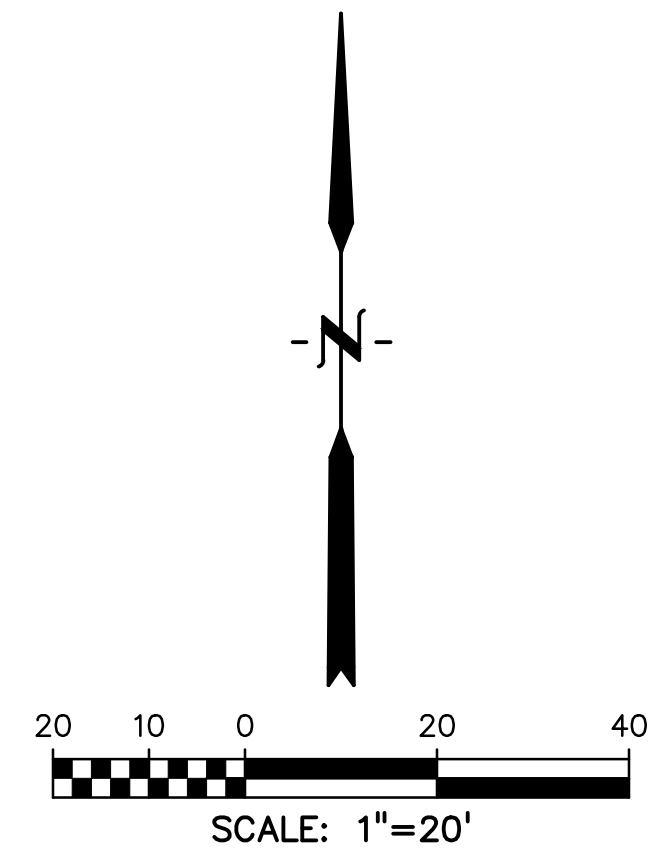

PREPARED BY:

DREXEL, BARRELL & CO.
 Engineers • Surveyors
 101 SAWATCH STREET, #100
 COLORADO SPGS, COLORADO 80903
 CONTACT: TIM D. MCCONNELL, P.E.
 (719)260-0887
 COLORADO SPRINGS • LAFAYETTE

CLIENT:
BH RE INVESTMENTS, LLC
 450 N McCLINTOCK DRIVE
 CHANDLER, AZ 85226
 (480)-313-2724

CONSTRUCTION PLANS FOR:

LOT 4, OWL MARKETPLACE


EL PASO COUNTY, COLORADO

ISSUE	DATE
INITIAL ISSUE	10/21/2024
DESIGNED BY:	CGH
DRAWN BY:	CGH
CHECKED BY:	KGV
FILE NAME:	21611-03-USP

PREPARED UNDER MY DIRECT SUPERVISION FOR AND ON BEHALF OF DREXEL, BARRELL & CO.
 DRAWING SCALE:
 HORIZONTAL: 1"=20'
 VERTICAL: N/A

UTILITY & SITE PLAN
 PROJECT NO. 21611-03CSCV
 DRAWING NO.

USP
 SHEET: 2 OF 2

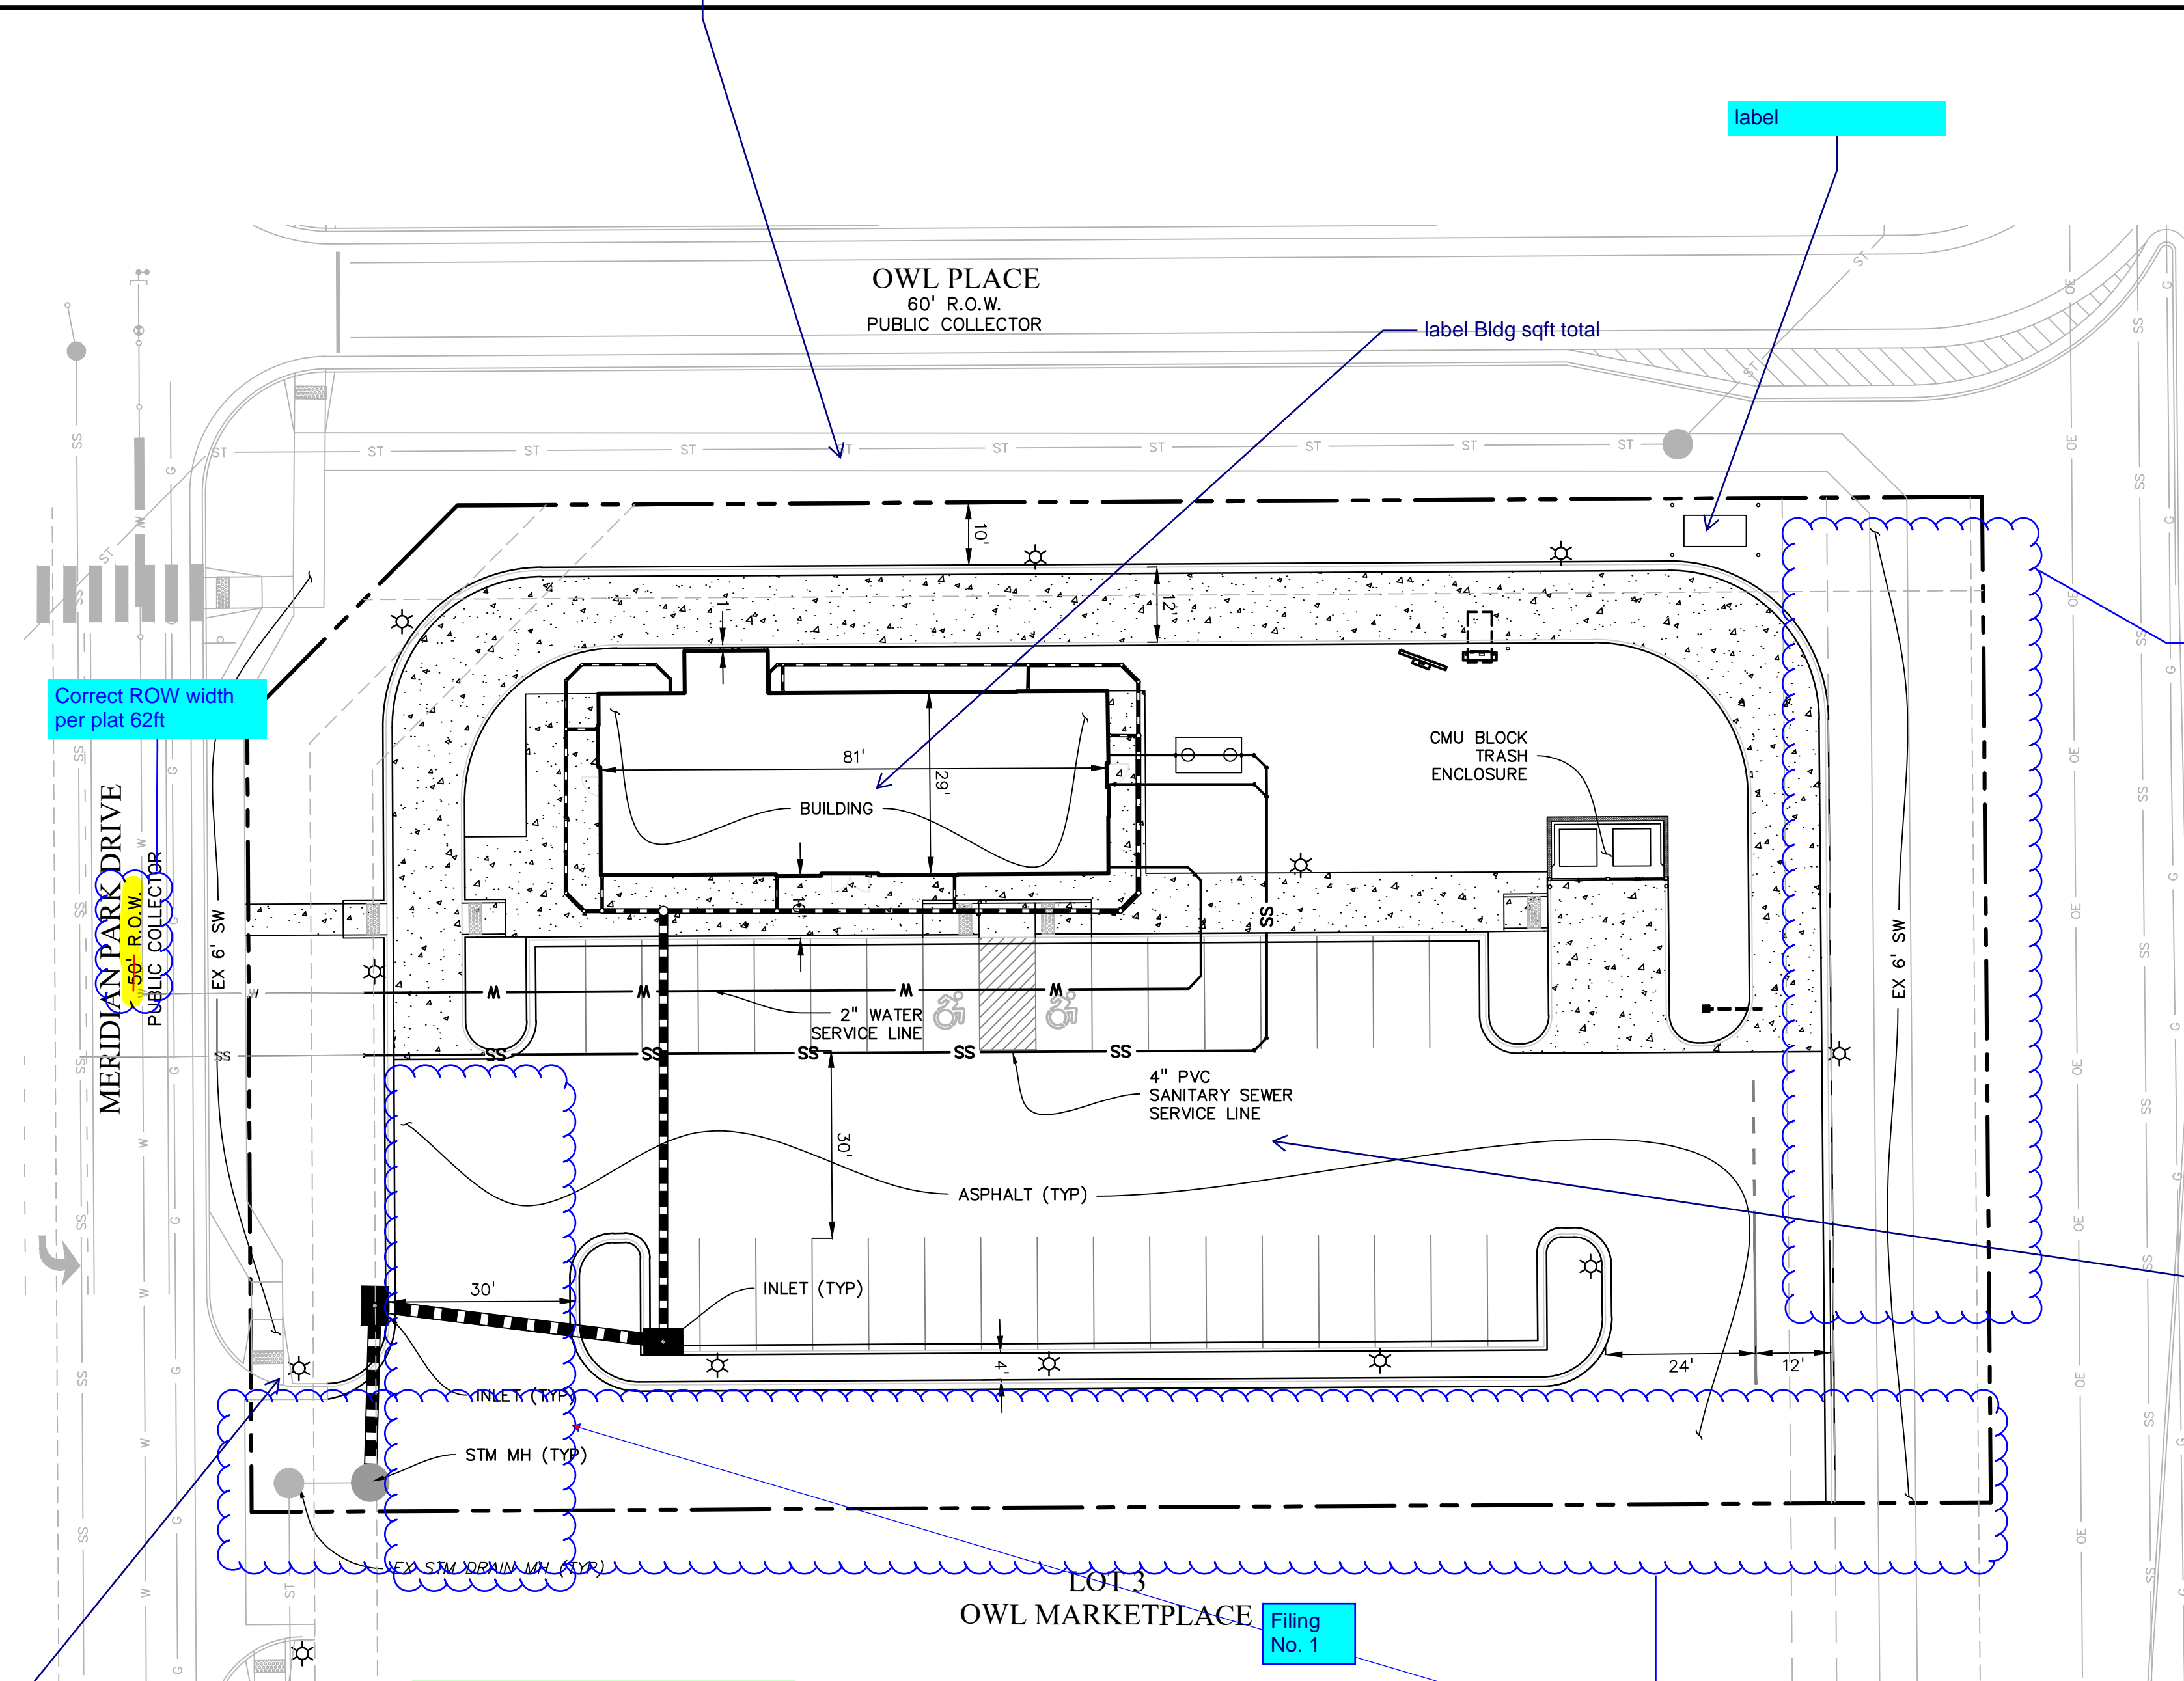

Update the ROW per plat

PLEASE LABEL THE LOT



Call out hydrants

Note these are not approved for/as CDs.

- Please depict the following items:
- dimensions of property lines and any existing or proposed easements.
 - location of sidewalks (if applicable)
 - a graphical depiction of the screening mechanism around the garbage receptacle
 - flow of traffic and points of ingress and egress


Depict the cross lot access easement per plat

depict surface marking and directional signage on the SDP

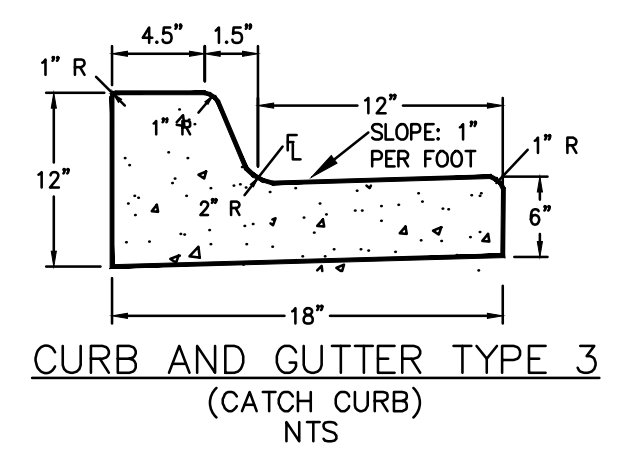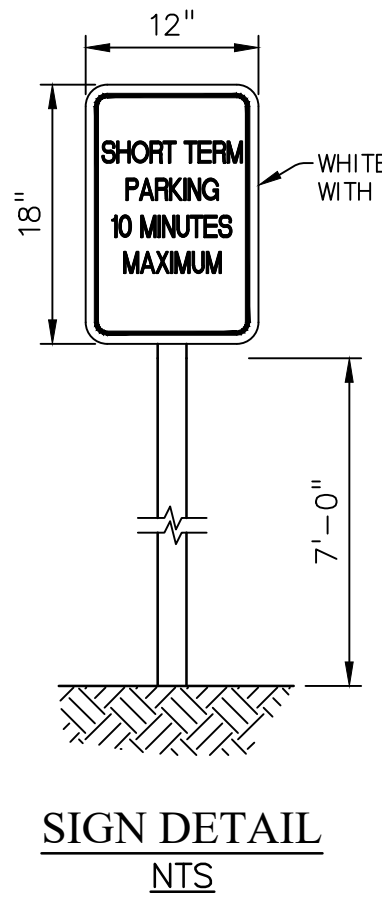


LENGTH FOR RADII


A	= 1/2"
C	= 1-1/2"
D	= 1-1/2" TO 2"

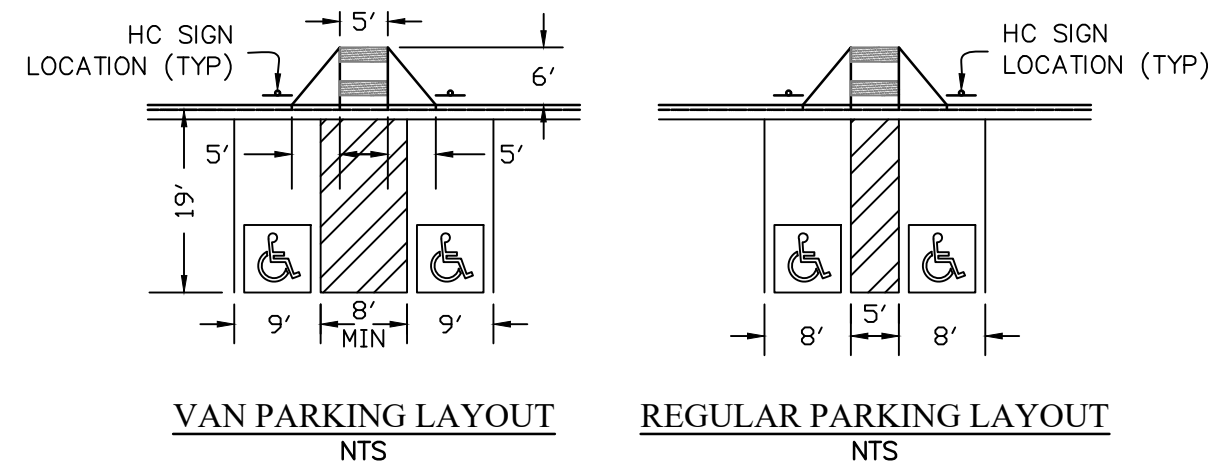

TYPICAL HANDICAP PARKING LAYOUT
NTS

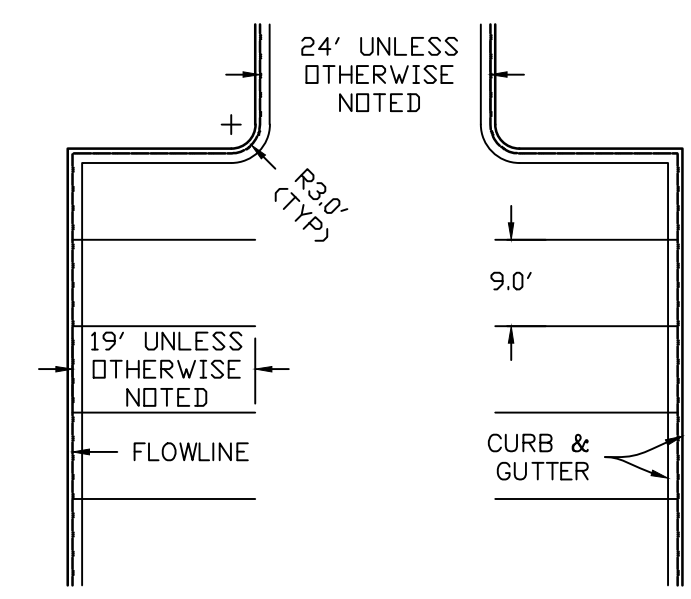

TYPICAL PARKING LAYOUT
NTS

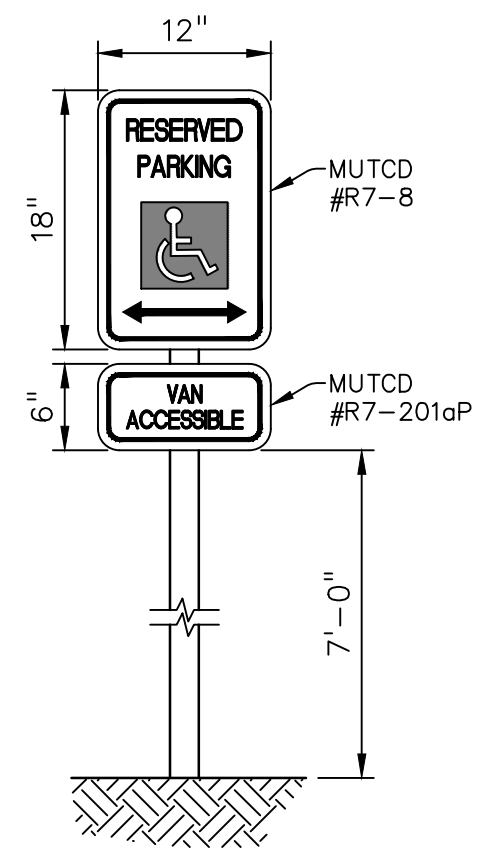

HC SIGN DETAIL
NTS

PPR2439

EL PASO COUNTY PCD FILE NO: PPR-####