

PARKING REQUIRED  
1 SPACE PER 4 SEATS  
  
220 SEATS / 4 = 55 SPACES  
  
PARKING PROVIDED  
56 STANDARD SPACES  
4 ACCESSIBLE SPACES  
60 TOTAL SPACES

# LEGAL DESCRIPTION

LOT B, BLOCK A,  
SPRING CREST FILING NO. 2  
EL PASO COUNTY, CO

SITE AREA: 269 ACRES  
SITE ZONING: RR-2.5

---

TAX SCHEDULE NUMBER

---


PROPERTY IS TAX EXEMPT  
RELIGIOUS ORGANIZATION

ADDRESS

1275 OLD RANCH ROAD  
EL PASO COUNTY, CO

## ADA SITE ACCESSIBILITY

THE PARTIES RESPONSIBLE FOR THIS PLAN HAVE FAMILIARIZED THEMSELVES WITH ALL CURRENT ACCESSIBILITY CRITERIA AND SPECIFICATIONS AND THE PROPOSED PLAN REFLECTS ALL SITE ELEMENTS REQUIRED BY THE APPLICABLE ADA DESIGN STANDARDS AND GUIDELINES AS PUBLISHED BY THE UNITED STATES DEPARTMENT OF JUSTICE. APPROVAL OF THIS PLAN BY EL PASO COUNTY DOES NOT ASSURE COMPLIANCE WITH ADA OR ANY REGULATIONS OR GUIDELINES ENACTED OR PROMULGATED UNDER OR WITH RESPECT TO SUCH LAWS.

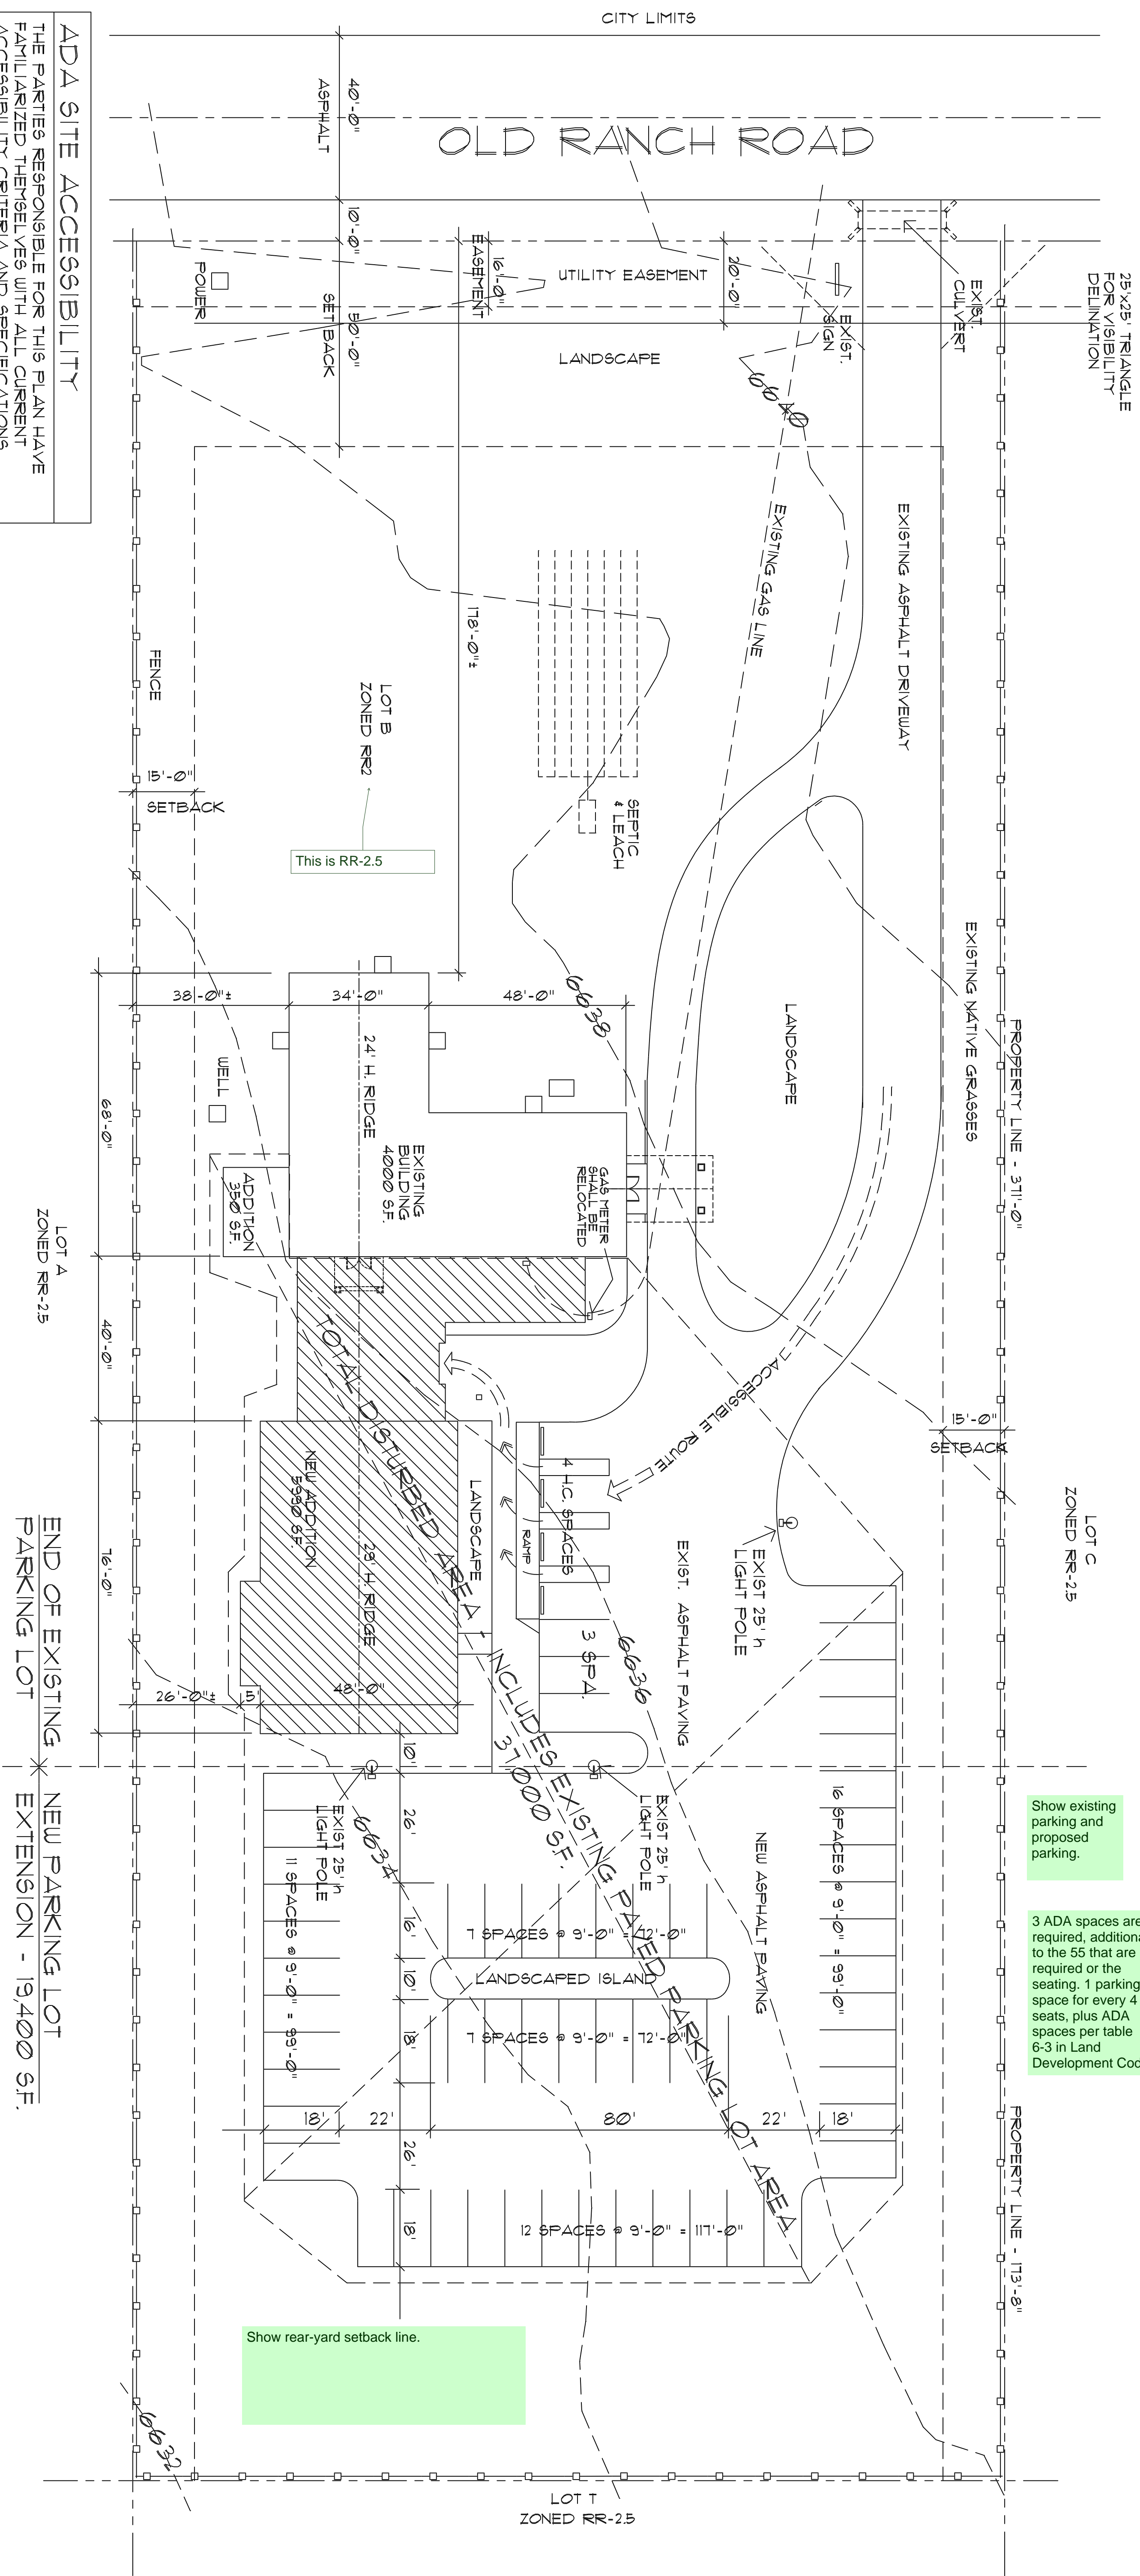

SCALE: 1" = 20'

Add: PCD File No PPR1921

APOSTOLIC CHRISTIAN CHURCH  
1275 Old Ranch Road  
El Paso County, Colorado 80921

DAVID WEESNER ASSOCIATES  
ARCHITECTURE and PLANNING  
2236 East Pikes Peak Avenue  
Colorado Springs, Colorado 80909  
(719) 473-2010 fax 473-2011

# Site Development Plan\_v1-redline.pdf Markup Summary

3 ADA spaces are required, additional to the 55 that are required or the seating. 1 parking space for every 4 seats, plus ADA spaces

3 ADA spaces are required, additional to the 55 that are required or the seating. 1 parking space for every 4 seats, plus ADA spaces per table 6-3 in Land Development Code.

**Subject:** Text Box  
**Page Label:** 1  
**Lock:** Locked  
**Author:** dsdkendall  
**Date:** 5/30/2019 4:16:51 PM  
**Status:**  
**Color:** ■  
**Layer:**  
**Space:**

3 ADA spaces are required, additional to the 55 that are required or the seating. 1 parking space for every 4 seats, plus ADA spaces per table 6-3 in Land Development Code.

Add: PCD File No PPR1921 (1)

1" = 20'  
Add: PCD File No PPR1921

**Subject:** Text Box  
**Page Label:** 1  
**Lock:** Locked  
**Author:** dsdlaforce  
**Date:** 5/30/2019 4:16:51 PM  
**Status:**  
**Color:** ■  
**Layer:**  
**Space:**

Add: PCD File No PPR1921

Include this note: The parties responsible for this plan have familiarized themselves with all current accessibility criteria and speci

Include this note:  
The parties responsible for this plan have familiarized themselves with all current accessibility criteria and specifications and the proposed plan reflects all site elements required by the applicable ADA design standards and guidelines as published by the United States Department of Justice. Approval of this plan by El Paso County does not assure compliance with the ADA or any regulations or guidelines enacted or promulgated under or with respect to such laws.

LOT B, BLOCK A,  
SPRING CREST FIL  
EL PASO COUNTY.

**Subject:** Text Box  
**Page Label:** 1  
**Lock:** Unlocked  
**Author:** dsdkendall  
**Date:** 5/30/2019 4:16:39 PM  
**Status:**  
**Color:** ■  
**Layer:**  
**Space:**

Include this note:

The parties responsible for this plan have familiarized themselves with all current accessibility criteria and specifications and the proposed plan reflects all site elements required by the applicable ADA design standards and guidelines as published by the United States Department of Justice. Approval of this plan by El Paso County does not assure compliance with the ADA or any regulations or guidelines enacted or promulgated under or with respect to such laws.


Show existing parking and proposed parking. (1)

Show existing parking and proposed parking.

**Subject:** Text Box  
**Page Label:** 1  
**Lock:** Locked  
**Author:** dsdkendall  
**Date:** 5/30/2019 4:16:54 PM  
**Status:**  
**Color:** ■  
**Layer:**  
**Space:**

Show existing parking and proposed parking.


Show rear-yard setback line. (1)

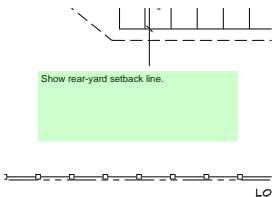

**Subject:** Text Box  
**Page Label:** 1  
**Lock:** Locked  
**Author:** dsdkendall  
**Date:** 5/30/2019 4:16:54 PM  
**Status:**  
**Color:** ■  
**Layer:**  
**Space:**

Show rear-yard setback line.

This is RR-2.5 (1)

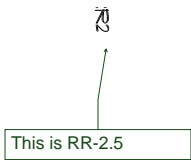

**Subject:** Callout  
**Page Label:** 1  
**Lock:** Locked  
**Author:** dsdkendall  
**Date:** 5/30/2019 4:16:53 PM  
**Status:**  
**Color:** ■  
**Layer:**  
**Space:**

This is RR-2.5