


Show the existing building floor plans for parking calculation.

Better outline the addition.

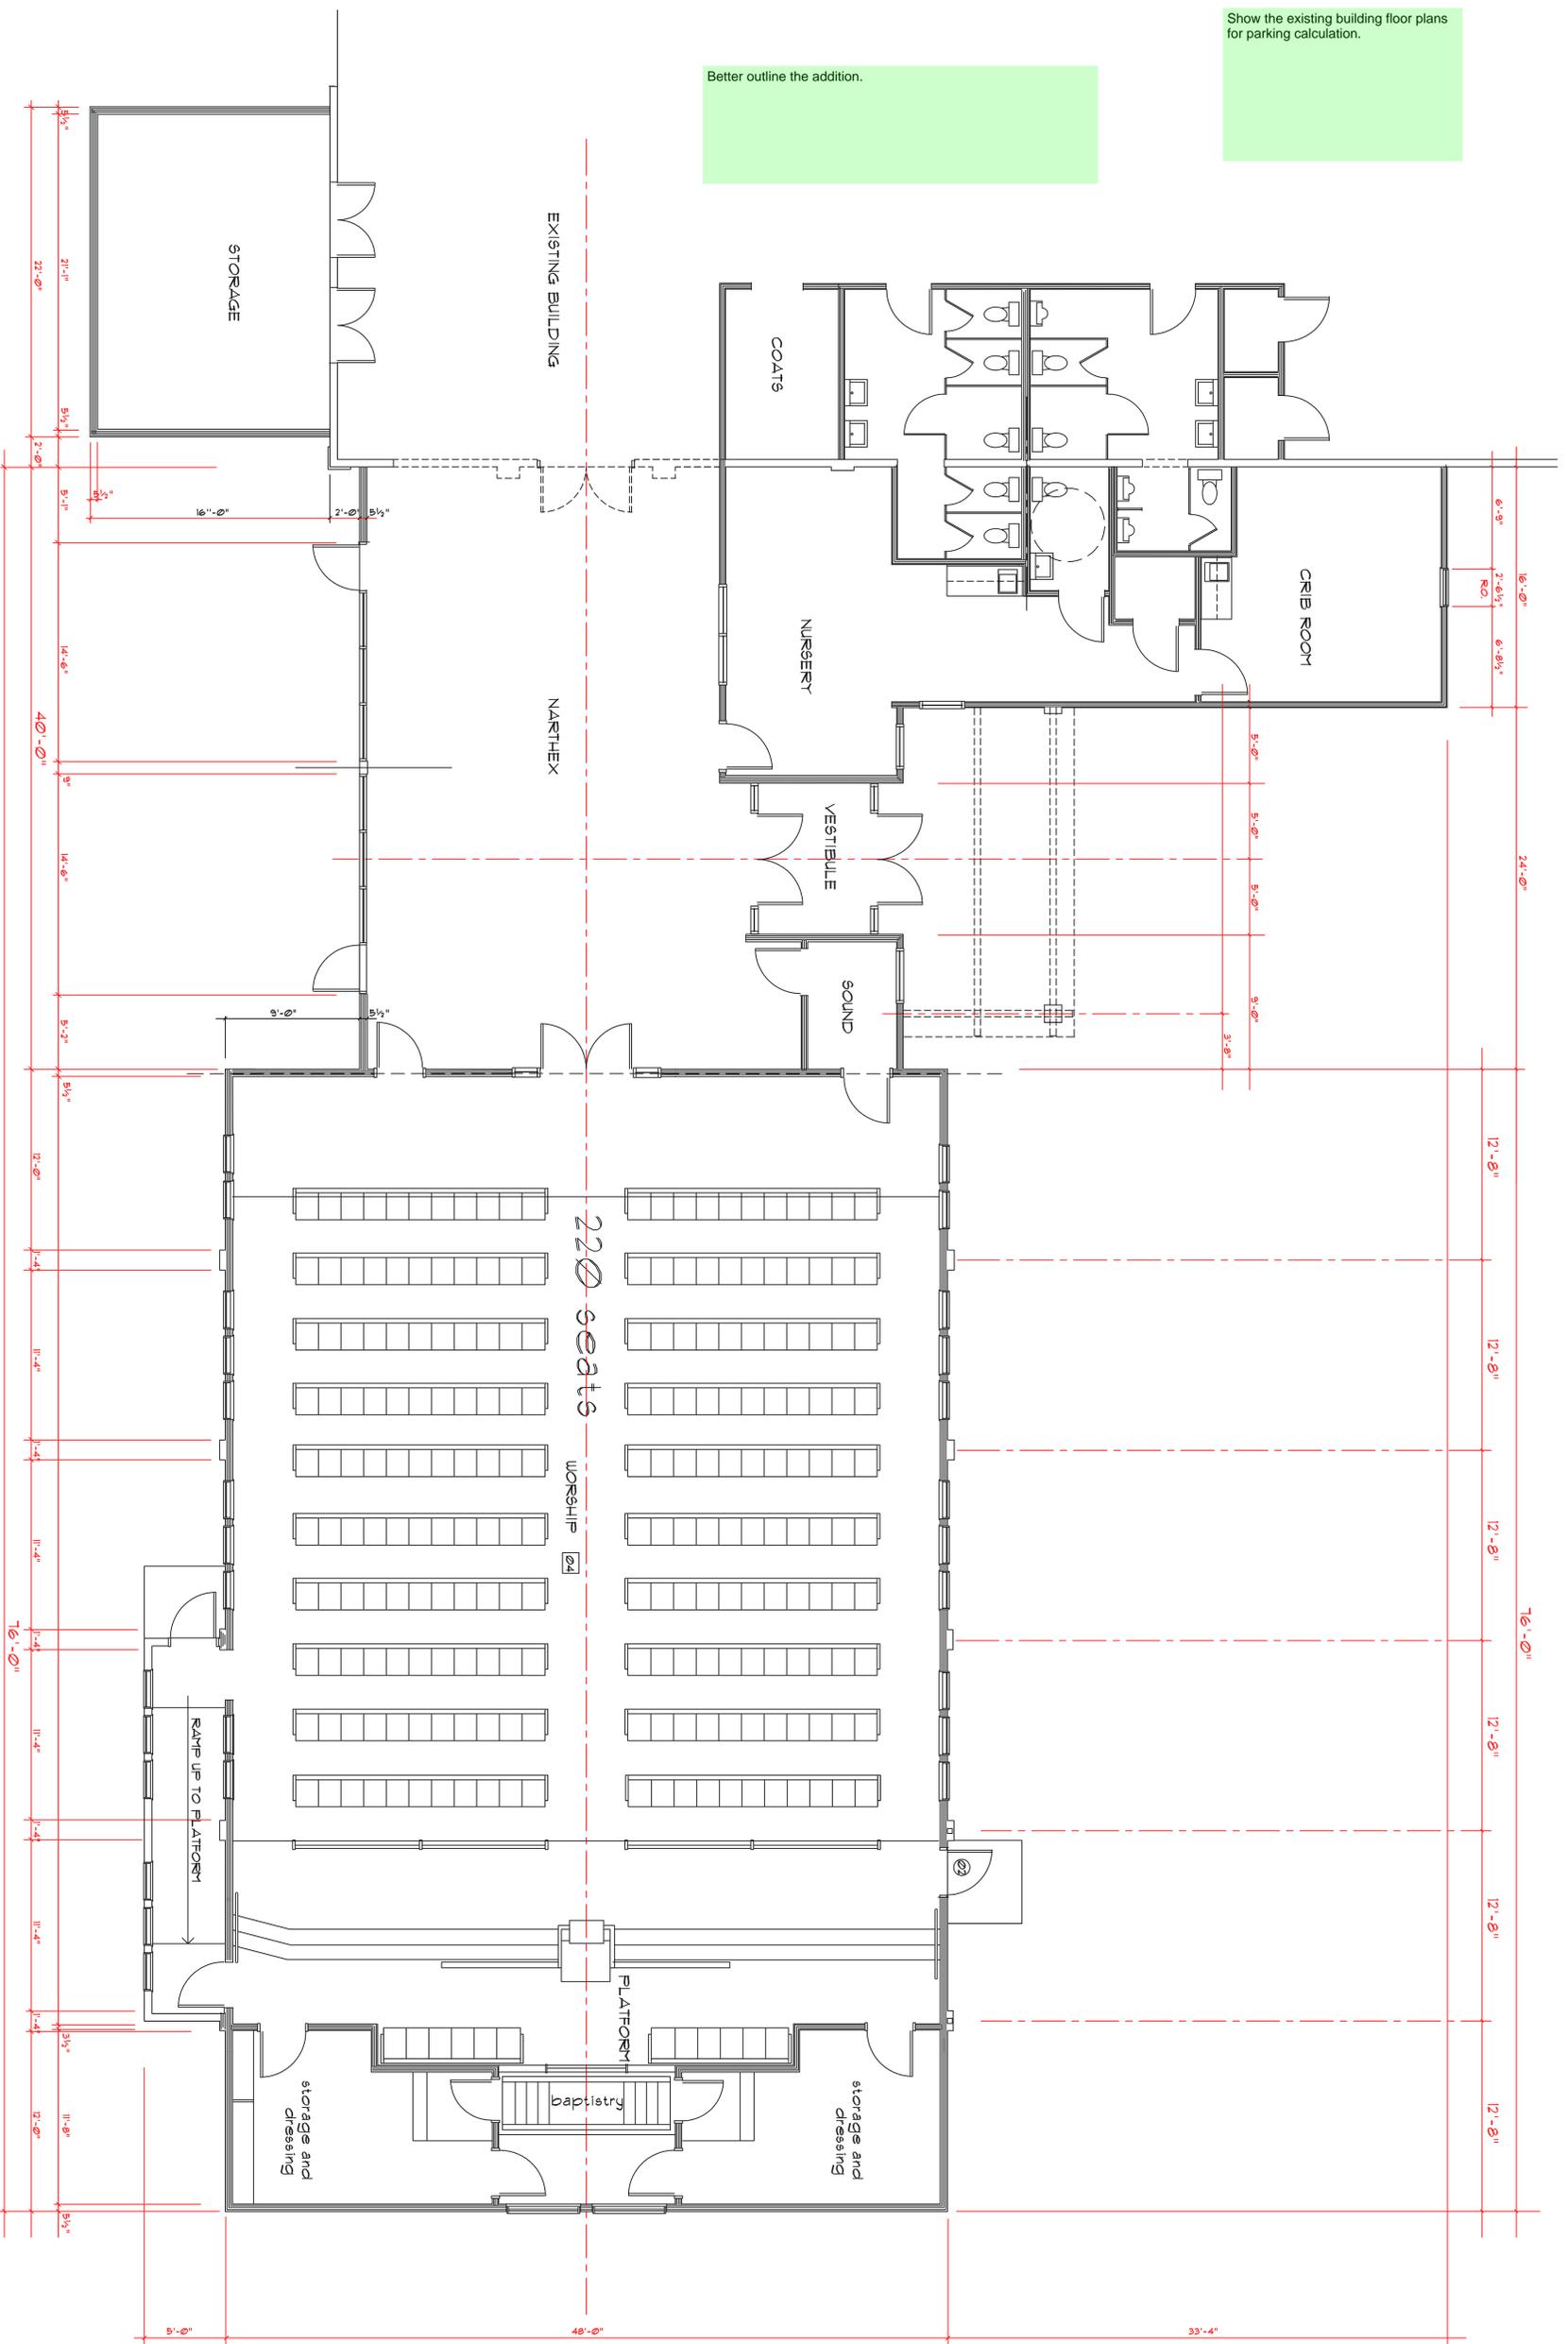

Building Addition Plan
 5B22 s.f.
 9C: 3/16" = 1'-0"

DAVID WEESNER ASSOCIATES
 ARCHITECTURE and PLANNING
 2236 East Pikes Peak Avenue
 Colorado Springs, Colorado 80309
 (719) 473-2010 dnuclwa@aol.com

BUILDING ADDITION & MINOR REMODEL
APOSTOLIC CHRISTIAN CHURCH
 1275 OLD RANCH ROAD, EL PASO COUNTY, CO 80921

JOB NO. 111
 DATE: 4-0-13
 DRAWN: DNU

DRAWING
 SHEET OF

Floor Plans_v1-redline.pdf Markup Summary

Better outline the addition. (1)

Better outline the addition.




Subject: Text Box
Page Label: 1
Lock: Locked
Author: dsdkendall
Date: 5/30/2019 4:06:50 PM
Status:
Color: ■
Layer:
Space:

Better outline the addition.

Show the existing building floor plans for parking calculation. (1)

Show the existing building floor plans for parking calculation.

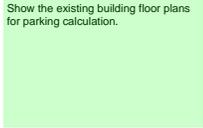

Subject: Text Box
Page Label: 1
Lock: Locked
Author: dsdkendall
Date: 5/30/2019 4:06:50 PM
Status:
Color: ■
Layer:
Space:

Show the existing building floor plans for parking calculation.