

**FINAL DRAINAGE REPORT FOR  
LOT 2 BECKETT AT WOODMEN HILLS FILING NO. 3  
7368 MCLAUGHLIN ROAD  
COLORADO SPRINGS, COLORADO**

**October 4, 2017**

Prepared For:

**TBONE CONSTRUCTION  
1310 FORD STREET  
COLORADO SPRINGS, CO 80915  
(719) 570-1456**

Prepared By:

**TERRA NOVA ENGINEERING, INC.  
721 S. 23<sup>RD</sup> STREET  
Colorado Springs, CO 80904  
(719) 635-6422**

Job No. 1729.00

Add PCD File No. PPR-17-055

**FINAL DRAINAGE REPORT FOR  
LOT 2 BECKETT AT WOODMEN HILLS FILING NO. 3  
7368 MCLAUGHLIN ROAD  
COLORADO SPRINGS, COLORADO**

**TABLE OF CONTENTS**

Engineer's Statement	Page 3
Purpose	Page 4
General Description	Page 4
Historic Drainage Conditions	Page 5
Developed Drainage Conditions	Page 5
Hydrologic Calculations	Page 5
Floodplain Statement	Page 6
Erosion Control	Page 6
Construction Cost Opinion	Page 6
Drainage Fees	Page 6
Maintenance	Page 6
Summary	Page 7
Bibliography	Page 8

**REQUIRED MAPS AND DRAWINGS**  
GENERAL LOCATION MAP  
S.C.S. SOILS MAP  
FEMA FIRM MAP  
HYDROLOGIC/HYDRAULIC CALCULATIONS  
DRAINAGE MAP

**CERTIFICATION STATEMENT:**

**Engineers Statement**

This attached drainage plan and report were prepared under my direction and supervision and are correct to the best of my knowledge and belief. Said drainage report has been prepared according to the criteria established by the County for drainage reports and said report is in conformity with the master plan of the drainage basin. I accept responsibility for any liability caused by any negligent acts, errors or omissions on my part in preparing this report.

\_\_\_\_\_  
L Ducett, P.E. 32339

\_\_\_\_\_  
Seal

**Developers Statements**

I, \_\_\_\_\_, the developer have read and will comply with all of the requirements specified in this drainage report and plan.

Shops at McLaughlin 2 LLC

Business Name

By: \_\_\_\_\_

Title: \_\_\_\_\_

Address: \_\_\_\_\_

\_\_\_\_\_

\_\_\_\_\_  
El Paso County Approval:

Filed in accordance with the requirements of the Drainage Criteria Manual, Volumes 1 & 2, El Paso County Engineering Criteria Manual and Land Development Code as amended.

\_\_\_\_\_  
Jennifer Ervine, P.E.  
County Engineer / ECM Administrator

\_\_\_\_\_  
Date

Conditions:

**FINAL DRAINAGE LETTER FOR  
LOT 2 BECKETT AT WOODMEN HILLS FILING NO. 3  
7368 MCLAUGHLIN ROAD  
COLORADO SPRINGS, COLORADO**

**PURPOSE**

The purpose of this Final Drainage Report is to identify and analyze the existing drainage patterns, determine existing runoff quantities and to analyze the current development of this site as a commercial site. This lot was previously platted with an existing drainage report entitled “Final Drainage Report for Beckett at Woodmen Hills Filing 3” by URS dated May 27, 2003. The proposed use and development is in conformance with the previously approved report.

**GENERAL DESCRIPTION**

This Final Drainage Letter (F.D.L.) for the site located at 7368 approximately 37,497 square feet. The site is currently vacant and is platted as Lot 2 Beckett at Woodmen Hills Filing No. 3. This area is not part of a previous study entitled “Final Drainage Report for Beckett at Woodmen Hills Filing No. 3” by URS dated May 27, 2003. The property is located in the northwest quarter of Section 7, Township 13 South, Range 64 West of the 6<sup>th</sup> Principal Meridian in the El Paso County, Colorado, near the intersection of McLaughlin and Woodmen Roads (See vicinity map, Appendix A) More specifically, the site is bounded by platted acreage properties with the same zoning on all sides.

Double check the Beckett Fil 3 drainage report. Cursory review of the URS report shows the majority of the site within Basin 1 and portions in Basin 2 & 3.

Falcon Drainage Basin

The site lies within the Black Squirrel Creek Drainage Basin

The site consists of Columbine gravelly sandy loam (19) and is part of the hydrologic soil group ‘B’ therefore hydrologic group “A” was used to represent the dominant soil type. (See map in appendix)

"B"

The study area consists of undeveloped land consisting of prairie vegetation. The existing topography is sloping from the north west to the south east.

Identify which subbasin of the URS report this is a part of.

## HISTORIC DRAINAGE CONDITIONS

Currently the existing storm runoff drains overland to the southwest via sheet flow and then into the existing McLaughlin Road curb and gutter and into the existing 10' sump inlet at the south east corner of the site. From here, the flow continues in existing storm sewer to the regional detention pond east of the site. The flow is 1.5 cfs in the 5 year event and 1.5 cfs in the 100 year event.

Include the pond name of the regional detention pond. Identify if the regional pond incorporated water quality or if it is flood control only. If not, then this property may be required to provide WQCV.

State whether or not the regional pond accounted for developed runoff for this subdivision.

## DEVELOPED DRAINAGE CONDITIONS

In the proposed condition, there will be an existing storm sewer at the existing inlet in McLaughlin Road. This inlet is sized for the developed flows. The sizing and basin areas for the onsite storm sewer are shown on the map and calculations in the appendix. The roof of the proposed building will drain into the storm sewer at Design Point 6. The storm sewer is to be 12" minimum pipe with 1% slope.

Include a proposed drainage map.

Basin A, B, C and D are roof areas that will drain into the proposed storm sewer at Design Points 6, 7, 8, and 9. Flows at each point are less than 0.4 cfs in both the 5 and 100 year events.

Basins J and E will flow to the proposed storm sewer and join roof flows. These combined flows will be approximately 3 cfs in the 100 year event and will be piped to the existing inlet at the south east corner of the site. An easement will need to be granted from the adjacent land owner for this connection.

Basin F's 0.27 acres will flow much as it does today directly into the existing inlet. It will join with flows from basin I and Basin H and G for total combined flows of 2.1 cfs in the 5 year event and 4.2 cfs in the 100 year event at Design Point 1, at the existing inlet.

These flows are consistent with the flows anticipated in the URS report. Please see detailed calculations in the appendix.

Revise. Reference the Intensity-Frequency-Duration Curve (Figure 6-5) for obtaining the intensity.

## HYDROLOGIC CALCULATIONS

Hydrologic calculations were performed using the El Paso County Storm Drainage Design Criteria Manual Volumes 1 & 2 latest editions. The Rational Method was used to estimate storm water runoff anticipated from the 24-Hour Rainfall Depths listed in Table 6-2 of the Drainage Criteria Manual for the design storms with 5-year and 100-year recurrence intervals. These values are 5-year 2.7 inches and 4.6 inches for the 100-year.

## **FLOODPLAIN STATEMENT**

No portion of this site is within a designated F.E.M.A. floodplain, as determined by Flood Insurance Rate Map No. 08041C0575 F dated March 17, 1997 (see appendix).

## **EROSION CONTROL/WATER QUALITY**

An erosion control plan is included with this drainage report as we are under one acre.

List the 4 step process (I.7.2) and summarize how each step were considered/incorporated.

Below is a description of the BMP's to be used for erosion control and water quality. For more detail see the erosion control plan.

The first and most effective way to eliminate erosion is to minimize disturbance. Therefore we have shown on the plan to reseed as soon as possible.

## **CONSTRUCTION COST OPINION**

### **Public Non Reimbursable**

NOT APPLICABLE

### **Private Non Reimbursable**

NO DRAINAGE IMPROVEMENTS AT THIS TIME.

List the on-site storm drain.

## **DRAINAGE FEES**

This site is not being platted. Drainage or bridge fees do not apply.

## **MAINTENANCE**

The proposed erosion control and water quality measures will be repaired and maintained by the property owner or owner's representative as required.

## **SUMMARY**

Development of this site will not adversely affect the surrounding development at this time per the previously approved drainage reports, this site will drain into the existing storm sewer system that drains into the existing pond. See the attached previous drainage report in the appendix.

**PREPARED BY:**  
**TERRA NOVA ENGINEERING, INC.**

L Ducett P.E.  
President  
Terra Nova Engineering, Inc.


## **BIBLIOGRAPHY**

“El Paso County Drainage Criteria Manual-Volumes 1 & 2, latest edition”

SCS Soils Map for El Paso County

Federal Emergency Management Agency (FEMA) flood maps


“Final Drainage Report for Beckett at Woodmen Hills Filing 3” by URS dated May 27, 2003

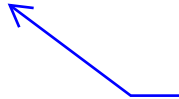

Include the Falcon DBPS.



## VICINITY MAP

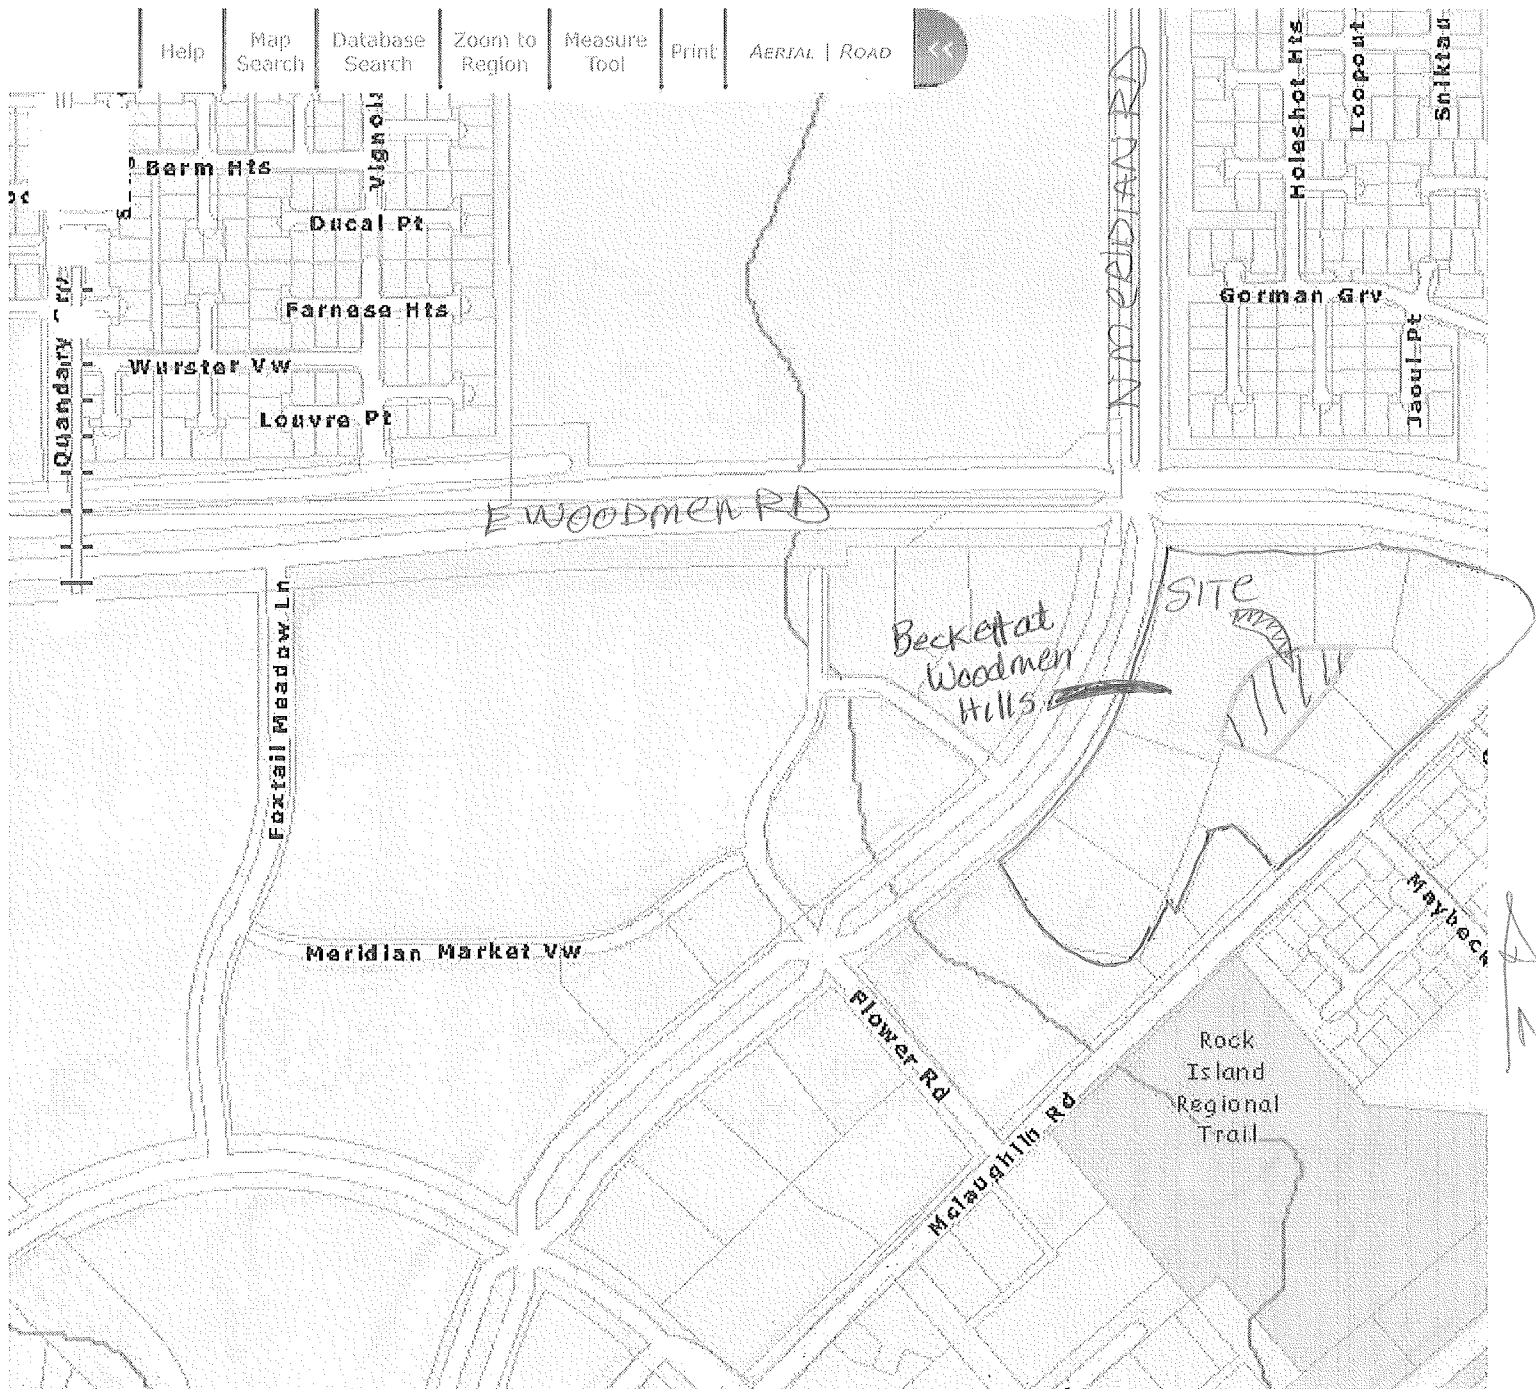

NOT TO SCALE

## **S.C.S. SOILS MAP**

[Area of Interest \(AOI\)](#)[Soil Map](#)[Soil Data Explorer](#)[Download Soils Data](#)[Shopping Cart \(Free\)](#)[Printable Version](#)[Add to Shopping Cart](#)


Search

Map Unit Legend

**El Paso County Area, Colorado (CO625)****El Paso County Area, Colorado (CO625)**


Map Unit Symbol	Map Unit Name	Acres in AOI	Percent of AOI
19	Columbine gravelly sandy loam, 0 to 3 percent slopes	0.7	100.0%
<b>Totals for Area of Interest</b>		<b>0.7</b>	<b>100.0%</b>

Soil Map

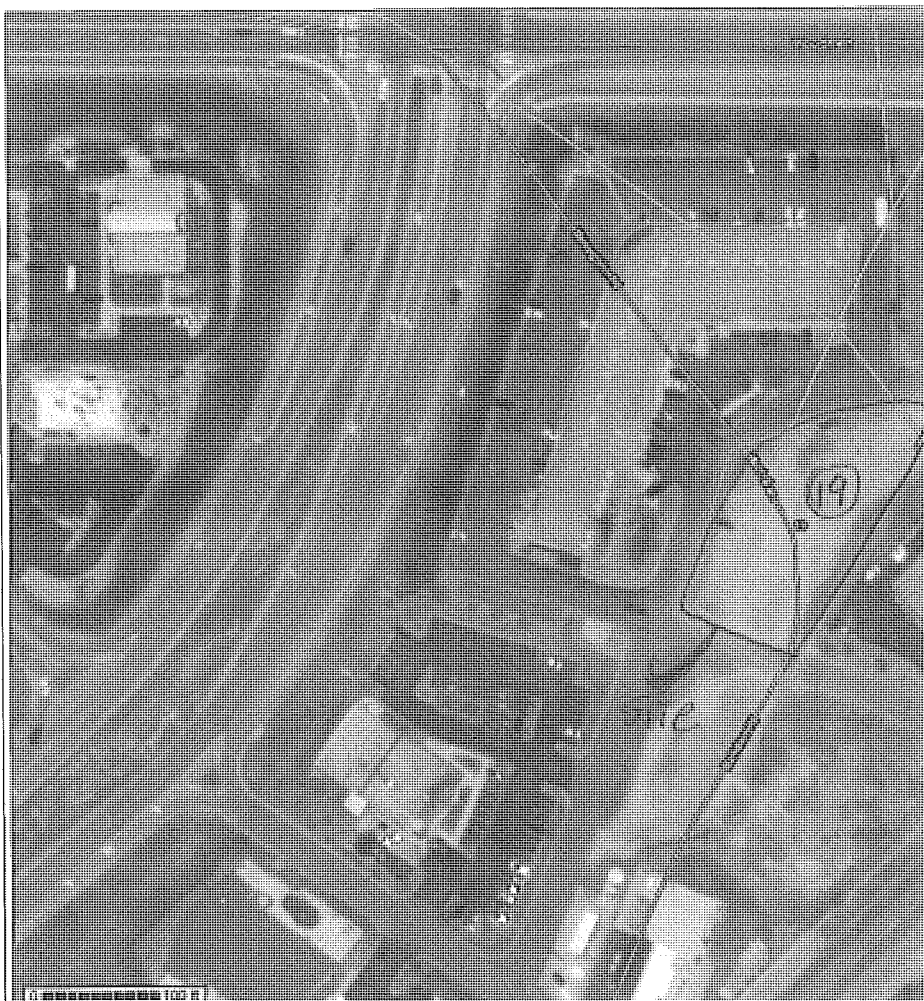 Scale (not to scale) ▾**Warning: Soil Map may not be valid at this scale.**

You have zoomed in beyond the scale at which the soil map for this area is intended to be used. Map AOI were mapped at 1:24,000. The design of map units and the level of detail shown in the resulting enlargement of maps beyond the scale of mapping can cause misunderstanding of the detail of map areas of contrasting soils that could have been shown at a more detailed scale.

## FEMA FIRM MAP

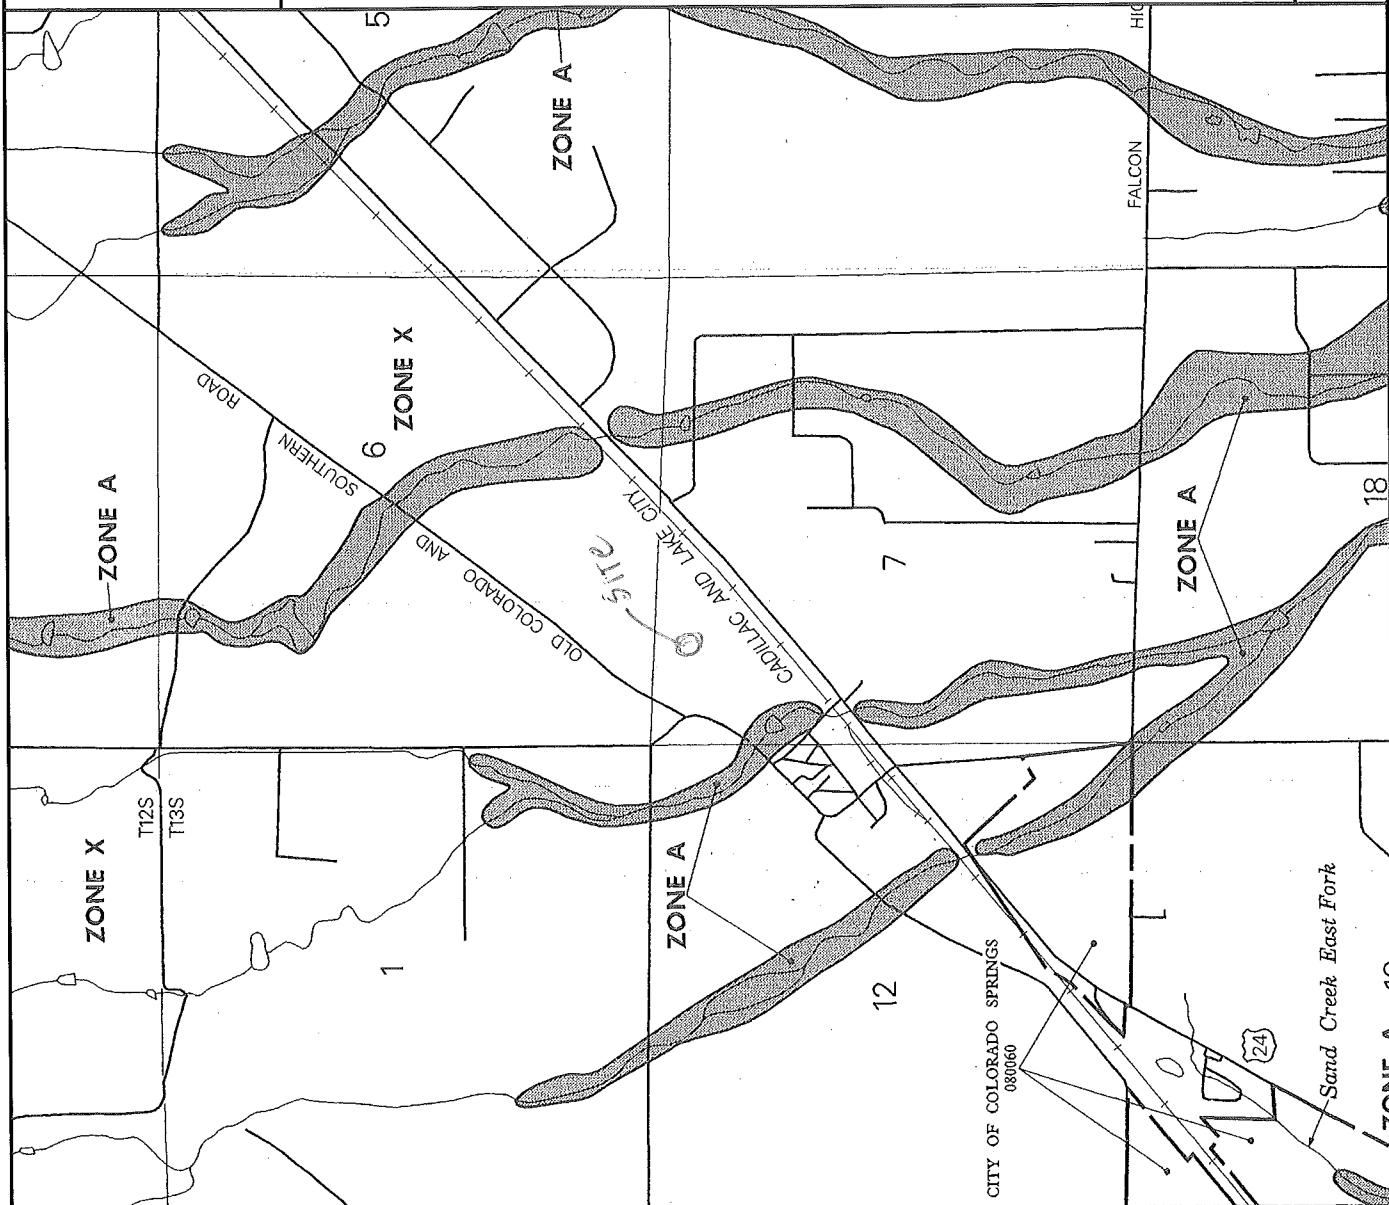

APPROXIMATE SCALE IN FEET

2000 0 2000

**NATIONAL FLOOD INSURANCE PROGRAM**

**FIRM**  
**FLOOD INSURANCE RATE MAP**  
 EL PASO COUNTY,  
 COLORADO AND  
 INCORPORATED AREAS

**PANEL 575 OF 1300**  
 (SEE MAP INDEX FOR PANELS NOT PRINTED)

CONTAINS:	COMMUNITY	NUMBER	PANEL	SUFFIX
	COLORADO SPRINGS CITY OF	080060	0075	F
	EL PASO COUNTY, UNINCORPORATED AREAS	080059	0075	F

**MAP NUMBER**  
 08041C0575 F  
**EFFECTIVE DATE:**  
 MARCH 17, 1997



Federal Emergency Management Agency

This is an official copy of a portion of the above referenced flood map. It was extracted using F-MIT On-Line. This map does not reflect changes or amendments which may have been made subsequent to the date on the title block. For the latest product information about National Flood Insurance Program flood maps check the FEMA Flood Map Store at [www.msc.fema.gov](http://www.msc.fema.gov)

## HYDROLOGIC/HYDRAULIC CALCULATIONS

**SHOPS AT MCLAUGHLIN II  
AREA DRAINAGE SUMMARY**

**EXISTING CONDITIONS**

BASIN	AREA TOTAL (acres)	WEIGHTED		OVERLAND			STREET / CHANNEL FLOW				T <sub>t</sub>		INTENSITY		TOTAL FLOWS	
		C <sub>5</sub>	C <sub>100</sub>	C <sub>5</sub>	Length (ft)	Height (ft)	T <sub>c</sub> (min)	Length (ft)	Slope (%)	Velocity (fps)	T <sub>t</sub> (min)	TOTAL (min)	I <sub>5</sub> (in/hr)	I <sub>100</sub> (in/hr)	Q <sub>5</sub> (c.f.s.)	Q <sub>100</sub> (c.f.s.)
EX-1	0.88	0.09	0.36	0.09	220	5.0	21.4	172	1.7%	2.5	1.1	22.5	2.9	4.8	0.2	1.5



***Shops at McLaughlin II  
Area Runoff  
Existing and Proposed***

**PROPOSED CONDITIONS**

BASIN	TOTAL AREA (Acres)		DEVELOPED			UNDEVELOPED			WEIGHTED		WEIGHTED CA	
	AREA (Acres)		AREA (Acres)	C <sub>5</sub>	C <sub>100</sub>	AREA (Acres)	C <sub>5</sub>	C <sub>100</sub>	C <sub>5</sub>	C <sub>100</sub>	CA5	CA100
A	0.04	0.04	0.04	1.00	1.00	0.00	0.81	0.88	1.00	1.00	0.04	0.04
B	0.03	0.03	0.03	1.00	1.00	0.00	0.81	0.88	1.00	1.00	0.03	0.03
C	0.03	0.03	0.03	1.00	1.00	0.00	0.81	0.88	1.00	1.00	0.028	0.028
D	0.04	0.04	0.04	1.00	1.00	0.00	0.81	0.88	1.00	1.00	0.035	0.035
E	0.12	0.12	0.12	0.81	0.88	0.00	0.81	0.88	0.81	0.81	0.115	0.115
F	0.27	0.27	0.27	0.81	0.88	0.00	0.81	0.88	0.81	0.81	0.238	0.238
G	0.01	0.01	0.01	0.81	0.88	0.00	0.81	0.88	0.81	0.81	0.006	0.006
H	0.08	0.08	0.08	0.81	0.88	0.00	0.81	0.88	0.81	0.81	0.074	0.074
I	0.17	0.17	0.17	0.81	0.88	0.00	0.81	0.88	0.81	0.81	0.145	0.145
J	0.09	0.09	0.09	0.81	0.88	0.00	0.81	0.88	0.81	0.81	0.0792	0.0792

Revise the runoff coefficients based on Table 6-6 of the City of Colorado Springs DCM. For Roofs: 5yr=0.73 and 100yr=0.81

Add a footnote identify what the corresponding surface characteristics the corresponding c-values are or include Table 6-6 in the report and identify (circle/mark) the corresponding surface characteristics.

Provide a drainage map.

# SHOPS AT MCLAUGHLIN II AREA DRAINAGE SUMMARY

## DEVELOPED CONDITIONS

BASIN		AREA TOTAL (Acres)		WEIGHTED		OVERLAND					STREET / CHANNEL FLOW				T <sub>t</sub>	INTENSITY		TOTAL FLOWS	
				C <sub>s</sub>	C <sub>100</sub>	C <sub>s</sub>	Length (ft)	Height (ft)	T <sub>c</sub> (min)	Length (ft)	Slope (%)	Velocity (fps)	T <sub>i</sub> (min)	TOTAL (min)		I <sub>s</sub> (in/hr)	I <sub>100</sub> (in/hr)	Q <sub>s</sub> (c.f.s.)	Q <sub>100</sub> (c.f.s.)
				* First Order Sub-Area Summary															
A		0.04		1.00	1.00	0	0.0	#DIV/0!	45	2.0%	2.5	0.3	5.0	5.0	9.1	0.2	0.4		
B		0.03		1.00	1.00	0	0.0	#DIV/0!	45	2.0%	2.5	0.3	5.0	5.0	9.1	0.2	0.3		
C		0.03		1.00	1.00	0	0.0	#DIV/0!	45	2.0%	2.5	0.3	5.0	5.0	9.1	0.2	0.3		
D		0.04		1.00	1.00	0	0.0	#DIV/0!	45	2.0%	2.5	0.3	5.0	5.0	9.1	0.2	0.4		
E		0.12		0.81	0.88	30	1.0	2.3	60	5.0%	4.0	0.3	5.0	5.0	9.1	0.5	1.0		
F		0.27		0.81	0.88	10	0.5	1.0	320	3.0%	3.5	1.5	5.0	5.0	9.1	1.1	2.2		
G		0.01		0.81	0.88	5	0.5	0.6	5	3.8%	3.5	0.0	5.0	5.0	9.1	0.0	0.1		
H		0.08		0.81	0.88	50	4.0	1.9	0	#DIV/0!	3.4	0.0	5.0	5.0	9.1	0.3	0.7		
I		0.17		0.81	0.88	20	1.0	1.4	40	6.0%	3.4	0.2	5.0	5.0	9.1	0.7	1.3		
J		0.09		0.81	0.88	50	2.0	2.4	0	#DIV/0!	3.4	0.0	5.0	5.0	9.1	0.4	0.7		

Calculated by: ld

Date: 10/12/2017

Checked by: ld

Fix.

# SHOPS AT MCLAUGHLIN II SURFACE ROUTING SUMMARY

	A	B	C	D	E	F	G	H	I	J
7	DEVELOPED CONDITIONS									
8	Design Point(s)	Contributing Basins	Area (Acres)	Equivalent $CA_5$	Equivalent $CA_{100}$	Maximum $T_C$	Intensity		Flow	
							$I_5$	$I_{100}$	$Q_5$	$Q_{100}$
9	1	G+DP2	0.53	0.43	0.46	5.0	5.0	9.1	2.1	4.2
10	2	F+H+DP3	0.52	0.42	0.46	5.0	5.0	9.1	2.1	4.1
11	3	I	0.17	0.13	0.15	5.0	5.0	9.1	0.7	1.3
12	4	J	0.09	0.07	0.08	5.0	5.0	9.1	0.4	0.7
13	5	E	0.12	0.10	0.11	5.0	5.0	9.1	0.5	1.0
14	6	A	0.04	0.04	0.04	5.0	5.0	9.1	0.2	0.4
15	7	B	0.03	0.03	0.03	5.0	5.0	9.1	0.2	0.3
16	8	C	0.03	0.03	0.03	5.0	5.0	9.1	0.2	0.3
17	9	D	0.04	0.04	0.04	5.0	5.0	9.1	0.2	0.4
18	<div> <div>PIPE</div> <div>3.1 cfs</div> <div>total</div> </div>									
19	Date: 10/12/17									
20	Checked by: ld									
21										

Routing Summary will be reviewed once the associated drainage map is included.

# Free Online Manning Pipe Flow Calculator

>> Nationalism not welcome here. <<

## Manning Formula Uniform Pipe Flow at Given Slope and Depth

Can you help me translate, program, or host these calculators? (./contact.php) [Hide this request]

Check out our newest spreadsheet update: Download Spreadsheet (spreadsheet/Manning-Pipe-Flow.xlsx) Open Google Sheets version (spreadsheet/Manning-Pipe-Flow.php) View All Spreadsheets (http://www.hawsedc.com/engcalcs/SpreadsheetLibrary.php)

--CAUTION: If you have downloaded the spreadsheet prior to September 24, you may have received incorrect results!--

Printable Title

Printable Subtitle

Set units:

Pipe diameter, $d_0$	12 in ▾
Manning roughness, $n$ ? (http://www.engineeringtoolbox.com/mannings-roughness-d_799.html)	0.013
Pressure slope (possibly ? (./pressureslope.php) equal to pipe slope), $S_0$	1.0 % rise/run ▾
Percent of (or ratio to) full depth (100% or 1 if flowing full)	75 % ▾

Results

Flow, $Q$	3.2485	cfs ▾
Velocity, $v$	5.1414	ft/sec ▾
Velocity head, $h_v$	0.4108	ft ▾
Flow area	0.6319	ft <sup>2</sup> ▾
Wetted perimeter	2.0944	ft ▾
Hydraulic radius	0.3017	ft ▾
Top width, $T$	0.8660	ft ▾
Froude number, $F$	1.06	
Shear stress (tractive force), $\tau$	22.4166	N/m <sup>2</sup> ▾

## DRAINAGE MAP

## EROSION CONTROL MAP

**FINAL DRAINAGE REPORT FOR  
BECKETT AT WOODMEN HILLS  
FILING 3**

**May 27, 2003**

**Prepared for:**

**BECKETT DEVELOPMENT, LLP  
P.O. BOX 49487  
COLORADO SPRINGS, CO 80949**

**Prepared by:**


**URS  
9960 FEDERAL DRIVE, SUITE 300  
COLORADO SPRINGS, CO 80921**

**URS Project No. 21710935**


## CERTIFICATIONS

### Engineer's Statement:

The attached drainage plan and report were prepared under my direction and supervision and are correct to the best of my knowledge and belief. Said drainage report has been prepared according to the criteria established by the City/County for drainage reports and said report is in conformity with the master plan of the drainage basin. I accept responsibility for any liability caused by any negligent acts, errors or omissions on my part in preparing this report.

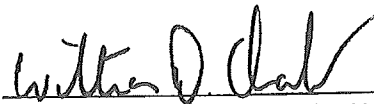

William D. Chaffin, PE # 35136

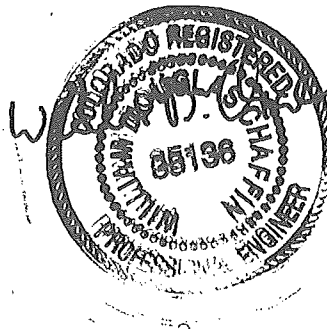

Seal


### Developer's Statement:

I, the developer have read and will comply with all of the requirements specified in this drainage report and plan.

  
Beckett Development, LLP

By: 

Title: 

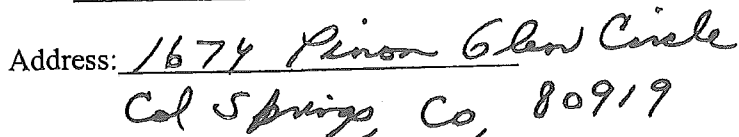Address: 

### El Paso County's Statement

Filed in accordance with Section 51.1 of the El Paso Land Development Code, as amended.

  
John McCarty, County Engineer / Director

7-8-03

Date

Conditions:



## TABLE OF CONTENTS

PURPOSE .....	1
GENERAL LOCATION AND DESCRIPTION.....	1
DRAINAGE BASINS AND SUB-BASINS.....	1
DRAINAGE DESIGN CRITERIA .....	2
SCS HYDROLOGIC CRITERIA .....	2
RATIONAL METHOD HYDROLOGIC CRITERIA .....	2
DETENTION STORAGE CRITERIA .....	2
DRAINAGE FACILITY DESIGN.....	2
GENERAL CONCEPT .....	2
EXISTING DRAINAGE CHARACTERISTICS.....	2
PROPOSED DESIGN DRAINAGE CHARACTERISTICS .....	3
EROSION CONTROL .....	4
GENERAL CONCEPT .....	4
DETENTION PONDS.....	4
SILT FENCING .....	4
EROSION BALES.....	4
MISCELLANEOUS .....	4
COST ESTIMATE .....	5
DRAINAGE FEES .....	5

## LIST OF FIGURES

- FIGURE 1: Vicinity Map
- FIGURE 2: Woodmen Hills Development Filing No. 7
- FIGURE 3: FEMA Flood Insurance Rate Map
- FIGURE 4: Soils Map
- FIGURE 5: Drainage Plan
- FIGURE 6: Erosion Control Plan

## APPENDICES

- A. Rational Method Calculations

## PURPOSE

The purpose of this Final Drainage Report for Beckett at Woodmen Hills Filing 3 is to identify on-site drainage patterns and design adequate storm water facilities for routing and capturing developed storm water runoff.

This drainage report supercedes the previous drainage report submitted for Beckett at Woodmen Hills Filing No. 1. It contains the drainage information for the entire property as shown in Figure 1: Vicinity Map. This map includes areas previously platted as Beckett at Woodmen Hills Filing 1, Filing 2 and Woodmen Hills Filing 7D.

## GENERAL LOCATION AND DESCRIPTION

Beckett at Woodmen Hills, Filing 3, is located approximately 1/2 mile north-northeast of Falcon, Colorado in El Paso County as shown on Figure 1, and further illustrated in Figure 2.

Filing 3, which is platted to be 9.21 acres, is located partly in Section 7, Township 13 South, Range 64 West, and partly in Section 12, Township 13 South, Range 65 West. Planned development for Filing 3 is commercial.

The terrain is generally flat with gentle northwest to southeast slopes ranging from 1% to 3%. The vegetation is typical eastern Colorado prairie grasses with little or no shrubs. Trees are present only near the existing drainage ways. The intermittent streams drain into the Black Squirrel Creek Basin which ultimately outfalls into the Arkansas River.

The site and surrounding area have soil characteristics of hydrologic soil Group A (Columbine and Blakeland) as classified by the Soil Conservation Service (See Figure 4). There are no irrigation facilities, utilities or other encumbrances that affect the drainage analysis of this site.

A FEMA regulated flood plain has been identified running adjacent with Filing 3 as shown in Figure 3.

The drainage design for Beckett at Woodmen Hills Filing 3 is consistent with the Final Drainage Report for Beckett at Woodmen Hills Filing 1 dated March 8, 2001.

## DRAINAGE BASINS AND SUB-BASINS

The Falcon Basin Drainage Basin Planning Study was completed and adopted by El Paso County in December 2000. In addition, a Drainage Plan and Report was submitted to El Paso County for Phase III and Filing 7 Woodmen Hills in February 1999. This report is supplemental to the 1999 report. Drainage Reports have also been accepted and approved for Woodmen Hills Filings 1 through 11 and Drainage Letters have been approved for the Lot 3, Beckett at Woodmen Hills Filing 1 and Lot 2, Beckett at Woodmen Hills Filing No. 2.

Developed condition basins for the Falcon Basin have been detailed in the previously mentioned Phase III Preliminary and Filing 7 Final Drainage and Erosion Control Report. These basin boundaries and designations are consistent with the earlier MDDP and Preliminary and Final Drainage Reports submitted for Woodmen Hills Subdivision Filing numbers 1 through 11 and remain consistent for this property. Beckett at Woodmen Hills Filing No. 3 is contained within basins 35A and 35B (the right-of-way for McLaughlin Road) as detailed in these previous reports.

## **DRAINAGE DESIGN CRITERIA**

### ***SCS Hydrologic Criteria***

The SCS method was used in calculating drainage for Filing 7 (including this property). Please see Phase III Preliminary and Filing 7 Final Drainage and Erosion Control Report for HEC-1 computer model results.

### ***Rational Method Hydrologic Criteria***

The Rational Method was used to estimate stormwater runoff facilities for the 5-year and 100-year design storm. The Rational Method coefficients "C" were selected from Table 5-1 in the Drainage Criteria Manual. The time of concentration is calculated per Drainage Criteria Manual requirements. The intensities for each basin are calculated from Figure 5-1 of the Drainage Criteria Manual based upon the basin time of concentration. Because there is no current development plan for the property, maximum values for C and intensity were used. Proposed developed subbasins used in the Rational Method analysis are detailed in Figure 5.

### ***Detention Storage Criteria***

Detention Pond No. 5 was designed in Woodmen Hills Filing 7 to handle runoff from the Woodmen Hills development, including portions of this property. Please see Phase III Preliminary and Filing 7 Final Drainage and Erosion Control Report for calculations and discussion on design.

## **DRAINAGE FACILITY DESIGN**

### ***General Concept***

This Final Drainage Report for Beckett at Woodmen Hills Filing 3 consists of seven drainage sub-basins as shown on Figure 5. Runoff from the area will drain to McLaughlin Road and to the existing FEMA floodplain along the southern boundary of the site. The direct flow to the FEMA floodplain will be compensated for by over detention of developed flows in Pond No. 5 as designed in the Phase III Preliminary and Filing 7 Final Drainage and Erosion Control Report.

### ***Existing Drainage Characteristics***

Currently, runoff from this property flows south and east and is intercepted by existing roads or flows over the curb and gutter into McLaughlin Road. Existing inlets intercept flows in McLaughlin Road per the Phase III Preliminary and Filing 7 Final Drainage and Erosion Control Report. Please see Phase III Preliminary and Filing 7 Final Drainage and Erosion Control Report for details.

### *Proposed Design Drainage Characteristics*

The sub-basins shown on Figure 5 were developed based on the proposed lot layout for this site. The northwestern area (Basin 1) will be graded to drain to two 10-foot sump inlets located at Design Point 1. The inlets will discharge into an existing storm system and eventually discharge into Detention Pond 5. Design flows are estimated to be 15 cfs and 28 cfs for 5-year and 100-year storm.

Basin 2 contains 4.3 acres and is located in the northeastern part of the site. Runoff drains south to the existing access road from McLaughlin Road. Runoff travels along the curb and gutter to Design Point 2 located at the intersection with McLaughlin Road. Anticipated design flows are 13 cfs and 24 cfs for the 5-year and 100-year storm. Flows are routed south to Design Point 3 to the existing 15-foot on-grade inlet along the western flowline of McLaughlin Road.

Basin 3 contains 1.6 acres west of McLaughlin Road. Runoff drains south to a proposed access road from McLaughlin Road. Runoff is directed east, via curb and gutter, to Design Point 3. Anticipated flows from Basin 3 are 6 cfs and 12 cfs for the 5-year and 100-year storm.

Flows from Basin 2 and 3 are combined at Design Point 3 and intercepted by the existing 15-foot on-grade inlet. Routed flows to Design Point 3 are 17 cfs and 31 cfs. The 15-foot on-grade inlet at Design Point 3 will intercept approximately 10 cfs and 13 cfs and bypass 7 cfs and 18 cfs for the 5-year and 100-year storm. Bypassed flows continue south to Design Point 4.

Basin 4 contains 2.3 acres west of McLaughlin Road. Runoff drains south to a proposed access road from McLaughlin Road. Runoff is directed east and south, via curb and gutter, to an existing inlet in McLaughlin Road at Design Point 4. The inlet discharges directly into the FEMA floodplain. Anticipated design flows for Basin 4 are 6 cfs and 13 cfs for 5-year and 100-year storm. Routed flows from Basin 4 and Design Point 3 are 10 cfs and 25 cfs for the 5-year and 10-year storm at Design Point 4. The existing inlet along the western side of McLaughlin Road is a 5-foot type R inlet. The inlet will not handle the 5-year or 100-year storm. Both storms will overtop the curb and flow into the existing FEMA floodplain. Riprap protection can be added behind the inlet for stabilization.

Basin 5 is along the southern boundary of the site, adjacent to McLaughlin Road. This small basin drains south directly into the FEMA floodplain. Anticipated flows for Basin 5 are 2 cfs and 3 cfs for the 5-year and 100-year storm.

Basin 6 is centrally located and adjacent to the future Meridian Road. Runoff flows south to Design Point 5. Estimated runoff of 8 cfs and 14 cfs will be generated for the 5-year and 100-year storm.

Basin 7 is located along the southern boundary of the site, adjacent to the future Meridian Road. Anticipated flows for Basin 7 are 7 cfs and 13 cfs. Runoff from basins 6 and 7 are routed to Design Point 6 and discharge directly into the FEMA floodplain. Routed flows are estimated to be 14 cfs and 26 cfs for the 5-year and 100-year storm. The discharge structure at Design Point 6 will be designed as part of the individual development plan for these lots. The owner of the lot will be responsible for the installation of the required drainage structure. The structure at Design Point 6 will be equivalent to a 15-foot sump inlet.

## **EROSION CONTROL**

### ***General Concept***

All ditches will be designed to meet El Paso County criteria for slope and velocity. During construction, best management practices for erosion control will be employed based on El Paso County Criteria and the erosion control plans shown in Figure 6.

### ***Detention Ponds***

The detention ponds will act as the primary erosion control facilities for this property and other tributary areas. The ponds will serve dual purposes in facilitating the settling of sediment in runoff during and after construction, and in maintaining runoff to existing levels.

### ***Silt Fencing***

Silt fencing will be placed along the southern and eastern property boundaries. This will prevent suspended sediment from leaving the site during construction. Silt fencing is to remain in place until vegetation is reestablished after completion of construction.

### ***Erosion Bales***

Erosion bales will be placed within the Woodmen Road ditch as check dams. Erosion bales will remain in place until vegetation is reestablished in drainage swales. Erosion bales will also be placed around all inlets to minimize sediment transport.

### ***Miscellaneous***

Best erosion control practices will be utilized as deemed necessary by the Contractor or Engineer and are not limited to the measures described above or as shown in Figure 6.

## COST ESTIMATE

The following table is a summary of estimated costs for proposed drainage improvements and erosion control measures for Beckett at Woodmen Hills Filing 3. The cost estimate submitted herein is based on time-honored practices within the construction industry. As such, the engineer does not control the cost of labor, material, equipment or a contractor's method of determining prices and competitive bidding practices or market conditions. The estimate contained represents our best judgement as design professionals using current information available at the time of preparation. The engineer cannot guarantee that proposals, bids, and/or construction costs will not vary from this cost estimate.

Item	Quantity	Unit	Unit Cost	Extension
<b>Erosion Control Measures</b>				
Erosion Control Hay Bales	8	EA	\$ 15.00	120
Silt Fencing	1,000	LF	\$ 2.00	2,000
<b>Subtotal, Erosion Control Measures</b>				<b>\$ 2,120</b>
<b>Subtotal, All Drainage &amp; Erosion Control</b>				<b>\$ 2,120</b>
<b>Engineering (10%)</b>				<b>\$ 212</b>
<b>Contingency (10%)</b>				<b>\$ 212</b>
<b>TOTAL, DRAINAGE &amp; EROSION CONTROL</b>				<b>\$ 2,544</b>

## Drainage Fees


Drainage fees for Beckett at Woodmen Hills Filing 3 have been paid in the previous submittals for Beckett at Woodmen Hills Filing 1 and Filing 2.

## FIGURES



\\S031ntfile1\6742451\CAD\FIGURES\FG01VMP01.dwg 05/29/2003 12:48:39 PM MDT

# BECKETT AT WOODMEN HILLS

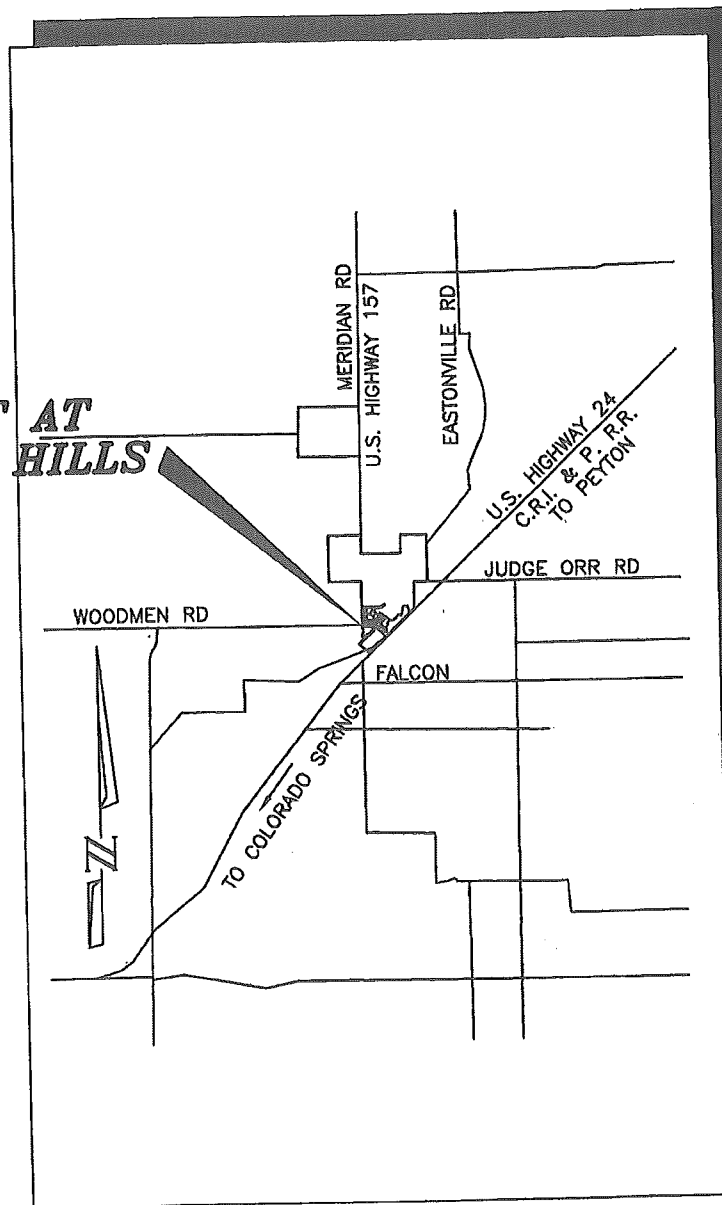

## VICINITY MAP

N.T.S.


BECKETT AT WOODMEN HILLS  
VICINITY MAP

**URS**

PROJ NO. 6742451

FIGURE 1

\\S031ntfile1\6742451\CAD\FIGURES\FG01VMP02.dwg 05/29/2003 12:49:05 PM MDT

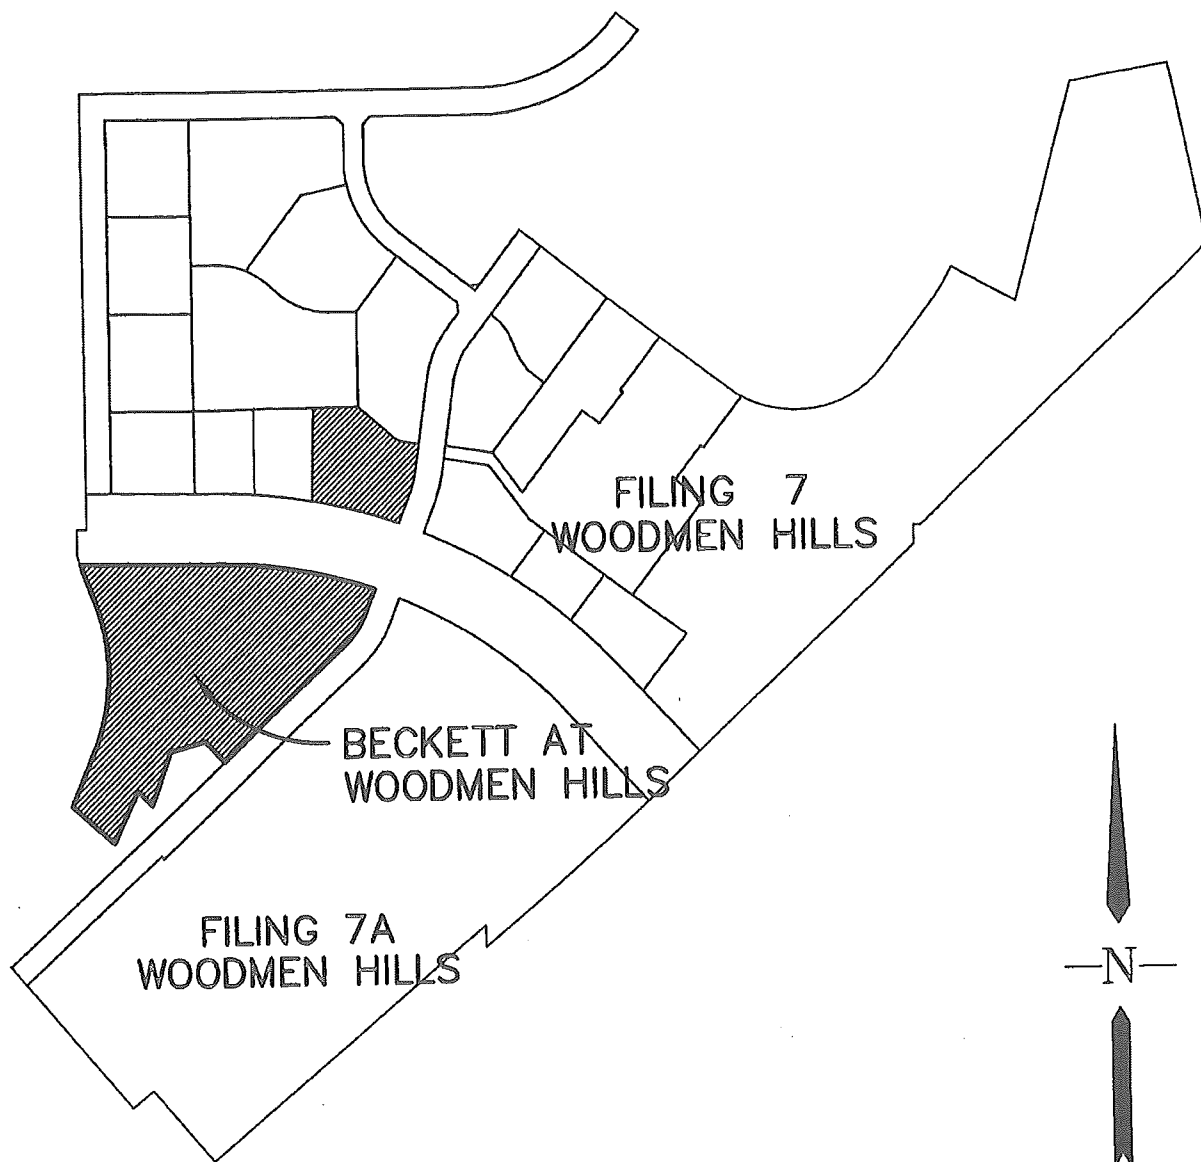

*BECKETT AT  
WOODMEN HILLS*

SITE MAP


NO SCALE

**URS**

PROJ NO. 6742451

FIGURE 2

\\S031ntfile1\6742451\CAD\21710935\figures\FG01FMA03.dwg 05/29/2003 12:50:25 PM MDT

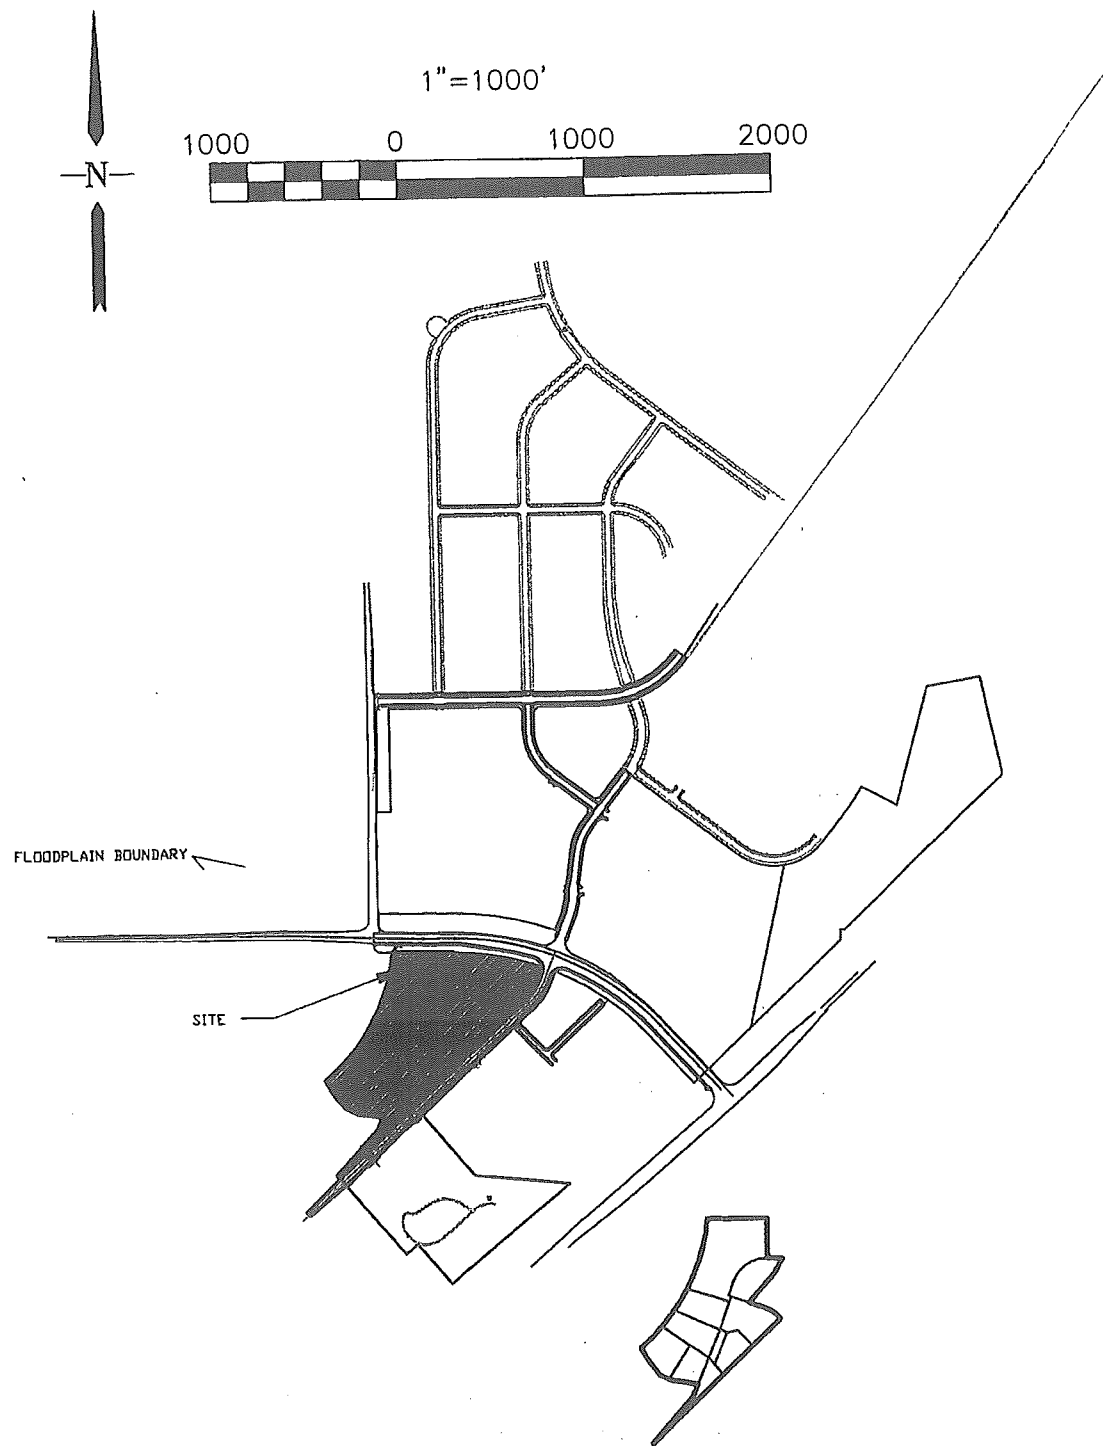

# BECKETT AT WOODMEN HILLS


FEMA FLOOD INSURANCE RATE MAP

**URS**

PROJ NO. 6700042451

FIGURE 3

\\urws167\6742451\CAD\FIGURES\FG01SOIL04.dwg 08/16/2000 09:51:55 AM MDT

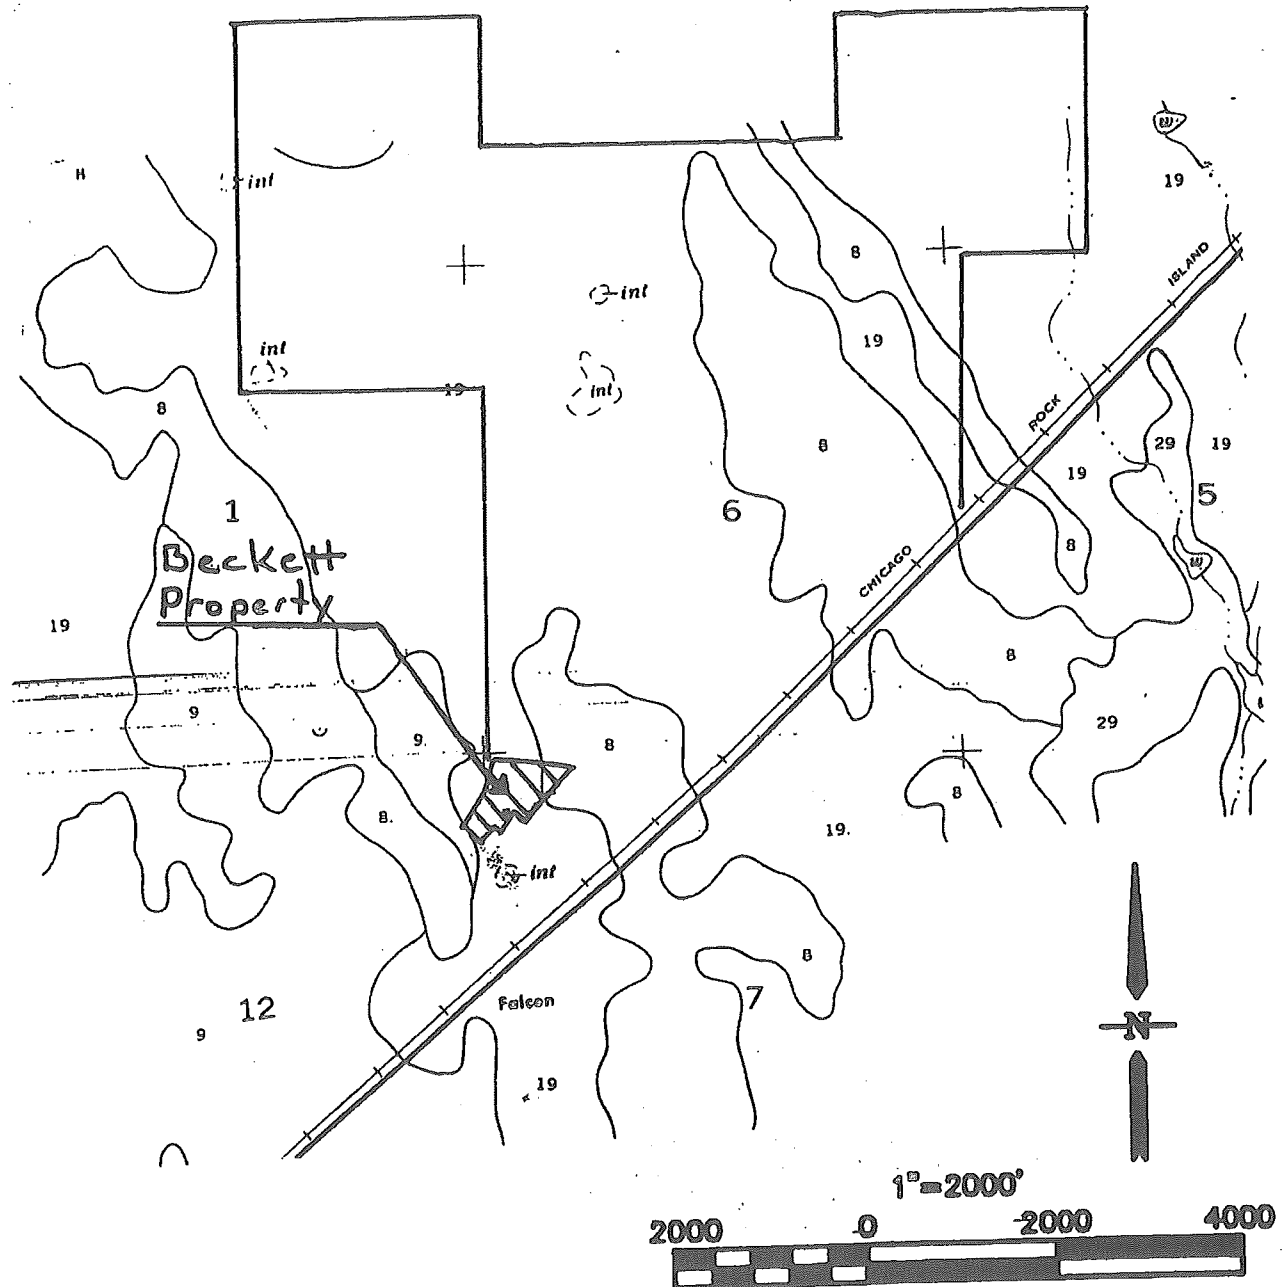

BECKETT AT  
WOODMEN HILLS  
SOILS MAP

URS

PROJ NO. 6742451

FIGURE 4

**APPENDIX A:**  
**Rational Method Calculations**

# BECKETT @ WOODMEN HILLS FILING 3 ON-GRADE INLET CALCULATIONS

Based on Table 7-2 Drainage Criteria Manual

BASED ON LANE 1+2 DRAINAGE CONTROL WORKSHEET																				
DP	Inlet size L(i)	CROSS SLOPE	STREET SLOPE	Q <sub>5</sub>										Q <sub>100</sub>					Bypass	
				Q(5)	Q(100)	Q <sub>i</sub> (5)	T	F <sub>w</sub>	L1	L2	L3	Q <sub>i</sub> (100)	T	F <sub>w</sub>	L1	L2	L3			
3	15	2.0%	2.0%	17	31	10	18	1.9244	27	16	58	13	23	2.0077	36	21	75	7	18	

## BECKETT @ WOODMEN HILLS FILING 3 SUMP INLET CALCULATIONS

Based on formula:  $Q_i = 1.7(L_i + 1.8W)(d_{max} + W^2)^{1.48}$

DP	Inlet size L(i)	CROSS SLOPE	Q(5)	Q(100)	Q <sub>5</sub>					Q <sub>100</sub>					Clogging Factor	Length Final
					Q <sub>i</sub> (5)	d <sub>max</sub>	W	a	Q <sub>i</sub> (100)	d <sub>max</sub>	W	a	Q <sub>i</sub> (100)	Q <sub>100</sub>		
1	16	2.0%	15	28	15	0.5	2	0.17	28	1.0	2	0.2	28	28	1.25	50.000
6	12	2.0%	14	26	14	0.5	2	0.17	26	1.0	2	0.2	26	26	1.25	15.000
4	5	2.0%	10	25	8	0.5	2	0.17	19	1.0	2	0.2	19	19	NA	NA

D	Q	SX	SO
0.48406	22	0.02	0.005
0.41014	20	0.02	0.01
0.38011	20	0.02	0.015
0.36015	20	0.02	0.02
0.3454	20	0.02	0.025
0.33379	20	0.02	0.03

**BECKETT @ WOODMEN HILLS FILING 3**  
**(RATIONAL METHOD Q=CIA)**

BASIN	TOTAL FLOWS			AREA TOTAL (Ac)	WEIGHTED		OVERLAND			CHANNEL			Tc TOTAL (min)	INTENSITY		COMMENTS
	Q(5) (c.f.s.)	Q(100) (c.f.s.)	CA(equiv.) 5YR 100 YR		C(5)	C(100)	Length (ft)	Slope (ft)	Tc (min)	Length (ft)	Slope (%)	Velocity (fps)		I(5) (in/hr)	I(100) (in/hr)	
1	15	28	3.53	3.92	0.90	0.95	35	3.0%	6.5	620	2.0%	4.5	2.3	8.8	4.3	7.4
2	13	24	3.90	4.33	0.90	0.95	130	3.0%	12.6	780	2.0%	4.5	2.9	15.5	3.3	5.8
3	6	12	1.41	1.57	0.90	0.95	30	2.0%	6.9	330	2.0%	5.5	1.0	7.9	4.4	7.8
4	6	13	1.38	2.34	0.59	0.71	25	3.0%	5.5	660	1.9%	6.5	1.7	7.2	4.6	8.0
5	1	3	0.13	0.37	0.35	0.45	25	3.0%	5.5	360	2.0%	7.5	0.8	6.3	4.8	8.4
6	8	14	1.60	1.78	0.90	0.95	25	3.0%	5.5	280	3.1%	8.5	0.5	6.1	4.9	8.5
7	7	13	1.46	1.62	0.90	0.95	25	3.0%	5.5	220	3.0%	5.5	0.7	6.2	4.8	8.5

# BECKETT @ WOODMEN HILLS FILING 3 SURFACE ROUTING

DESIGN POINT	CONTRIBUTING BASINS	CA (equivalent)		Tc (min.)	INTENSITY		TOTAL FLOWS	
		CA(5)	CA(100)		I(5) (in/hr)	I(100) (in/hr)	Q(5) (cfs)	Q(100) (cfs)
2	2	3.90	4.11	15.5	3.3	5.8	13	24
		TRAVEL TIME						
		3.90	4.11	Type/flow	Length (ft)	Velocity (fps)	d. Time (min)	T. Time (min)
					320	4.5	1.2	16.7
3	2 3	3.90	4.11	16.7	3.2	5.6	17	31
		1.41	1.49	TRAVEL TIME				
		5.31	5.61	Type/flow	Length (ft)	Velocity (fps)	d. Time (min)	T. Time (min)
					660	4.5	2.4	19.1
4	4 2,3	1.38	1.66	19.1	3.0	5.2	20	38
		5.31	5.61	TRAVEL TIME				
		6.69	7.27	Type/flow	Length (ft)	Velocity (fps)	d. Time (min)	T. Time (min)
5	6	1.60	1.69	6.1	4.9	8.5	8	14
		TRAVEL TIME						
		1.60	1.69	Type/flow	Length (ft)	Velocity (fps)	d. Time (min)	T. Time (min)
					210	4.5	0.8	6.9
6	6 7	1.60	1.69	6.9	4.7	8.2	14	26
		1.46	1.54	TRAVEL TIME				
		3.06	3.23	Type/flow	Length (ft)	Velocity (fps)	d. Time (min)	T. Time (min)

D Flows intercepted at DP-3 are 10 cfs and 13 cfs  
 this flow is removed from the 20 cfs and 38 cfs  
 routed flows ,
 

20 cfs	38 cfs
- 10 cfs	- 13 cfs
= 10 cfs 5 year	= 25 cfs 100 yr

 at DP-4



# BECKETT @ WOODMEN HILLS FILING 3 ON-GRADE INLET CALCULATIONS

Based on table 7-2 Drainage Criteria Manual

DP	Inlet size L(0)	CROSS SLOPE	STREET SLOPE	Q <sub>s</sub>										Q <sub>100</sub>						Bypass	
				Q(5)	Q(100)	Q(5)	T	F <sub>w</sub>	L1	L2	L3	Q(100)	T	F <sub>w</sub>	L1	L2	L3	Q <sub>s</sub>	Q <sub>100</sub>		
3	15	2.0%	2.0%	17	31	10	18	1.9244	27	16	58	18	23	2.0077	36	21	75	7	18		

## BECKETT @ WOODMEN HILLS FILING 3 SUMP INLET CALCULATIONS

Based on formula:  $Q_s = 1.7(L_i + 1.8W)(d_{max} + W/12)^{1.48}$

DP	Inlet size L(0) Initial	CROSS SLOPE	Q(5)	Q(100)	Q <sub>s</sub>					Q <sub>100</sub>					Clogging Factor	Length Final
					Q(5)	d <sub>max</sub>	W	a	Q(100)	d <sub>max</sub>	W	a				
1	16	2.0%	15	28	15	0.5	2	0.17	28	1.0	2	0.2	1.25	20(100)		
6	12	2.0%	14	26	14	0.5	2	0.17	26	1.0	2	0.2	1.25	15(100)		
4	5	2.0%	10	25	8	0.5	2	0.17	19	1.0	2	0.2	NA	NA		

D	Q	SX	SO
0.48406	22	0.02	0.005
0.41014	20	0.02	0.01
0.38011	20	0.02	0.015
0.36015	20	0.02	0.02
0.3454	20	0.02	0.025
0.33579	20	0.02	0.03

# STREET CAPACITY

FOR 1/2 STREET SECTION

	Formula	Longitudinal Slope	Cross Slope	n	Curb Type	Depth of flow	Q <sub>max</sub>	Q	Comments
Residential	$Q=170.2 S^{1/2}$	0.5%	0.02	0.016	V/R	0.5	34	12.0	County ramp curb is 6"
		1.0%					34	17.0	
		1.5%					34	20.8	
		2.0%					34	24.1	
		2.5%					34	26.9	
		3.0%					34	29.5	
		3.5%					34	31.8	
		4.0%					34	34.0	
Collector/Arterial	$Q=171.7 S^{1/2}$	0.5%	0.02	0.016	V	0.5	34	12.0	
		1.0%					34	17.0	
		1.5%					34	20.8	
		2.0%					34	24.1	
		2.5%					34	26.9	
		3.0%					34	29.5	
		3.5%					34	31.8	
		4.0%					34	34.0	



GENERAL NOTES:

- ALL DRAWING CONSTRUCTION SHALL MEET THE SPECIFICATIONS OF THE CITY OF COLORADO SPRINGS/ PASO COUNTY DRAINAGE DESIGN MANUAL. THE CONTRACTOR SHALL BE RESPONSIBLE FOR THE NOTIFICATION AND FIELD LOCATION OF ALL EXISTING UTILITIES. WHETHER SHOWN ON THE PLANS OR NOT, BEFORE BEGINNING CONSTRUCTION. LOCATION OF EXISTING UTILITIES SHALL BE VERIFIED BY THE CONSTRUCTION PERSONNEL PRIOR TO ANY CONSTRUCTION BEING INITIATED. A REPORT FOR THIS SITE, DATED NOVEMBER 17, 2006 SHALL BE CONSIDERED A PART OF THESE PLANS AND SHALL BE REFERRED TO AS "REPORT FOR THIS SITE".
- THE CONTRACTOR SHALL HAVE AT LEAST ONE (1) SIGNED COPY OF THESE APPROVED PLANS AND SALES REPORT PREPARED FOR THIS SITE AT ALL TIMES. THESE PLANS AND SALES REPORT SHALL BE KEPT ON THE JOB SITE AND SHALL BE SUBMITTED TO THE FOLLOWING:
1. THE CITY OF COLORADO SPRINGS/ PASO COUNTY DRAINAGE DESIGN MANUAL
2. THE CITY OF COLORADO SPRINGS/ PASO COUNTY DRAINAGE DESIGN MANUAL
3. THE CITY OF COLORADO SPRINGS/ PASO COUNTY DRAINAGE DESIGN MANUAL

A PRE-CONSTRUCTION MEETING BETWEEN THE CONTRACTORS, ENGINEER, AND EL PASO COUNTY DEPARTMENT OF TRANSPORTATION WILL BE HELD PRIOR TO ANY CONSTRUCTION. IT IS THE RESPONSIBILITY OF THE CONTRACTOR TO COORDINATE THE MEETING TIME AND PLACE WITH ALL PERSONS TO ATTEND.

1. ALL APPROPRIATE PERMITS (SUCH AS EL PASO COUNTY GRADING PERMIT, NIPCOB, FLOODPLAIN DEVELOPMENT, 404 a/c) MUST BE OBTAINED BY THE CONTRACTOR PRIOR TO CONSTRUCTION.
2. CONSTRUCTION STARTUP WILL BE PROVIDED BY THE ENGINEER.
3. GRADING OPERATIONS TO BEGIN IN FEBRUARY 2003, TO BE COMPLETED FEBRUARY 2004.
4. ALL FILL & CUT SUPPLIES SHALL NOT EXCEED 30' Ht.
5. ALL PROPOSED CONTIGUOUS AND SPOT ELEVATIONS SHOWN WITHIN THE RIGHT-OF-WAY ARE TO FINISHED GRADE.
6. THE USER IS NOT RESPONSIBLE FOR THE ACCURACY OF THE EXISTING CONDITIONS.
7. ALL DISBURSED SUPPLIES SHALL BE RECOVERED WITH THE USED AND SHOWN SUPPLY BEDD ON APPROX. EQUAL TWO WEEKS AFTER FINAL GAUGE IS ACHIEVED. EXCESS SUPPLY MATERIAL SHALL BE USED ON SHOWN SUPPLIES WHICH ARE EQUAL TO OR GREATER THAN 30' Ht. SUPPLY.
8. DRAINAGE CONTROL WILL CONSIST OF BUT NOT LIMITED TO STRAIN BARS PLACED AT THE POSITION SHOWN ON THIS PLAN, AND TOP SOIL MIXED WITH GRASS SEED TO BE PLACED ON TOP OF STRAIN BARS.
9. THE ENGINEER CANNOT GUARANTEE OR OVERSEE THE RESPONSIBILITY OF THE DEVELOPER TO MONITOR AND REPLACE EROSION AND REBUILD AS NECESSARY UNTIL VEGETATION IS ESTABLISHED.
10. DRAINAGE CONTROL MEASURES SHALL BE IMPLEMENTED IN A MANNER THAT WILL PROTECT ADJACENT PROPERTIES AND PUBLIC FACILITIES FROM THE ADVERSE EFFECTS OF EROSION AND SEDIMENTATION AS A RESULT OF CONSTRUCTION AND EARTHWORK ACTIVITIES WITHIN THE PROJECT SITE.
11. EROSION CONTROL MEASURES TO BE DOCKSLOUR VELOCITY CURLEX BAR OR EQUIVALENT, FOR ALL SLOPES EQUAL TO OR GREATER THAN 3:1.
12. ADDITIONAL STRUCTURES MAY BE REQUIRED AT TIME OF CONSTRUCTION.
13. ADDITIONAL MEASURES MAY BE REQUIRED.

10. OWNER IS RESPONSIBLE FOR IMPLEMENTATION OF STORM WATER MANAGEMENT PLAN.

1. ALL REQUIRED MODIFICATIONS OF THE APPROVED GRADING AND EROSION CONTROL PLAN MUST BE SUBMITTED ALONG WITH SUPPORTING MATERIALS TO THE COUNTY ENGINEER, NO WORK IN CONNECTION WITH THE PROPOSED MODIFICATIONS SHALL BE PERMITTED WITHOUT PRIOR APPROVAL OF THE COUNTY ENGINEER. THE ENGINEER'S REVIEW OF THE MODIFICATIONS WILL BE LIMITED TO THE MODIFICATIONS THAT WILL PRODUCE SOIL EROSION CONTROLS EQUITABLE TO, OR BETTER THAN, THAT OF THE ORIGINALLY APPROVED SOIL EROSION CONTROL PLAN.
2. LOCATE AND PLACE MARKS TO THE AUTOMATIC PAVING OF CONSTRUCTION FOR DISTURBED AREAS THAT WILL INTERFERE OR CAUSE OR MORE AFTER CONSTRUCTION OF THE PROJECT. THE OWNER OR OPERATOR OF THE CONSTRUCTION ACTIVITY SHALL SUBMIT A PERMIT APPLICATION FOR STOP/START DISCHARGE TO THE COLORADO DEPARTMENT OF PUBLIC HEALTH AND ENVIRONMENT, WATER QUALITY CONTROL, BEFORE THE APPLICATION FOR STOP/START CERTIFICATION OF COMPLETION OF CONSTRUCTION OF THE PROJECT IS SUBMITTED TO THE COLORADO DEPARTMENT OF PUBLIC HEALTH AND ENVIRONMENT. THE APPLICATION FOR APPLICATION MATERIALS CONTROL.
3. COLORADO DEPARTMENT OF PUBLIC HEALTH AND ENVIRONMENT WATER QUALITY CONTROL, DENVER, COLORADO 80246-1330
4. COLORADO PERMITS DIVISION, 1400 SOUTH COCKEY AVE, DENVER, COLORADO 80202-1500
5. SOIL SHALL NOT BE STOCKPILED FOR MORE THAN 6 MONTHS. ADDITIONAL EROSION CONTROL MEASURES MAY BE REQUIRED IF STOCKPILED MATERIAL, DUSTS, & SOIL SHALL STOCKPILES ARE LOCATED WITHIN 100 FEET OF INHABITED AREAS. ADDITIONAL EROSION CONTROLS MAY BE NECESSARY, SUCH AS DIVERSION DICES OR BUILT FENCE.
6. ALL DISTURBED AREAS, OUTSIDE OF THE PROPOSED PAYMENT WILL REQUIRE RESEEDING WITHIN TWO WEEKS OF ESTABLISHING FINAL GRADE.
7. AFTER FINISHING RESEED, SOIL SURFACE ESTABLISHMENT SHALL BE APPLIED TO ALL DISTURBED AREAS THAT MAY NOT BE AT FINAL GRADE BUT WILL REMAIN DOMINANT (UNCOVERED) FOR PERIODS LONGER THAN AN ADDITIONAL 30 CALENDAR DAYS. TEMPORARY RESEEDING IS REQUIRED ON ALL DISTURBED AREAS HAVING A PERIOD OF EXPOSURE PRIOR TO FINAL ESTABLISHMENT OF 6 MONTHS OR LONGER. RESEEDING IS REQUIRED TO PRODUCE AGRICULTURAL COVER ON ALL DISTURBED AREAS WHICH WILL NOT BE PLANTED OR SOIL PLANT FOR A PERIOD OF 1 YEAR OR LONGER ON AN ANNUAL RESEEDING SCHEDULE OF TIME.
8. GRADING OUTSIDE OF THE PROJECT BOUNDARIES MAY REQUIRE TEMPORARY CONSTRUCTION EASEMENTS. THE DEVELOPER IS RESPONSIBLE FOR OBTAINING ANY

### EROSION CONTROL

**STEPS FOR CONSTRUCTION:**

THE ANTICIPATED START FOR THIS PROJECT IS FEBRUARY 2003 WITH AN ANTICIPATED COMPLETION DATE OF FEBRUARY 2004.

- CONSTRUCTION OF EROSION CONTROL STRUCTURES
- ROUGH GRADING
- FINISH GRADING
- FINAL INSPECTION

### TRACKING THE EQUIPMENT CONTROLS

SILT FENCES AND STRAW BALE CHECK DAMS WILL BE INSTALLED IMMEDIATELY AFTER ANY EXCAVATION FOR THE MAJOR ROADS. STRAW BALE CHECK DAMS WILL BE PLACED AT ALL ENTRANCES AND EXITS OF DRAINAGEWAYS. THE TEMPORARY SEDIMENTATION POUNDS WILL ALSO BE USED AS AN INFILTRATION POND FOR TRAPPING ANY SEDIMENT-LADEN RUNOFF FROM NEW CONSTRUCTION. STRAW BALES WILL BE INSTALLED AROUND THE OUTLET AND CHECK DAM STRUCTURES. THE OUTLET STRUCTURES WILL ALSO BE

STAMP BOLTS WILL BE INSTALLED IN A ROW  
PROTECTED WITH RIP RAP ON THE DOWNSTREAM

NON-STRUCTURE PRACTICES TO CONTROL EROSION AND SEDIMENTATION WILL INCLUDE RECOVERING OF GROUND COVER IN DISTURBED AREAS ACCORDING TO THE EROSION CONTROL PLAN. TEMPORARY SEEDING OF THE DETENTION POND AND MULCHING ALONG STEEP EMBANKMENTS WILL BE PERFORMED WHEN FEASIBLE.

## MATERIAL HANDLING AND SOIL DECONTAMINATION


THE MOST PROBABLE SOURCE OF NON-STRENGTHEN POLLUTION IS REFUELING AND DAILY MAINTENANCE OPERATIONS. IF MOBILE FUEL TENDERS ARE USED TO SERVICE EQUIPMENT, AIRBORNE MATERIALS AND CONTAMINANTS FOR THE STORAGE OF USED AIRBORNE MATERIAL WILL BE CLOSE BY. IF A FUEL TANK IS LIFT ON SITE, IDEAS WILL BE BUILT AROUND THE TANK TO CAPTURE ANY SPILLED FUEL. AGAIN, AIRBORNE MATERIALS AND THEIR CONTAMINANTS WILL BE ON HAND.

# FINAL STABILIZATION AND LONG TERM STORMWATER MANAGEMENT

ONCE THE MAJOR ROADS ARE PAVED AND THE SURROUNDING DISTURBED AREAS ARE 70 % ESTABLISHED WITH VEGETATION, THE STRAIN BALE CHECK DAMS AND THE SILT FENCES AROUND THE STREETS CAN BE REMOVED. AFTER COMPLETION OF THE STORM WATER SYSTEM, THE STRAIN BALES AROUND THE ALLEYS CAN BE REMOVED. AFTER ALL GROUND RESTORATION CONSTRUCTION HAS BEEN COMPLETED AND ALL SLOPES ARE TOP ESTABLISHED WITH VEGETATION, REMAINING STRAIN BALE CHECK DAMS AND SILT FENCES CAN BE REMOVED. THE RIP RAP ON ANY OF THE DOWDLETS WILL REMAIN AFTER CONSTRUCTION TO REDUCE EROSION OF THE CHANNELS. ANY STRALES WILL BE LANDSCAPED TO SLOW RUNOFF AND FILTER SEDIMENT.

**STOCKS**

- ALL PUMPERS AND RECEIPTS SHALL BE EQUIPPED WITH FUNCTIONAL IDS TO PREVENT RAIN AND SNOW FROM ENTERING CONTAINERS.
- ALL PUMPERS, CONTAINERS, DRUMS AND BAGS SHALL BE STORED AWAY FROM DIRECT TRAFFIC ROUTES TO PREVENT ACCIDENTAL SPILLS.
- EMPTY DRUMS SHALL BE COVERED TO PREVENT COLLECTION OF PRECIPITATION.
- CONTAINERS SHALL BE STORED IN A MANNER TO AVOID AN OVERFLOW OF PRECIPITATION TO THE GROUND.
- REGULARLY SCHEDULED REMOVAL OF CONSTRUCTION TRASH AND DEBRIS. THE CONTRACTOR IS CERTAINLY NOT LIMITED TO THOSE HANDSOME MEASURES, AND MAY IMPLEMENT FURTHER CONTROLS AS PRODUCE AND GOOD JUDGMENT DICTATE.

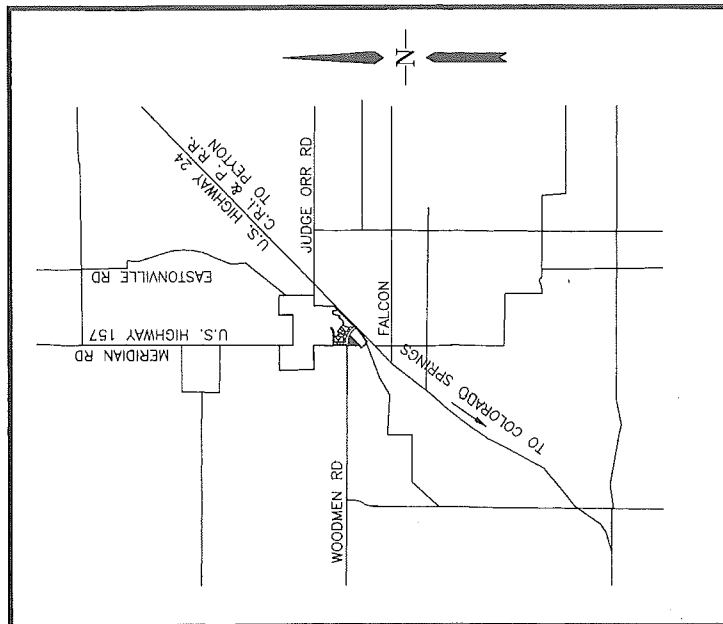VICINITY MAP  
N.T.S.

*SHEET INDEX*

1. COVER SHEET

## DEVELOPERS STATEMENT:

1. THE DEVELOPER HAVE REVIEWED AND WILL COMPLY WITH ALL OF THE REQUIREMENTS SPECIFIED IN THIS GRADING AND EROSION CONTROL PLAN

Andrew C. Beckwith  
BECKETT DEVELOPMENT  
DATE: 6/9/63

[illegible]

THESE PLANS WERE PREPARED FOR OR ON BEHALF OF URS UNDER THE SUPERVISION OF:

William P. Chaffin *W. P. Chaffin* 1/4/02  
 WILLIAM DOUGLAS CHAFFIN P.E. 35136 DATE

COUNTY PLAN REVIEW IS PROVIDED ONLY FOR GENERAL CONFORMANCE WITH COUNTY DESIGN CRITERIA. THE COUNTY IS NOT RESPONSIBLE FOR THE ACCURACY AND ADEQUACY OF THE DIMENSIONS, AND/OR ELEVATIONS WHICH SHALL BE CONFIRMED AT THE JOB SITE. THE COUNTY ASSUMES NO RESPONSIBILITY FOR THE APPROVAL OF THIS DOCUMENT ASSUMES NO RESPONSIBILITY FOR COMPLETION AND/OR ACCURACY OF THIS DOCUMENT.


*John A. McCarty*  
JOHN A. MCCARTY, P.E.  
COUNTY ENGINEER/DIRECTOR

ANY PROPOSED MODIFICATION TO THE APPROVED GRADING AND EROSION CONTROL PLAN MUST BE SUBMITTED, ALONG WITH SUPPORTING DOCUMENTS, TO THE COUNTY ENGINEER FOR APPROVAL PRIOR TO ANY WORK RELATED TO THE PROPOSED MODIFICATION TAKING PLACE. APPROVAL FROM THE COUNTY ENGINEER SHALL BE ISSUED IF THE APPLICANT DEMONSTRATES THAT THE MODIFICATION WILL PROVIDE SOIL EROSION CONTROLS EQUIVALENT TO OR EXCEEDING THOSE OF THE PREVIOUSLY APPROVED GRADING AND EROSION CONTROL PLAN.


DEVELOPERS STATEMENT:

1. THE DEVELOPER HAVE REVIEWED AND WILL COMPLY WITH ALL OF THE REQUIREMENTS SPECIFIED IN THIS GRADING AND EROSION CONTROL PLAN


Andrew C. Beckwith  
BECKETT DEVELOPMENT  
DATE: 6/9/63

REVISIONS:		ENGINEER DESIGNED BY: DC DATE: 2-26-03	
NO.	DESCRIPTION	DATE	
		DRAWN BY: DC DATE: 2-26-03	
		CHECKED BY: DC DATE: 2-26-03	
		48 HOURS BEFORE YOU DIG, CALL UTILITY LOCATORS 1-800-922-1987 (SEE COVER FOR LIST OF UTILITY CONTRACTORS)	
		 <b>URS</b> 10000 WILLOW AVE. SUITE 2000 SPRINGFIELD, MA 01104-2000 TEL: 413/246-0000 FAX: 413/246-0001	
		PROJECT: <u>BECKETT AT W</u>	
		SHEET TITLE: <u>ROUGH GRADING</u>	
		FROM: _____ TC _____	
		JOB NO.: <u>2710935</u>	

AMOUNT IN U.S. DOLLARS PER ACRE	
2.0	
2.0	
2.0	
0.5	
0.5	
1.0	

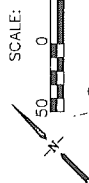

NOTE: CONTOURS SHOWN ARE  
DRAINING ONLY. FINAL DRAINAGE  
DEVELOPED FOR EACH INDIVIDUAL

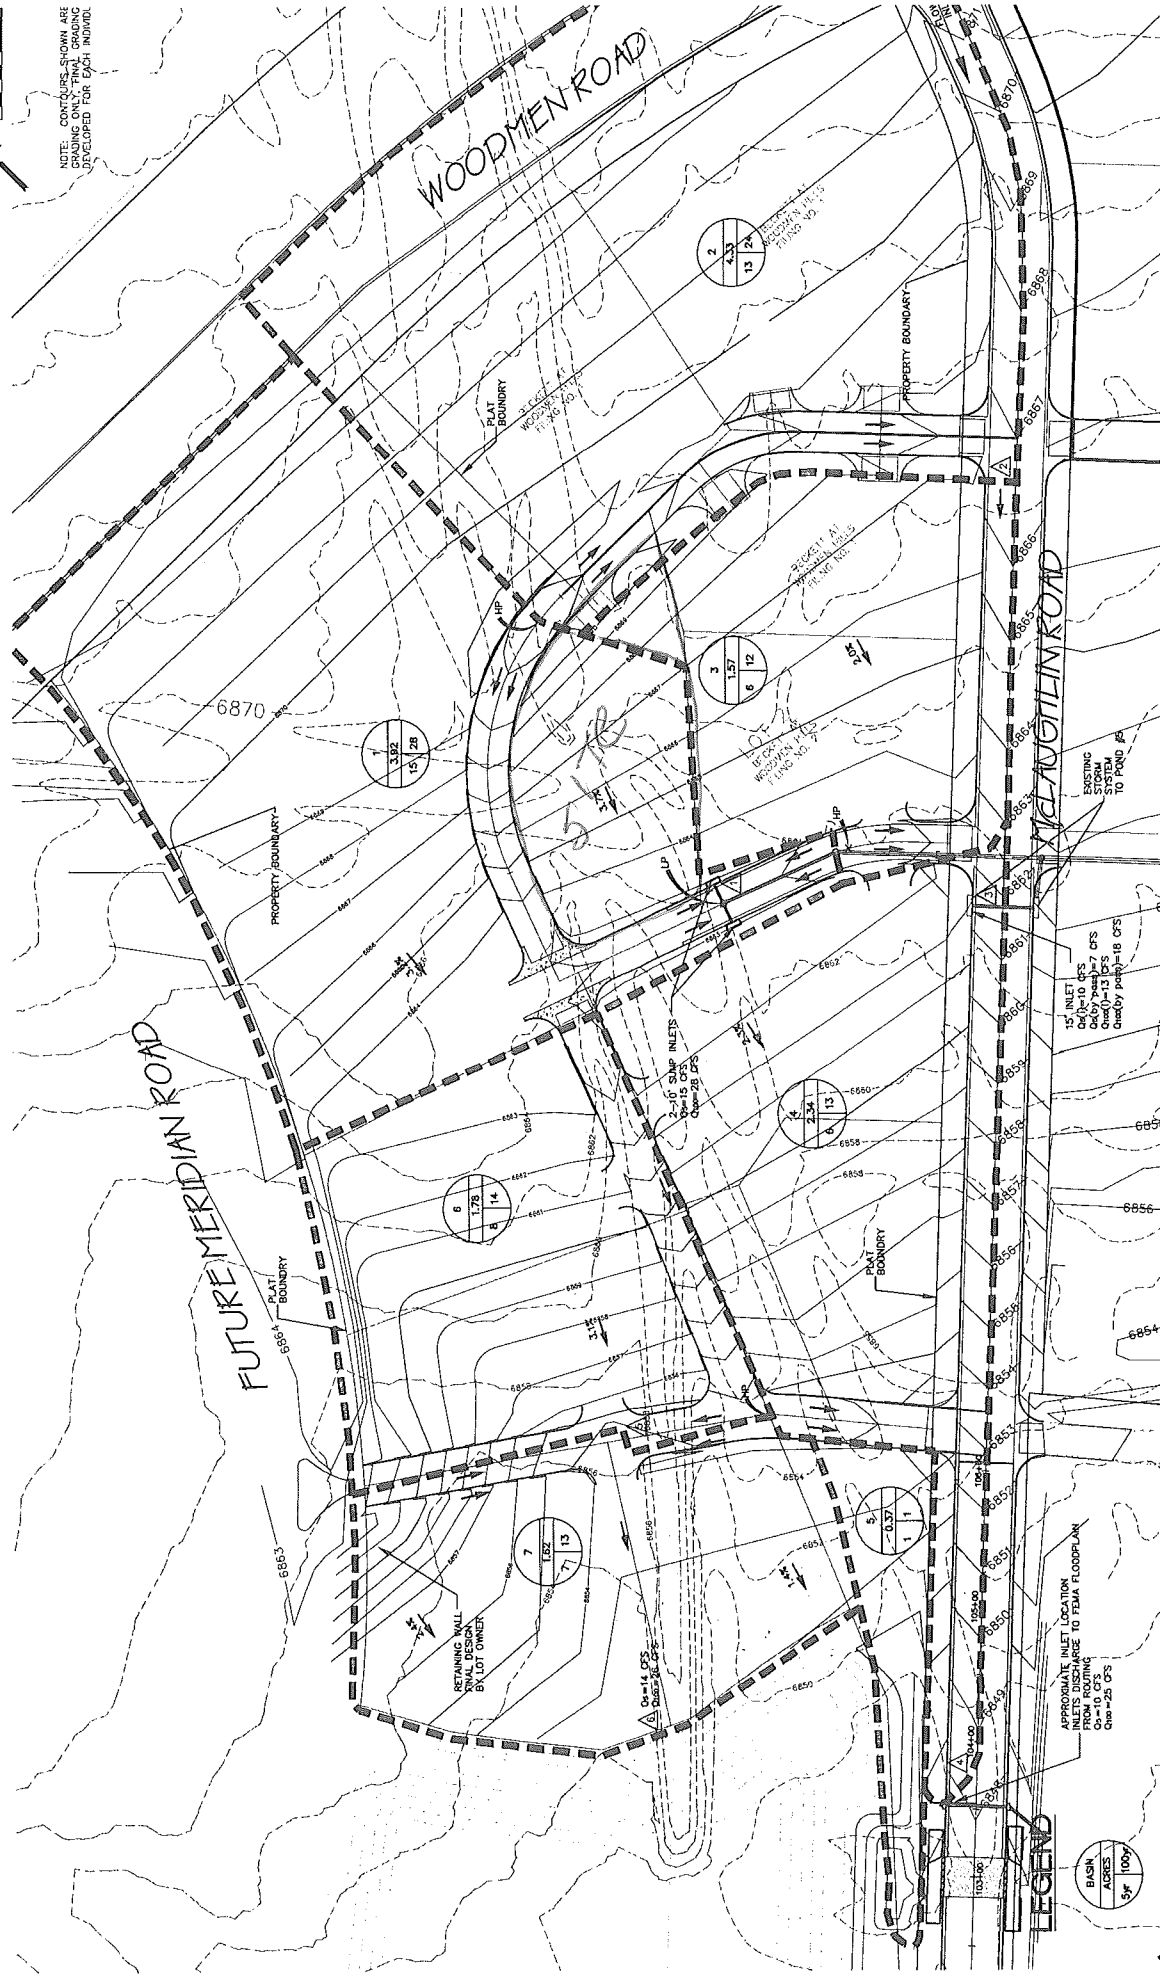

REVISIONS:		ENGINEER:		DESIGNED BY:		DATE:	
NO.	DESCRIPTION	DATE		DC	DATE	2-1-01	
						2-1-01	
						2-1-01	
48 HOURS BEFORE YOU DIG  
 CALL UTILITY LOCATIONS  
 1-800-922-1987  
 U.S. DEPARTMENT OF TRANSPORTATION  
 U.S. HIGHWAY SAFETY AND ADMINISTRATION

PROJECT: BECKETT AT WOODMEN  
 SHEET TITLE: GRADING AND DRAINAGE  
 FROM: \_\_\_\_\_ TO: \_\_\_\_\_  
 JOB NO.: 8742451

URS  
 10000 JPMC SUITE 110  
 60000 SHANNON GARDENS  
 FARM

**LEGEND**







BASIN  
 5' 100'

BASIN BOUNDARY

RETAINING WALL

DESIGN POINT

# Markup Summary

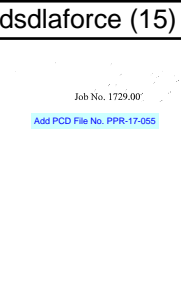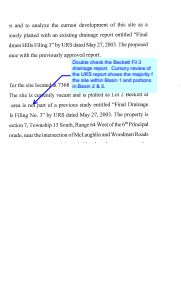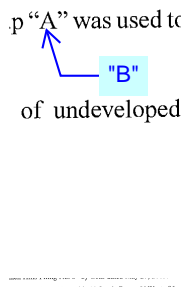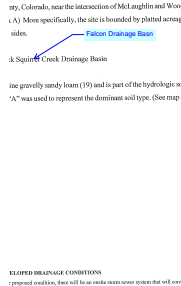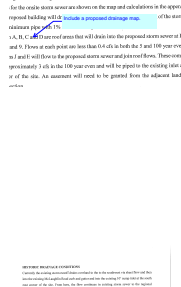	<div><div><div><div>Subject: Text Box</div><div>Page Label: 1</div><div>Lock: Locked</div><div>Status:</div><div>Checkmark: Unchecked</div><div>Author: dsdlaforce</div><div>Date: 1/11/2018 2:35:57 PM</div><div>Color: <span></span></div></div></div></div>	Add PCD File No. PPR-17-055
	<div><div><div><div>Subject: Callout</div><div>Page Label: 4</div><div>Lock: Locked</div><div>Status:</div><div>Checkmark: Unchecked</div><div>Author: dsdlaforce</div><div>Date: 1/11/2018 2:35:58 PM</div><div>Color: <span></span></div></div></div></div>	Double check the Beckett Fil 3 drainage report.  Cursorsory review of the URS report shows the majority f the site within Basin 1 and portions in Basin 2 & 3.
	<div><div><div><div>Subject: Callout</div><div>Page Label: 4</div><div>Lock: Locked</div><div>Status:</div><div>Checkmark: Unchecked</div><div>Author: dsdlaforce</div><div>Date: 1/11/2018 2:36:00 PM</div><div>Color: <span></span></div></div></div></div>	"B"
	<div><div><div><div>Subject: Callout</div><div>Page Label: 4</div><div>Lock: Locked</div><div>Status:</div><div>Checkmark: Unchecked</div><div>Author: dsdlaforce</div><div>Date: 1/11/2018 2:35:59 PM</div><div>Color: <span></span></div></div></div></div>	Falcon Drainage Basn
	<div><div><div><div>Subject: Callout</div><div>Page Label: 5</div><div>Lock: Locked</div><div>Status:</div><div>Checkmark: Unchecked</div><div>Author: dsdlaforce</div><div>Date: 1/11/2018 2:36:05 PM</div><div>Color: <span></span></div></div></div></div>	Include a proposed drainage map.
	<div><div><div><div>Subject: Callout</div><div>Page Label: 5</div><div>Lock: Locked</div><div>Status:</div><div>Checkmark: Unchecked</div><div>Author: dsdlaforce</div><div>Date: 1/11/2018 2:36:20 PM</div><div>Color: <span></span></div></div></div></div>	Include the pond name of the regional detention pond.  Identify if the regional pond incorporated water quality or if it is flood control only.  If not, then this property may be required to provide WQCV.  State whether or not the regional pond accounted for developed runoff for this subdivision.

Identify which subbasin of the URS report this is a part of.

CONDITIONS

not drains overlaid to the to the southwest via shoe and curb and gutter and into the existing 10" sump in

**Subject:** Callout  
**Page Label:** 5  
**Lock:** Locked  
**Status:**  
**Checkmark:** Unchecked  
**Author:** dsdlaforce  
**Date:** 1/11/2018 2:36:02 PM  
**Color:** ■

Identify which subbasin of the URS report this is a part of.

Revise. Reference the Intensity-Frequency-Duration Curve (Figure 6-5) for obtaining the intensity.

11

**Subject:** Cloud+  
**Page Label:** 5  
**Lock:** Locked  
**Status:**  
**Checkmark:** Unchecked  
**Author:** dsdlaforce  
**Date:** 1/11/2018 2:36:04 PM  
**Color:** ■

Revise. Reference the Intensity-Frequency-Duration Curve (Figure 6-5) for obtaining the intensity.

DISCLAIMER STATEMENT

Regulation of flood risk is a complex task and requires a high level of expertise and resources. The URS Corporation and its affiliates are not responsible for the accuracy or completeness of the information provided in this report. The URS Corporation and its affiliates are not responsible for the accuracy or completeness of the information provided in this report.

DISCLAIMER STATEMENT

The URS Corporation and its affiliates are not responsible for the accuracy or completeness of the information provided in this report. The URS Corporation and its affiliates are not responsible for the accuracy or completeness of the information provided in this report.

**Subject:** Text Box  
**Page Label:** 6  
**Lock:** Locked  
**Status:**  
**Checkmark:** Unchecked  
**Author:** dsdlaforce  
**Date:** 1/11/2018 2:36:16 PM  
**Color:** ■

List the 4 step process (I.7.2) and summarize how each step were considered/incorporated.

OPINION

List the on-site storm drain.

EMENTS AT THIS TIME.

Procedures are followed from the most recent

**Subject:** Callout  
**Page Label:** 6  
**Lock:** Locked  
**Status:**  
**Checkmark:** Unchecked  
**Author:** dsdlaforce  
**Date:** 1/11/2018 2:36:06 PM  
**Color:** ■

List the on-site storm drain.

Final Drainage Report for Becken at Woodloch Hills FI

Include the Falcon DBPS.

**Subject:** Callout  
**Page Label:** 8  
**Lock:** Locked  
**Status:**  
**Checkmark:** Unchecked  
**Author:** dsdlaforce  
**Date:** 1/11/2018 2:36:08 PM  
**Color:** ■


Include the Falcon DBPS.

Provide a drainage map.

17

**Subject:** Callout  
**Page Label:** 17  
**Lock:** Locked  
**Status:**  
**Checkmark:** Unchecked  
**Author:** dsdlaforce  
**Date:** 1/11/2018 2:36:09 PM  
**Color:** ■


Provide a drainage map.

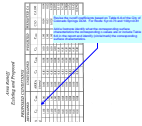

**Subject:** Callout  
**Page Label:** 17  
**Lock:** Locked  
**Status:**  
**Checkmark:** Unchecked  
**Author:** dsdlaforce  
**Date:** 1/11/2018 2:36:10 PM  
**Color:** ■


Revise the runoff coefficients based on Table 6-6 of the City of Colorado Springs DCM. For Roofs: 5yr=0.73 and 100yr=0.81

Add a footnote identify what the corresponding surface characteristics the corresponding c-values are or include Table 6-6 in the report and identify (circle/mark) the corresponding surface characteristics.

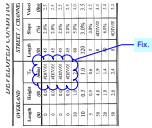

**Subject:** Cloud+  
**Page Label:** 18  
**Lock:** Locked  
**Status:**  
**Checkmark:** Unchecked  
**Author:** dsdlaforce  
**Date:** 1/11/2018 2:36:12 PM  
**Color:** ■

Fix.

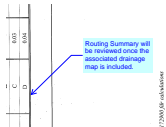

**Subject:** Callout  
**Page Label:** 19  
**Lock:** Locked  
**Status:**  
**Checkmark:** Unchecked  
**Author:** dsdlaforce  
**Date:** 1/11/2018 2:36:13 PM  
**Color:** ■

Routing Summary will be reviewed once the associated drainage map is included.