

SCHMIDT PARCEL REZONE MULTI-DWELLING

BEING A PORTION OF THE SOUTHWEST 1/4 AND THE SOUTHWEST 1/4 OF THE SOUTHEAST 1/4 OF SECTION 32, TOWNSHIP 12 SOUTH, RANGE 65 WEST OF THE 6TH PRINCIPAL MERIDIAN

EL PASO COU, COLORADO


REZONE RM 30

LEGAL DESCRIPTION

PROPERTY DESCRIPTION - PARCEL 1
 A PARCEL OF LAND, BEING A PORTION OF THE SOUTHWEST 1/4 AND THE SOUTHWEST 1/4 OF THE SOUTHEAST 1/4 OF SECTION 32, TOWNSHIP 12 SOUTH, RANGE 65 WEST OF THE 6TH PRINCIPAL MERIDIAN, COUNTY OF EL PASO, STATE OF COLORADO, BEING MORE PARTICULARLY DESCRIBED AS FOLLOWS:
BASIS OF BEARINGS: THE SOUTH LINE OF THE SOUTHWEST 1/4 OF THE SOUTHWEST 1/4 OF SECTION 32, TOWNSHIP 12 SOUTH, RANGE 65 WEST OF THE 6TH P.M. BEING MONUMENTED BY A 3-1/4" ALUMINUM CAP STAMPED "LS 10376" AT THE EAST END AND A 2-1/2" ALUMINUM CAP STAMPED "LS 4842" AT THE WEST END, SAID LINE BEING ASSUMED TO BEAR S89°14'13"W. COMMENCING AT THE SOUTH 1/4 CORNER OF SAID SECTION 32.
 THENCE ON THE SOUTH LINE OF THE SOUTHWEST 1/4 OF THE SOUTHWEST 1/4 OF SAID SECTION 32, N89°14'13"E A DISTANCE OF 816.32 FEET, TO A POINT ON THE NORTHERLY RIGHT-OF-WAY LINE OF VOLLMER ROAD;
 THENCE ON SAID NORTHERLY RIGHT-OF-WAY LINE, N34°04'17"E A DISTANCE OF 259.29 FEET TO THE POINT OF BEGINNING;
 THENCE N55°55'42"W A DISTANCE OF 490.63 FEET;
 THENCE N87°41'24"W A DISTANCE OF 228.83 FEET;
 THENCE N75°30'36"W A DISTANCE OF 307.08 FEET;
 THENCE N28°05'30"E A DISTANCE OF 35.79 FEET, TO A POINT OF CURVE;
 THENCE ON THE ARC OF A CURVE TO THE LEFT, HAVING A RADIUS OF 605.00 FEET, A CENTRAL ANGLE OF 28°46'54" AND AN ARC LENGTH OF 303.91 FEET, TO A POINT OF TANGENT;
 THENCE N00°41'24"W A DISTANCE OF 198.54 FEET;
 THENCE N89°18'36"E A DISTANCE OF 333.21 FEET, TO A POINT OF CURVE;
 THENCE ON THE ARC OF A CURVE TO THE RIGHT, HAVING A RADIUS OF 1146.50 FEET, A CENTRAL ANGLE OF 41°02'55" AND AN ARC LENGTH OF 821.39 FEET, TO A POINT OF TANGENT;
 THENCE S49°38'29"E A DISTANCE OF 51.96 FEET, TO A POINT ON THE WESTERLY RIGHT-OF-WAY LINE OF TAHTI DRIVE AS PLATTED IN HOLIDAY HILLS NO. 1 RECORDED IN BOOK E-2 AT PAGE 12 IN THE RECORDS OF THE EL PASO COUNTY CLERK AND RECORDER;
 THENCE ON SAID WESTERLY RIGHT-OF-WAY LINE, S00°09'11"E A DISTANCE OF 162.66 FEET, TO A POINT ON THE NORTHERLY RIGHT-OF-WAY LINE OF SAID VOLLMER ROAD;
 THENCE ON SAID NORTHERLY RIGHT-OF-WAY LINE, S34°04'17"W A DISTANCE OF 504.76 FEET, TO THE POINT OF BEGINNING.
 CONTAINING A CALCULATED AREA OF 690.132 SQUARE FEET OR 15.8432 ACRES.

PROPERTY DESCRIPTION - PARCEL 2
 A PARCEL OF LAND, BEING A PORTION OF THE SOUTHWEST 1/4 AND THE SOUTHWEST 1/4 OF THE SOUTHEAST 1/4 OF SECTION 32, TOWNSHIP 12 SOUTH, RANGE 65 WEST OF THE 6TH PRINCIPAL MERIDIAN, COUNTY OF EL PASO, STATE OF COLORADO, BEING MORE PARTICULARLY DESCRIBED AS FOLLOWS:
BASIS OF BEARINGS: THE SOUTH LINE OF THE SOUTHWEST 1/4 OF THE SOUTHWEST 1/4 OF SECTION 32, TOWNSHIP 12 SOUTH, RANGE 65 WEST OF THE 6TH P.M. BEING MONUMENTED BY A 3-1/4" ALUMINUM CAP STAMPED "LS 10376" AT THE EAST END AND A 2-1/2" ALUMINUM CAP STAMPED "LS 4842" AT THE WEST END, SAID LINE BEING ASSUMED TO BEAR S89°14'13"W. COMMENCING AT THE SOUTH 1/4 CORNER OF SAID SECTION 32.
 THENCE ON THE SOUTH LINE OF THE SOUTHWEST 1/4 OF SAID SECTION 32, S89°14'13"W A DISTANCE OF 143.15 FEET;
 THENCE N00°45'04"W A DISTANCE OF 61.34 FEET, TO A POINT OF CURVE;
 THENCE ON THE ARC OF A CURVE TO THE RIGHT, HAVING A RADIUS OF 770.00 FEET, A CENTRAL ANGLE OF 13°07'51" AND AN ARC LENGTH OF 176.46 FEET, TO THE POINT OF BEGINNING;
 THENCE CONTINUING ON THE ARC OF SAID CURVE TO THE RIGHT, HAVING A RADIUS OF 770.00 FEET, A CENTRAL ANGLE OF 15°42'43" AND AN ARC LENGTH OF 211.15 FEET, TO A POINT OF TANGENT;
 THENCE N28°05'30"E A DISTANCE OF 175.07 FEET;
 THENCE S75°30'36"E A DISTANCE OF 307.08 FEET;
 THENCE S87°41'24"E A DISTANCE OF 228.83 FEET;
 THENCE S55°55'42"E A DISTANCE OF 490.63 FEET, TO A POINT ON THE NORTHERLY RIGHT-OF-WAY LINE OF VOLLMER ROAD;
 THENCE ON SAID NORTHERLY RIGHT-OF-WAY LINE, S34°04'17"W A DISTANCE OF 259.29 FEET, TO A POINT ON THE SOUTH LINE OF THE SOUTHWEST 1/4 OF THE SOUTHEAST 1/4 OF SAID SECTION 32;
 THENCE ON SAID SOUTH LINE, S89°14'13"W A DISTANCE OF 73.22 FEET;
 THENCE DEPARTING SAID SOUTH LINE, N88°30'10"W A DISTANCE OF 155.19 FEET;
 THENCE N77°53'11"W A DISTANCE OF 507.94 FEET;
 THENCE N81°15'09"W A DISTANCE OF 242.78 FEET, TO THE POINT OF BEGINNING.
 CONTAINING A CALCULATED AREA OF 345.082 SQUARE FEET OR 7.922 ACRES.

VICINITY MAP

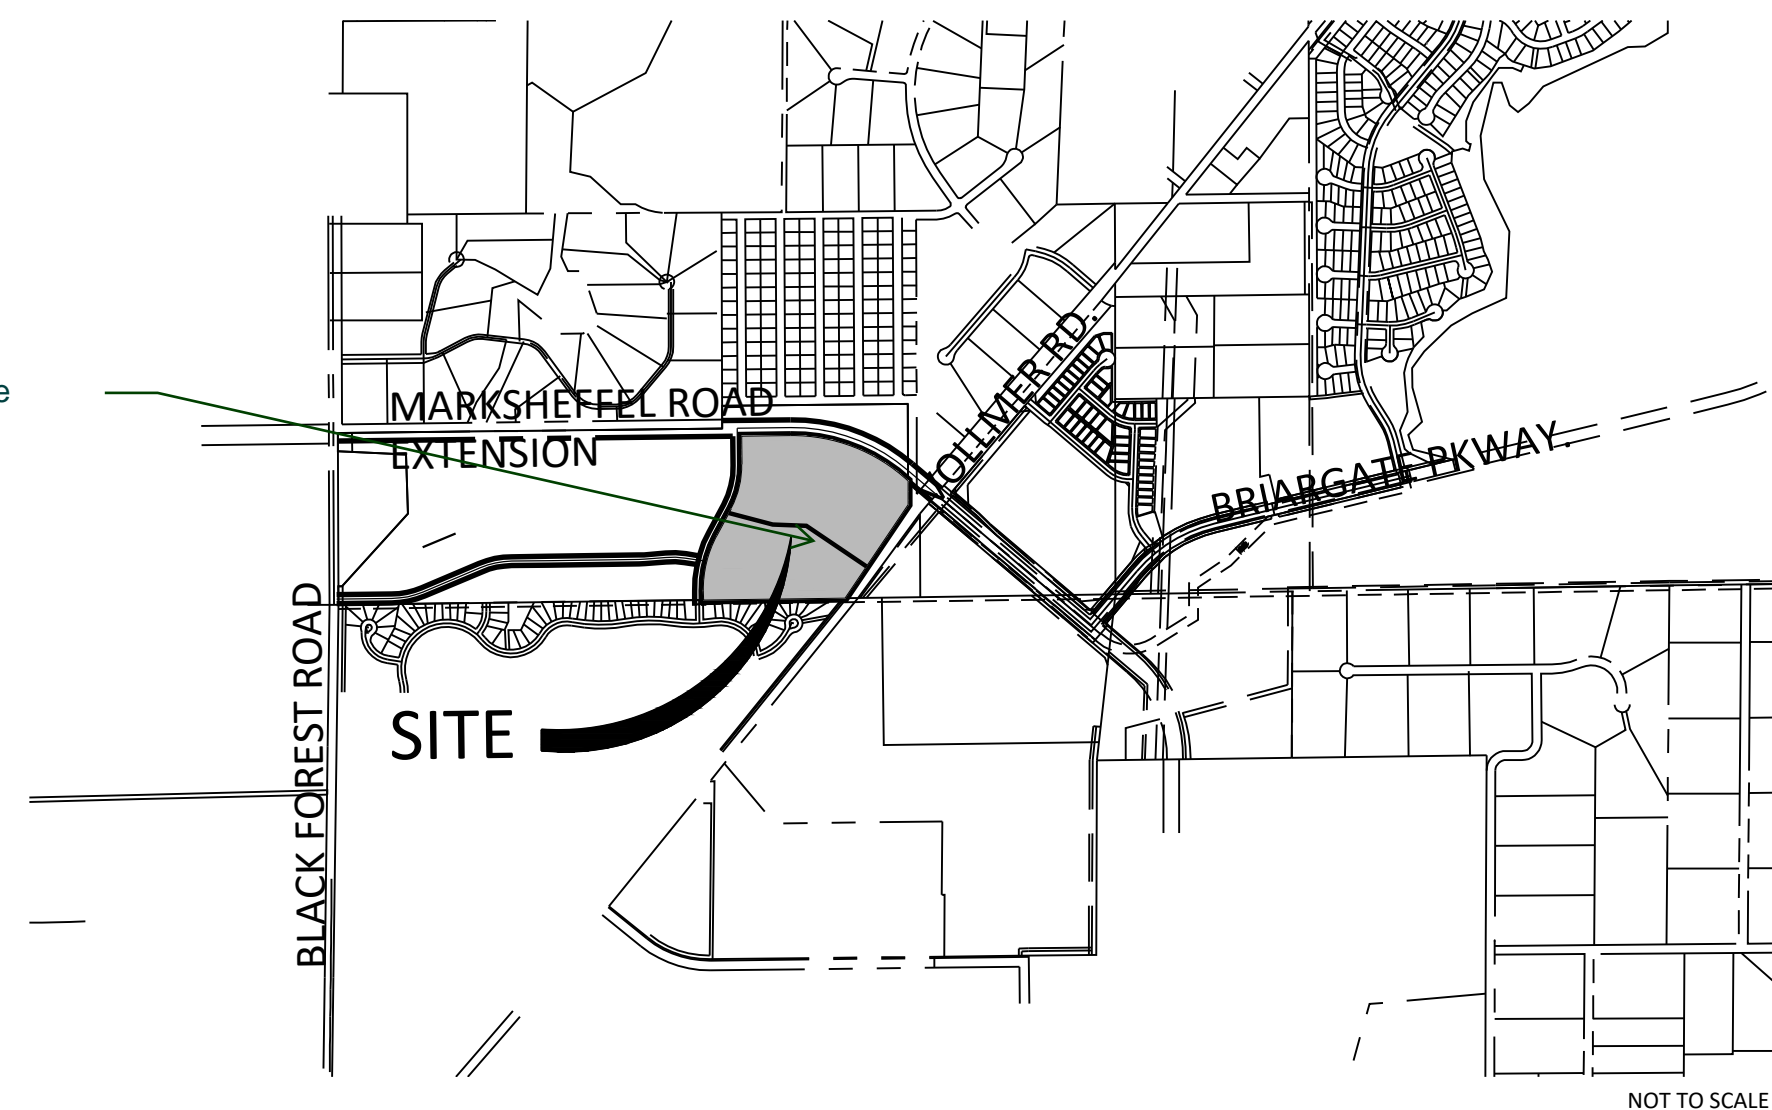


SITE DATA

Tax ID Number:	5200000264
Total Area:	28.3493
Current Zoning:	RR-5 CAD-O
Proposed Zoning:	RM-30
Current Use:	Vacant
Proposed Use:	Multifamily Residential

PROJECT TEAM

OWNER:	Turkey Canon Quarry Inc. 20 Boulder Crescent St. 2nd Floor Colorado Springs, CO 80903
APPLICANT:	N.E.S. Inc. 619 N. Cascade Avenue, Suite 200 Colorado Springs, CO 80903
Engineer:	JR Engineering 5475 Tech Center Dr. 235 Colorado Springs, CO 80919

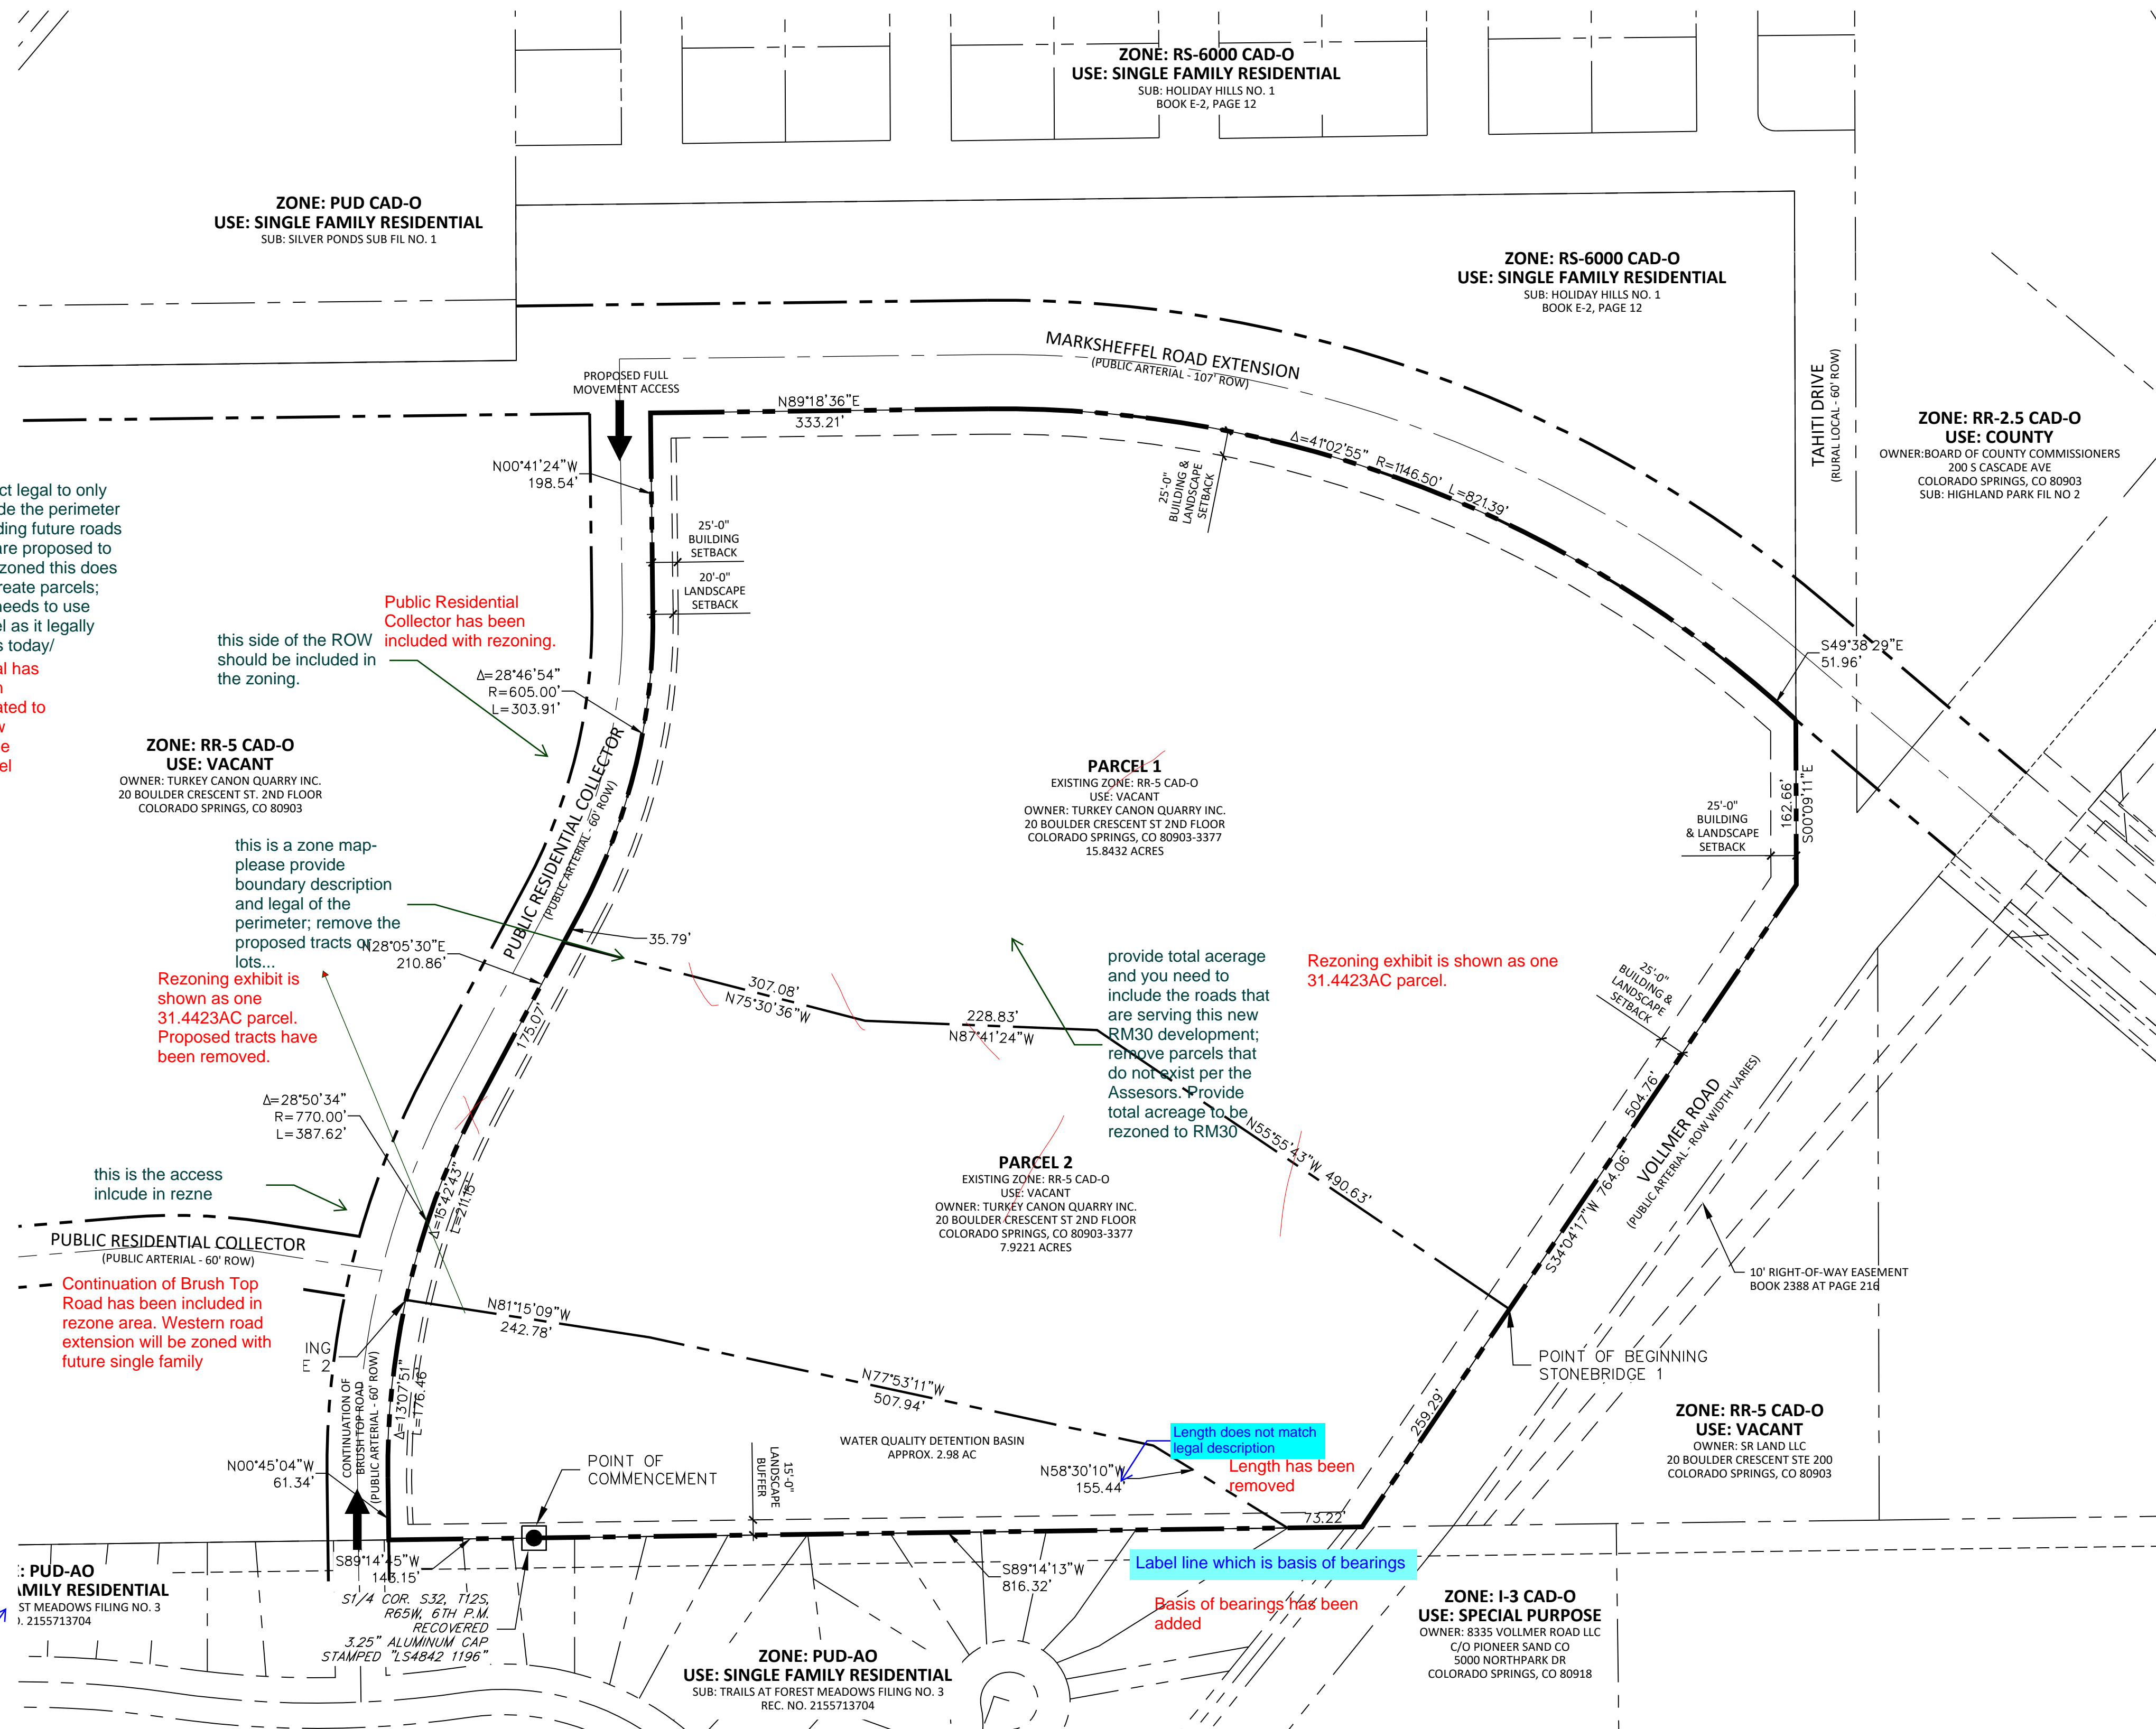

correct legal to only provide the perimeter including future roads that are proposed to be rezoned this does not create parcels; one needs to use parcel as it legally exists today/ Legal has been updated to show single parcel

this side of the ROW should be included in the zoning.

Public Residential Collector has been included with rezoning.

Re zoning exhibit is shown as one 31.4423AC parcel. Proposed tracts have been removed.

this is the access include in rezne

Continuation of Brush Top Road has been included in rezone area. Western road extension will be zoned with future single family

provide total acreage and you need to include the roads that are serving this new RM30 development; remove parcels that do not exist per the Assessor's. Provide total acreage to be rezoned to RM30

Re zoning exhibit is shown as one 31.4423AC parcel.



Length does not match legal description. Length has been removed

Label line which is basis of bearings. Basis of bearings has been added

Fix cut off text. Full text shown.

i think your proposing to rezone half of the entire single parcel; the legal and map should reflect that. Legal has been updated to reflect area of rezone

No Photo Available

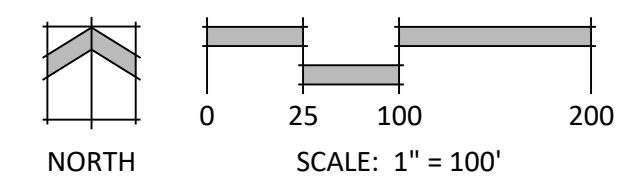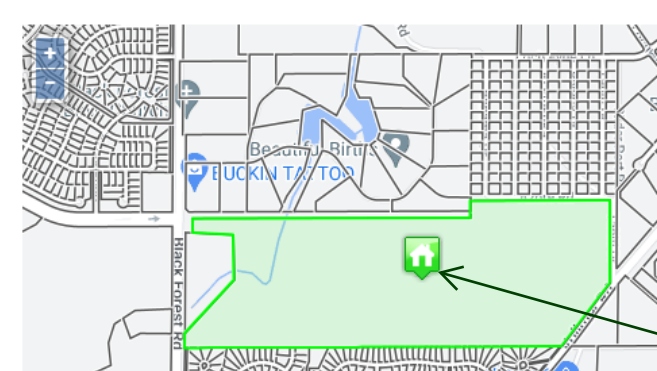

N.E.S. Inc.
 619 N. Cascade Avenue, Suite 200
 Colorado Springs, CO 80903
 Tel. 719.471.0073
 Fax 719.471.0267
 www.nescolorado.com

© 2012. All Rights Reserved.

Schmidt Parcel Rezone Multi-dwelling

DATE: 10/04/22
 PROJECT MGR: A. BARLOW
 PREPARED BY: J. SHAGIN

ENTITLEMENT

DATE: BY: DESCRIPTION:


REZONE EXHIBIT

1 OF 1

P:\Marketing\Schmidt_Property Drawings\Planning\Concept\Schmidt_04132_Rezone.dwg [REZONING EXHIBIT] 10/2/2022 11:55:31 PM Jennifer Shagin


Zoning Map_v1.pdf Markup Summary 11-15-2022

CDurham (3)

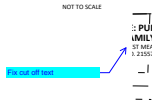


Subject: Callout
Page Label: [1] REZONING EXHIBIT
Author: CDurham
Date: 11/14/2022 2:01:27 PM
Status:
Color: ■
Layer:
Space:

Fix cut off text

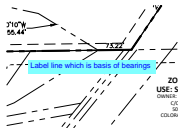

Subject: Text Box
Page Label: [1] REZONING EXHIBIT
Author: CDurham
Date: 11/14/2022 2:02:27 PM
Status:
Color: ■
Layer:
Space:

Label line which is basis of bearings

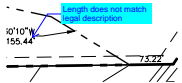

Subject: Callout
Page Label: [1] REZONING EXHIBIT
Author: CDurham
Date: 11/14/2022 2:06:27 PM
Status:
Color: ■
Layer:
Space:

Length does not match legal description

dspdparsons (14)




Subject: Callout
Page Label: [1] REZONING EXHIBIT
Author: dspdparsons
Date: 11/15/2022 8:52:47 AM
Status:
Color: ■
Layer:
Space:

this is a zone map- please provide boundary description and legal of the perimeter; remove the proposed tracts or lots...



Subject: Arrow
Page Label: [1] REZONING EXHIBIT
Author: dspdparsons
Date: 11/15/2022 8:52:54 AM
Status:
Color: ■
Layer:
Space:


this side of the ROW should be included in the zoning.

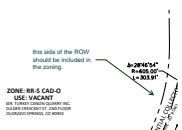

Subject: Callout
Page Label: [1] REZONING EXHIBIT
Author: dspdparsons
Date: 11/15/2022 8:53:16 AM
Status:
Color: ■
Layer:
Space:



Subject: Image
Page Label: [1] REZONING EXHIBIT
Author: dsdparsons
Date: 11/15/2022 8:53:38 AM
Status:
Color: ■
Layer:
Space:

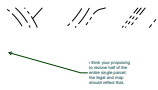


Subject: Callout
Page Label: [1] REZONING EXHIBIT
Author: dsdparsons
Date: 11/15/2022 8:54:02 AM
Status:
Color: ■
Layer:
Space:

i think your proposing to rezone half of the entire single parcel; the legal and map should reflect that.




Subject: Callout
Page Label: [1] REZONING EXHIBIT
Author: dsdparsons
Date: 11/15/2022 8:55:50 AM
Status:
Color: ■
Layer:
Space:

correct legal to only provide the perimeter including future roads that are proposed to be rezoned this does not create parcels; one needs to use parcel as it legally exists today/

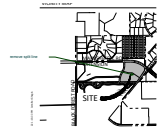


Subject: Callout
Page Label: [1] REZONING EXHIBIT
Author: dsdparsons
Date: 11/15/2022 8:56:03 AM
Status:
Color: ■
Layer:
Space:

remove split line

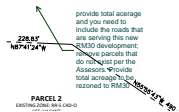

Subject: Callout
Page Label: [1] REZONING EXHIBIT
Author: dsdparsons
Date: 11/15/2022 8:57:36 AM
Status:
Color: ■
Layer:
Space:

provide total acreage and you need to include the roads that are serving this new RM30 development; remove parcels that do not exist per the Assesors. Provide total acreage to be rezoned to RM30

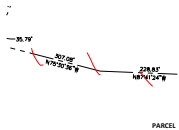

Subject: Owner Certification
Page Label: [1] REZONING EXHIBIT
Author: dsdparsons
Date: 11/15/2022 8:57:42 AM
Status:
Color: ■
Layer:
Space:


"

PARCEL 1
EXISTING ZONE: RR-5 CAD-1
USE: VACANT
TURKEY CANYON QUARRY


Subject: Owner Certification
Page Label: [1] REZONING EXHIBIT
Author: dsdparsons
Date: 11/15/2022 8:57:44 AM
Status:
Color: ■
Layer:
Space:

PARCEL 2
EXISTING ZONE: RR-5 CAD-0
USE: VACANT
OWNER: TURKEY CANYON QUARRY INC
70 BOULDER CRESCENT ST. 2ND FLOOR
COLORADO SPRINGS, CO 80903-3377
7.9223 ACRES


Subject: Owner Certification
Page Label: [1] REZONING EXHIBIT
Author: dsdparsons
Date: 11/15/2022 8:57:45 AM
Status:
Color: ■
Layer:
Space:

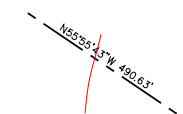

Subject: Owner Certification
Page Label: [1] REZONING EXHIBIT
Author: dsdparsons
Date: 11/15/2022 8:57:46 AM
Status:
Color: ■
Layer:
Space:

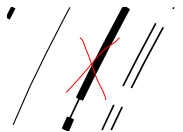

Subject: Owner Certification
Page Label: [1] REZONING EXHIBIT
Author: dsdparsons
Date: 11/15/2022 8:57:52 AM
Status:
Color: ■
Layer:
Space:

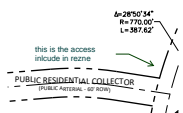

Subject: Callout
Page Label: [1] REZONING EXHIBIT
Author: dsdparsons
Date: 11/15/2022 8:58:21 AM
Status:
Color: ■
Layer:
Space:

this is the access include in rezne