
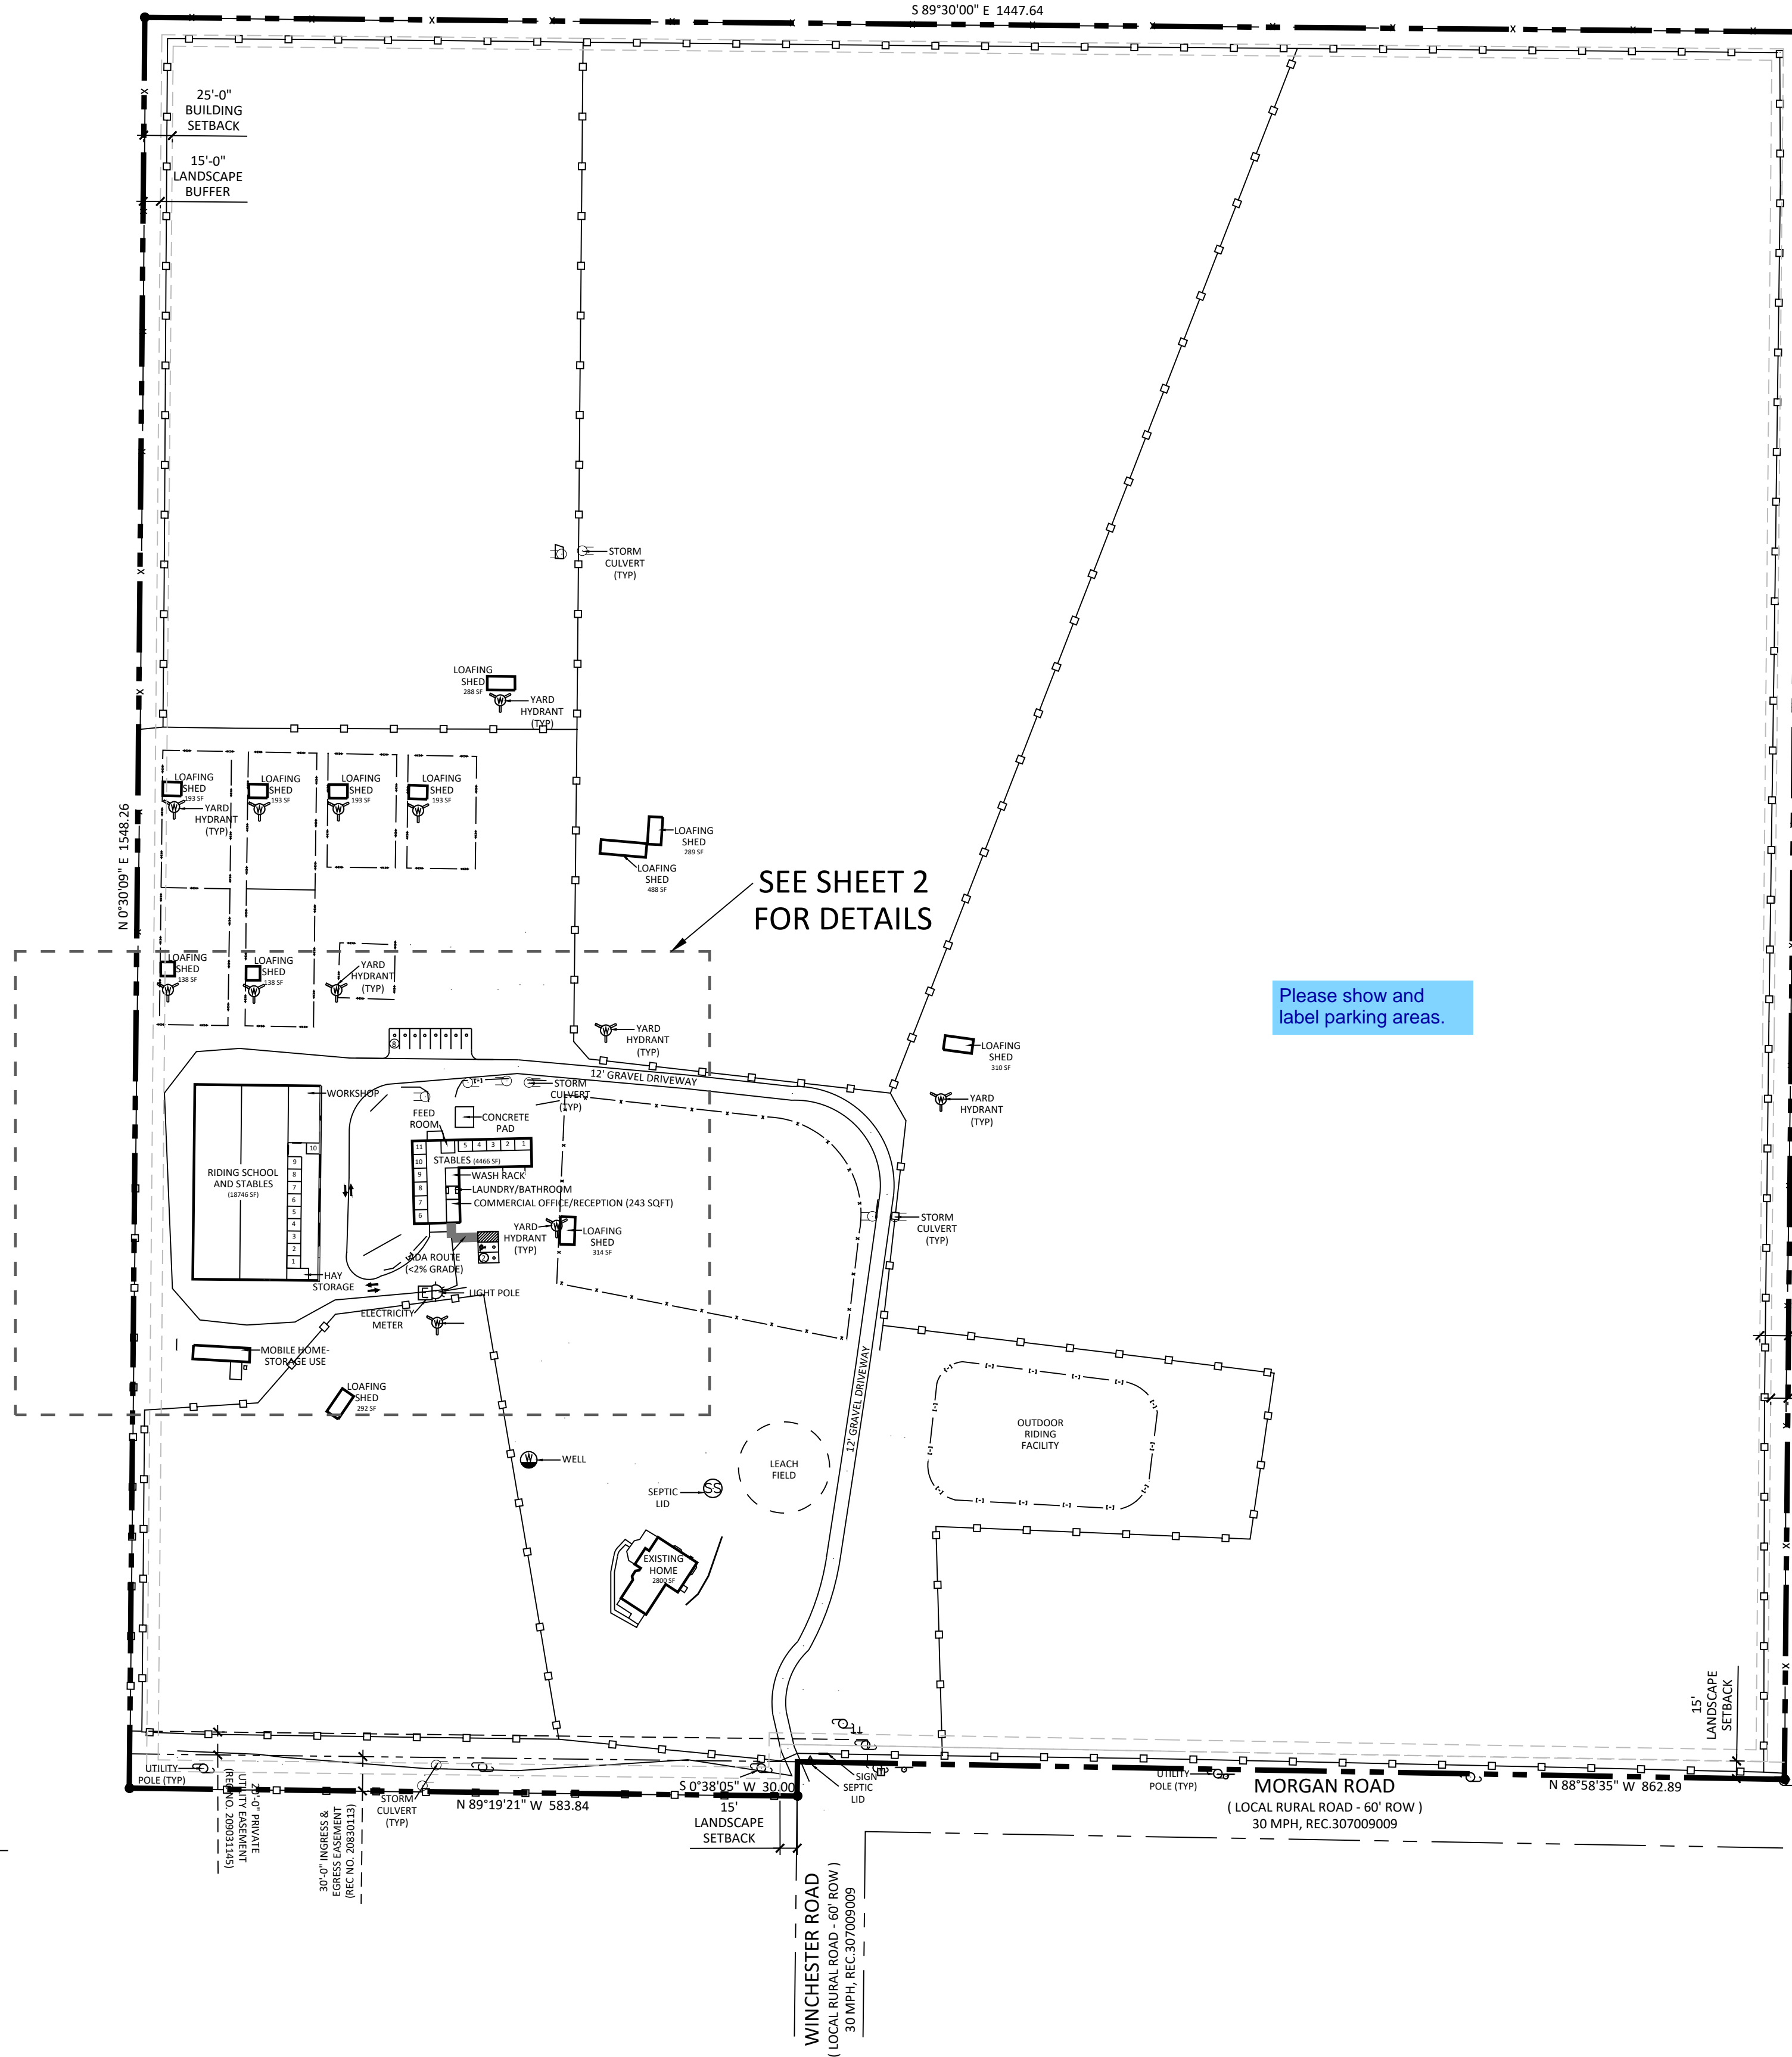


LILLYWOOD SHOW STABLES RIDING ACADEMY

A PORTION OF THE SOUTHWEST QUARTER OF SECTION 15, TOWNSHIP 11 SOUTH,
RANGE 65 WEST OF THE 6TH P.M., EL PASO COUNTY, COLORADO
EL PASO COUNTY, COLORADO

SITE DEVELOPMENT PLAN

OVERALL SITE PLAN

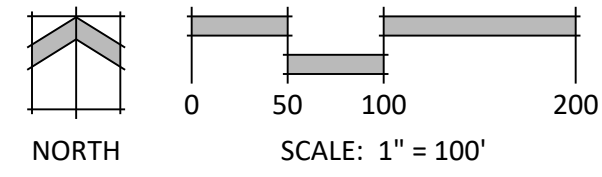


- LEGEND**
- FOUND MONUMENT
 - ⊠ ELECTRIC PEDESTAL
 - ⊙ LIGHT POLE
 - ⊕ UTILITY POLE
 - ⊞ TELEPHONE PEDESTAL
 - ⊚ GAS METER
 - ⊗ LEACH FIELD LID
 - ⊘ STORM CULVERT
 - ⊙ STREET SIGN
 - ⊕ WATER WELL HEAD
 - ⊞ HORSE SHELTER
 - ⊚ YARD HYDRANT
 - ⊗ GUY WIRE
 - IRON FENCE, 53'
 - x— BARBED WIRE FENCE, 53'
 - o— WIRE FENCE, 53'
 - h— SPLIT RAIL FENCE, 53'

SEE SHEET 2 FOR DETAILS

Please show and label parking areas.

VICINITY MAP

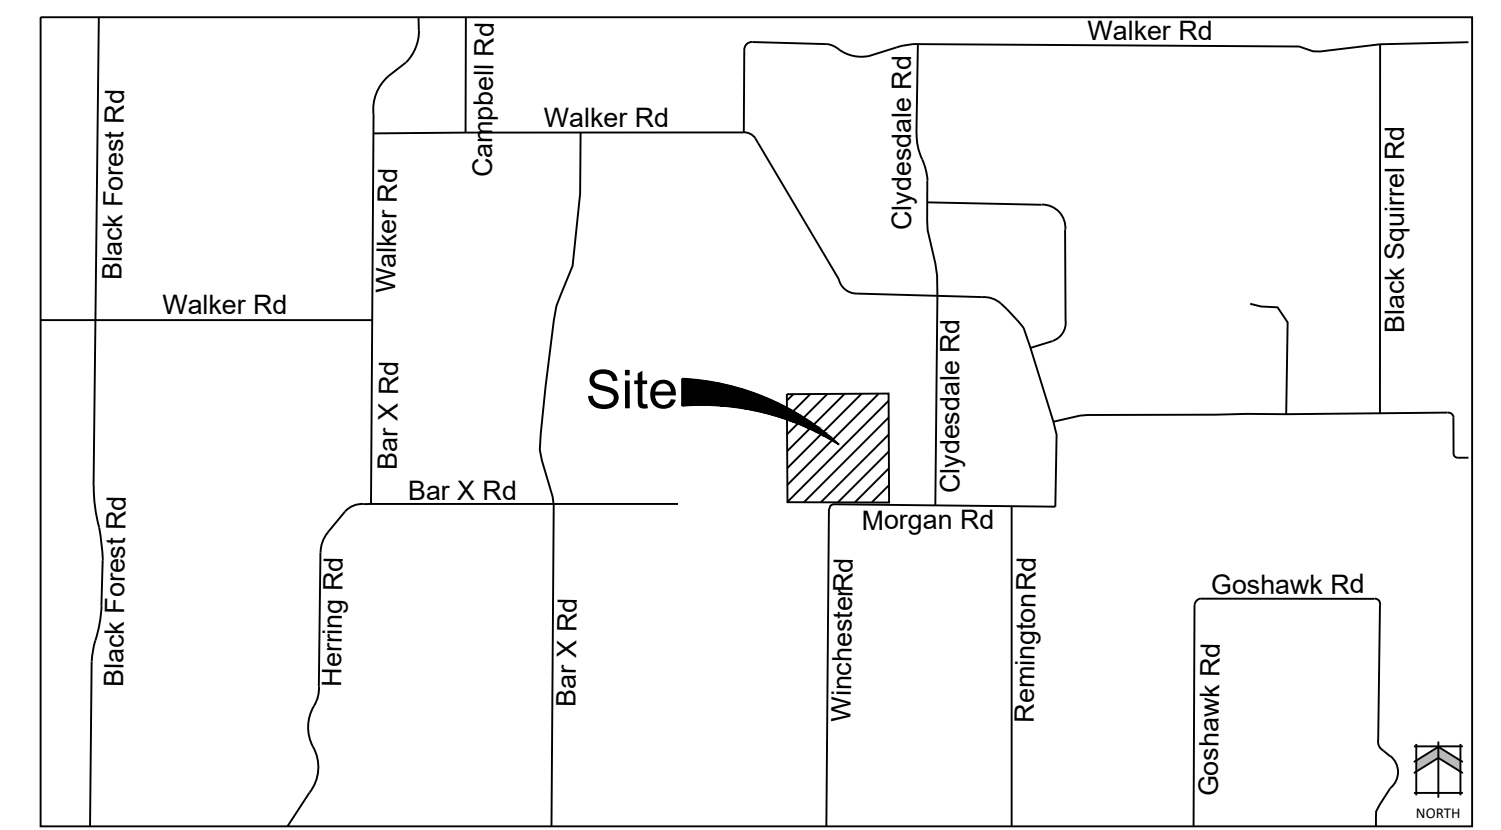

LEGAL DESCRIPTION

A portion of the Southwest one-quarter of Section 15, Township 11 South, Range 65 West of the 6th P.M., El Paso County, Colorado, more particularly described as follows:

Beginning at the Southwest corner of Lot 13, Block 2, Willow Springs Estates (Plat Book H-2 Page 54) said point also being on the Northerly right of way line of Morgan Road (60 feet right of way) (all bearings in this description are relative to those plotted in said estates); thence North 88 degrees 58 minutes 35 seconds West along the Southerly line of said Lot 13, as extended, and coincident with the Northerly right of way line, 862.89 feet to a point on the Westerly right of way line Winchester Road (60 feet right of way), as extended; thence South 00 degrees 38 minutes 05 seconds West along said Westerly right of way line extension, 30.00 feet to the Northeast corner of Lot 15, Rampart View (plat Book P-3, thence North 89 degrees 19 minutes 21 seconds West along the North boundary line of said Rampart View, 583.84 feet to the Southeast corner of a tract of land recorded in Book 2634 at Page 42 thence North 00 degrees 30 minutes 09 seconds East (North 00 degrees 30 minutes 00 seconds East of record) along the Easterly lines of the tracts of land recorded in said Book 2634 at Page 42 and Book 2487 at Page 768, 1548.26 feet; thence South 89 degrees 30 minutes 00 seconds East, 1447.64 feet to a point on a boundary line of said Willow Springs Estates; thence South 00 degrees 32 minutes 08 seconds West (South 00 degrees 30 minutes 00 seconds West of record) along said boundary line, 1527.96 feet to the Point of Beginning.

GENERAL NOTES

- ALL LIGHTING FIXTURES SHALL HAVE FULL CUT-OFF SHIELDING OR FIXTURES TO REDUCE OFF-SITE LIGHTING IMPACTS.
- ACCORDING TO THE CURRENT EFFECTIVE FEDERAL EMERGENCY MANAGEMENT AGENCY FLOOD INSURANCE RATE MAP (FIRM NO. 0804103106 DATED 12/7/2018), THE SUBJECT PROPERTY IS LOCATED OUTSIDE THE BOUNDARY OF THE 100 YEAR FLOODPLAIN.
- THE PARTIES RESPONSIBLE FOR THIS PLAN HAVE FAMILIARIZED THEMSELVES WITH ALL CURRENT ACCESSIBILITY CRITERIA AND SPECIFICATIONS AND THE PROPOSED PLAN REFLECTS ALL SITE ELEMENTS REQUIRED BY THE APPLICABLE ADA DESIGN STANDARDS AND GUIDELINES AS PUBLISHED BY THE UNITED STATES DEPARTMENT OF JUSTICE. APPROVAL OF THIS PLAN BY EL PASO COUNTY DOES NOT ASSURE COMPLIANCE WITH THE ADA OR ANY REGULATIONS OR GUIDELINES ENACTED OR PROMULGATED UNDER OR WITH RESPECT TO SUCH LAWS.

SITE SUMMARY

| | |
|--------------------------------------|--|
| Property address: | 9210 Morgan Road Colorado Springs CO, 80908 |
| Property tax schedule number: | 5115000007 |
| Total Area: | 51.62 Acres |
| Existing Land use: | Single Family Residential/Riding Academy and Stables |
| Proposed land use: | Riding Academy |
| Current Zoning: | RR-5 |
| Total gross building square footage: | 25381 sqft |
| Landscaping %: | 11.7% |
| Impermeable surface %: | 1.1% |
| Maximum Allowed Building Height: | 30 ft |
| Proposed Building Height: | 19 ft |
| Lot area coverage calculation: | 26429 sqft/51.62 Acres = 1.2% |
| Building Setbacks: | |
| Front: | 25 ft |
| Rear: | 25 ft |
| Sides: | 25 ft |
| Landscape Setback: | |
| Morgan Road: | 10 ft |
| Parking: | |
| Formula: | 1 parking space/5 horse stalls |
| Required: | 4 spaces |
| ADA Required: | 1 space |
| Provided: | 10 spaces, 1 ADA Accessible |

PROJECT TEAM

OWNER/APPLICANT: Lucky Lilly Land Company LLC
Matt Barnet
9210 Morgan Rd
Colorado Springs, CO 80908
Matt.Barnett@LuckyLilly.com
(719) 330-0862

CONSULTANT: N.E.S. Inc.
Andres Barlow
619 N. Cascade Ave., Suite 200
Colorado Springs, CO 80903
A.Barlow@NESColorado.com
(719) 471-0073

SHEET INDEX

| | |
|---------------|-----------------------------|
| Sheet 1 of 2: | Site Development Plan Cover |
| Sheet 2 of 2: | Site Development Plan |



N.E.S. Inc.
619 N. Cascade Avenue, Suite 200
Colorado Springs, CO 80903
Tel. 719.471.0073
Fax 719.471.0267
www.nescolorado.com
© 2012. All Rights Reserved.

LILLYWOOD SHOW STABLES RIDING ACADEMY SITE DEVELOPMENT PLAN

9210 MORGAN RD
COLORADO SPRINGS
CO, 80908

DATE: 3/14/24
PROJECT MGR: E. TROLLER
PREPARED BY: A. ROMAN

| DATE: | BY: | DESCRIPTION: |
|-------|-----|--------------|
| | | |
| | | |
| | | |
| | | |

SITE DEVELOPMENT PLAN COVER


1
1 of 2

P:\Matt Barnett\Lillywood Riding Academy\Drawings\Planning\Overall Site Development Plan.dwg (CTTY_COVER) 3/13/2024 4:29:17 PM ARBORIAN

LILLYWOOD SHOW STABLES RIDING ACADEMY

A PORTION OF THE SOUTHWEST QUARTER OF SECTION 15, TOWNSHIP 11 SOUTH,
RANGE 65 WEST OF THE 6TH P.M., EL PASO COUNTY, COLORADO
EL PASO COUNTY, COLORADO

FLOOR PLAN

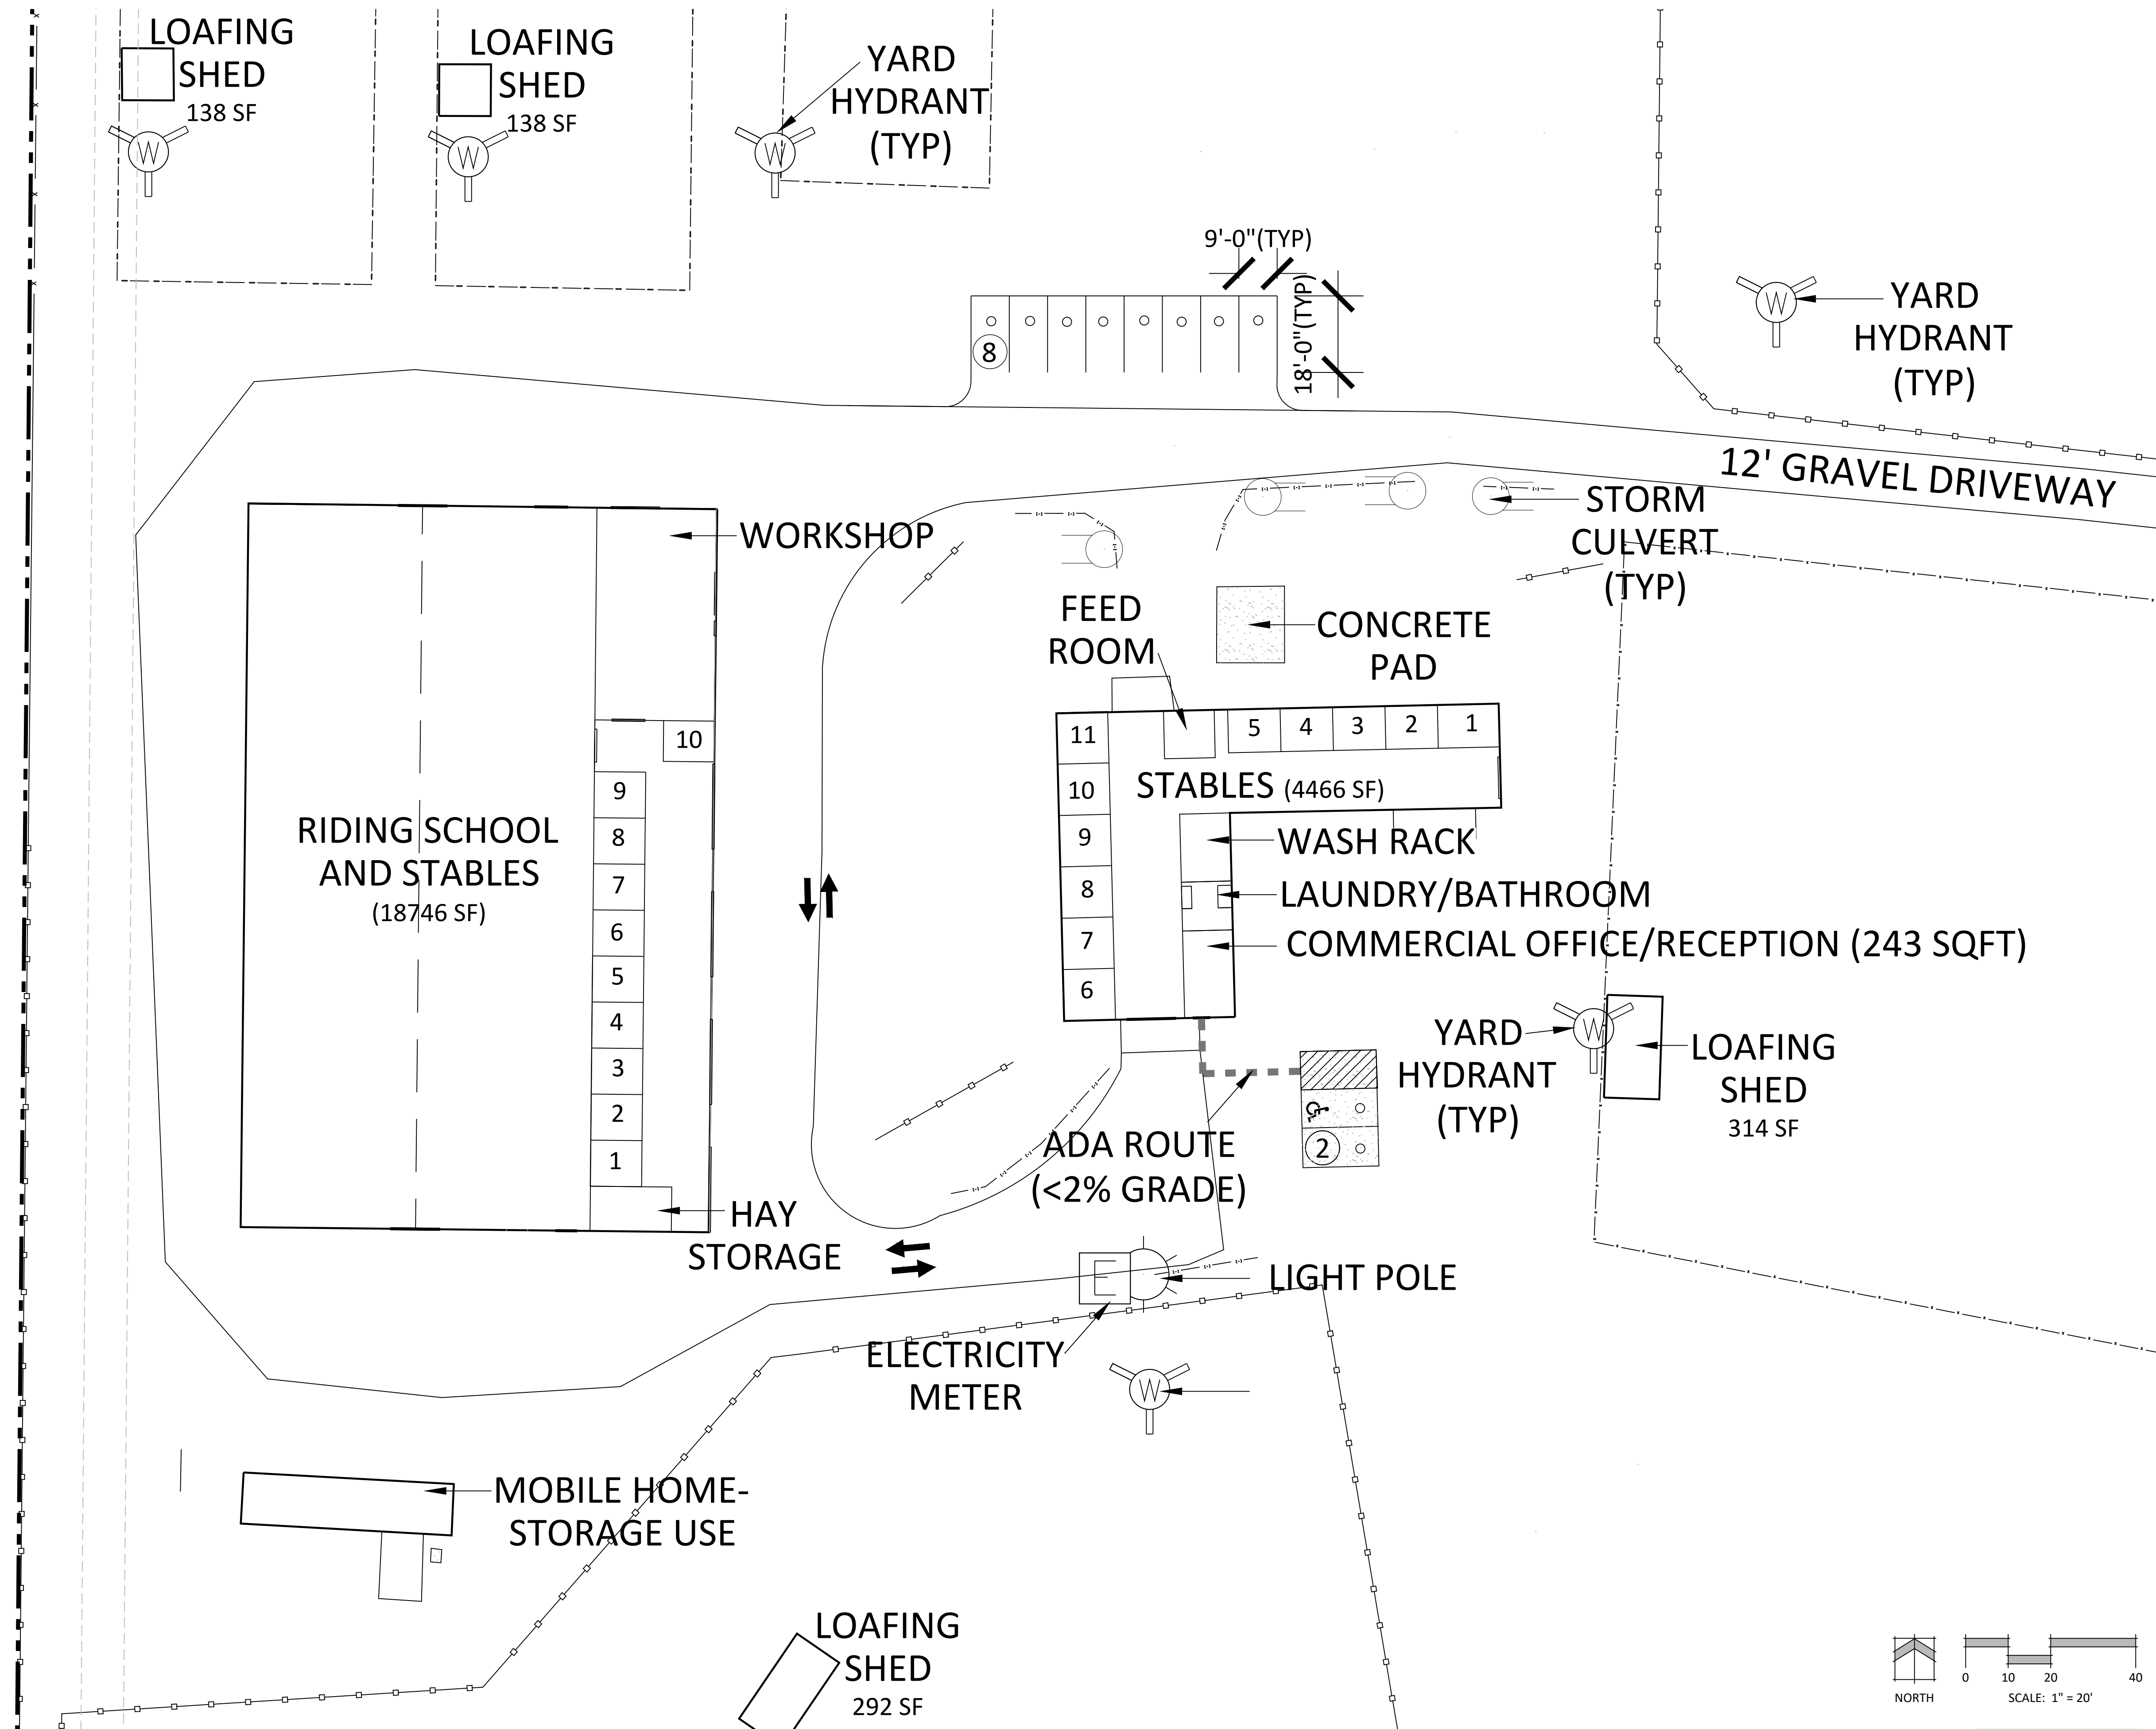

N.E.S. Inc.
619 N. Cascade Avenue, Suite 200
Colorado Springs, CO 80903
Tel. 719.471.0073
Fax 719.471.0267
www.nescolorado.com
© 2012. All Rights Reserved.

PLANNER / LANDSCAPE ARCHITECT

BY ASSOCIATION WITH

**LILLYWOOD
SHOW STABLES
RIDING
ACADEMY**
SITE DEVELOPMENT PLAN
9210 MORGAN RD
COLORADO SPRINGS
CO, 80908

PROJECT INFO
DATE: 3/14/24
PROJECT MGR: E. TROLLER
PREPARED BY: A. ROMAN

STAMP

ISSUE INFO

| DATE: | BY: | DESCRIPTION: |
|-------|-----|--------------|
| | | |
| | | |
| | | |


SITE DEVELOPMENT PLAN

SHEET TITLE

2

2 of 2

SHEET NUMBER

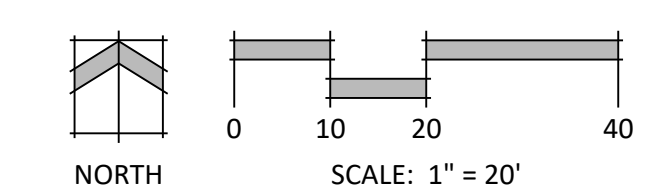

File Number:
PPR248

P:\Matt Barnett\Lillywood Riding Academy\Drawings\Planning\PPR\Lillywood Riding Academy_SDP.dwg [SITE PLAN (LOOK PLANS)] 3/13/2024 4:41:37 PM AROMAN