


How are these northern fields accessed?
provide inventory of existing roads to be used as haul routes.
is there time limitations proposed to not disturb residents during construction?

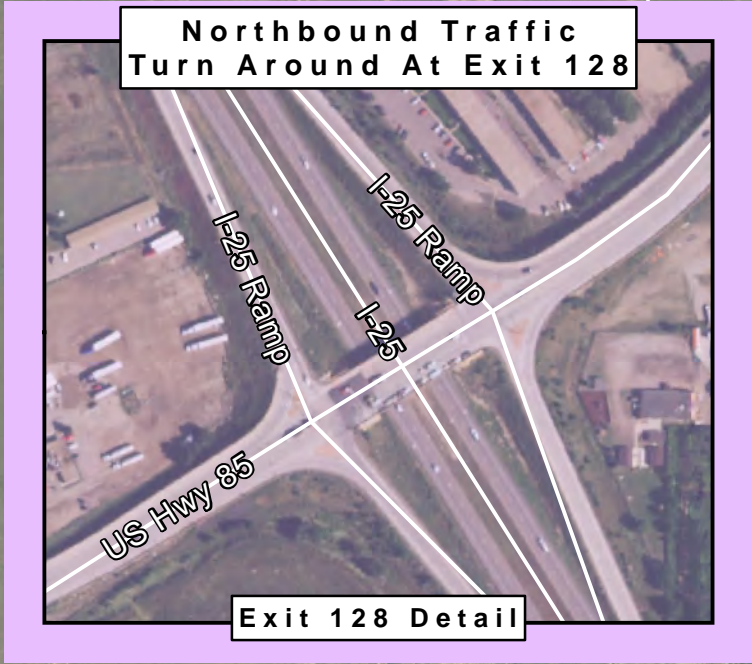

Exit 128
±9 Miles North
See Detail

- Proposed Project Boundary
- Proposed Road
- Preliminary Array
- Parcel Boundary
- South Bound Haul Route (Exit 119)
- Restricted Tunnel (Light Traffic Only)
- Wigwam Mutual Water Company

Front Range Midway Solar Project

Haul Route Map

El Paso County, Colorado




CORE
CONSULTANTS

CIVIL ENGINEERING
DEVELOPMENT CONSULTING
NATURAL RESOURCES CONSULTING
LAND SURVEYING
303.703.4444
1950 W. Littleton Blvd., Ste. 109
Littleton, CO 80120

CORE Project #: 17-012 Date: 8/21/2017

Markup Summary

dsdparsons (4)

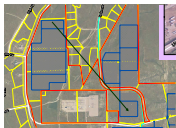


Subject: Arrow
Page Label: 1
Lock: Unlocked
Status:
Checkmark: Unchecked
Author: dsdparsons
Date: 11/22/2017 9:34:45 AM
Color: ■



Subject: Arrow
Page Label: 1
Lock: Unlocked
Status:
Checkmark: Unchecked
Author: dsdparsons
Date: 11/22/2017 9:34:24 AM
Color: ■



Subject: Arrow
Page Label: 1
Lock: Unlocked
Status:
Checkmark: Unchecked
Author: dsdparsons
Date: 11/22/2017 9:34:29 AM
Color: ■

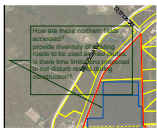

Subject: Callout
Page Label: 1
Lock: Unlocked
Status:
Checkmark: Unchecked
Author: dsdparsons
Date: 11/22/2017 9:33:58 AM
Color: ■

How are these northern fields accessed?
provide inventory of existing roads to be used as
haul routes. is there time limitations proposed to
not disturb resints during construction?