

©2017 Westwood Professional Services, Inc.

Westwood

Phone (214) 473-4640 2740 Dallas Parkway N, #280
Toll Free (888) 937-5150 Plano, TX 75093
westwoodps.com

Westwood Professional Services, Inc.

Designed: DCB

Checked: JNH

Drawn: DCB


Record Drawing by/date:

Revisions: DATE DESCRIPTION

Prepared for:



16105 West 113th Street, Suite 105
Lenexa, KS 66219

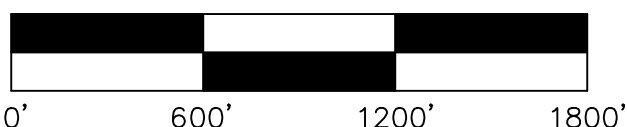

Front Range-Midway
Solar Project

Frontier, CO

Site Layout

Preliminary
Not For Construction

Date: 10/6/17


Drawing No: 7 of 12

Markup Summary

dsdparsons (2)



Subject: Callout
Page Label: 1
Lock: Unlocked
Status:
Checkmark: Unchecked
Author: dsdparsons
Date: 11/22/2017 8:00:45 AM
Color: label two cultural sites to be avoided

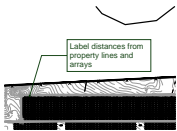

Subject: Callout
Page Label: 1
Lock: Unlocked
Status:
Checkmark: Unchecked
Author: dsdparsons
Date: 11/22/2017 7:58:07 AM
Color: Label distances from property lines and arrays