

Reviewed by
dsdgrimm
04/30/2019 2:15:54 PM

Identify this line as the
property boundary

please show as
residence

only 1 guest house is
allowed. Please
relabel if this is being
removed/converted


Identify structures
as existing or
proposed.

SCALE: 1" = 50'

Adjoining Property Owners

1	Castro	RR-5
2	Meadows	RR-5
3	Sommers	RR-5
4	Villalobos	RR-5
5	Dalley (Moyers)	RR-5
6	Moyers	RR-5
7	Straziscar (Meadows)	RR-5
8	Stapel	RR-5

7750 MOHAWK ROAD
LOT 2, BL 2 PAWNEE
RANCHEROS FILING 1

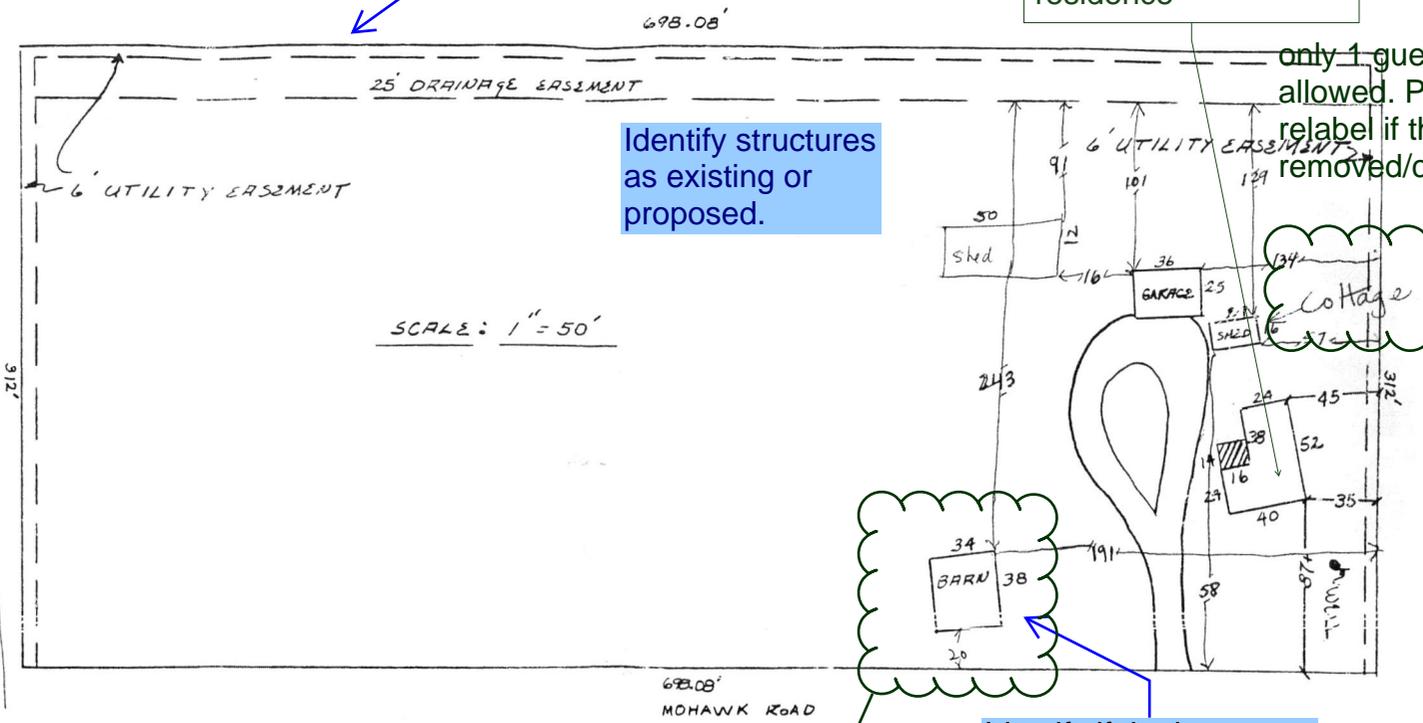

Identify if the barn
uses the existing
access location or if a
secondary access
location is proposed.

please identify this as
the
structure/dimension
being legalized