

**CONTOURED LOGO CABINET**

**SPECIFICATIONS:**

Front lit, LED illuminated, contoured logo cabinet, having 3/16" high impact white acrylic face with laminated digital print artwork, 5" black returns and 1" black trim cap.

**Illumination Specifications:**

White LED modules, low voltage power supply, low voltage insulated wiring, UL listed and approved, service/disconnect switch on raceway.

**Electrical Specifications:**


Property owner and/or client is responsible at their own expense to provide a dedicated 20A circuit for the sign, and is responsible at their own expense to have a qualified licensed electrician make the final connection of the sign to the provided circuit.

Show entire parcel, entire building, entire frontage of tenant, and where the signs are proposed on the structure.

Include a note stating that the illumination meets criteria in El Paso County Land Development Code.

**Electrical and Attachment Detail:**

THIS SIGN IS INTENDED TO BE INSTALLED IN ACCORDANCE WITH THE REQUIREMENTS OF ARTICLE 600 OF THE NATIONAL ELECTRICAL CODE AND/OR OTHER APPLICABLE LOCAL CODES. THIS INCLUDES PROPER GROUNDING AND BONDINGS OF THE SIGN.

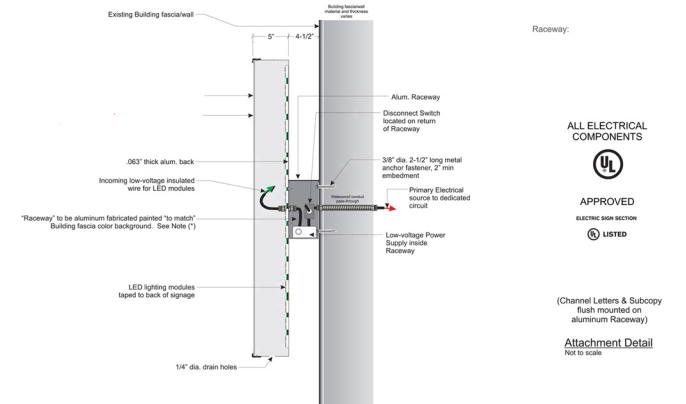

El Nissi Corporation  
P.O. Box 63795  
Colorado Springs, CO 80962  
(719)492-5807

Customer: **NEXT GEAR**  
Address: **11852 STAPLETON DRIVE  
PEYTON, CO 80831**  
Contact: **BRAD EDWARDS  
(719)660-5855**

Sign Consultant: **Emil Rock**  
Approved by:

Designed by:  
**KR**

**Article 600 of the National Electric Code (NEC)**  
This statement "MUST" go on every technical drawing that has a sign installed in any jurisdiction in the United States  
(Note: the "UL" label or logo, is the Underwriters Laboratory icon and must be placed on every electrical sign attachment or installation detail drawing. UL is only one of several certifying agencies in the U.S.)



# Markup Summary

dsdkendall (1)

Property owner and/or client is responsible at their own expense to provide a dedicated 20A circuit for the sign, and is responsible at their own expense to have a qualified licensed electrician make the final connection of the sign to the provided circuit.

Show entire parcel, entire building, entire frontage of tenant, and where the signs are proposed on the structure.

Include a note stating that the illumination meets criteria in El Paso County Land Development Code.

Electrical and Attachment Detail:

THIS DRAWING IS THE PROPERTY OF THE ARCHITECT AND IS NOT TO BE REPRODUCED OR TRANSMITTED IN ANY FORM OR BY ANY MEANS, ELECTRONIC OR MECHANICAL, WITHOUT THE WRITTEN PERMISSION OF THE ARCHITECT.

**Subject:** Text Box  
**Page Label:** 1  
**Author:** dsdkendall  
**Date:** 7/27/2018 10:37:12 AM  
**Color:** ■

Show entire parcel, entire building, entire frontage of tenant, and where the signs are proposed on the structure.

Include a note stating that the illumination meets criteria in El Paso County Land Development Code.