

Released for Permit
07/02/2025 8:02:00 PM
REGIONAL
 Building Department
Becky A
ENUMERATION

APPROVED
 Plan Review
 07/03/2025 8:00:51 AM
(Signature)
 EPC Planning & Community
 Development Department

ANY APPROVAL GIVEN BY
 EL PASO COUNTY
 DOES NOT WAIVE THE NEED
 TO COMPLY WITH APPLICABLE
 FEDERAL, STATE OR LOCAL
 LAWS AND/OR REGULATION.
 Planning & Community Development Department
 approval is contingent upon compliance with all
 applicable codes on the jurisdiction part.
 An access permit must be granted by the
 Planning & Community Development Department
 prior to the establishment of any driveway onto a
 County road.
 Placement of drainage of any drainage way
 is not permitted without approval of the
 Planning & Community Development Department.

APPROVED
 BESQCP
 07/03/2025 8:14:07 AM
(Signature)
 EPC Planning & Community
 Development Department

It is the owner's responsibility to
 coordinate with easement holders
 to avoid impact to utilities that
 may be located in the easements.


SFD25658
 PLAT 15427
 PUD

SUPERINTENDENT NOTES


1. OWNER SIGNATURE
2. COVER SHEET
3. DEED RECORD DATE
4. DEED RECORD DATE
5. SUPERVISOR'S VISITING DATE
6. OPEN HOUSE CALL DATE
7. FOUNDATION BRACKET & WINDOW WELL INSTALLATION DATE
8. SUPER INSPECTION OF BACKFILL DATE
9. GARAGE OF BACKFILL

NOTE: INDEX HAS MORE THAN 6'-0" OF CLEARANCE UNDERNEATH, IS PARTIALLY COVERED AND THE ENTIRE DECK IS INCLUDED IN BUILDING SIZE.

HOUSE	HOUSE GARAGE
LOT SIZE: 109137 SF	LOT SIZE: 109137 SF
BLDG. SIZE: 4290 SF	BLDG. SIZE: 600 SF
BLDG. HEIGHT: 22'-10 1/2"	BLDG. HT: 10'-3"
LOT COVER: 4.4%	LOT COVER: 4.4%

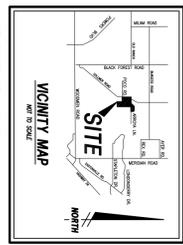

LOT COVERAGE MAXIMUM ON THIS LOT IS 45%.

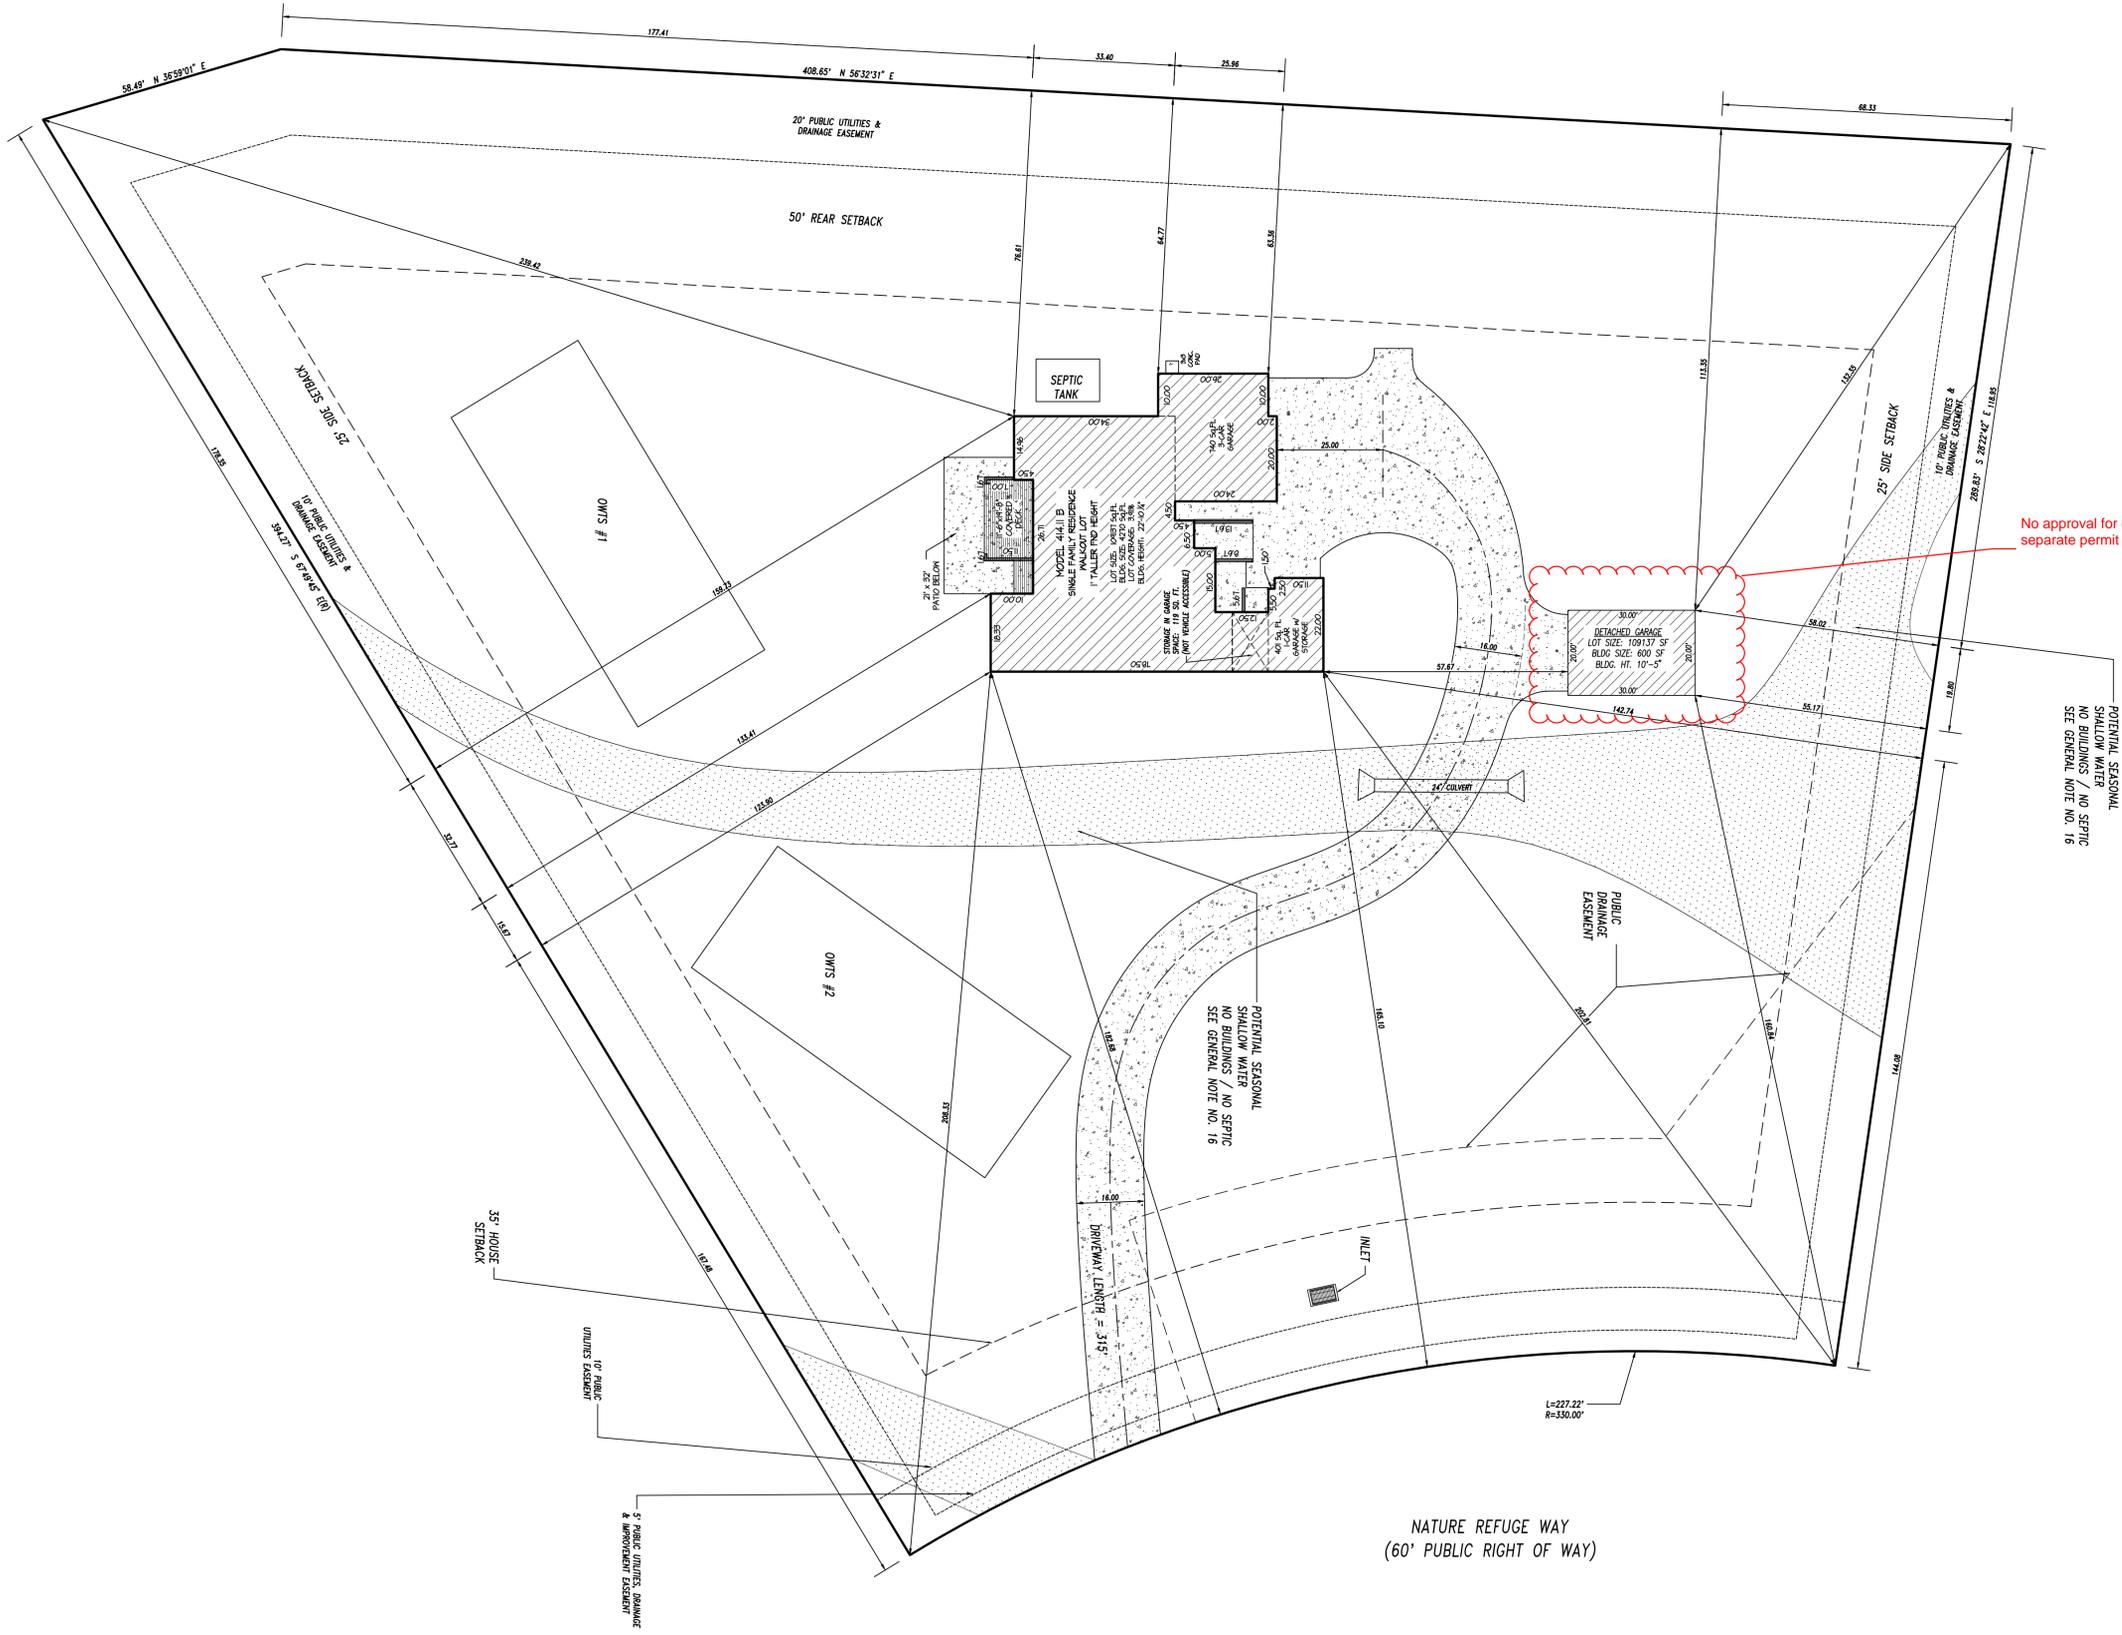

No approval for detached garage - separate permit will be required

POTENTIAL SEASONAL SHALLOW WATER / NO SEPTIC SEE GENERAL NOTE NO. 16




LEGAL DESCRIPTION
 ACRES: 3.04 NABER TRACT HWY DESCRIPTION: LOT 7, 2, 1, 4, 5, 6, 999, 1000.

CLASSIC HOMES
 779.922.8888
 2281 Hwy 90 West, Suite 100, Colorado Springs, Colorado 80901

PLOT PLAN
 Drawn by: NAHEB
 1-1-2025

TAX ID #522206002

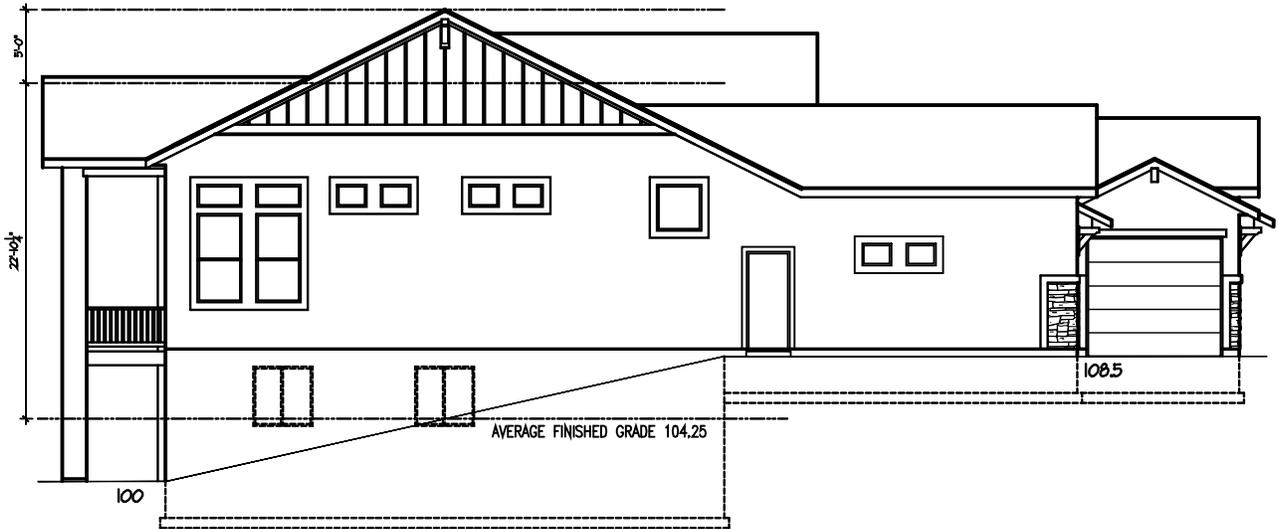

**APPROVED
Plan Review**


07/03/2025 7:41:28 AM
dsdrangel

EPC Planning & Community
Development Department

HEIGHT CALCULATIONS

2 CORNERS @ 100 = 200
2 CORNERS @ 108.5 = 217
TOTAL: 417

417 : 4 = 104.25
(AVERAGE FINISHED GRADE)

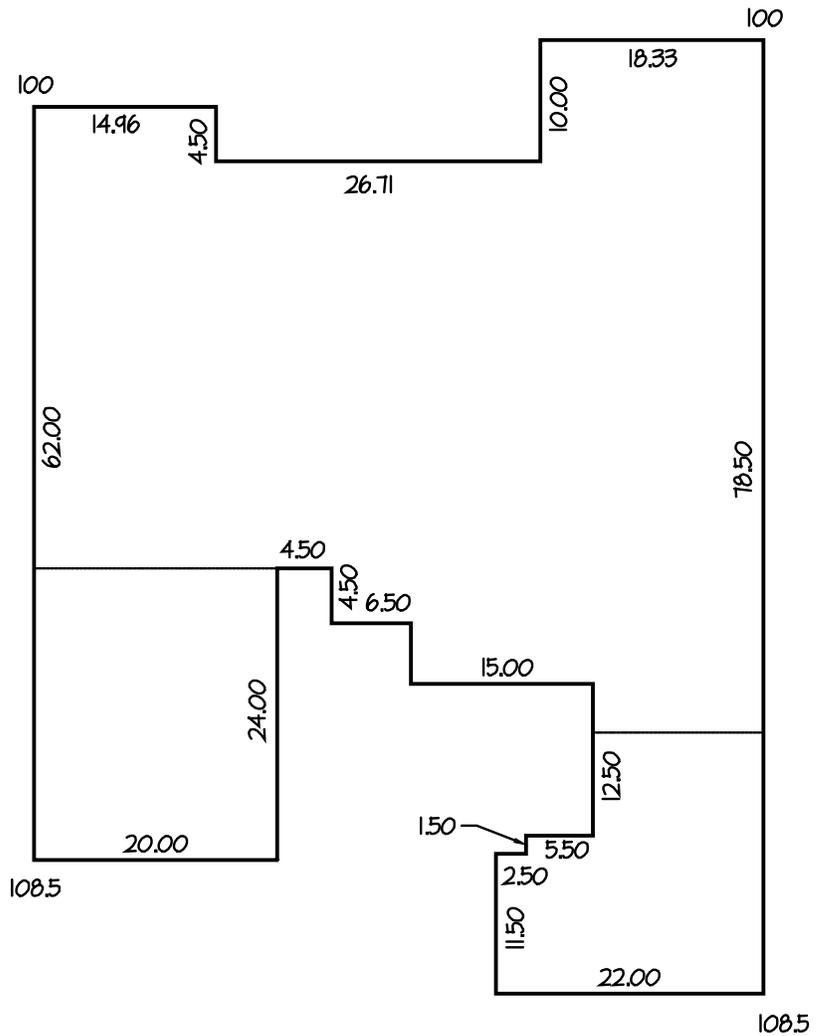

HEIGHT CALCULATIONS

WALKOUT BUILDING SITE
APRIL 29, 2021



2138 Flying Horse Club Dr
Colorado Springs, Colorado 80921
(719) 592-9333

MODEL 414.11 (ALL ELEVATIONS)

DRAWN BY: DJW

SITE



2023 PPRBC
2021 IECC Amended

Address: 9094 NATURE REFUGE WAY, COLORADO SPRINGS

Parcel: 5222006002

Plan Track #: 203363 

Received: 02-Jul-2025 (BECKYA)

Description:

RESIDENCE

Type of Unit:

Garage	881	
Lower Level 2	2621	
Main Level	2621	
	6123	Total Square Feet

Required PPRBD Departments (2)

Enumeration

APPROVED

BECKYA

7/2/2025 3:02:27 PM

Floodplain

(N/A) RBD GIS

Required Outside Departments (1)

County Zoning

APPROVED

Plan Review

07/03/2025 8:10:34 AM



EPC Planning & Community
Development Department

Release of this plan does not preclude compliance with all applicable codes, ordinances and other pertinent regulations. This plan set must be present on the job site for every inspection.