
MDT-SF21026-R5-CDs.pdf Markup Summary



27 (1)

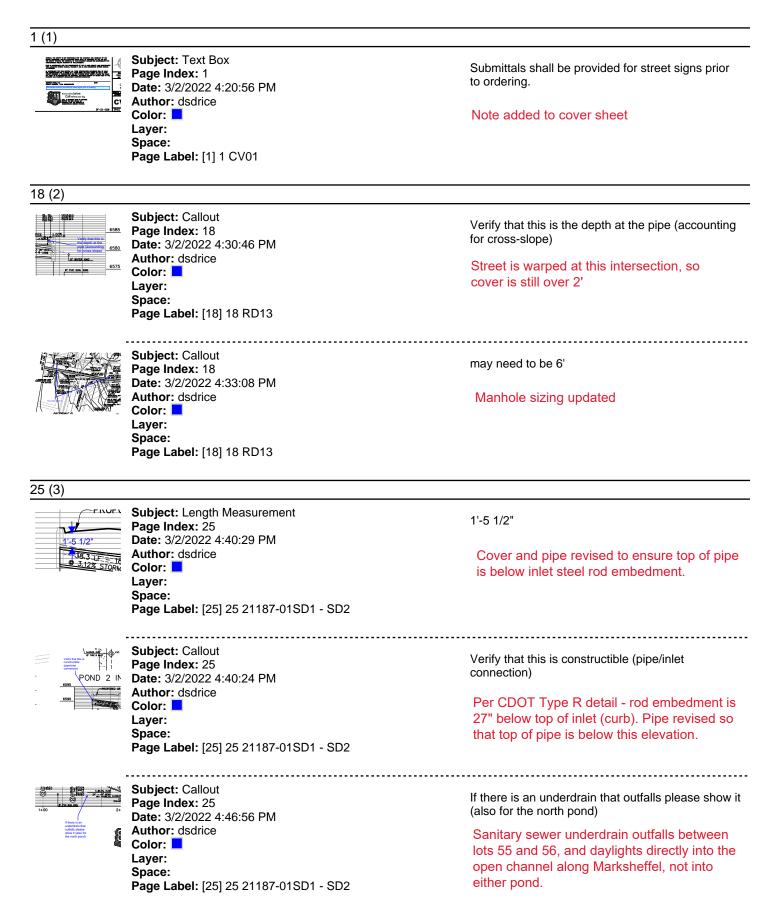

Subject: Callout Page Index: 27 Date: 3/2/2022 4:51:47 PM Author: dsdrice Color: Layer: Space: Page Label: [27] 27 21187-01INT - INT1

All landings need to have a 2% max cross-slope, so if one direction is 2% the other should be flat or both at 1.4%.

Ped ramp grades revised accordingly.