



CORE
ENGINEERING GROUP

August 13, 2024

El Paso County Planning and Community Development
2880 International Circle, Suite 110
Colorado Springs, CO 80910

RE: Ridge at Lorson Ranch Filing No. 2 (SF 225)
Certification Letter

Dear El Paso County PCD,

Based upon information gathered from as-built surveys and periodic visits to the project, Core Engineering Group is of the opinion that the subdivision improvements have been constructed in general conformance with the approved design plans as filed with El Paso County.


The site and adjacent properties (as affected by work performed under the County permit) appear to be stable with respect to settlement and subsidence, sloughing of cut and fill slopes, revegetation or other ground cover, and the improvements (public improvements, common development improvements, site grading and paving) visually appear to meet or exceed the minimum design requirements.

The sanitary and watermain located in the public ROW has also been completed in accordance with Widefield Water and Sanitation Districts criteria.

In addition, Core Engineering Group has verified in a separate certification letter dated May 4, 2023 that Extended Detention Basin/WQ Ponds C2.2 and C4 which serve this site, meet the volume and elevation requirements and are constructed in general compliance with the approved construction plans.

Based on information gathered during construction and post-construction, Core Engineering Group is of the opinion that the public streets, storm sewer, and Detention Ponds C2.2, & C4 have been constructed in general accordance with the approved construction documents.

Sincerely,
Core Engineering Group, LLC

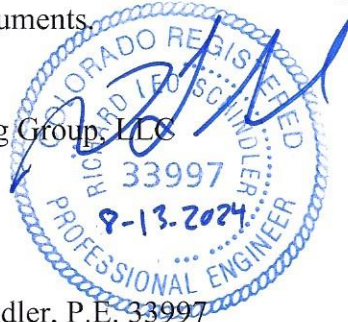

Richard L. Schindler, P.E. 33997

Attachments: Pond Certification Letter



May 4, 2023

El Paso County
Planning & Community Development
2880 International Circle, Suite 110
Colorado Springs, CO 80910

Attn.: Project Manager

RE: The Hills at Lorson Ranch Filing No. 1 (SF 21-010)
Private Detention/Stormwater Quality Ponds C1, C2.1, C2.2, C2.3, C3, & C4
As-built Certification

Dear Project Manager:

Per the approved construction drawings for The Hills at Lorson Ranch Filing No.1 (SF 21-010), improvements were made to construct six full spectrum detention ponds including water quality facility in compliance with the current El Paso County Drainage Criteria and the approved Final Drainage Report for this project.

Based upon this information and periodic site visits by field personnel to the project during significant/key phases of the stormwater BMP installation, Core Engineering Group, LLC is of the opinion that the detention and stormwater BMPs have been constructed in general compliance with the approved design plans and specifications as filed with El Paso County. The Pond C2.2 ratio peak outflow to predeveloped did exceed allowable limits for the 10-year (ratio=1.2, 25cfs) and 25-year (ratio=1.1, 40.3cfs) flows. Pond C2.2 was designed with a downstream oversized storm sewer overflow conveyance system in Fontaine Boulevard for the 100-year storm event and a modified Type D outlet structure to capture emergency overflows. The exceeded outflows will not negatively impact the oversized downstream storm sewer system for the 10-year and 25-year storms. Pond C2.2 flows downstream (in series) into existing Pond C5 located at the East Tributary of Jimmy Camp Creek. Existing Pond C5 is a large pond and the Pond C2.2 larger outflows for the 10-year and 25-year will not have any negative impact on Existing Pond C5 which flows directly into the East Tributary of Jimmy Camp Creek.

Statement Of Engineer of Record

To the best of my knowledge, information and belief, for the referenced project above, the improvements have been constructed in general compliance with the approved design plans and specifications as filed with El Paso County.


A circular blue ink seal for Richard L. Schindler, a Professional Engineer in Colorado. The seal contains the text 'RICHARD L. SCHINDLER', 'PROFESSIONAL ENGINEER', and 'COLORADO'. The number '33997' is stamped in the center, and the date '5/4/2023' is handwritten across it.
Richard L. Schindler
Colorado P.E. No. 33997
For and on behalf of Core Engineering Group, LLC

Attachments: Pond C1, C2.1, C2.2, C2.3, C3, & C4 As-Built Drawings

DETENTION BASIN OUTLET STRUCTURE DESIGN

MHFD-Detention, Version 4.02 (February 2020)

Project: The Hills at Lorson Ranch
Basin ID: Pond C1-asbuilt

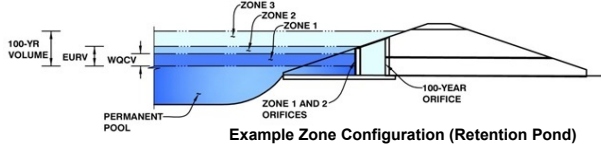

Example Zone Configuration (Retention Pond)

	Estimated Stage (ft)	Estimated Volume (ac-ft)	Outlet Type
Zone 1 (WQCV)	3.70	1.240	Orifice Plate
Zone 2 (EURV)	5.76	2.759	Rectangular Orifice
Z3 (100+1/2WQCV)	7.86	3.393	Weir&Pipe (Restrict)
Total (all zones)		7.392	

User Input: Orifice at Underdrain Outlet (typically used to drain WQCV in a Filtration BMP)

Underdrain Orifice Invert Depth = ft (distance below the filtration media surface)
Underdrain Orifice Diameter = inches

Calculated Parameters for Underdrain
Underdrain Orifice Area = ft²
Underdrain Orifice Centroid = feet

User Input: Orifice Plate with one or more orifices or Elliptical Slot Weir (typically used to drain WQCV and/or EURV in a sedimentation BMP)

Invert of Lowest Orifice = ft (relative to basin bottom at Stage = 0 ft)
Depth at top of Zone using Orifice Plate = ft (relative to basin bottom at Stage = 0 ft)
Orifice Plate: Orifice Vertical Spacing = inches
Orifice Plate: Orifice Area per Row = sq. inches (diameter = 2 inches)

Calculated Parameters for Plate
WQ Orifice Area per Row = ft²
Elliptical Half-Width = feet
Elliptical Slot Centroid = feet
Elliptical Slot Area = ft²

User Input: Stage and Total Area of Each Orifice Row (numbered from lowest to highest)

	Row 1 (required)	Row 2 (optional)	Row 3 (optional)	Row 4 (optional)	Row 5 (optional)	Row 6 (optional)	Row 7 (optional)	Row 8 (optional)
Stage of Orifice Centroid (ft)	0.00	1.20	2.45					
Orifice Area (sq. inches)	3.20	3.20	3.20					

	Row 9 (optional)	Row 10 (optional)	Row 11 (optional)	Row 12 (optional)	Row 13 (optional)	Row 14 (optional)	Row 15 (optional)	Row 16 (optional)
Stage of Orifice Centroid (ft)								
Orifice Area (sq. inches)								

User Input: Vertical Orifice (Circular or Rectangular)

Zone 2 Rectangular ☐ Not Selected ☐
Invert of Vertical Orifice = ft (relative to basin bottom at Stage = 0 ft)
Depth at top of Zone using Vertical Orifice = ft (relative to basin bottom at Stage = 0 ft)
Vertical Orifice Height = inches
Vertical Orifice Width = inches

Calculated Parameters for Vertical Orif
Zone 2 Rectangular Not Selected
Vertical Orifice Area =
Vertical Orifice Centroid =

User Input: Overflow Weir (Dropbox with Flat or Sloped Grate and Outlet Pipe OR Rectangular/Trapezoidal Weir (and No Outlet Pipe).

Zone 3 Weir ☐ Not Selected ☐
Overflow Weir Front Edge Height, H_o = ft (relative to basin bottom at Stage = 0 ft)
Overflow Weir Front Edge Length = feet
Overflow Weir Grate Slope = H:V
Horiz. Length of Weir Sides = feet
Overflow Grate Open Area % = %
Debris Clogging % = %

Height of Grate Upper Edge, H_u =
Overflow Weir Slope Length =
Grate Open Area / 100-yr Orifice Area =
Overflow Grate Open Area w/o Debris =
Overflow Grate Open Area w/ Debris =

User Input: Outlet Pipe w/ Flow Restriction Plate (Circular Orifice, Restrictor Plate, or Rectangular Orifice)

Zone 3 Restrictor ☐ Not Selected ☐
Depth to Invert of Outlet Pipe = ft (distance below basin bottom at Stage = 0 ft)
Outlet Pipe Diameter = inches
Restrictor Plate Height Above Pipe Invert = inches

Calculated Parameters for Outlet Pipe w/ Flow Restriction Plate
Outlet Orifice Area =
Outlet Orifice Centroid =
Half-Central Angle of Restrictor Plate on Pipe =

User Input: Emergency Spillway (Rectangular or Trapezoidal)

Spillway Invert Stage = ft (relative to basin bottom at Stage = 0 ft)
Spillway Crest Length = feet
Spillway End Slopes = H:V
Freeboard above Max Water Surface = feet

Calculated Parameters for Spillway
Spillway Design Flow Depth = feet
Stage at Top of Freeboard = feet
Basin Area at Top of Freeboard = acres
Basin Volume at Top of Freeboard = acre-ft

micropool = 0 = 5743.35

Routed Hydrograph Results

The user can override the default CUHP hydrographs and runoff volumes by entering new values in the Inflow Hydrographs table (Columns W through AF)

	WQCV	EURV	2 Year	5 Year	10 Year	25 Year	50 Year	100 Year
Design Storm Return Period	N/A	N/A	1.19	1.50	1.75	2.00	2.25	2.52
One-Hour Rainfall Depth (in)	N/A	N/A	1.240	3.999	3.772	5.294	6.615	8.338
CUHP Runoff Volume (acre-ft)	N/A	N/A	3.772	5.294	6.615	8.338	9.762	11.547
Inflow Hydrograph Volume (acre-ft)	N/A	N/A	3.772	5.294	6.615	8.338	9.762	11.547
CUHP Predevelopment Peak Q (cfs)	N/A	N/A	4.8	13.7	21.2	39.0	49.1	63.3
OPTIONAL Override Predevelopment Peak Q (cfs)	N/A	N/A						
Predevelopment Unit Peak Flow, q (cfs/acre)	N/A	N/A	0.07	0.20	0.31	0.58	0.73	0.94
Peak Inflow Q (cfs)	N/A	N/A	45.6	64.4	78.4	105.4	123.5	145.4
Peak Outflow Q (cfs)	0.5	6.0	5.0	6.4	14.6	15.7	16.5	17.5
Ratio Peak Outflow to Predevelopment Q	N/A	N/A	N/A	0.5	0.7	0.4	0.3	0.3
Structure Controlling Flow	Vertical Orifice 1	Vertical Orifice 1	Vertical Orifice 1	Vertical Orifice 1	Outlet Plate 1	Outlet Plate 1	Outlet Plate 1	Outlet Plate 1
Max Velocity through Grate 1 (fps)	N/A	N/A	N/A	N/A	0.6	0.6	0.6	0.6
Max Velocity through Grate 2 (fps)	N/A	N/A	N/A	N/A	N/A	N/A	N/A	N/A
Time to Drain 97% of Inflow Volume (hours)	39	48	49	50	49	48	47	46
Time to Drain 99% of Inflow Volume (hours)	41	52	53	55	55	55	56	56
Maximum Ponding Depth (ft)	3.70	5.76	5.15	6.02	6.57	7.37	8.06	8.95
Area at Maximum Ponding Depth (acres)	1.10	1.50	1.42	1.53	1.59	1.68	1.76	1.87
Maximum Volume Stored (acre-ft)	1.248	4.005	3.115	4.398	5.238	6.545	7.732	9.348

MHFD-Detention, Version 4.02 (February 2020)

Basin ID: Pond C1-asbuilt




Watershed Information

Optional User Overrides

Initial Surcharge Area (A_{ISV})	=	user	ft ²
Surcharge Volume Length (L_{SV})	=	user	ft
Surcharge Volume Width (W_{SV})	=	user	ft
Depth of Basin Floor (H_{rLOOR})	=	user	ft
Length of Basin Floor (L_{rLOOR})	=	user	ft
Width of Basin Floor (W_{rLOOR})	=	user	ft
Area of Basin Floor (A_{rLOOR})	=	user	ft ²
Volume of Basin Floor (V_{rLOOR})	=	user	ft ³
Depth of Main Basin (H_{uMAIN})	=	user	ft
Length of Main Basin (L_{uMAIN})	=	user	ft
Width of Main Basin (W_{uMAIN})	=	user	ft
Area of Main Basin (A_{uMAIN})	=	user	ft ²
Volume of Main Basin (V_{uMAIN})	=	user	ft ³
Calculated Total Basin Volume (V_{uBAS})	=	user	acre-feet

[illegible]

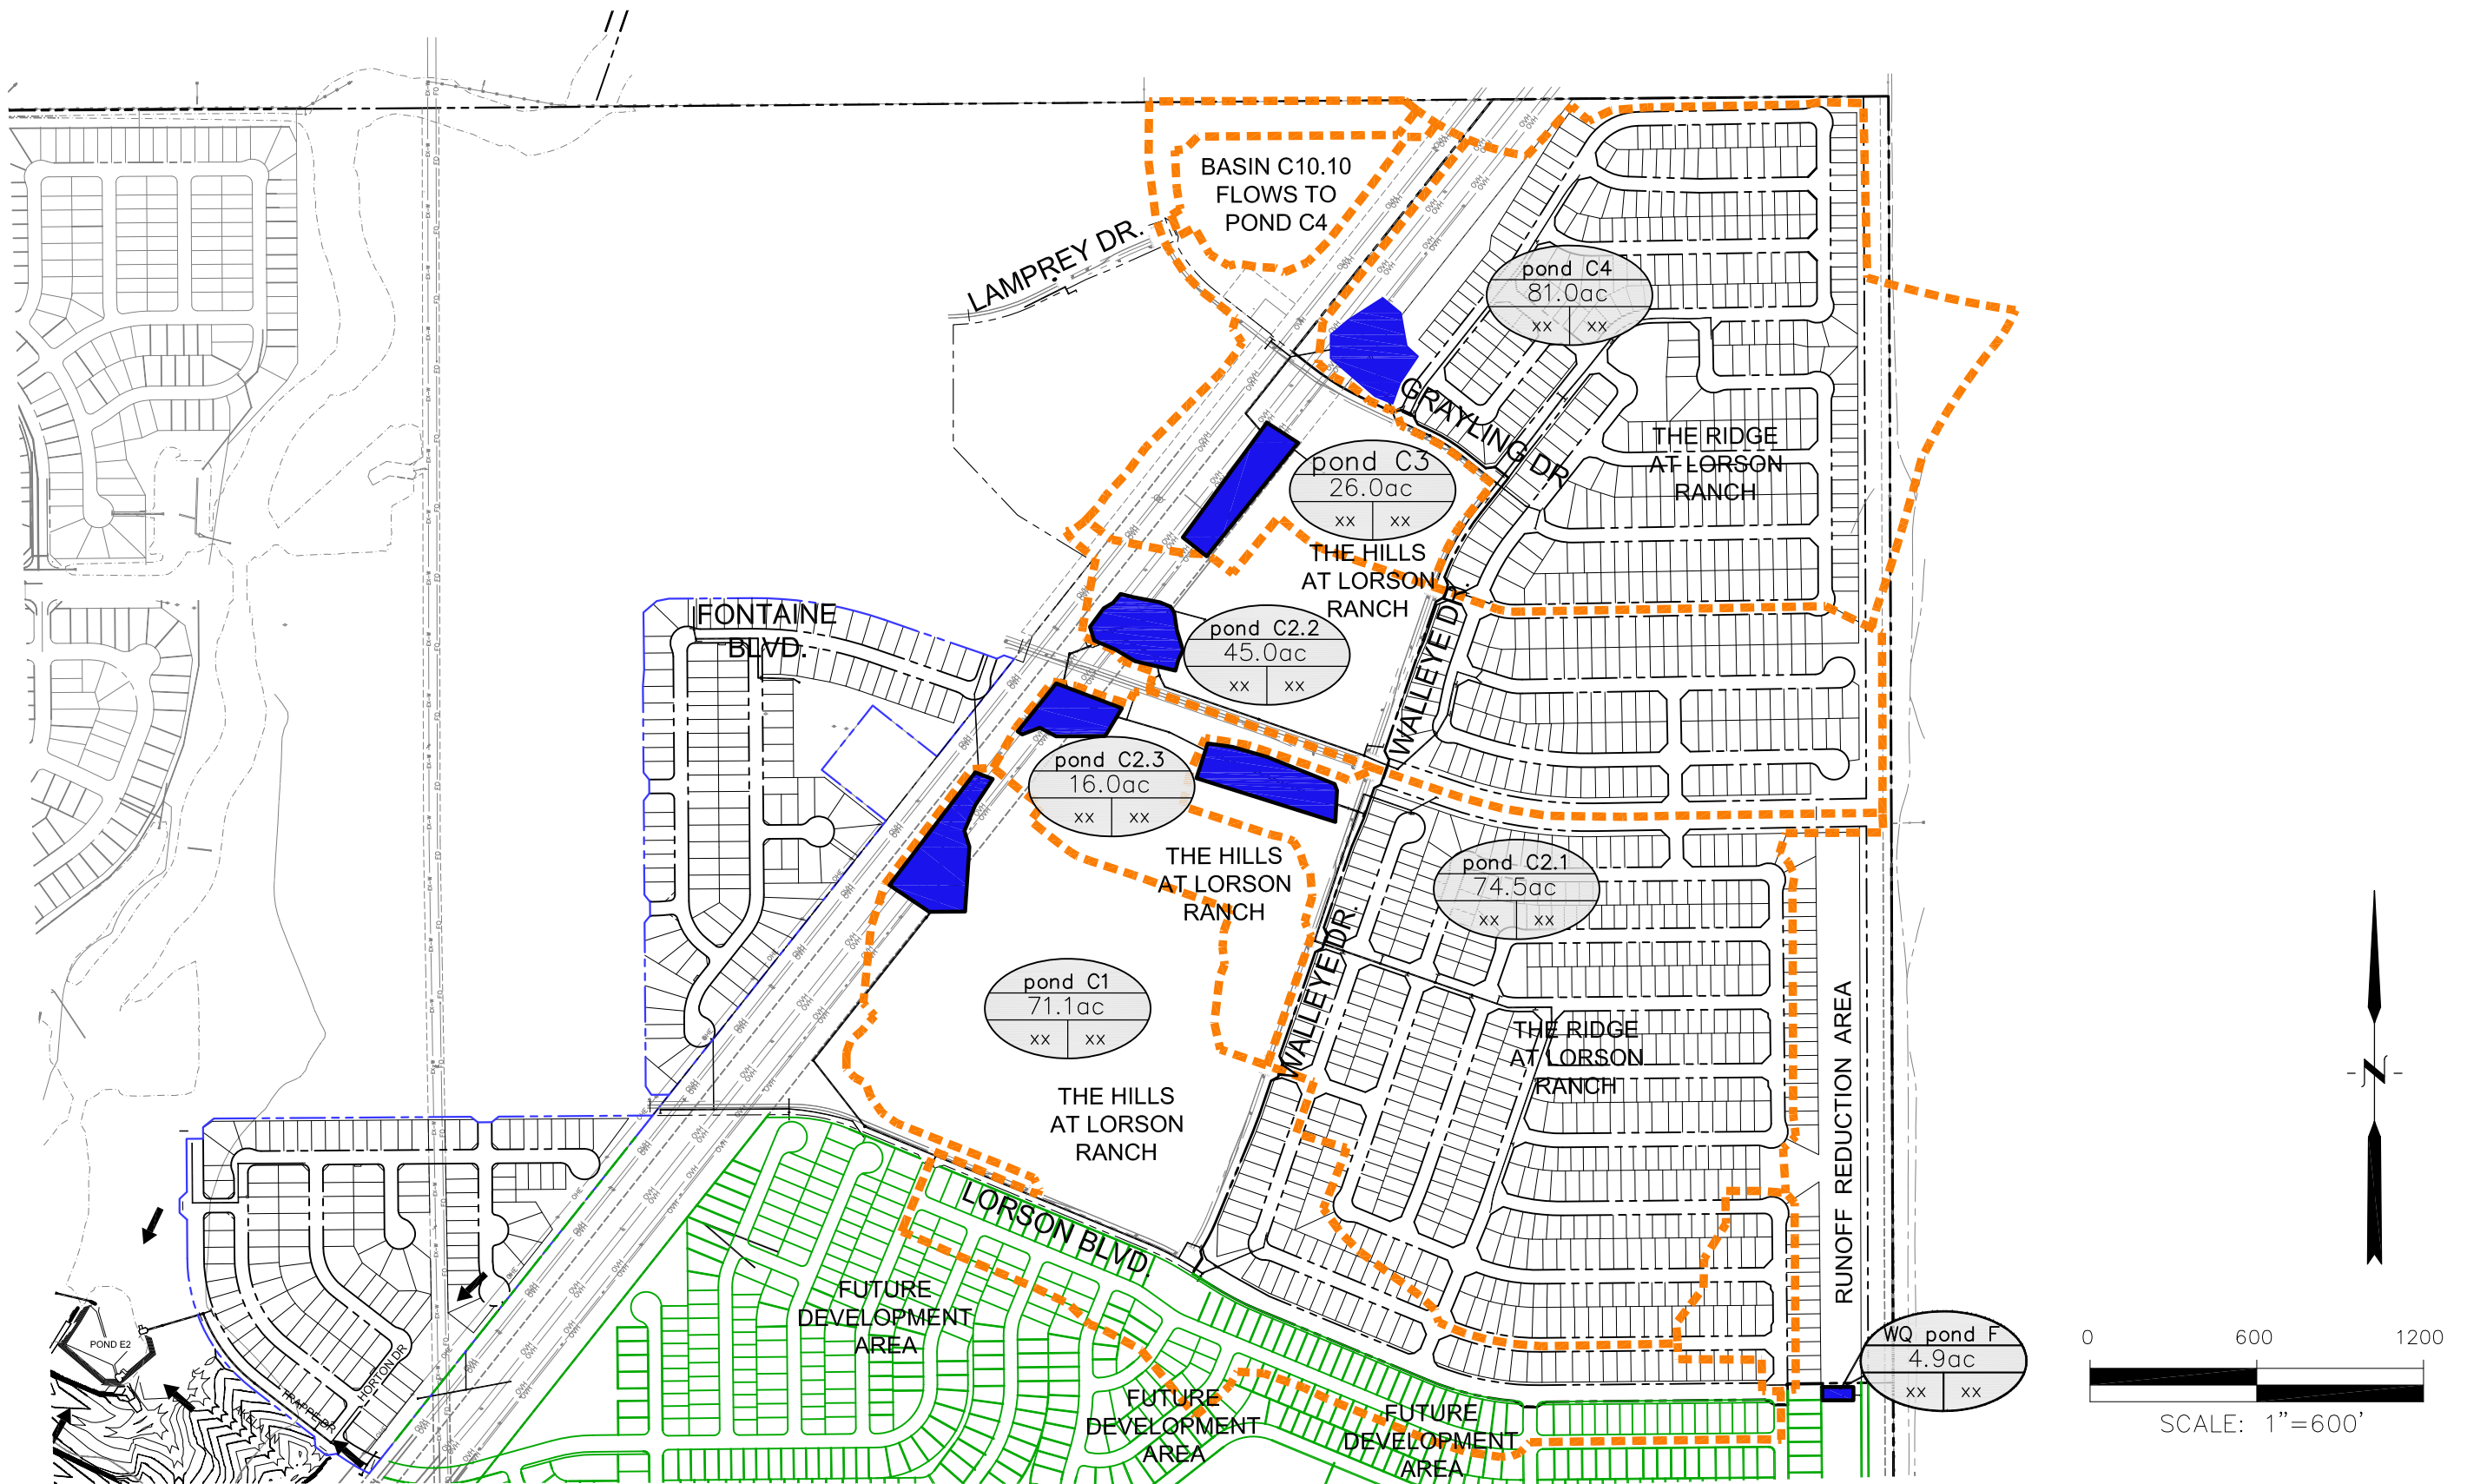


**CORE
ENGINEERING GROUP**
15004 1ST AVENUE S.
BURNSVILLE, MN 55306
PH: 719.570.1100
CONTACT: RICHARD L. SCHINDLER, P.E.
EMAIL: Rich@ceg1.com

**THE RIDGE AT LORSON RANCH
WATER QUALITY & POND TRIBUTARY AREAS**

SCALE:
NTS

DATE:
SEPT, 2021

FIGURE NO.
1

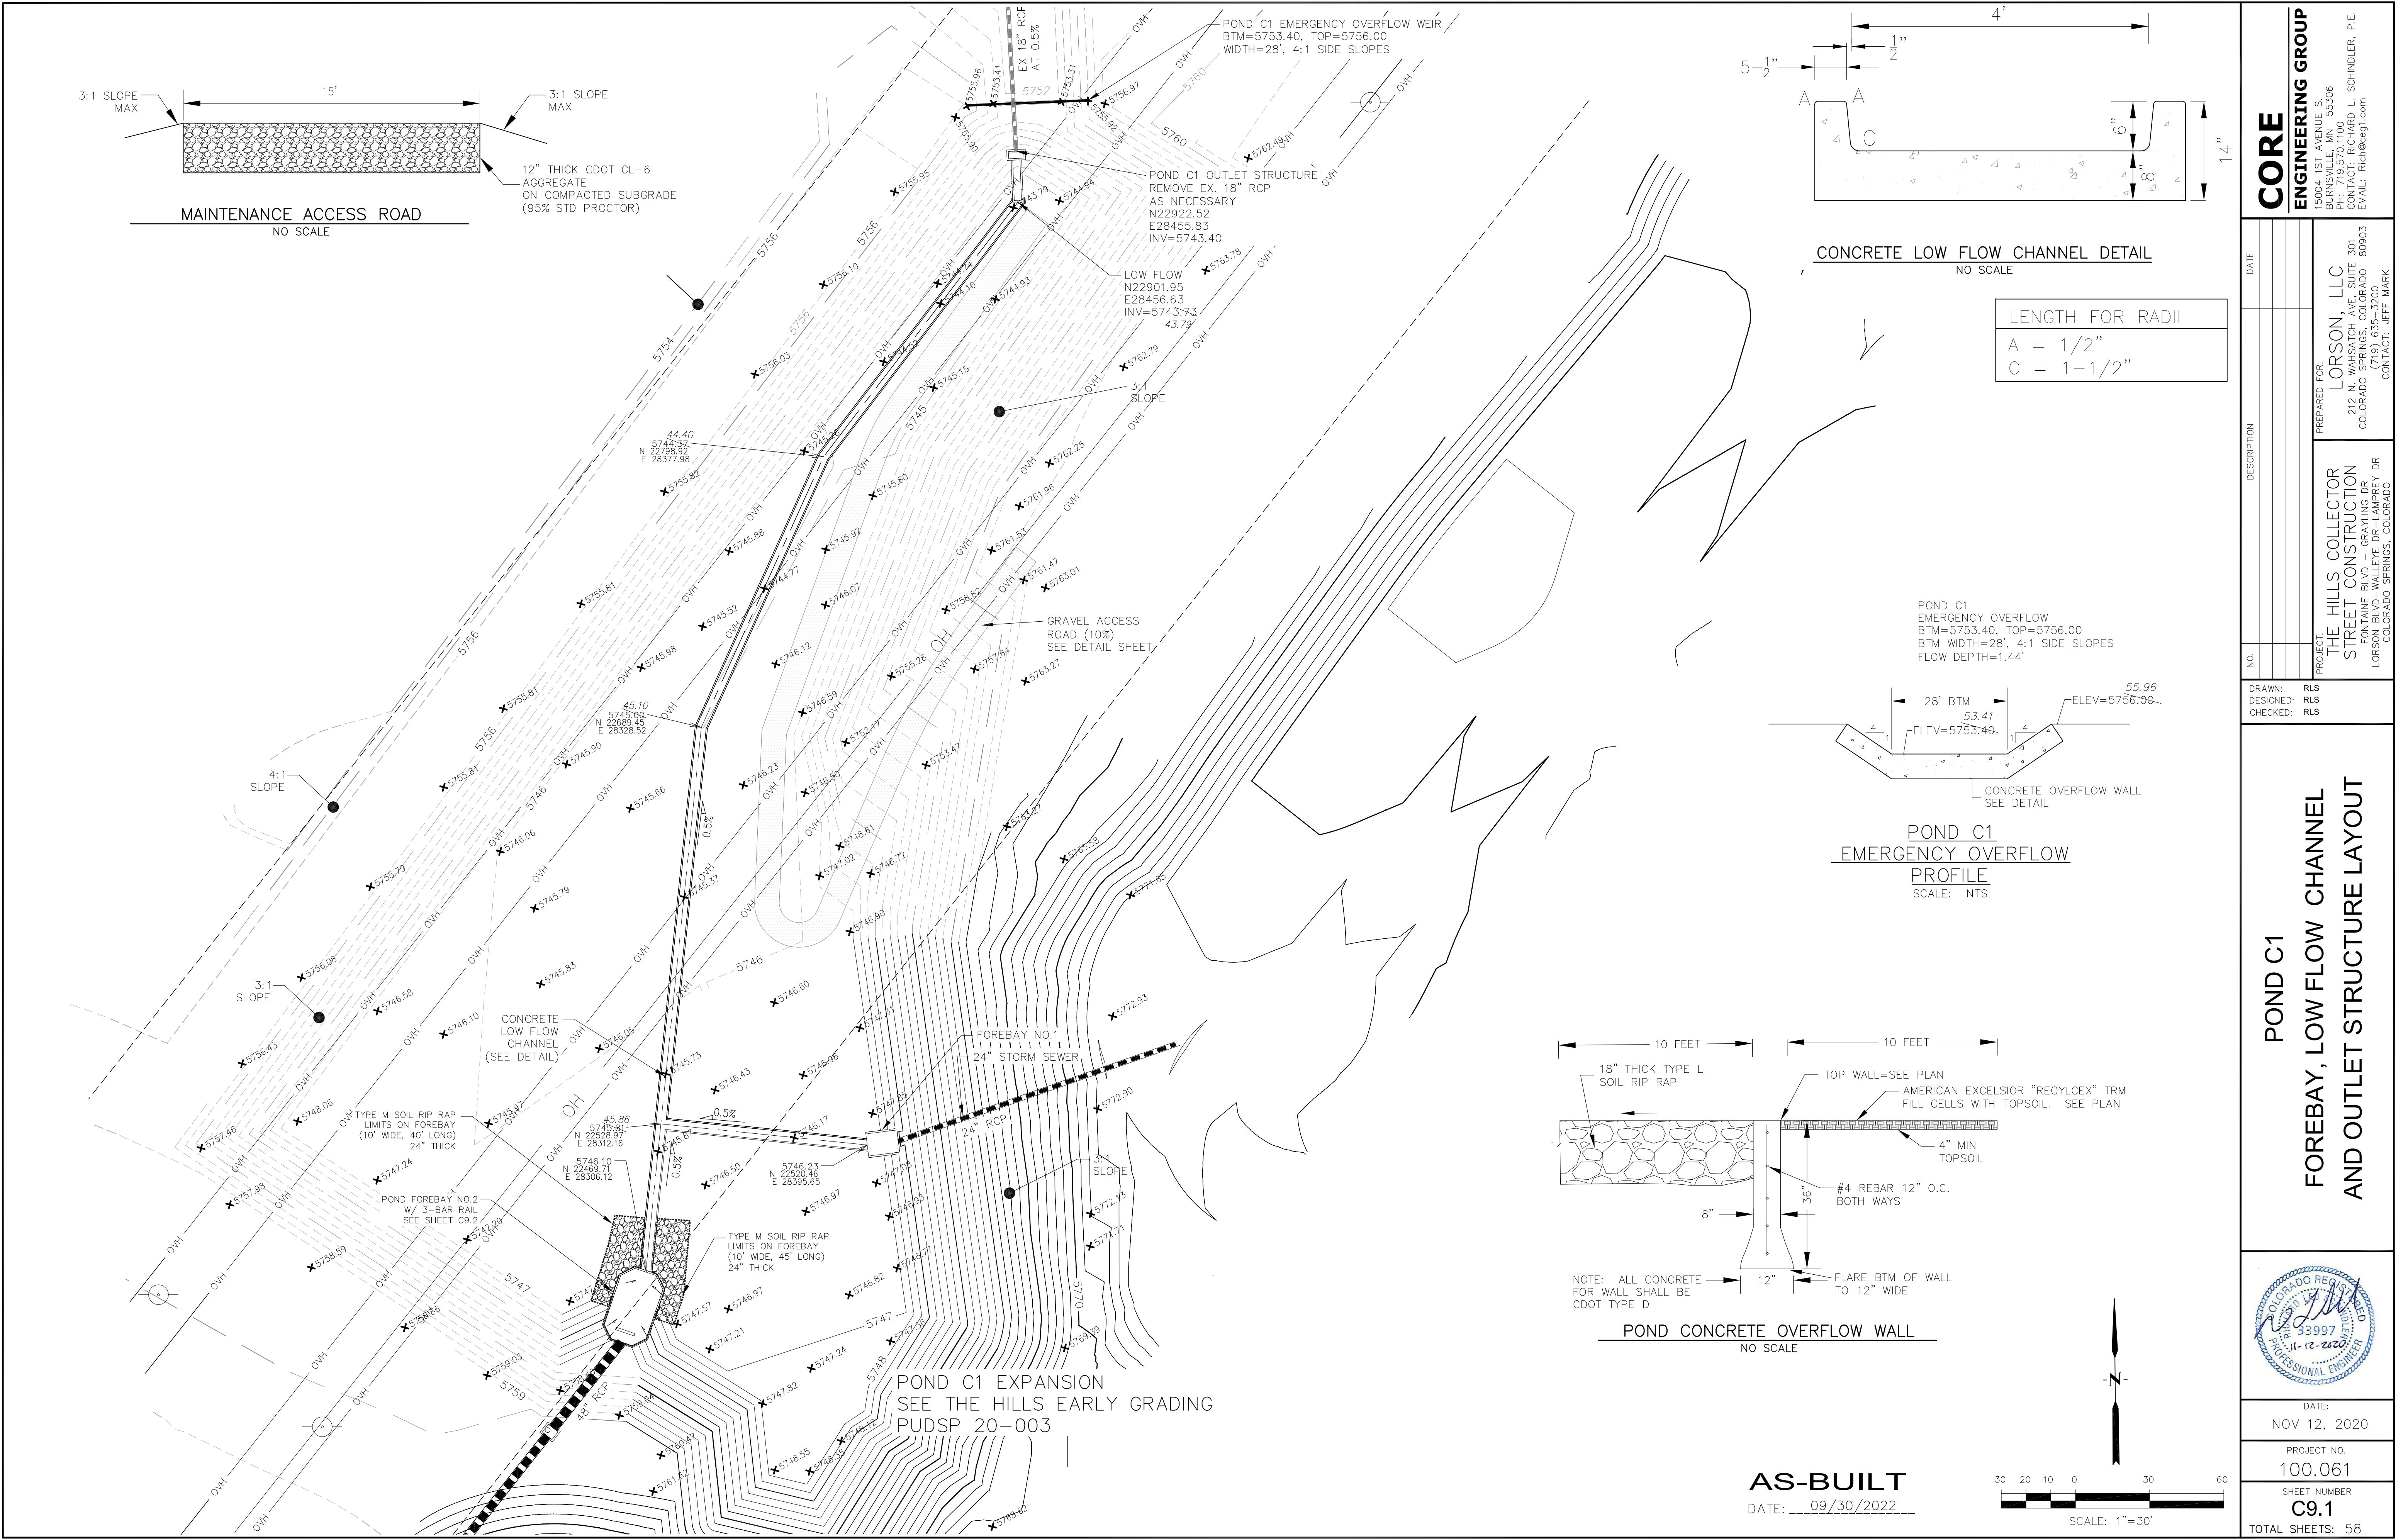

CORE
ENGINEERING GROUP

15004 1ST AVENUE S.
BURNING WOODS, CO 80903
CONTACT: RICHARD L. SCHINDLER, P.E.
EMAIL: Rich@ceg.com

DATE

DESCRIPTION

NO.

PROJECT: THE HILLS COLLECTOR STREET CONSTRUCTION

PREPARED FOR: LORSON, LLC
212 N. WAHSATCH AVE. SUITE 301
COLORADO SPRINGS, COLORADO 80903
(719) 635-3200
CONTACT: JEFF MARK

DRAWN: RLS
DESIGNED: RLS
CHECKED: RLS

POND C1
FOREBAY, LOW FLOW CHANNEL
AND OUTLET STRUCTURE LAYOUT

DATE:
NOV 12, 2020



PROJECT NO.
100.061

SHEET NUMBER
C9.1


TOTAL SHEETS: 58

1. ALL SPOT ELEVATIONS ARE FLOW LINE UNLESS OTHERWISE NOTED.
2. SEE GRADING PLAN FOR GRADING INFORMATION.
3. ALL STORM SEWER SHALL BE CLASS III RCP.
4. ALL MHs SHALL BE TYPE 1 UNLESS OTHERWISE NOTED.



- 1 CURVE DATA ID
2 CURB TRANSITIONS
3 PEDESTRIAN RAMP, SEE SHEET C10.1

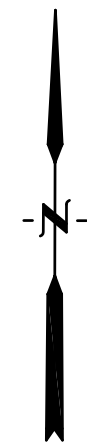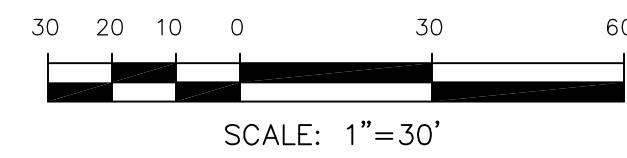

KITFOX CT
SEE SHEET C6.13

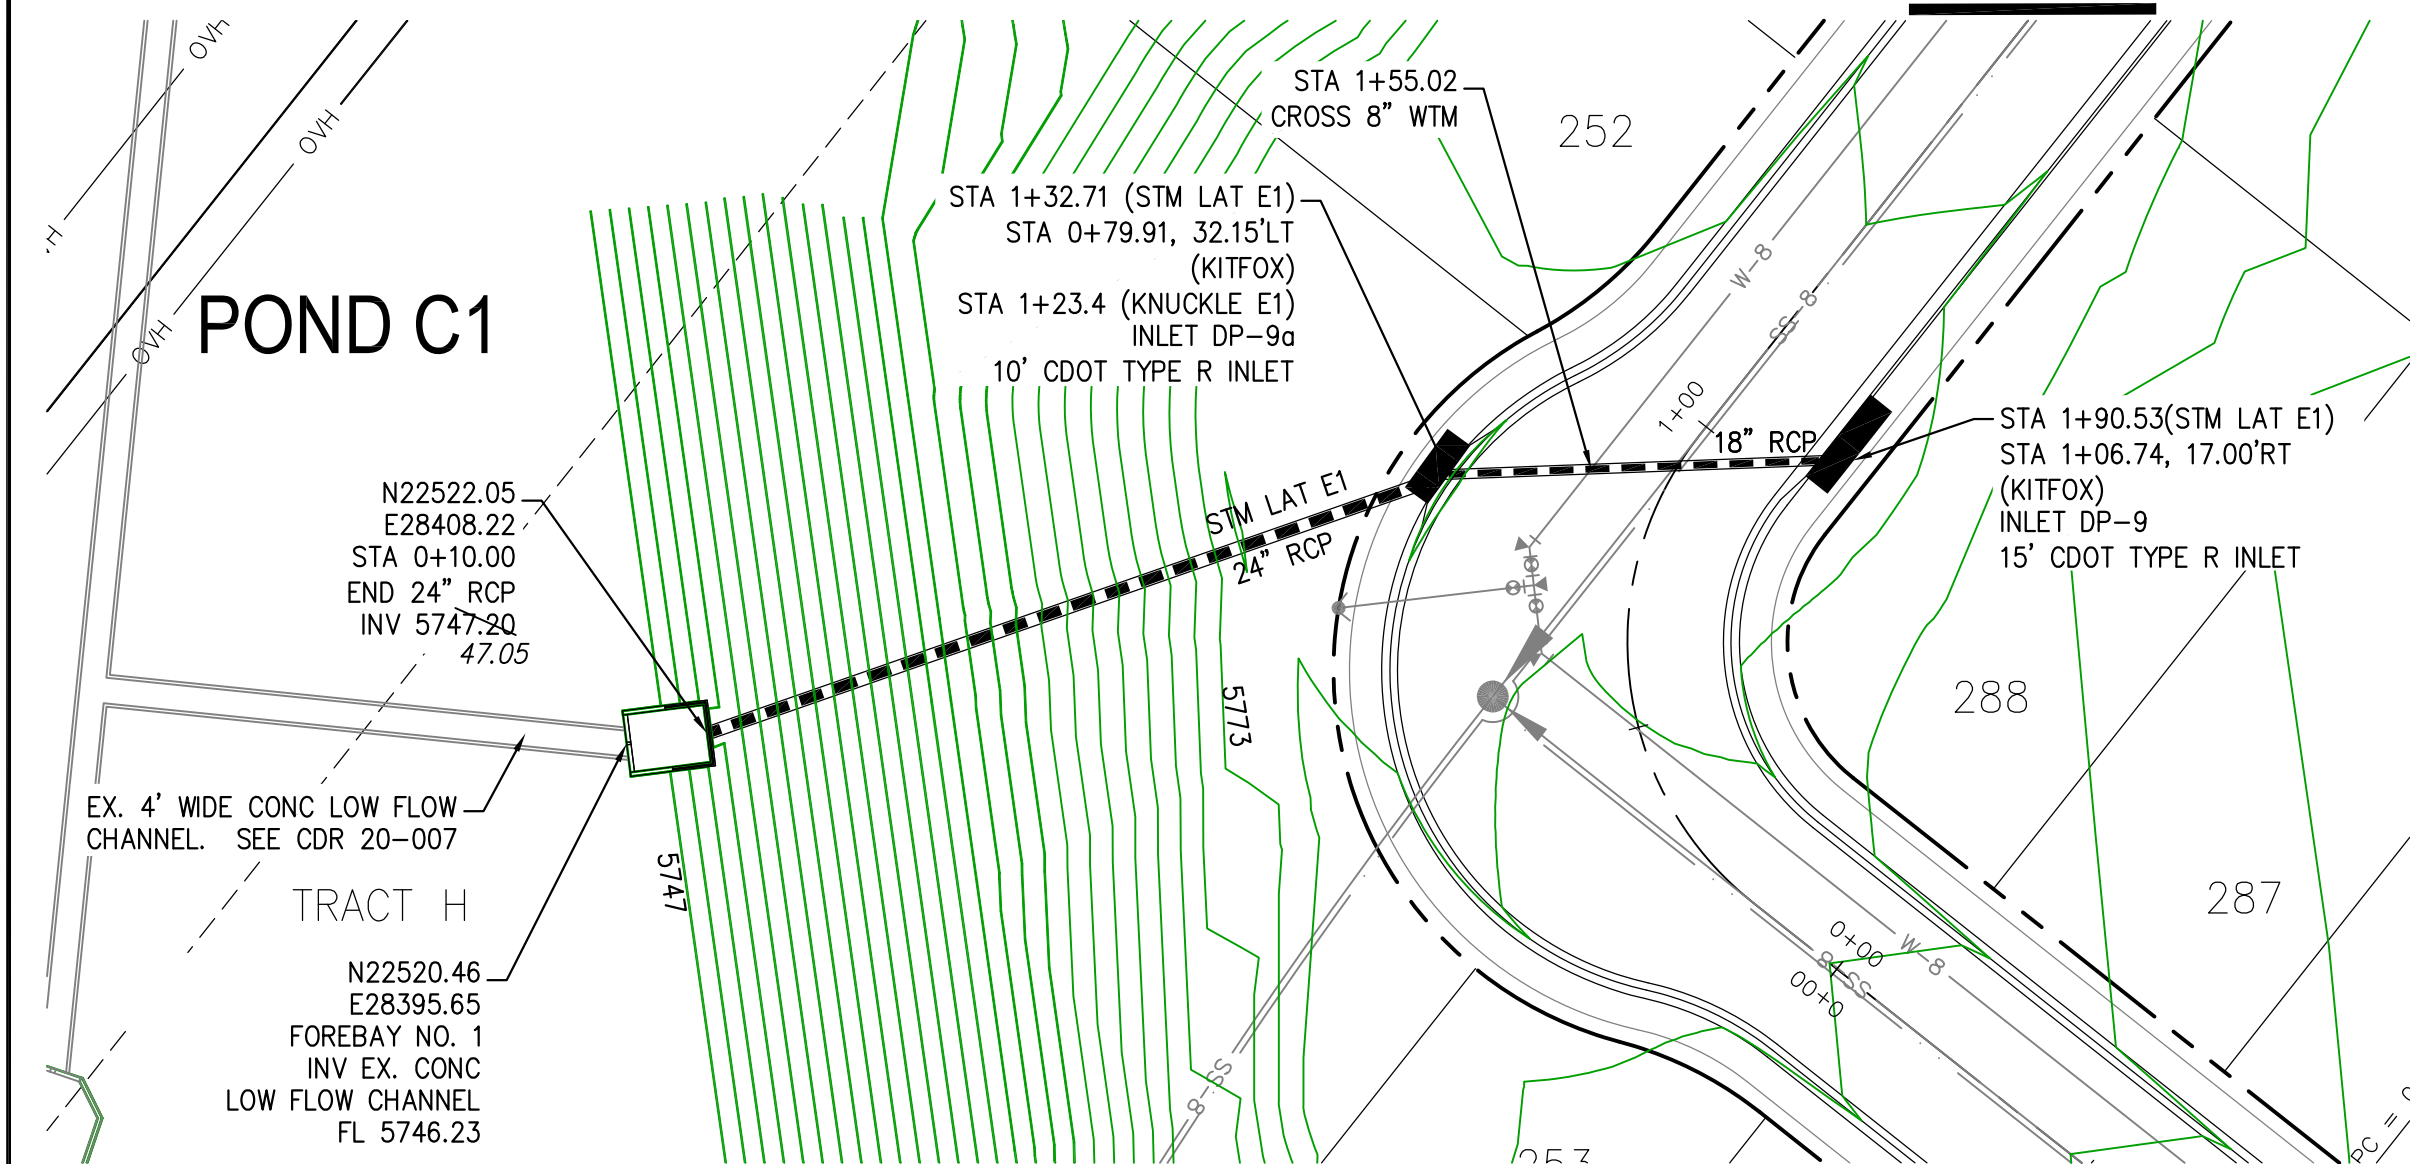


STORM LATERAL E1

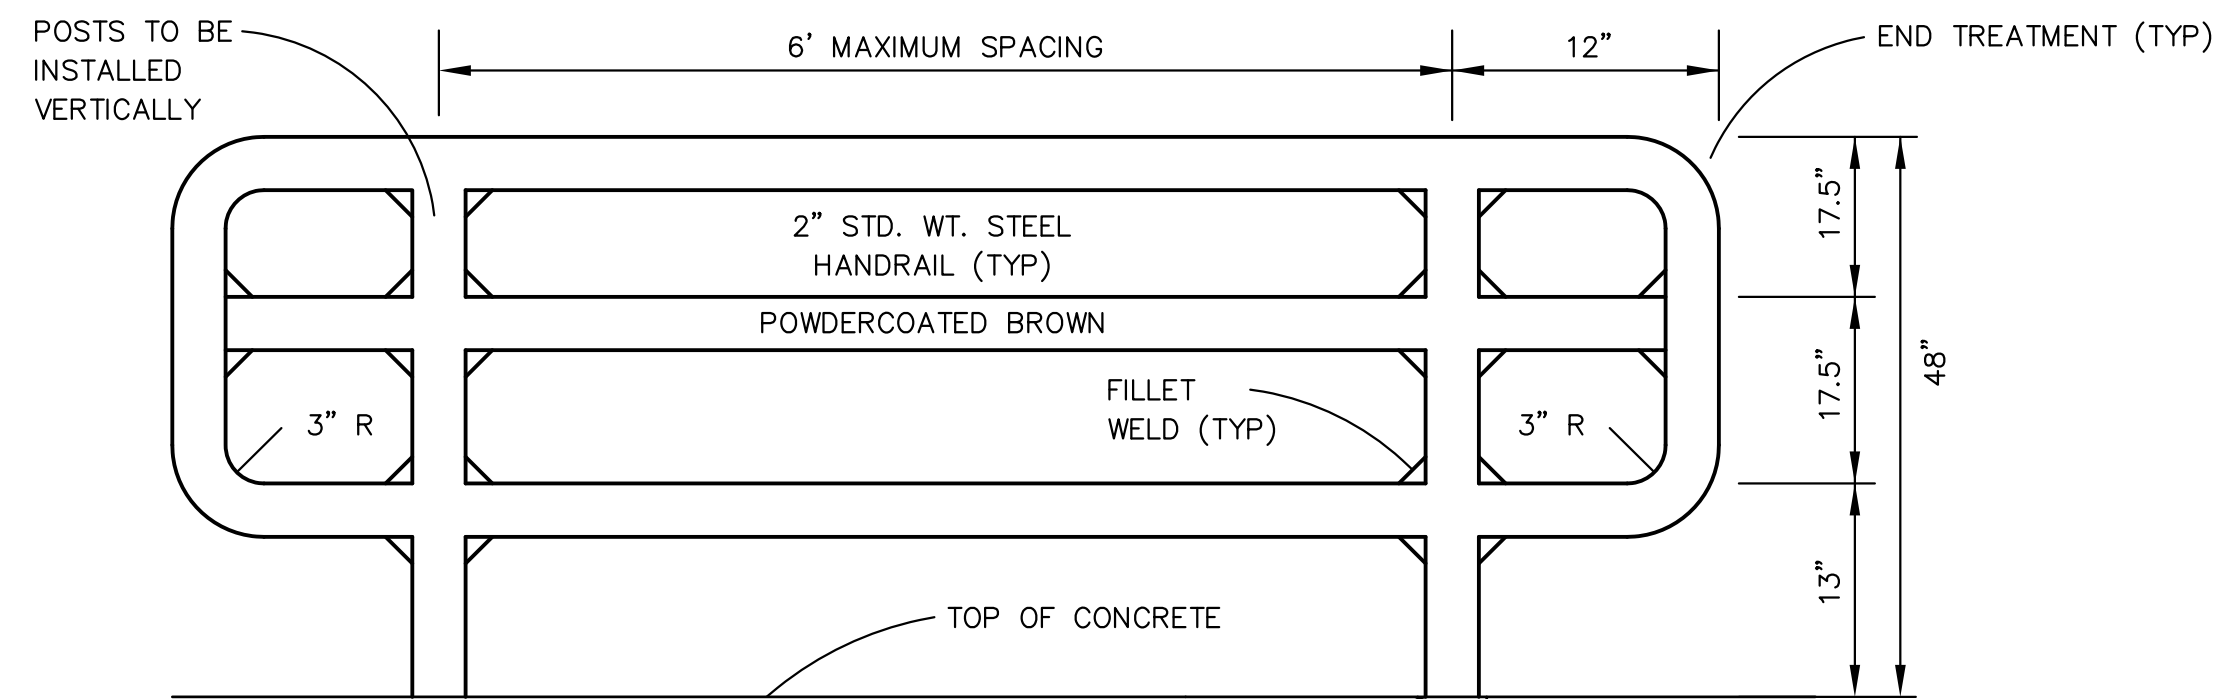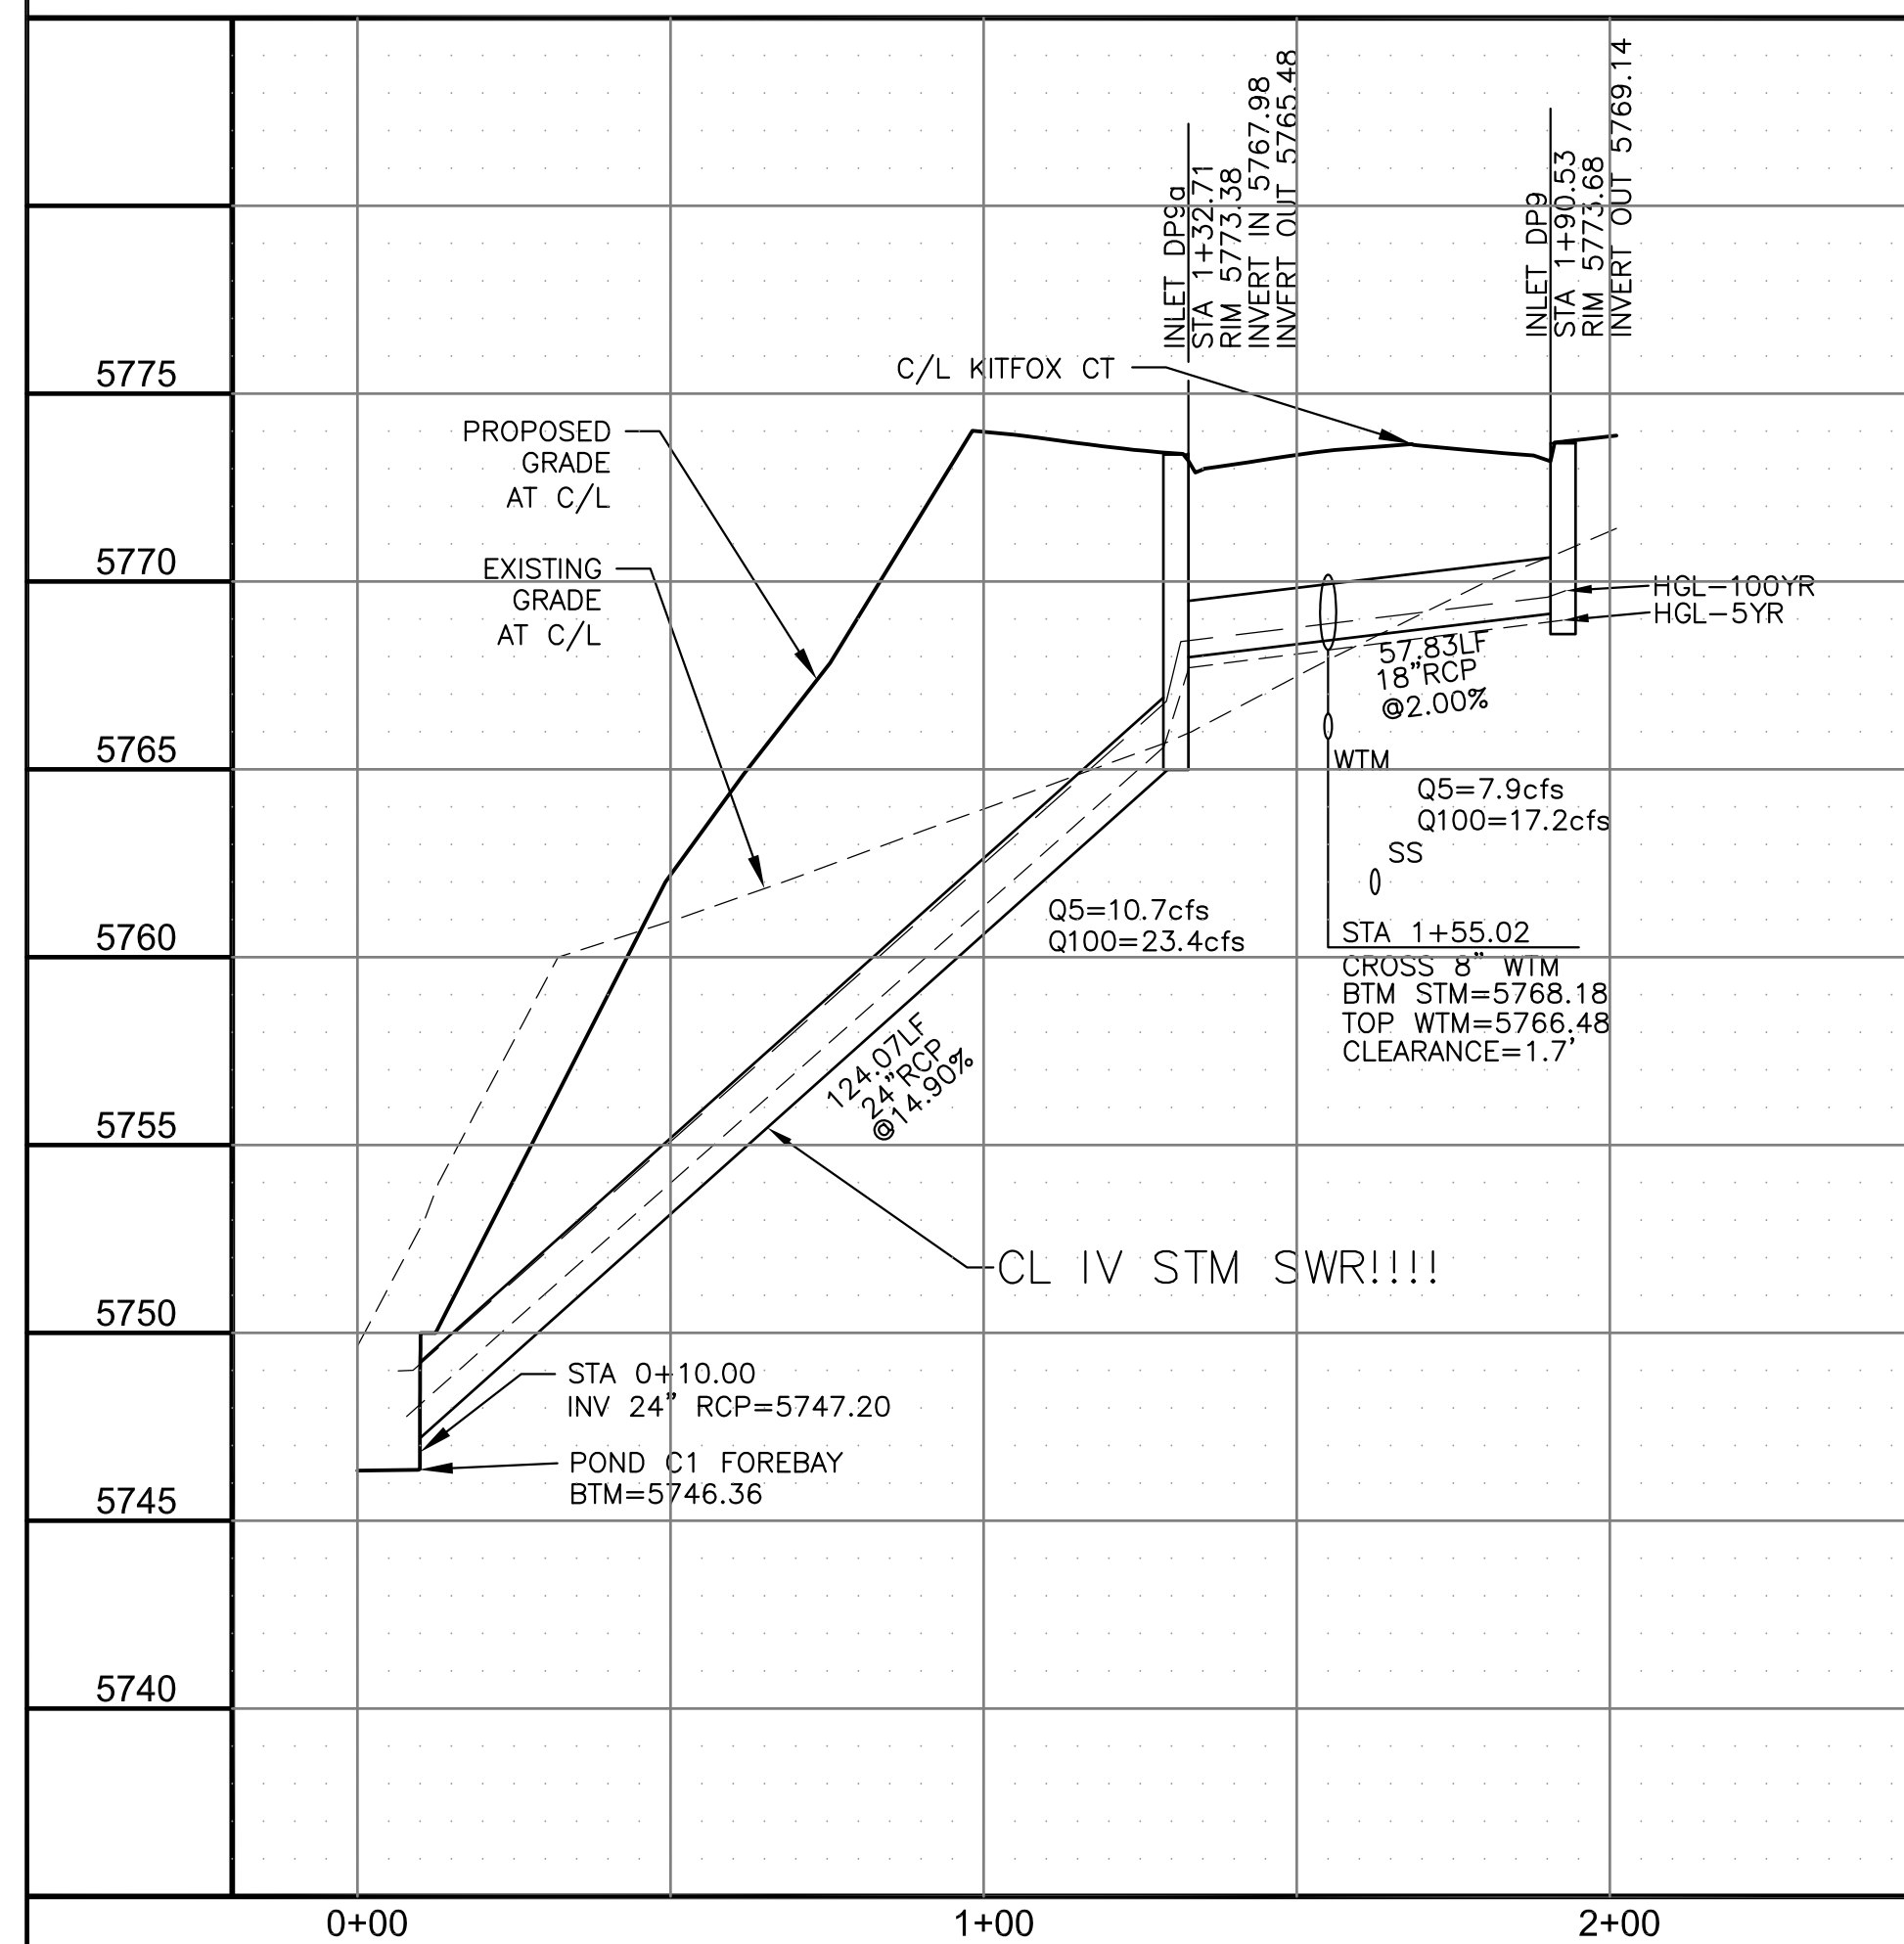


3-BAR RAIL DETAIL


NO SCALE

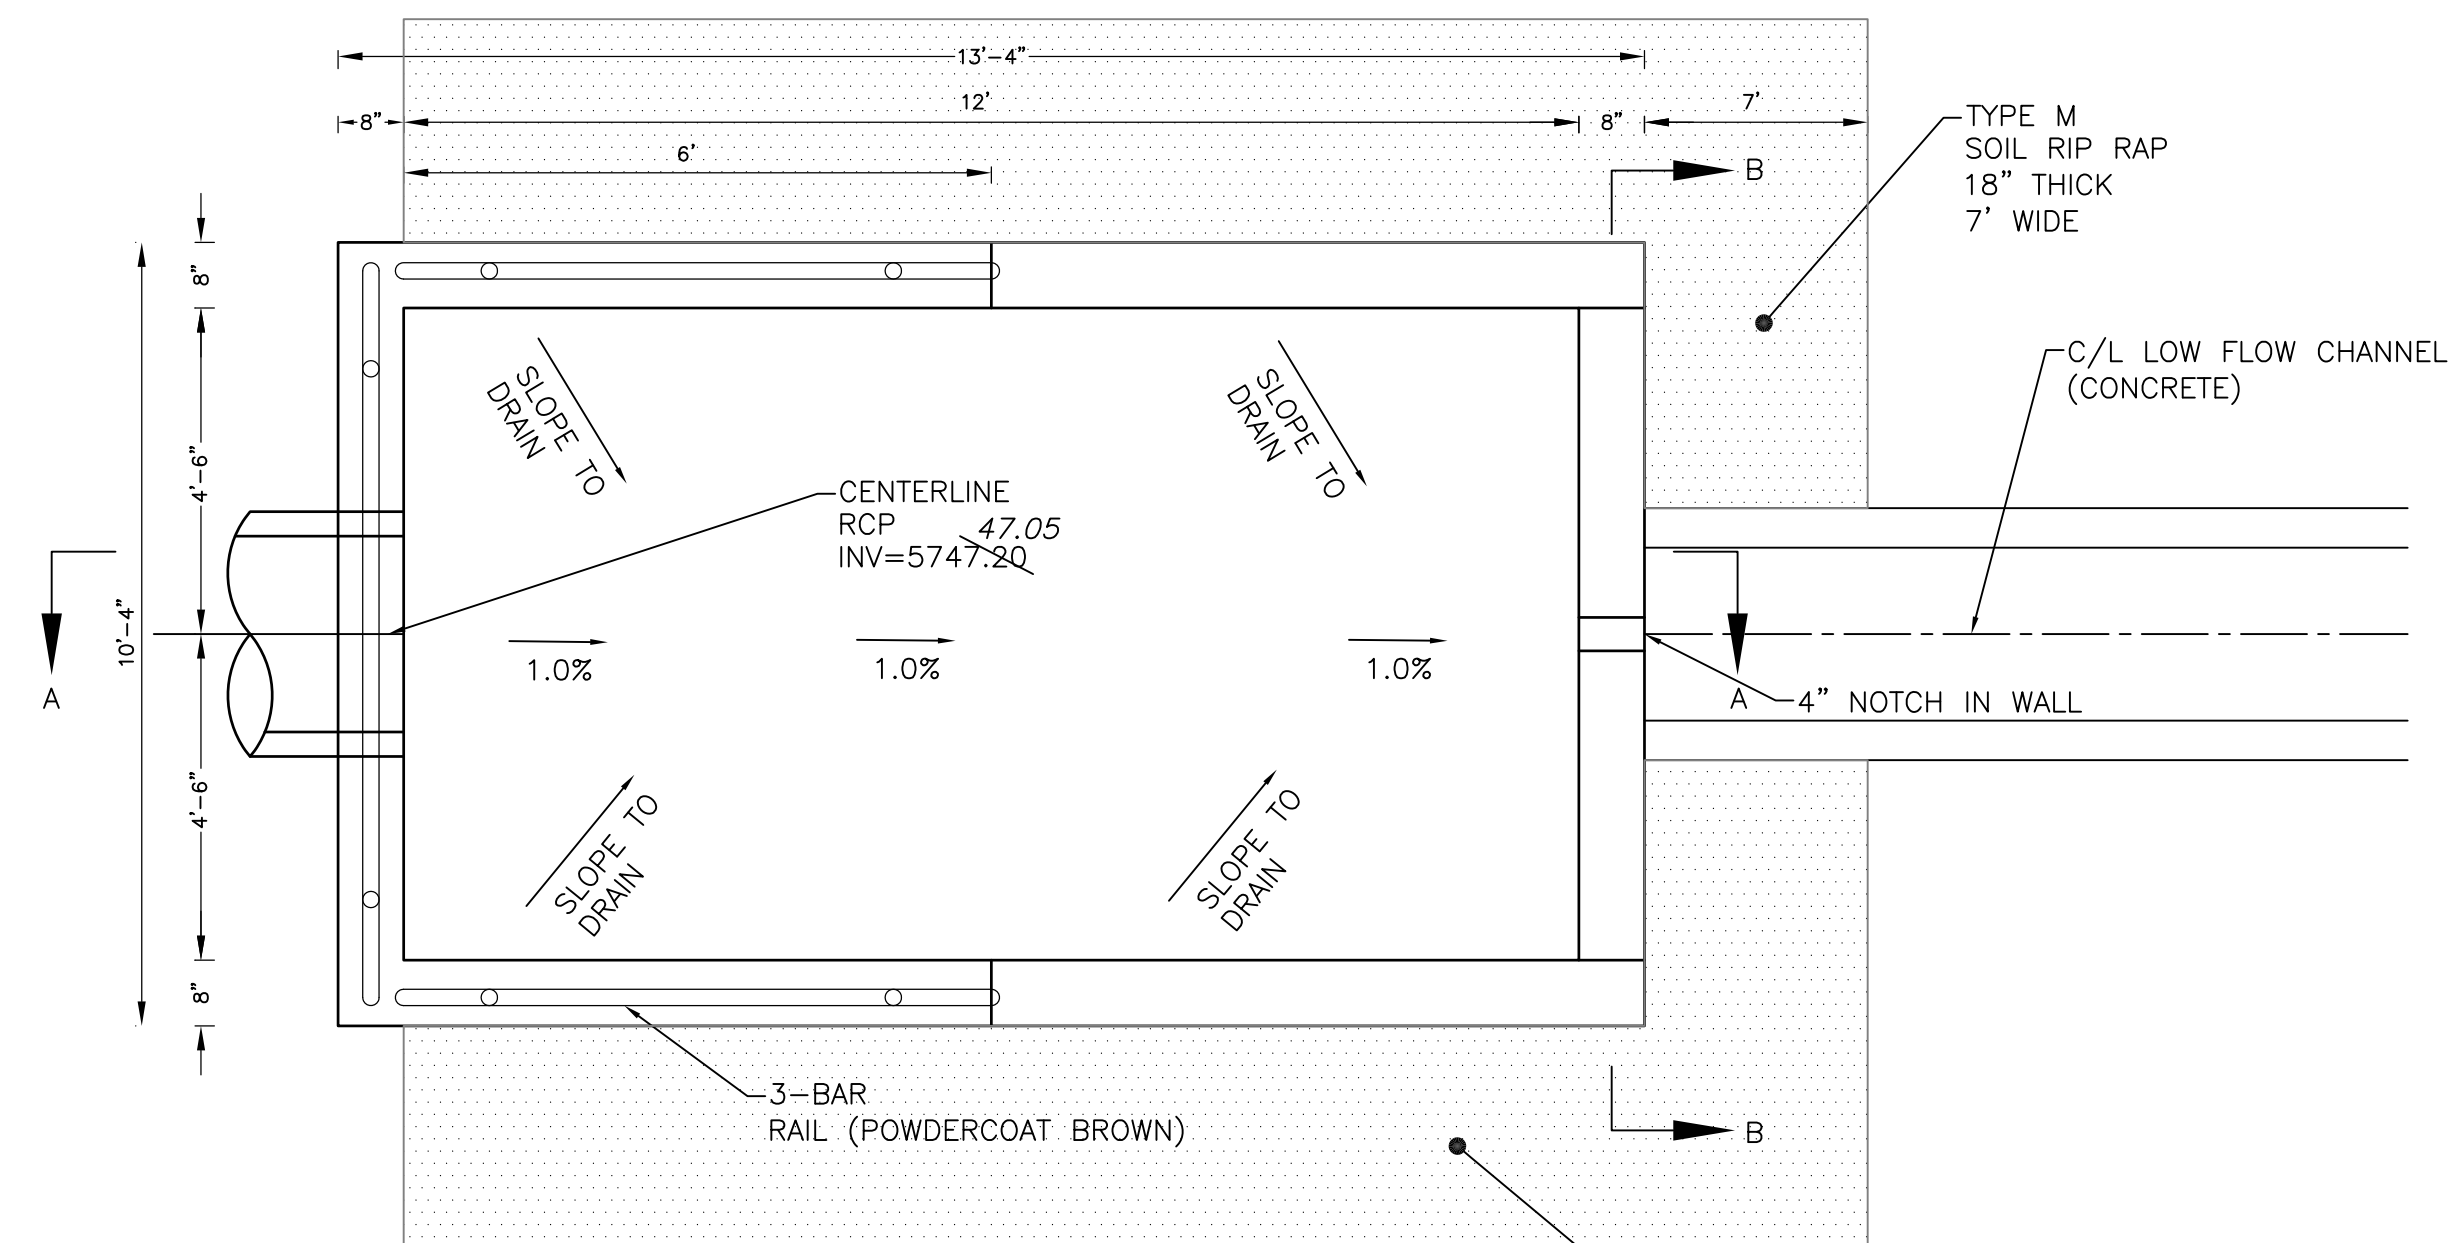

FOREBAY NO. 1 DETAIL
NO SCALE

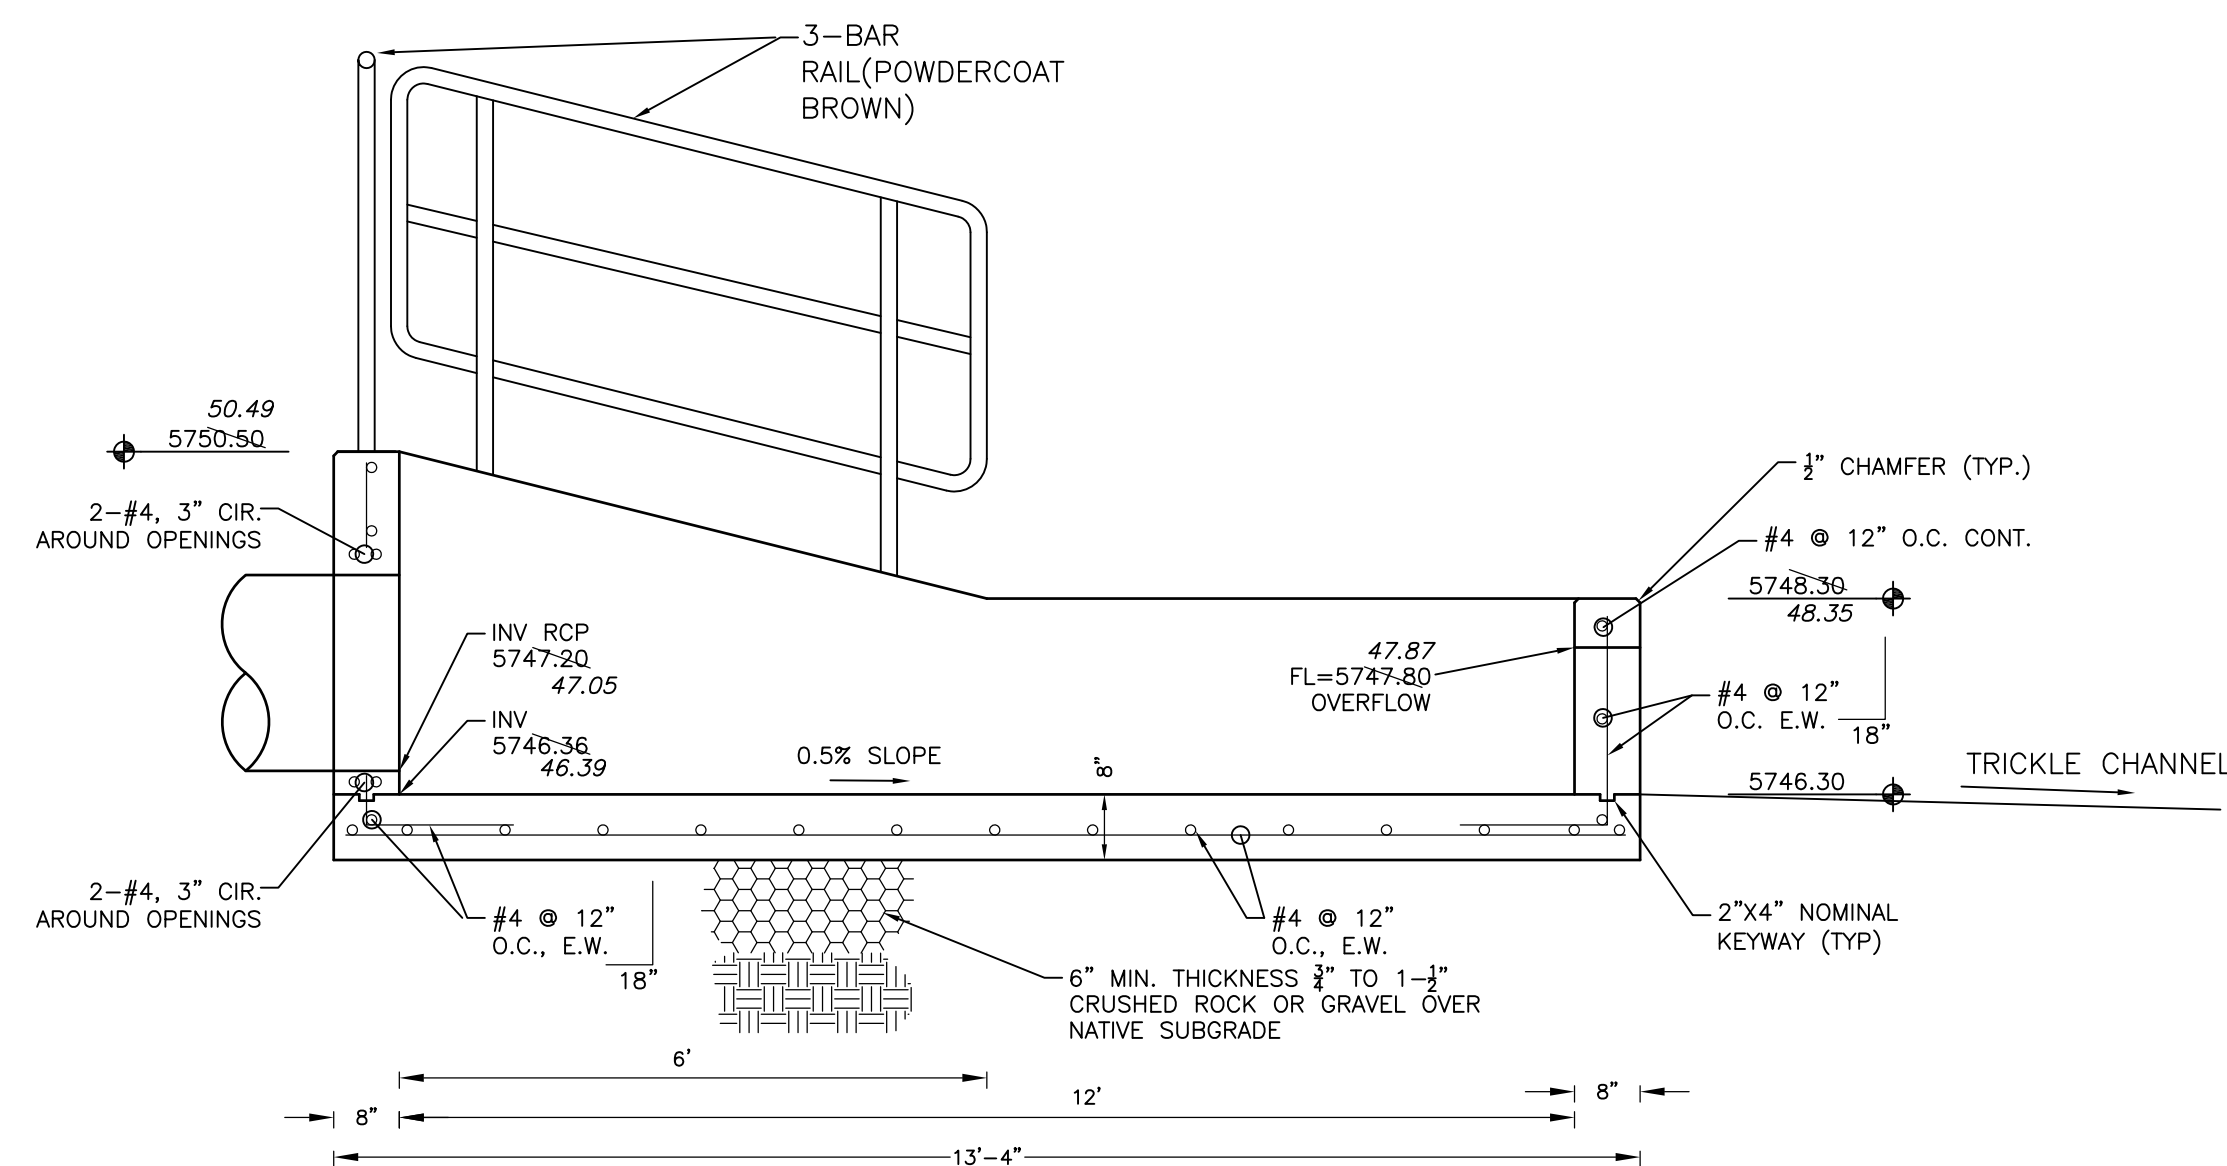


FOREBAY NO. 1 SECTION A-A
NO SCALE

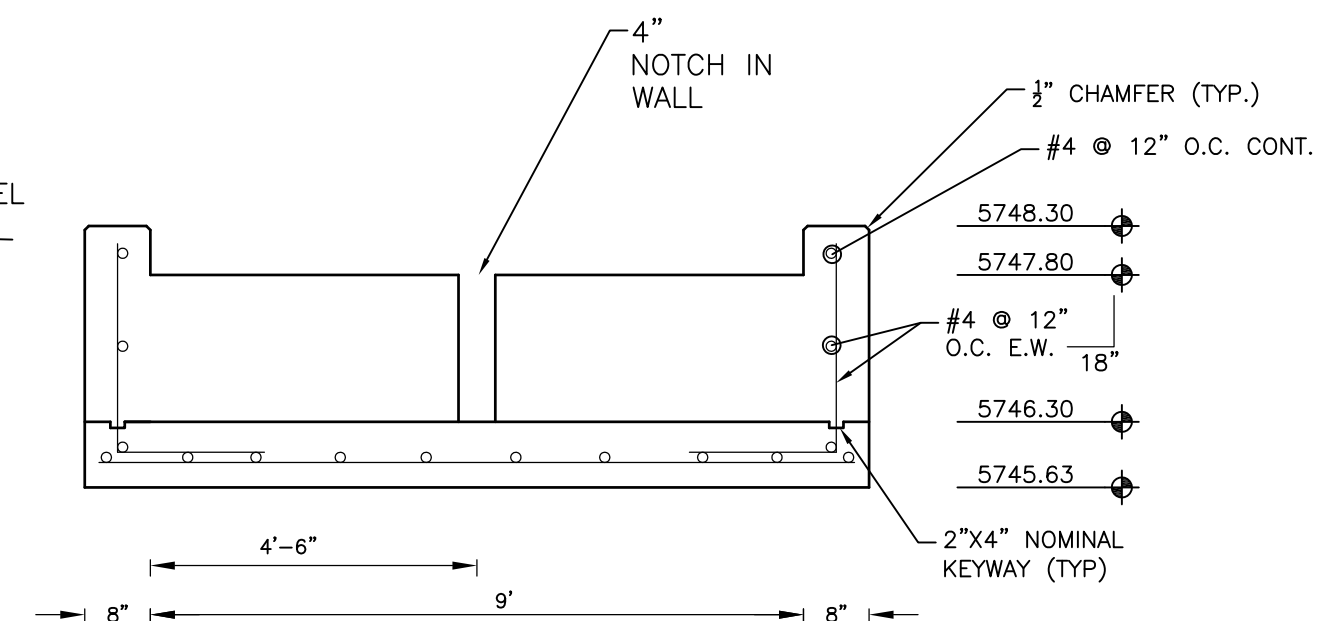

FOREBAY NO. 1 SECTION B-B
NO SCALE

AS-BUILT
DATE: 09/30/2022

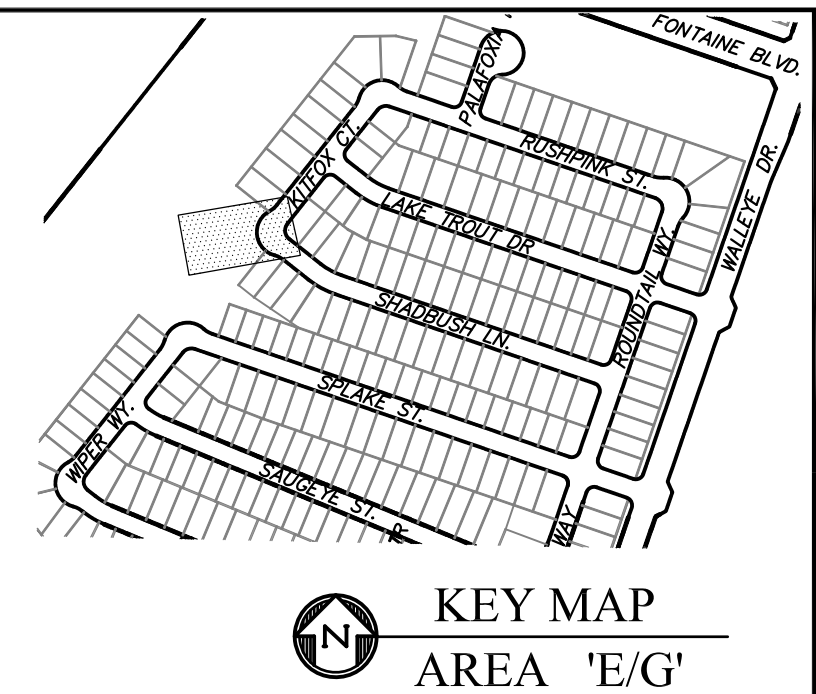

CORE
ENGINEERING GROUP
15004 1ST AVENUE S.
BURNSVILLE, MN 55306
PH: 719.570.1100
CONTACT: RICHARD L. SCHINDLER, P.E.
EMAIL: Rich@ceg1.com

DATE
JAN 14, 2021

PREPARED FOR:

LORSON, LLC


212 N. WAHSATCH AVE, SUITE 301
 COLORADO SPRINGS, COLORADO 80903
 (719) 635-3200
 CONTACT: JEFF MARK

RAISE SITE BY 1' EAST OF POWERLINES	DESK

THE HILLS AT LORSON
RANCH FILING NO. 1
FONTAINE BLVD - WALLEYE DR
COLORADO SPRINGS, COLORADO

DRAWN: RLS
DESIGNED: RLS
CHECKED: RLS

STORM SEWER LATERAL - AREA 'E' / G'
STORM LATERAL E1
STA 0+00 TO 1+90

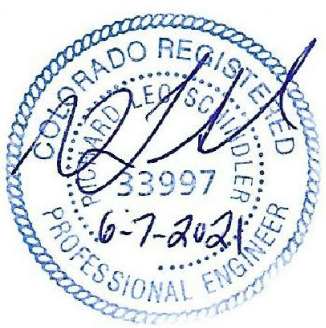

DATE:	JUNE 7, 2021
PROJECT NO.	100.062
SHEET NUMBER	C7.1
TOTAL SHEETS: 42	



SCALE: 1"=5'

NOTE: ALL CONCRETE
FOR FOREBAY SHALL BE
CDOT TYPE D

AS-BUILT
DATE: 09/30/2022

CORE
ENGINEERING GROUP
15004 1ST AVENUE S.
BURNSVILLE, MN 55306
PH: 719.570.1100
CONTACT: RICHARD L. SCHINDLER, P.E.
EMAIL: Rich@cegi.com

PROJECT:	THE HILLS COLLECTOR STREET CONSTRUCTION FOR THE BOWLING GREEN LORSON BLVD.-WALLEY DR.-LAMPREY DR COLORADO SPRINGS, COLORADO	PREPARED FOR:	LORSON, LLC 212 N. W. CHATEAU DRIVE COLORADO SPRINGS, COLORADO 80903 (719) 635-3200 CONTACT: JEFF MARK
----------	---	---------------	--

DRAWN: RLS
DESIGNED: RLS
CHECKED: RLS


POND C1
FOREBAY NO. 2
FOREBAY DETAILS





DATE:
NOV 12, 2020

PROJECT NO.
100.061


SHEET NUMBER
C9.2
TOTAL SHEETS: 58

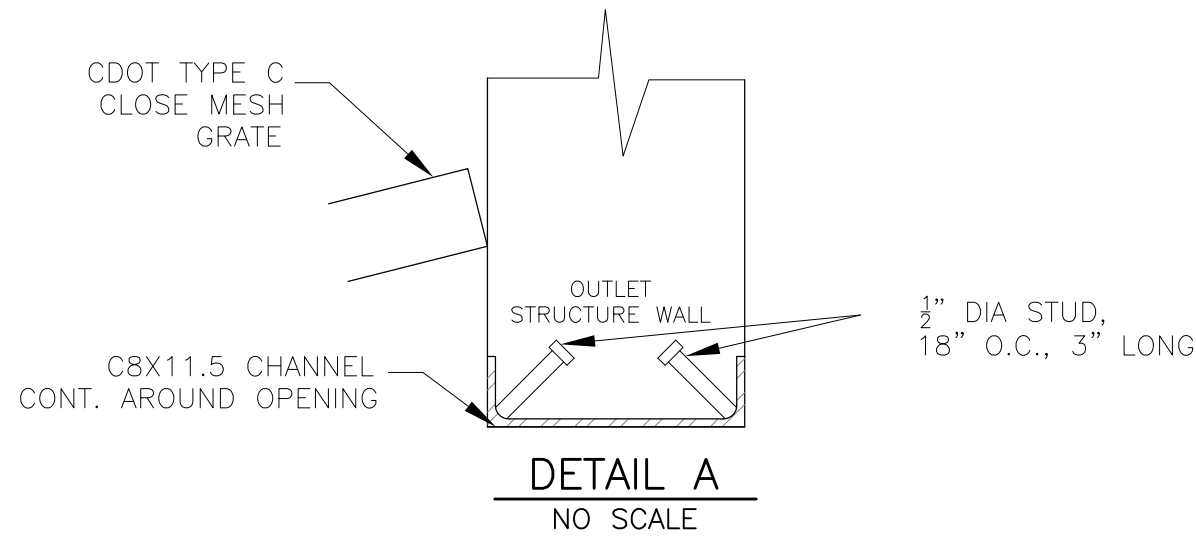


NOTE:
AFTER CONCRETE STRUCTURE HAS BEEN POURED
ALL GRATE DIMENSIONS SHALL BE FIELD VERIFIED
PRIOR TO GRATE CONSTRUCTION

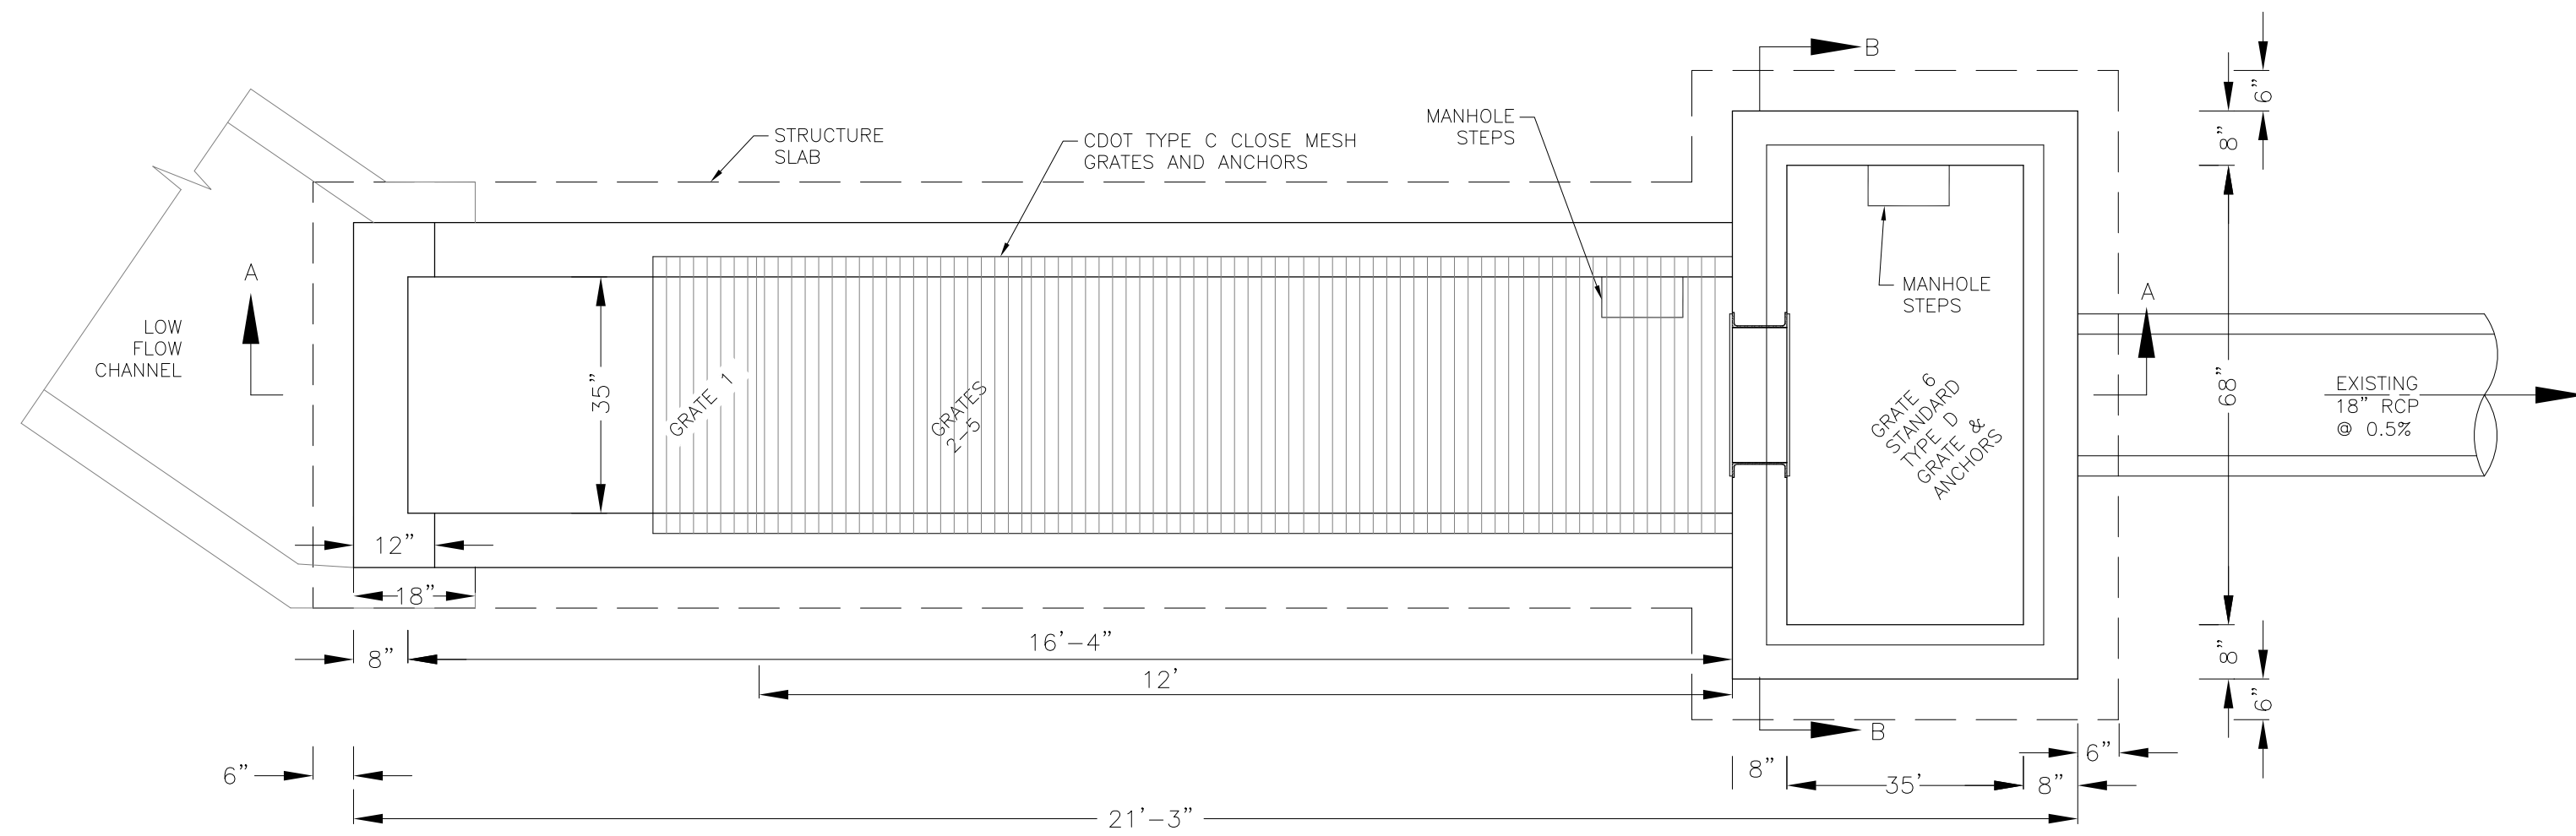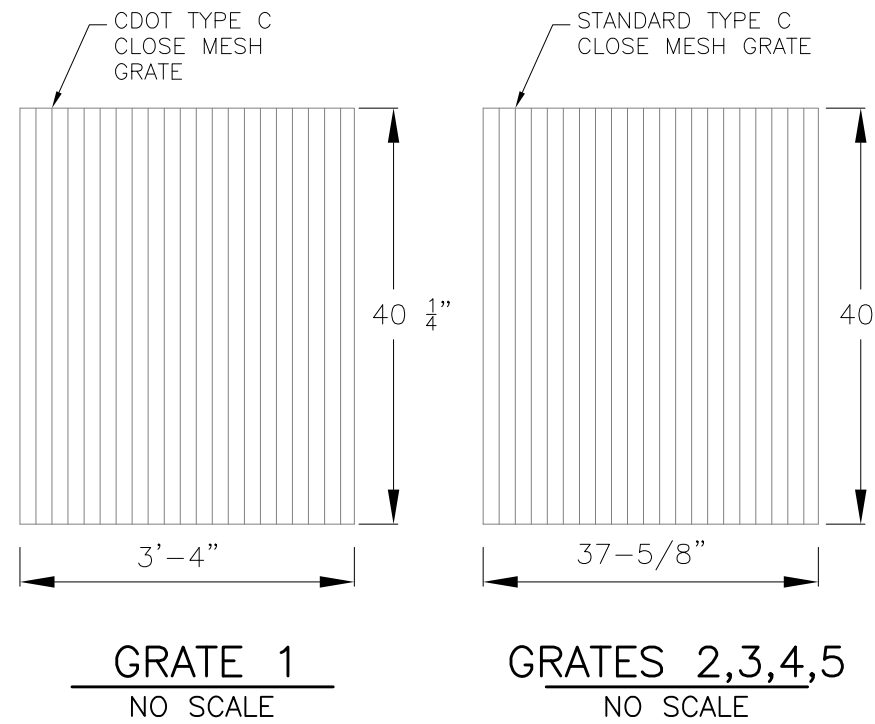


OUTLET STRUCTURE DETAIL - PLAN VIEW
NO SCALE

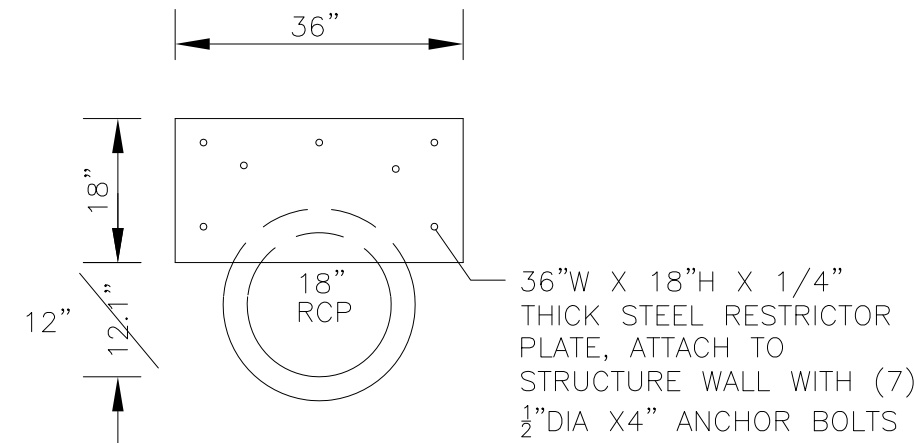



OUTLET RESTRICTOR PLATE
NO SCALE

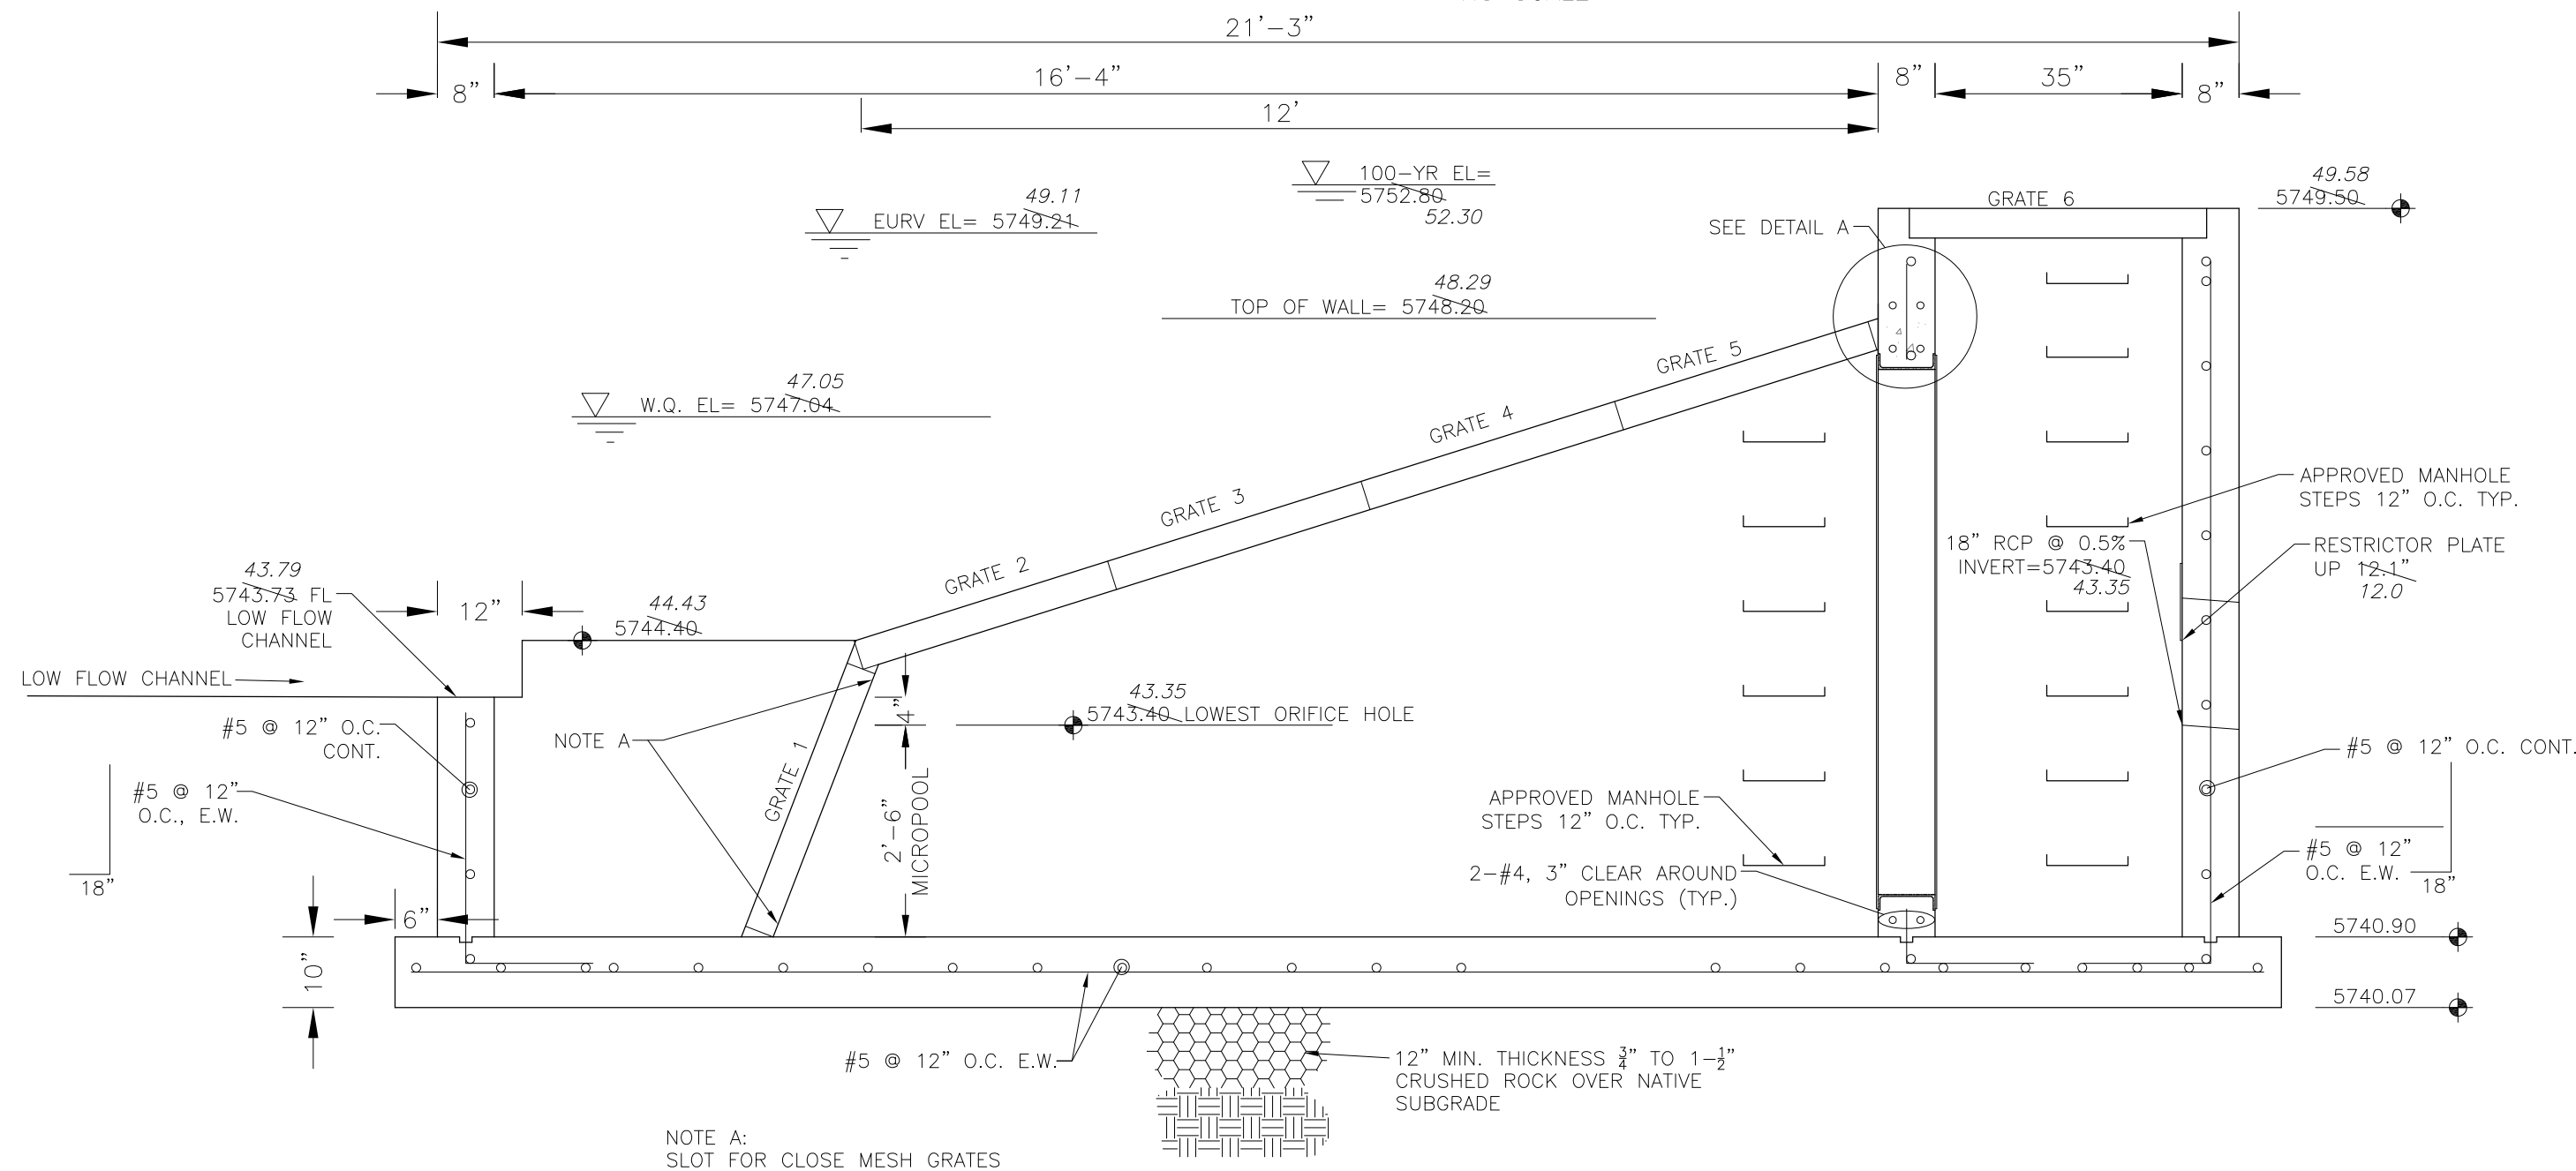

OUTLET STRUCTURE DETAIL - SECTION A-A
NO SCALE

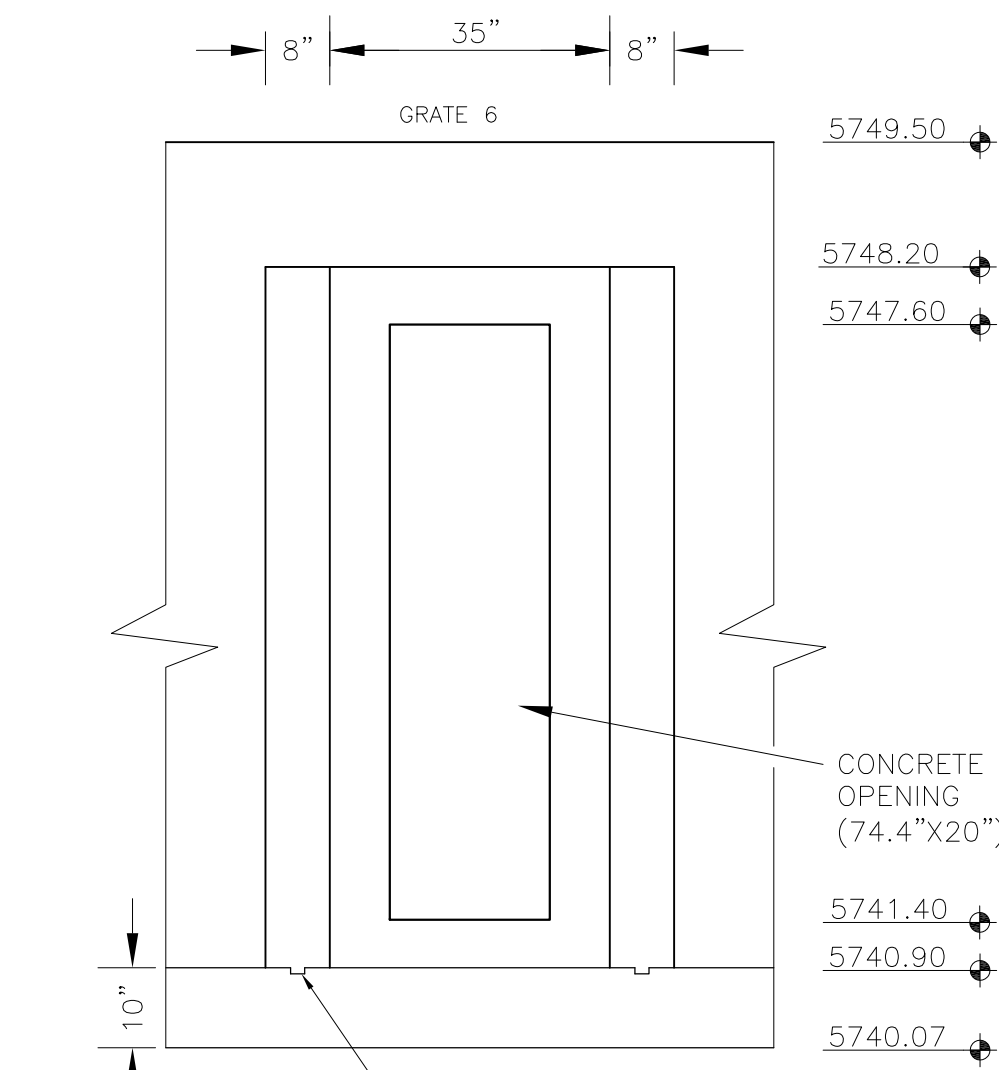

OUTLET STRUCTURE DETAIL - SECTION B-B
NO SCALE

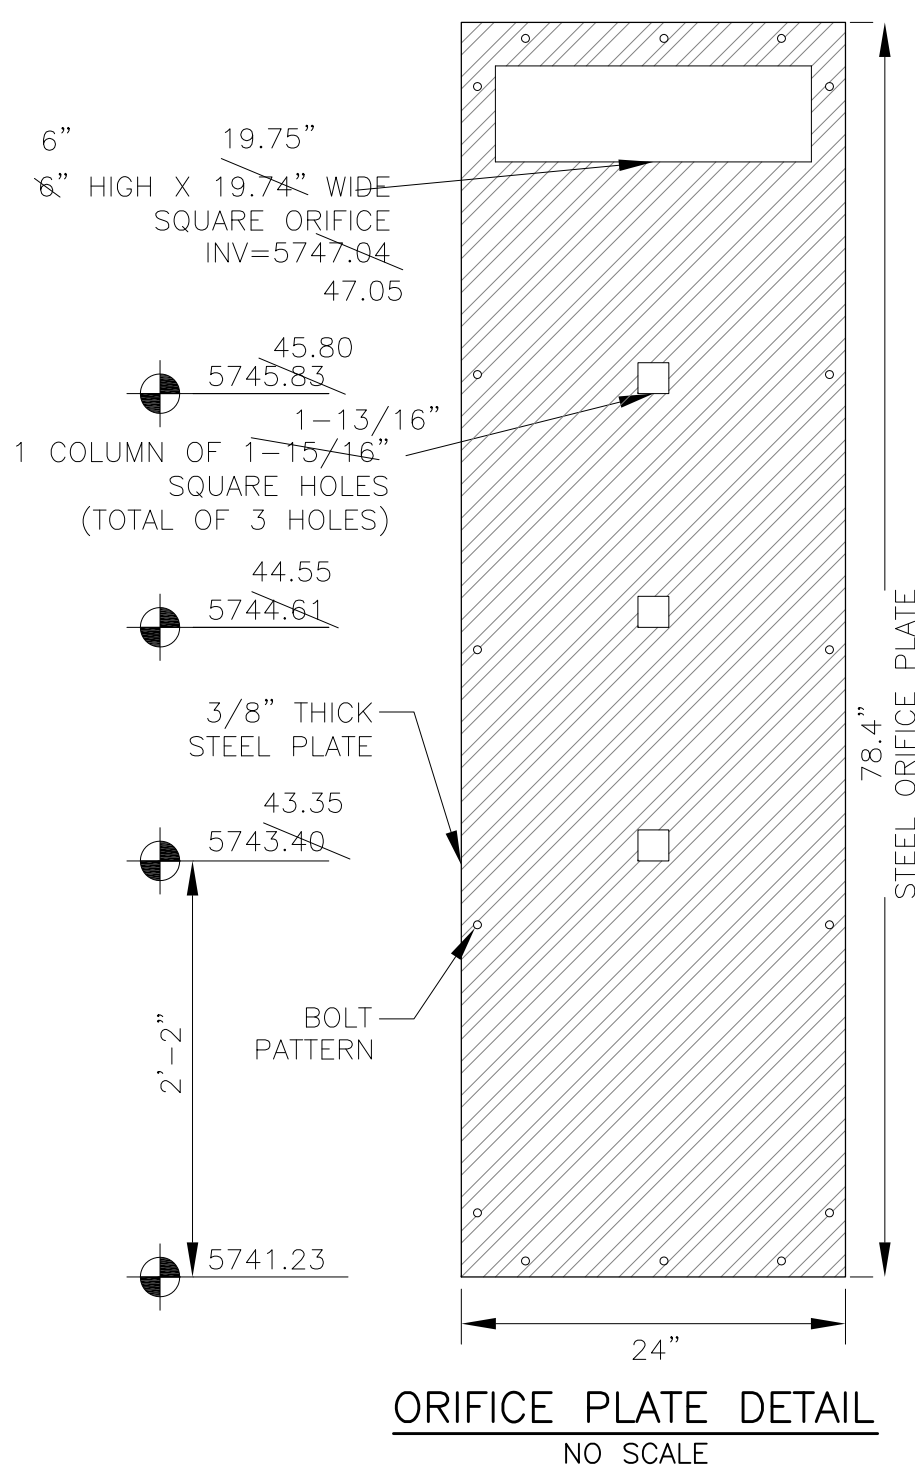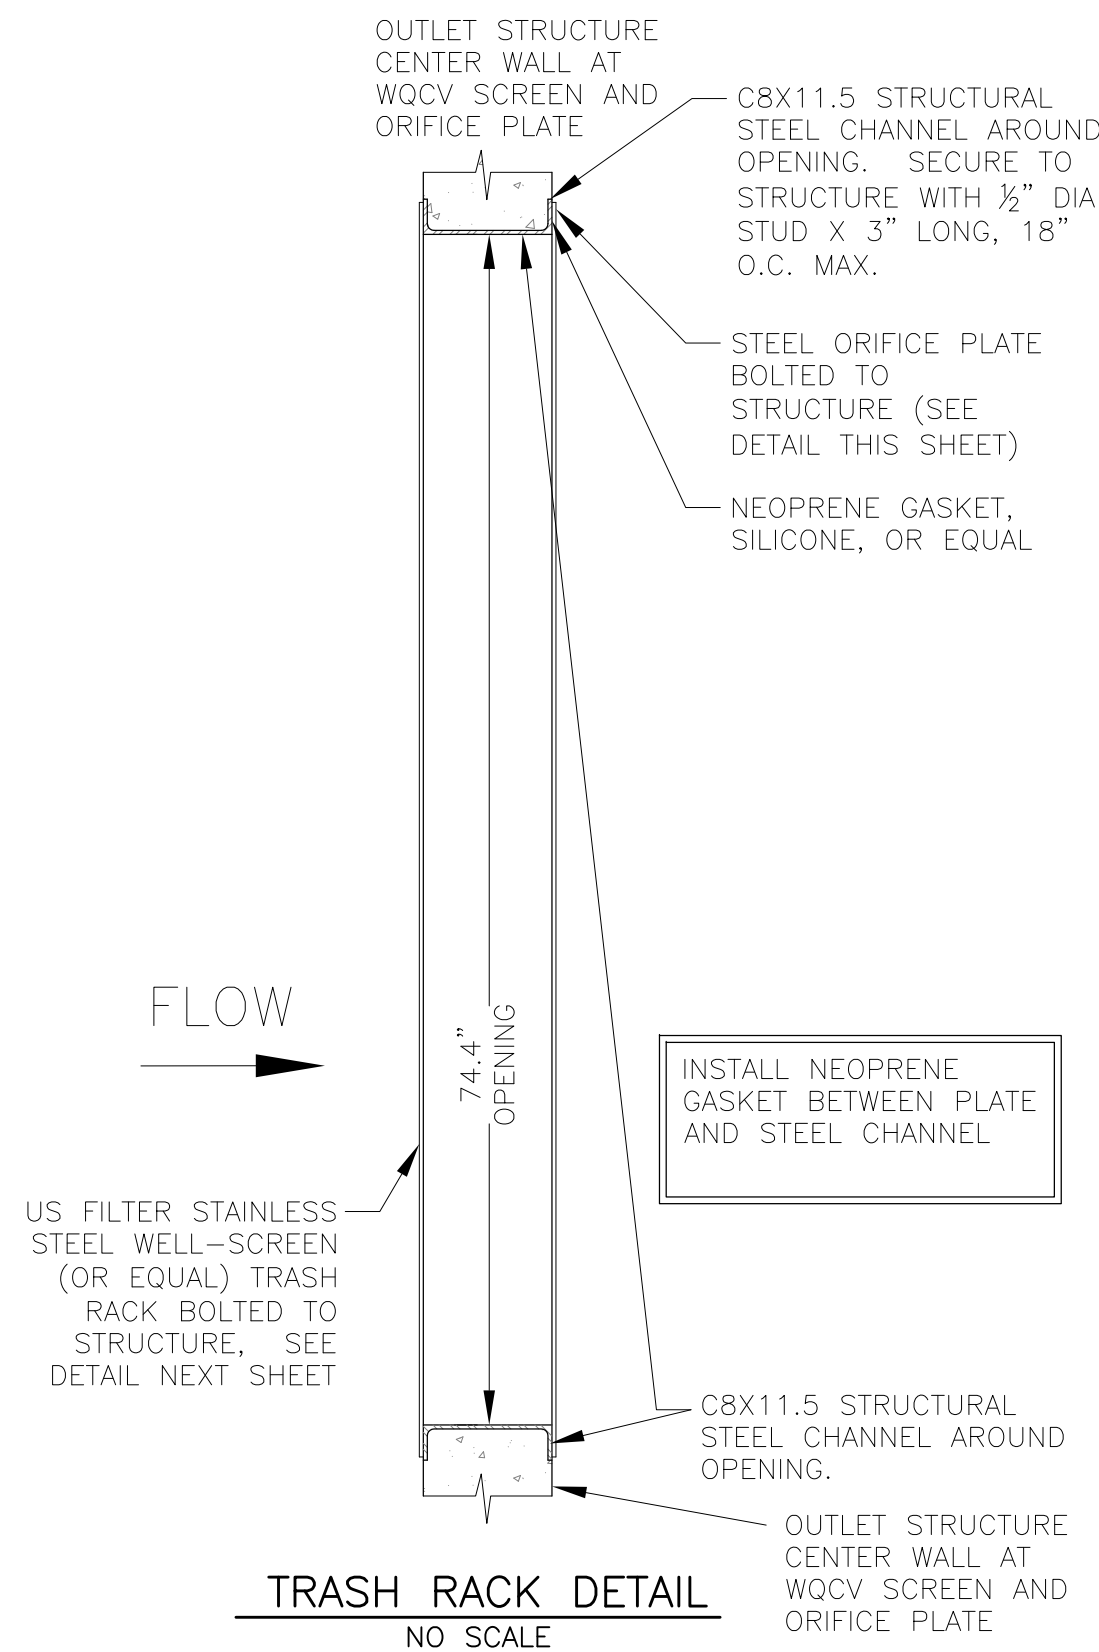

OUTLET STRUCTURE, FOREBAY, AND DRAIN CHANNEL NOTES:


- PRIOR TO CONSTRUCTION, CONTRACTOR SHALL PROVIDE SHOP DRAWINGS FOR ALL COMPONENTS OF THE OUTLET STRUCTURE.
- GRADE 60 REINFORCING STEEL REQUIRED. SEE TABLE FOR THE MINIMUM LAP SPLICE LENGTH FOR REINFORCING BARS. ALL REINFORCING STEEL SHALL HAVE A TWO-INCH MINIMUM CLEARANCE FROM EDGE OF CONCRETE, UNLESS OTHERWISE NOTED.
- CONCRETE FOR THE OUTLET STRUCTURE AND FOREBAY SHALL BE CDOT CLASS D CONCRETE.
- CONCRETE FOR DRAIN CHANNELS SHALL BE CDOT CLASS B CONCRETE
- EXPANSION JOINT MATERIAL SHALL MEET AASHTO SPECIFICATION M-213. EXPANSION JOINT MATERIAL SHALL BE 1/2" THICK, SHALL EXTEND THE FULL DEPTH OF CONTACT SURFACE AND THE JOINT SHALL BE SEALED, REFER TO DETAILS.
- ALL EXPOSED CONCRETE CORNERS SHALL HAVE A 3/8" CHAMFER UNLESS OTHERWISE NOTED.
- SUBGRADE TO BE 12" THICK CLEAN FILL COMPACTED TO 95% STANDARD PROCTOR DENSITY PER ASTM M698 UNDER STRUCTURE.
- REFER TO POND DETAILS FOR PRESEDIMENTATION/FOREBAY DESIGN.
- ENGINEER SHALL BE NOTIFIED PRIOR TO BEGINNING CONSTRUCTION OF OUTLET STRUCTURE TO SCHEDULE OBSERVATION VISITS FOR STRUCTURES.

BAR SIZE	#4	#5	#6
MIN. SPLICE LENGTH	1'-3"	1'-7"	2'-0"

WQCV WELL-SCREEN NOTES:

- Well-Screen shall be stainless steel and attached by stainless steel bolts along edge of the mounting frame.
- WQCV Well Screen
 - Type of Screen: Stainless steel #93 Vee Wire (Johnson Vee Wire (tm) Stainless Steel Screen or equivalent with 60% open area)
 - Screen slot opening dimension: 0.139" (Screen #93 Vee Wire Slot Opening)
 - Type and Size of Support Rod: TE 0.074"x0.50"
 - Spacing of Support Rod (O.C.): 1.0 Inch
 - Total Screen Thickness: 0.655"
 - Carbon Steel Holding Frame Type: 3/4" x 1.0" angle

AS-BUILT
DATE: 09/30/2022

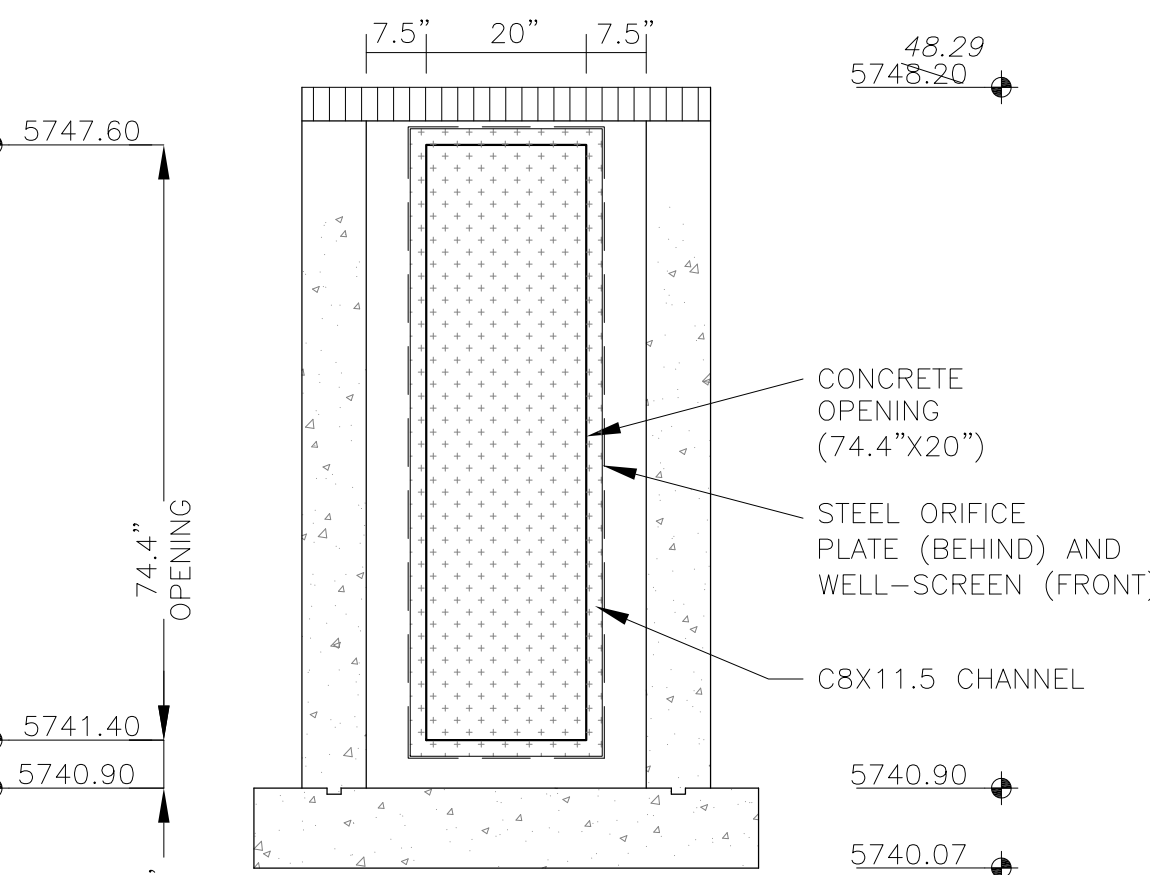

OUTLET STRUCTURE DETAIL - SECTION B-B
NO SCALE


CORE ENGINEERING GROUP 15004 1ST AVENUE S. BURNING WOOD, CO 80903 CONTACT: RICHARD L. SCHINDLER, P.E. EMAIL: Rich@ceg1.com	DATE	
	DESCRIPTION	
	NO.	
	DRAWN: RLS DESIGNED: RLS CHECKED: RLS	
PROJECT: THE HILLS COLLECTOR STREET CONSTRUCTION 212 N. WAHSATCH AVE. SUITE 301 FONTAINE BLVD. - GRAYLING DR LORSON BLVD - VALLEY DR - LAMPREY DR COLORADO SPRINGS, COLORADO 80903 CONTACT: JEFF MARK	PREPARED FOR: LORSON, LLC 212 N. WAHSATCH AVE. SUITE 301 COLORADO SPRINGS, COLORADO 80903 CONTACT: RICH@ceg1.com	
	POND C1 FULL SPECTRUM OUTLET STRUCTURE DETAILS	
	COLORADO REGISTERED PROFESSIONAL ENGINEER No. 33997 Exp. 12-11-2022	
	DATE: NOV 12, 2020	PROJECT NO. 100.061
TOTAL SHEETS: 58		

DETENTION BASIN OUTLET STRUCTURE DESIGN

MHFD-Detention, Version 4.02 (February 2020)

Project: The Hills at Lorson Ranch

Basin ID: Pond C2.1-asbuilt

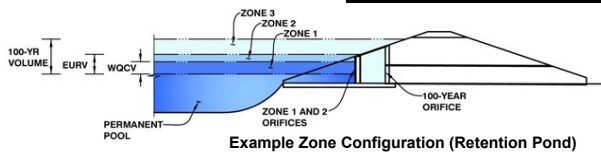

Example Zone Configuration (Retention Pond)

	Estimated Stage (ft)	Estimated Volume (ac-ft)	Outlet Type
Zone 1 (WQCV)	3.32	1.368	Orifice Plate
Zone 2 (EURV)	6.18	3.045	Rectangular Orifice
Zone 3 (100+1/2WQCV)	8.98	3.745	Weir&Pipe (Restrict)
Total (all zones)		8.159	

User Input: Orifice at Underdrain Outlet (typically used to drain WQCV in a Filtration BMP)

Underdrain Orifice Invert Depth = ft (distance below the filtration media surface)

Underdrain Orifice Diameter = inches

Calculated Parameters for Underdrain
Underdrain Orifice Area = ft²
Underdrain Orifice Centroid = feet

User Input: Orifice Plate with one or more orifices or Elliptical Slot Weir (typically used to drain WQCV and/or EURV in a sedimentation BMP)

Invert of Lowest Orifice = ft (relative to basin bottom at Stage = 0 ft)
Depth at top of Zone using Orifice Plate = ft (relative to basin bottom at Stage = 0 ft)
Orifice Plate: Orifice Vertical Spacing = inches
Orifice Plate: Orifice Area per Row = sq. inches (use rectangular openings)

Calculated Parameters for Plate
WQ Orifice Area per Row = ft²
Elliptical Half-Width = feet
Elliptical Slot Centroid = feet
Elliptical Slot Area = ft²

User Input: Stage and Total Area of Each Orifice Row (numbered from lowest to highest)

	Row 1 (required)	Row 2 (optional)	Row 3 (optional)	Row 4 (optional)	Row 5 (optional)	Row 6 (optional)	Row 7 (optional)	Row 8 (optional)
Stage of Orifice Centroid (ft)	0.00	0.95	2.05					
Orifice Area (sq. inches)	4.00	4.00	4.00					

	Row 9 (optional)	Row 10 (optional)	Row 11 (optional)	Row 12 (optional)	Row 13 (optional)	Row 14 (optional)	Row 15 (optional)	Row 16 (optional)
Stage of Orifice Centroid (ft)								
Orifice Area (sq. inches)								

User Input: Vertical Orifice (Circular or Rectangular)

Zone 2 Rectangular ☐ Not Selected ☐
Invert of Vertical Orifice = ft (relative to basin bottom at Stage = 0 ft)
Depth at top of Zone using Vertical Orifice = ft (relative to basin bottom at Stage = 0 ft)
Vertical Orifice Height = inches
Vertical Orifice Width = inches

Calculated Parameters for Vertical Orifice
Zone 2 Rectangular Not Selected
Vertical Orifice Area = ft²
Vertical Orifice Centroid = feet

User Input: Overflow Weir (Dropbox with Flat or Sloped Grate and Outlet Pipe OR Rectangular/Trapezoidal Weir (and No Outlet Pipe).

Zone 3 Weir ☐ Not Selected ☐
Overflow Weir Front Edge Height, H_o = ft (relative to basin bottom at Stage = 0 ft)
Overflow Weir Front Edge Length = feet
Overflow Weir Grate Slope = H:V
Horiz. Length of Weir Sides = feet
Overflow Grate Open Area % =
Debris Clogging % =

Calculated Parameters for Overflow Weir
Zone 3 Weir Not Selected
Height of Grate Upper Edge, H_u = feet
Overflow Weir Slope Length = feet
Grate Open Area / 100-yr Orifice Area =
Overflow Grate Open Area w/o Debris = ft²
Overflow Grate Open Area w/ Debris = ft²

User Input: Outlet Pipe w/ Flow Restriction Plate (Circular Orifice, Restrictor Plate, or Rectangular Orifice)

Zone 3 Restrictor ☐ Not Selected ☐
Depth to Invert of Outlet Pipe = ft (distance below basin bottom at Stage = 0 ft)
Outlet Pipe Diameter = inches
Restrictor Plate Height Above Pipe Invert = inches

Calculated Parameters for Outlet Pipe w/ Flow Restriction Plate
Zone 3 Restrictor Not Selected
Outlet Orifice Area = ft²
Outlet Orifice Centroid = feet
Half-Central Angle of Restrictor Plate on Pipe =

User Input: Emergency Spillway (Rectangular or Trapezoidal)

Spillway Invert Stage = ft (relative to basin bottom at Stage = 0 ft)
Spillway Crest Length = feet
Spillway End Slopes = H:V
Freeboard above Max Water Surface = feet

Calculated Parameters for Spillway
Spillway Design Flow Depth = feet
Stage at Top of Freeboard = feet
Basin Area at Top of Freeboard = acres
Basin Volume at Top of Freeboard = acre-ft

top micropool = 5761.15 = stage 0


Routed Hydrograph Results

The user can override the default CUHP hydrographs and runoff volumes by entering new values in the Inflow Hydrographs table (Columns W through AF)

	WQCV	EURV	2 Year	5 Year	10 Year	25 Year	50 Year	100 Year
Design Storm Return Period	N/A	N/A	1.19	1.50	1.75	2.00	2.25	2.52
One-Hour Rainfall Depth (in)	N/A	N/A	1.368	4.414	4.152	5.828	7.285	9.182
CUHP Runoff Volume (acre-ft)	N/A	N/A	4.152	5.828	7.285	9.182	10.750	12.716
Inflow Hydrograph Volume (acre-ft)	N/A	N/A	4.152	5.828	7.285	9.182	10.750	12.716
CUHP Predevelopment Peak Q (cfs)	N/A	N/A	7.5	21.2	32.2	57.6	72.4	92.1
OPTIONAL Override Predevelopment Peak Q (cfs)	N/A	N/A						
Predevelopment Unit Peak Flow, q (cfs/acre)	N/A	N/A	0.10	0.28	0.43	0.77	0.97	1.24
Peak Inflow Q (cfs)	N/A	N/A	63.8	91.4	112.2	146.0	171.6	201.7
Peak Outflow Q (cfs)	N/A	N/A	6.3	4.9	32.2	59.3	62.0	66.3
Ratio Peak Outflow to Predevelopment Q	N/A	N/A	N/A	0.6	1.0	1.0	0.9	0.7
Structure Controlling Flow	Vertical Orifice 1	Overflow Weir 1	Vertical Orifice 1	Overflow Weir 1	Overflow Weir 1	Outlet Plate 1	Outlet Plate 1	Outlet Plate 1
Max Velocity through Gate 1 (fps)	N/A	0.03	N/A	0.2	0.8	1.6	1.6	1.7
Max Velocity through Gate 2 (fps)	N/A	N/A	N/A	N/A	N/A	N/A	N/A	N/A
Time to Drain 97% of Inflow Volume (hours)	38	46	46	46	45	42	41	38
Time to Drain 99% of Inflow Volume (hours)	40	50	51	52	51	50	49	49
Maximum Ponding Depth (ft)	3.32	6.18	5.40	6.36	6.68	7.12	7.70	8.69
Area at Maximum Ponding Depth (acres)	0.93	1.20	1.13	1.22	1.25	1.29	1.34	1.44
Maximum Volume Stored (acre-ft)	1.369	4.424	3.503	4.642	5.025	5.583	6.347	7.726




MHFD-Detention, Version 4.02 (February 2020)

Basin ID: Pond C2.1-asbuilt



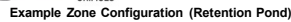


Depth Increment =	0.20	f
-------------------	------	---


4/24/2023, 8:50 AM

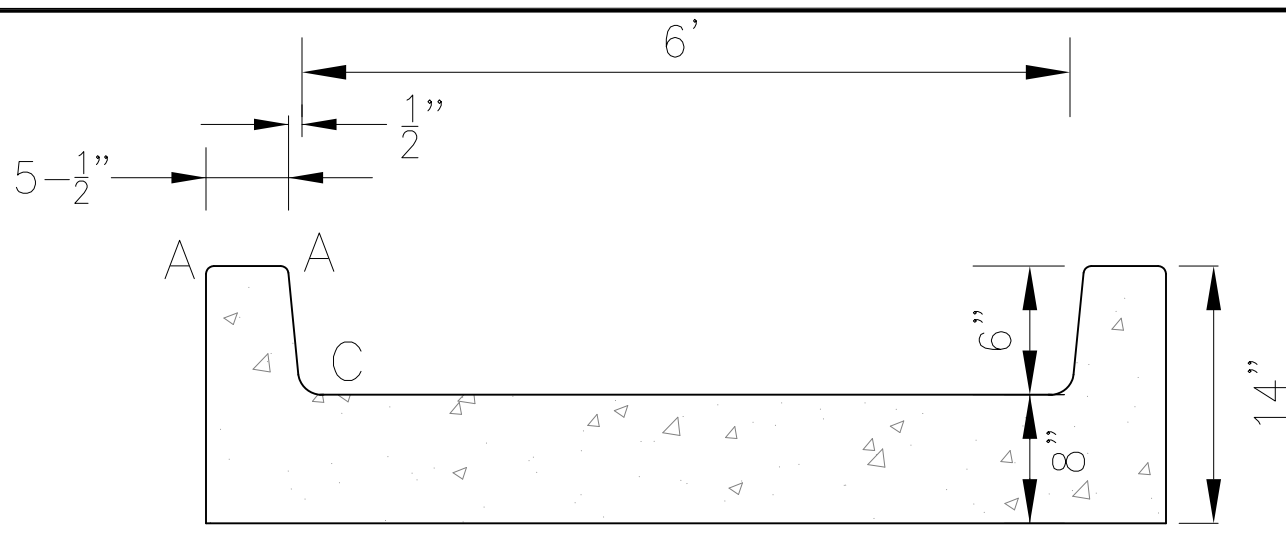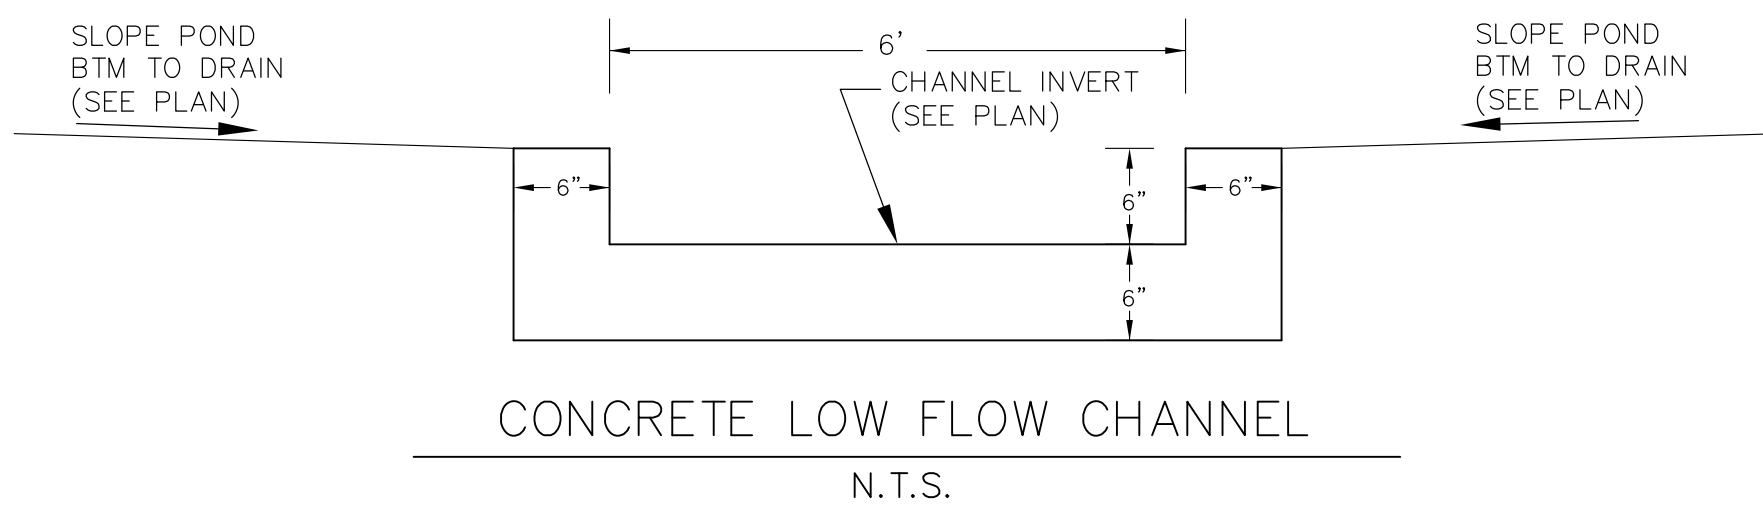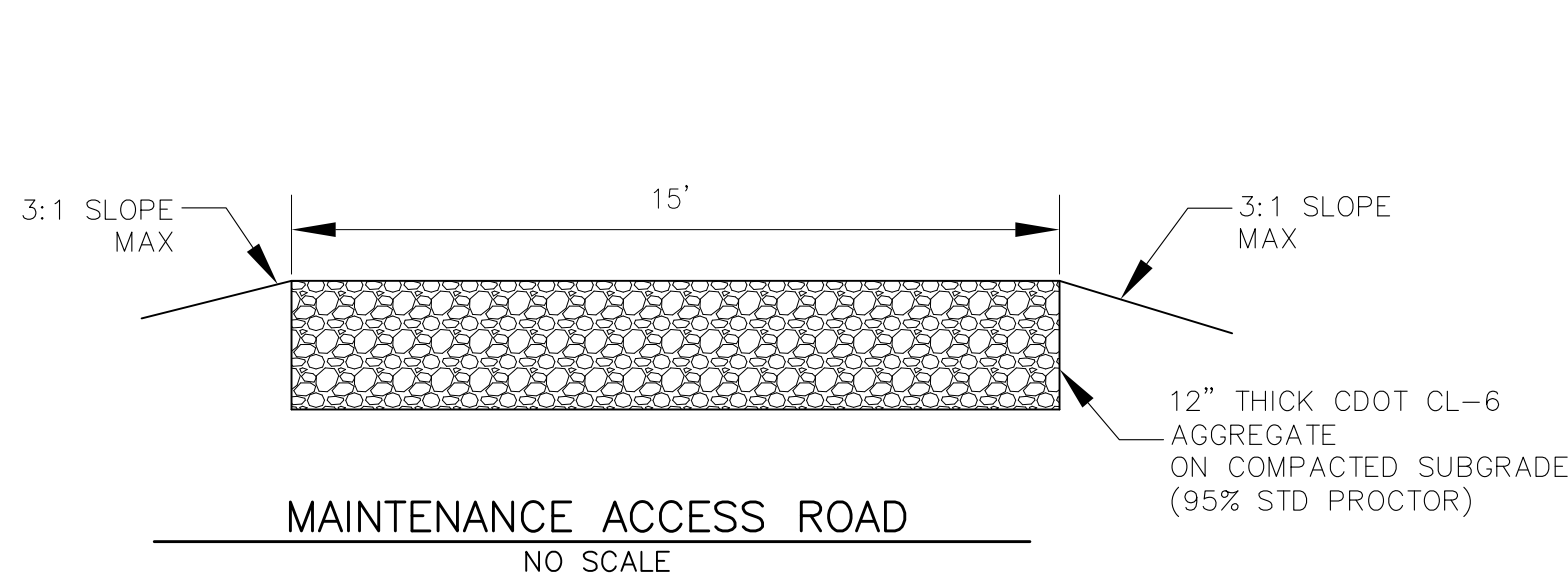

POND C2.1 IS LOCATED IN TRACT G, THE HILLS AT LORSON RANCH FILING NO. 1. SEE MAINTENANCE AGREEMENT AT REC. NO. 220211669

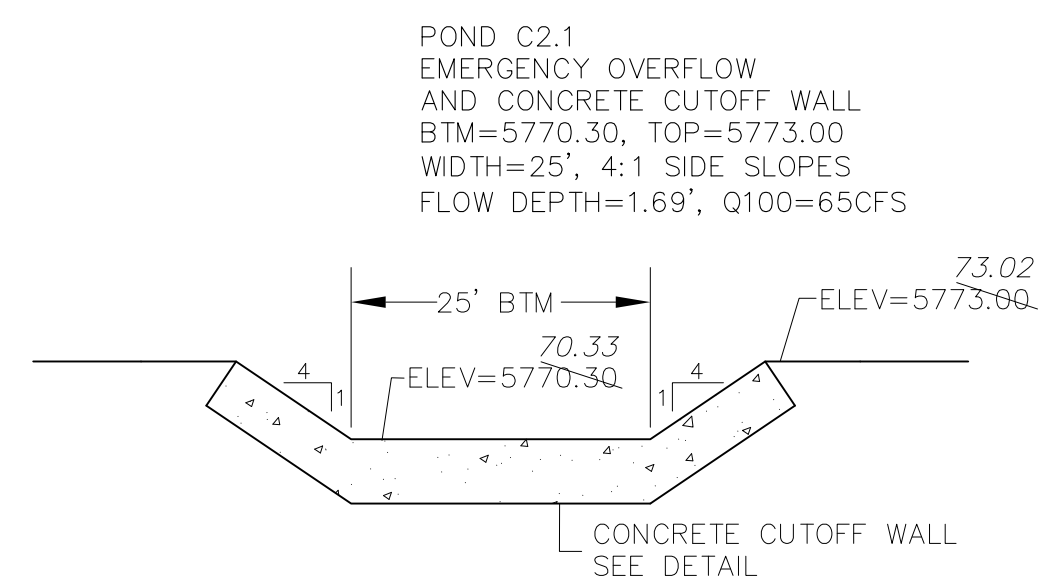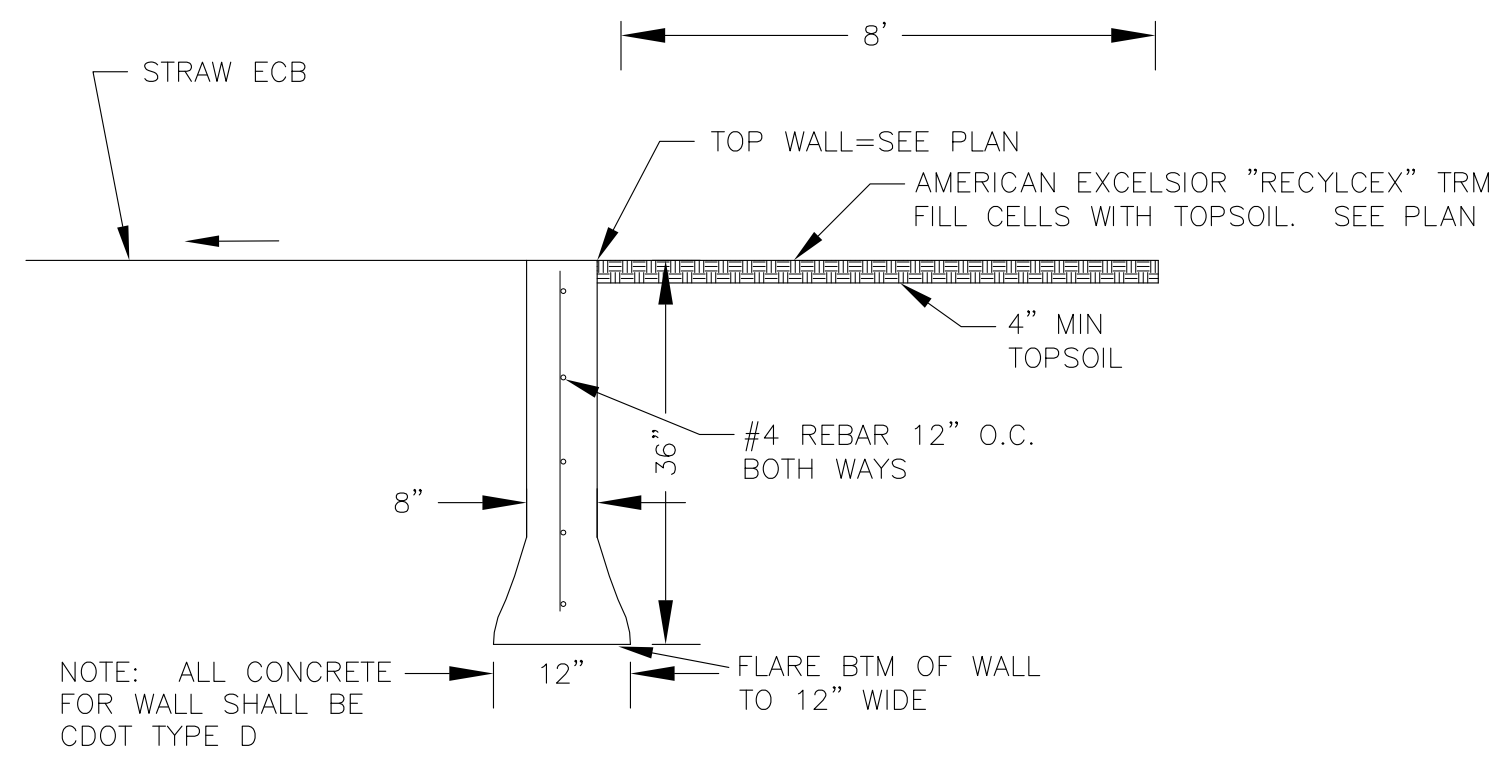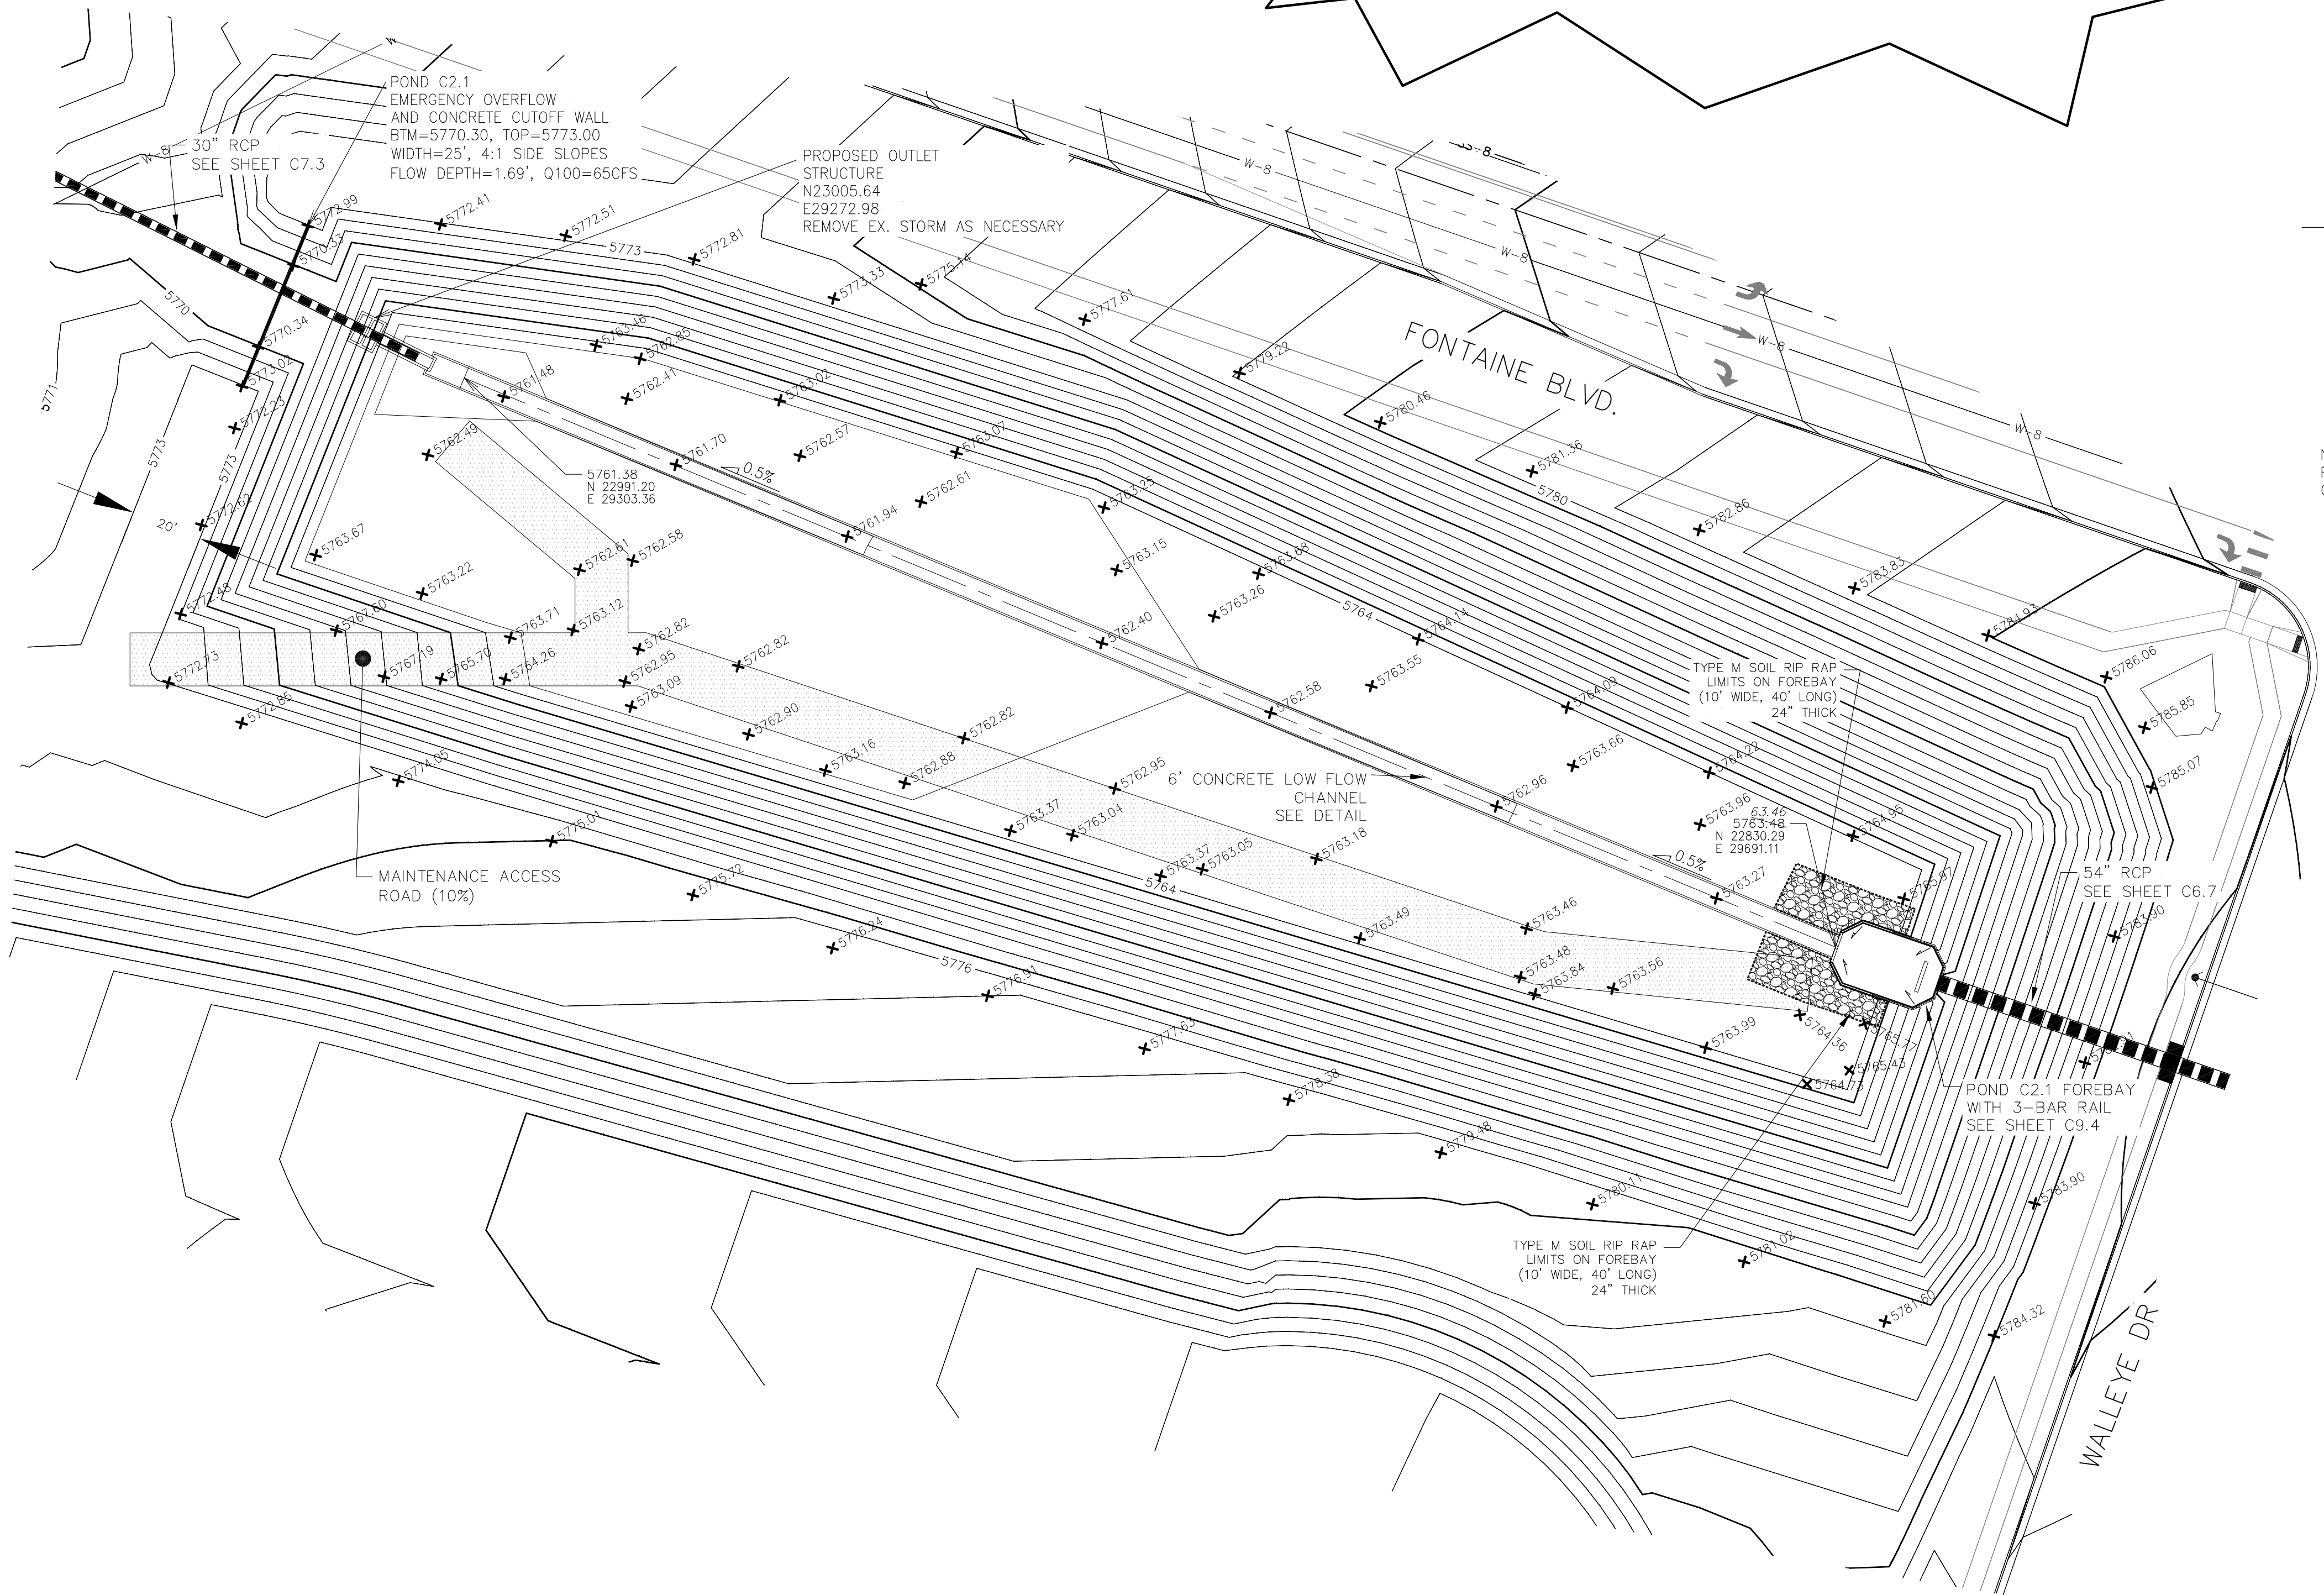

AS-BUILT
DATE: 09/30/2022

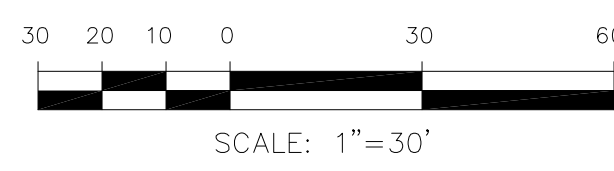

CORE
ENGINEERING GROUP
15004 1ST AVENUE S.
BURNING WOOD, CO 80903
CONTACT: RICHARD L. SCHINDLER, P.E.
EMAIL: Rich@ceg1.com

DATE: JAN 12, 2021

PROJECT NO. 100.061

PROJECT: THE HILLS COLLECTOR STREET CONSTRUCTION
212 N. WAHSAATCH AVE. SUITE 301
COLORADO SPRINGS, COLORADO 80903
CONTACT: JEFF MARK

NOV 12, 2020


PROJECT NO. 100.061

SHEET NUMBER C9.3

TOTAL SHEETS: 58



NOTE: ALL CONCRETE
FOR FOREBAY SHALL BE
CDOT TYPE D

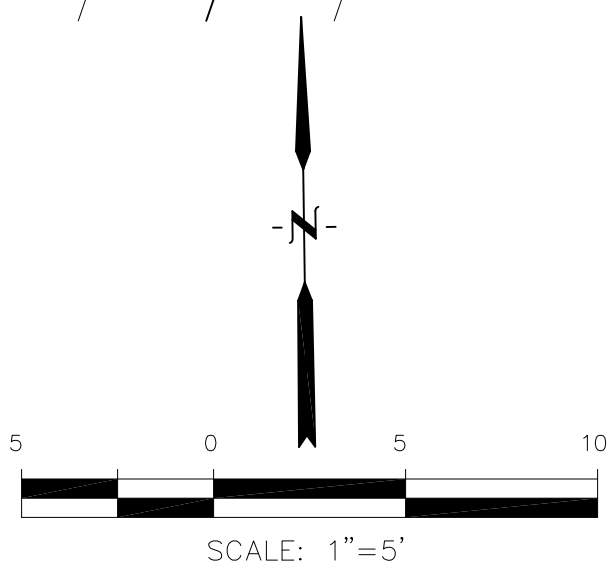

POINT TABLE (FOREBAY)				
NUMBER	NORTHING	EASTING	ELEVATION	NOTES
1	22830.08	29691.75	5763.50	FOREBAY BOTTOM
2	22820.31	29720.11	5763.65	FOREBAY BOTTOM, INV 54"=5764.50



PREPARED FOR:
LORSON, LLC
212 N. WAHSATCH AVE., SUITE 301
COLORADO SPRINGS, COLORADO 80903
(719) 635-3200
CONTACT: JEFF MARK

PROJECT: THE HILLS COLLECTOR
STREET CONSTRUCTION
FONTAINE BLVD – GRAYLING DR
LORSON BLVD-WALLEYE DR-LAMPREY DR
COLORADO SPRINGS, COLORADO

DRAWN: RLS
DESIGNED: RLS
CHECKED: RLS

DRAWN: RLS
DESIGNED: RLS
CHECKED: RLS

DRAWN: RLS
DESIGNED: RLS
CHECKED: RLS

POND C2.1

FOREBAY DETAILS



DATE: V 12, 2020

PROJECT NO.


100.06

SHEET NUMBER







C94

AS-BUILT

DATE: 09/30/2022

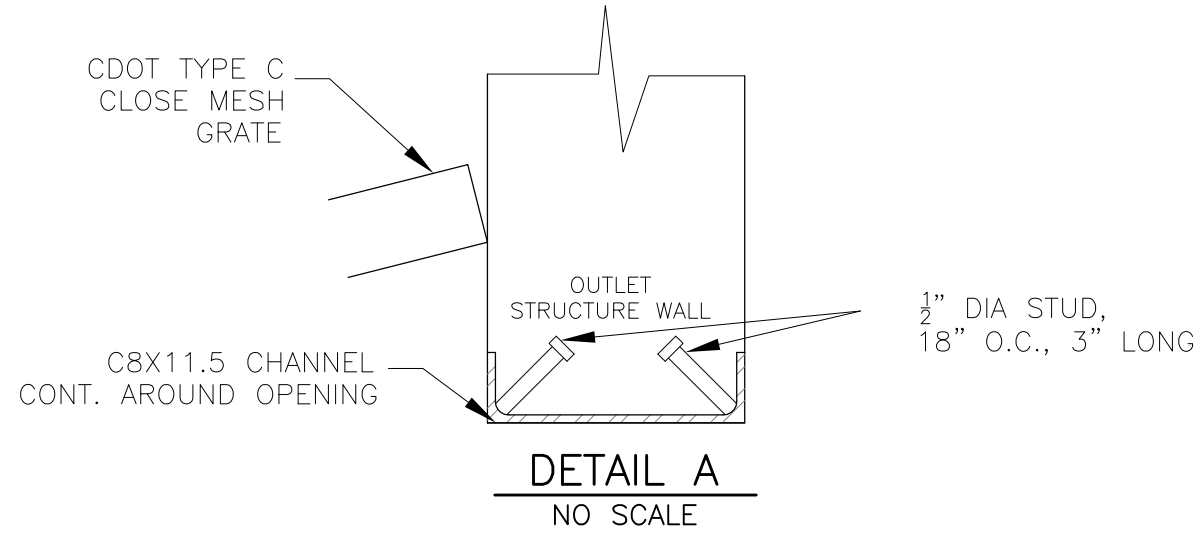

NOTE:
AFTER CONCRETE STRUCTURE HAS BEEN POURED
ALL GRATE DIMENSIONS SHALL BE FIELD VERIFIED
PRIOR TO GRATE CONSTRUCTION

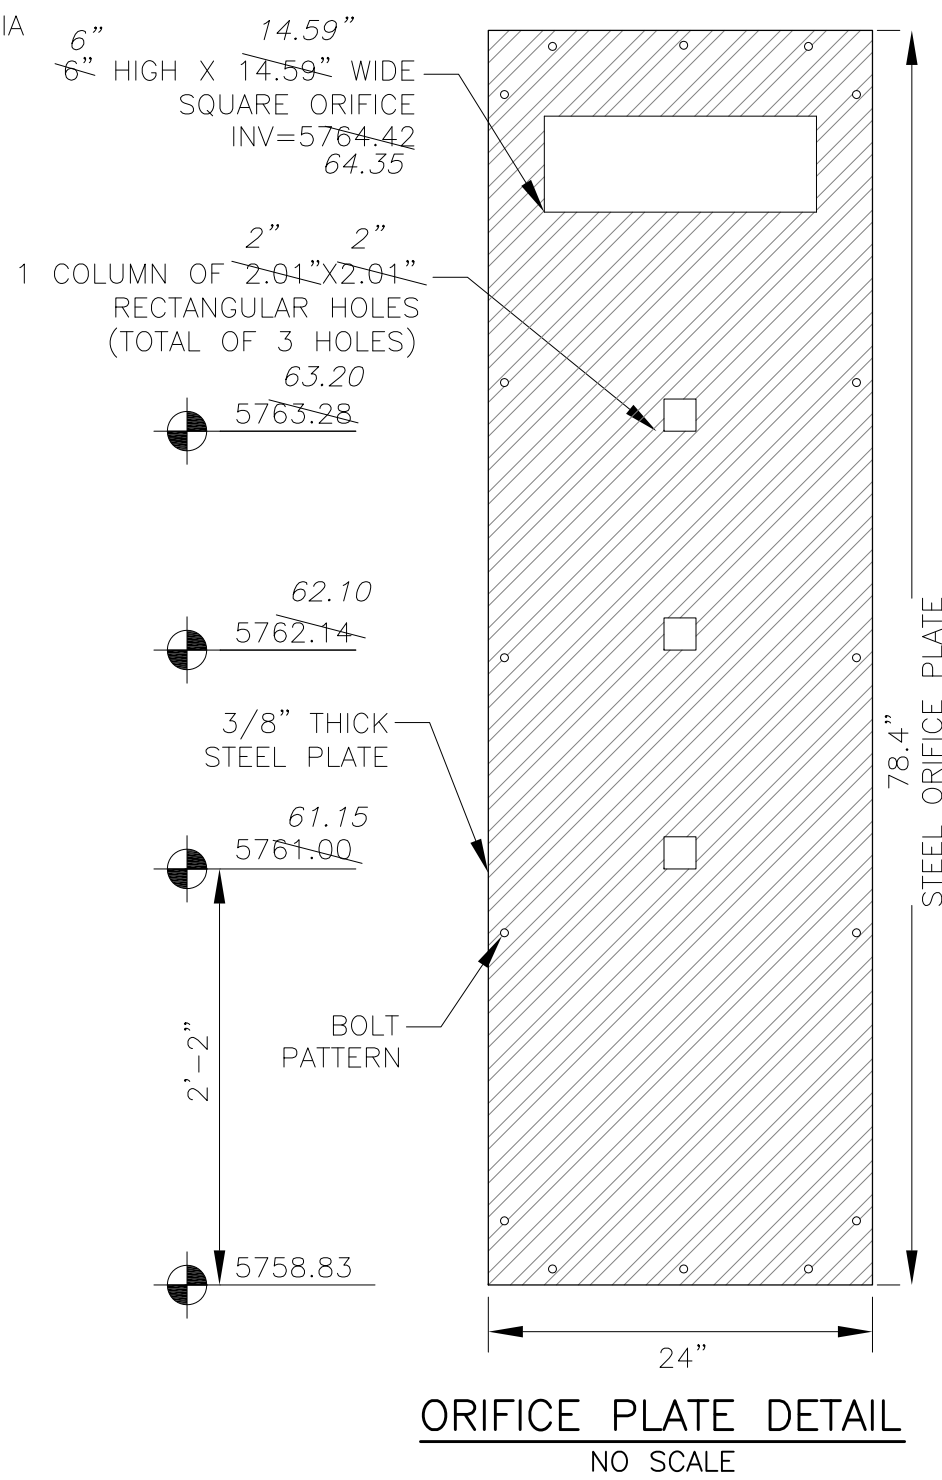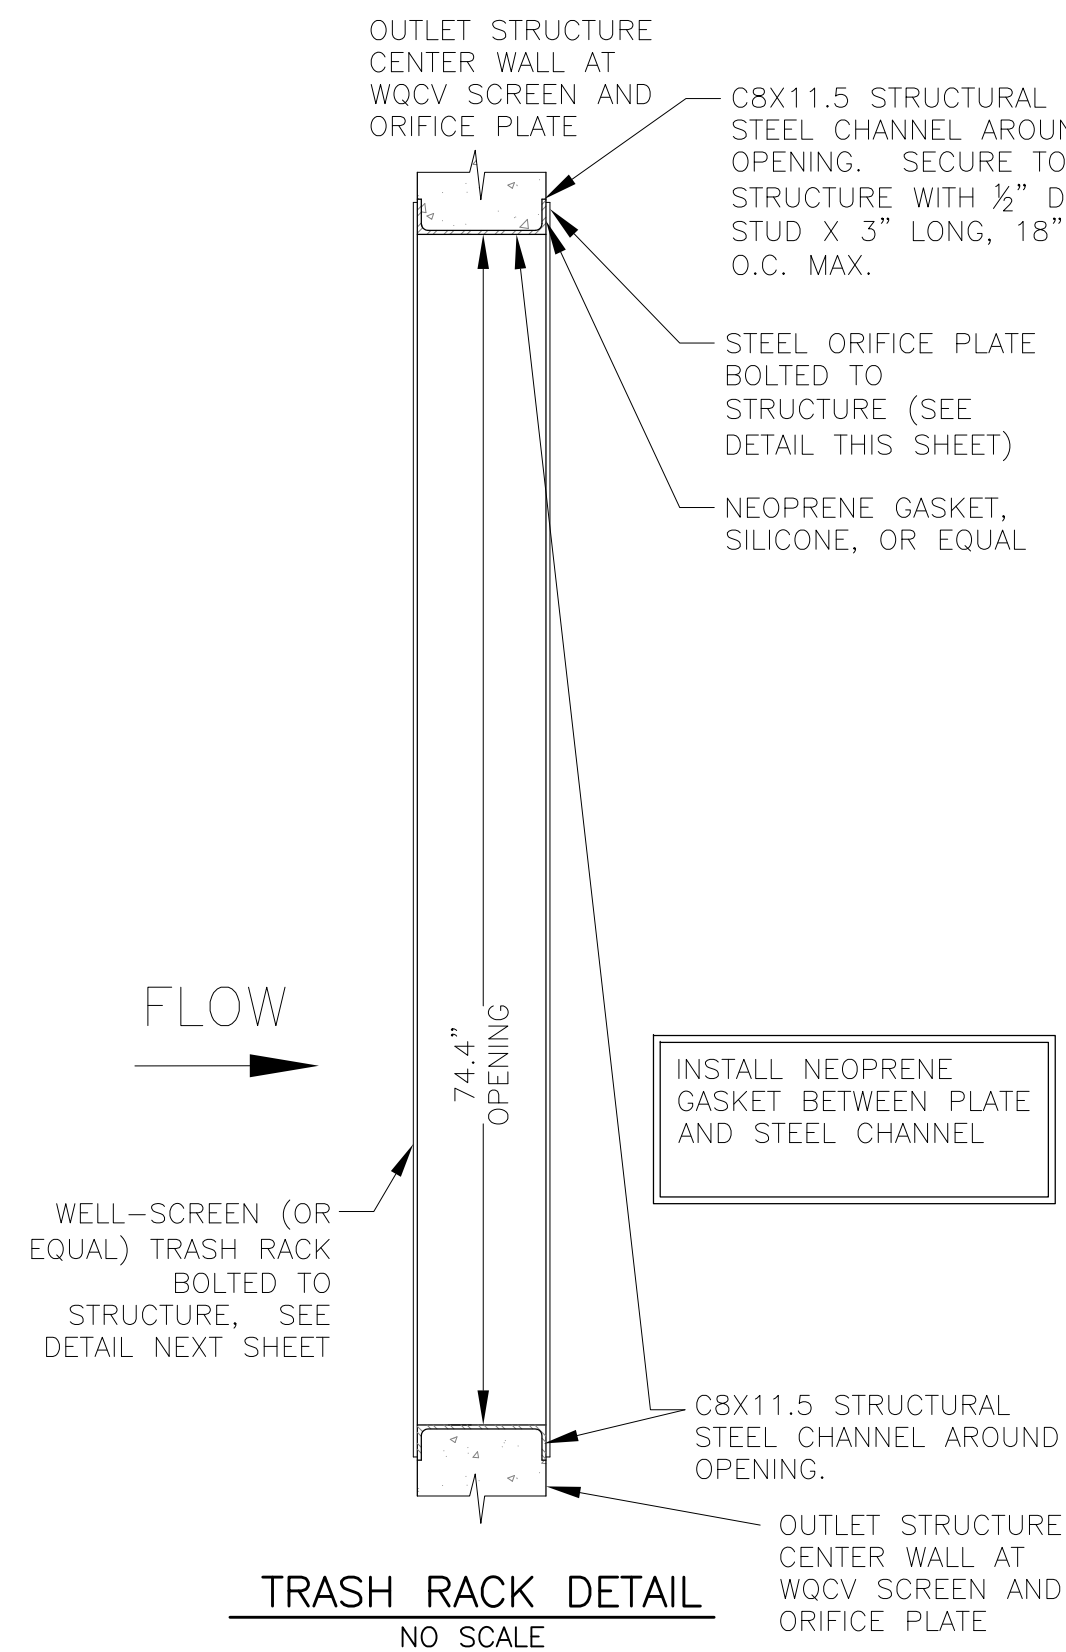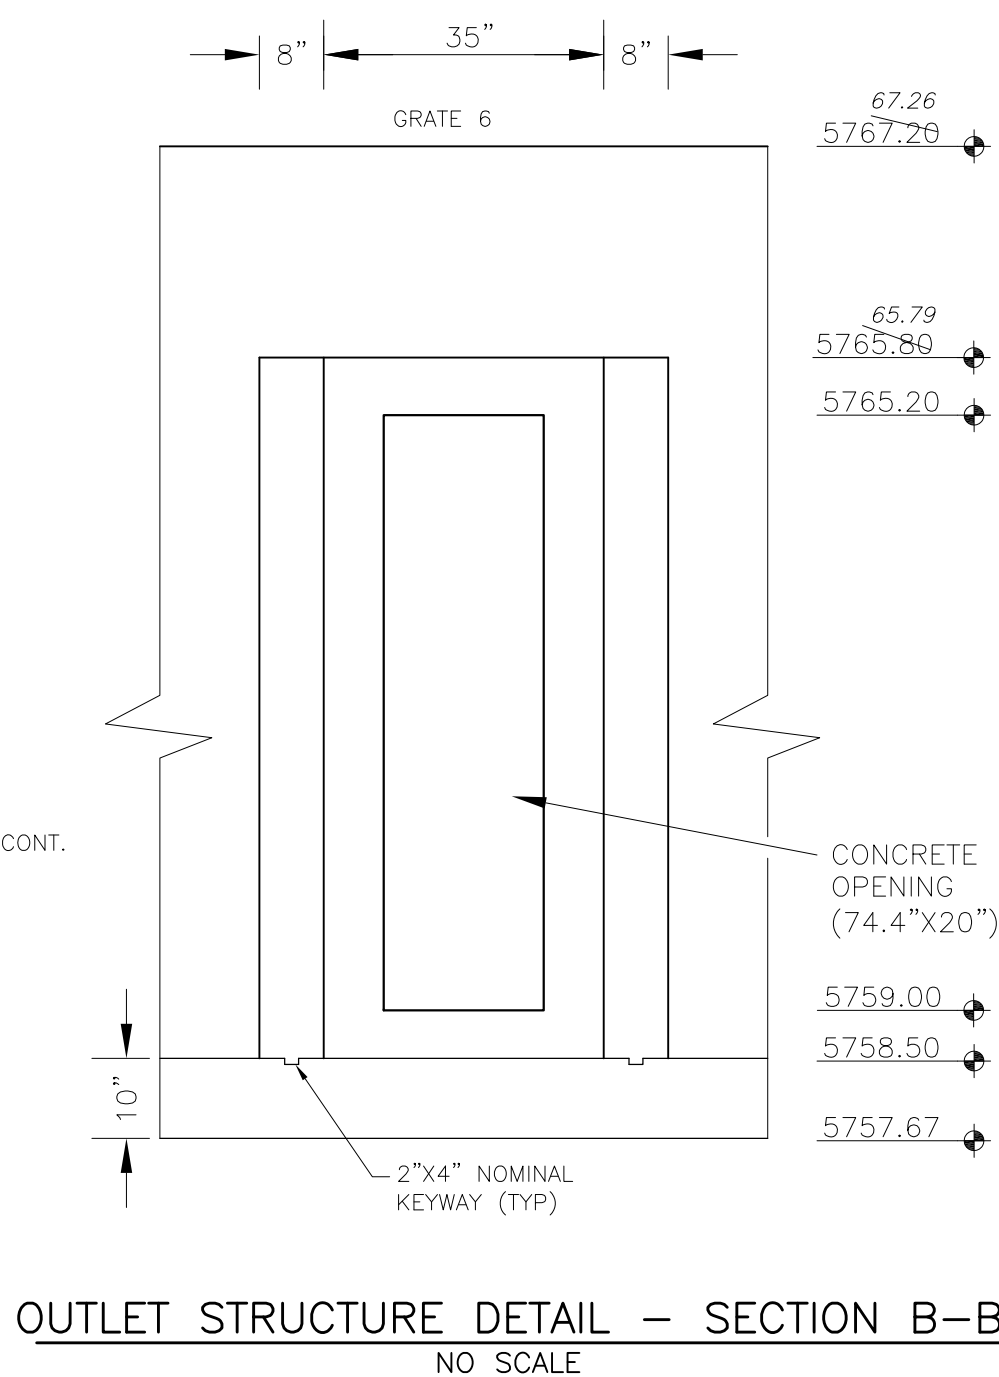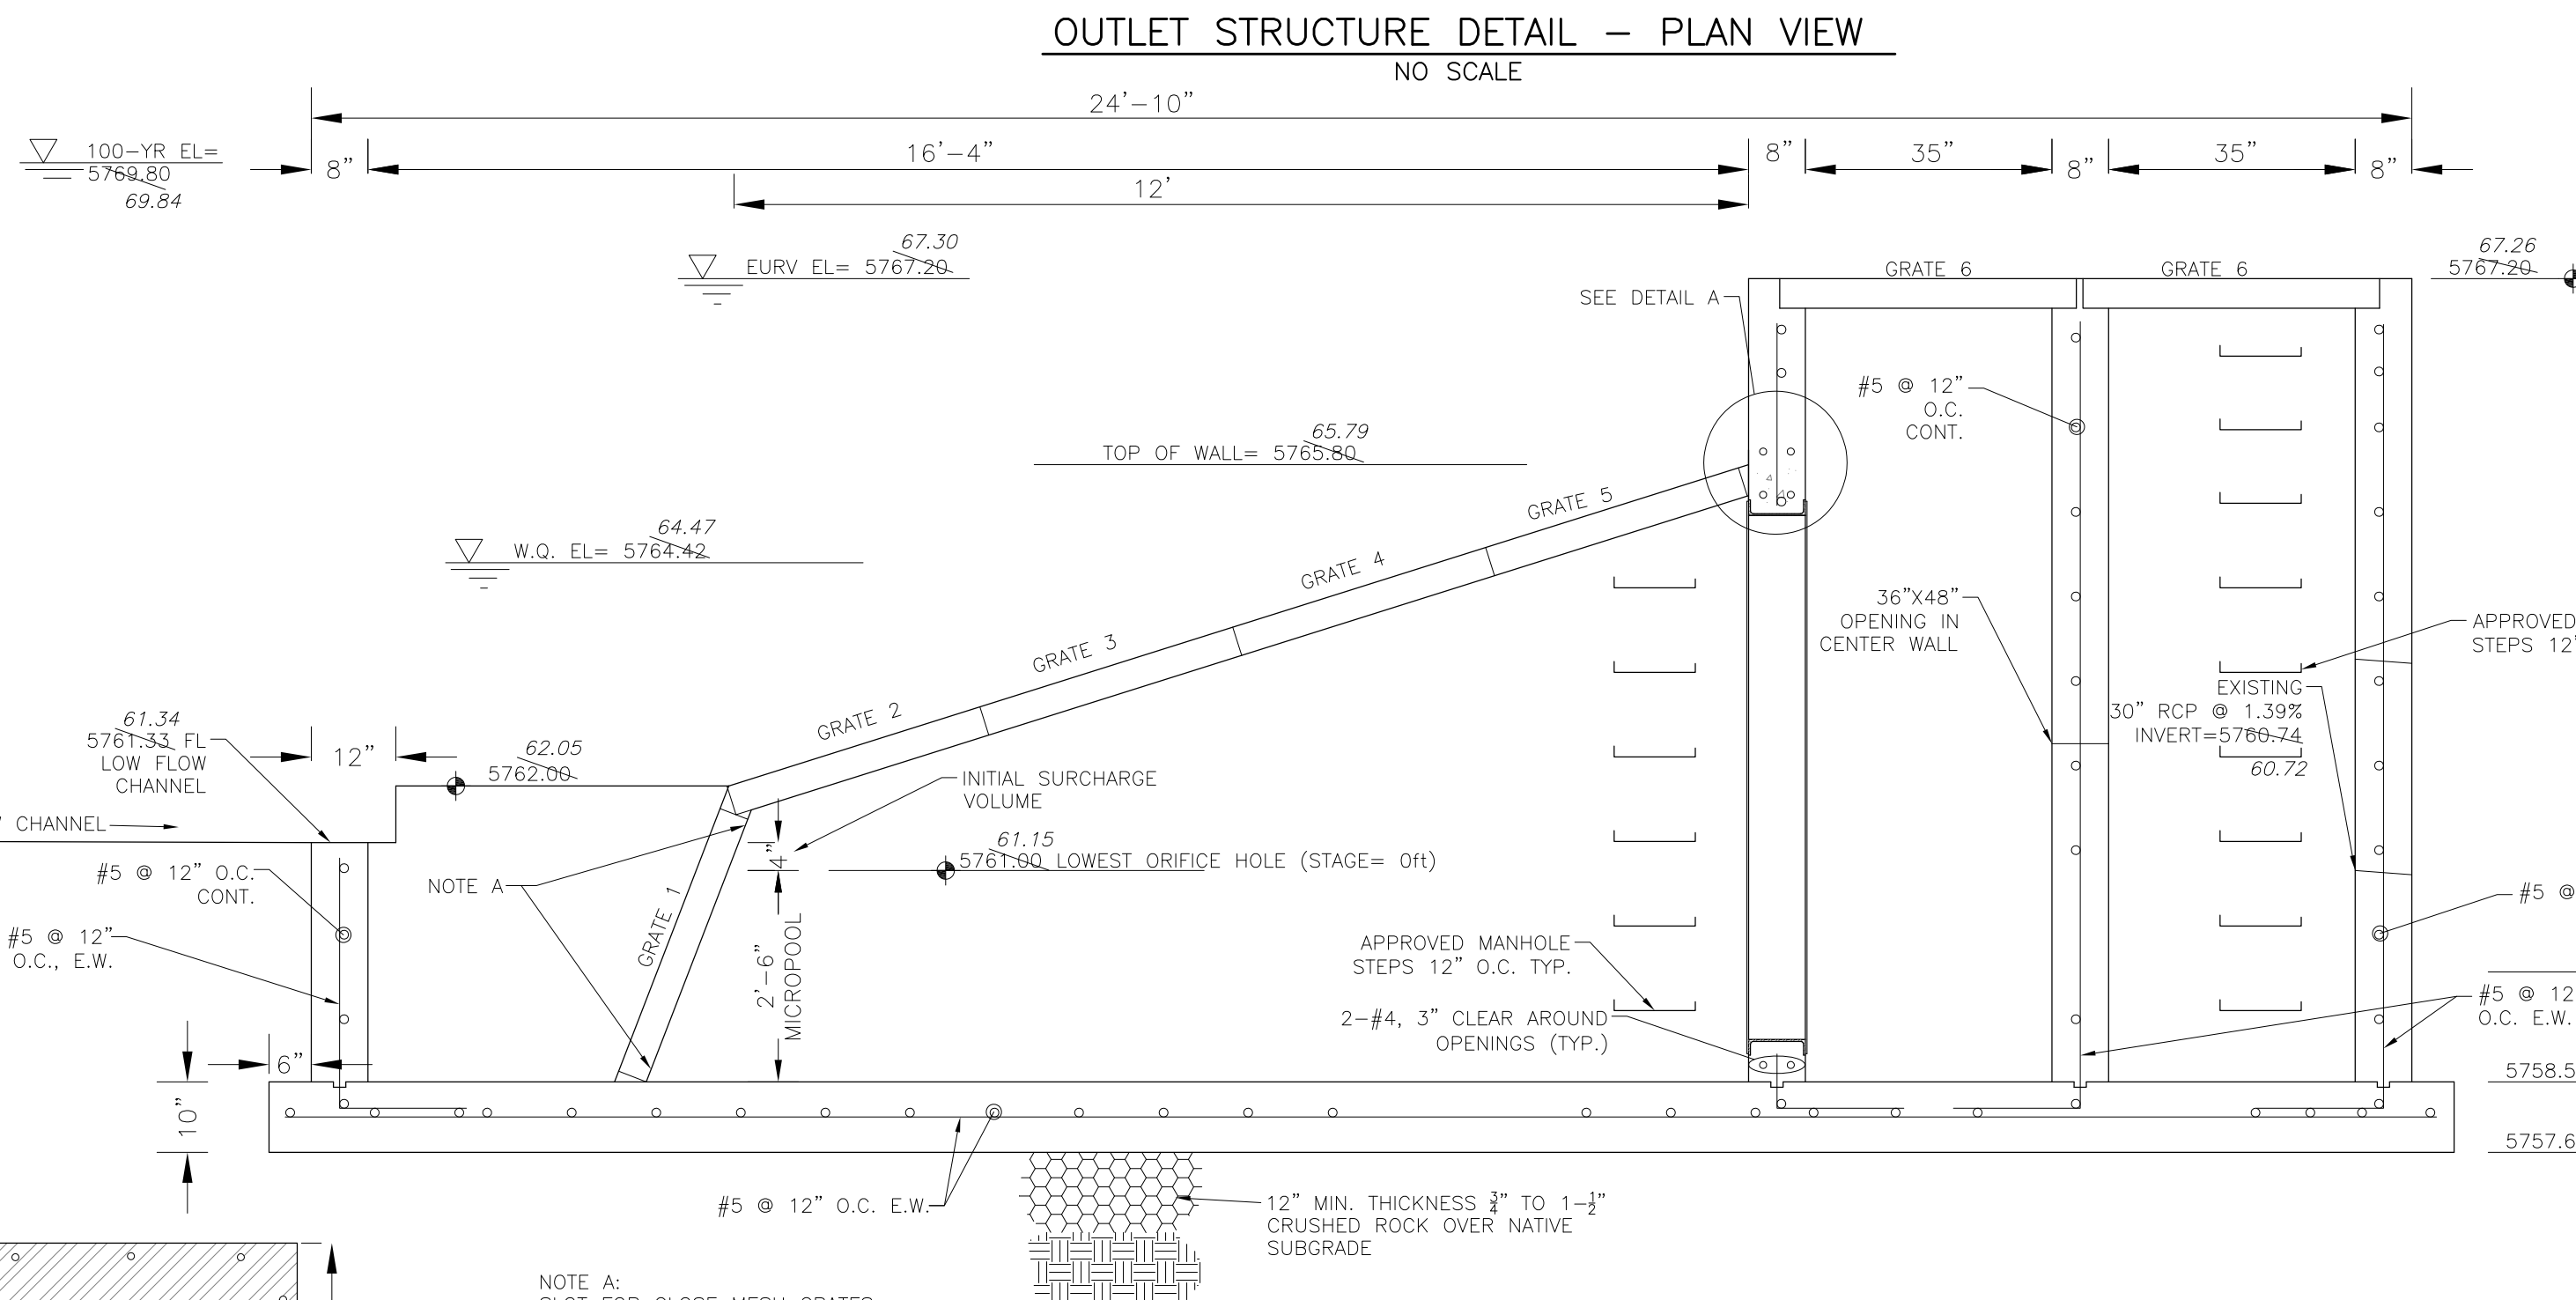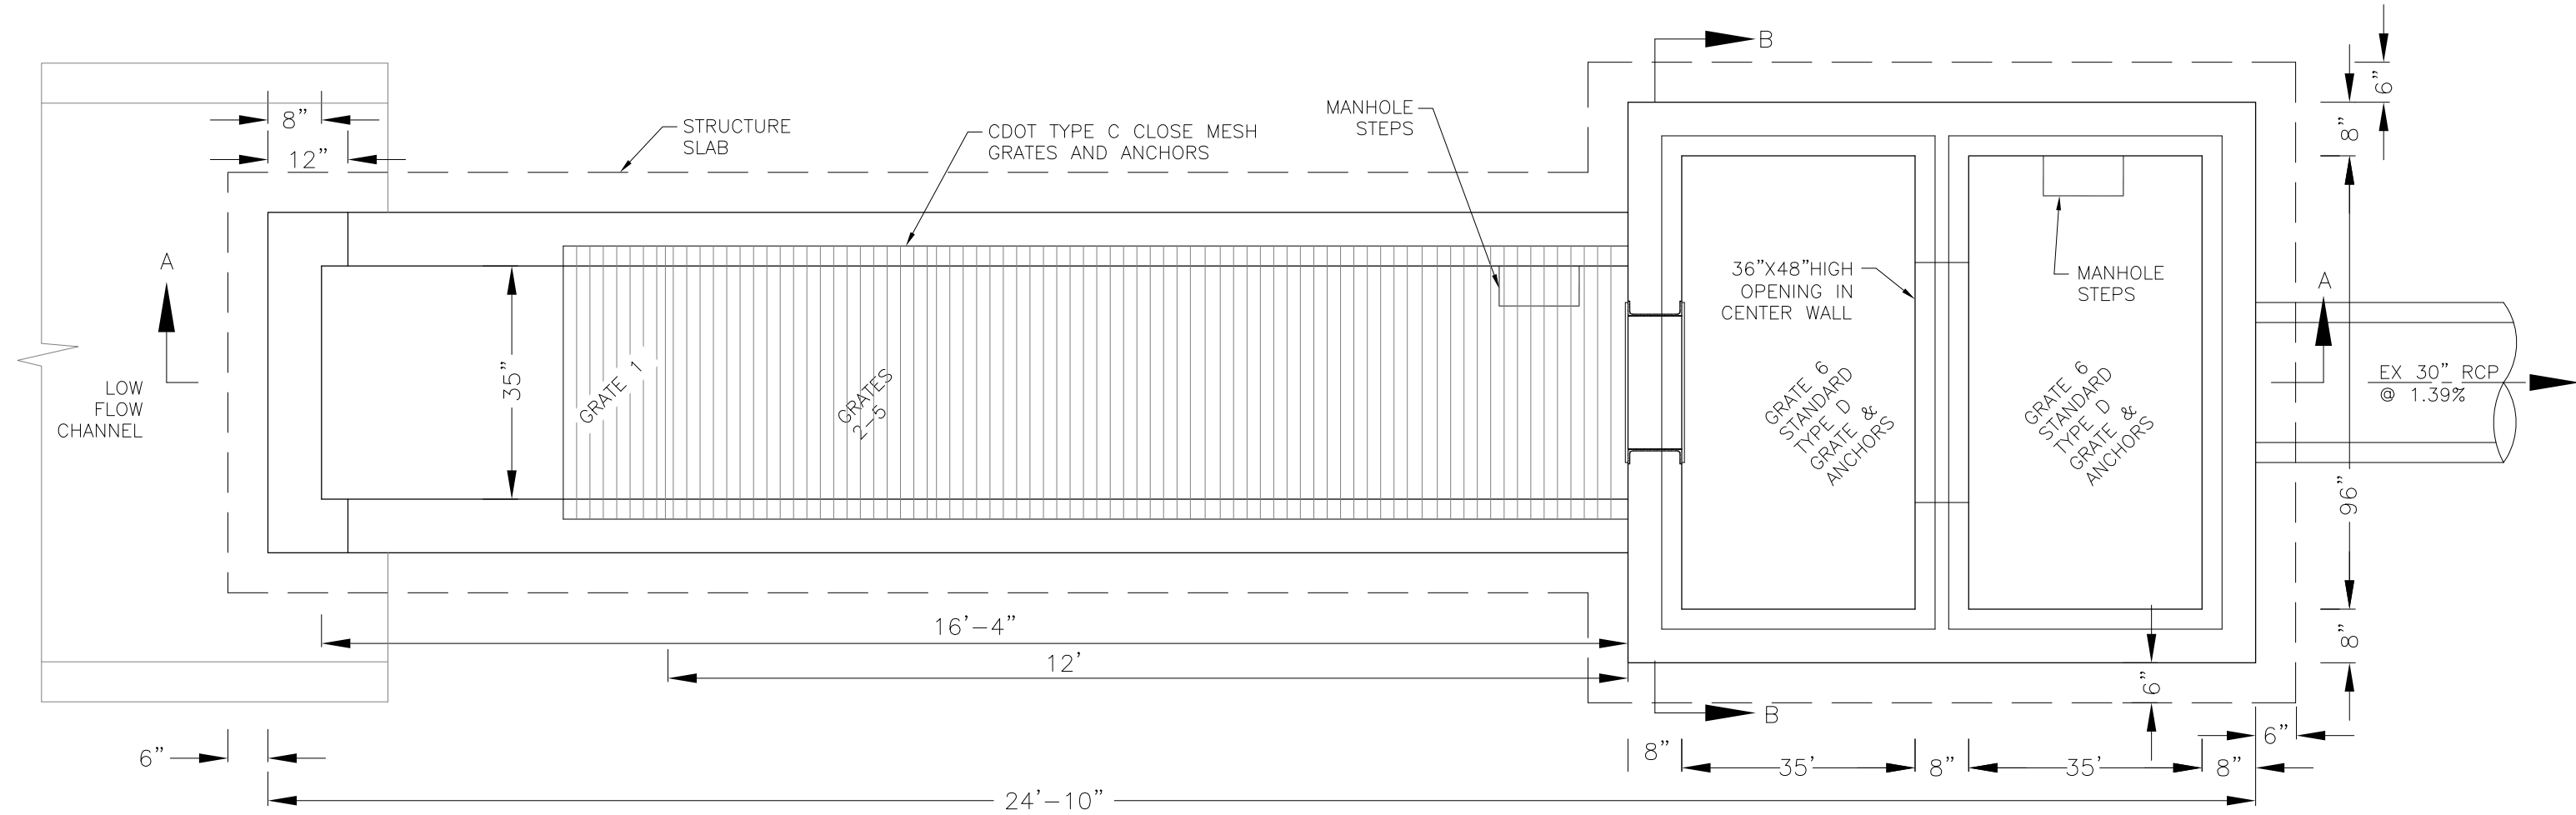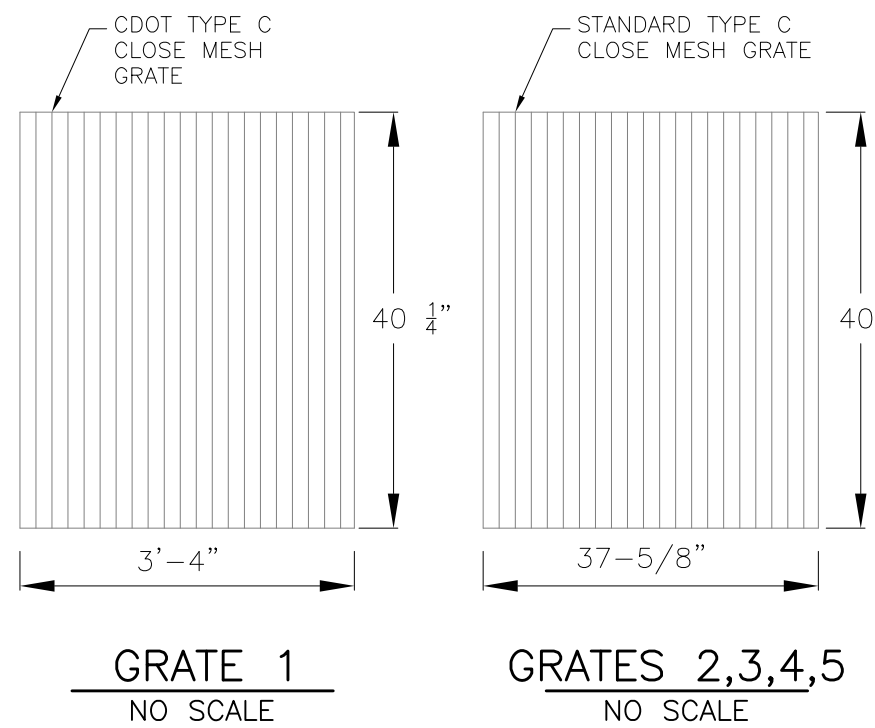


OUTLET STRUCTURE, FOREBAY, AND DRAIN CHANNEL NOTES:

- PRIOR TO CONSTRUCTION, CONTRACTOR SHALL PROVIDE SHOP DRAWINGS FOR ALL COMPONENTS OF THE OUTLET STRUCTURE.
- GRADE 60 REINFORCING STEEL REQUIRED. SEE TABLE FOR THE MINIMUM LAP SPLICE LENGTH FOR REINFORCING BARS. ALL REINFORCING STEEL SHALL HAVE A TWO-INCH MINIMUM CLEARANCE FROM EDGE OF CONCRETE, UNLESS OTHERWISE NOTED.
- CONCRETE FOR THE OUTLET STRUCTURE AND FOREBAY SHALL BE CDOT CLASS D CONCRETE.
- CONCRETE FOR DRAIN CHANNELS SHALL BE CDOT CLASS B CONCRETE
- EXPANSION JOINT MATERIAL SHALL MEET AASHTO SPECIFICATION M-213. EXPANSION JOINT MATERIAL SHALL BE 1/2" THICK, SHALL EXTEND THE FULL DEPTH OF CONTACT SURFACE AND THE JOINT SHALL BE SEALED, REFER TO DETAILS.
- ALL EXPOSED CONCRETE CORNERS SHALL HAVE A 3/8" CHAMFER UNLESS OTHERWISE NOTED.
- SUBGRADE TO BE 12" THICK CLEAN FILL COMPACTED TO 95% STANDARD PROCTOR DENSITY PER ASTM M698 UNDER STRUCTURE.
- REFER TO POND DETAILS FOR PRESEDIMENTATION/FOREBAY DESIGN.
- ENGINEER SHALL BE NOTIFIED PRIOR TO BEGINNING CONSTRUCTION OF OUTLET STRUCTURE TO SCHEDULE OBSERVATION VISITS FOR STRUCTURES.

WQCV WELL-SCREEN NOTES:

- Well-Screen shall be stainless steel and attached by stainless steel bolts along edge of the mounting frame.
- WQCV Well Screen
 - Type of Screen: Stainless steel #93 Vee Wire (Johnson Vee Wire (tm) Stainless Steel Screen or equivalent with 60% open area)
 - Screen slot opening dimension: 0.139" (Screen #93 Vee Wire Slot Opening)
 - Type and Size of Support Rod: TE 0.074"x0.50"
 - Spacing of Support Rod (O.C.): 1.0 Inch
 - Total Screen Thickness: 0.655"
 - Carbon Steel Holding Frame Type: 3/4" x 1.0" angle

AS-BUILT
DATE: 09/30/2022

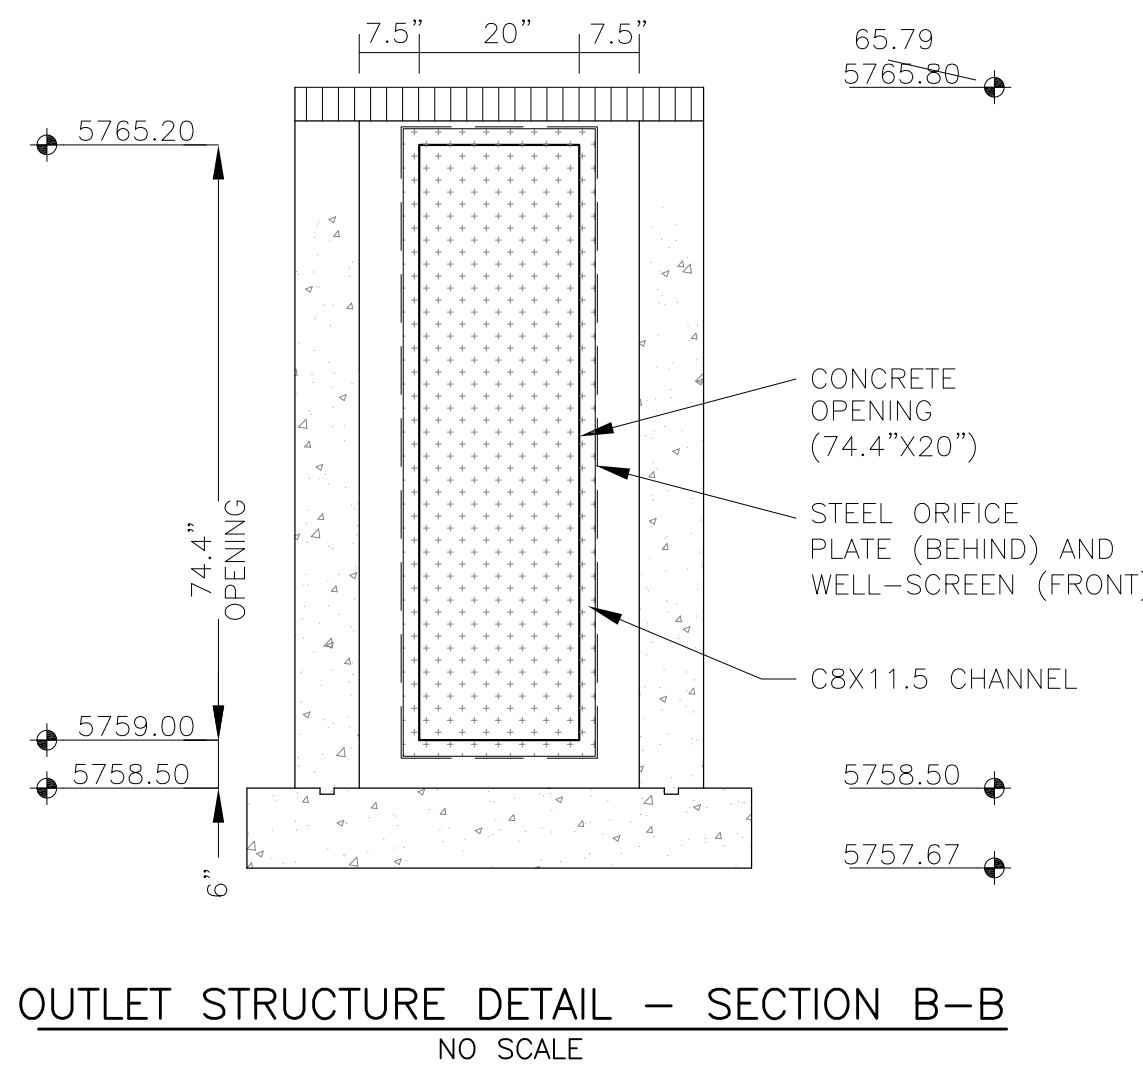

CORE
ENGINEERING GROUP
15004 1ST AVENUE S.
DENVER, CO 80202
PHONE: 303.570.1100
CONTACT: RICHARD L. SCHINDLER, P.E.
EMAIL: Rich@ceg.com

DATE: _____
DESCRIPTION: _____
NO: _____
DRAWN: RLS
DESIGNED: RLS
CHECKED: RLS

PREPARED FOR:
LORSON, LLC
212 N. WAHSATCH AVE. SUITE 301
COLORADO SPRINGS, COLORADO 80903
(719) 635-3200
CONTACT: JEFF MARK

PROJECT:
THE RIDGE AT LORSON RANCH
FONTAINE BLVD - WALLEYE DR
COLORADO SPRINGS, COLORADO

POND C2.1
FULL SPECTRUM
OUTLET STRUCTURE DETAILS

COLORADO REGISTERED PROFESSIONAL ENGINEER
33997
11/15/2021

DATE:
NOV 5, 2021


PROJECT NO.
100.064

SHEET NUMBER
C9.4
TOTAL SHEETS: 23

DETENTION BASIN OUTLET STRUCTURE DESIGN

MHFD-DETENTION, Version 4.02 (February 2020)

Project: The Hills at Lorson Ranch
Basin ID: Pond C2.2-asbuilt

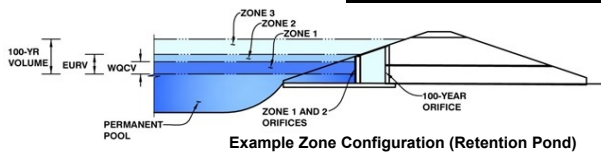

Example Zone Configuration (Retention Pond)

	Estimated Stage (ft)	Estimated Volume (ac-ft)	Outlet Type
Zone 1 (WQCV)	3.40	0.827	Orifice Plate
Zone 2 (EURV)	5.40	1.824	Rectangular Orifice
Z3 (100+1/2WQCV)	7.54	2.269	Weir&Pipe (Restrict)
Total (all zones)		4.920	

User Input: Orifice at Underdrain Outlet (typically used to drain WQCV in a Filtration BMP)

Underdrain Orifice Invert Depth = ft (distance below the filtration media surface)
Underdrain Orifice Diameter = inches

Calculated Parameters for Underdrain
Underdrain Orifice Area = ft²
Underdrain Orifice Centroid = feet

User Input: Orifice Plate with one or more orifices or Elliptical Slot Weir (typically used to drain WQCV and/or EURV in a sedimentation BMP)

Invert of Lowest Orifice = ft (relative to basin bottom at Stage = 0 ft)
Depth at top of Zone using Orifice Plate = ft (relative to basin bottom at Stage = 0 ft)
Orifice Plate: Orifice Vertical Spacing = inches
Orifice Plate: Orifice Area per Row = sq. inches (diameter = 1-11/16 inches)

Calculated Parameters for Plate
WQ Orifice Area per Row = ft²
Elliptical Half-Width = feet
Elliptical Slot Centroid = feet
Elliptical Slot Area = ft²

User Input: Stage and Total Area of Each Orifice Row (numbered from lowest to highest)

	Row 1 (required)	Row 2 (optional)	Row 3 (optional)	Row 4 (optional)	Row 5 (optional)	Row 6 (optional)	Row 7 (optional)	Row 8 (optional)
Stage of Orifice Centroid (ft)	0.00	1.15	2.20					
Orifice Area (sq. inches)	2.21	2.21	2.21					

	Row 9 (optional)	Row 10 (optional)	Row 11 (optional)	Row 12 (optional)	Row 13 (optional)	Row 14 (optional)	Row 15 (optional)	Row 16 (optional)
Stage of Orifice Centroid (ft)								
Orifice Area (sq. inches)								

User Input: Vertical Orifice (Circular or Rectangular)

Zone 2 Rectangular ☐ Not Selected ☐
Invert of Vertical Orifice = ft (relative to basin bottom at Stage = 0 ft)
Depth at top of Zone using Vertical Orifice = ft (relative to basin bottom at Stage = 0 ft)
Vertical Orifice Height = inches
Vertical Orifice Width = inches

Calculated Parameters for Vertical Orifice
Zone 2 Rectangular Not Selected
Vertical Orifice Area = ft²
Vertical Orifice Centroid = feet

User Input: Overflow Weir (Dropbox with Flat or Sloped Grate and Outlet Pipe OR Rectangular/Trapezoidal Weir (and No Outlet Pipe).

Zone 3 Weir ☐ Not Selected ☐
Overflow Weir Front Edge Height, H_o = ft (relative to basin bottom at Stage = 0 ft)
Overflow Weir Front Edge Length = feet
Overflow Weir Grate Slope = H:V
Horiz. Length of Weir Sides = feet
Overflow Grate Open Area % = %
Debris Clogging % = %

Calculated Parameters for Overflow Weir
Zone 3 Weir Not Selected
Height of Grate Upper Edge, H_u = feet
Overflow Weir Slope Length = feet
Grate Open Area / 100-yr Orifice Area = %
Overflow Grate Open Area w/o Debris = %
Overflow Grate Open Area w/ Debris = %

User Input: Outlet Pipe w/ Flow Restriction Plate (Circular Orifice, Restrictor Plate, or Rectangular Orifice)

Zone 3 Restrictor ☐ Not Selected ☐
Depth to Invert of Outlet Pipe = ft (distance below basin bottom at Stage = 0 ft)
Outlet Pipe Diameter = inches
Restrictor Plate Height Above Pipe Invert = inches

Calculated Parameters for Outlet Pipe w/ Flow Restriction Plate
Zone 3 Restrictor Not Selected
Outlet Orifice Area = ft²
Outlet Orifice Centroid = feet
Half-Central Angle of Restrictor Plate on Pipe = degrees

User Input: Emergency Spillway (Rectangular or Trapezoidal)

Spillway Invert Stage = ft (relative to basin bottom at Stage = 0 ft)
Spillway Crest Length = feet
Spillway End Slopes = H:V
Freeboard above Max Water Surface = feet

Calculated Parameters for Spillway
Spillway Design Flow Depth = feet
Stage at Top of Freeboard = feet
Basin Area at Top of Freeboard = acres
Basin Volume at Top of Freeboard = acre-ft

micropool = 0 = 5743.90


Routed Hydrograph Results

The user can override the default CUHP hydrographs and runoff volumes by entering new values in the Inflow Hydrographs table (Columns W through AF)

	WQCV	EURV	2 Year	5 Year	10 Year	25 Year	50 Year	100 Year
Design Storm Return Period	N/A	N/A	1.19	1.50	1.75	2.00	2.25	2.52
One-Hour Rainfall Depth (in)	N/A	N/A	1.19	1.50	1.75	2.00	2.25	2.52
CUHP Runoff Volume (acre-ft)	0.827	2.651	2.510	3.521	4.403	5.541	6.487	7.671
User Override Inflow Hydrograph Volume (acre-ft)	N/A	N/A	4.057	5.655	8.290	11.856	14.864	18.552
CUHP Predevelopment Peak Q (cfs)	N/A	N/A	5.0	13.5	20.5	36.5	45.7	58.2
OPTIONAL Override Predevelopment Peak Q (cfs)	N/A	N/A						
Predevelopment Unit Peak Flow, q (cfs/acre)	N/A	N/A	0.11	0.30	0.46	0.81	1.02	1.29
Peak Inflow Q (cfs)	N/A	N/A	41.0	59.5	73.2	94.9	111.3	131.4
Peak Outflow Q (cfs)	0.4	2.1	2.3	3.9	25.0	40.3	41.5	43.7
Ratio Peak Outflow to Predevelopment Q	N/A	N/A	N/A	0.3	1.2	1.1	0.9	0.8
Structure Controlling Flow	Vertical Orifice 1	Vertical Orifice 1	Vertical Orifice 1	Overflow Weir 1	Overflow Weir 1	Outlet Plate 1	Outlet Plate 1	Outlet Plate 1
Max Velocity through Grate 1 (fps)	N/A	N/A	N/A	0.0	0.7	1.1	1.1	1.2
Max Velocity through Grate 2 (fps)	N/A	N/A	N/A	N/A	N/A	N/A	N/A	N/A
Time to Drain 97% of Inflow Volume (hours)	39	54	59	62	58	53	49	44
Time to Drain 99% of Inflow Volume (hours)	41	58	65	70	68	66	64	62
Maximum Ponding Depth (ft)	3.40	5.40	5.86	7.13	7.57	7.80	8.25	9.04
Area at Maximum Ponding Depth (acres)	0.78	0.99	1.02	1.10	1.13	1.15	1.18	1.23
Maximum Volume Stored (acre-ft)	0.834	2.659	3.122	4.468	4.959	5.221	5.745	6.698

MHFD-Detention, Version 4.02 (February 2020)

Basin ID: Pond C2.2-asbuilt

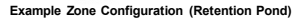


Depth Increment =	0.20	f
-------------------	------	---

	acre-feet
	acre-feet
1.19	inches
1.50	inches
1.75	inches
2.00	inches
2.25	inches
2.52	inches
	inches


[illegible]

Pond C2.2 Developed Inflow Hydrograph---- asbuilt Pond C3 outflow + C5 Basin + C7 Basin

2 Year			CUHP	2yr	5 Year		CUHP	5yr	10 Year		CUHP	10yr	25 Year		CUHP	25yr	50 Year		CUHP	50yr	100 Year		CUHP	100yr	500 Year		CUHP	500yr
Time [hr]	Time [min]	Pond C3 Outflow2 - [cfs]	2 Year [cfs]	Hydrograph	Pond C3 Outflow2 - [cfs]	5 Year [cfs]	Hydrograph	Ponc C3 Outflow2 - [cfs]	10 Year [cfs]	Hydrograph	Pond C3 Outflow2 - [cfs]	25 Year [cfs]	Hydrograph	Pond C3 Outflow2 - [cfs]	50 Year [cfs]	Hydrograph	Pond C3 Outflow2 - [cfs]	100 Year [cfs]	Hydrograph	Pond C3 Outflow2 - [cfs]	500 Year [cfs]	Hydrograph						
0.00	0.00	0.00	0.00	0.00	0.00	0.00	0.00	0.00	0.00	0.00	0.00	0.00	0.00	0.00	0.00	0.00	0.02	0.00	0.02	0.00	0.02	0.00	0.00	0.03	0.00	0.00	0.03	
0.08	5.00	0.03	0.00	0.03	0.03	0.00	0.03	0.03	0.00	0.03	0.03	0.00	0.03	0.03	0.04	0.00	0.04	0.03	0.00	0.03	0.05	0.00	0.05					
0.17	10.00	0.07	0.00	0.07	0.08	0.00	0.08	0.08	0.00	0.08	0.07	0.00	0.07	0.08	0.42	0.50	0.08	0.04	0.12	0.09	1.36	1.45						
0.25	15.00	0.11	3.74	3.85	0.12	6.11	6.23	0.13	7.57	7.70	0.11	5.09	5.20	0.12	6.38	6.50	0.12	6.20	6.32	0.13	9.01	9.14						
0.33	20.00	0.14	13.60	13.74	0.16	18.00	18.16	0.16	21.92	22.08	0.15	13.38	13.53	0.15	15.61	15.76	0.15	16.68	16.83	0.17	22.29	22.46						
0.42	25.00	0.17	31.11	31.28	0.19	45.07	45.26	0.51	57.54	58.05	0.18	30.50	30.68	0.23	35.87	36.10	0.37	39.63	40.00	1.70	57.77	59.47						
0.50	30.00	0.23	40.82	41.05	1.23	58.25	59.48	1.97	71.19	73.16	1.69	76.90	78.59	2.18	91.05	93.23	2.61	102.55	105.16	3.35	136.67	140.02						
0.58	35.00	0.87	38.60	39.47	2.11	53.89	56.00	2.59	65.04	67.63	2.78	92.11	94.89	3.23	108.06	111.29	3.68	127.72	131.40	4.34	166.67	171.01						
0.67	40.00	1.68	33.84	35.52	2.54	46.24	48.78	3.04	55.88	58.92	3.52	88.47	91.99	3.95	103.22	107.17	4.39	122.26	126.65	5.05	158.77	163.82						
0.75	45.00	2.03	28.43	30.46	2.83	39.40	42.23	3.45	48.41	51.86	4.08	77.76	81.84	4.49	90.67	95.16	4.93	110.23	115.16	18.15	143.17	161.32						
0.83	50.00	2.27	23.82	26.09	3.07	33.85	36.92	3.84	41.10	44.94	4.51	69.49	74.00	4.91	81.04	85.95	6.77	98.35	105.12	29.80	127.67	157.47						
0.92	55.00	2.46	20.11	22.57	3.28	28.41	31.69	4.17	34.74	38.91	4.86	58.63	63.49	5.26	68.45	73.71	23.46	85.07	108.53	31.17	110.43	141.60						
1.00	60.00	2.61	17.63	20.24	3.48	24.74	28.22	4.46	30.90	35.36	5.15	48.90	54.05	14.42	57.23	71.65	29.32	73.51	102.83	32.44	95.81	128.25						
1.08	65.00	2.73	15.89	18.62	3.68	22.20	25.88	4.71	28.16	32.87	8.14	42.78	50.92	27.08	50.23	77.31	29.85	66.37	96.22	33.69	86.66	120.35						
1.17	70.00	2.82	13.63	16.45	3.85	19.91	23.76	4.93	25.58	30.51	17.52	36.41	53.93	29.18	42.84	72.02	30.27	55.34	85.61	50.30	72.60	122.90						
1.25	75.00	2.90	11.46	14.36	4.00	17.10	21.10	5.13	23.01	28.14	26.03	30.66	56.69	29.49	36.16	65.65	30.60	44.97	75.57	64.86	59.42	124.28						
1.33	80.00	2.97	9.51	12.48	4.14	14.14	18.28	5.56	19.48	25.04	29.01	24.76	53.77	29.74	29.17	58.91	30.87	34.93	65.80	70.54	46.13	116.67						
1.42	85.00	3.03	7.93	10.96	4.26	11.69	15.95	10.03	15.58	25.61	29.20	19.60	48.80	29.95	23.03	52.98	31.09	26.23	57.32	70.07	34.55	104.62						
1.50	90.00	3.08	6.97	10.05	4.38	10.29	14.67	14.87	13.16	28.03	29.36	14.82	44.18	30.14	17.32	47.46	31.29	19.11	50.40	66.81	25.36	92.17						
1.58	95.00	3.14	6.50	9.64	4.48	9.58	14.06	18.58	11.74	30.32	29.51	11.96	41.47	30.32	13.95	44.27	31.47	14.90	46.37	63.07	19.87	82.94						
1.67	100.00	3.19	6.27	9.46	4.57	8.56	13.13	21.01	10.76	31.77	29.64	10.21	39.85	30.47	11.85	42.32	31.63	12.39	44.02	59.93	16.55	76.48						
1.75	105.00	3.24	6.14	9.38	4.65	7.72	12.37	22.39	10.05	32.44	29.77	9.08	38.85	30.62	10.48	41.10	31.78	10.63	42.41	57.48	14.20	71.68						
1.83	110.00	3.29	6.04	9.33	4.72	7.11	11.83	22.95	9.57	32.52	29.88	8.29	38.17	30.75	9.52	40.27	31.91	9.43	41.34	55.54	12.60	68.14						
1.92	115.00	3.33	5.34	8.67	4.78	6.67	11.45	22.82	8.98	31.80	29.98	7.79	37.77	30.88	8.90	39.78	32.05	8.58	40.63	54.02	11.45	65.47						
2.00	120.00	3.36	4.68	8.04	4.84	6.16	11.00	21.99	8.10	30.09	30.08	7.44	37.52	30.99	8.45	39.44	32.16	7.98	40.14	52.61	10.64	63.25						
2.08	125.00	3.39	3.59	6.98	4.88	4.72	9.60	20.59	6.16	26.75	30.15	5.71	35.86	31.08	6.47	37.55	32.27	6.02	38.29	51.13	8.02	59.15						
2.17	130.00	3.42	2.65	6.07	4.91	3.44	8.35	18.90	4.45	23.35	30.17	4.14	34.31	31.16	4.68	35.84	32.36	4.36	36.72	49.70	5.80	55.50						
2.25	135.00	3.44	1.95	5.39	4.93	2.52	7.45	17.14	3.22	20.36	30.11	3.01	33.12	31.23	3.40	34.63	32.43	3.19	35.62	48.36	4.22	52.58						
2.33	140.00	3.46	1.42	4.88	4.94	1.83	6.77	15.43	2.34	17.77	29.99	2.20	32.19	31.28	2.48	33.76	32.50	2.35	34.85	47.13	3.11	50.24						
2.42	145.00	3.48	1.02	4.50	4.96	1.28	6.24	13.86	1.67	15.53	29.83	1.56	31.39	31.33	1.75	33.08	32.57	1.68	34.25	46.02	2.22	48.24						
2.50	150.00	3.49	0.71	4.20	4.96	0.88	5.84	12.47	1.17	13.64	29.63	1.10	30.73	31.37	1.23	32.60	32.62	1.18	33.80	45.01	1.56	46.57						
2.58	155.00	3.51	0.49	4.00	4.97	0.61	5.58	11.27	0.82	12.09	29.41	0.79	30.20	31.37	0.88	32.25	32.66	0.84	33.50	44.09	1.11	45.20						
2.67	160.00	3.52																										

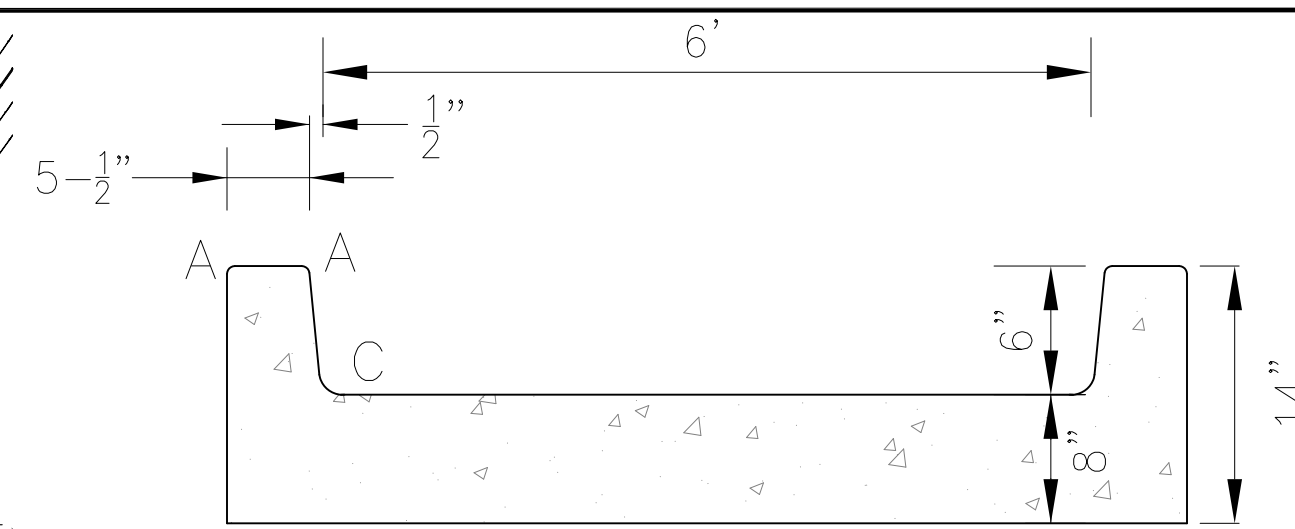

LENGTH FOR RADII
A = 1/2"
C = 1-1/2"

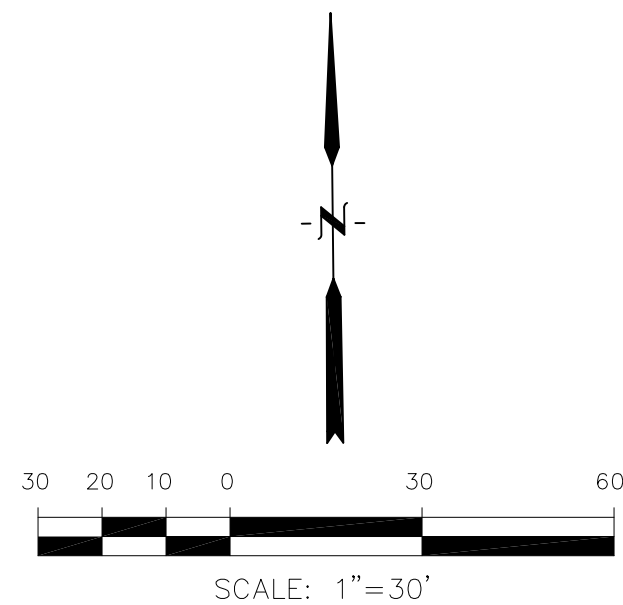

CORE
ENGINEERING GROUP
15004 1ST AVENUE S.
BURNSVILLE, MN 55306
PH: 719.570.1100
CONTACT: RICHARD L. SCHINDLER, P.E.
EMAIL: Rich@ceg1.com

[illegible][illegible]

DRAWN: RLS
DESIGNED: RLS
CHECKED: RLS

POND C2.2 & C2.3 FOREBAY, LOW FLOW CHANNEL AND OUTLET STRUCTURE LAYOUT




DATE:
NOV 12, 2020




PROJECT NO.
100.061

SHEET NUMBER
C9.5



TOTAL SHEETS: 58

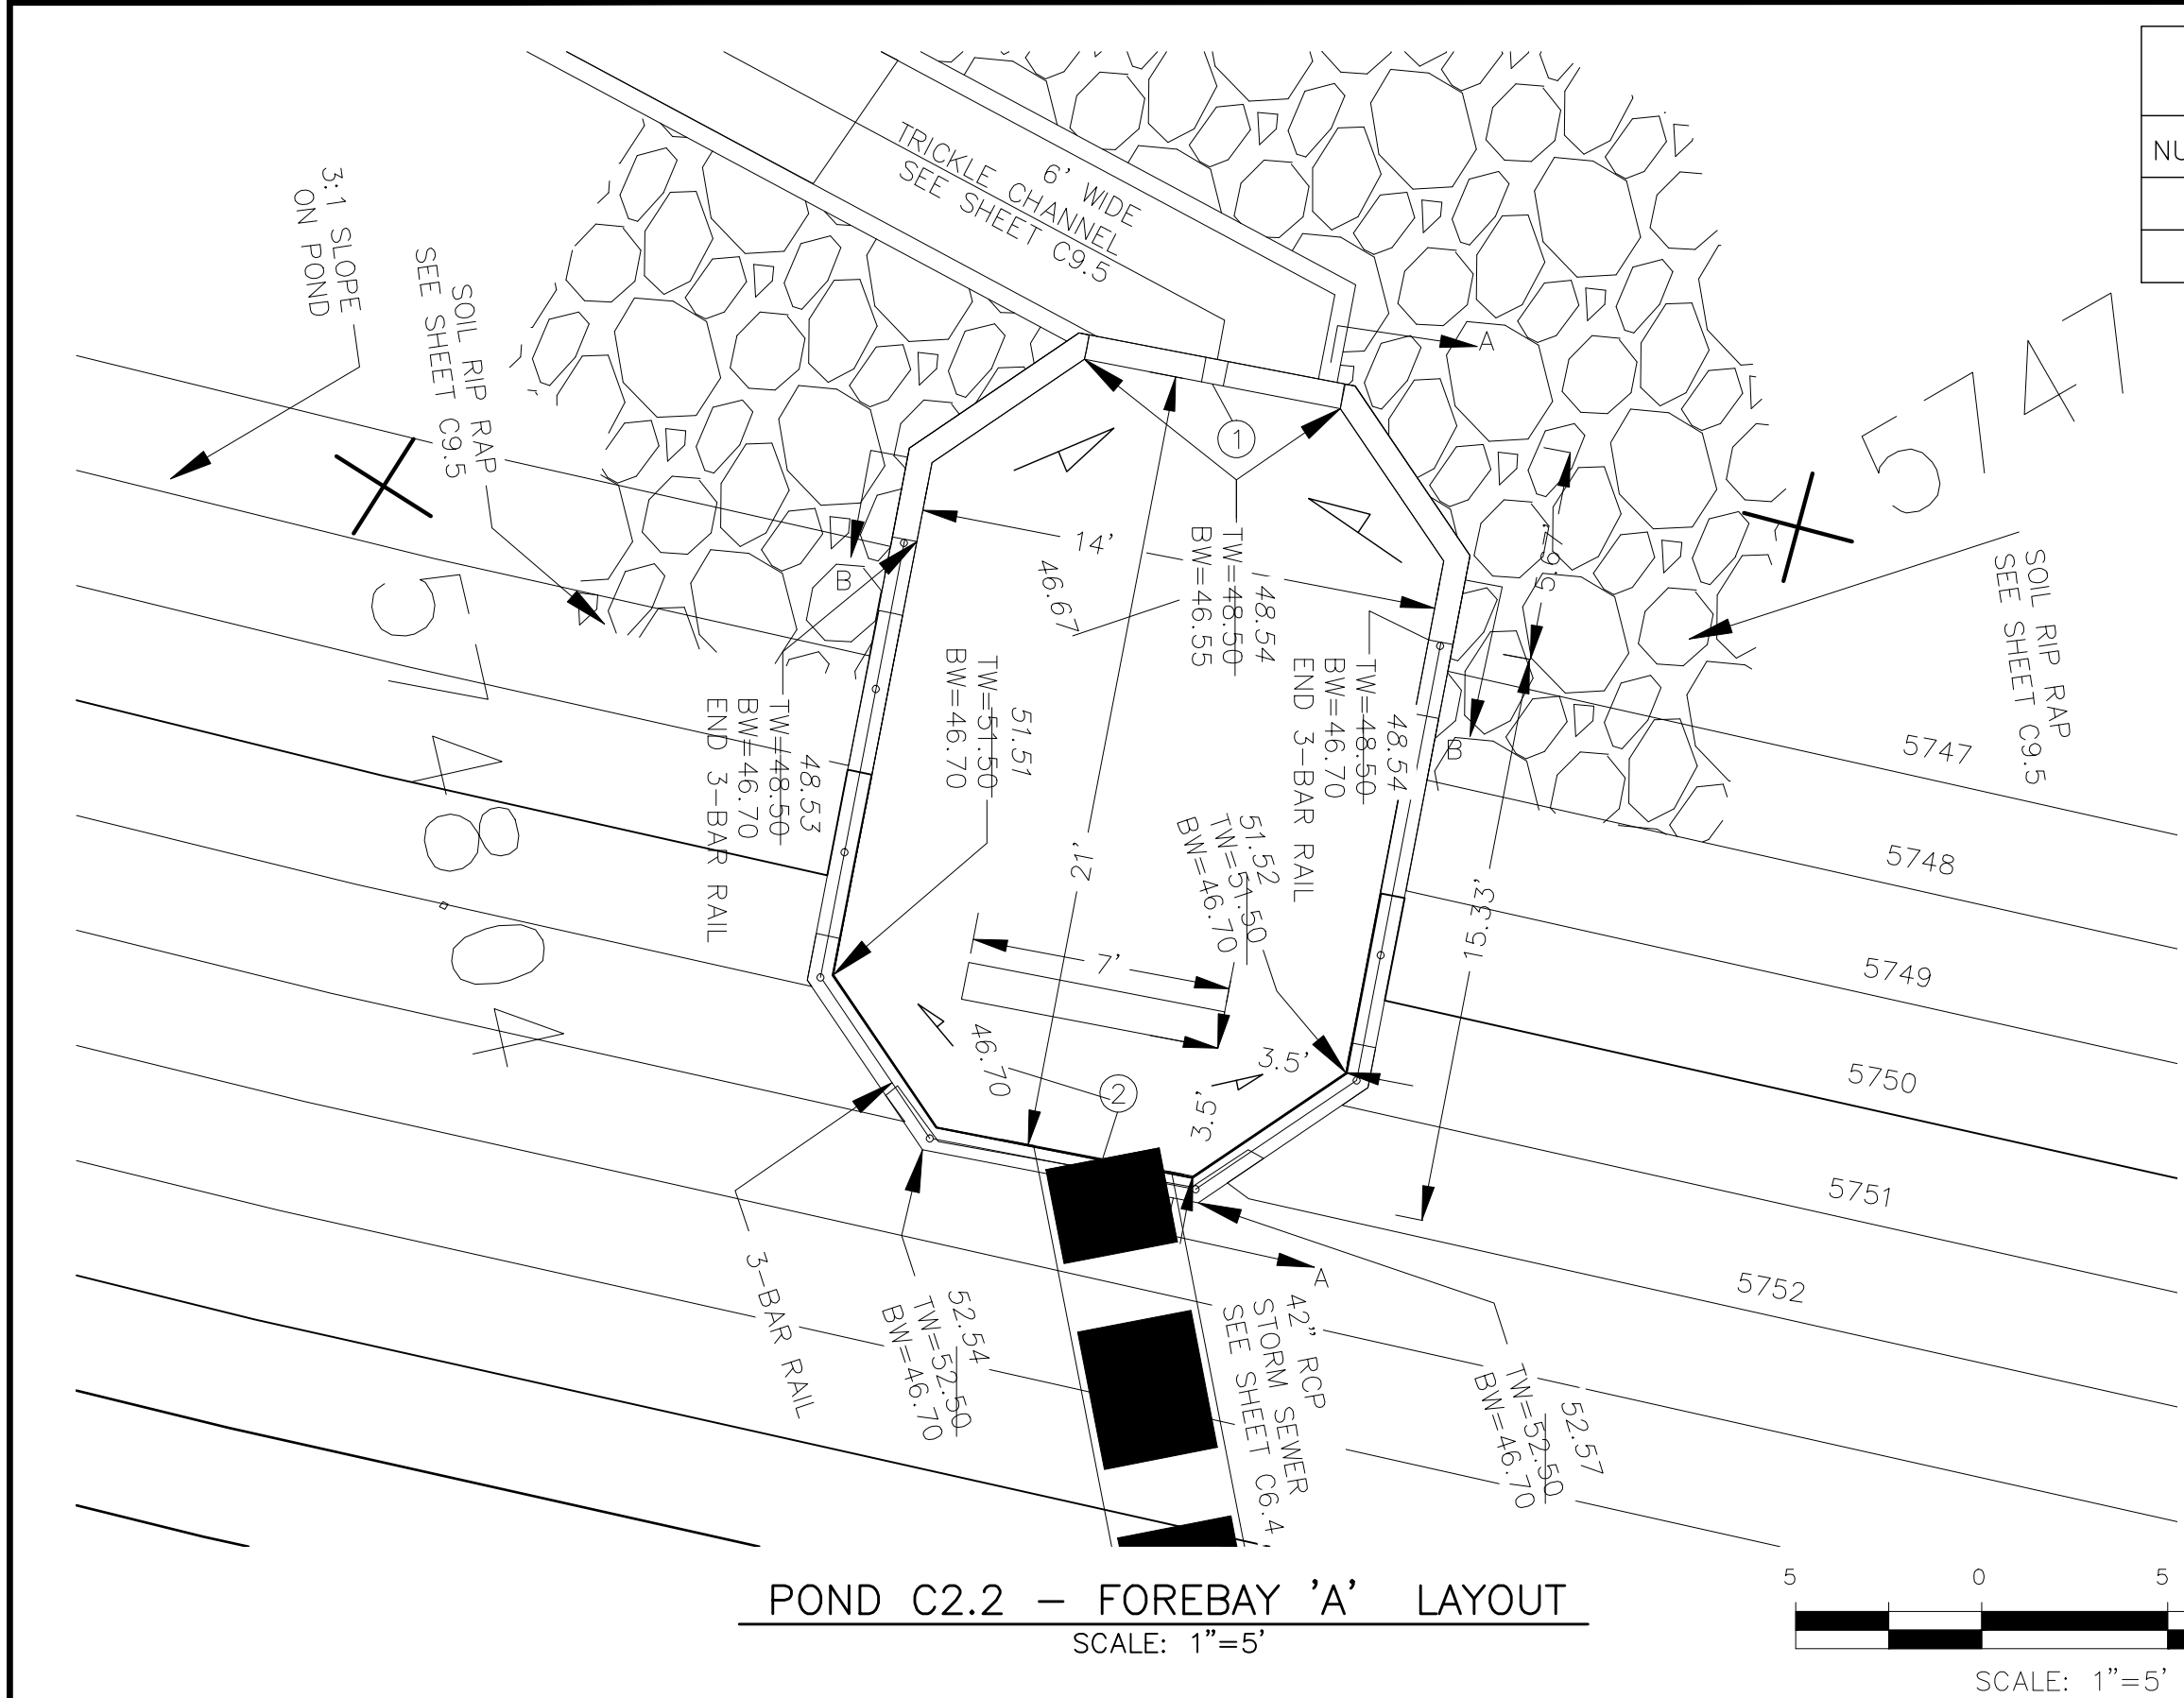

POINT TABLE (FOREBAY)				
NUMBER	NORTHING	EASTING	ELEVATION	NOTES
1	23338.41	29100.32	5746.50	FOREBAY BOTTOM
2	23317.59	29097.36	5746.62	FOREBAY BOTTOM, INV 42"=5747.70

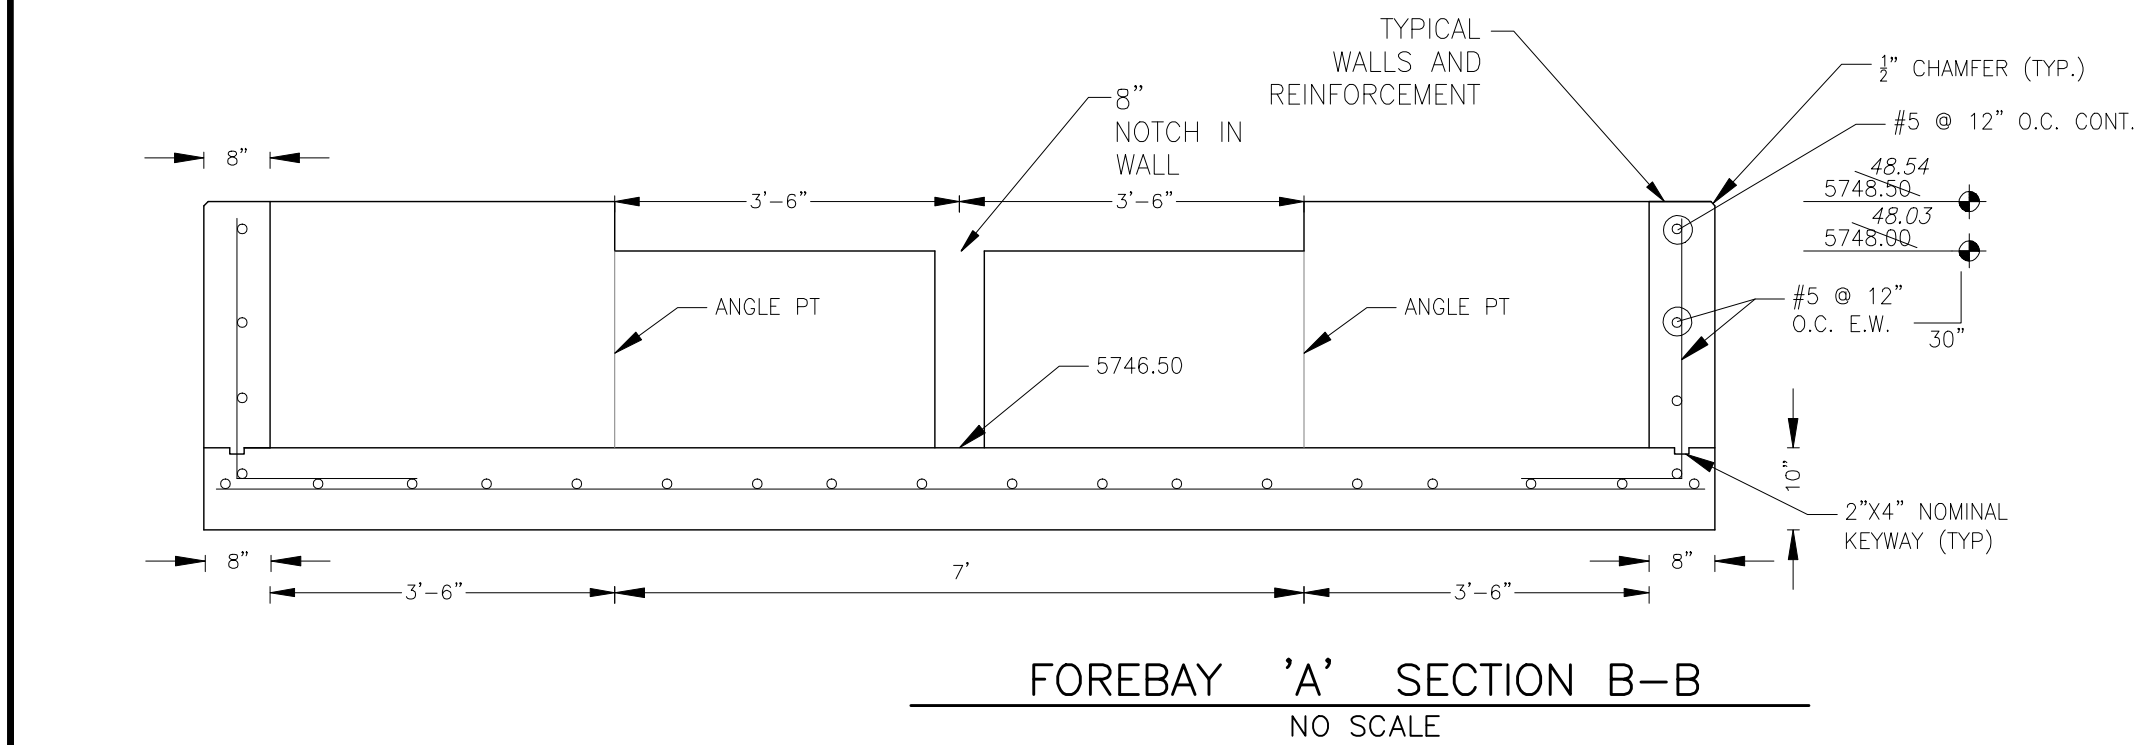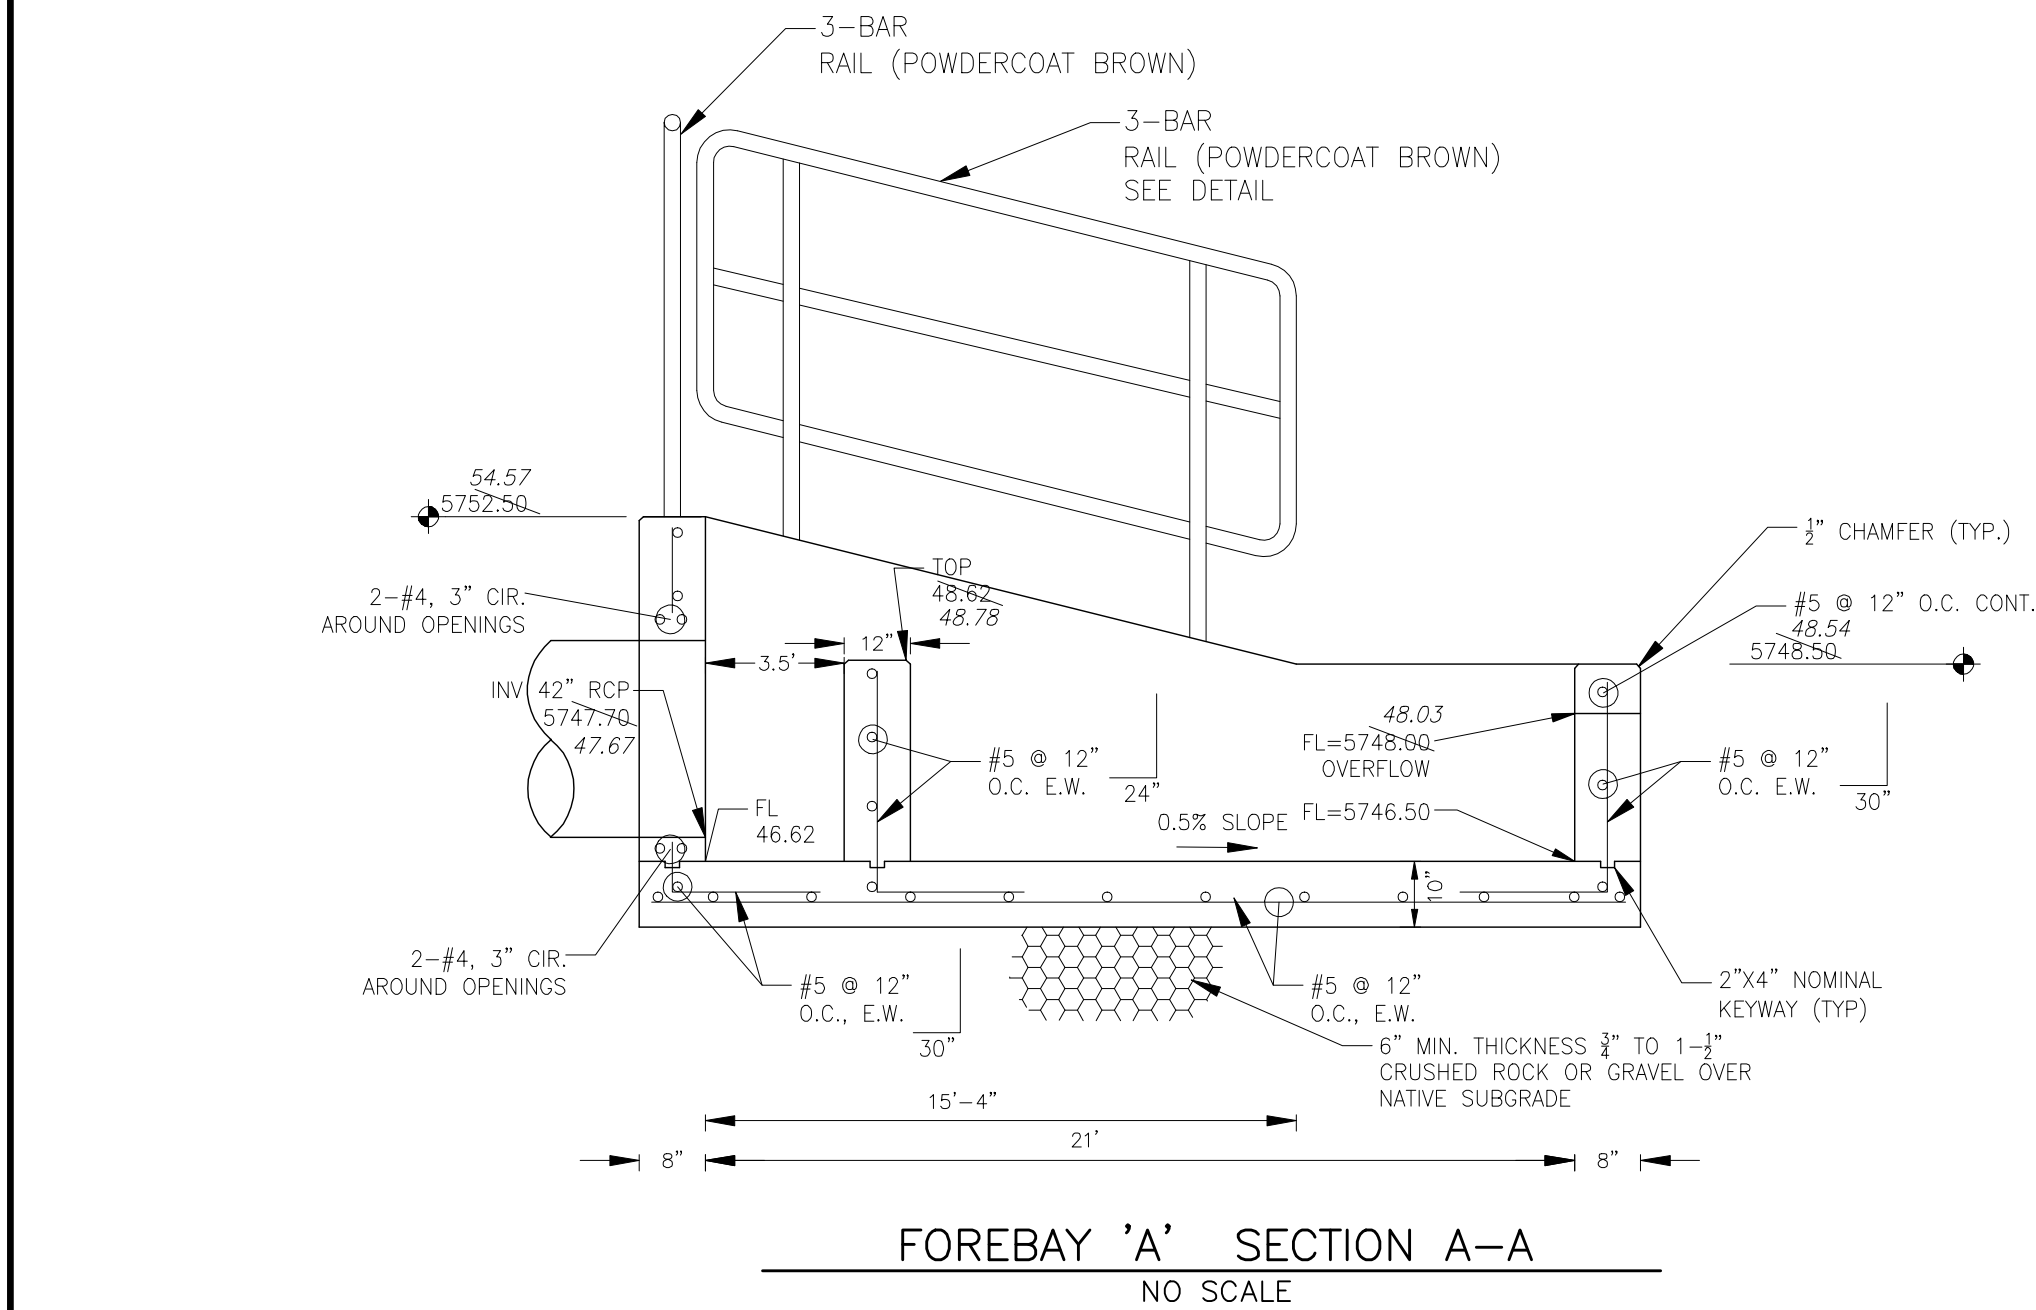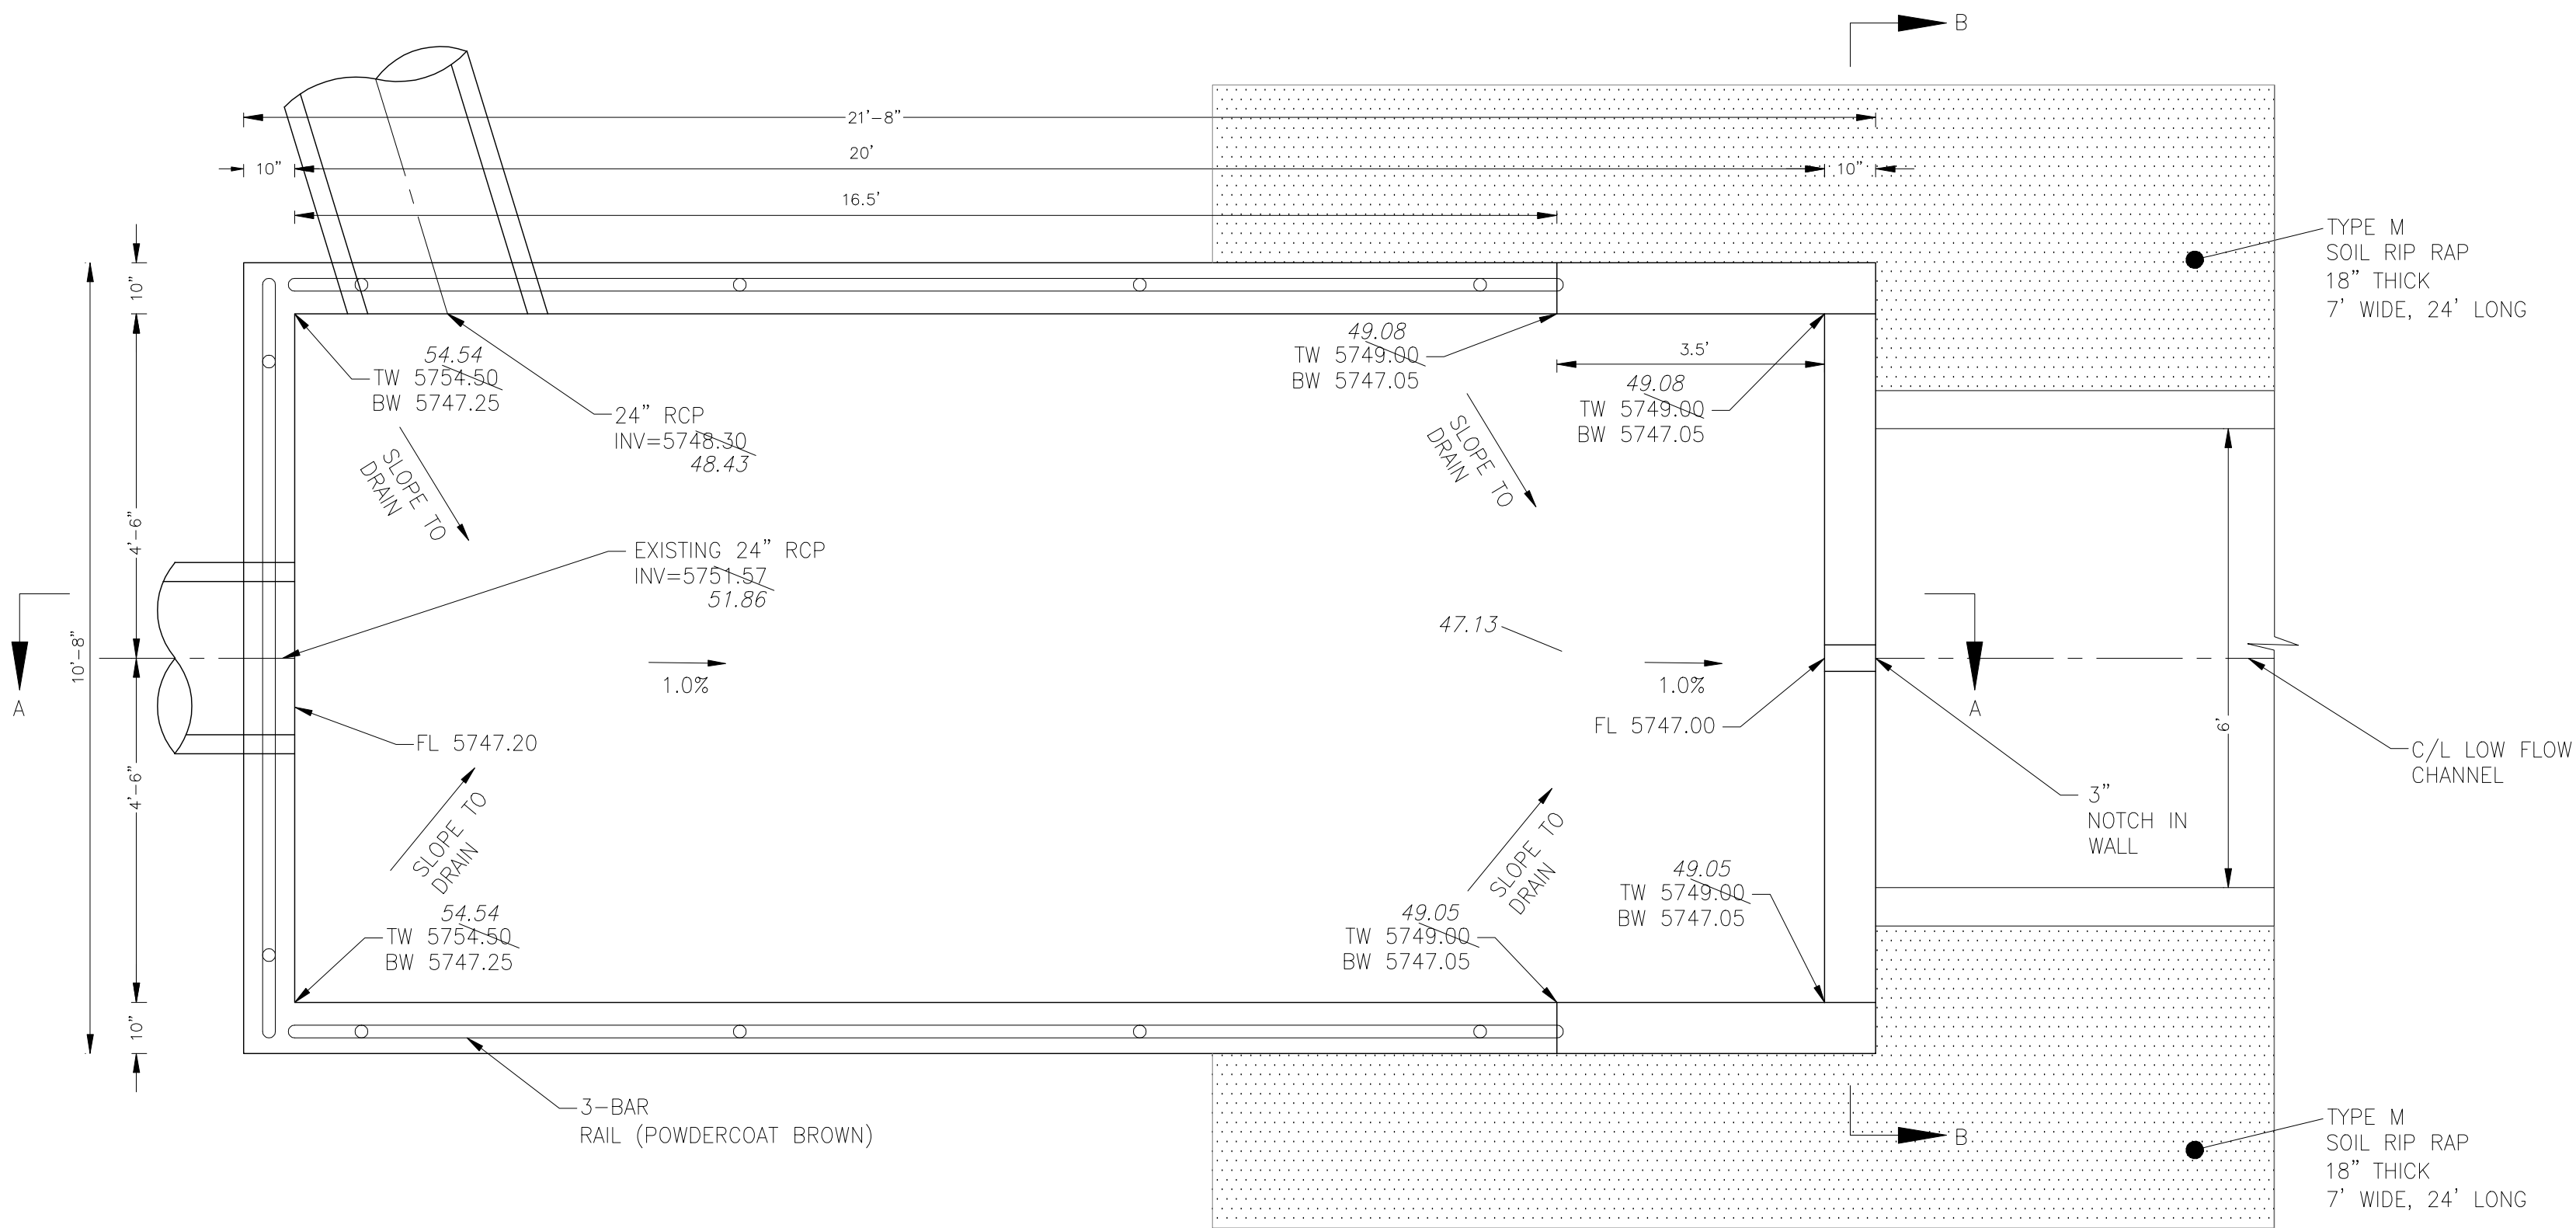

NOTE: ALL CONCRETE
FOR FOREBAY SHALL BE
CDOT TYPE D

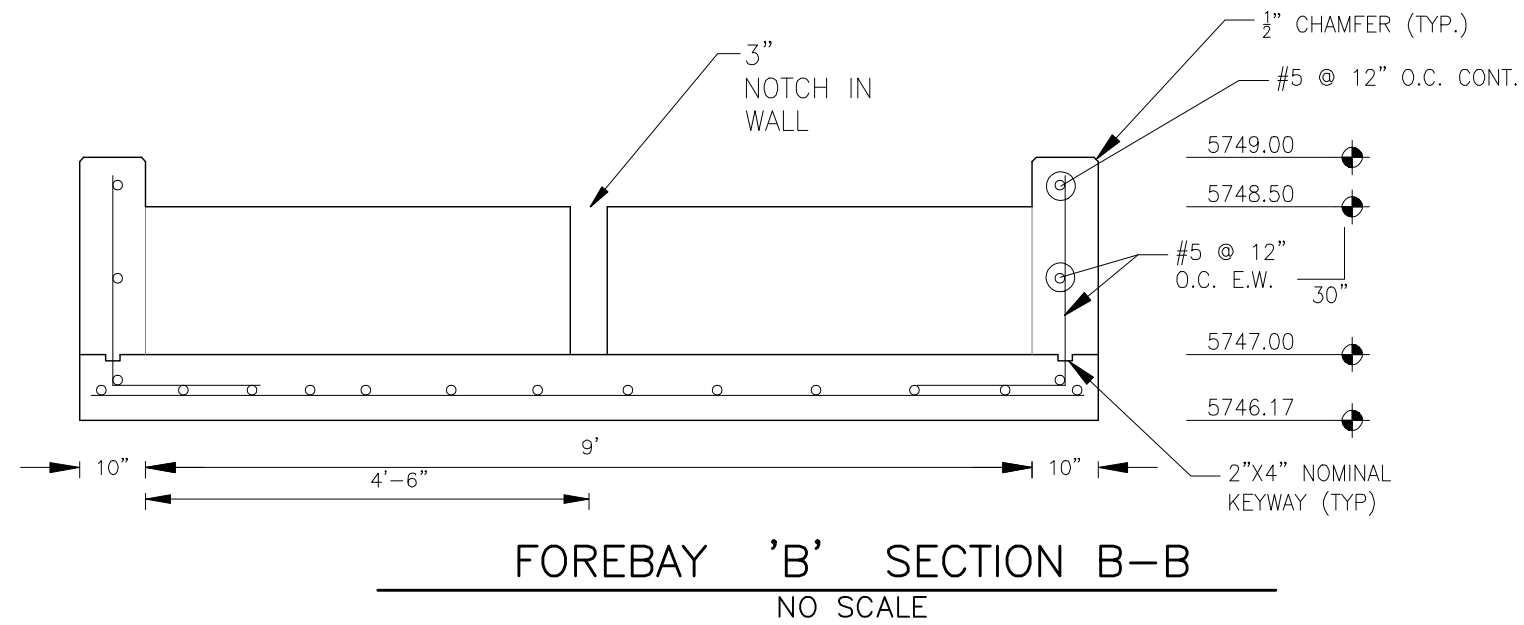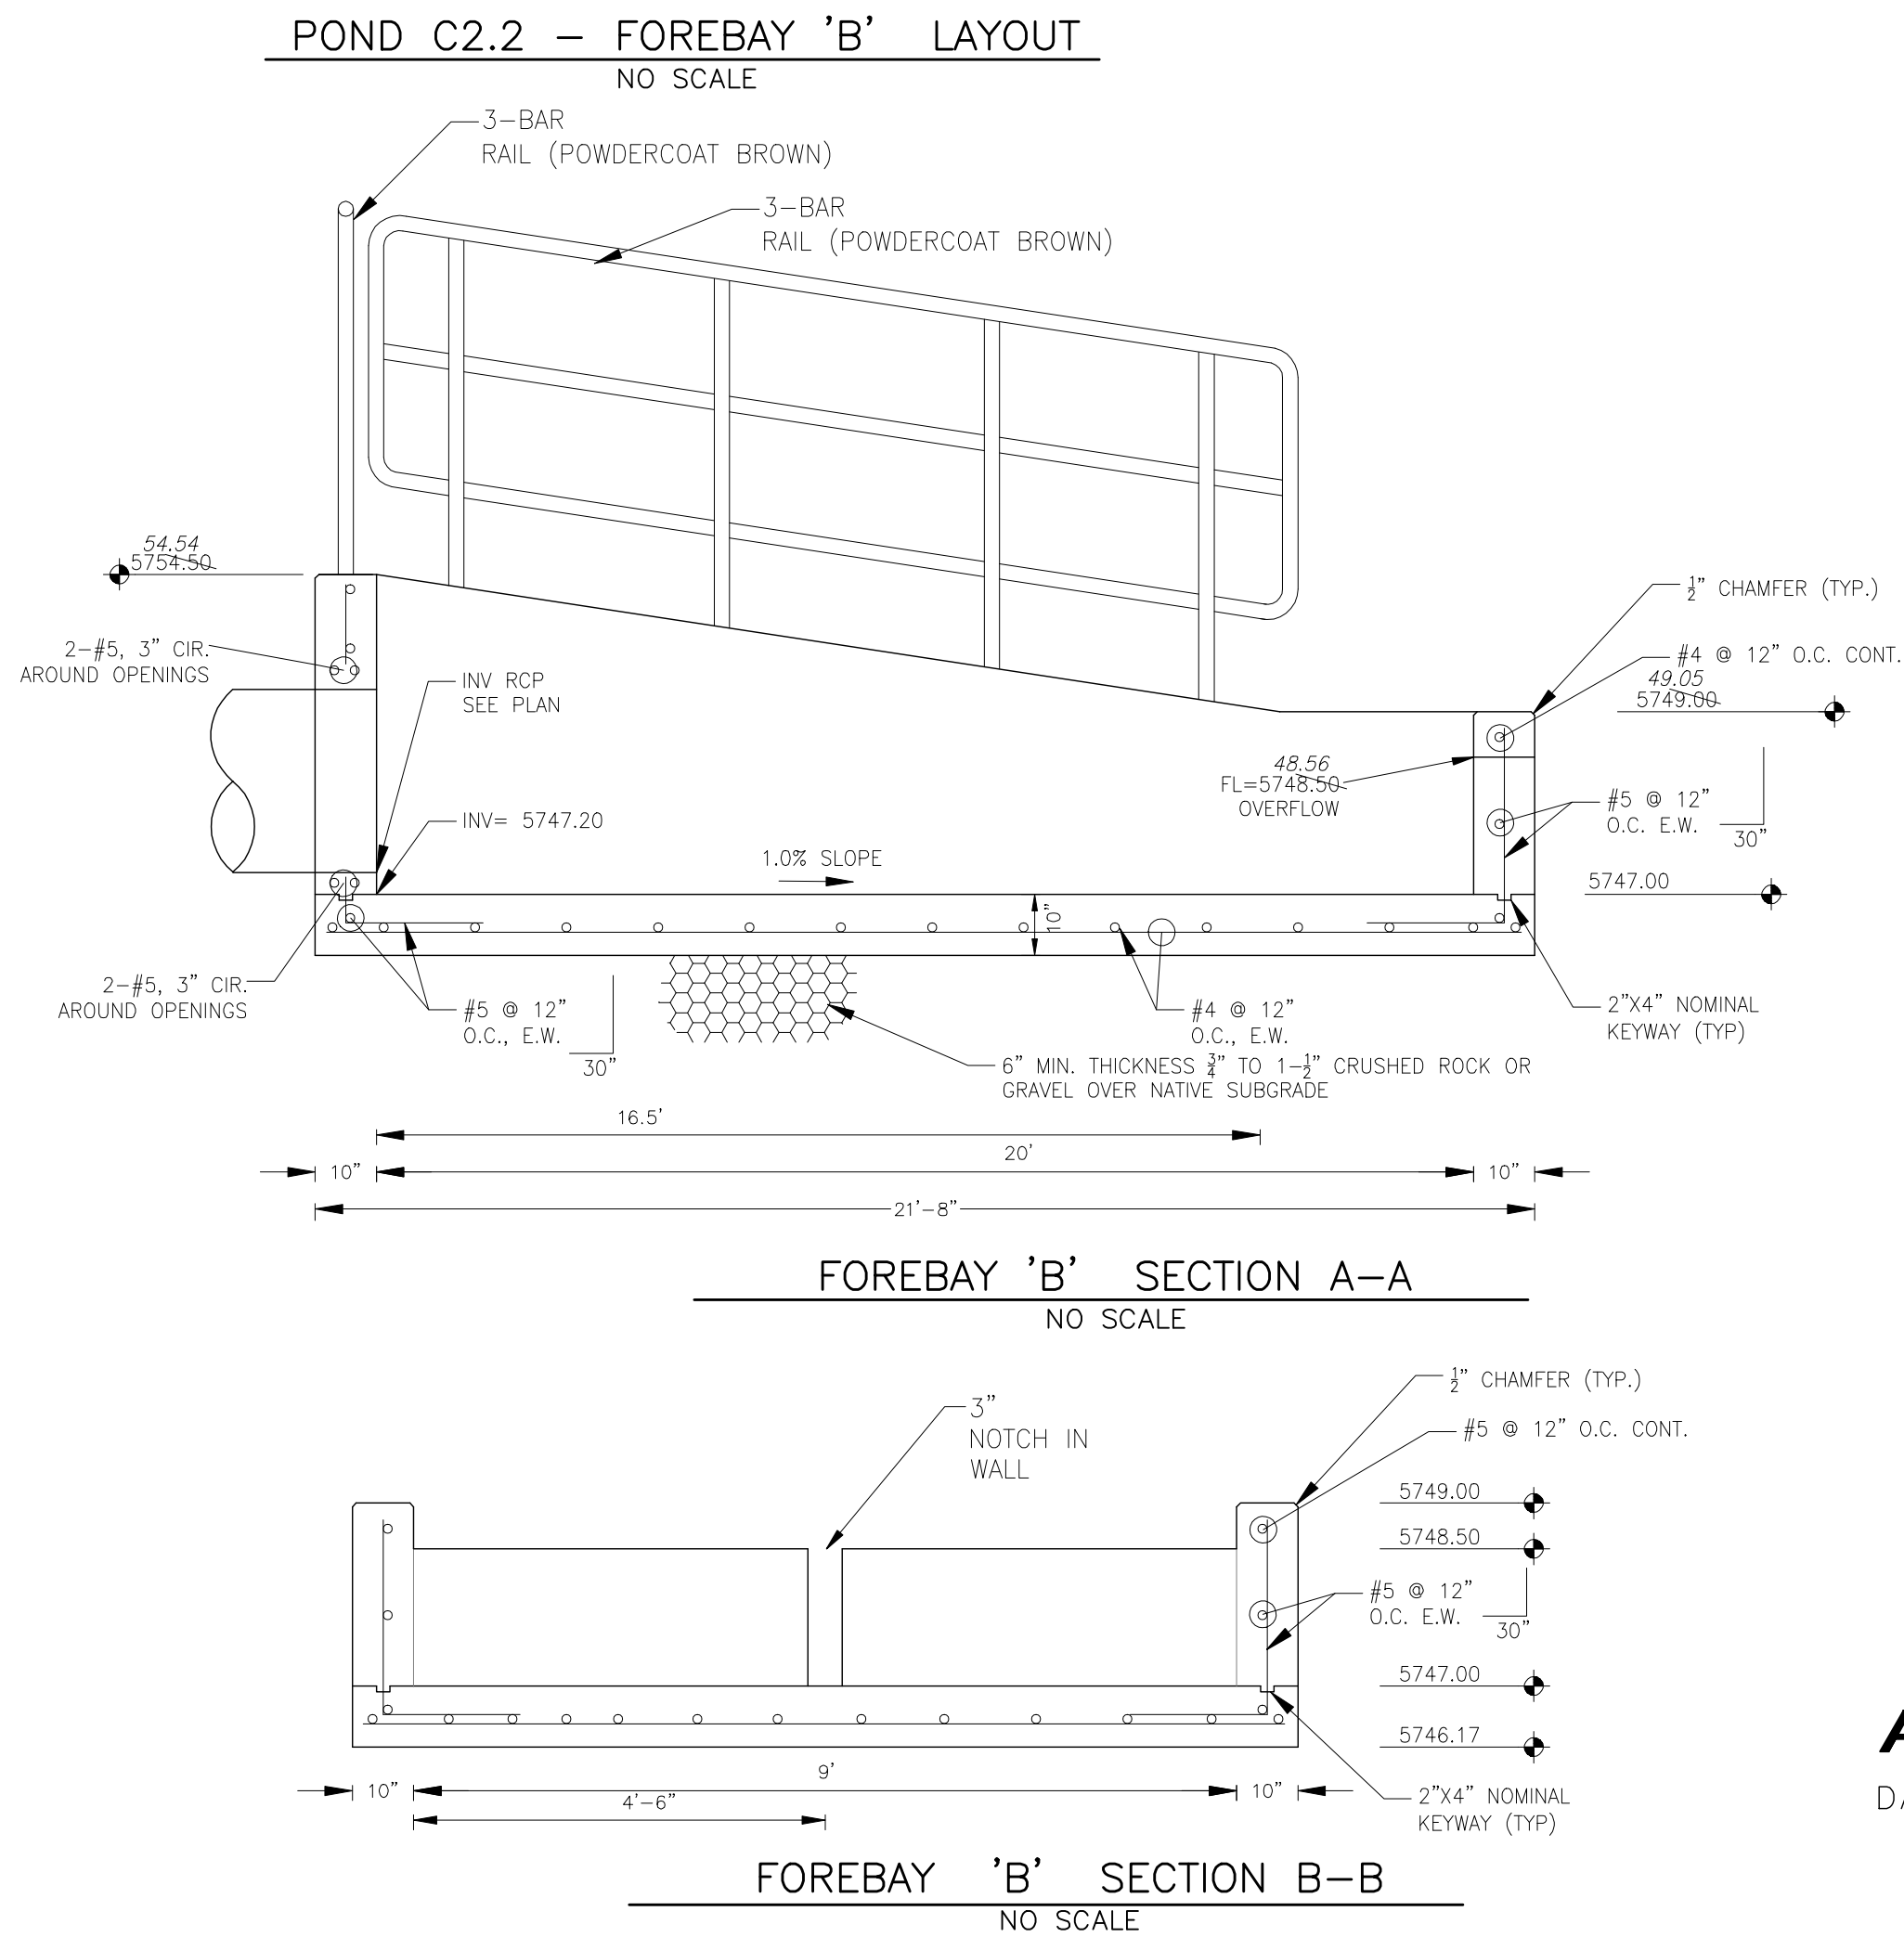

AS-BUILT
DATE: 09/30/2022

CORE
ENGINEERING GROUP

15004 13TH AVENUE S.
BURNHELM, CO 80903
CONTACT: RICHARD L. SCHINDLER, P.E.
EMAIL: Rich@ceg1.com

DATE

DESCRIPTION

NO.

PROJECT:
THE HILLS COLLECTOR
STREET CONSTRUCTION
FONTAINE BLVD. - GRAYLING DR
LORSON BLVD - WALLEYE DR - LAMPREY DR
COLORADO SPRINGS, COLORADO

PREPARED FOR:
LORSON, LLC
212 N. WAHSATCH AVE. SUITE 301
COLORADO SPRINGS, COLORADO 80903
CONTACT: JEFF MARK

DRAWN: RLS
DESIGNED: RLS
CHECKED: RLS

NOV 12, 2020

PROJECT NO.
100.061

SHEET NUMBER
C9.6

TOTAL SHEETS: 58

COLORADO REGISTERED
PROFESSIONAL ENGINEER
33997
2022-21-11

DATE:
NOV 12, 2020



PROJECT NO.
100.061

SHEET NUMBER
C9.6



TOTAL SHEETS: 58

- NOTES
1. ALL SPOT ELEVATIONS ARE FLOW LINE UNLESS OTHERWISE NOTED.
 2. SEE EARLY GRADING PLAN FOR GRADING INFORMATION.
 3. ALL STORM SEWER SHALL BE CLASS III RCP.
 4. ALL MHS SHALL BE TYPE 1 UNLESS OTHERWISE NOTED.

- 1 CURVE DATA ID
- 2 PEDESTRIAN RAMP, SEE SHEET C10.1
- 3 CURB/GUTTER FLOW LINE POINTS

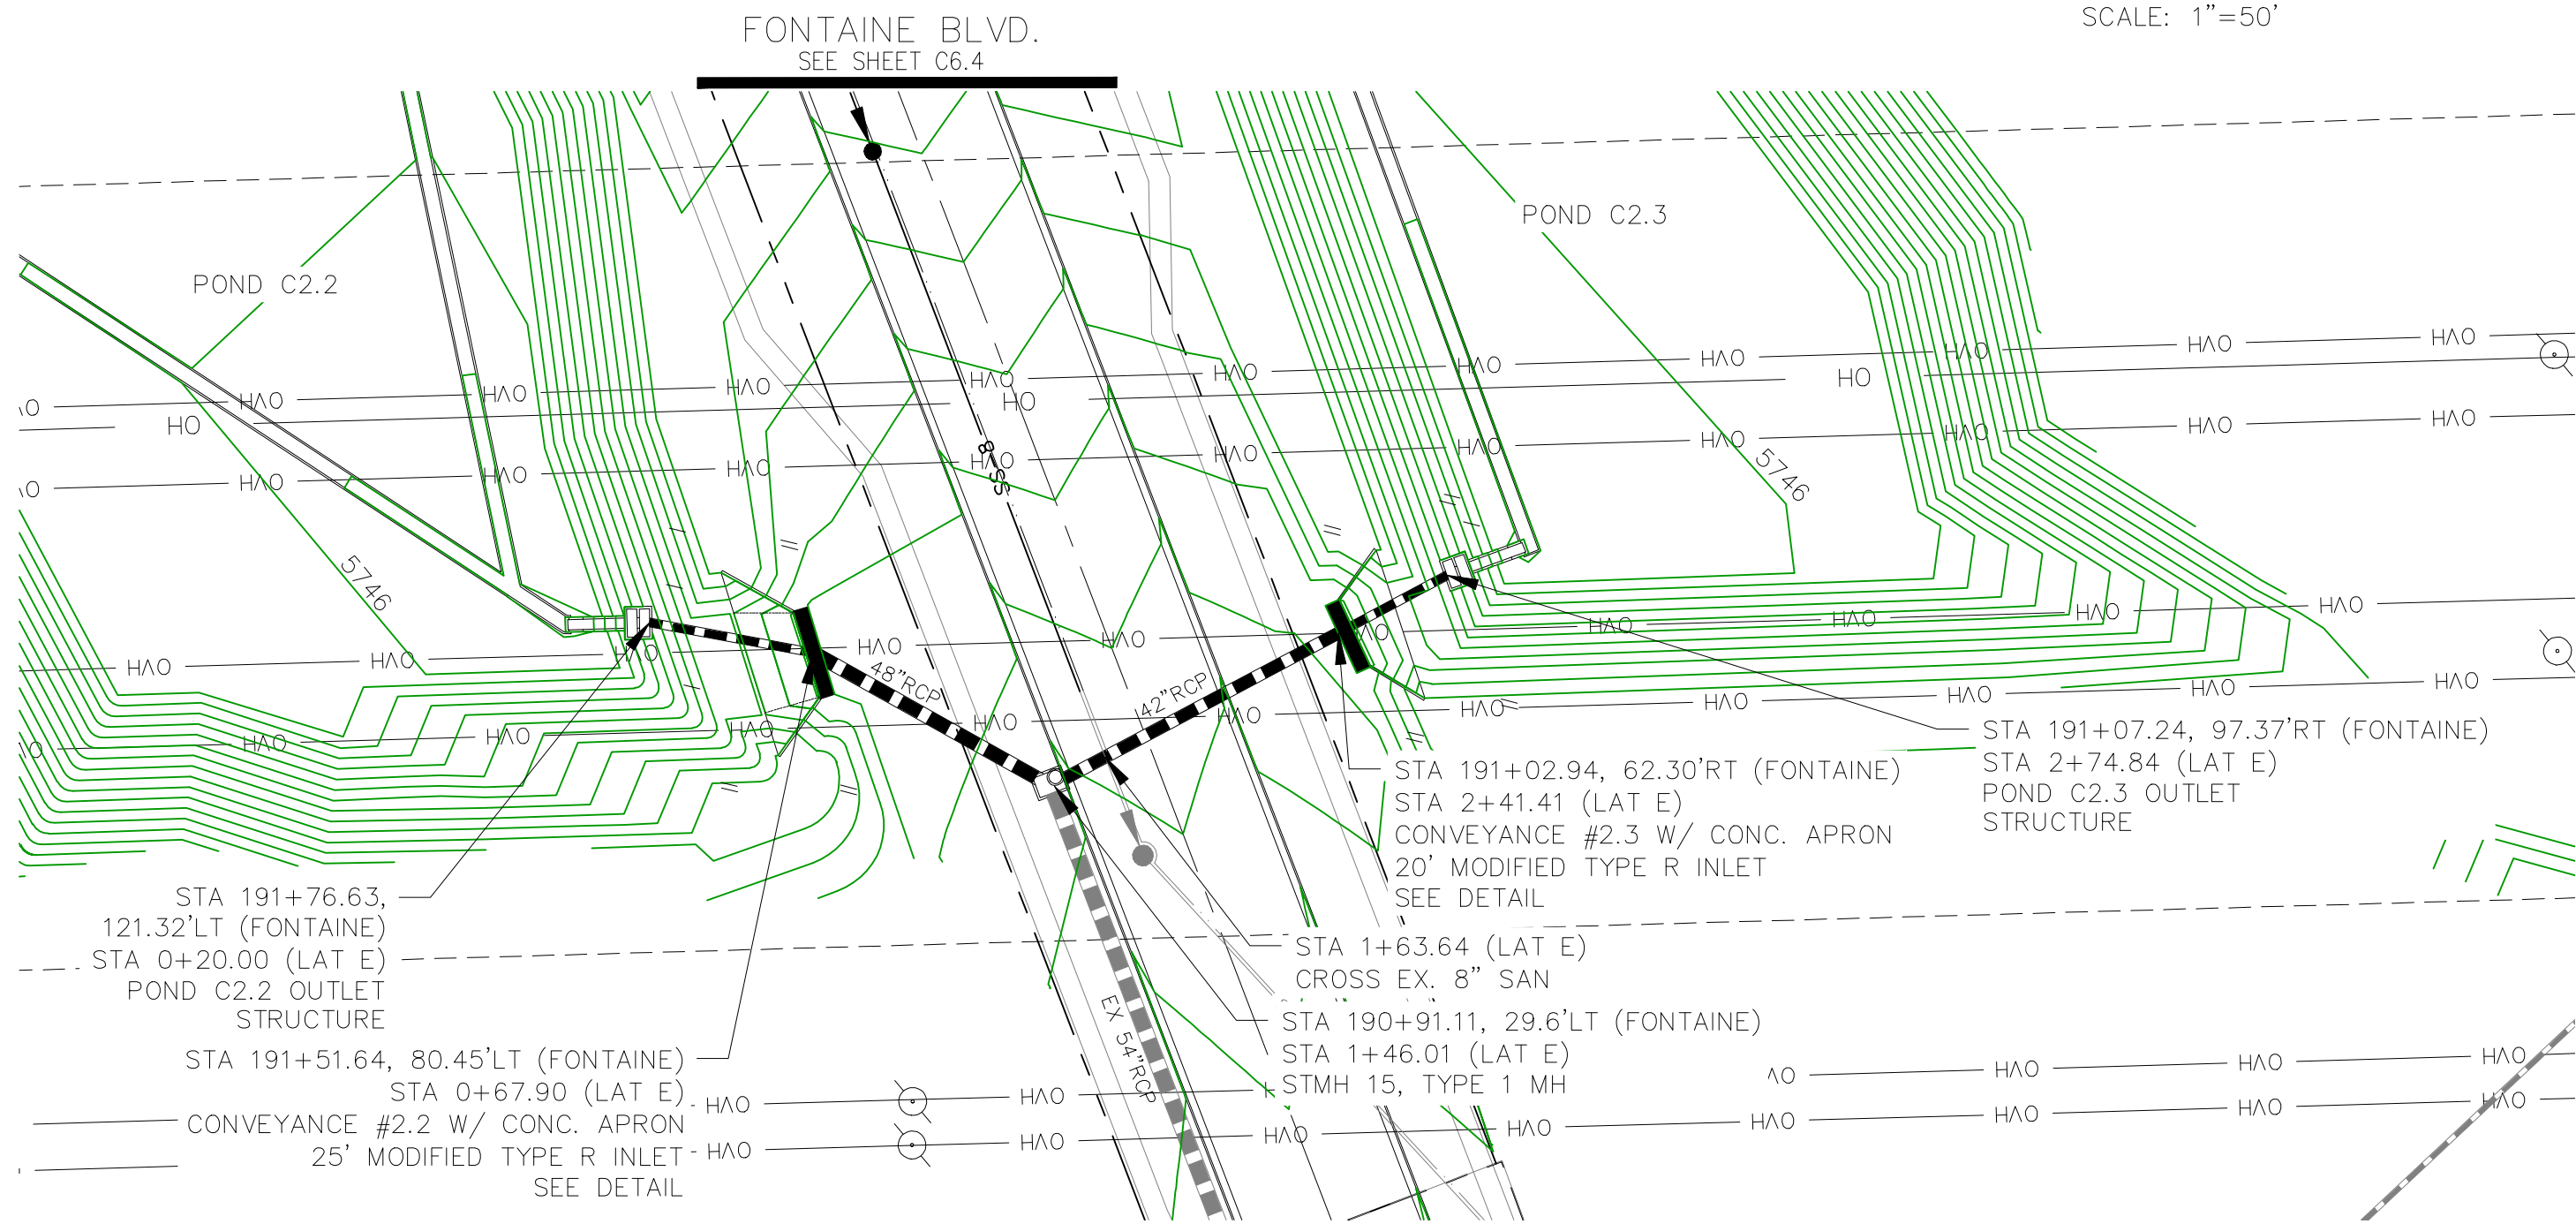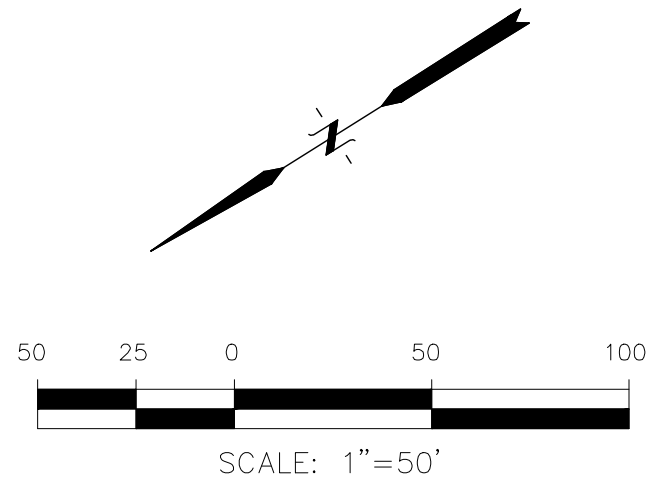


STORM LATERAL 'E'

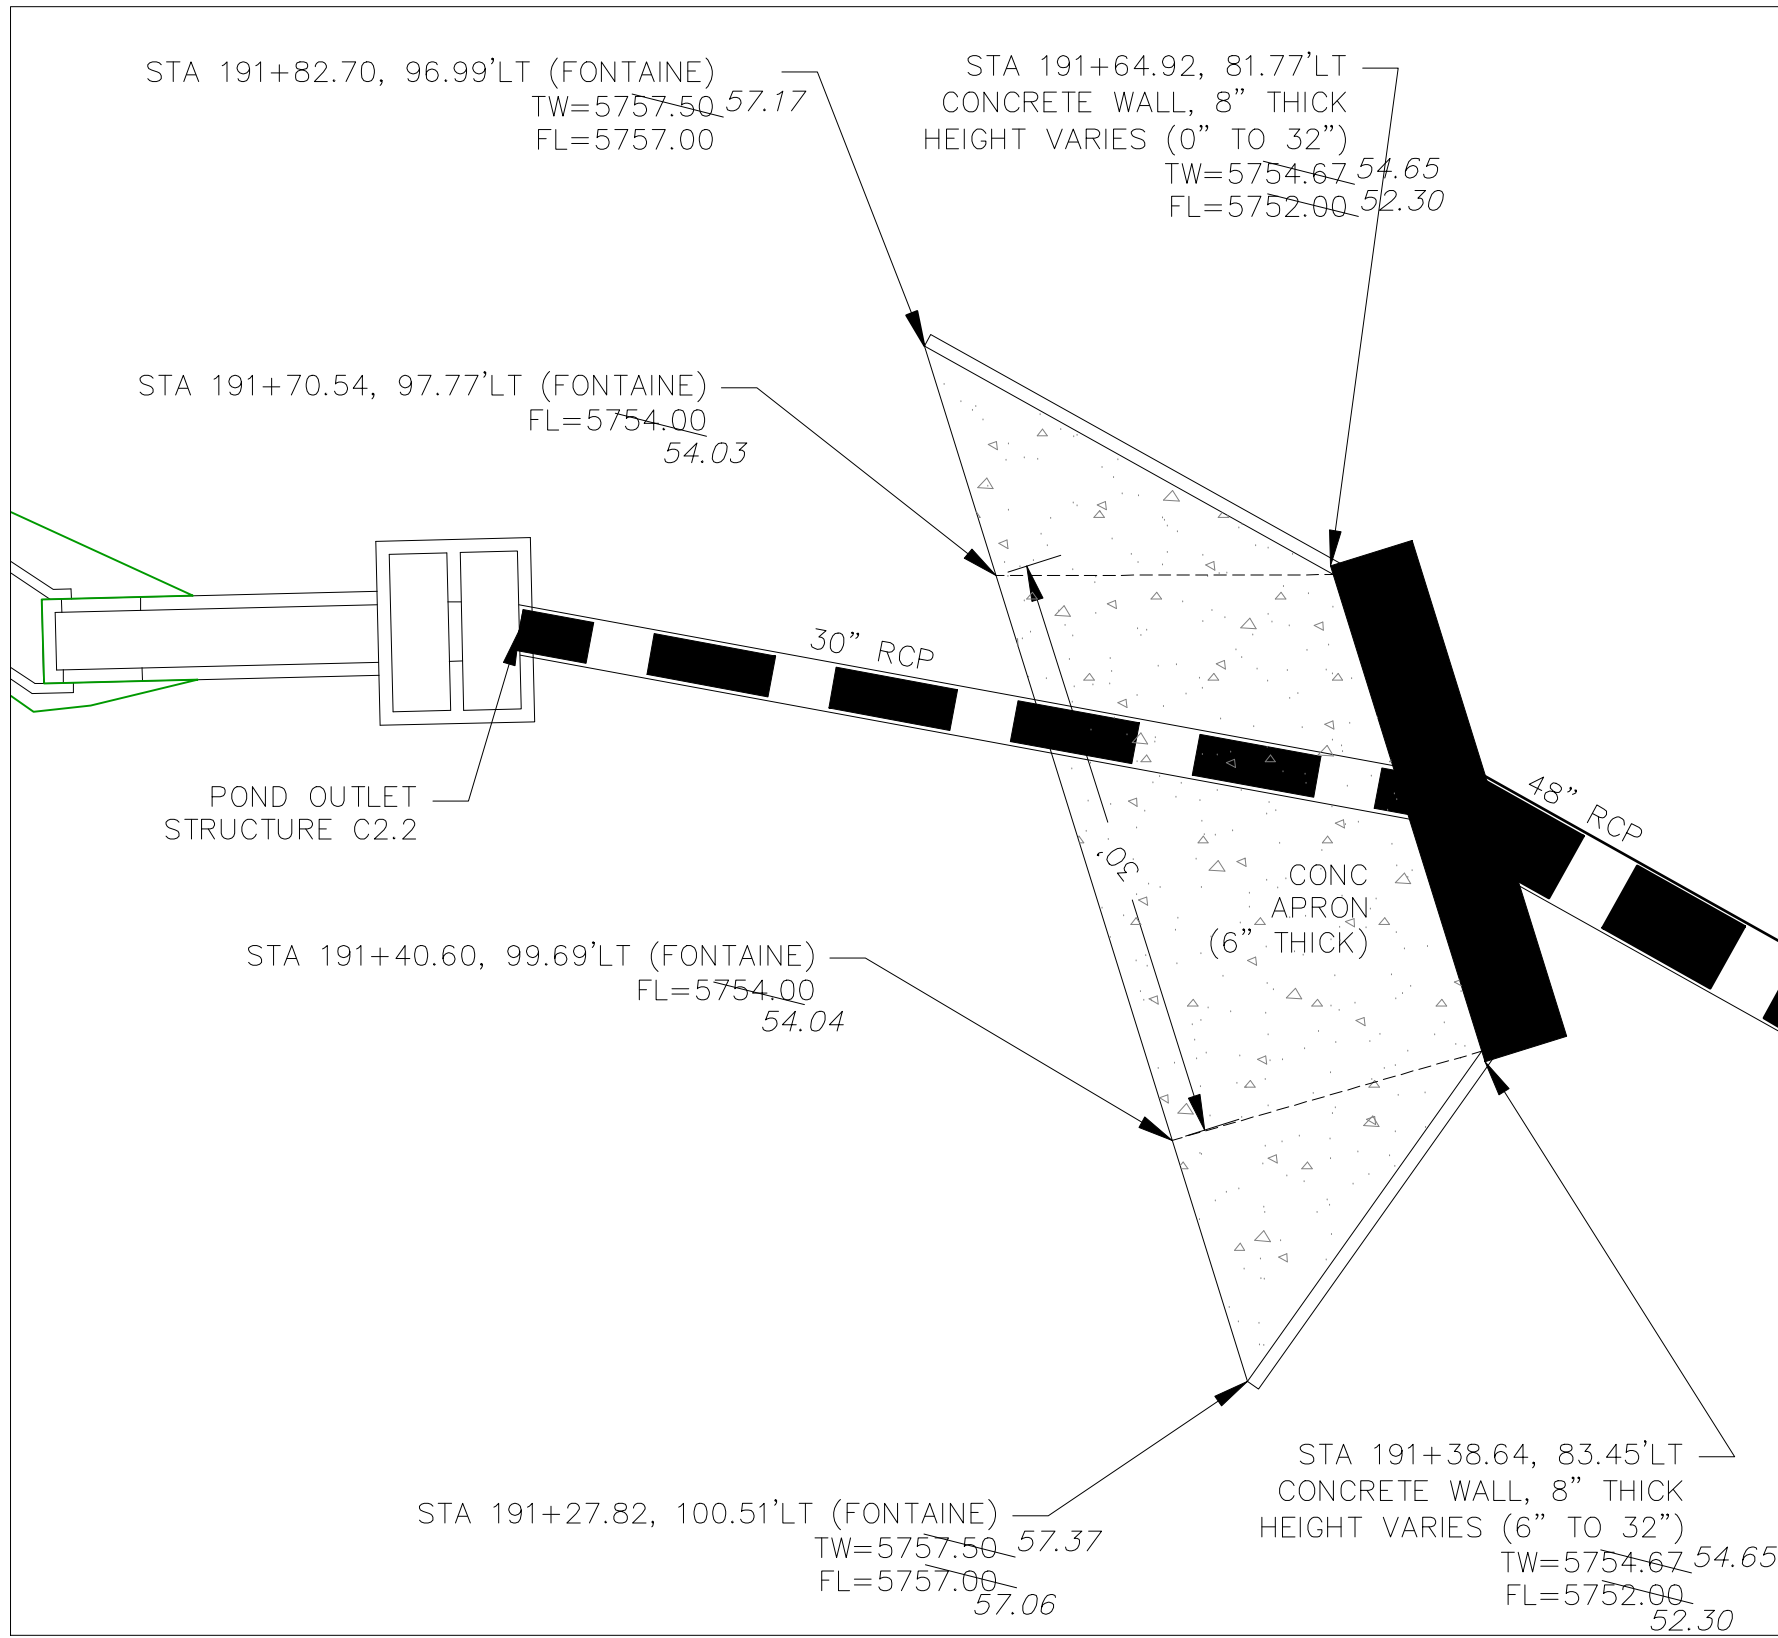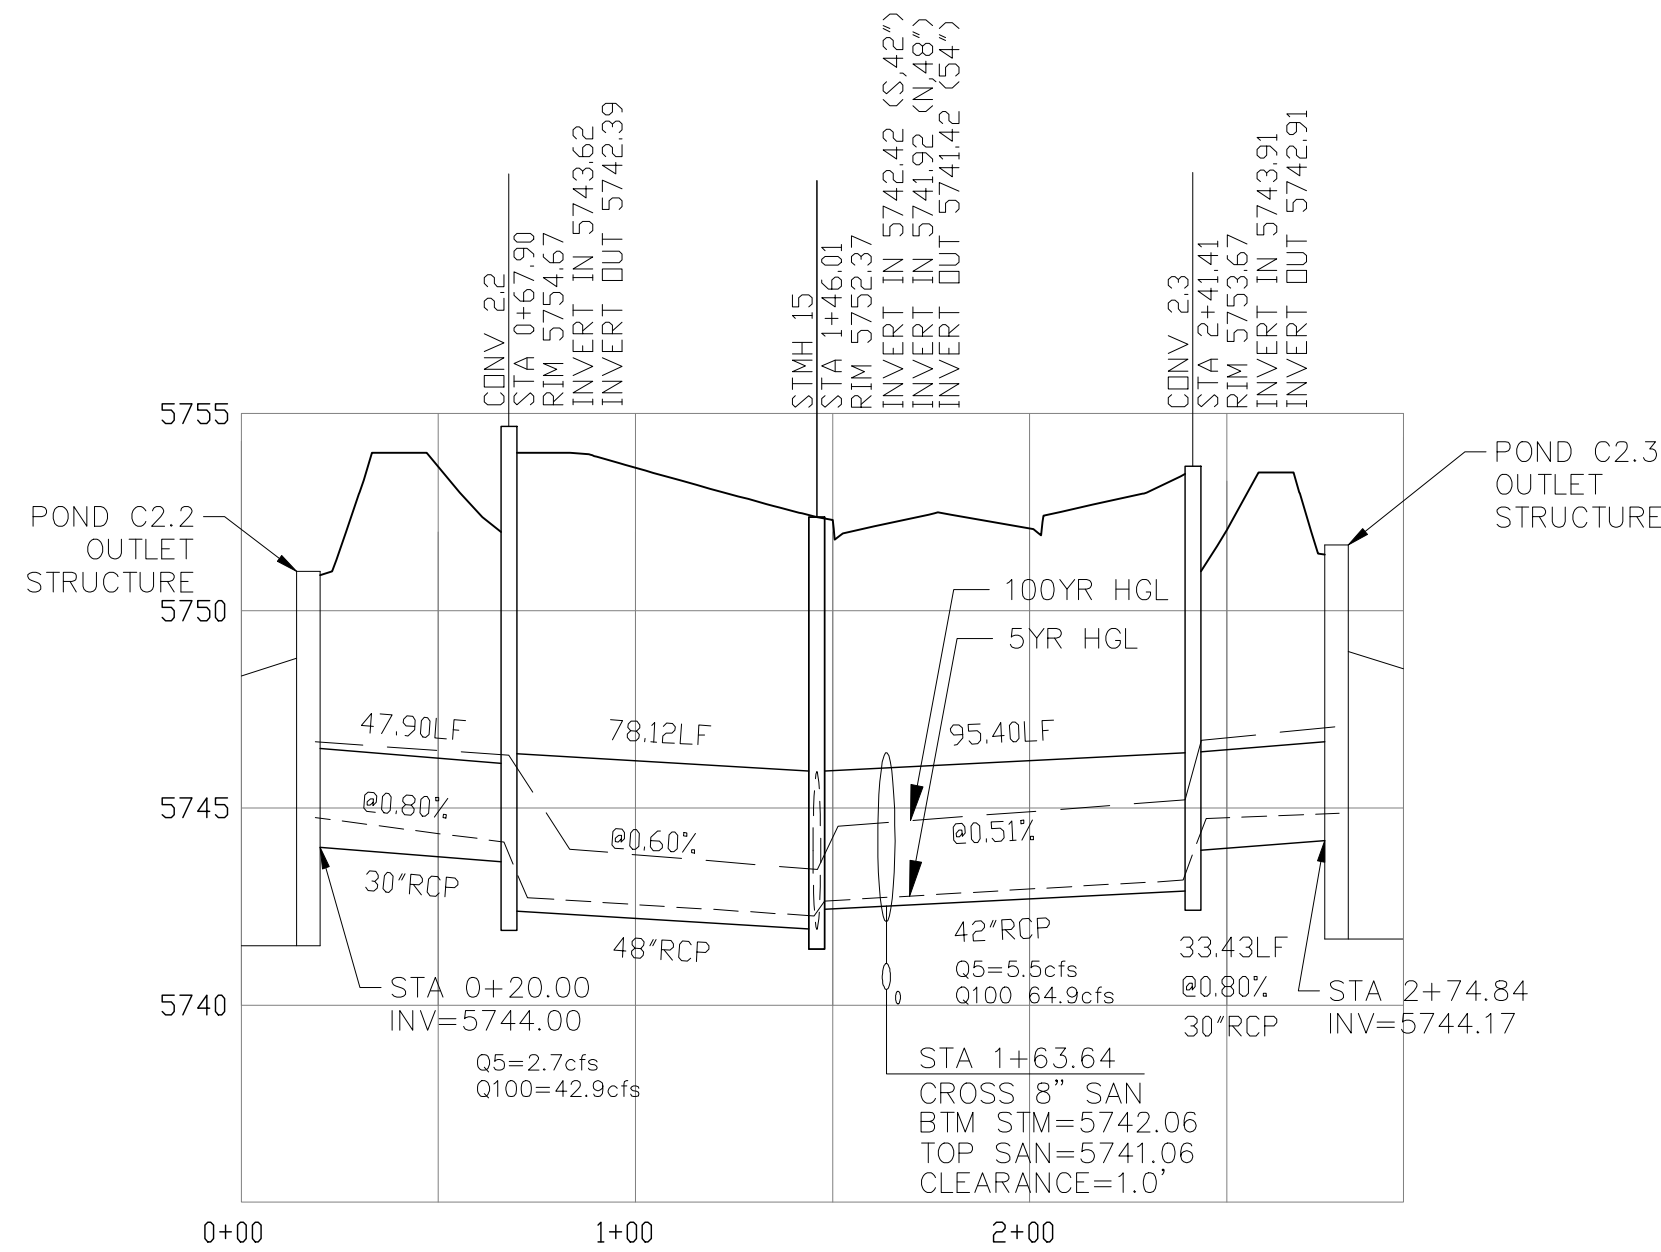

CONVEYANCE STRUCTURE #2.2


SCALE: 1"=10'

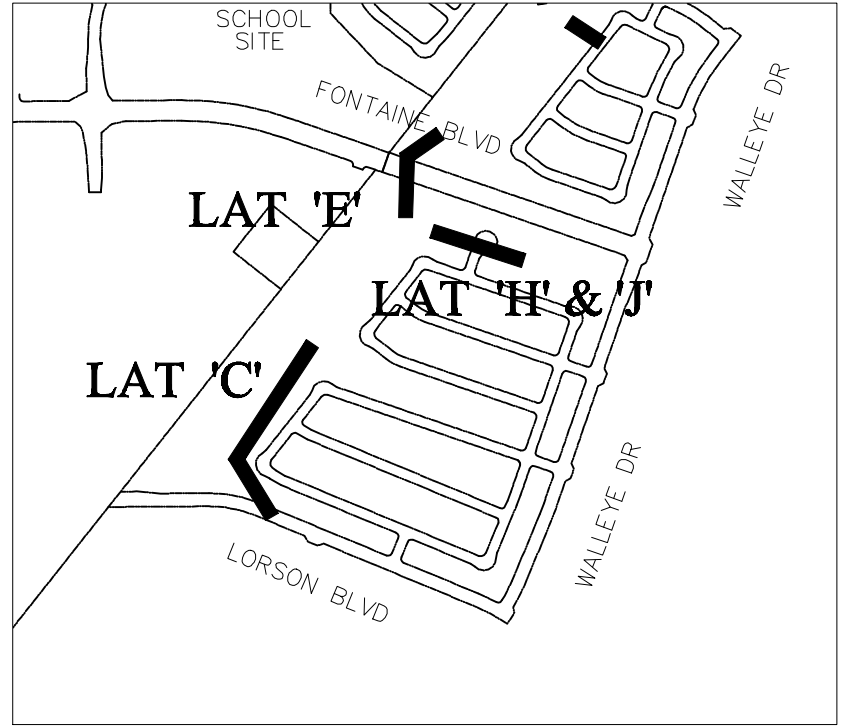

KEY MAP

CONVEYANCE STRUCTURE #2.2 NOTES:

1. 25' CDOT TYPE R INLET WITH MODIFIED THROAT OPENING
2. THROAT OPENING = 24"
3. EXTEND 1.25" GALVANIZED STEEL ROD SUPPORTS (TYPE R INLET) TO ACCOMMODATE 24" THROAT OPENING
4. CONCRETE APRON TO BE REINFORCED WITH NO. 4 REBAR, 24" O.C. BOTH WAYS. REBAR TO EXTEND INTO CONCRETE WALL W/ NO. 4 "L" BARS, 18" O.C.
5. CONCRETE WALLS SHALL HAVE A MINIMUM OF TWO HORIZONTAL NO. 4 BARS
6. 24" THROAT OPENING TO INCLUDE SAFETY GRATE.

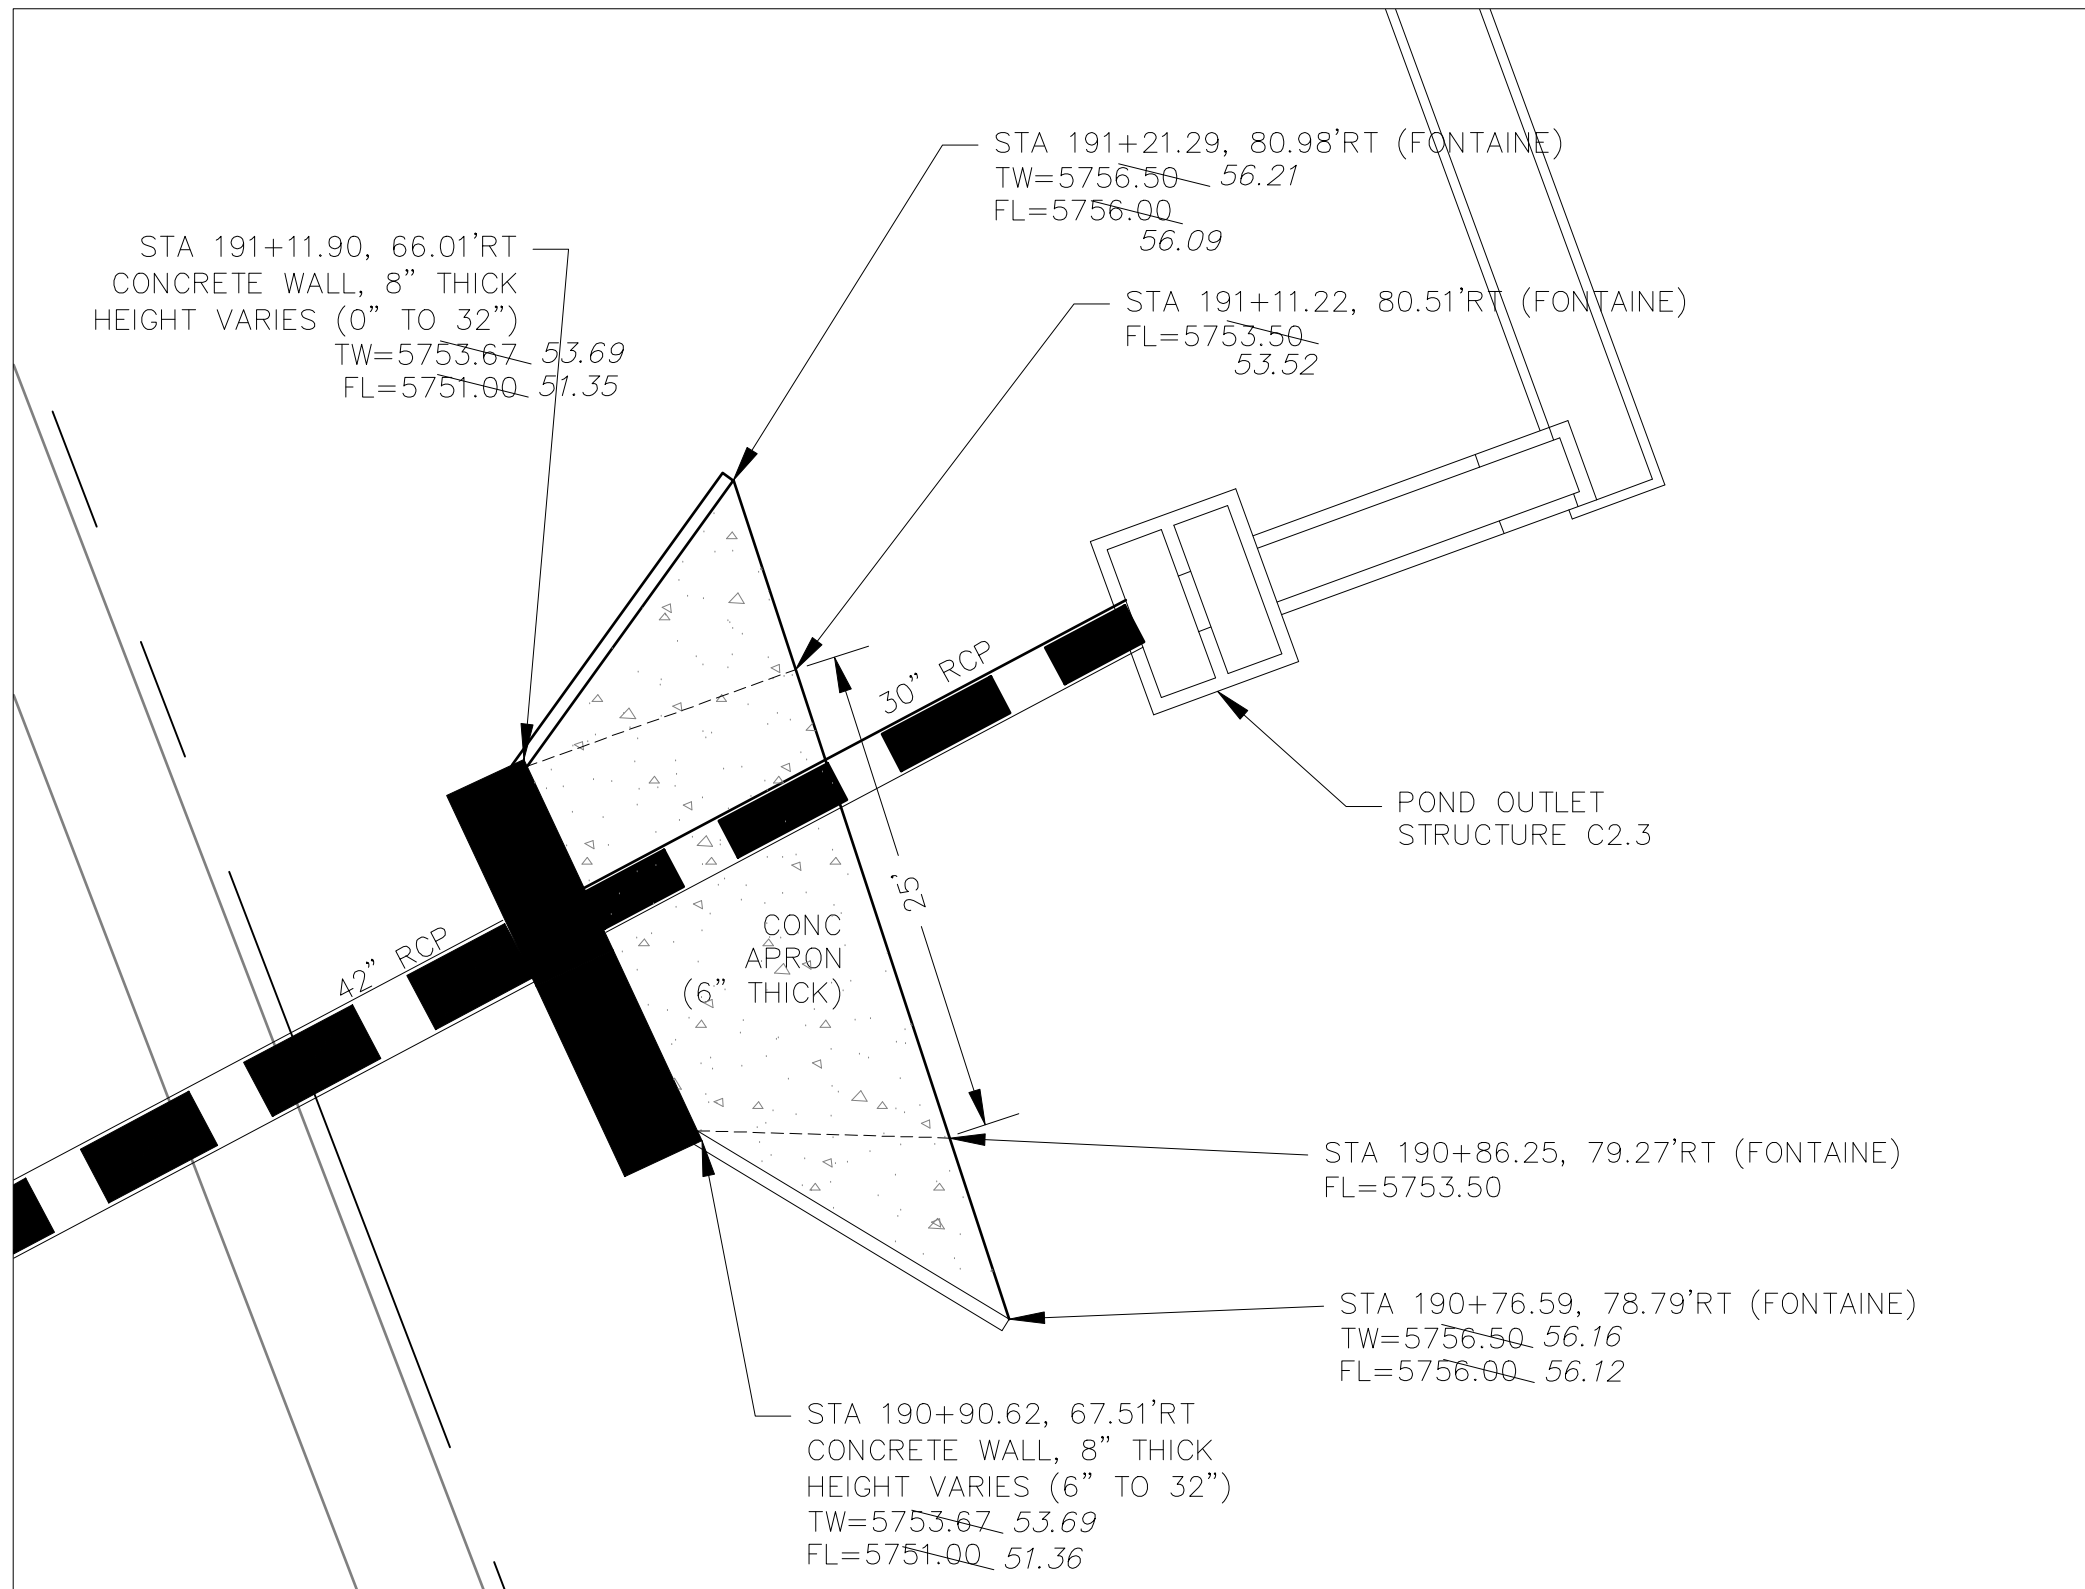

CONVEYANCE STRUCTURE #2.3


SCALE: 1"=10'

CONVEYANCE STRUCTURE #2.3 NOTES:


1. 20' CDOT TYPE R INLET WITH MODIFIED THROAT OPENING
2. THROAT OPENING = 24"
3. EXTEND 1.25" GALVANIZED STEEL ROD SUPPORTS (TYPE R INLET) TO ACCOMMODATE 24" THROAT OPENING
4. CONCRETE APRON TO BE REINFORCED WITH NO. 4 REBAR, 24" O.C. BOTH WAYS. REBAR TO EXTEND INTO CONCRETE WALL W/ NO. 4 "L" BARS.
5. CONCRETE WALLS SHALL HAVE A MINIMUM OF TWO HORIZONTAL NO. 4 BARS
6. 24" THROAT OPENING TO INCLUDE SAFETY GRATE.

AS-BUILT




DATE: 09/30/2022

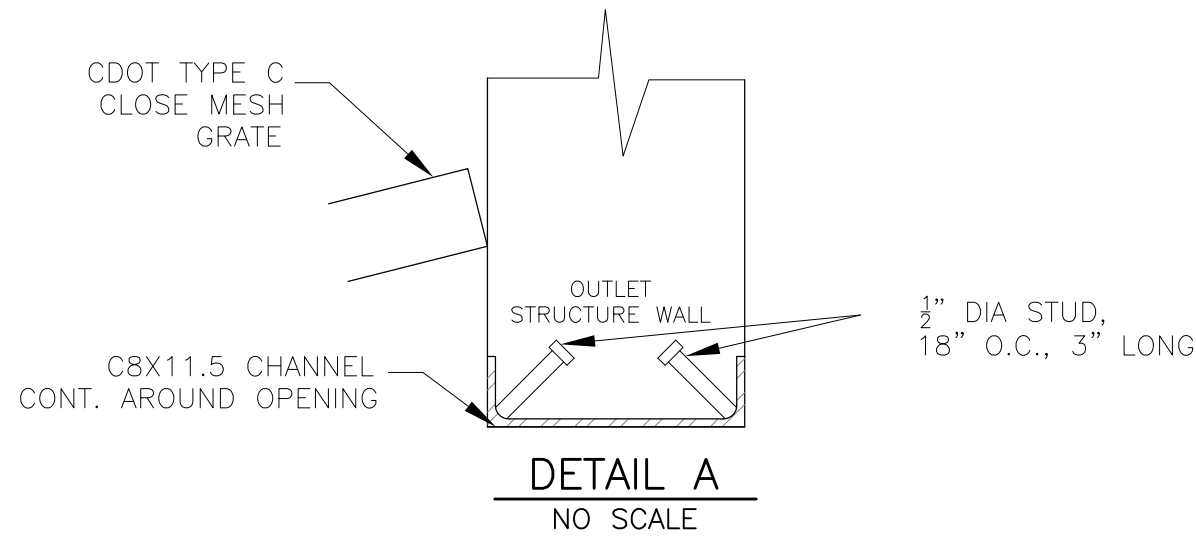


NOTE:
AFTER CONCRETE STRUCTURE HAS BEEN POURED
ALL GRATE DIMENSIONS SHALL BE FIELD VERIFIED
PRIOR TO GRATE CONSTRUCTION

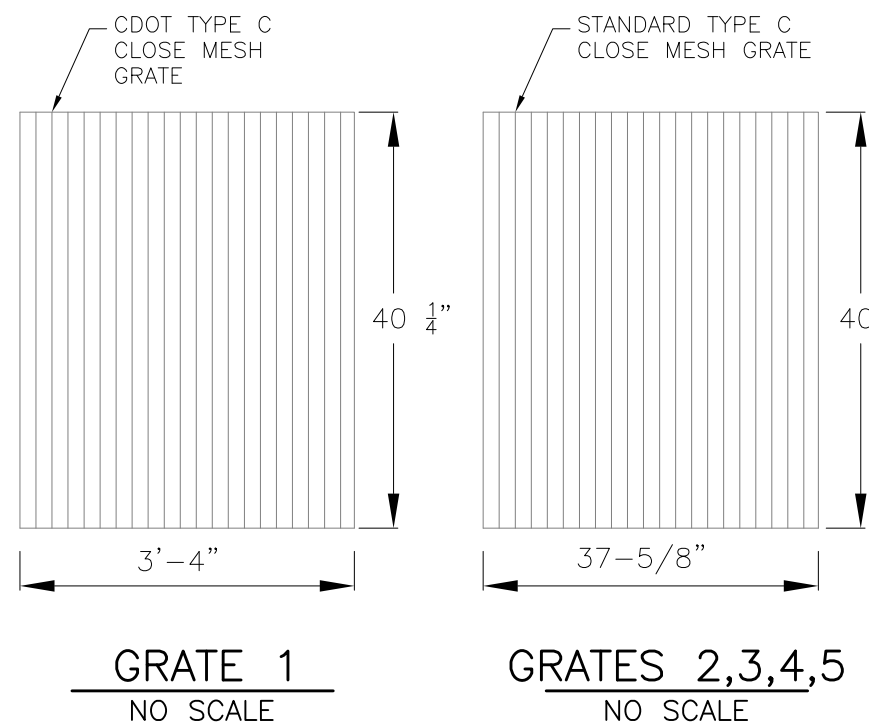

GRATES 2,3,4,5
NO SCALE

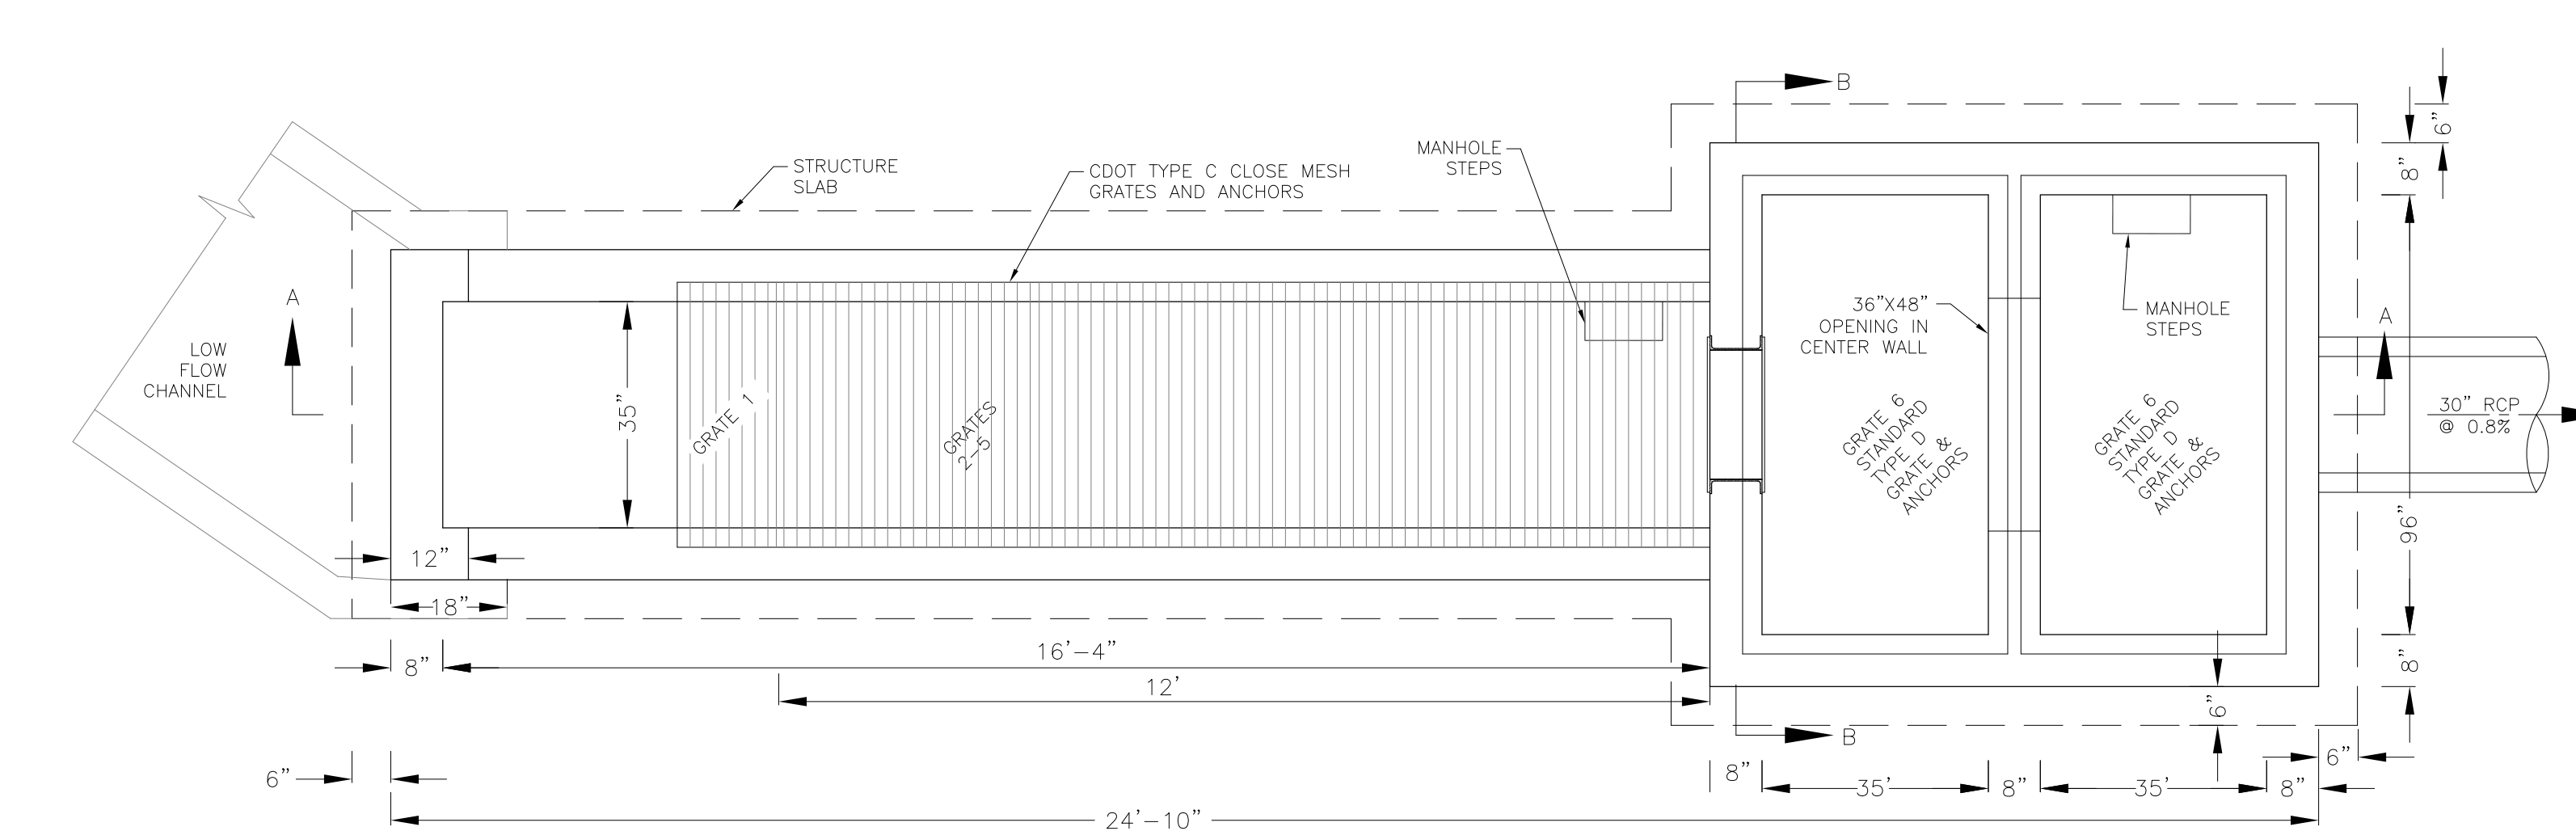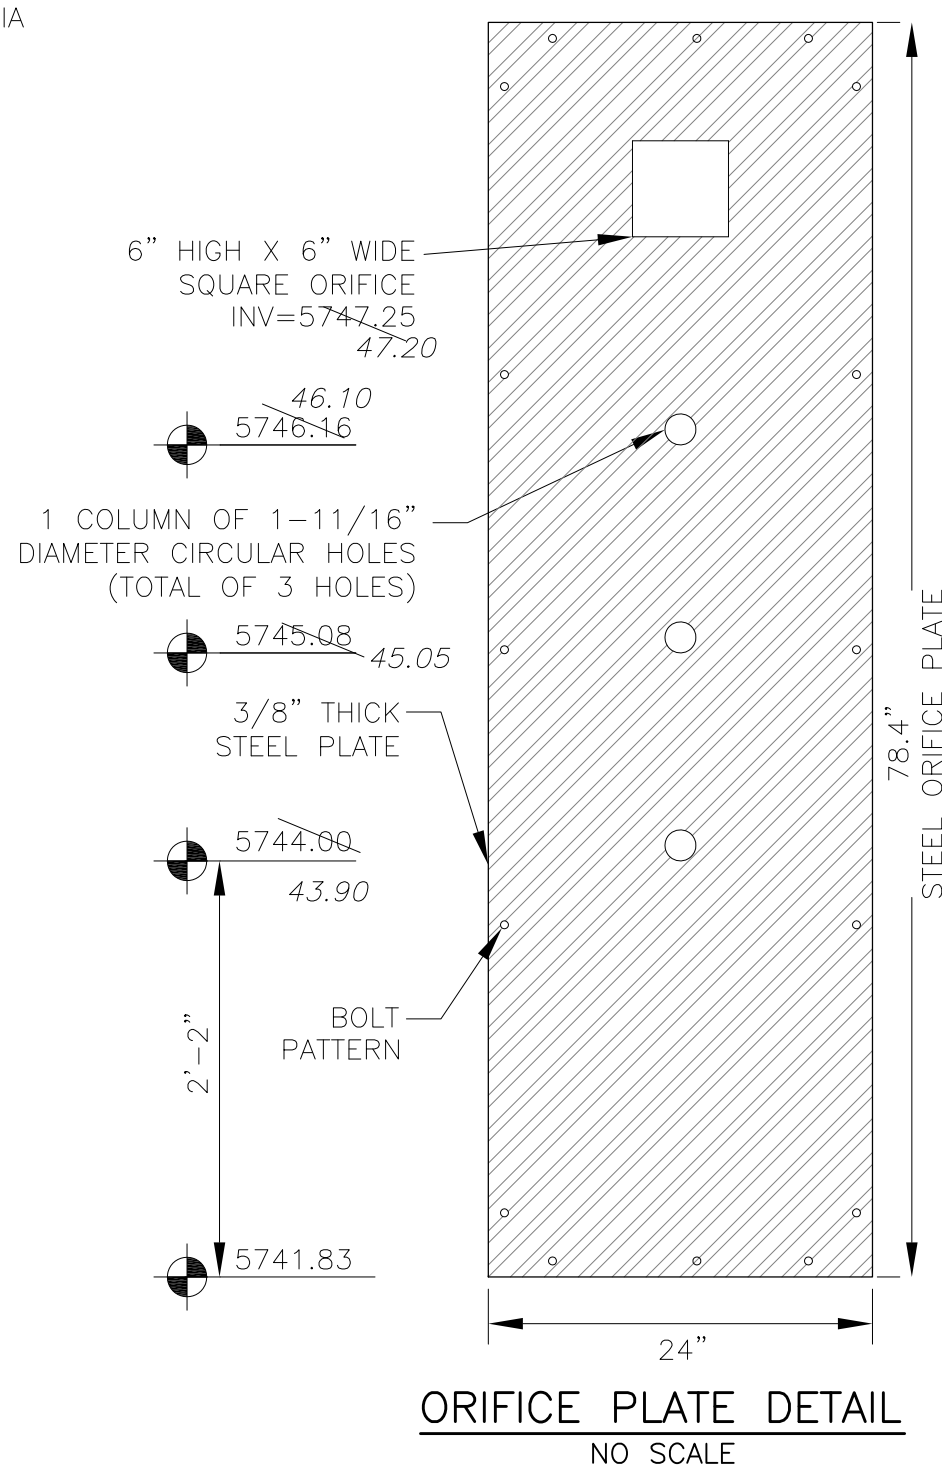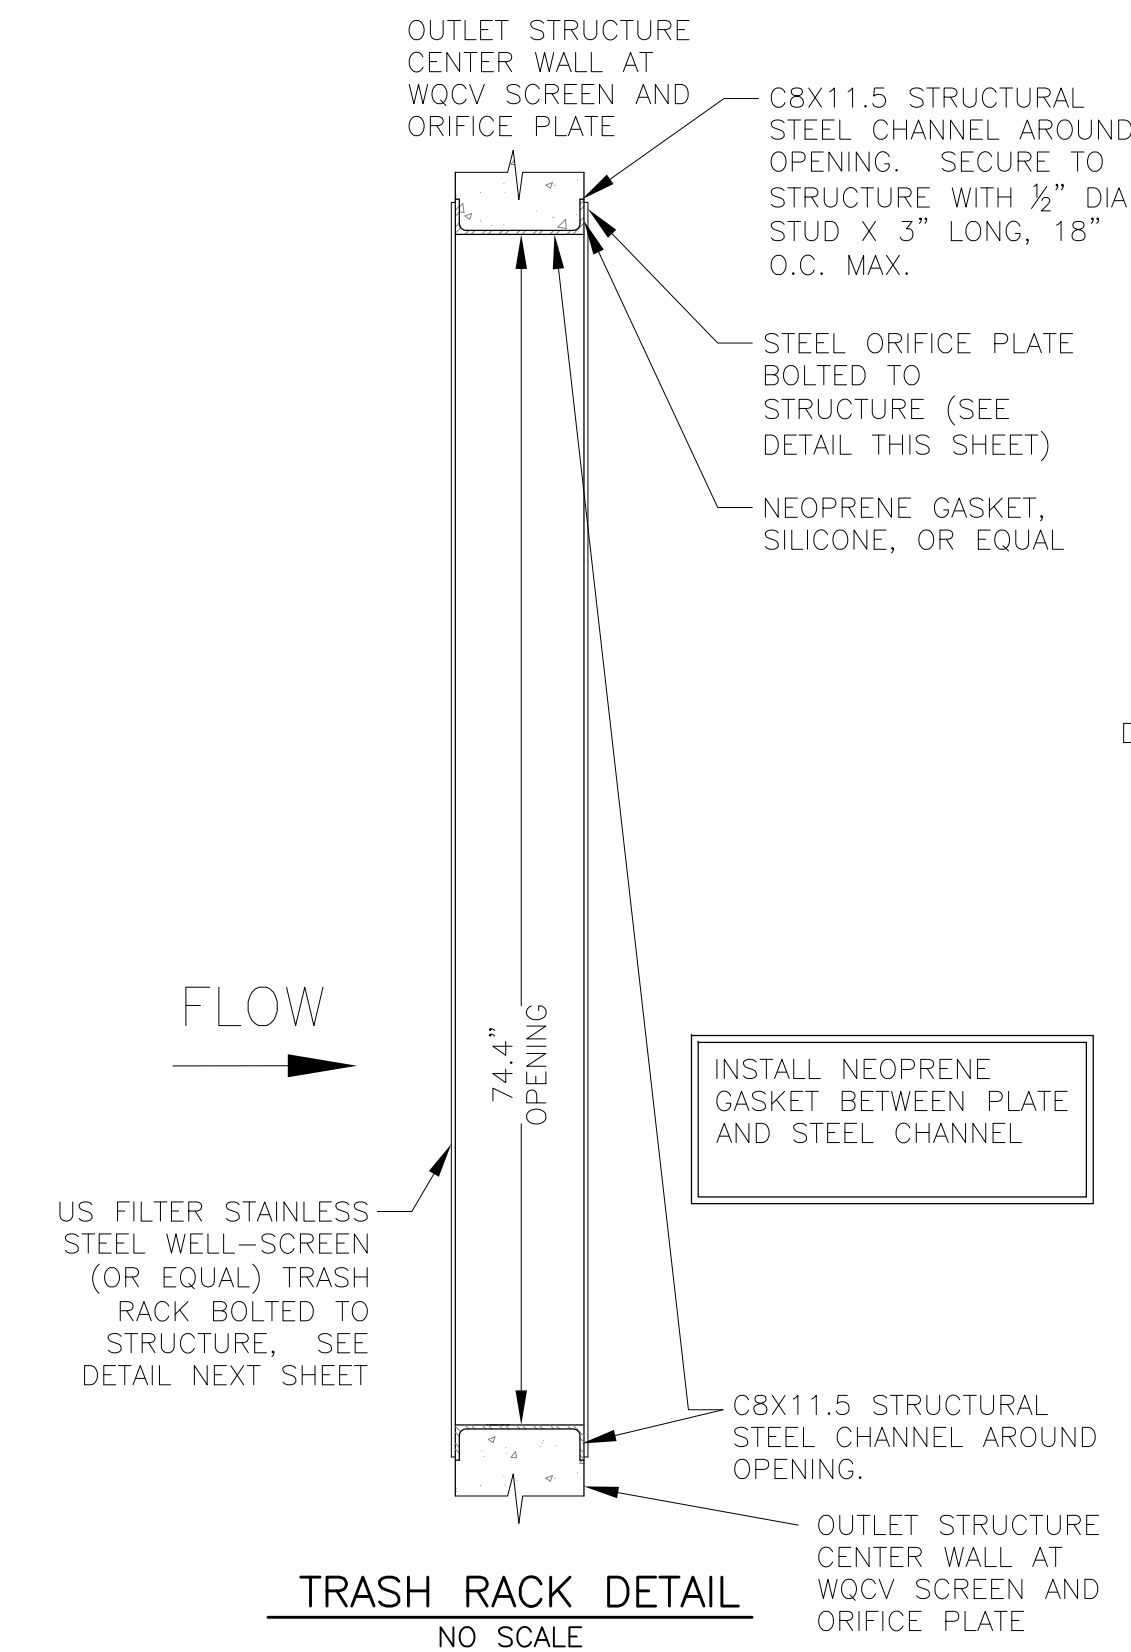

OUTLET STRUCTURE DETAIL - PLAN VIEW
NO SCALE

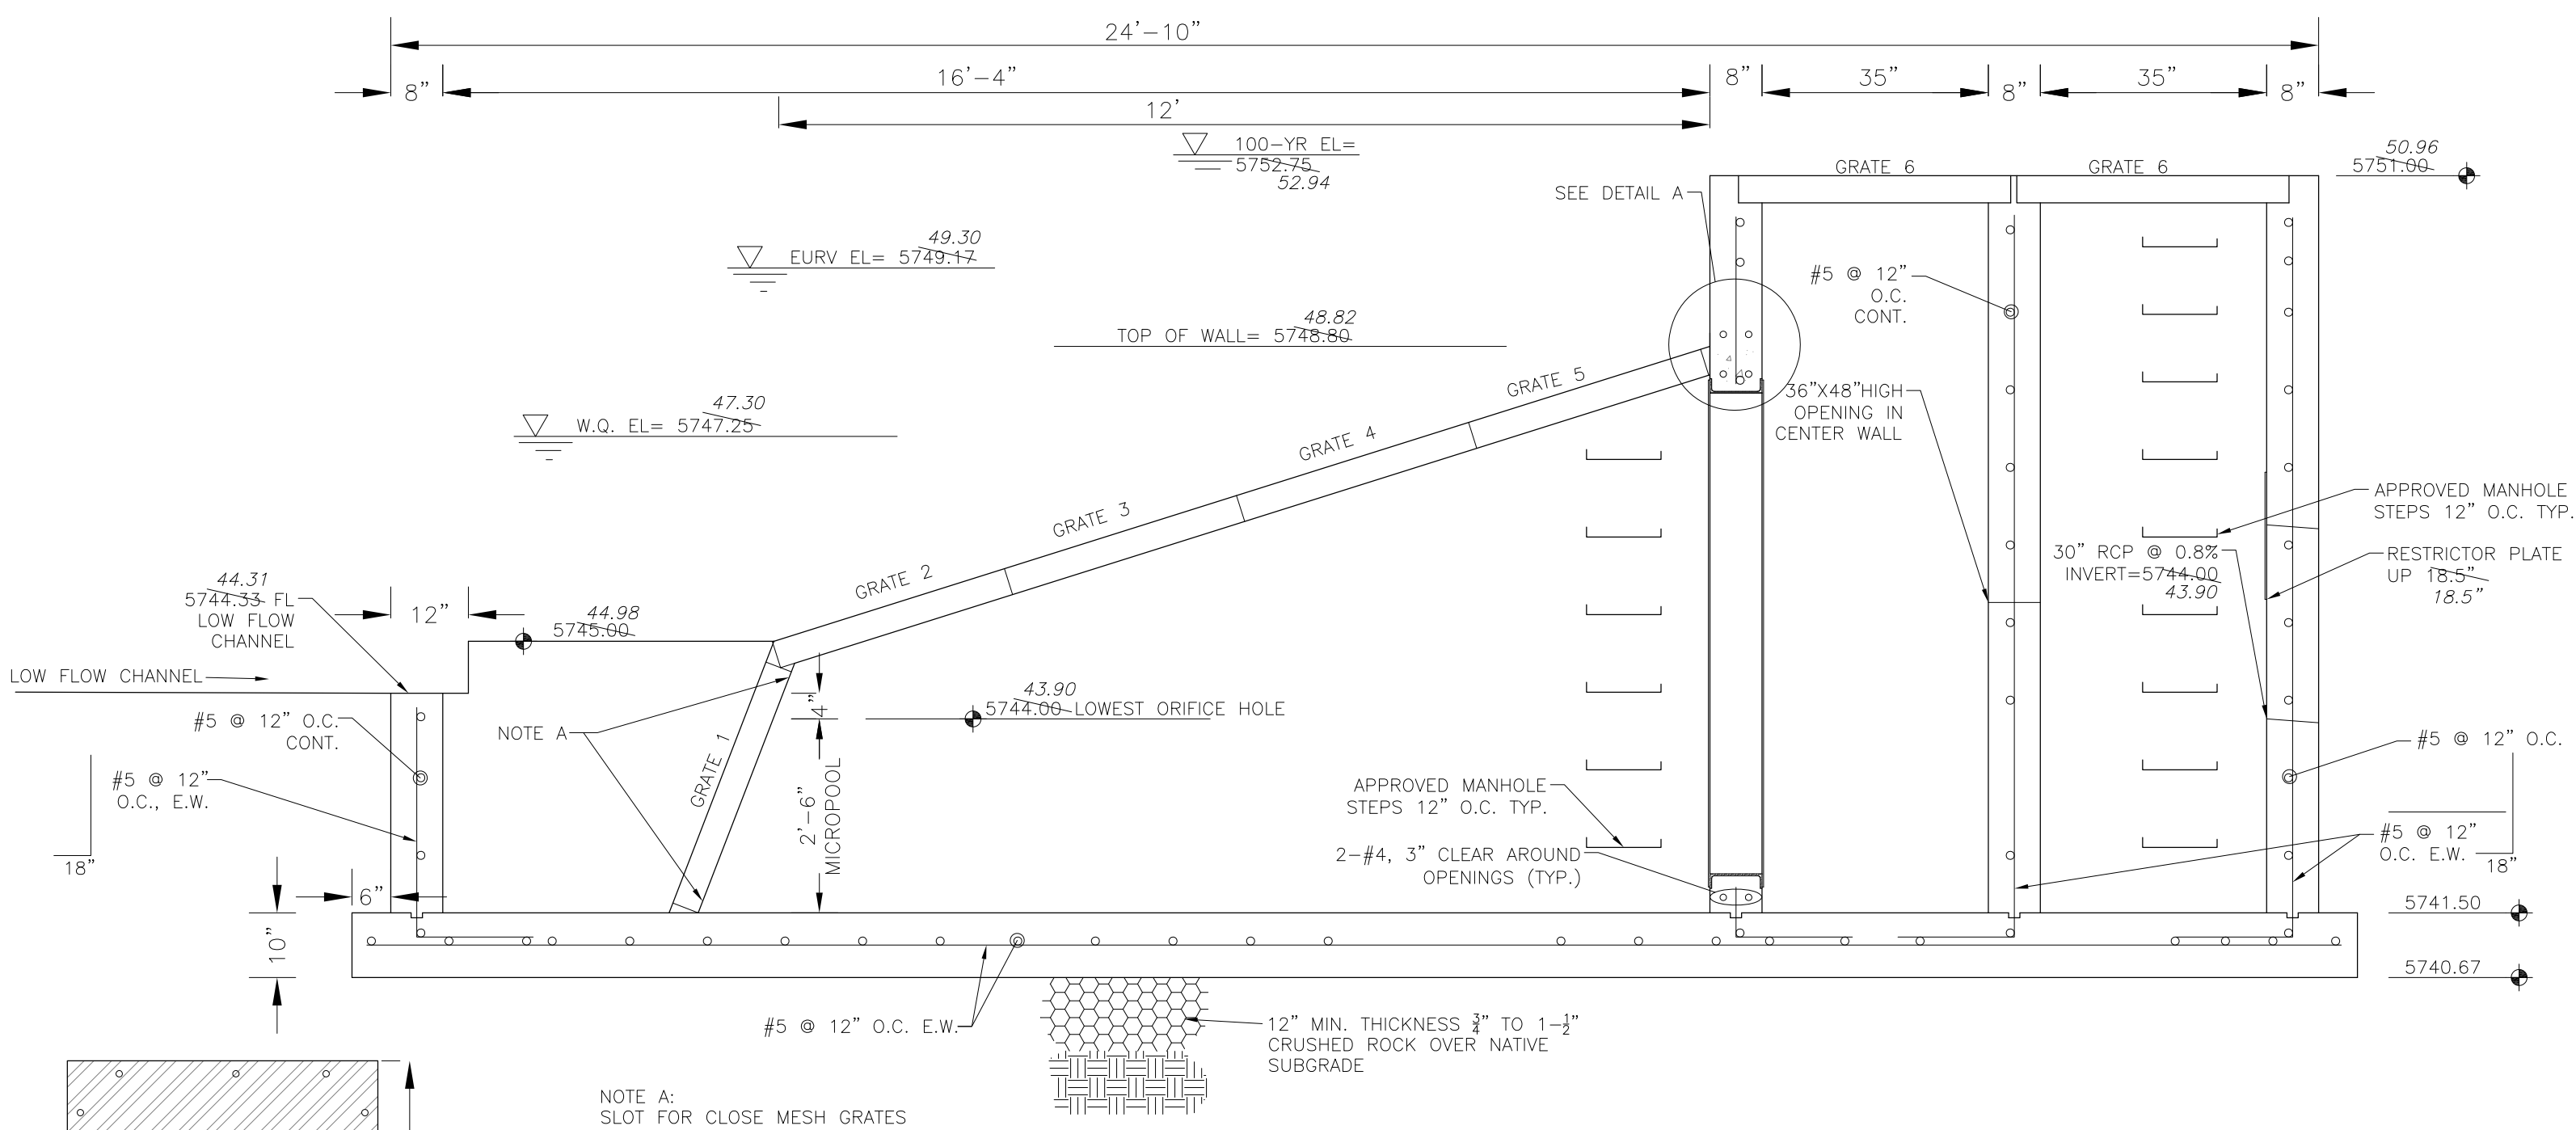

OUTLET STRUCTURE DETAIL - SECTION A-A
NO SCALE


OUTLET STRUCTURE, FOREBAY, AND DRAIN CHANNEL NOTES:

1. PRIOR TO CONSTRUCTION, CONTRACTOR SHALL PROVIDE SHOP DRAWINGS FOR ALL COMPONENTS OF THE OUTLET STRUCTURE.
2. GRADE 60 REINFORCING STEEL REQUIRED. SEE TABLE FOR THE MINIMUM LAP SPLICE LENGTH FOR REINFORCING BARS. ALL REINFORCING STEEL SHALL HAVE A TWO-INCH MINIMUM CLEARANCE FROM EDGE OF CONCRETE, UNLESS OTHERWISE NOTED.
3. CONCRETE FOR THE OUTLET STRUCTURE AND FOREBAY SHALL BE CDOT CLASS D CONCRETE.
4. CONCRETE FOR DRAIN CHANNELS SHALL BE CDOT CLASS B CONCRETE
5. EXPANSION JOINT MATERIAL SHALL MEET AASHTO SPECIFICATION M-213. EXPANSION JOINT MATERIAL SHALL BE 1/2" THICK, SHALL EXTEND THE FULL DEPTH OF CONTACT SURFACE AND THE JOINT SHALL BE SEALED, REFER TO DETAILS.
6. ALL EXPOSED CONCRETE CORNERS SHALL HAVE A 3/8" CHAMFER UNLESS OTHERWISE NOTED.
7. SUBGRADE TO BE 12" THICK CLEAN FILL COMPACTED TO 95% STANDARD PROCTOR DENSITY PER ASTM M698 UNDER STRUCTURE.
8. REFER TO POND DETAILS FOR PRESEDIMENTATION/FOREBAY DESIGN.
9. ENGINEER SHALL BE NOTIFIED PRIOR TO BEGINNING CONSTRUCTION OF OUTLET STRUCTURE TO SCHEDULE OBSERVATION VISITS FOR STRUCTURES.


WQCV WELL-SCREEN NOTES:

1. Well-Screen shall be stainless steel and attached by stainless steel bolts along edge of the mounting frame.
2. WQCV Well Screen
 - Type of Screen: Stainless steel #93 Vee Wire (Johnson Vee Wire (tm) Stainless Steel Screen or equivalent with 60% open area)
 - Screen slot opening dimension: 0.139" (Screen #93 Vee Wire Slot Opening)
 - Type and Size of Support Rod: TE 0.074"x0.50"
 - Spacing of Support Rod (O.C.): 1.0 Inch
 - Total Screen Thickness: 0.655"
 - Carbon Steel Holding Frame Type: 3/4" x 1.0" angle


AS-BUILT
DATE: 09/30/2022

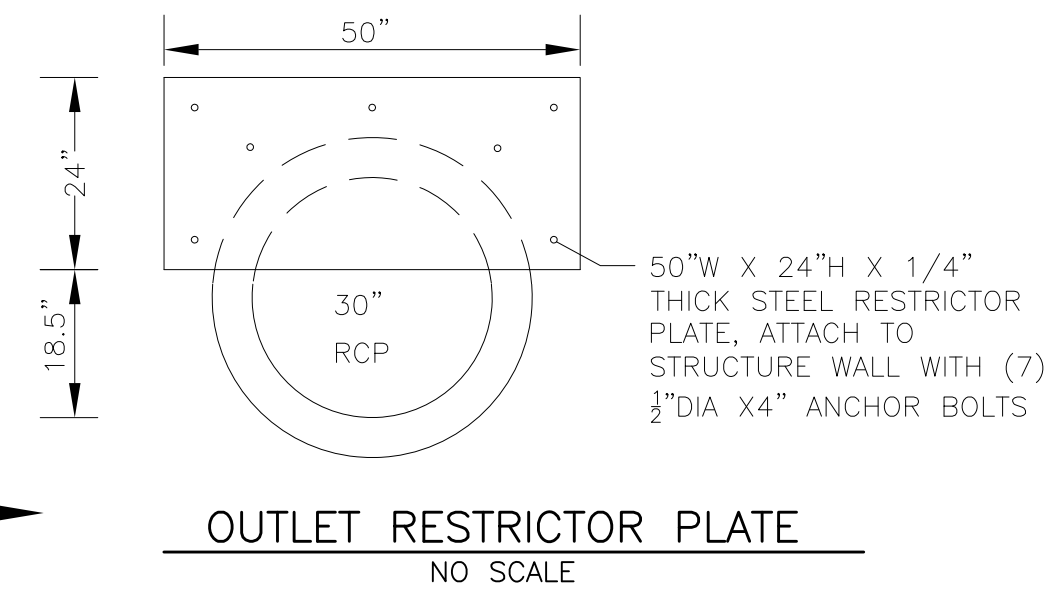

OUTLET RESTRICTOR PLATE
NO SCALE

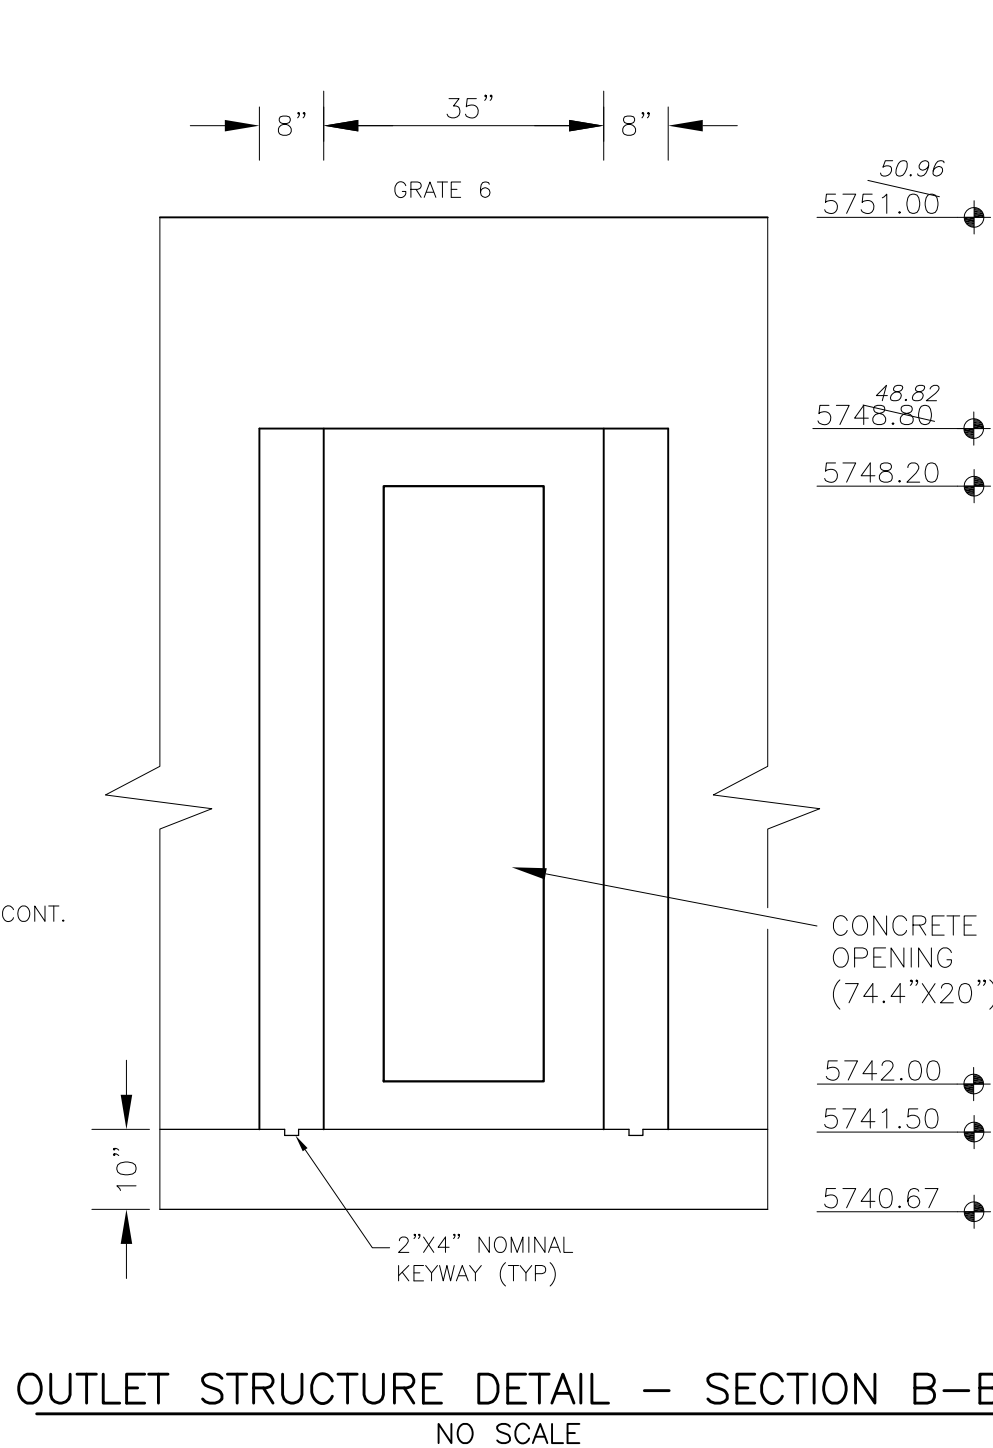

OUTLET STRUCTURE DETAIL - SECTION B-B
NO SCALE

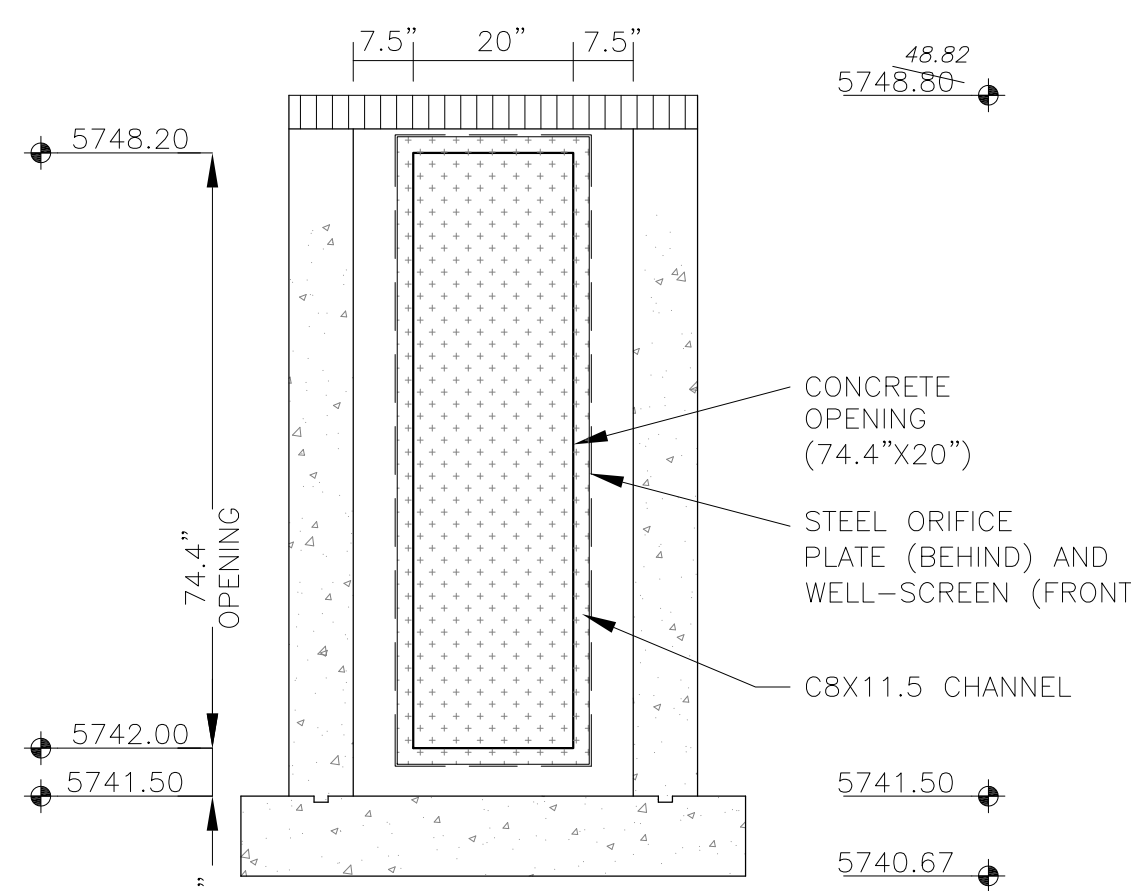

OUTLET STRUCTURE DETAIL - SECTION B-B
NO SCALE

CORE
ENGINEERING GROUP
15004 1ST AVENUE S.
BURNING WOOD, CO 80903
CONTACT: RICHARD L. SCHINDLER, P.E.
EMAIL: rich@ceg1.com

DATE

DESCRIPTION

NO

DRAWN: RLS
DESIGNED: RLS
CHECKED: RLS

PREPARED FOR:
LORSON, LLC
212 N. WAHSATCH AVE. SUITE 301
COLORADO SPRINGS, COLORADO 80903
(719) 635-3200
CONTACT: JEFF MARK

PROJECT:
THE HILLS COLLECTOR
STREET CONSTRUCTION
FONTAINE BLVD. - GRAYLING DR
LORSON BLVD - WALLEYE DR - LAMPREY DR
COLORADO SPRINGS, COLORADO

POND C2.2
FULL SPECTRUM
OUTLET STRUCTURE DETAILS

DATE:
NOV 12, 2020

PROJECT NO.
100.061

SHEET NUMBER
C9.13


TOTAL SHEETS: 58

DETENTION BASIN OUTLET STRUCTURE DESIGN

MHFD-Detention, Version 4.02 (February 2020)

Project: The Hills at Lorson Ranch

Basin ID: Pond C2.3-asbuilt

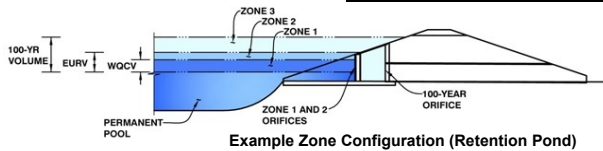

Example Zone Configuration (Retention Pond)

	Estimated Stage (ft)	Estimated Volume (ac-ft)	Outlet Type
Zone 1 (WQCV)	2.25	0.294	Orifice Plate
Zone 2 (EURV)	3.34	0.589	Rectangular Orifice
Z3 (100+1/2WQCV)	4.62	0.834	Weir&Pipe (Restrict)
Total (all zones)		1.717	

User Input: Orifice at Underdrain Outlet (typically used to drain WQCV in a Filtration BMP)

Underdrain Orifice Invert Depth =	N/A	ft (distance below the filtration media surface)
Underdrain Orifice Diameter =	N/A	inches

Calculated Parameters for Underdrain	
Underdrain Orifice Area =	N/A ft ²
Underdrain Orifice Centroid =	N/A feet

User Input: Orifice Plate with one or more orifices or Elliptical Slot Weir (typically used to drain WQCV and/or EURV in a sedimentation BMP)

Invert of Lowest Orifice =	0.00	ft (relative to basin bottom at Stage = 0 ft)
Depth at top of Zone using Orifice Plate =	2.25	ft (relative to basin bottom at Stage = 0 ft)
Orifice Plate: Orifice Vertical Spacing =	N/A	inches
Orifice Plate: Orifice Area per Row =	0.98	sq. inches (diameter = 1-1/8 inches)

Calculated Parameters for Plate	
WQ Orifice Area per Row =	6.806E-03 ft ²
Elliptical Half-Width =	N/A feet
Elliptical Slot Centroid =	N/A feet
Elliptical Slot Area =	N/A ft ²

User Input: Stage and Total Area of Each Orifice Row (numbered from lowest to highest)

	Row 1 (required)	Row 2 (optional)	Row 3 (optional)	Row 4 (optional)	Row 5 (optional)	Row 6 (optional)	Row 7 (optional)	Row 8 (optional)
Stage of Orifice Centroid (ft)	0.00	0.80	1.63					
Orifice Area (sq. inches)	0.98	0.98	0.98					

	Row 9 (optional)	Row 10 (optional)	Row 11 (optional)	Row 12 (optional)	Row 13 (optional)	Row 14 (optional)	Row 15 (optional)	Row 16 (optional)
Stage of Orifice Centroid (ft)								
Orifice Area (sq. inches)								

User Input: Vertical Orifice (Circular or Rectangular)

	Zone 2 Rectangular	Not Selected	
Invert of Vertical Orifice =	2.41	N/A	ft (relative to basin bottom at Stage = 0 ft)
Depth at top of Zone using Vertical Orifice =	3.34	N/A	ft (relative to basin bottom at Stage = 0 ft)
Vertical Orifice Height =	6.00	N/A	inches
Vertical Orifice Width =	17.00		inches

Calculated Parameters for Vertical Orif	
Zone 2 Rectangular	Not Selected
Vertical Orifice Area =	0.71 N/A
Vertical Orifice Centroid =	0.25 N/A

User Input: Overflow Weir (Dropbox with Flat or Sloped Gate and Outlet Pipe OR Rectangular/Trapezoidal Weir (and No Outlet Pipe)

	Zone 3 Weir	Not Selected	
Overflow Weir Front Edge Height, Ho =	7.35	N/A	ft (relative to basin bottom at Stage = 0 ft)
Overflow Weir Front Edge Length =	8.00	N/A	feet
Overflow Weir Gate Slope =	0.00	N/A	H:V
Horiz. Length of Weir Sides =	6.00	N/A	feet
Overflow Gate Open Area % =	70%	N/A	% gate open area/total area
Debris Clogging % =	50%	N/A	%

Calculated Parameters for Overflow Weir	
Zone 3 Weir	Not Selected
Height of Gate Upper Edge, H _g =	7.35 N/A
Overflow Weir Slope Length =	6.00 N/A
Gate Open Area / 100-yr Orifice Area =	6.84 N/A
Overflow Gate Open Area w/o Debris =	33.60 N/A
Overflow Gate Open Area w/ Debris =	16.80 N/A

User Input: Outlet Pipe w/ Flow Restriction Plate (Circular Orifice, Restrictor Plate, or Rectangular Orifice)

	Zone 3 Restrictor	Not Selected	
Depth to Invert of Outlet Pipe =	0.15	N/A	ft (distance below basin bottom at Stage = 0 ft)
Outlet Pipe Diameter =	30.00	N/A	inches
Restrictor Plate Height Above Pipe Invert =	30.00		inches

Calculated Parameters for Outlet Pipe w/ Flow Restriction Plate	
Zone 3 Restrictor	Not Selected
Outlet Orifice Area =	4.91 N/A
Outlet Orifice Centroid =	1.25 N/A
Half-Central Angle of Restrictor Plate on Pipe =	3.14 N/A

User Input: Emergency Spillway (Rectangular or Trapezoidal)

Spillway Invert Stage =	9.20	ft (relative to basin bottom at Stage = 0 ft)
Spillway Crest Length =	20.00	feet
Spillway End Slopes =	4.00	H:V
Freeboard above Max Water Surface =	1.33	feet

Calculated Parameters for Spillway	
Spillway Design Flow Depth =	1.17 feet
Stage at Top of Freeboard =	11.70 feet
Basin Area at Top of Freeboard =	1.04 acres
Basin Volume at Top of Freeboard =	6.04 acre-ft

micropool = 0 = 5744.30


Routed Hydrograph Results

The user can override the default CUHP hydrographs and runoff volumes by entering new values in the Inflow Hydrographs table (Columns W through AF)

	WQCV	EURV	2 Year	5 Year	10 Year	25 Year	50 Year	100 Year
Design Storm Return Period	N/A	N/A	1.19	1.50	1.75	2.00	2.25	2.52
One-Hour Rainfall Depth (in)	N/A	N/A	0.924	1.299	1.627	2.016	2.357	2.775
CUHP Runoff Volume (acre-ft)	0.294	0.883	0.924	1.299	1.627	2.016	2.357	2.775
User Override Inflow Hydrograph Volume (acre-ft)	N/A	N/A	2.831	4.148	5.891	8.181	10.069	12.414
CUHP Predevelopment Peak Q (cfs)	N/A	N/A	2.2	5.0	7.2	11.8	14.6	18.5
OPTIONAL Override Predevelopment Peak Q (cfs)	N/A	N/A						
Predevelopment Unit Peak Flow, q (cfs/acre)	N/A	N/A	0.14	0.31	0.45	0.74	0.91	1.16
Peak Inflow Q (cfs)	N/A	N/A	14.3	21.0	40.8	77.8	87.7	97.1
Peak Outflow Q (cfs)	0.1	2.9	4.0	5.5	7.3	36.9	63.5	65.3
Ratio Peak Outflow to Predevelopment Q	N/A	N/A	N/A	1.1	1.0	3.1	4.3	3.5
Structure Controlling Flow	Plate	Vertical Orifice 1	Vertical Orifice 1	Vertical Orifice 1	Vertical Orifice 1	Overflow Weir 1	Outlet Plate 1	Outlet Plate 1
Max Velocity through Gate 1 (fps)	N/A	N/A	N/A	N/A	N/A	0.9	1.6	1.7
Max Velocity through Gate 2 (fps)	N/A	N/A	N/A	N/A	N/A	N/A	N/A	N/A
Time to Drain 97% of Inflow Volume (hours)	45	56	51	46	41	33	27	20
Time to Drain 99% of Inflow Volume (hours)	47	61	62	61	60	56	52	49
Maximum Ponding Depth (ft)	2.25	3.34	3.95	5.07	6.96	7.96	8.33	8.73
Area at Maximum Ponding Depth (acres)	0.40	0.61	0.65	0.71	0.83	0.90	0.93	0.95
Maximum Volume Stored (acre-ft)	0.296	0.886	1.266	2.029	3.493	4.348	4.686	5.061

MHFD-Detention, Version 4.02 (February 2020)



Basin ID: Pond C2.3-asbuilt

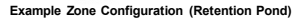


Depth Increment =	0.20	ft
-------------------	------	----

Pond C2.3 Developed Inflow Hydrograph---- asbuilt Pond C2.1 outflow + C3 Basin + C4 Basin

		2 Year		2yr Combined		5 Year		5yr Combined		10 Year		10yr Combined		25 Year		25yr Combined		50 Year		50yr Combined		100 Year		100yr Combined	
Time [hr]	Time [min]	Ponc C2.1 Outflow2 - [cfs]	2 Year [cfs]	Hydrograph	Ponc C2.1 Outflow2 - [cfs]	5 Year [cfs]	Hydrograph	Ponc C2.1 Outflow2 - [cfs]	10 Year [cfs]	Hydrograph	Ponc C2.1 Outflow2 - [cfs]	25 Year [cfs]	Hydrograph	Ponc C2.1 Outflow2 - [cfs]	50 Year [cfs]	Hydrograph	Ponc C2.1 Outflow2 - [cfs]	50 Year [cfs]	Hydrograph	Ponc C2.1 Outflow2 - [cfs]	100 Year [cfs]	Hydrograph	Ponc C2.1 Outflow2 - [cfs]	100 Year [cfs]	
0.00	0.00	0.00	0.00	0.00	0.00	0.00	0.00	0.00	0.00	0.00	0.00	0.00	0.00	0.00	0.00	0.00	0.00	0.00	0.00	0.00	0.00	0.00	0.00	0.00	
0.08	5.00	0.00	0.00	0.00	0.00	0.00	0.00	0.00	0.00	0.00	0.00	0.00	0.00	0.00	0.00	0.00	0.00	0.00	0.00	0.00	0.00	0.00	0.00	0.00	
0.17	10.00	0.14	0.00	0.14	0.18	0.00	0.18	0.20	0.00	0.20	0.17	0.00	0.17	0.00	0.19	0.13	0.33	0.18	0.01	0.20	0.01	0.01	0.00	0.20	
0.25	15.00	0.25	1.17	1.42	0.27	1.91	2.18	0.28	2.37	2.65	0.26	1.59	1.85	0.27	1.99	2.26	0.27	1.94	2.21	0.27	1.94	2.21	0.27	1.94	
0.33	20.00	0.32	4.21	4.54	0.40	5.61	6.01	0.45	6.91	7.36	0.33	4.12	4.45	0.37	4.81	5.18	0.39	5.14	5.53	0.37	4.81	5.18	0.39	5.14	
0.42	25.00	0.48	9.83	10.31	0.54	14.69	15.23	0.58	18.61	19.20	0.52	9.65	10.17	0.55	11.51	12.05	0.57	12.82	13.39	0.55	11.51	12.05	0.57	12.82	
0.50	30.00	0.56	13.28	13.84	1.55	18.82	20.37	2.81	22.84	25.65	2.25	24.57	26.82	3.01	28.96	31.97	3.48	32.54	36.01	3.01	28.96	31.97	3.48	32.54	
0.58	35.00	1.21	12.88	14.09	3.15	17.81	20.96	3.93	21.42	25.35	4.04	29.19	33.23	4.63	34.09	38.72	5.11	40.16	45.28	4.63	34.09	38.72	5.11	40.16	
0.67	40.00	2.54	11.77	14.31	3.89	15.99	19.88	4.62	19.25	23.87	5.06	28.83	33.89	5.64	33.53	39.17	22.82	39.47	62.29	5.64	33.53	39.17	22.82	39.47	
0.75	45.00	3.14	10.24	13.38	4.40	14.14	18.54	5.12	17.24	22.36	6.33	26.34	32.68	34.39	30.62	65.01	60.13	36.96	97.09	34.39	30.62	65.01	60.13	36.96	
0.83	50.00	3.54	8.93	12.48	4.77	12.65	17.42	5.49	15.26	20.75	30.40	24.16	54.56	59.62	28.08	87.70	62.31	33.83	96.13	59.62	28.08	87.70	62.31	33.83	
0.92	55.00	3.84	7.84	11.67	5.05	11.06	16.11	6.49	13.49	19.98	51.27	21.27	72.54	60.76	24.75	85.51	63.89	30.40	94.29	60.76	24.75	85.51	63.89	30.40	
1.00	60.00	4.07	6.88	10.94	5.28	9.62	14.89	11.94	11.94	26.62	59.24	18.58	77.83	61.49	21.64	83.13	65.04	27.30	92.34	61.49	21.64	83.13	65.04	27.30	
1.08	65.00	4.25	6.17	10.42	5.47	8.60	14.06	22.85	10.89	33.74	59.45	16.29	75.74	61.90	19.00	80.90	65.83	24.59	90.42	61.90	19.00	80.90	65.83	24.59	
1.17	70.00	4.40	5.44	9.84	5.62	7.90	13.52	28.48	10.19	38.67	59.42	14.12	73.54	62.05	16.54	78.58	66.25	20.97	87.22	62.05	16.54	78.58	66.25	20.97	
1.25	75.00	4.51	4.83	9.34	5.94	7.15	13.09	31.24	9.58	40.82	59.16	12.44	71.60	61.95	14.62	76.57	66.34	18.02	84.36	61.95	14.62	76.57	66.34	18.02	
1.33	80.00	4.60	4.29	8.89	8.20	6.33	14.52	31.33	8.56	39.89	52.97	10.74	63.71	61.61	12.61	74.22	66.14	15.09	81.23	61.61	12.61	74.22	66.14	15.09	
1.42	85.00	4.67	3.78	8.45	10.29	5.55	15.84	29.58	7.32	54.66	45.47	9.19	61.06	61.06	10.77	71.83	65.68	12.49	78.17	61.06	10.77	71.83	65.68	12.49	
1.50	90.00	4.72	3.29	8.00	11.72	4.82	16.54	27.15	6.18	33.33	38.42	7.64	46.06	60.30	8.94	69.24	64.99	10.21	75.20	60.30	8.94	69.24	64.99	10.21	
1.58	95.00	4.76	2.84	7.60	12.54	4.18	16.72	24.80	5.20	29.99	32.37	6.21	38.59	59.40	7.26	66.66	64.16	8.15	72.31	59.40	7.26	66.66	64.16	8.15	
1.67	100.00	4.80	2.49	7.30	12.84	3.49	16.33	22.74	4.46	27.21	27.58	4.97	32.56	48.95	5.81	54.75	63.22	6.37	69.59	48.95	5.81	54.75	63.22	6.37	
1.75	105.00	4.84	2.31	7.15	12.79	3.04	15.84	21.02	4.04	25.06	23.88	4.05	27.94	37.96	4.74	42.70	62.21	5.07	67.28	37.96	4.74	42.70	62.21	5.07	
1.83	110.00	4.88	2.22	7.10	12.55	2.77	15.32	19.56	3.77	23.33	21.04	3.51	24.55	30.77	4.11	34.89	61.14	4.28	65.43	30.77	4.11	34.89	61.14	4.28	
1.92	115.00	4.90	2.08	6.88	12.19	2.57	14.76	18.22	3.51	21.72	18.86	3.16	22.02	25.88	3.71	29.59	60.03	3.77	63.79	25.88	3.71	29.59	60.03	3.77	
2.00	120.00	4.92	1.77	6.68	11.59	2.37	13.96	16.71	3.18	19.88	16.91	2.93	19.84	22.12	3.43	25.55	55.41	3.39	58.80	19.84	22.12	3.43	25.55	55.41	
2.08	125.00	4.92	1.41	6.33	10.69	1.88	12.57	14.92	2.52	17.44	14.89	2.30	17.19	18.78	2.69	21.48	38.98	2.61	41.59	17.44	14.89	2.30	17.19	18.78	
2.17	130.00	4.92	1.09	6.01	9.65	1.45	11.11	13.06	1.95	15.01	12.93	1.76	14.68	15.83	2.06	17.89	28.56	1.94	30.51	15.01	12.93	1.76	14.68	15.83	
2.25	135.00	4.90	0.85	5.75	8.62	1.13	9.75	11.33	1.50	12.82	11.16	1.34	12.50	13.34	1.57	14.91	21.64	1.45	23.09	12.82	11.16	1.34	12.50	13.34	
2.33	140.00	4.89	0.65	5.54	7.69	0.86	8.55	9.81	1.13	10.94	9.64	1.02	10.66	11.28	1.19	12.47	16.85	1.08	17.93	10.94	9.64	1.02	10.66	11.28	
2.42	145.00	4.86	0.50	5.36	6.89	0.66	7.54	8.52	0.85	9.37	8.37	0.77	9.14	9.60	0.90	10.50	13.43	0.82	14.25	9.37	8.37	0.77	9.14	9.60	
2.50	150.00	4.84	0.38	5.22	6.25	0.49	6.74	7.46	0.63	8.10	7.34	0.57	7.91	8.26	0.67	8.93	10.93	0.62	11.55	8.10	7.34	0.57	7.91	8.26	
2.58	155.00	4.81	0.29	5.09	5.81	0.36	6.17	6.63	0.47	7.11	6.54	0.43	6.96	7.21	0.50	7.70	9.08	0.46	9.55	7.11	6.54	0.43	6.96	7.21	
2.67	160.00	4.78	0.21	4.99	5.71	0.26	5.97	6.03	0.35	6.38	5.97	0.32	6.29	6.41	0.37	6.79	7.72	0.35	8.07	6.38	5.97	0.32	6.29	6.41	
2.75	165.00	4.74	0.15	4.90	5.68	0.19	5.87	5.72	0.26	5.98	5.72	0.24	5.96	5.88	0.28	6.15	6.71	0.26	6.97	5.98	5.72	0.24	5.96	5.88	
2.83	170.00	4.71	0.10	4.81	5.65	0.13	5.78	5.69	0.18	5.87	5.69	0.17	5.86	5.71	0.19	5.91	6.03	0.18	6.21	5.87	5.69	0.17	5.86	5.71	
2.92	175.00	4.68	0.06	4.74	5.62	0.08	5.70	5.66	0.11	5.77	5.66	0.11	5.77	5.68	0.12	5.81	5.72	0.12	5.84	5.74	5.66	0.11	5.77	5.68	
3.00	180.00	4.64	0.03	4.67	5.58	0.05	5.63	5.63	0.06	5.69	5.63	0.06	5.69	5.65	0.07	5.72	5.69	0.07	5.76	5.69	5.63	0.06	5.69	5.65	
3.08	185.00	4.61	0.01	4.62	5.55	0.02	5.57	5.60	0.03	5.62	5.59	0.03	5.62	5.62	0.03	5.65	5.66	0.03	5.69	5.62	5.59	0.03	5.62	5.62	
3.17	190.00	4.57	0.00	4.58	5.52	0.01	5.53	5.56	0.01	5.57	5.56	0.01	5.57	5.58	0.01	5.59	5.62	0.01	5.63	5.58	5.56	0.01	5.57	5.58	
3.25	195.00	4.54	0.00	4.54	5.49	0.00	5.49	5.53	0.00	5.53	5.53	0.00	5.53	5.55	0.00	5.55	5.59	0.00	5.59	5.54	5.53	0.00	5.53	5.55	
3.33	200.00	4.50	0.00	4.50	5.45	0.00	5.45	5.50	0.00	5.50	5.50	0.00	5.50	5.52	0.00	5.52	5.56	0.00	5.56	5.50	5.50	0.00	5.50	5.52	
3.42	205.00	4.46	0.00	4.46	5.42	0.00	5.42	5.47	0.00	5.47	5.46	0.00	5.46	5.49	0.00	5.49	5.53	0.00	5.53	5.46	5.46	0.00	5.46	5.49	
3.50	210.00	4.43	0.00	4.43	5.39	0.00	5.39	5.43	0.00	5.43	5.43	0.00	5.43	5.45	0.00	5.45	5.49	0.00	5.49	5.43	5.43	0.00	5.43	5.45	
3.58	215.00	4.39	0.00	4.39	5.35	0.00	5.35	5.40	0.00	5.40	5.40	0.00	5.40	5.42	0.00	5.42	5.46	0.00	5.46	5.40	5.40	0.00	5.40	5.42	
3.67	220.00	4.36	0.00	4.36	5.32	0.00	5.32	5.37	0.00	5.37	5.36	0.00	5.36	5.39	0.00	5.39	5.43	0.00	5.43	5.37	5.37	0.00	5.37	5.39	
3.75	225.00	4.32	0.00	4.32	5.29	0.00	5.29	5.33	0.00	5.33	5.33	0.00	5.33	5.35	0.00	5.35	5.40	0.00	5.40	5.33	5.33	0.00	5.33	5.35	
3.83	230.00	4.29	0.00	4.29	5.25	0.00	5.25	5.30	0.00	5.30	5.30	0.00	5.30	5.32	0.00	5.32	5.36	0.00	5.36	5.29	5.29	0.00	5.29	5.32	
3.92	235.00	4.25	0.00	4.25	5.22	0.00	5.22	5.27	0.00	5.27	5.26	0.00	5.26	5.29	0.00	5.29	5.33	0.00	5.33	5.27	5.27	0.00	5.27	5.29	
4.00	240.00	4.21	0.00	4.21	5.19	0.00	5.19	5.23	0.00	5.23	5.23	0.00	5.23	5.25	0.00	5.25	5.30	0.00	5.30	5					

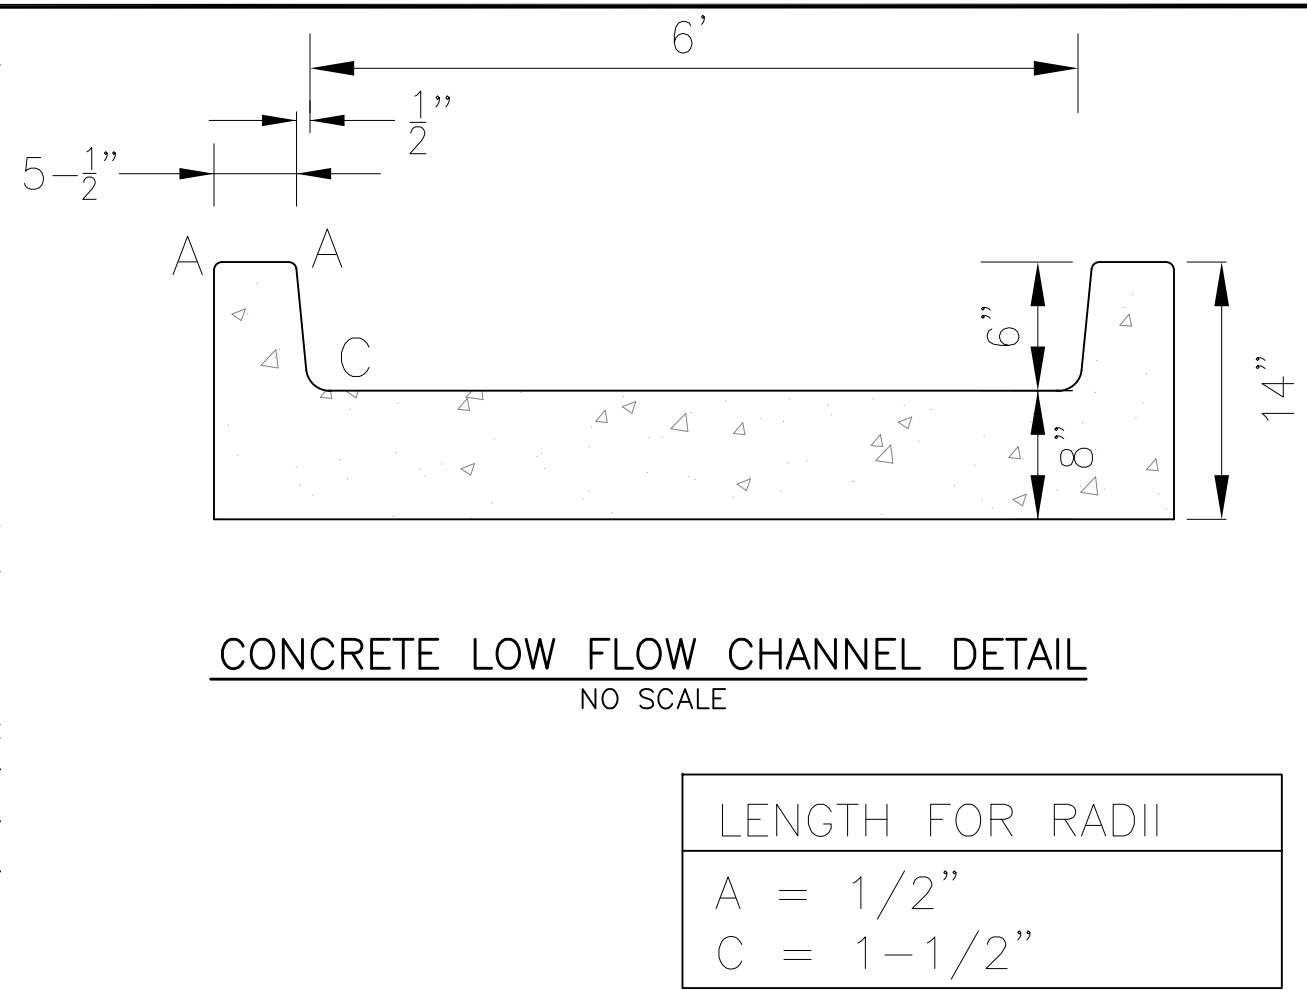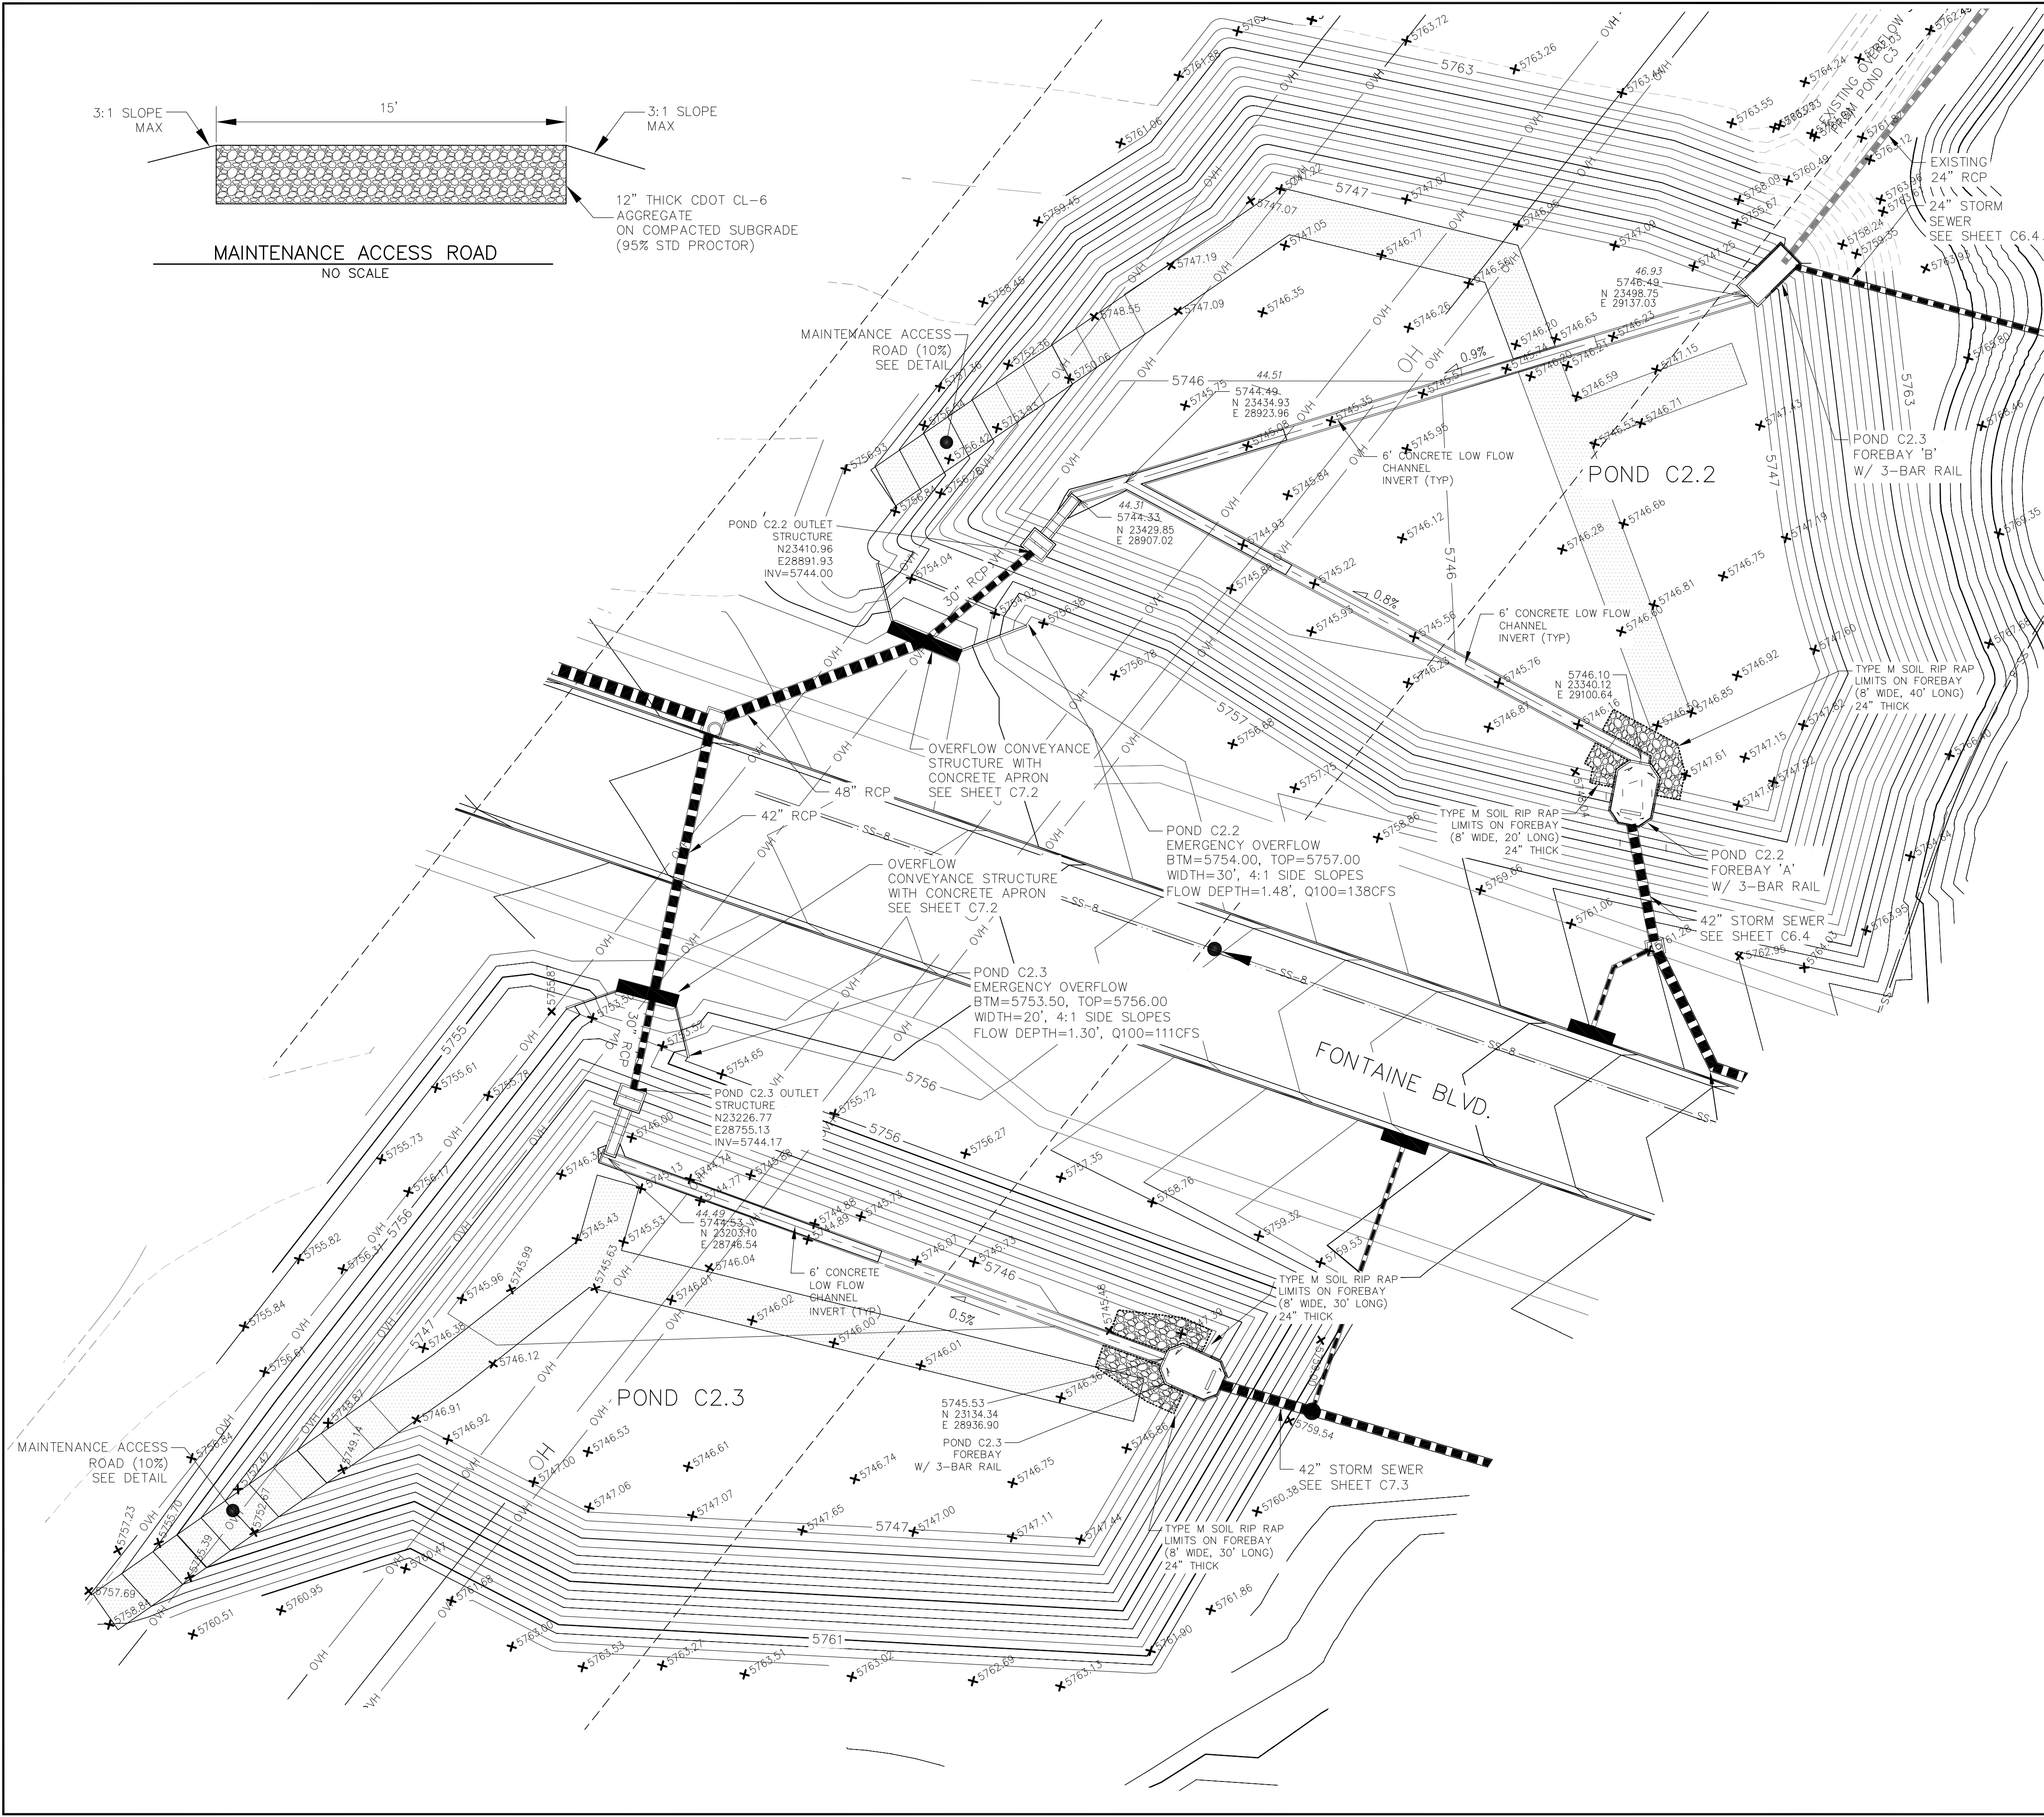

AS-BUILT
DATE: 09/30/2022

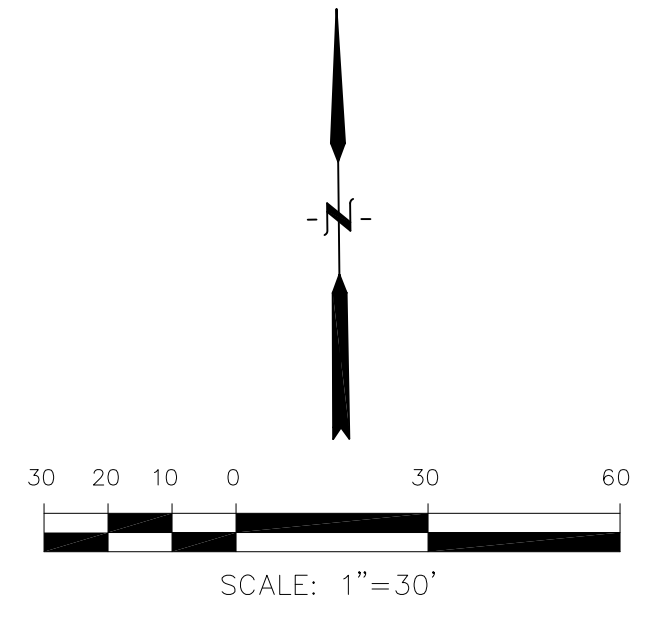

CORE
ENGINEERING GROUP

15004 1ST AVENUE S.
SUITE 301
BURNING WOOD, CO 80903
CONTACT: RICHARD L. SCHINDLER, P.E.
EMAIL: Rich@ceg1.com

DATE

DESCRIPTION

NO.

DRAWN: RLS
DESIGNED: RLS
CHECKED: RLS

NOV 12, 2020

PROJECT NO.
100.061


SHEET NUMBER
C9.5

TOTAL SHEETS: 58

PREPARED FOR:
THE HILLS COLLECTOR
STREET CONSTRUCTION

212 N. WAHATCH AVE. SUITE 301
COLORADO SPRINGS, COLORADO 80903
(719) 635-3200
CONTACT: JEFF MARK

POND C2.2 & C2.3
FOREBAY, LOW FLOW CHANNEL
AND OUTLET STRUCTURE LAYOUT

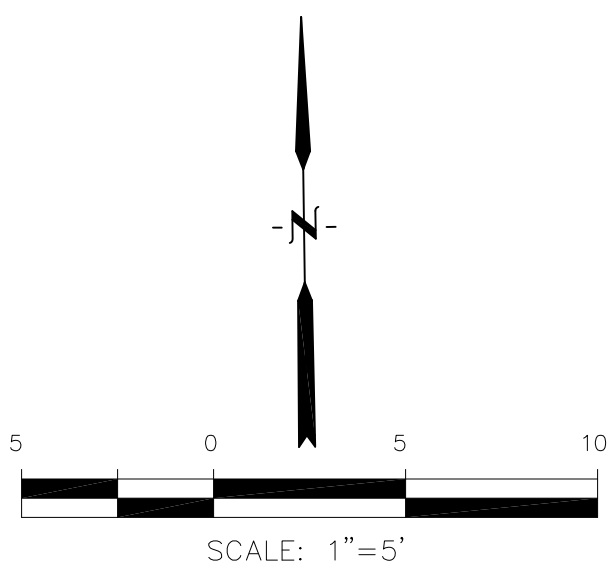

POINT TABLE (FOREBAY)				
NUMBER	NORTHING	EASTING	ELEVATION	NOTES
1	23134.06	28937.51	5745.53	FOREBAY BOTTOM
2	23125.44	28956.66	5745.64	FOREBAY BOTTOM, INV 42"=5746.50

NOTE: ALL CONCRETE
FOR FOREBAY SHALL BE
CDOT TYPE D

AS-BUILT
DATE: 09/30/2022

POND C2.3

POND C2.3

CORE
ENGINEERING GROUP
15004 1ST AVENUE S.
BURNSVILLE, MN 55306
PH: 719.570.1100
CONTACT: RICHARD L. SCHINDLER, P.E.
EMAIL: Rich@ceg1.com

PREPARED FOR:
LORSON, LLC
212 N. WAHSATCH AVE., SUITE 301
COLORADO SPRINGS, COLORADO 80903
(719) 635-3200
CONTACT: JEFF MARK

PROJECT: THE HILLS COLLECTOR
STREET CONSTRUCTION
FONTAINE BLVD – GRAYLING DR
LORSON BLVD-WALLEYE DR-LAMPREY DR
COLORADO SPRINGS, COLORADO

DRAWN: RLS
DESIGNED: RLS
CHECKED: RLS



DATE:
NOV 12, 2020



PROJECT NO.
100.061

SHEET NUMBER
C9.7



TOTAL SHEETS: 58

- NOTES
1. ALL SPOT ELEVATIONS ARE FLOW LINE UNLESS OTHERWISE NOTED.
 2. SEE EARLY GRADING PLAN FOR GRADING INFORMATION.
 3. ALL STORM SEWER SHALL BE CLASS III RCP.
 4. ALL MHS SHALL BE TYPE 1 UNLESS OTHERWISE NOTED.

- 1 CURVE DATA ID
- 2 PEDESTRIAN RAMP, SEE SHEET C10.1
- 3 CURB/GUTTER FLOW LINE POINTS

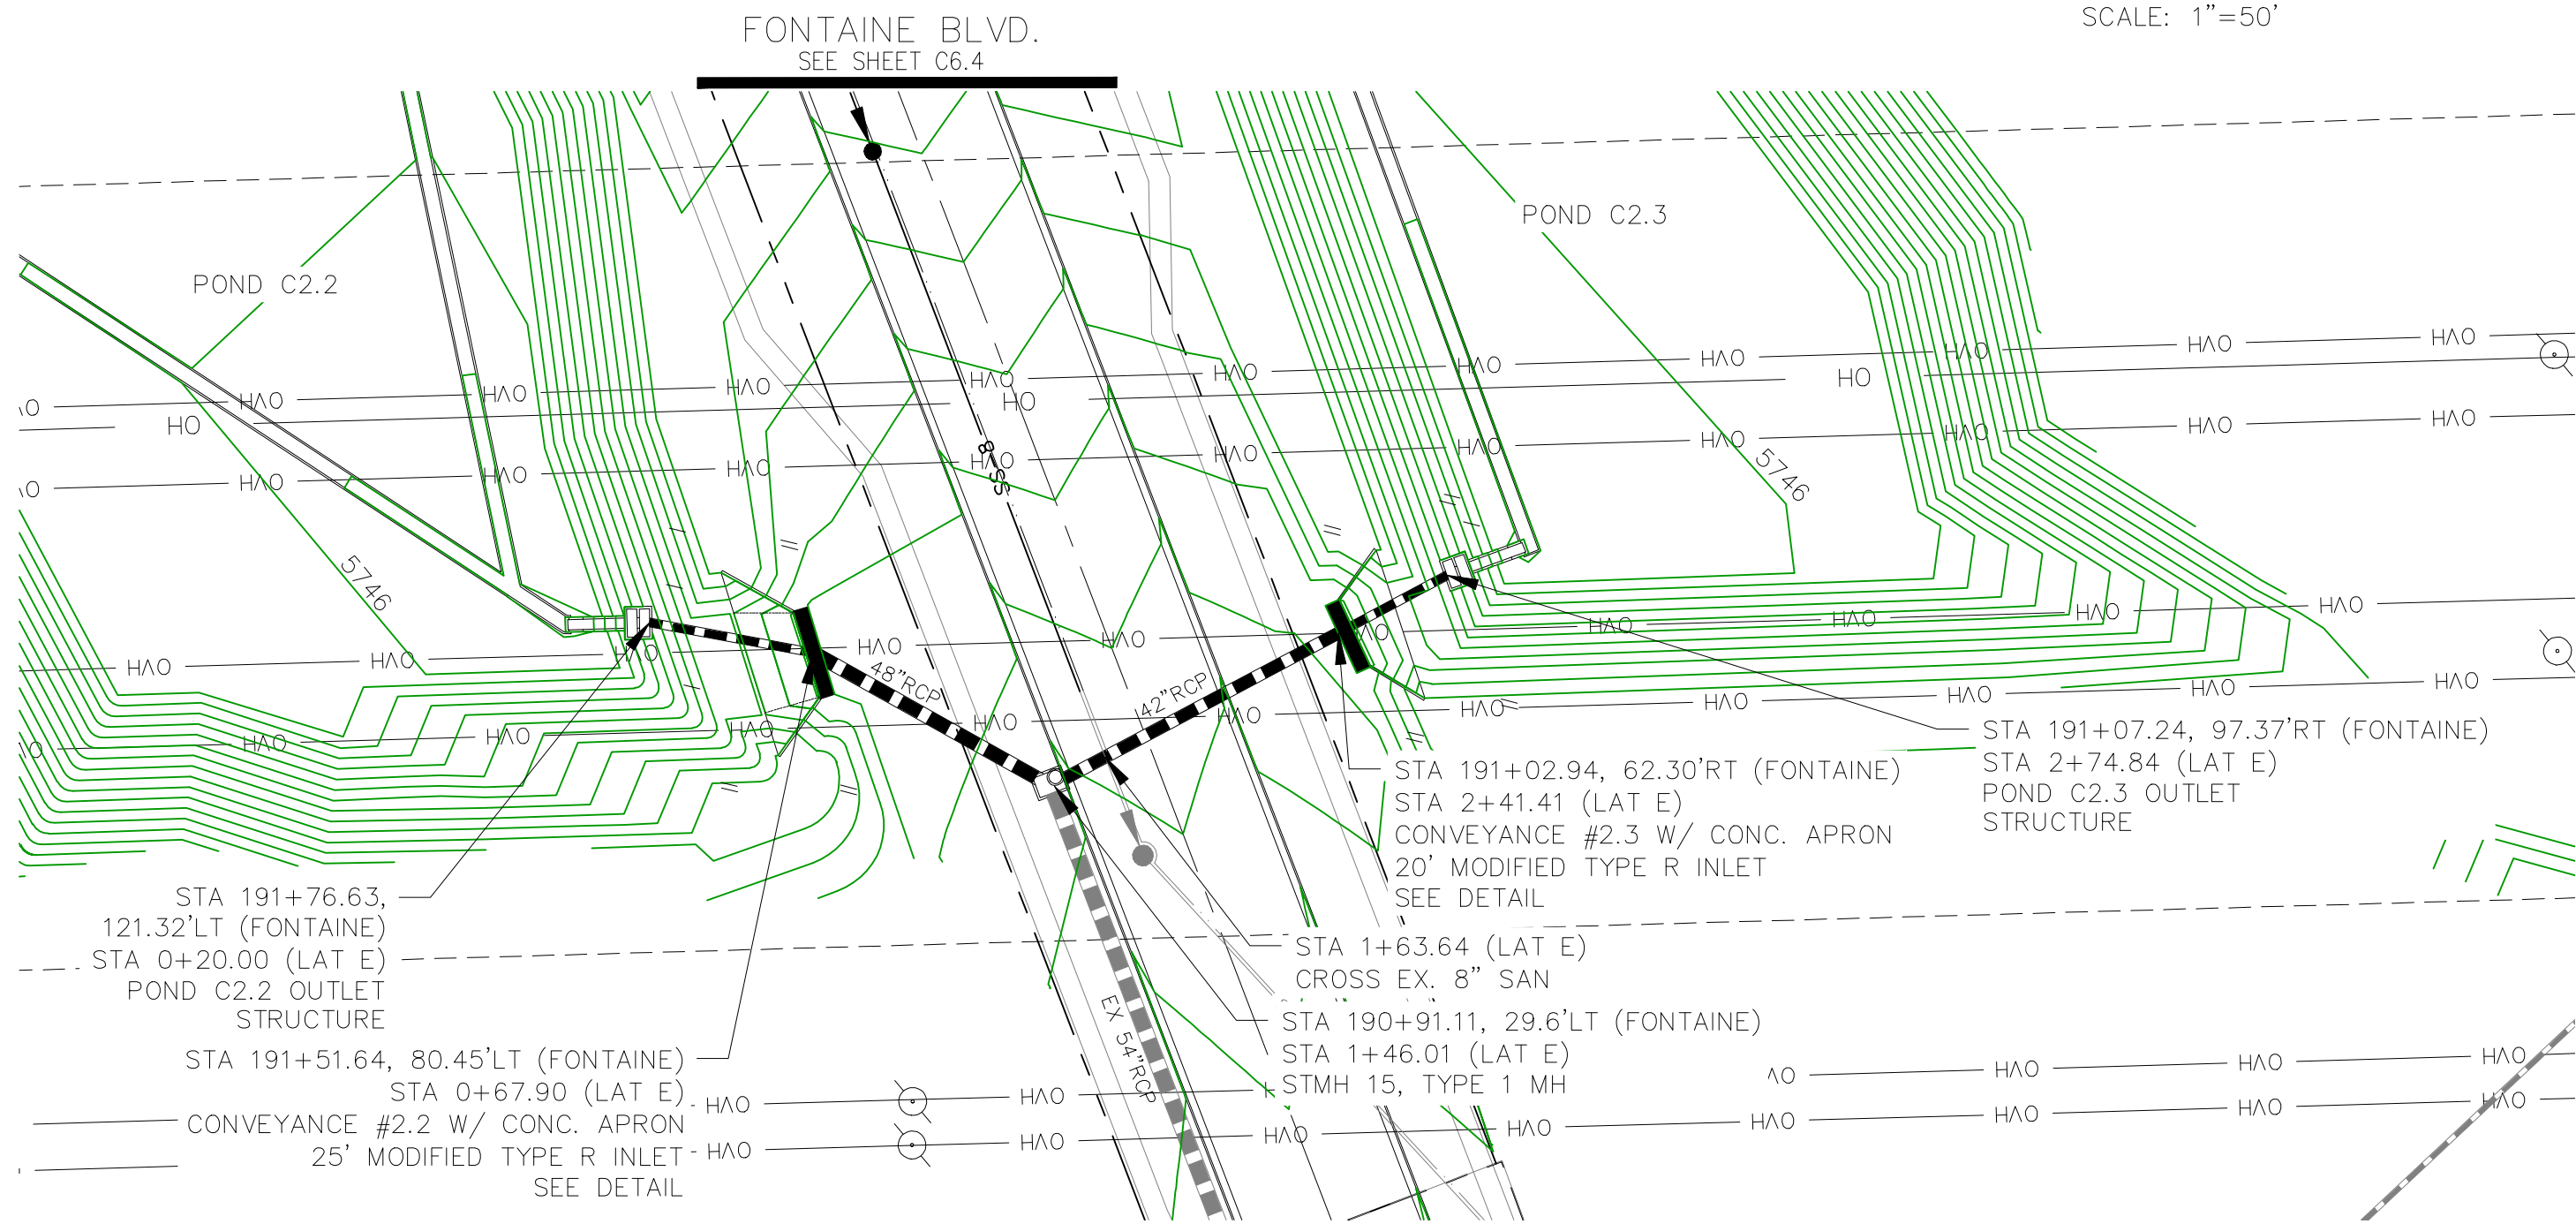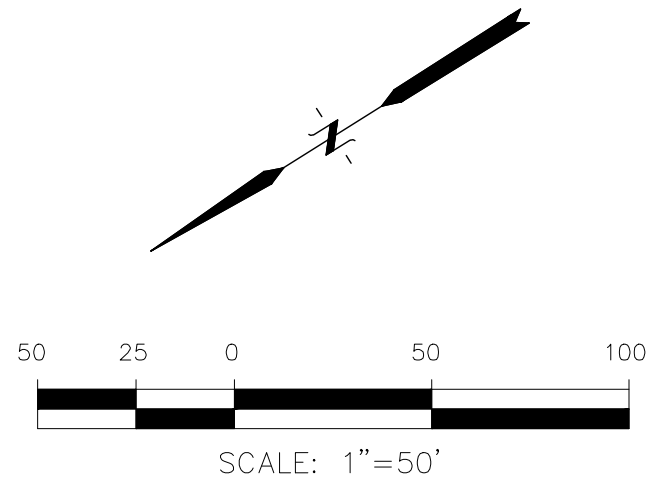


STORM LATERAL 'E'

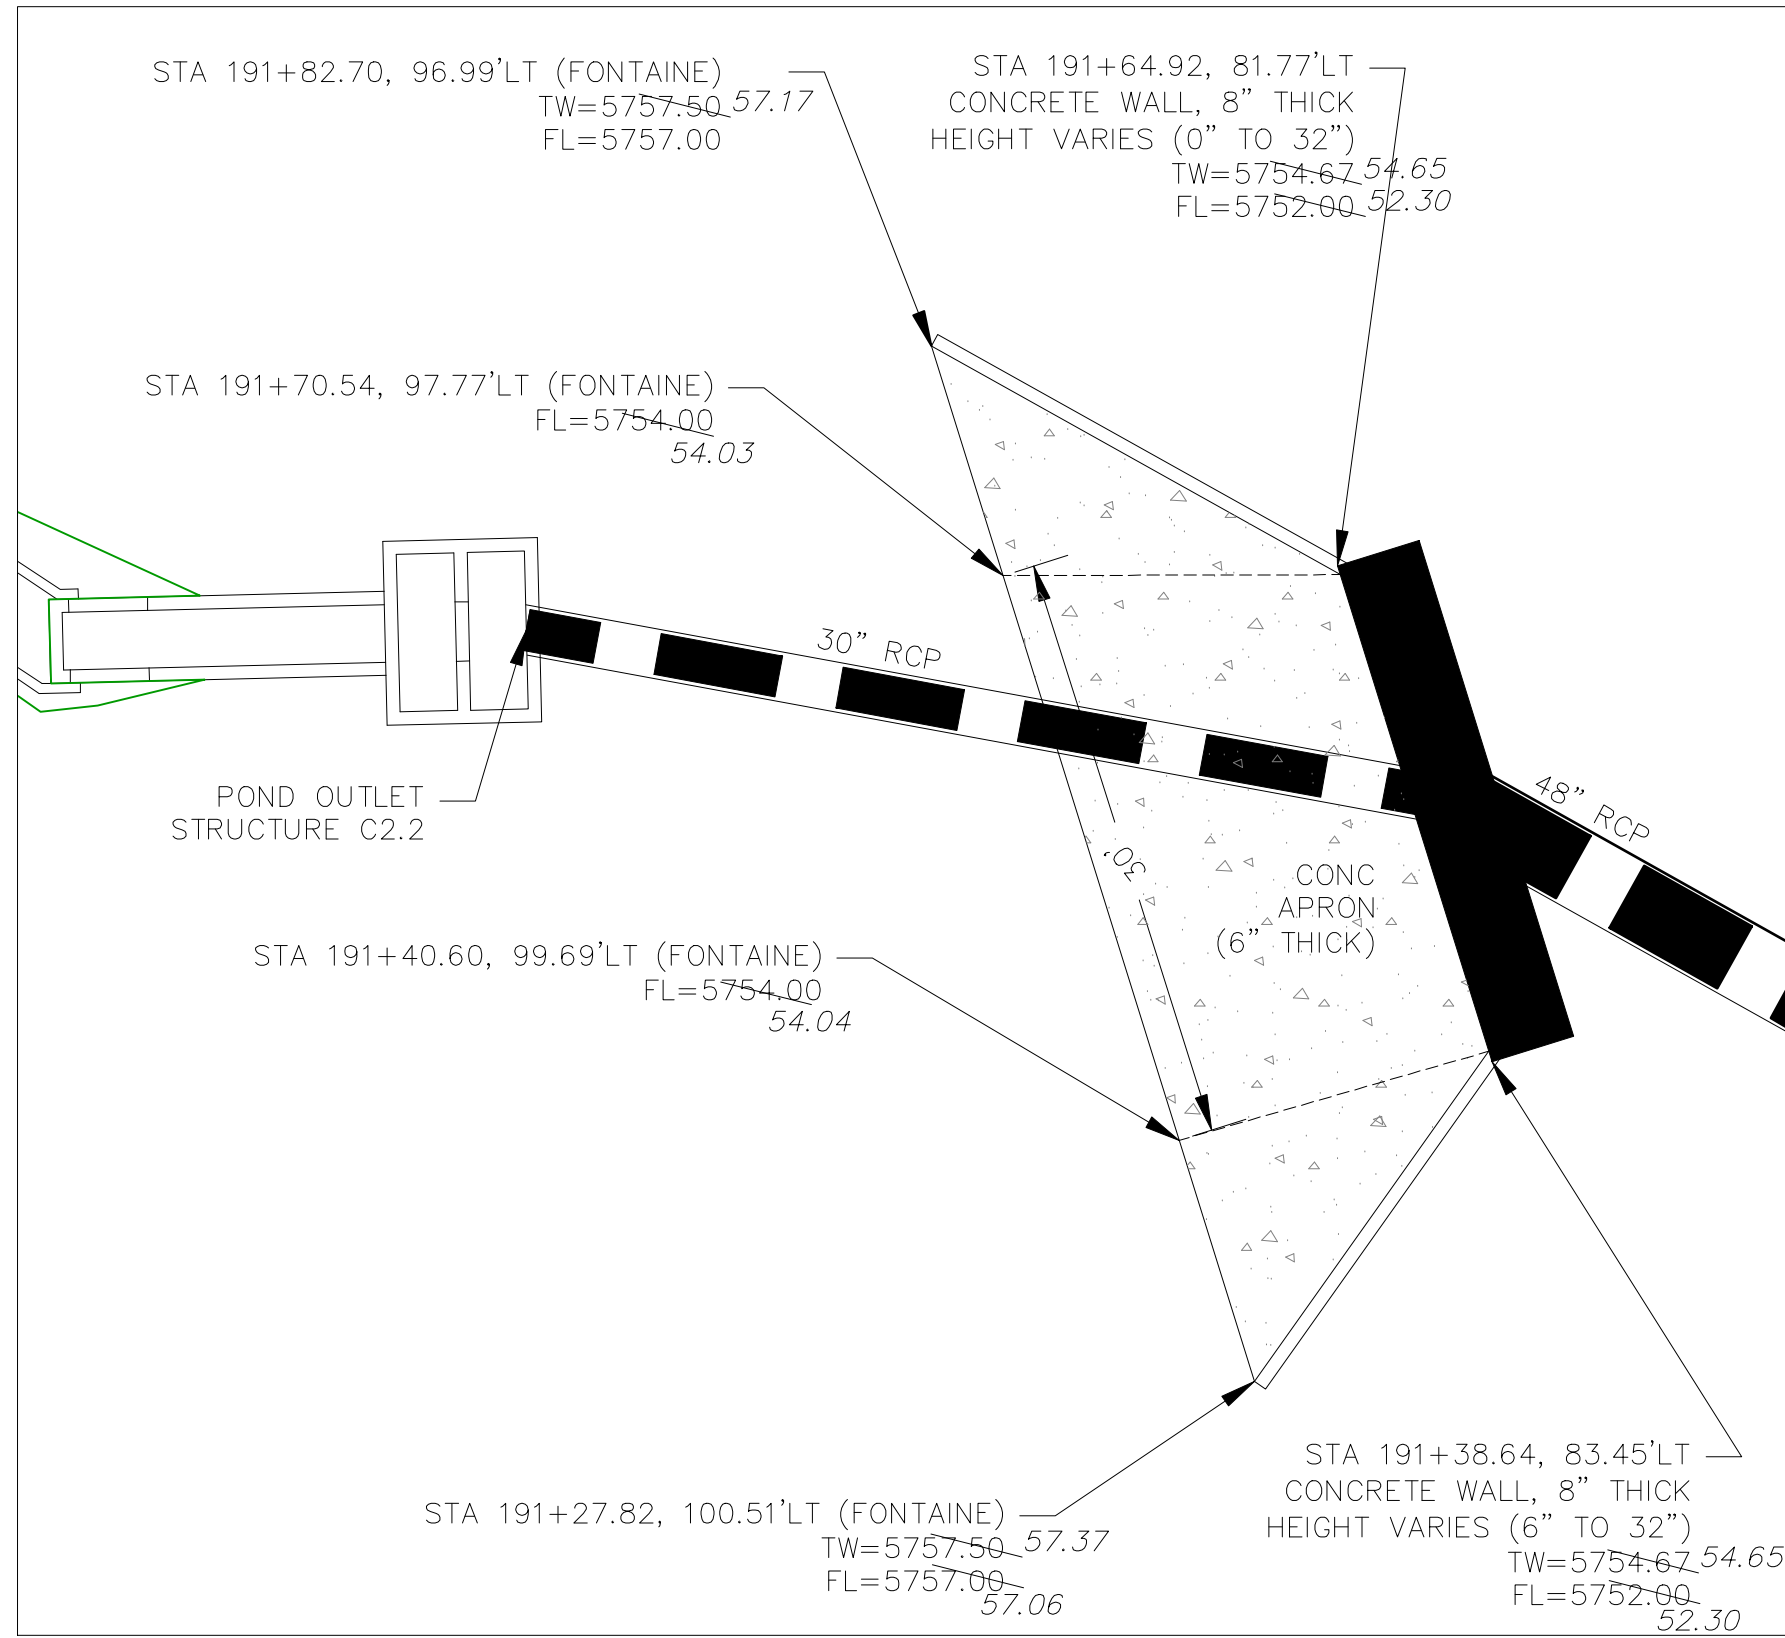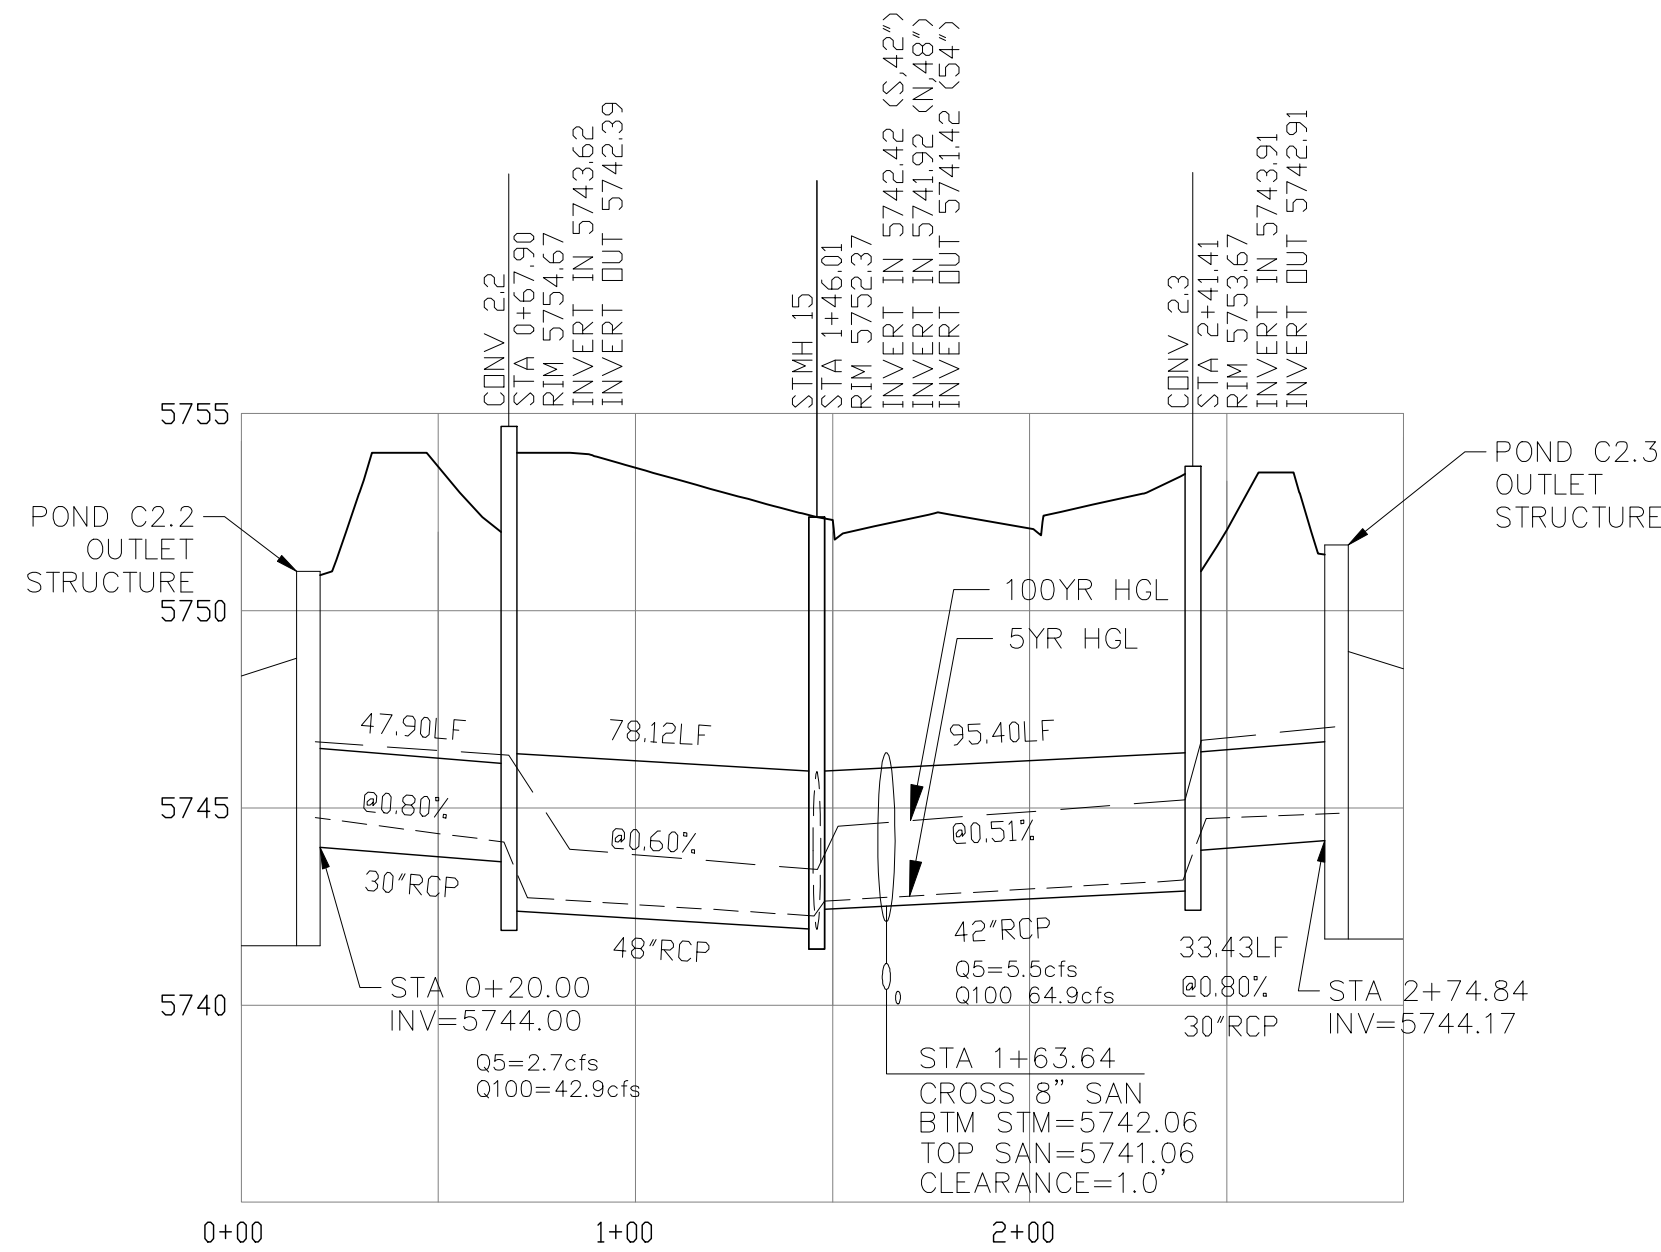


CONVEYANCE STRUCTURE #2.2

SCALE: 1"=10'

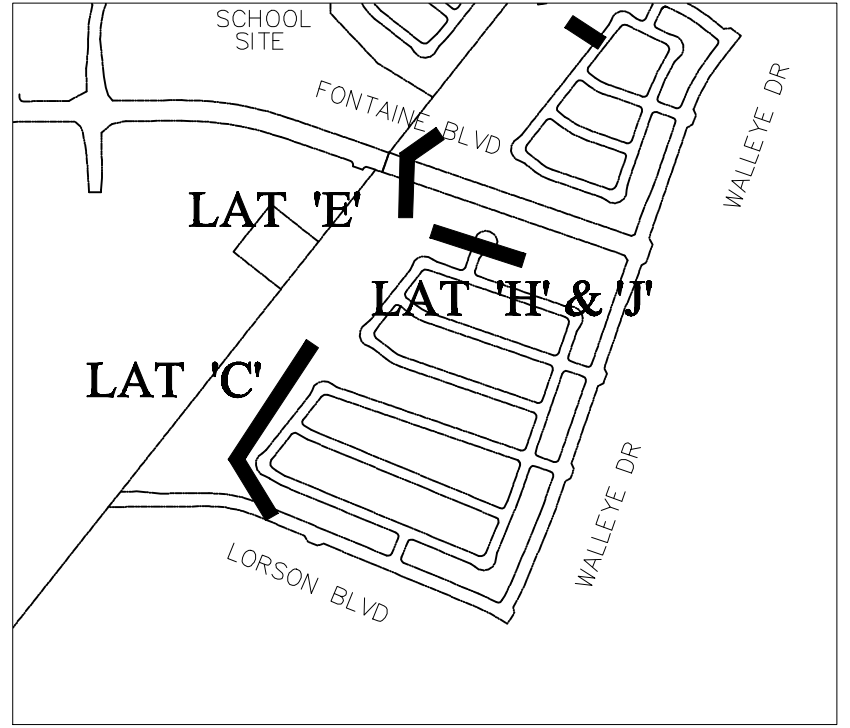

CONVEYANCE STRUCTURE #2.2 NOTES:

1. 25' CDOT TYPE R INLET WITH MODIFIED THROAT OPENING
2. THROAT OPENING = 24"
3. EXTEND 1.25" GALVANIZED STEEL ROD SUPPORTS (TYPE R INLET) TO ACCOMMODATE 24" THROAT OPENING
4. CONCRETE APRON TO BE REINFORCED WITH NO. 4 REBAR, 24" O.C. BOTH WAYS. REBAR TO EXTEND INTO CONCRETE WALL W/ NO. 4 "L" BARS, 18" O.C.
5. CONCRETE WALLS SHALL HAVE A MINIMUM OF TWO HORIZONTAL NO. 4 BARS
6. 24" THROAT OPENING TO INCLUDE SAFETY GRATE.

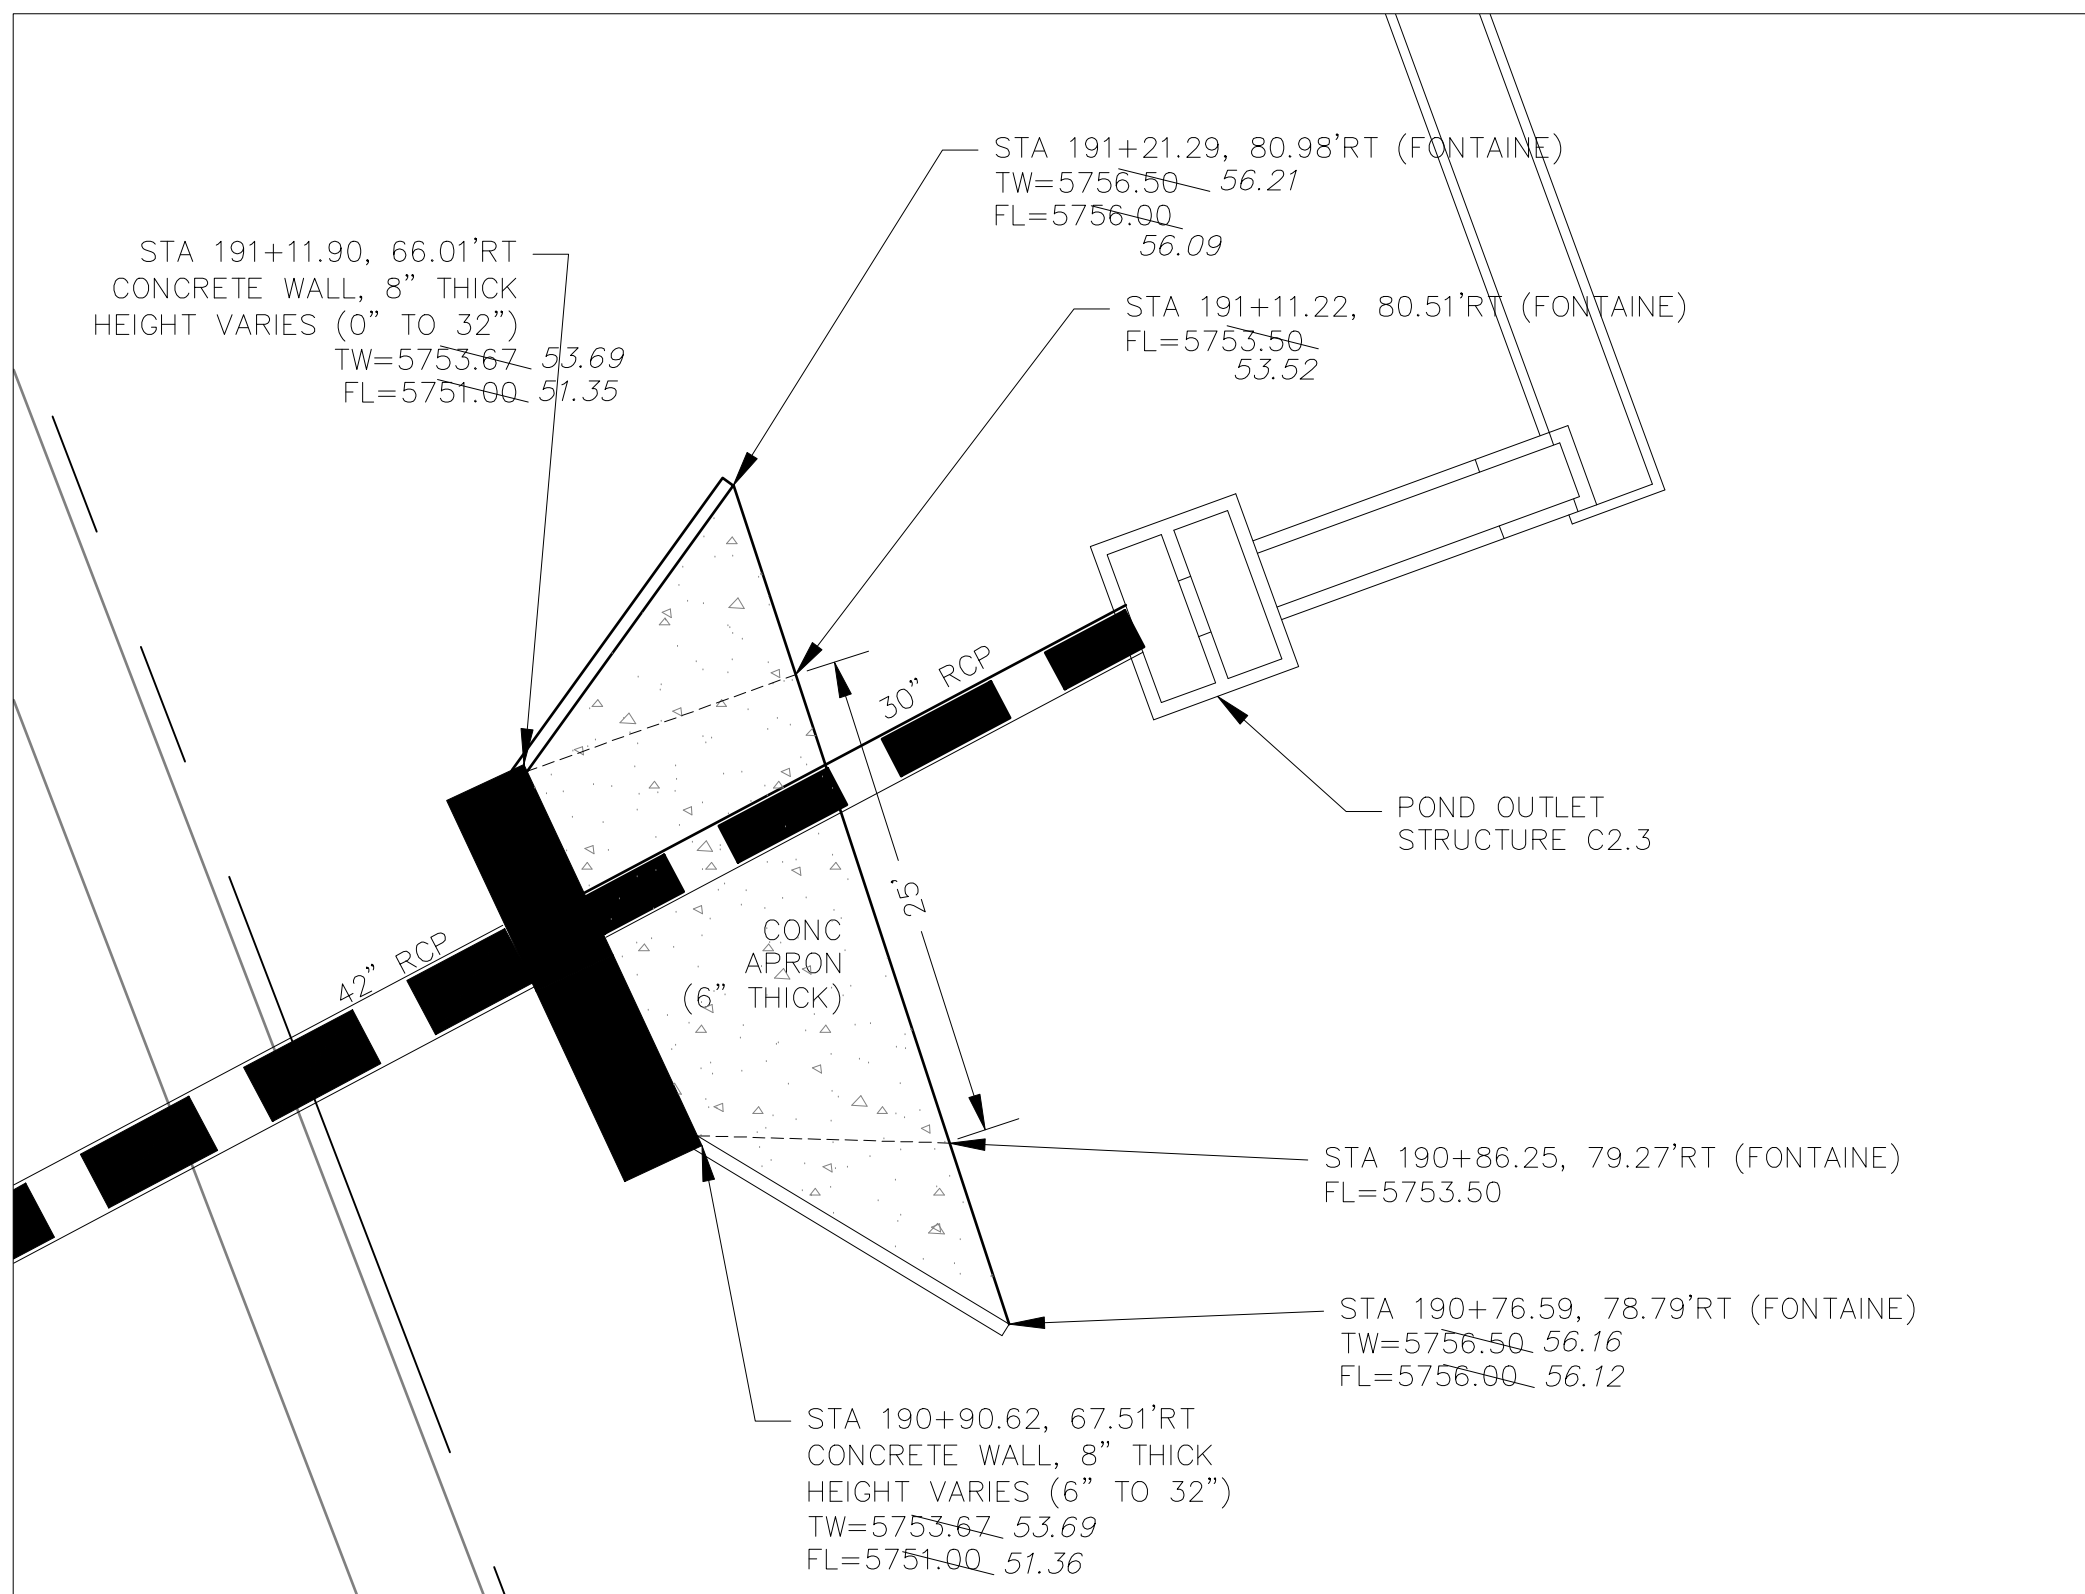

CONVEYANCE STRUCTURE #2.3

SCALE: 1"=10'

CONVEYANCE STRUCTURE #2.3 NOTES:

1. 20' CDOT TYPE R INLET WITH MODIFIED THROAT OPENING
2. THROAT OPENING = 24"
3. EXTEND 1.25" GALVANIZED STEEL ROD SUPPORTS (TYPE R INLET) TO ACCOMMODATE 24" THROAT OPENING
4. CONCRETE APRON TO BE REINFORCED WITH NO. 4 REBAR, 24" O.C. BOTH WAYS. REBAR TO EXTEND INTO CONCRETE WALL W/ NO. 4 "L" BARS.
5. CONCRETE WALLS SHALL HAVE A MINIMUM OF TWO HORIZONTAL NO. 4 BARS
6. 24" THROAT OPENING TO INCLUDE SAFETY GRATE.

AS-BUILT
DATE: 09/30/2022

CORE
ENGINEERING GROUP
15004 1ST AVENUE S
BURNSVILLE, MN 55306
CONTACT: RICHARD L. SCHINDLER, P.E.
EMAIL: Rich@ceg1.com

DATE: JAN 12, 2021
DESCRIPTION: RAISE SITE 1' EAST OF POWERLINES
PROJECT: THE HILLS COLLECTOR STREET CONSTRUCTION
PREPARED FOR: LORSON, LLC
212 N. WAHSATCH AVE SUITE 301
COLORADO SPRINGS, COLORADO 80903
CONTACT: JEFF MARK


NO. 1
DRAWN: RLS
DESIGNED: RLS
CHECKED: RLS

DATE: NOV 12, 2020
PROJECT NO. 100.061
SHEET NUMBER C7.2
TOTAL SHEETS: 58






STREET & STORM SEWER PLAN/PROFILE
STORM LATERAL 'E'
CONVEYANCE #2.2 & #2.3



DATE: NOV 12, 2020
PROJECT NO. 100.061
SHEET NUMBER C7.2
TOTAL SHEETS: 58

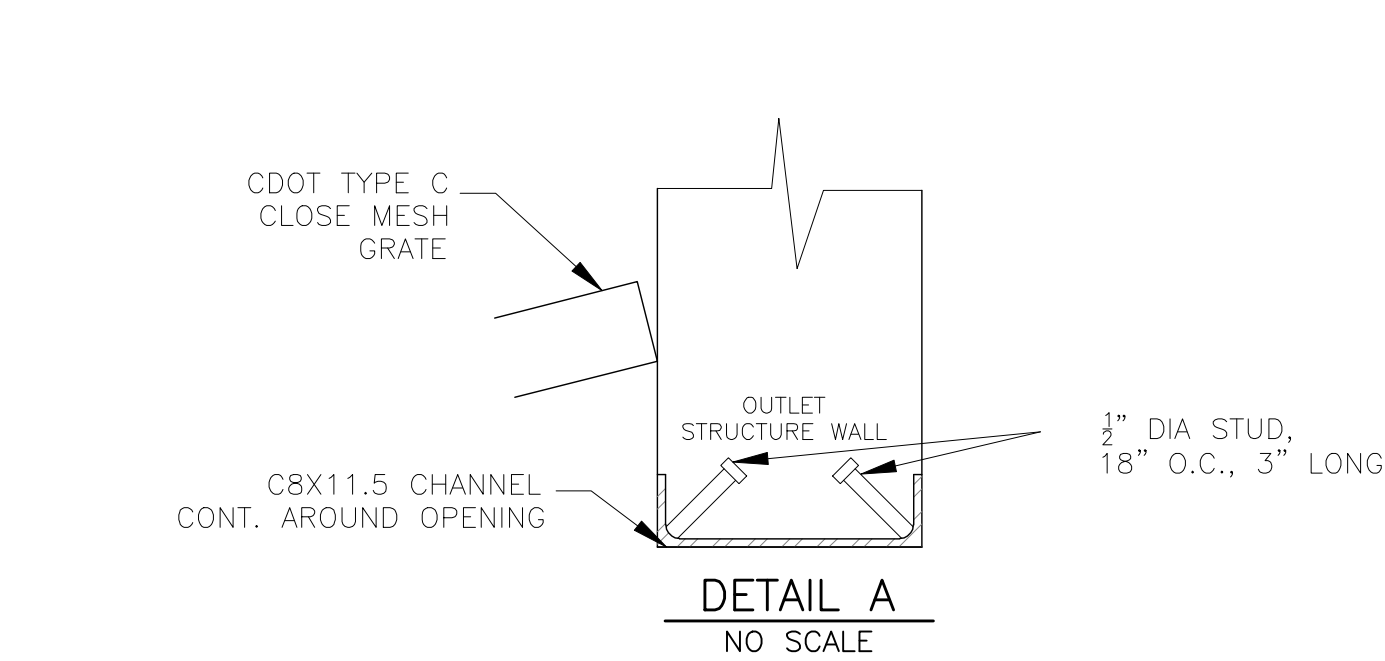

NOTE:
AFTER CONCRETE STRUCTURE HAS BEEN POURED
ALL GRATE DIMENSIONS SHALL BE FIELD VERIFIED
PRIOR TO GRATE CONSTRUCTION

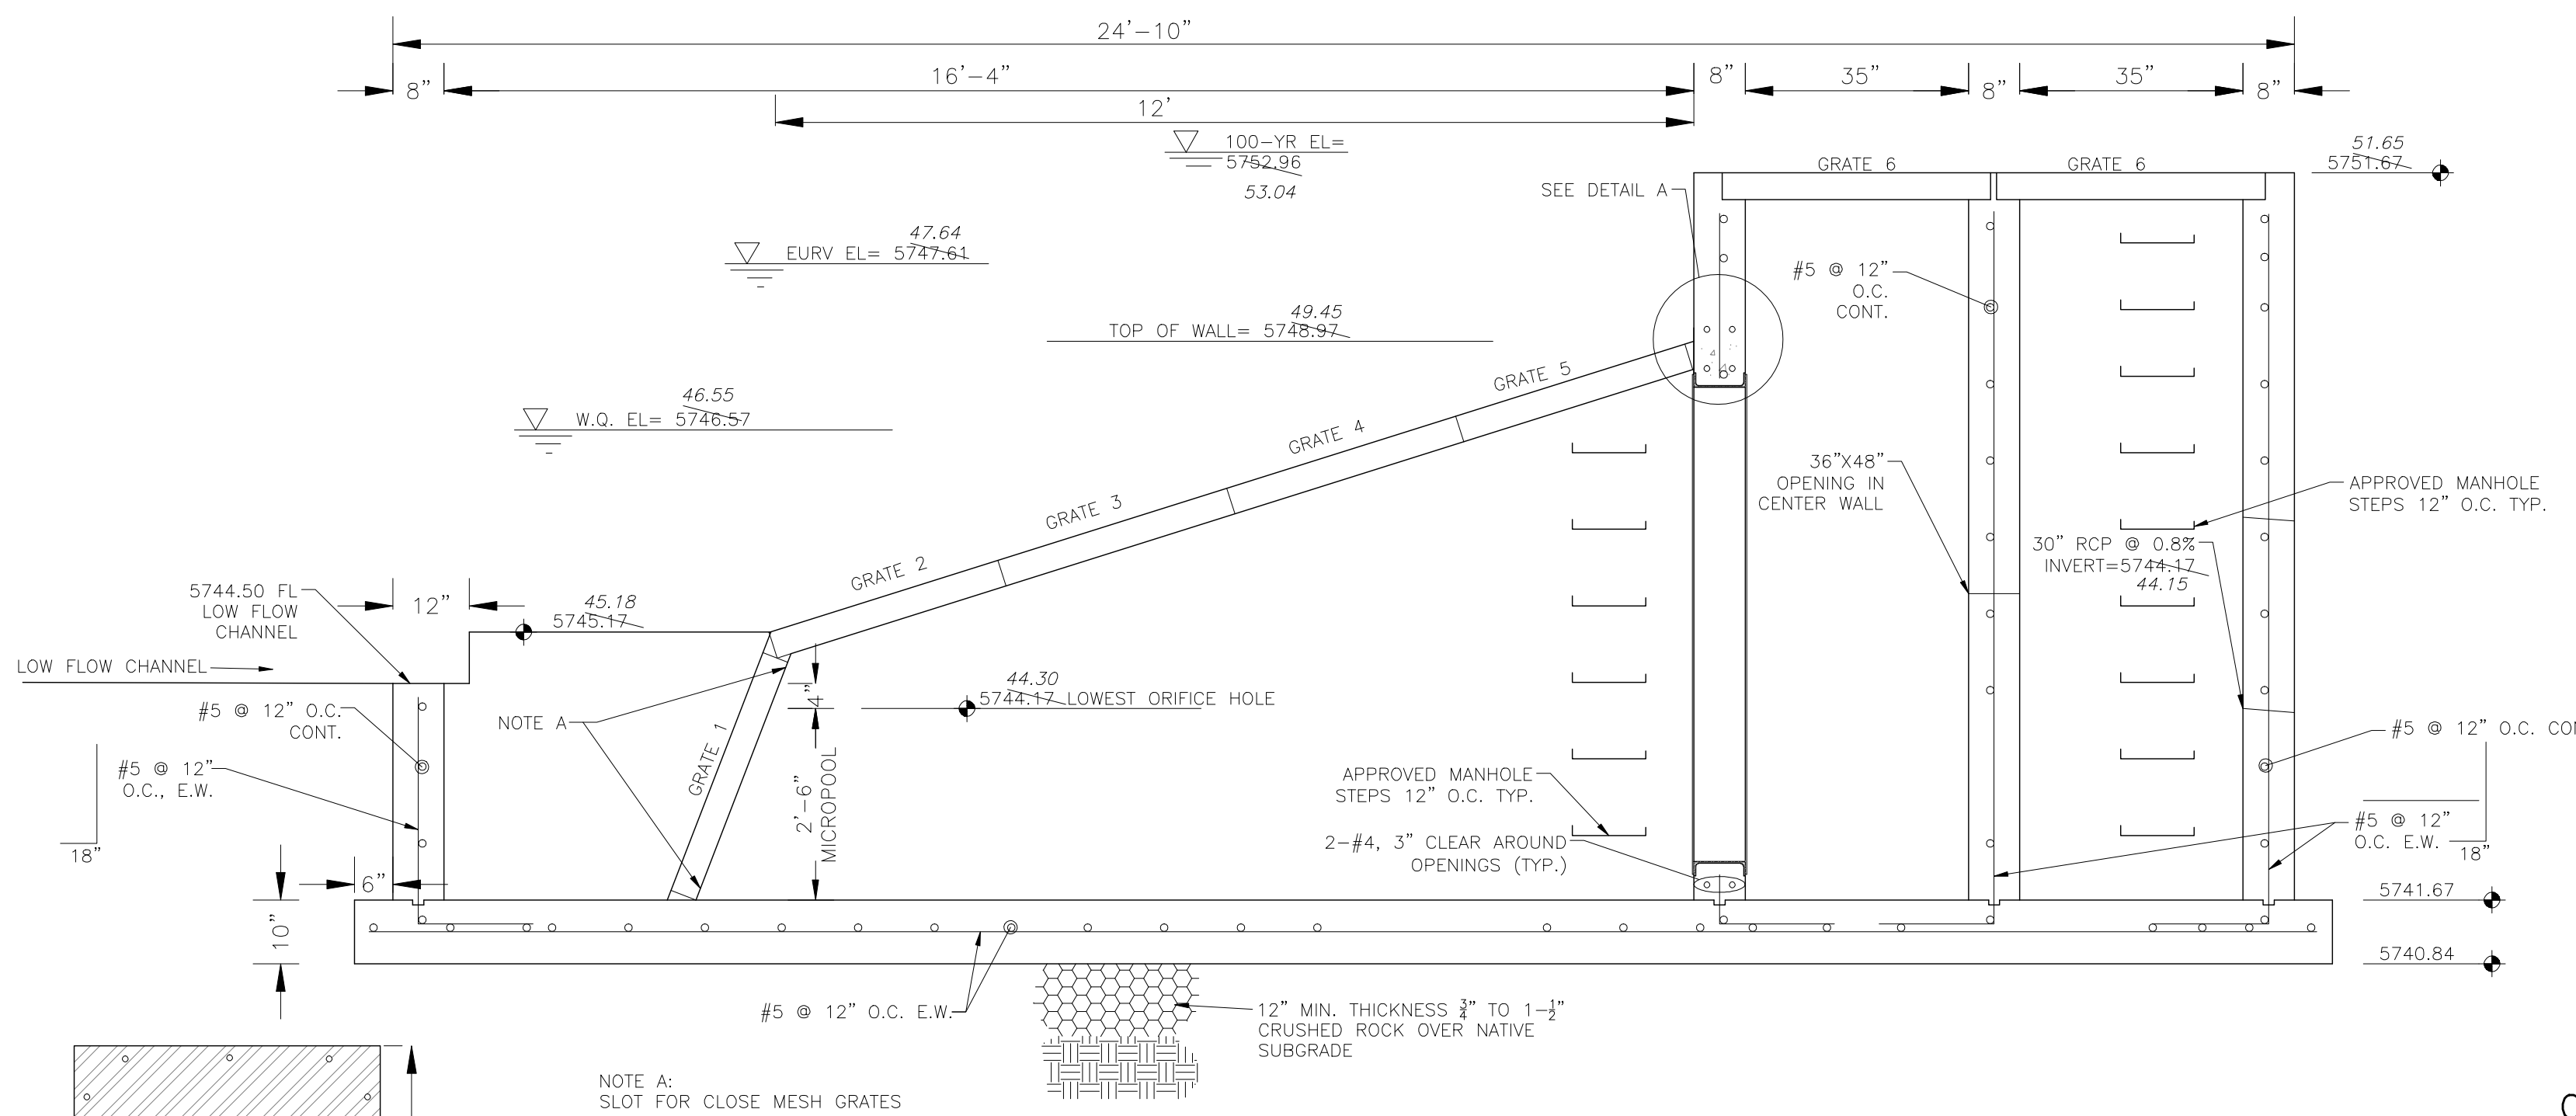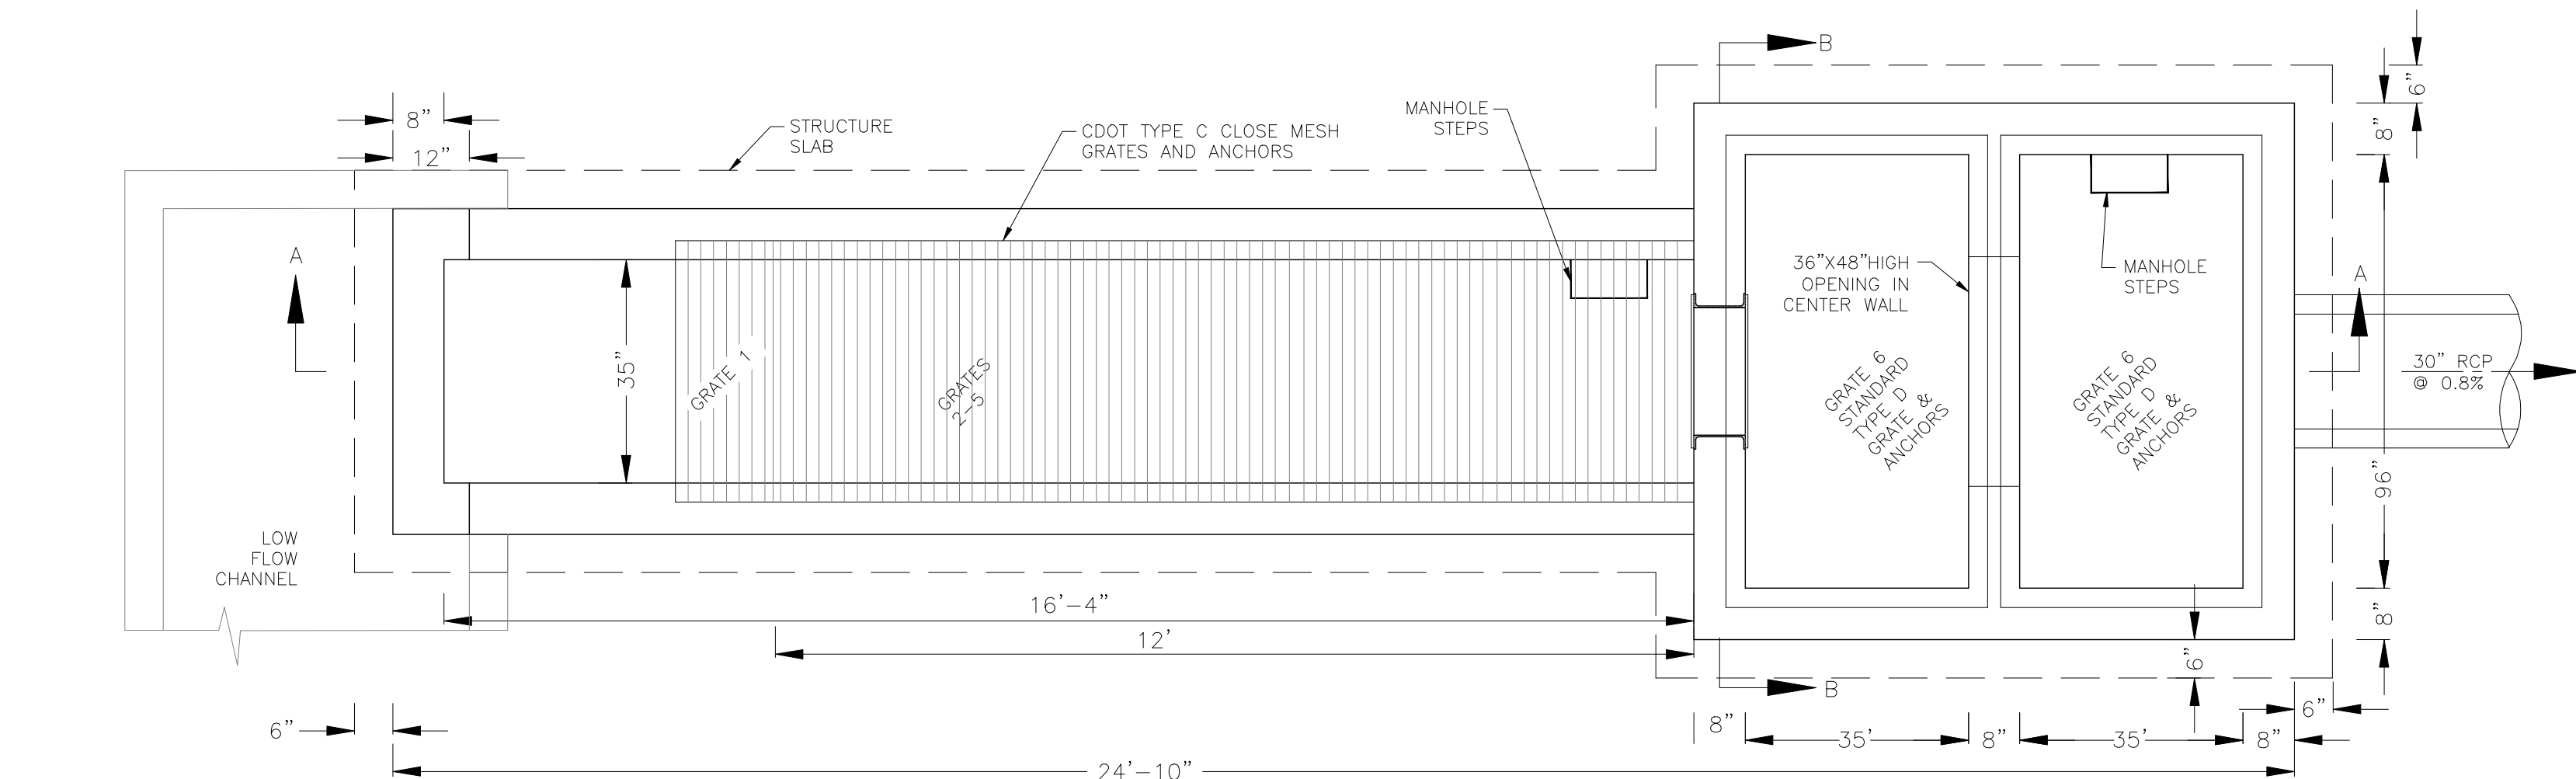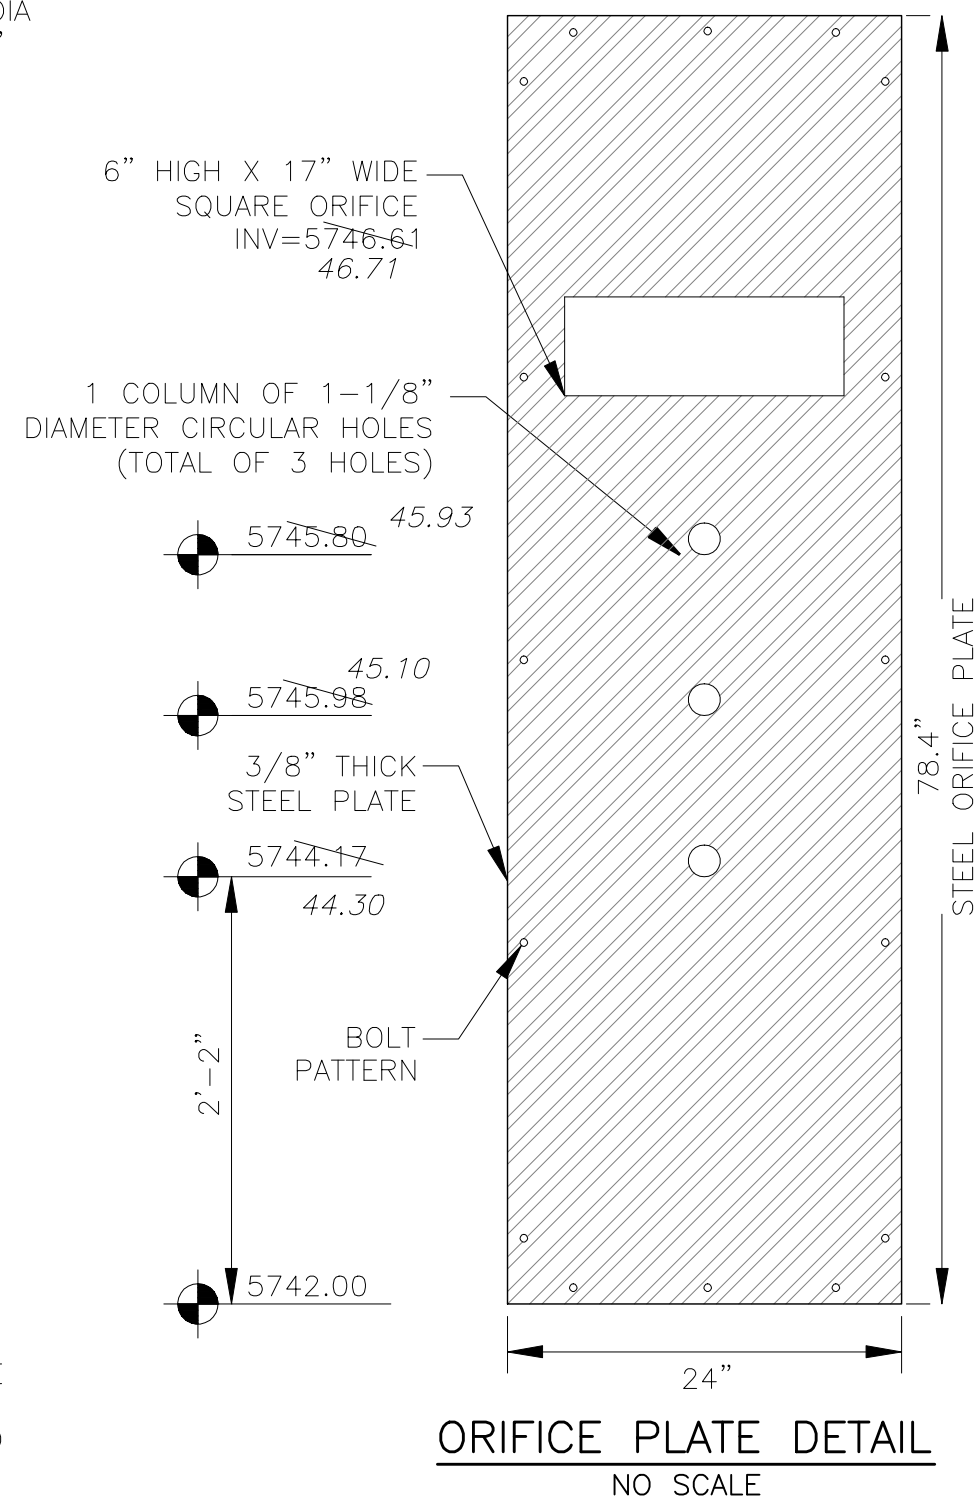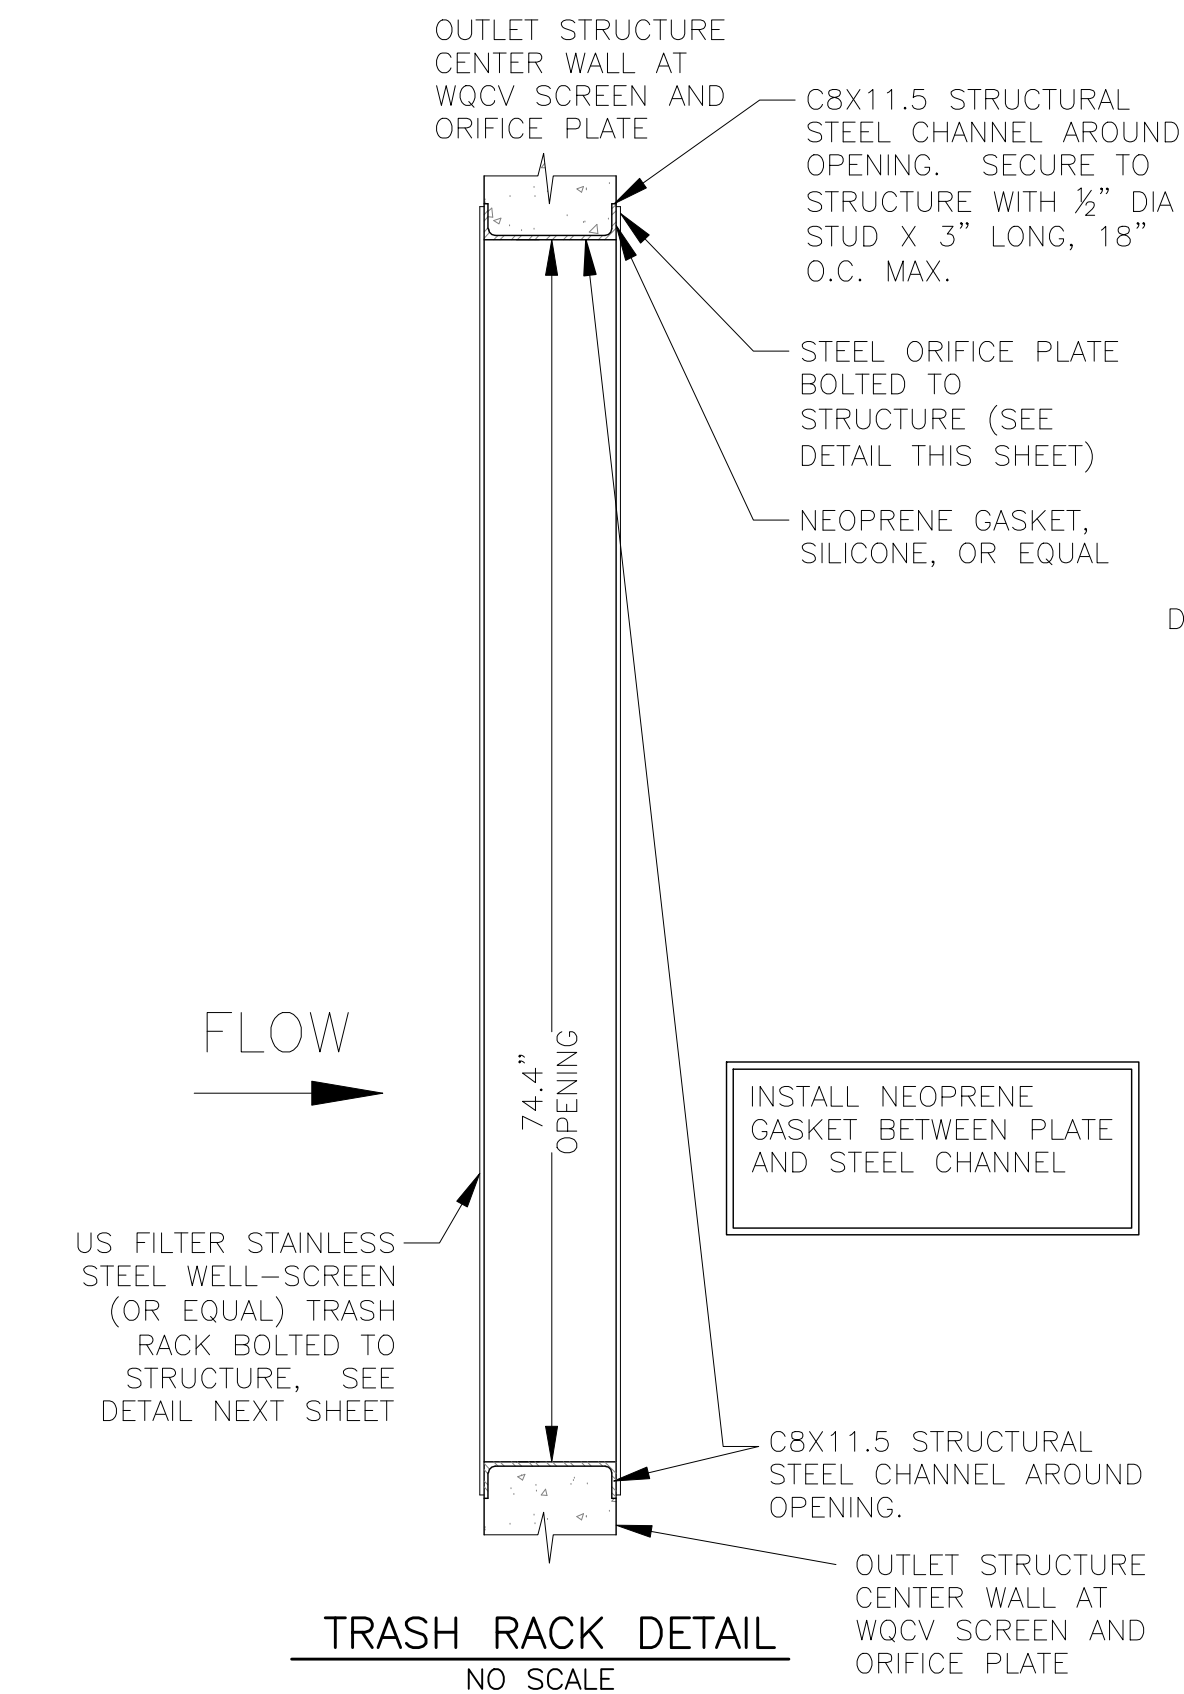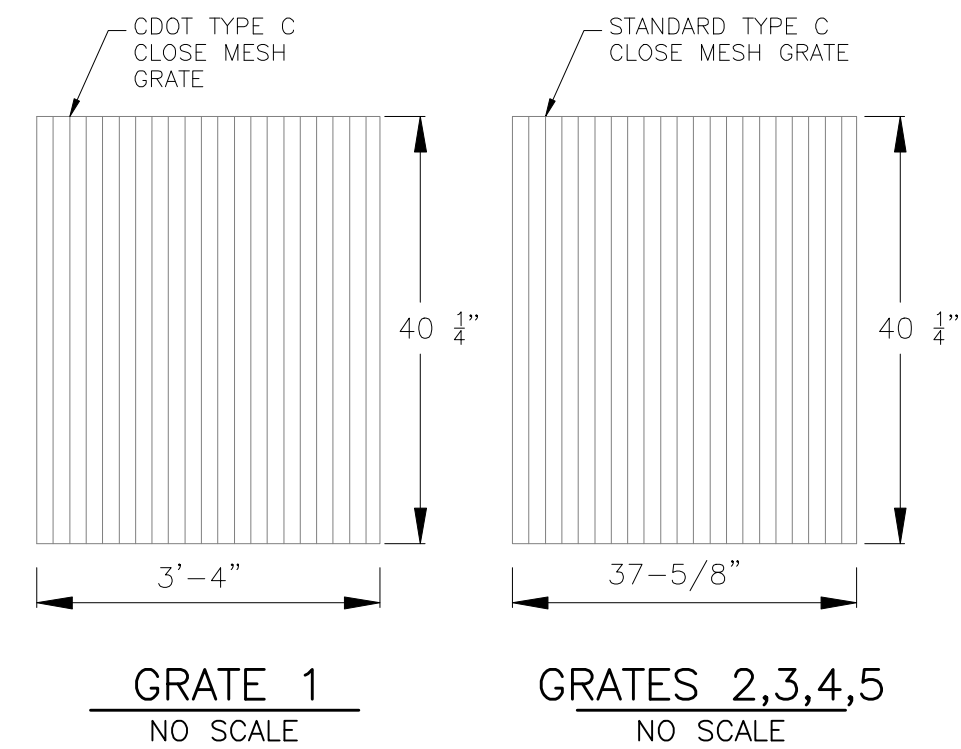



OUTLET STRUCTURE, FOREBAY, AND DRAIN CHANNEL NOTES:

- PRIOR TO CONSTRUCTION, CONTRACTOR SHALL PROVIDE SHOP DRAWINGS FOR ALL COMPONENTS OF THE OUTLET STRUCTURE.
- GRADE 60 REINFORCING STEEL REQUIRED. SEE TABLE FOR THE MINIMUM LAP SPLICE LENGTH FOR REINFORCING BARS. ALL REINFORCING STEEL SHALL HAVE A TWO-INCH MINIMUM CLEARANCE FROM EDGE OF CONCRETE, UNLESS OTHERWISE NOTED.
- CONCRETE FOR THE OUTLET STRUCTURE AND FOREBAY SHALL BE CDOT CLASS D CONCRETE.
- CONCRETE FOR DRAIN CHANNELS SHALL BE CDOT CLASS B CONCRETE
- EXPANSION JOINT MATERIAL SHALL MEET AASHTO SPECIFICATION M-213. EXPANSION JOINT MATERIAL SHALL BE 1/2" THICK, SHALL EXTEND THE FULL DEPTH OF CONTACT SURFACE AND THE JOINT SHALL BE SEALED, REFER TO DETAILS.
- ALL EXPOSED CONCRETE CORNERS SHALL HAVE A 3/8" CHAMFER UNLESS OTHERWISE NOTED.
- SUBGRADE TO BE 12" THICK CLEAN FILL COMPACTED TO 95% STANDARD PROCTOR DENSITY PER ASTM M698 UNDER STRUCTURE.
- REFER TO POND DETAILS FOR PRESEDIMENTATION/FOREBAY DESIGN.
- ENGINEER SHALL BE NOTIFIED PRIOR TO BEGINNING CONSTRUCTION OF OUTLET STRUCTURE TO SCHEDULE OBSERVATION VISITS FOR STRUCTURES.

BAR SIZE	#4	#5	#6
MIN. SPLICE LENGTH	1'-3"	1'-7"	2'-0"

WQCV WELL-SCREEN NOTES:

- Well-Screen shall be stainless steel and attached by stainless steel bolts along edge of the mounting frame.
- WQCV Well Screen
 - Type of Screen: Stainless steel #93 Vee Wire (Johnson Vee Wire (tm) Stainless Steel Screen or equivalent with 60% open area)
 - Screen slot opening dimension: 0.139" (Screen #93 Vee Wire Slot Opening)
 - Type and Size of Support Rod: TE 0.074"x0.50"
 - Spacing of Support Rod (O.C.): 1.0 Inch
 - Total Screen Thickness: 0.655"
 - Carbon Steel Holding Frame Type: 3/4" x 1.0" angle

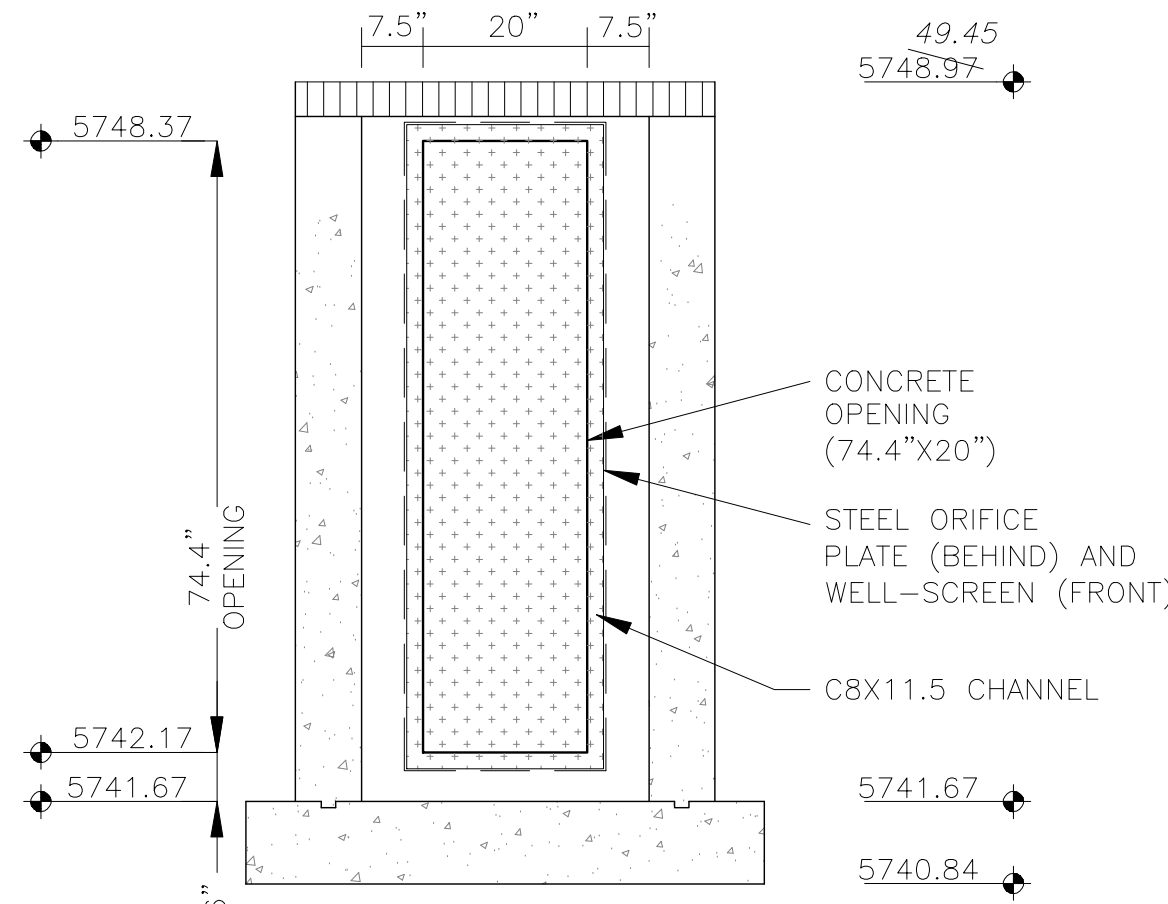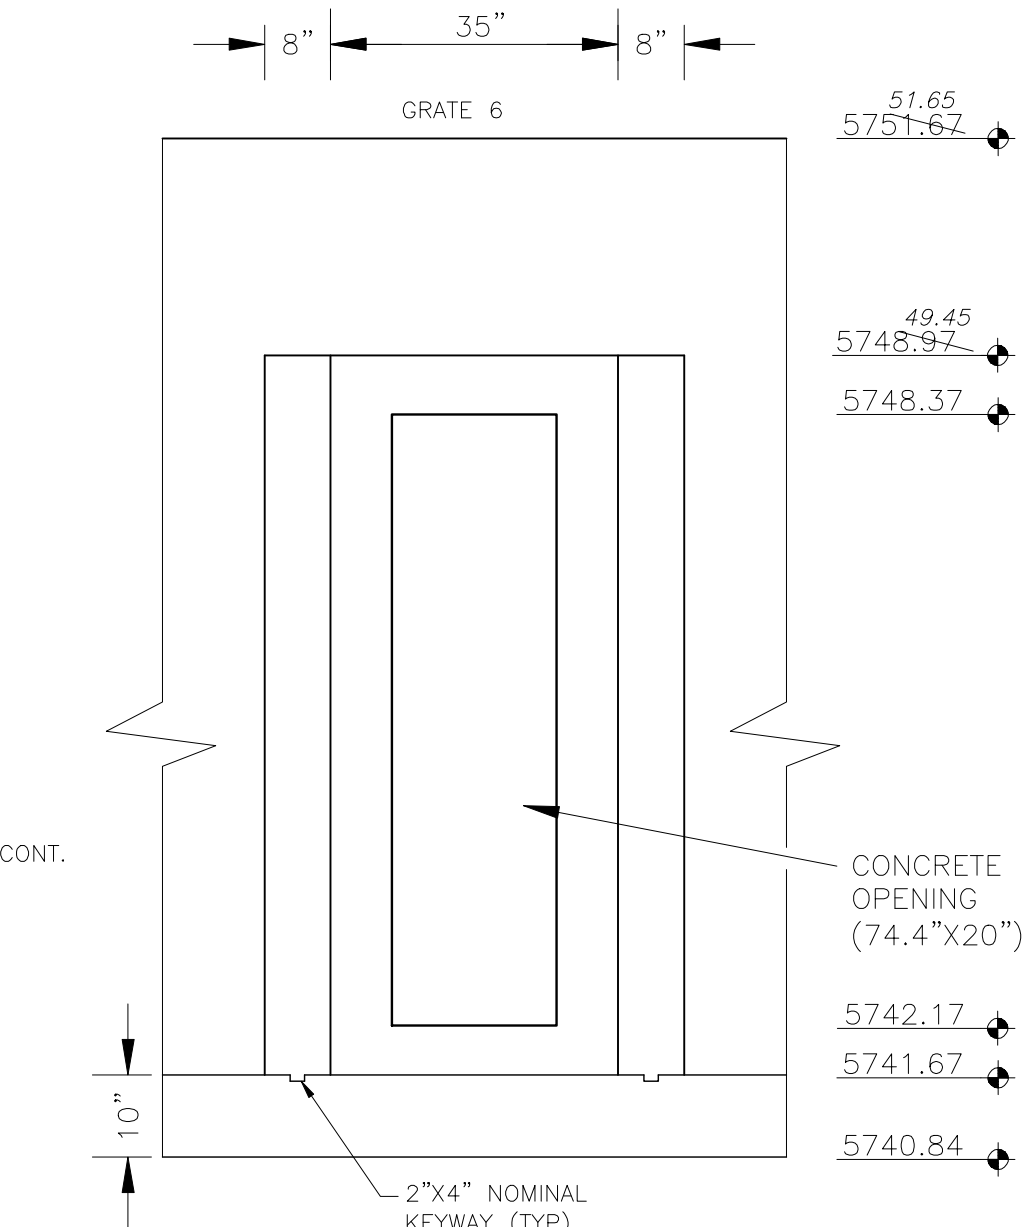

AS-BUILT
DATE: 09/30/2022

CORE
ENGINEERING GROUP

15004 1ST AVENUE S
BURNSVILLE, MN 55306
CONTACT: RICHARD L. SCHINDLER, P.E.
EMAIL: Rich@ceg.com

DATE: _____

DESCRIPTION: _____

NO: _____

PREPARED FOR:
LORSON, LLC
212 N. WAHSATCH AVE. SUITE 301
COLORADO SPRINGS, COLORADO 80903
CONTACT: JEFF MARK

PROJECT:
THE HILLS COLLECTOR STREET CONSTRUCTION
FONTAINE BLVD. - GRAYLING DR
LORSON BLVD.-WALLEYE DR-LAMPREY DR
COLORADO SPRINGS, COLORADO

DRAWN: **RLS**

DESIGNED: **RLS**

CHECKED: **RLS**

POND C2.3
FULL SPECTRUM
OUTLET STRUCTURE DETAILS

DATE:
NOV 12, 2020

PROJECT NO.
100.061

SHEET NUMBER
C9.14


TOTAL SHEETS: 58

DETENTION BASIN OUTLET STRUCTURE DESIGN

MHFD-Detention, Version 4.02 (February 2020)

Project: The Hills at Lorson Ranch

Basin ID: Pond C3-asbuilt

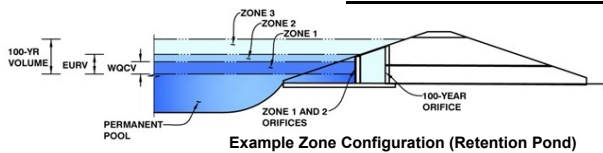

Example Zone Configuration (Retention Pond)

	Estimated Stage (ft)	Estimated Volume (ac-ft)	Outlet Type
Zone 1 (WQCV)	3.27	0.459	Orifice Plate
Zone 2 (EURV)	4.37	0.858	Rectangular Orifice
Z3 (100+1/2WQCV)	5.66	1.346	Weir&Pipe (Restrict)
Total (all zones)		2.663	

User Input: Orifice at Underdrain Outlet (typically used to drain WQCV in a Filtration BMP)

Underdrain Orifice Invert Depth =	N/A	ft (distance below the filtration media surface)
Underdrain Orifice Diameter =	N/A	inches

Calculated Parameters for Underdrain	
Underdrain Orifice Area =	N/A ft ²
Underdrain Orifice Centroid =	N/A feet

User Input: Orifice Plate with one or more orifices or Elliptical Slot Weir (typically used to drain WQCV and/or EURV in a sedimentation BMP)

Invert of Lowest Orifice =	0.00	ft (relative to basin bottom at Stage = 0 ft)
Depth at top of Zone using Orifice Plate =	3.27	ft (relative to basin bottom at Stage = 0 ft)
Orifice Plate: Orifice Vertical Spacing =	N/A	inches
Orifice Plate: Orifice Area per Row =	1.20	sq. inches (diameter = 1-1/4 inches)

Calculated Parameters for Plate	
WQ Orifice Area per Row =	8.333E-03 ft ²
Elliptical Half-Width =	N/A feet
Elliptical Slot Centroid =	N/A feet
Elliptical Slot Area =	N/A ft ²

User Input: Stage and Total Area of Each Orifice Row (numbered from lowest to highest)

	Row 1 (required)	Row 2 (optional)	Row 3 (optional)	Row 4 (optional)	Row 5 (optional)	Row 6 (optional)	Row 7 (optional)	Row 8 (optional)
Stage of Orifice Centroid (ft)	0.00	1.02	2.02					
Orifice Area (sq. inches)	1.20	1.20	1.20					

	Row 9 (optional)	Row 10 (optional)	Row 11 (optional)	Row 12 (optional)	Row 13 (optional)	Row 14 (optional)	Row 15 (optional)	Row 16 (optional)
Stage of Orifice Centroid (ft)								
Orifice Area (sq. inches)								

User Input: Vertical Orifice (Circular or Rectangular)

	Zone 2 Rectangular	Not Selected	
Invert of Vertical Orifice =	3.32	N/A	ft (relative to basin bottom at Stage = 0 ft)
Depth at top of Zone using Vertical Orifice =	4.37	N/A	ft (relative to basin bottom at Stage = 0 ft)
Vertical Orifice Height =	6.00	N/A	inches
Vertical Orifice Width =	14.00		inches

Calculated Parameters for Vertical Orif		
	Zone 2 Rectangular	Not Selected
Vertical Orifice Area =	0.58	N/A
Vertical Orifice Centroid =	0.25	N/A

User Input: Overflow Weir (Dropbox with Flat or Sloped Gate and Outlet Pipe OR Rectangular/Trapezoidal Weir (and No Outlet Pipe)

	Zone 3 Weir	Not Selected	
Overflow Weir Front Edge Height, Ho =	6.73	N/A	ft (relative to basin bottom at Stage = 0 ft)
Overflow Weir Front Edge Length =	6.00	N/A	feet
Overflow Weir Gate Slope =	0.00	N/A	H:V
Horiz. Length of Weir Sides =	6.00	N/A	feet
Overflow Gate Open Area % =	70%	N/A	% gate open area/total area
Debris Clogging % =	50%	N/A	%

	Zone 3 Weir	Not Selected
0 ft) Height of Gate Upper Edge, H_1 =	6.73	N/A
Overflow Weir Slope Length	6.00	N/A
Gate Open Area / 100-yr Orifice Area =	10.87	N/A
Overflow Gate Open Area w/o Debris =	25.20	N/A
Overflow Gate Open Area w/ Debris =	12.60	N/A

User Input: Outlet Pipe w/ Flow Restriction Plate (Circular Orifice, Restrictor Plate, or Rectangular Orifice)

	Zone 3 Restrictor	Not Selected	
Depth to Invert of Outlet Pipe =	0.17	N/A	ft (distance below basin bottom at Stage = 0 ft)
Outlet Pipe Diameter =	24.00	N/A	inches
Restrictor Plate Height Above Pipe Invert =	16.60		inches

Calculated Parameters for Outlet Pipe w/ Flow Restriction Plate		
	Zone 3 Restrictor	Not Selected
Outlet Orifice Area =	2.32	N/A
Outlet Orifice Centroid =	0.77	N/A
Half-Central Angle of Restrictor Plate on Pipe =	1.96	N/A

User Input: Emergency Spillway (Rectangular or Trapezoidal)

Spillway Invert Stage =	9.59	ft (relative to basin bottom at Stage = 0 ft)
Spillway Crest Length =	20.00	feet
Spillway End Slopes =	4.00	H:V
Freeboard above Max Water Surface =	1.68	feet

Calculated Parameters for Spillway		
Spillway Design Flow Depth=	1.32	feet
Stage at Top of Freeboard =	12.59	feet
Basin Area at Top of Freeboard =	1.66	acres
Basin Volume at Top of Freeboard =	9.74	acre-ft

micropool = 0 = 5755.15


Routed Hydrograph Results

The user can override the default CUHP hydrographs and runoff volumes by entering new values in the Inflow Hydrographs table (Columns W through AF)

	WQCV	EURV	2 Year	5 Year	10 Year	25 Year	50 Year	100 Year
Design Storm Return Period =	N/A	N/A	1.19	1.50	1.75	2.00	2.25	2.52
One-Hour Rainfall Depth (in) =	N/A	N/A	1.426	2.032	2.557	3.174	3.723	4.395
CUHP Runoff Volume (acre-ft) =	0.459	1.316	1.426	2.032	2.557	3.174	3.723	4.395
User Override Inflow Hydrograph Volume (acre-ft) =	N/A	N/A	3.549	5.555	7.674	10.126	12.221	14.786
CUHP Predevelopment Peak Q (cfs) =	N/A	N/A	5.6	12.2	17.2	27.0	33.3	41.0
OPTIONAL Override Predevelopment Peak Q (cfs) =	N/A	N/A						
Predevelopment Unit Peak Flow, q (cfs/acre) =	N/A	N/A	0.22	0.47	0.66	1.04	1.28	1.58
Peak Inflow Q (cfs) =	N/A	N/A	28.0	41.4	54.0	82.0	98.8	115.3
Peak Outflow Q (cfs) =	0.2	2.7	3.7	5.0	22.5	30.2	31.4	32.8
Ratio Peak Outflow to Predevelopment Q =	N/A	N/A	N/A	0.4	1.3	1.1	0.9	0.8
Structure Controlling Flow =	Plate	Vertical Orifice 1	Vertical Orifice 1	Vertical Orifice 1	Overflow Weir 1	Outlet Plate 1	Outlet Plate 1	Outlet Plate 1
Max Velocity through Gate 1 (fps) =	N/A	N/A	N/A	N/A	0.7	1.0	1.0	1.0
Max Velocity through Gate 2 (fps) =	N/A	N/A	N/A	N/A	N/A	N/A	N/A	N/A
Time to Drain 97% of Inflow Volume (hours) =	38	48	50	48	44	39	34	29
Time to Drain 99% of Inflow Volume (hours) =	40	52	57	59	57	55	53	51
Maximum Ponding Depth (ft) =	3.27	4.37	5.09	6.39	7.20	7.91	8.50	9.24
Area at Maximum Ponding Depth (acres) =	0.57	0.93	1.06	1.18	1.26	1.32	1.39	1.48
Maximum Volume Stored (acre-ft) =	0.462	1.320	2.044	3.493	4.493	5.407	6.193	7.253

MHFD-Detention, Version 4.02 (February 2020)

Basin ID: Pond C3-asbuilt

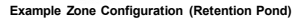

Depth Increment =	0.20	f
-------------------	------	---


Zone 1 Volume (V_{QVC1}) =	0.459	acre-feet
Zone 2 Volume ($E_{URV} - Zone 1$) =	0.858	acre-feet
Zone 3 (100yr + 1 / 2 $W_{QVC} - Zones 1 \& 2$) =	1.346	acre-feet
Total Detention Basin Volume =	2.663	acre-feet
Initial Surge Volume (ISV) =	user	ft ³
Initial Surge Depth (ISD) =	user	ft
Total Available Detention Depth ($H_{(DAS)}$) =	user	ft
Depth of Trickle Channel (H_{TC}) =	user	ft
Slope of Trickle Channel (S_{TC}) =	user	ft/ft
Slopes of Main Basin Sides ($S_{(main)}$) =	user	H:V
Basin Length-to-Width Ratio ($R_{(L/W)}$) =	user	
Initial Surge Area (A_{ISV}) =	user	ft ²
Surcharge Volume Length (L_{ISV}) =	user	ft
Surcharge Basin Width (W_{ISV}) =	user	ft
Depth of Basin Floor ($H_{(FLOOR)}$) =	user	ft
Length of Basin Floor ($L_{(FLOOR)}$) =	user	ft
Width of Basin Floor ($W_{(FLOOR)}$) =	user	ft
Area of Basin Floor ($A_{(FLOOR)}$) =	user	ft ²
Volume of Basin Floor ($V_{(FLOOR)}$) =	user	ft ³
Depth of Main Basin ($H_{(MAIN)}$) =	user	ft
Length of Main Basin ($L_{(MAIN)}$) =	user	ft
Width of Main Basin ($W_{(MAIN)}$) =	user	ft
Area of Main Basin ($A_{(MAIN)}$) =	user	ft ²
Volume of Main Basin ($V_{(MAIN)}$) =	user	ft ³
Calculated Total Basin Volume ($V_{(TAS)}$) =	user	acre-feet

[illegible]

Pond C3 Developed Inflow Hydrograph --- asbuilt Pond C4 Outflow + C10 Basin

Pond C3 Inflow = asbuilt Pond C4 + direct tributary area

		2 Year		2yr	5 Year		5yr	10 Year		10yr	25 Year		25yr	50 Year		50yr	100 Year		100yr
Time	Time	Pond C4 Outflow2	CUHP	Combined	Pond C4 Outflow2	CUHP	Combined	Pond C4 Outflow2	CUHP	Combined	Pond C4 Outflow2	CUHP	Combined	Pond C4 Outflow2	CUHP	Combined	Pond C4 Outflow2	CUHP	Combined
[hr]	[min]	- [cfs]	2 Year [cfs]	Hydrograph	- [cfs]	5 Year [cfs]	Hydrograph	- [cfs]	10 Year [cfs]	Hydrograph	- [cfs]	25 Year [cfs]	Hydrograph	- [cfs]	50 Year [cfs]	Hydrograph	- [cfs]	100 Year [cfs]	Hydrograph
0.00	0.00	0.00	0.00	0.00	0.00	0.00	0.00	0.00	0.00	0.00	0.00	0.00	0.00	0.00	0.00	0.00	0.00	0.00	0.00
0.08	5.00	0.00	0.00	0.00	0.00	0.00	0.00	0.00	0.00	0.00	0.00	0.00	0.00	0.13	0.00	0.13	0.06	0.00	0.06
0.17	10.00	0.24	0.00	0.24	0.26	0.00	0.26	0.27	0.00	0.27	0.26	0.00	0.26	0.27	0.29	0.56	0.27	0.03	0.29
0.25	15.00	0.32	2.54	2.86	0.34	4.14	4.49	0.35	5.13	5.49	0.33	3.45	3.77	0.34	4.27	4.61	0.34	4.20	4.54
0.33	20.00	0.44	8.76	9.20	0.52	11.77	12.28	0.57	14.53	15.09	0.45	8.43	8.87	0.48	9.78	10.26	0.50	10.52	11.02
0.42	25.00	0.59	20.44	21.04	0.91	31.71	32.62	2.44	40.41	42.85	0.65	20.03	20.68	1.16	24.46	25.62	1.85	27.48	29.33
0.50	30.00	1.18	26.78	27.96	3.43	37.99	41.42	4.32	45.89	50.20	3.96	53.09	57.05	4.66	62.73	67.39	5.16	70.67	75.83
0.58	35.00	2.95	24.15	27.10	4.48	33.33	37.81	5.30	39.98	45.28	5.56	58.17	63.73	11.91	67.93	79.84	34.54	80.78	115.32
0.67	40.00	3.70	20.70	24.41	5.12	27.98	33.10	5.93	33.64	39.58	24.54	54.13	78.68	35.81	62.96	98.77	37.63	74.38	112.01
0.75	45.00	4.16	16.52	20.69	5.56	22.99	28.54	17.02	28.10	45.12	35.64	46.38	82.02	37.68	53.91	91.60	39.81	65.87	105.68
0.83	50.00	4.48	13.25	17.72	5.87	19.04	24.91	28.41	22.85	51.26	36.82	40.15	76.96	38.98	46.60	85.58	41.35	56.56	97.91
0.92	55.00	4.70	11.05	15.76	8.69	15.88	24.57	34.44	19.61	54.04	37.60	32.28	69.87	39.85	37.57	77.43	42.46	47.10	89.57
1.00	60.00	4.87	9.54	14.41	13.02	13.57	26.58	34.59	17.21	51.80	38.09	27.13	65.22	40.43	31.66	72.09	43.28	41.02	84.30
1.08	65.00	4.99	8.16	13.15	16.03	11.50	27.52	34.64	14.96	49.59	38.35	23.19	61.54	40.75	27.12	67.88	43.80	36.40	80.20
1.17	70.00	5.07	6.38	11.46	17.74	9.65	27.39	34.63	12.91	47.54	38.41	18.55	56.96	40.87	21.79	62.66	44.02	28.19	72.21
1.25	75.00	5.14	4.93	10.06	18.46	7.69	26.15	34.57	11.26	45.83	38.33	14.54	52.88	40.85	17.18	58.03	44.05	21.30	65.35
1.33	80.00	5.19	4.06	9.25	18.54	6.44	24.98	34.44	9.60	44.04	38.16	10.73	48.89	40.73	12.68	53.42	43.94	14.84	58.77
1.42	85.00	5.24	3.65	8.89	18.27	5.79	24.06	32.01	8.07	40.08	37.93	8.55	46.48	40.54	10.11	50.65	43.73	10.85	54.58
1.50	90.00	5.28	3.42	8.70	17.87	5.37	23.25	28.79	7.00	35.79	37.64	6.82	44.46	40.29	8.07	48.36	43.47	8.38	51.85
1.58	95.00	5.32	3.31	8.63	17.26	5.10	22.36	26.04	6.25	32.30	37.31	5.71	43.03	40.00	6.76	46.76	43.17	6.83	50.00
1.67	100.00	5.36	3.23	8.59	16.40	4.46	20.85	23.78	5.73	29.51	36.96	4.95	41.92	39.69	5.86	45.55	42.84	5.75	48.60
1.75	105.00	5.40	3.16	8.56	15.46	3.98	19.44	21.93	5.37	27.31	36.60	4.49	41.09	39.36	5.30	44.66	42.50	5.04	47.54
1.83	110.00	5.43	3.12	8.54	14.56	3.64	18.19	20.37	5.11	25.48	36.23	4.15	40.38	39.03	4.89	43.92	42.16	4.54	46.70
1.92	115.00	5.45	2.67	8.12	13.72	3.38	17.10	18.88	4.73	23.62	35.85	3.94	39.79	38.68	4.64	43.32	41.81	4.25	46.06
2.00	120.00	5.45	2.34	7.79	12.68	3.10	15.78	17.12	4.16	21.28	35.44	3.82	39.25	38.30	4.49	42.79	41.43	4.16	45.59
2.08	125.00	5.44	1.68	7.12	11.36	2.22	13.58	15.03	2.94	17.96	34.97	2.72	37.69	37.87	3.20	41.06	41.00	2.97	43.98
2.17	130.00	5.42	1.17	6.59	10.01	1.54	11.56	12.96	2.04	15.00	34.45	1.90	36.35	37.38	2.23	39.61	40.54	2.09	42.63
2.25	135.00	5.40	0.80	6.20	8.79	1.05	9.84	11.11	1.41	12.52	26.72	1.31	28.03	36.87	1.54	38.41	40.05	1.46	41.50
2.33	140.00	5.36	0.54	5.91	7.75	0.69	8.44	9.54	0.95	10.49	20.46	0.89	21.35	36.33	1.04	37.37	39.54	0.98	40.52
2.42	145.00	5.33	0.35	5.68	6.92	0.45	7.36	8.26	0.62	8.88	16.06	0.59	16.64	35.77	0.69	36.46	39.01	0.65	39.66
2.50	150.00	5.29	0.22	5.51	6.30	0.29	6.59	7.25	0.40	7.65	12.88	0.39	13.27	35.20	0.46	35.65	38.47	0.43	38.89
2.58	155.00	5.25	0.12	5.37	5.95	0.17	6.12	6.50	0.23	6.73	10.55	0.23	10.79	34.61	0.27	34.88	37.91	0.25	38.17
2.67	160.00	5.21	0.05	5.26	5.90	0.08	5.98	6.03	0.10	6.13	8.86	0.11	8.97	28.41	0.13	28.55	37.35	0.12	37.48
2.75	165.00	5.17	0.02	5.19	5.86	0.03	5.89	5.91	0.03	5.94	7.66	0.04	7.66	21.16	0.04	21.21	36.79	0.04	36.83
2.83	170.00	5.13	0.00	5.13	5.82	0.00	5.82	5.87	0.00	5.87	6.74	0.00	6.74	16.31	0.00	16.31	36.21	0.00	36.21
2.92	175.00	5.09	0.00	5.09	5.78	0.00	5.78	5.83	0.00	5.83	6.16	0.00	6.16	12.95	0.00	12.95	35.63	0.00	35.63
3.00	180.00	5.05	0.00	5.05	5.74	0.00	5.74	5.80	0.00	5.80	5.93	0.00	5.93	10.58	0.00	10.58	35.05	0.00	35.05
3.08	185.00	5.01	0.00	5.01	5.71	0.00	5.71	5.76	0.00	5.76	5.89	0.00	5.89	8.87	0.00	8.87	34.46	0.00	34.46
3.17	190.00	4.97	0.00	4.97	5.67	0.00	5.67	5.72	0.00	5.72	5.85	0.00	5.85	7.63	0.00	7.63	26.05	0.00	26.05
3.25	195.00	4.93	0.00	4.93	5.63	0.00	5.63	5.68	0.00	5.68	5.81	0.00	5.81	6.75	0.00	6.75	19.60	0.00	19.60
3.33	200.00	4.89	0.00	4.89	5.59	0.00	5.59	5.64	0.00	5.64	5.77	0.00	5.77	6.16	0.00	6.16	15.24	0.00	15.24
3.42	205.00	4.85	0.00	4.85	5.55	0.00	5.55	5.60	0.00	5.60	5.73	0.00	5.73	5.93	0.00	5.93	12.20	0.00	12.20
3.50	210.00	4.81	0.00	4.81	5.51	0.00	5.51	5.56	0.00	5.56	5.69	0.00	5.69	5.89	0.00	5.89	10.04	0.00	10.04
3.58	215.00	4.76	0.00	4.76	5.47	0.00	5.47	5.52	0.00	5.52	5.65	0.00	5.65	5.85	0.00	5.85	8.48	0.00	8.48
3.67	220.00	4.72	0.00	4.72	5.43	0.00	5.43	5.48	0.00	5.48	5.61	0.00	5.61	5.81	0.00	5.81	7.35	0.00	7.35
3.75	225.00	4.68	0.00	4.68	5.39	0.00	5.39	5.44	0.00	5.44	5.58	0.00	5.58	5.77	0.00	5.77	6.56	0.00	6.56
3.83	230.00	4.64	0.00	4.64	5.35	0.00	5.35	5.40	0.00	5.40	5.54	0.00	5.54	5.73	0.00	5.73	6.05	0.00	6.05
3.92	235.00	4.60	0.00	4.60	5.31	0.00	5.31	5.36	0.00	5.36	5.50	0.00	5.50	5.69	0.00	5.69	5.92	0.00	5.92
4.00	240.00	4.56	0.00	4.56	5.27	0.00	5.27	5.32	0.00	5.32	5.46	0.00	5.46	5.65	0.00	5.65	5.88	0.00	5.88
4.08	245.00	4.52	0.00	4.52	5.23	0.00	5.23	5.28	0.00	5.28	5.42	0.00	5.42	5.61	0.00	5.61	5.84	0.00	5.84
4.17	250.00	4.47	0.00	4.47	5.19	0.00	5.19	5.24	0.00	5.24	5.38	0.00	5.38	5.58	0.00	5.58	5.80	0.00	5.80
4.25	255.00	4.43	0.00	4.43	5.15	0.00	5.15	5.20	0.00	5.20	5.34	0.00	5.34	5.54	0.00	5.54	5.76	0.00	5.76
4.33	260.00	4.39	0.00	4.39	5.11	0.00	5.11	5.16	0.00	5.16	5.30	0.00	5.30	5.50	0.00	5.50	5.72	0.00	5.72
4.42	265.00	4.35	0.00	4.35	5.07	0.00	5.07	5.12	0.00	5.12	5.26	0.00	5.26	5.46	0.00	5.46	5.68	0.00	5.68
4.50	270.00	4.31	0.00	4.31	5.03	0.00	5.03	5.08	0.00	5.08	5.22	0.00	5.22	5.42	0.00	5.42	5.64	0.00	5.64
4.58	275.00	4.27	0.00	4.27	4.99	0.00	4.99	5.04	0.00	5.04	5.18	0.00	5.18	5.38	0.00	5.38	5.60	0.00	5.60
4.67	280.00	4.22	0.00	4.22	4.95	0.00	4.95	5.00	0.00	5.00	5.14	0.00	5.14	5.34	0.00	5.34	5.56	0.00	5.56
4.75	285.00	4.18	0.00	4.18	4.91	0.00	4.91	4.96	0.00	4.96	5.10	0.00	5.10	5.30	0.00	5.30	5.53	0.00	5.53
4.83	290.00	4.14	0.00	4.14	4.87	0.00	4.87	4.92	0.00	4.92	5.06	0.00	5.06	5.26	0.00	5.26	5.49	0.00	5.49
4.92	295.00	4.10	0.00	4.10	4.83	0.00	4.83	4.88	0.00	4.88	5.02	0.00	5.02	5.22	0.00	5.22	5.45	0.00	5.45
5.00	300.00	4.05	0.00	4.05	4.78	0.00	4.78	4.84	0.00	4.84	4.98	0.00	4.98	5.18	0.00	5.18	5.41	0.00	5.41
5.08	305																		

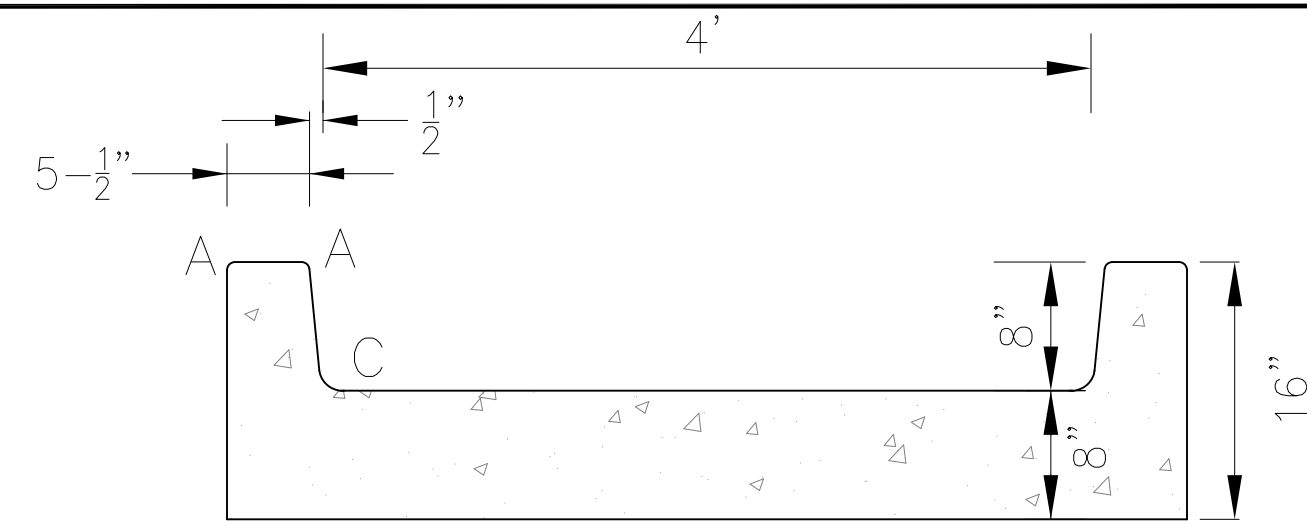

LENGTH FOR RADII
A = $1/2''$
C = $1-1/2''$




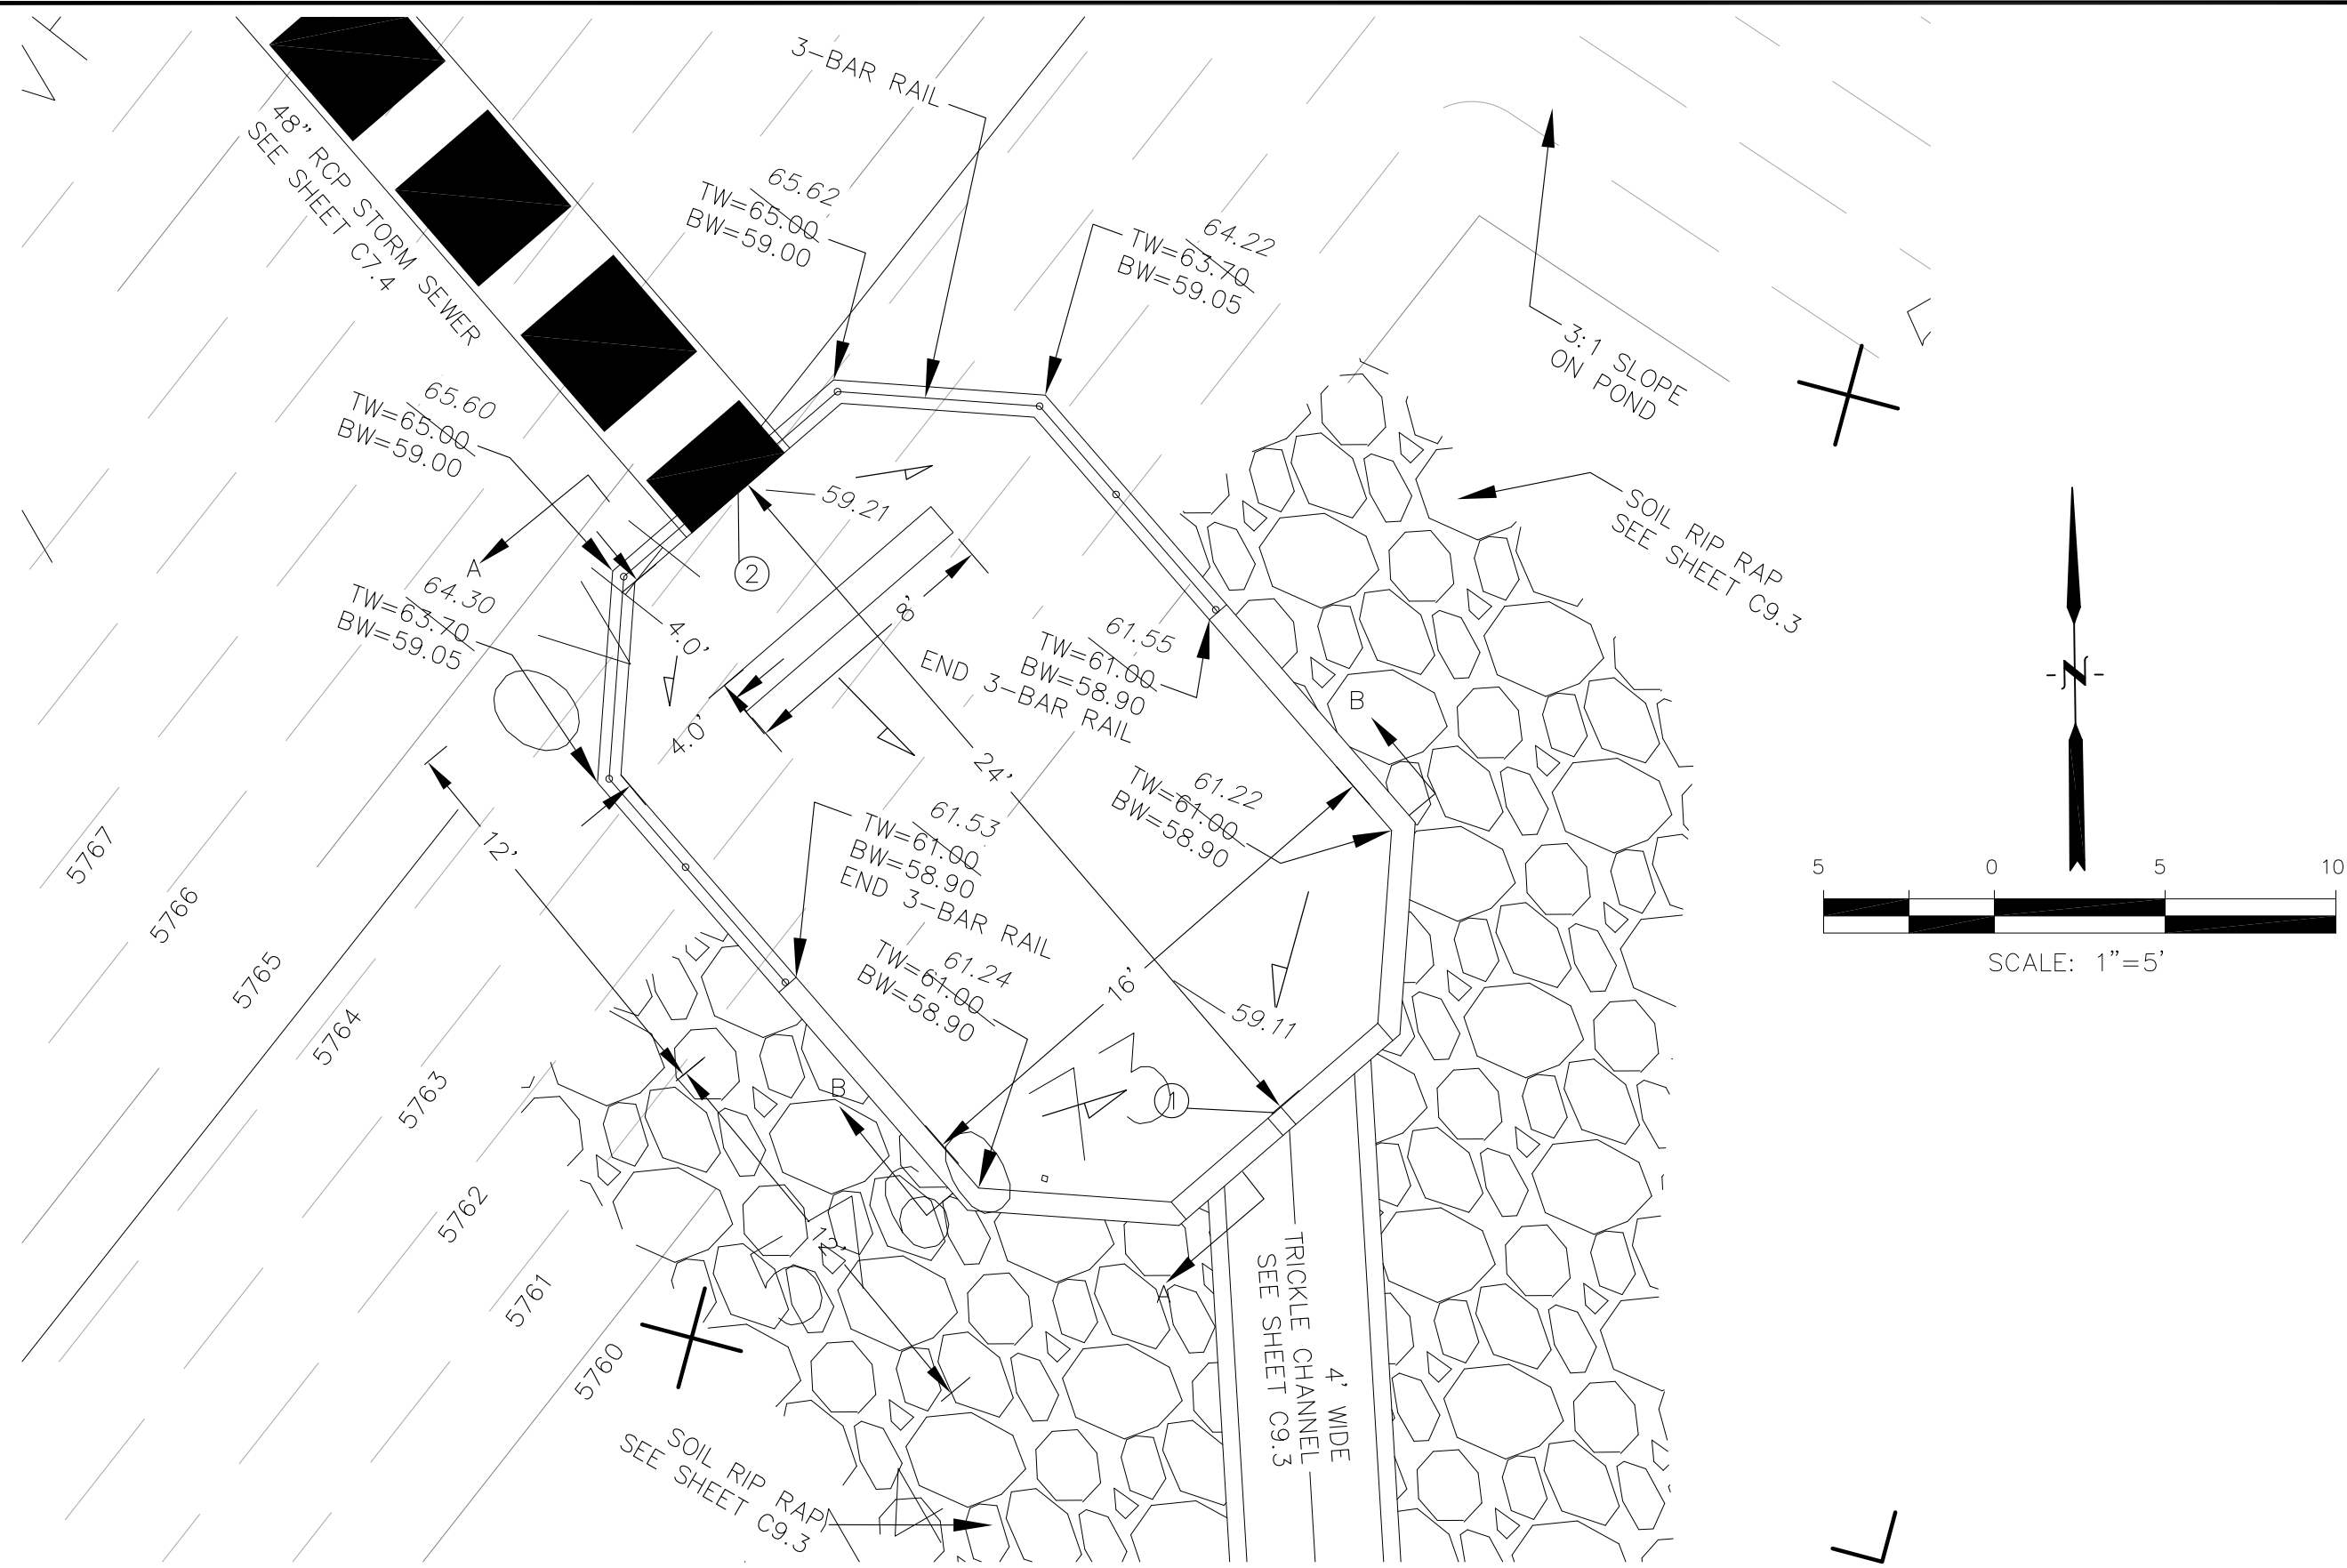
30 20 10 0 30 60

SCALE: 1"=30'




DATE: 09/30/2022


		<p align="center">POND C3</p> <p align="center">FOREBAY, LOW FLOW CHANNEL</p> <p align="center">AND OUTLET STRUCTURE LAYOUT</p>		<p>CORE</p> <p>ENGINEERING GROUP</p> <p>15004 1ST AVENUE S. BURNSVILLE, MN 55306 TEL: 612-892-0000 CONTACT: RICHARD L. SCHINDLER, P.E. EMAIL: Rich@ceg1.com</p>	
DATE:		NOV 12, 2020		DATE	
PROJECT NO.		100.061		PROJECT FOR:	
SHEET NUMBER		C9.8		<p>THE HILLS COLLECTOR</p> <p>STREET CONSTRUCTION</p> <p>212 N. WAHSATCH AVE., SUITE 301 COLORADO SPRINGS, COLORADO 80903 (719) 635-3200 CONTACT: JEFF MARK</p>	
TOTAL SHEETS:		58		<p>NO.</p> <p>DESCRIPTION</p>	
DRAWN:		RLS		<p>PREPARED FOR:</p> <p>LORSON, LLC</p> <p>212 N. WAHSATCH AVE., SUITE 301 COLORADO SPRINGS, COLORADO 80903 (719) 635-3200 CONTACT: JEFF MARK</p>	
DESIGNED:		RLS		<p>PROJECT:</p> <p>THE HILLS COLLECTOR</p> <p>STREET CONSTRUCTION</p> <p>FONTAINE BLVD. - GRAYLING DR LORSON BLVD-WALLEYE DR-LAMPREY DR COLORADO SPRINGS, COLORADO</p>	
CHECKED:		RLS			



POND C3 - FOREBAY 'A' LAYOUT
SCALE: 1"=5'

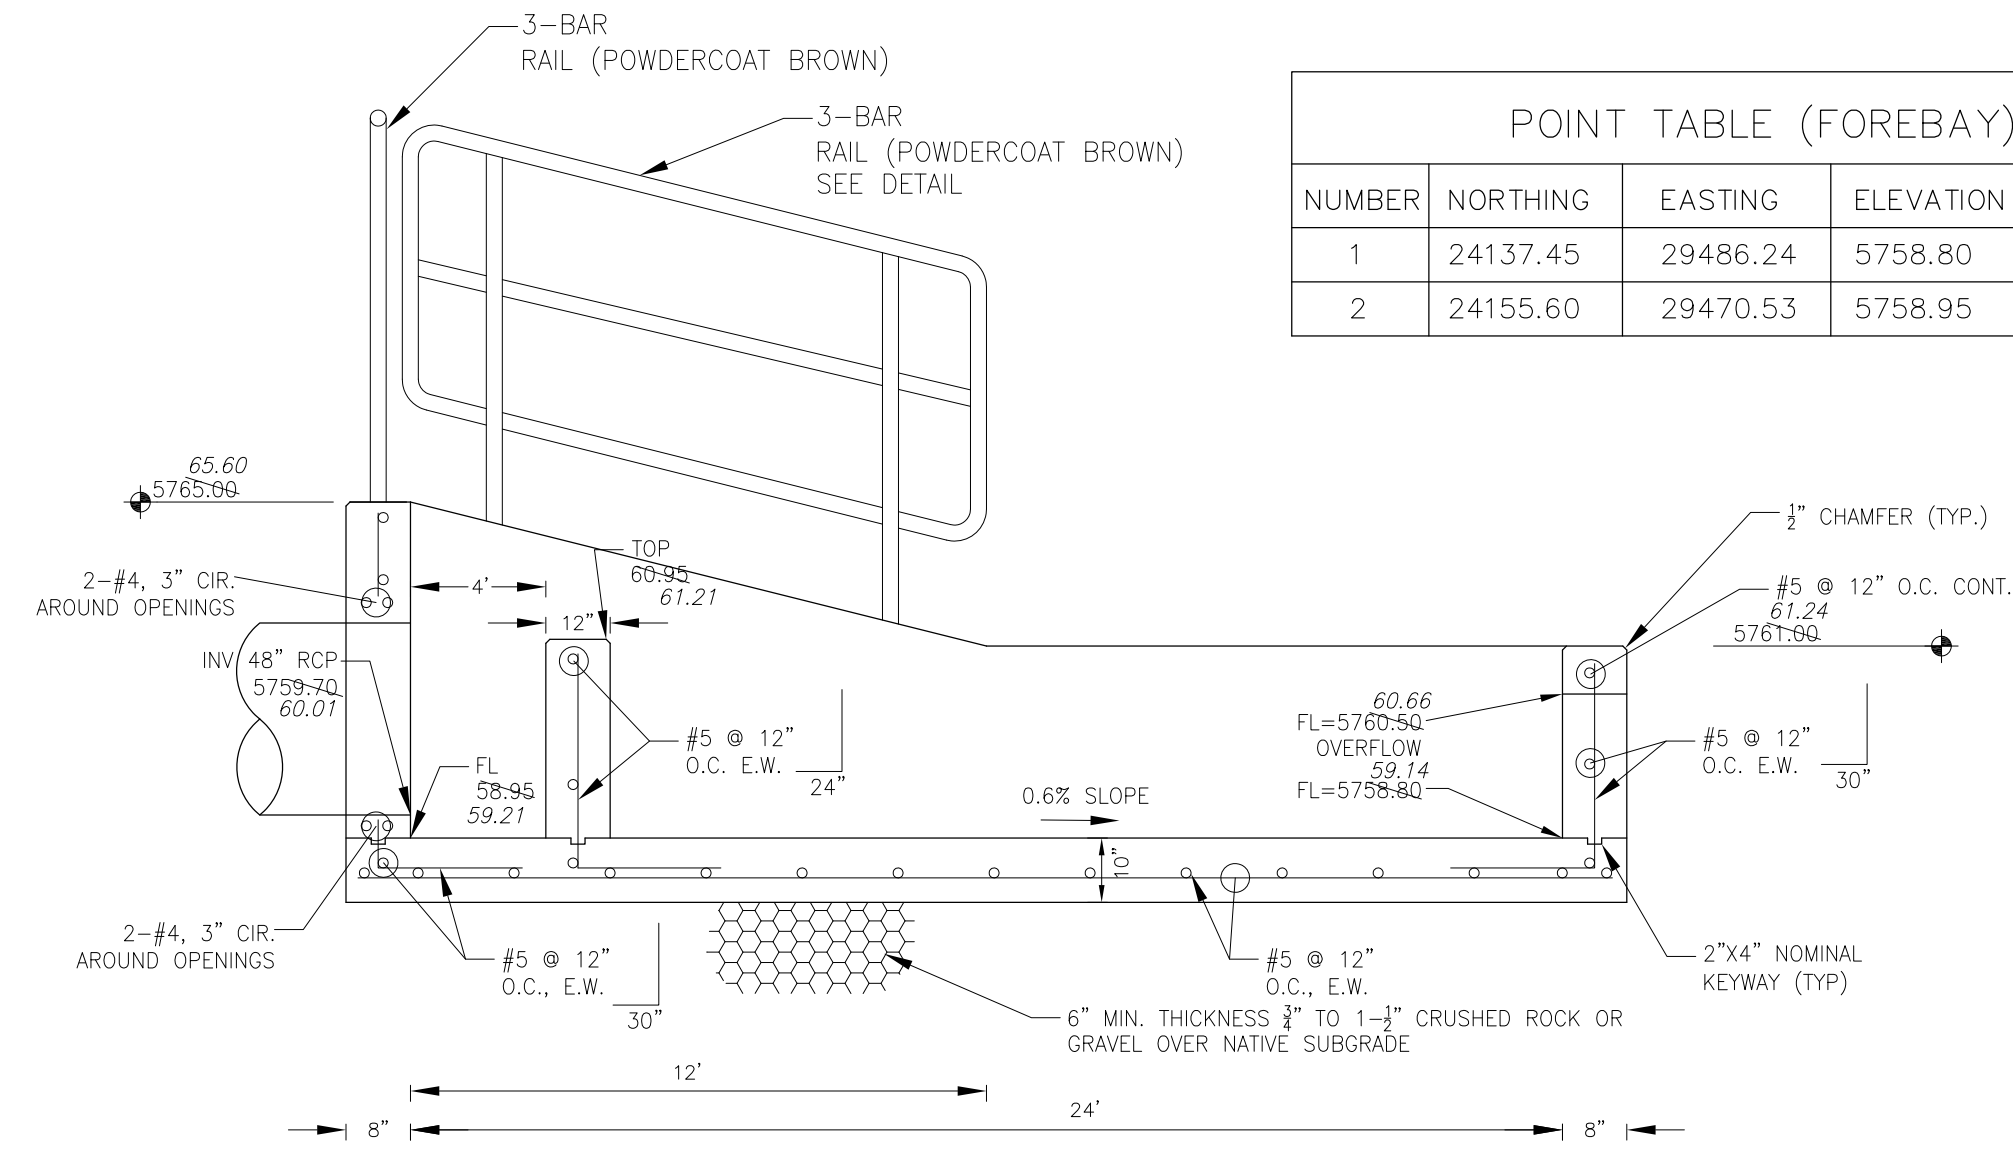


FOREBAY 'A' SECTION A-A
NO SCALE

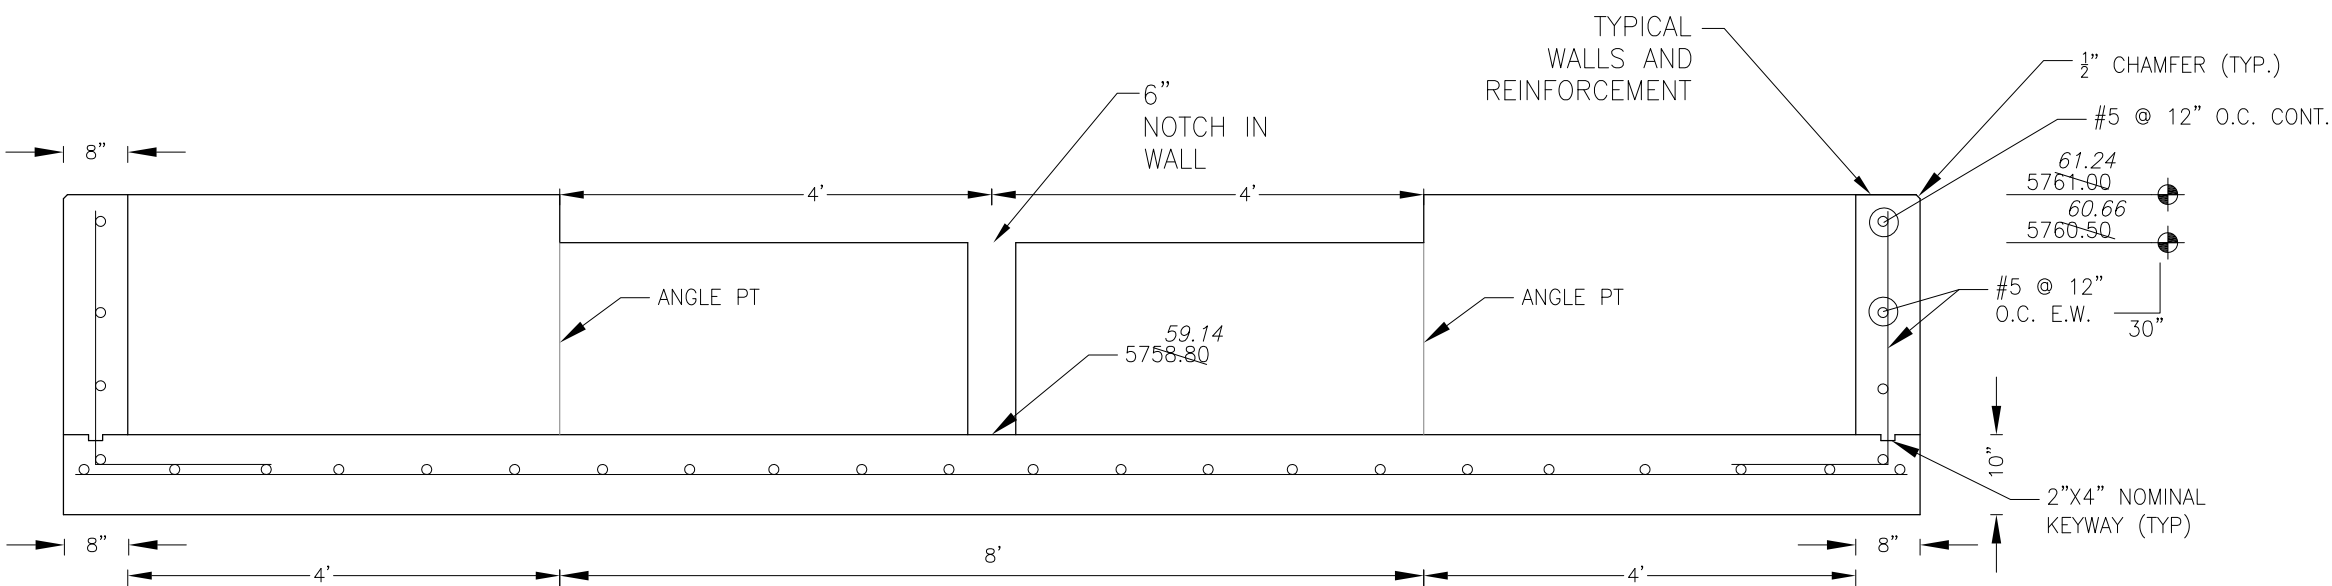


FOREBAY 'A' SECTION B-B
NO SCALE

POINT TABLE (FOREBAY)				
NUMBER	NORTHING	EASTING	ELEVATION	NOTES
1	24137.45	29486.24	5758.80	FOREBAY BOTTOM
2	24155.60	29470.53	5758.95	FOREBAY BOTTOM, INV 48"=5759.70


NOTE: ALL CONCRETE FOR FOREBAY SHALL BE CDOT TYPE D

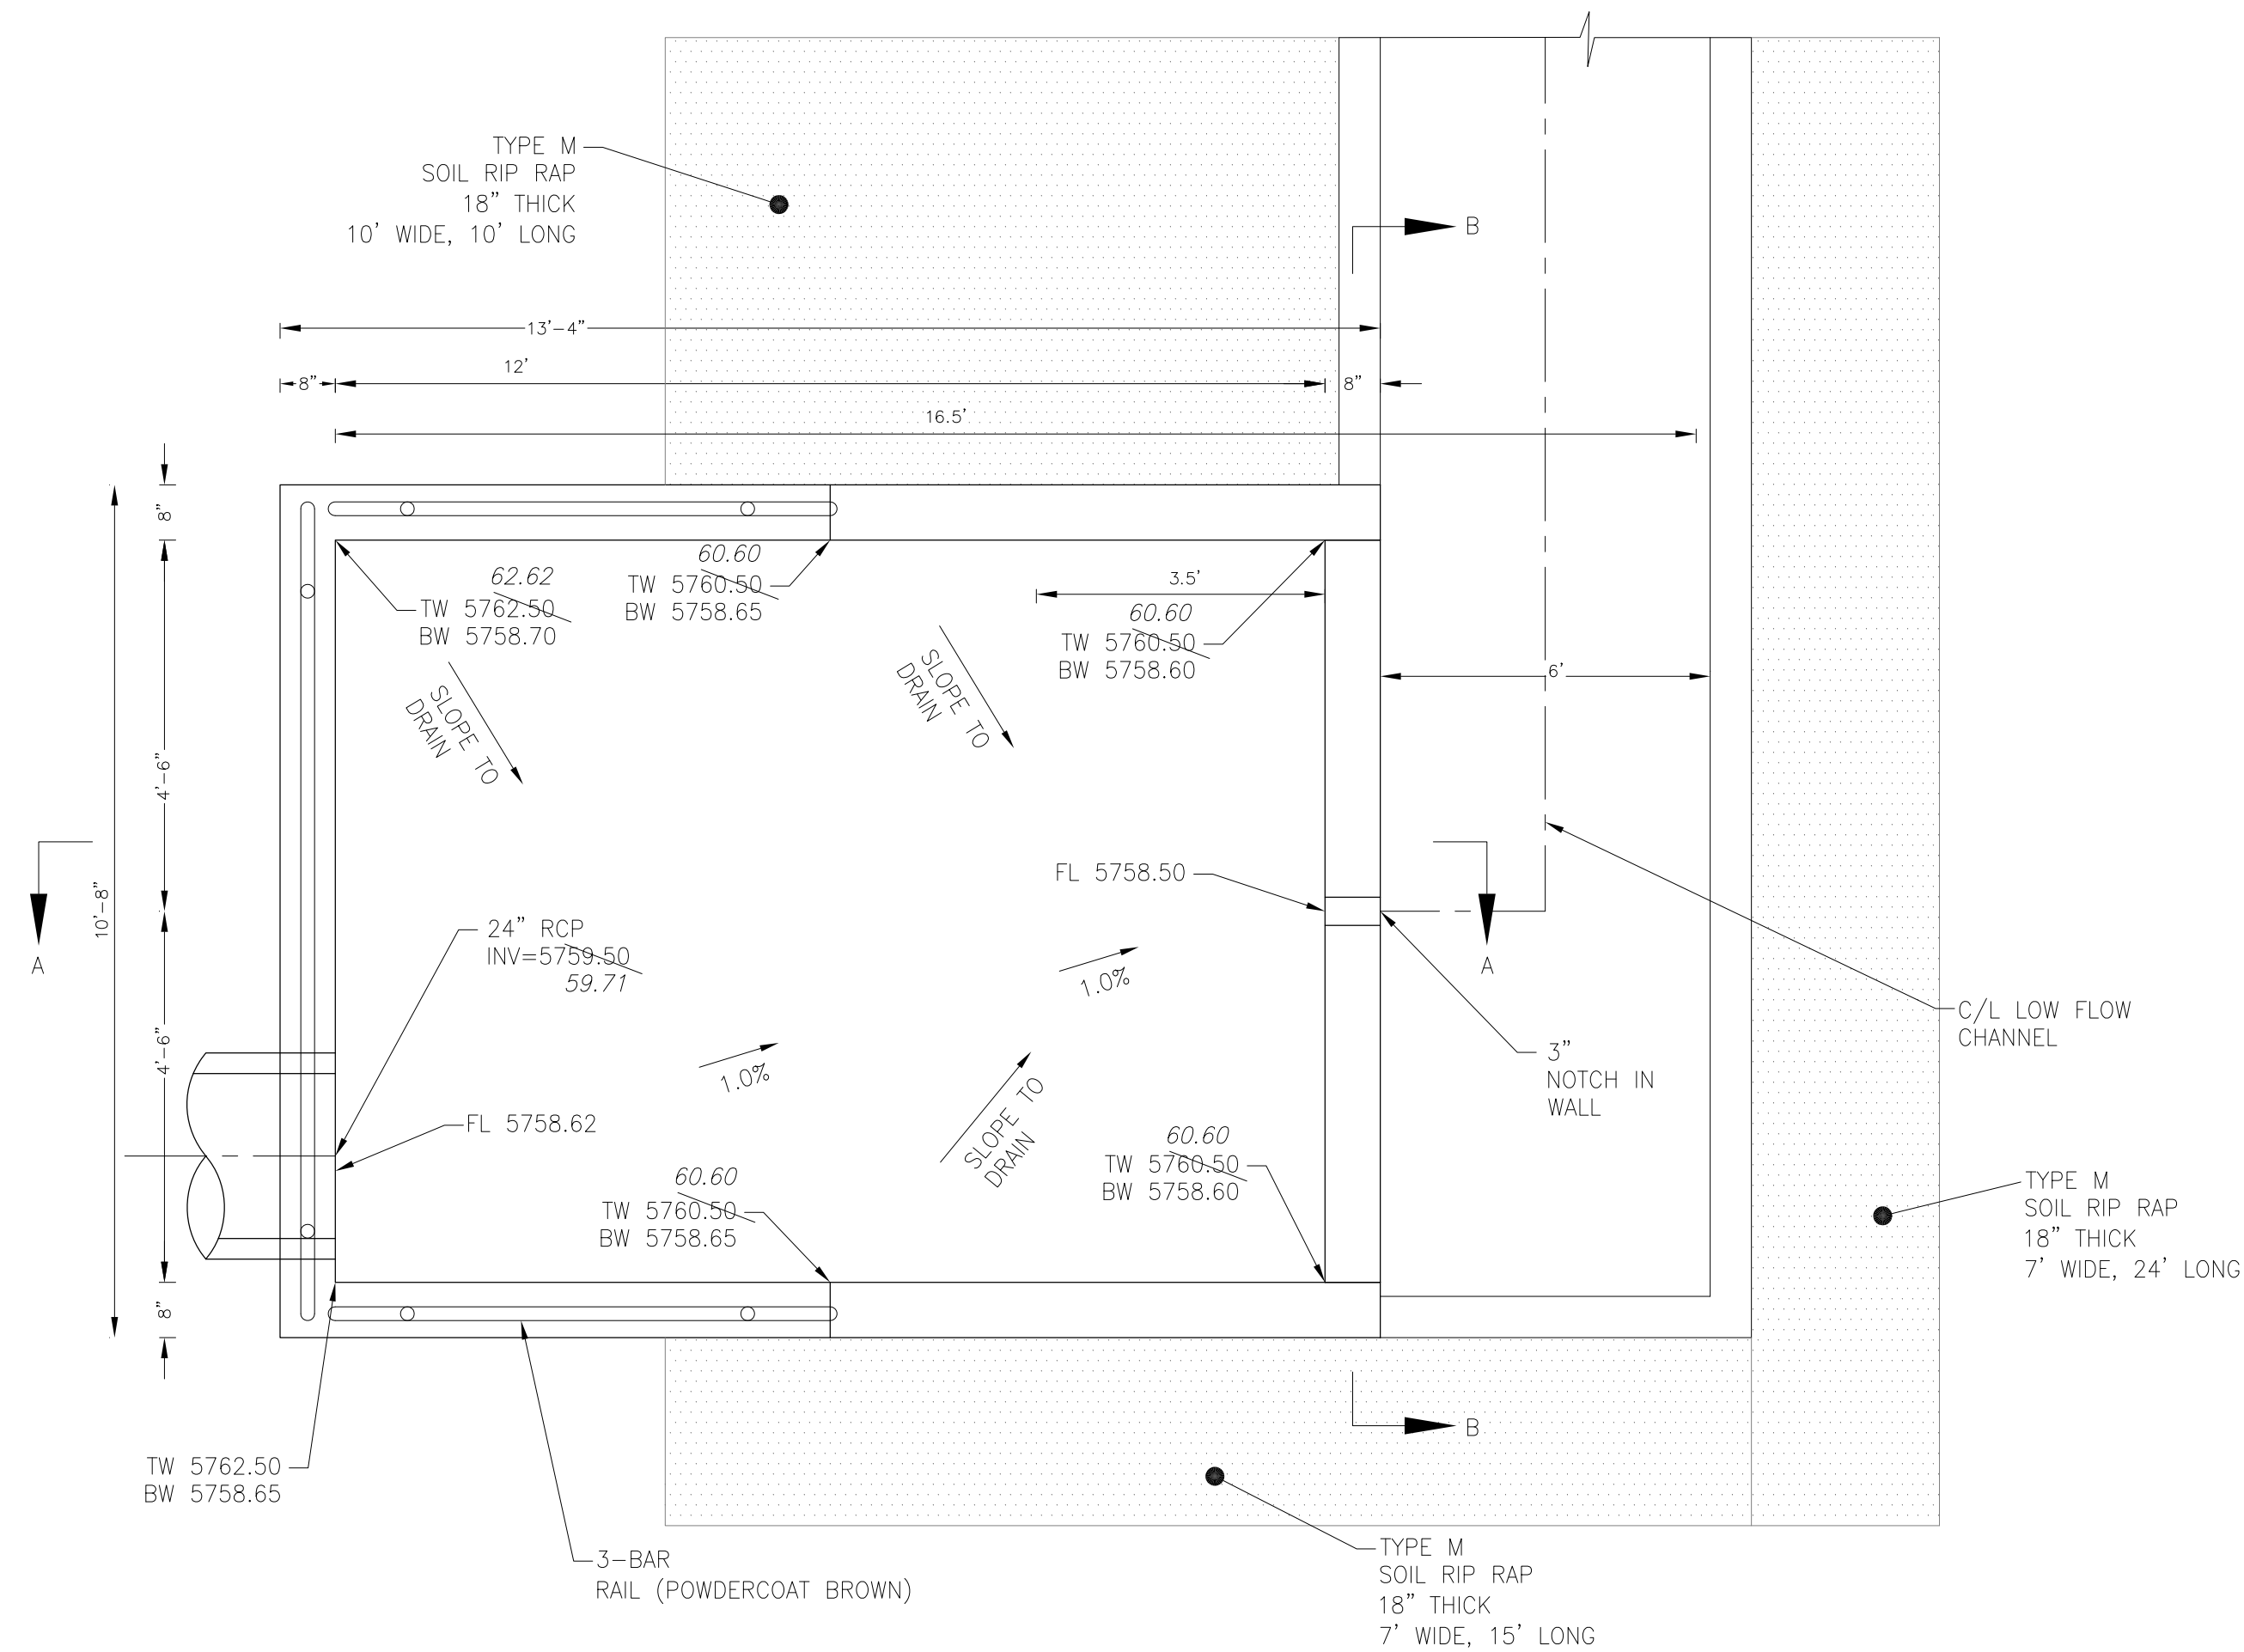

POND C3 - FOREBAY 'B' LAYOUT
SCALE: 1"=5'

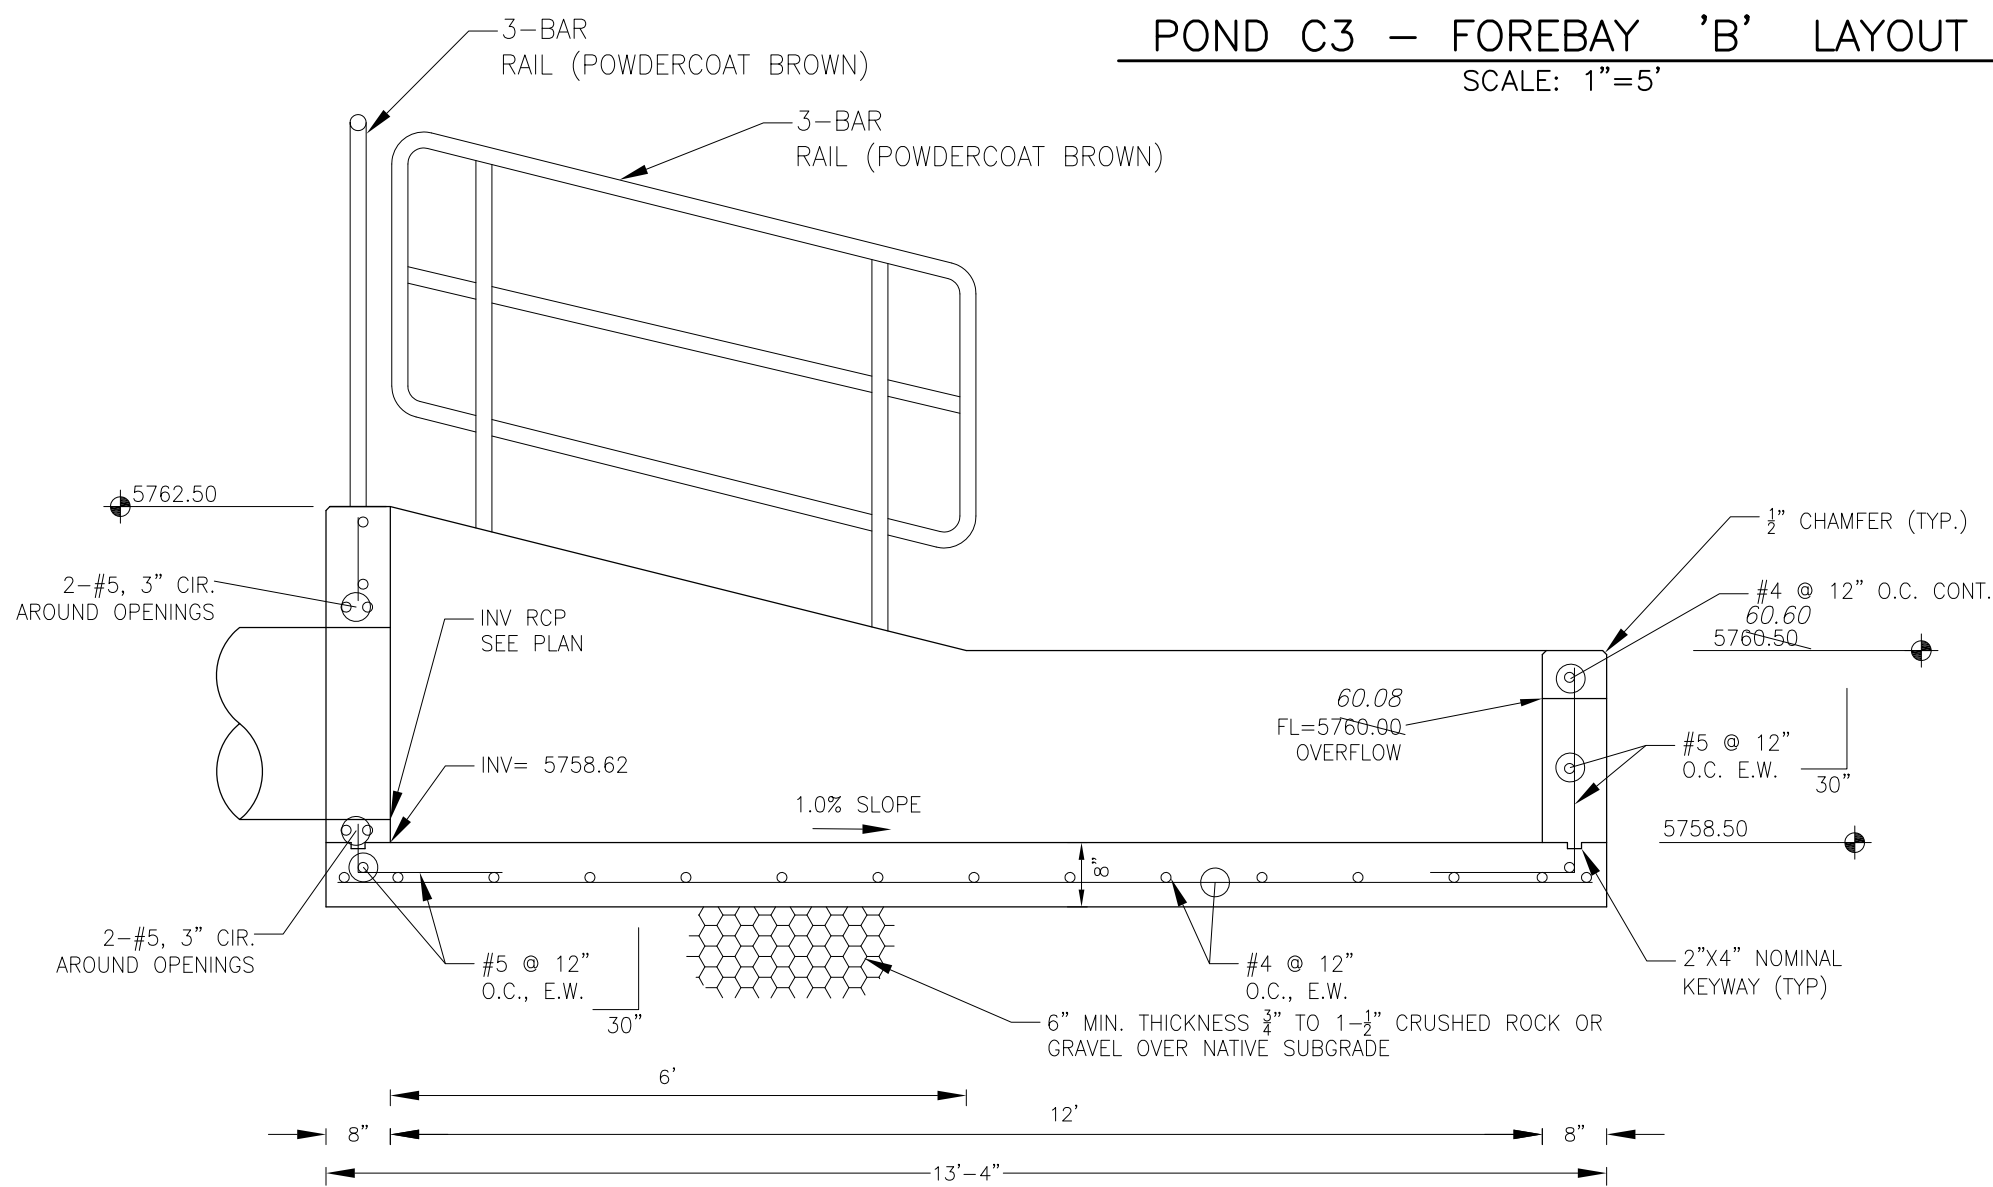

FOREBAY 'B' SECTION A-A
NO SCALE

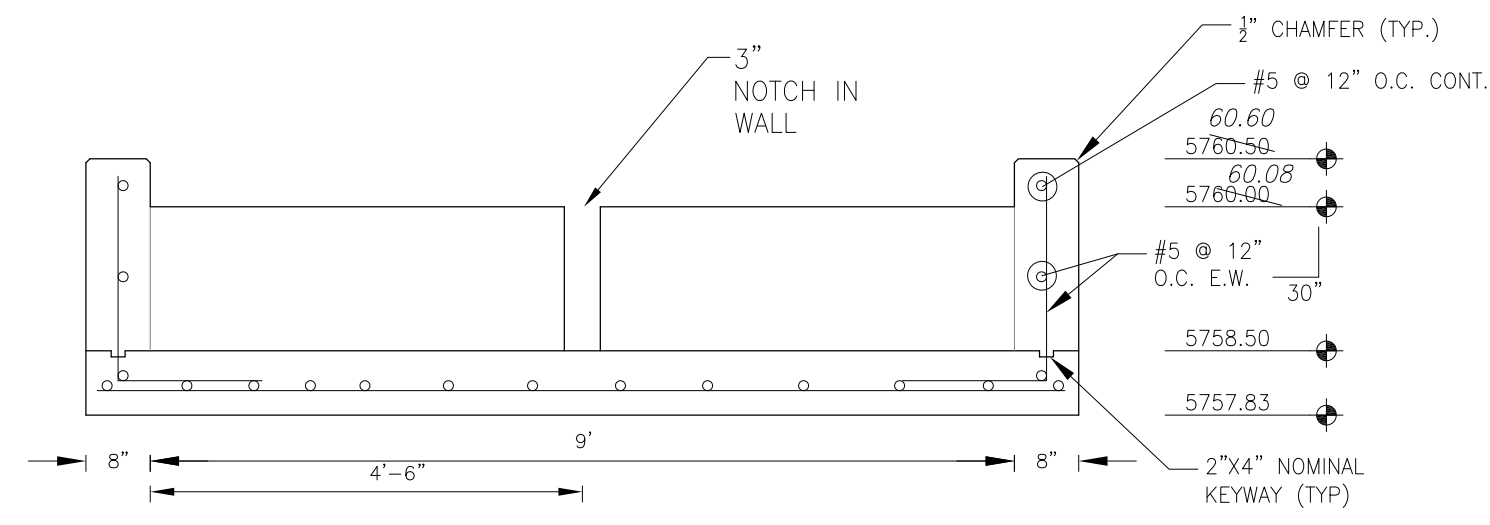

FOREBAY 'B' SECTION B-B
NO SCALE

AS-BUILT

DATE: 09/30/2022

CORE
ENGINEERING GROUP
15004 1ST AVENUE S.
BURNING WOOD, CO 80903
CONTACT: RICHARD L. SCHINDLER, P.E.
EMAIL: Rich@ceg1.com

DATE
DESCRIPTION
NO.
PROJECT: THE HILLS COLLECTOR STREET CONSTRUCTION
212 N. WAHSATCH AVE, SUITE 301
COLORADO SPRINGS, COLORADO 80903
CONTACT: JEFF MARK

DRAWN: RLS
DESIGNED: RLS
CHECKED: RLS

POND C3
FOREBAY DETAILS



DATE:
NOV 12, 2020

PROJECT NO.
100.061

SHEET NUMBER
C9.9


TOTAL SHEETS: 58

DETENTION BASIN OUTLET STRUCTURE DESIGN

MHFD-DETENTION, Version 4.02 (February 2020)

Project: The Hills at Lorson Ranch

Basin ID: Pond C4-asbuilt

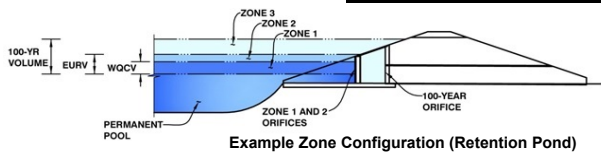

Example Zone Configuration (Retention Pond)

	Estimated Stage (ft)	Estimated Volume (ac-ft)	Outlet Type
Zone 1 (WQCV)	3.06	1.488	Orifice Plate
Zone 2 (EURV)	5.56	2.980	Rectangular Orifice
Zone 3 (100+1/2WQCV)	8.58	4.225	Weir&Pipe (Restrict)
Total (all zones)		8.692	

User Input: Orifice at Underdrain Outlet (typically used to drain WQCV in a Filtration BMP)

Underdrain Orifice Invert Depth = ft (distance below the filtration media surface)

Underdrain Orifice Diameter = inches

Calculated Parameters for Underdrain
Underdrain Orifice Area = ft²
Underdrain Orifice Centroid = feet

User Input: Orifice Plate with one or more orifices or Elliptical Slot Weir (typically used to drain WQCV and/or EURV in a sedimentation BMP)

Invert of Lowest Orifice = ft (relative to basin bottom at Stage = 0 ft)
Depth at top of Zone using Orifice Plate = ft (relative to basin bottom at Stage = 0 ft)
Orifice Plate: Orifice Vertical Spacing = inches
Orifice Plate: Orifice Area per Row = sq. inches (use rectangular openings)

Calculated Parameters for Plate
WQ Orifice Area per Row = ft²
Elliptical Half-Width = feet
Elliptical Slot Centroid = feet
Elliptical Slot Area = ft²

User Input: Stage and Total Area of Each Orifice Row (numbered from lowest to highest)

	Row 1 (required)	Row 2 (optional)	Row 3 (optional)	Row 4 (optional)	Row 5 (optional)	Row 6 (optional)	Row 7 (optional)	Row 8 (optional)
Stage of Orifice Centroid (ft)	0.00	1.00	2.00					
Orifice Area (sq. inches)	4.68	4.68	4.68					

	Row 9 (optional)	Row 10 (optional)	Row 11 (optional)	Row 12 (optional)	Row 13 (optional)	Row 14 (optional)	Row 15 (optional)	Row 16 (optional)
Stage of Orifice Centroid (ft)								
Orifice Area (sq. inches)								

User Input: Vertical Orifice (Circular or Rectangular)

Zone 2 Rectangular ☐ Not Selected ☐
Invert of Vertical Orifice = ft (relative to basin bottom at Stage = 0 ft)
Depth at top of Zone using Vertical Orifice = ft (relative to basin bottom at Stage = 0 ft)
Vertical Orifice Height = inches
Vertical Orifice Width = inches

Calculated Parameters for Vertical Orifice
Zone 2 Rectangular Not Selected
Vertical Orifice Area = ft²
Vertical Orifice Centroid = feet

User Input: Overflow Weir (Dropbox with Flat or Sloped Grate and Outlet Pipe OR Rectangular/Trapezoidal Weir (and No Outlet Pipe))

Zone 3 Weir ☐ Not Selected ☐
Overflow Weir Front Edge Height, H_o = ft (relative to basin bottom at Stage = 0 ft)
Overflow Weir Front Edge Length = feet
Overflow Weir Grate Slope = H:V
Horiz. Length of Weir Sides = feet
Overflow Grate Open Area % = %
Debris Clogging % = %

Calculated Parameters for Overflow Weir
Zone 3 Weir Not Selected
Height of Grate Upper Edge, H_u = feet
Overflow Weir Slope Length = feet
Grate Open Area / 100-yr Orifice Area = %
Overflow Grate Open Area w/o Debris = %
Overflow Grate Open Area w/ Debris = %

User Input: Outlet Pipe w/ Flow Restriction Plate (Circular Orifice, Restrictor Plate, or Rectangular Orifice)

Zone 3 Restrictor ☐ Not Selected ☐
Depth to Invert of Outlet Pipe = ft (distance below basin bottom at Stage = 0 ft)
Outlet Pipe Diameter = inches
Restrictor Plate Height Above Pipe Invert = inches

Calculated Parameters for Outlet Pipe w/ Flow Restriction Plate
Zone 3 Restrictor Not Selected
Outlet Orifice Area = ft²
Outlet Orifice Centroid = feet
Half-Central Angle of Restrictor Plate on Pipe = degrees

User Input: Emergency Spillway (Rectangular or Trapezoidal)

Spillway Invert Stage = ft (relative to basin bottom at Stage = 0 ft)
Spillway Crest Length = feet
Spillway End Slopes = H:V
Freeboard above Max Water Surface = feet

Calculated Parameters for Spillway
Spillway Design Flow Depth = feet
Stage at Top of Freeboard = feet
Basin Area at Top of Freeboard = acres
Basin Volume at Top of Freeboard = acre-ft

micropool = 0 = 5765


Routed Hydrograph Results

The user can override the default CUHP hydrographs and runoff volumes by entering new values in the Inflow Hydrographs table (Columns W through AF)

	WQCV	EURV	2 Year	5 Year	10 Year	25 Year	50 Year	100 Year
Design Storm Return Period	N/A	N/A	1.19	1.50	1.75	2.00	2.25	2.52
One-Hour Rainfall Depth (in)	N/A	N/A	1.488	1.468	1.407	1.309	1.1748	1.0330
CUHP Runoff Volume (acre-ft)	N/A	N/A	4.607	4.607	4.675	4.675	4.675	4.675
Inflow Hydrograph Volume (acre-ft)	N/A	N/A	4.607	4.607	4.675	4.675	4.675	4.675
CUHP Predevelopment Peak Q (cfs)	N/A	N/A	17.5	39.6	56.8	90.6	111.9	138.5
OPTIONAL Override Predevelopment Peak Q (cfs)	N/A	N/A						
Predevelopment Unit Peak Flow, q (cfs/acre)	N/A	N/A	0.22	0.49	0.70	1.12	1.38	1.71
Peak Inflow Q (cfs)	N/A	N/A	93.5	131.6	158.6	200.0	232.9	277.2
Peak Outflow Q (cfs)	0.7	6.2	5.5	18.5	34.6	38.4	40.9	44.1
Ratio Peak Outflow to Predevelopment Q	N/A	N/A	N/A	0.5	0.6	0.4	0.4	0.3
Structure Controlling Flow	Vertical Orifice 1	Overflow Weir 1	Vertical Orifice 1	Overflow Weir 1	Outlet Plate 1	Outlet Plate 1	Outlet Plate 1	Outlet Plate 1
Max Velocity through Gate 1 (fps)	N/A	0.02	N/A	0.5	1.1	1.2	1.3	1.4
Max Velocity through Gate 2 (fps)	N/A	N/A	N/A	N/A	N/A	N/A	N/A	N/A
Time to Drain 97% of Inflow Volume (hours)	38	46	47	47	45	43	42	40
Time to Drain 99% of Inflow Volume (hours)	40	50	51	52	51	51	50	50
Maximum Ponding Depth (ft)	3.06	5.56	5.13	5.89	6.24	7.45	8.30	9.48
Area at Maximum Ponding Depth (acres)	1.10	1.28	1.25	1.31	1.33	1.42	1.49	1.59
Maximum Volume Stored (acre-ft)	1.497	4.476	3.919	4.903	5.364	7.017	8.272	10.092

MHFD-Detention, Version 4.02 (February 2020)







Basin ID: Pond C4-asbuilt

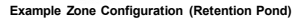

Depth Increment =	0.20	ft
-------------------	------	----


Zone 1 Volume (V_{QVCV}) =	1.488	acre-feet
Zone 2 Volume ($EURV - Zone 1$) =	2.980	acre-feet
Zone 3 ($100yr + 1/2 WQCV - Zones 1 \& 2$) =	4.225	acre-feet
Total Detention Basin Volume =	8.692	acre-feet
Initial Surcharge Volume (ISV) =	user	ft ³
Initial Surcharge Depth (ISD) =	user	ft
Total Available Detention Depth (H_{total}) =	user	ft
Depth of Trickle Channel (H_{TC}) =	user	ft
Slope of Trickle Channel (S_{TC}) =	user	ft/ft
Slopes of Main Basin Sides (S_{main}) =	user	H:V
Basin Length-to-Width Ratio ($R_{L/W}$) =	user	
Initial Surcharge Area (A_{ISV}) =	user	ft ²
Surcharge Volume Length (L_{ISV}) =	user	ft
Surcharge Volume Width (W_{ISV}) =	user	ft
Depth of Basin Floor (H_{FLOOR}) =	user	ft
Length of Basin Floor (L_{FLOOR}) =	user	ft
Width of Basin Floor (W_{FLOOR}) =	user	ft
Area of Basin Floor (A_{FLOOR}) =	user	ft ²
Volume of Basin Floor (V_{FLOOR}) =	user	ft ³
Depth of Main Basin (H_{MAIN}) =	user	ft
Length of Main Basin (L_{MAIN}) =	user	ft
Width of Main Basin (W_{MAIN}) =	user	ft
Area of Main Basin (A_{MAIN}) =	user	ft ²
Volume of Main Basin (V_{MAIN}) =	user	ft ³
Calculated Total Basin Volume (V_{total}) =	user	acre-feet

[illegible]

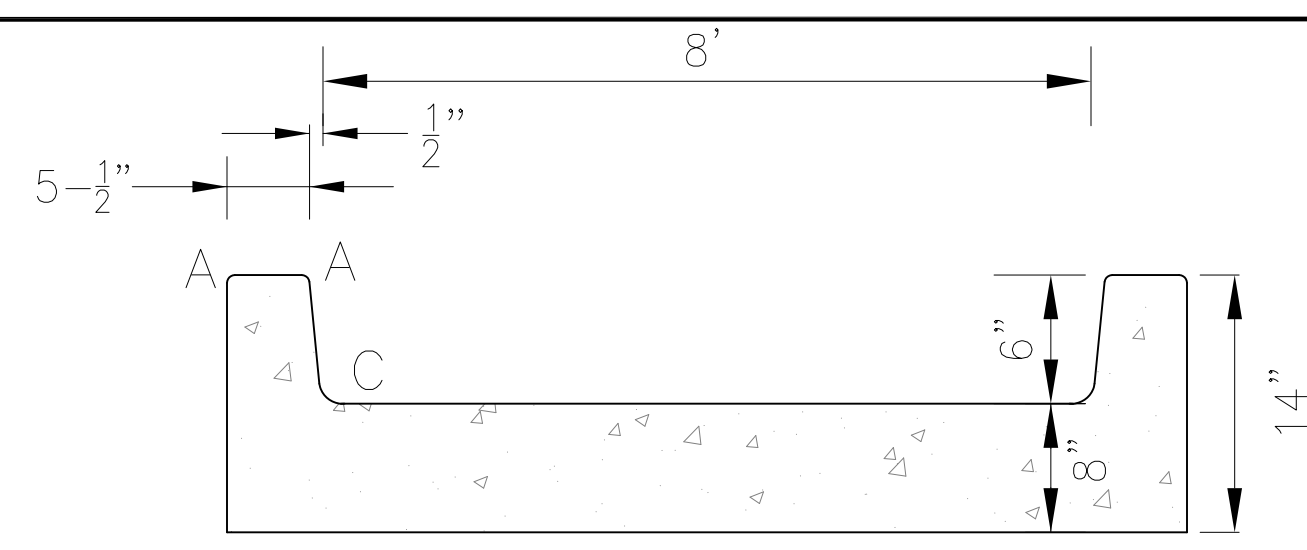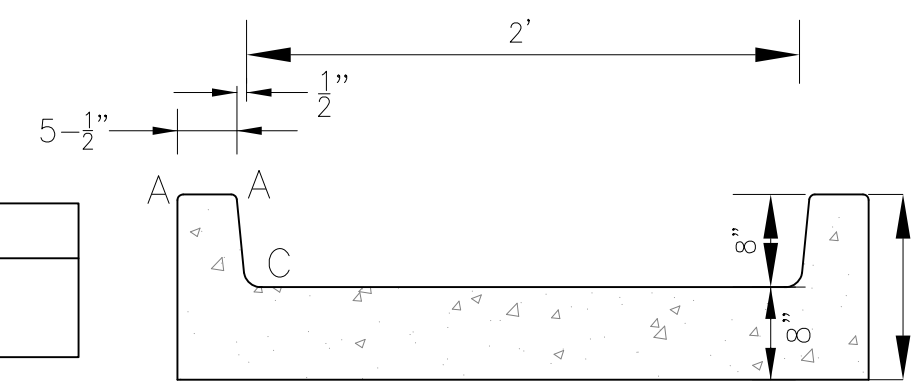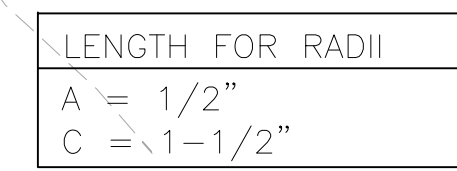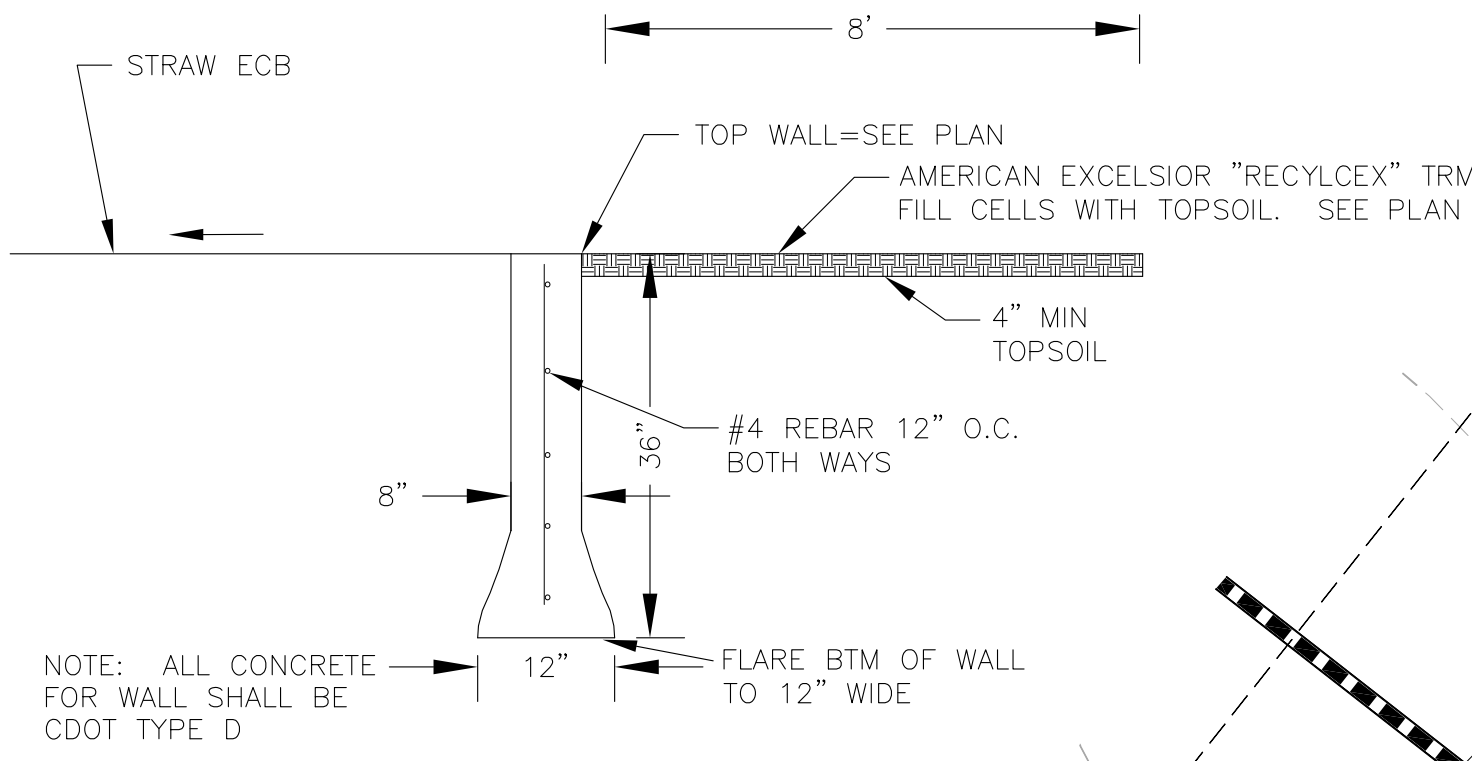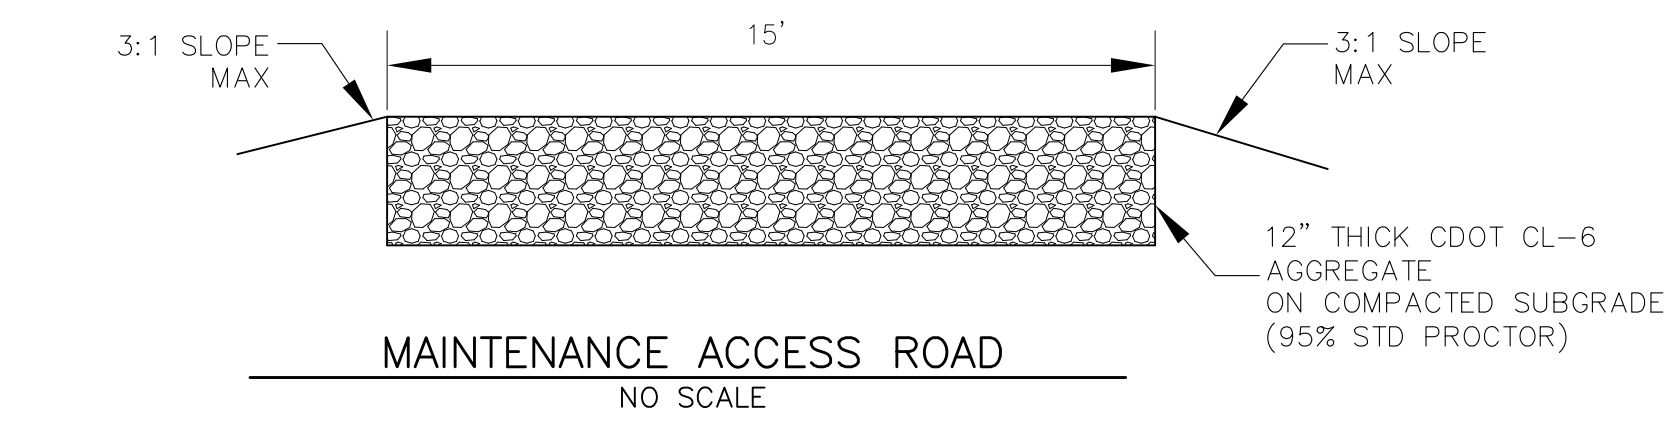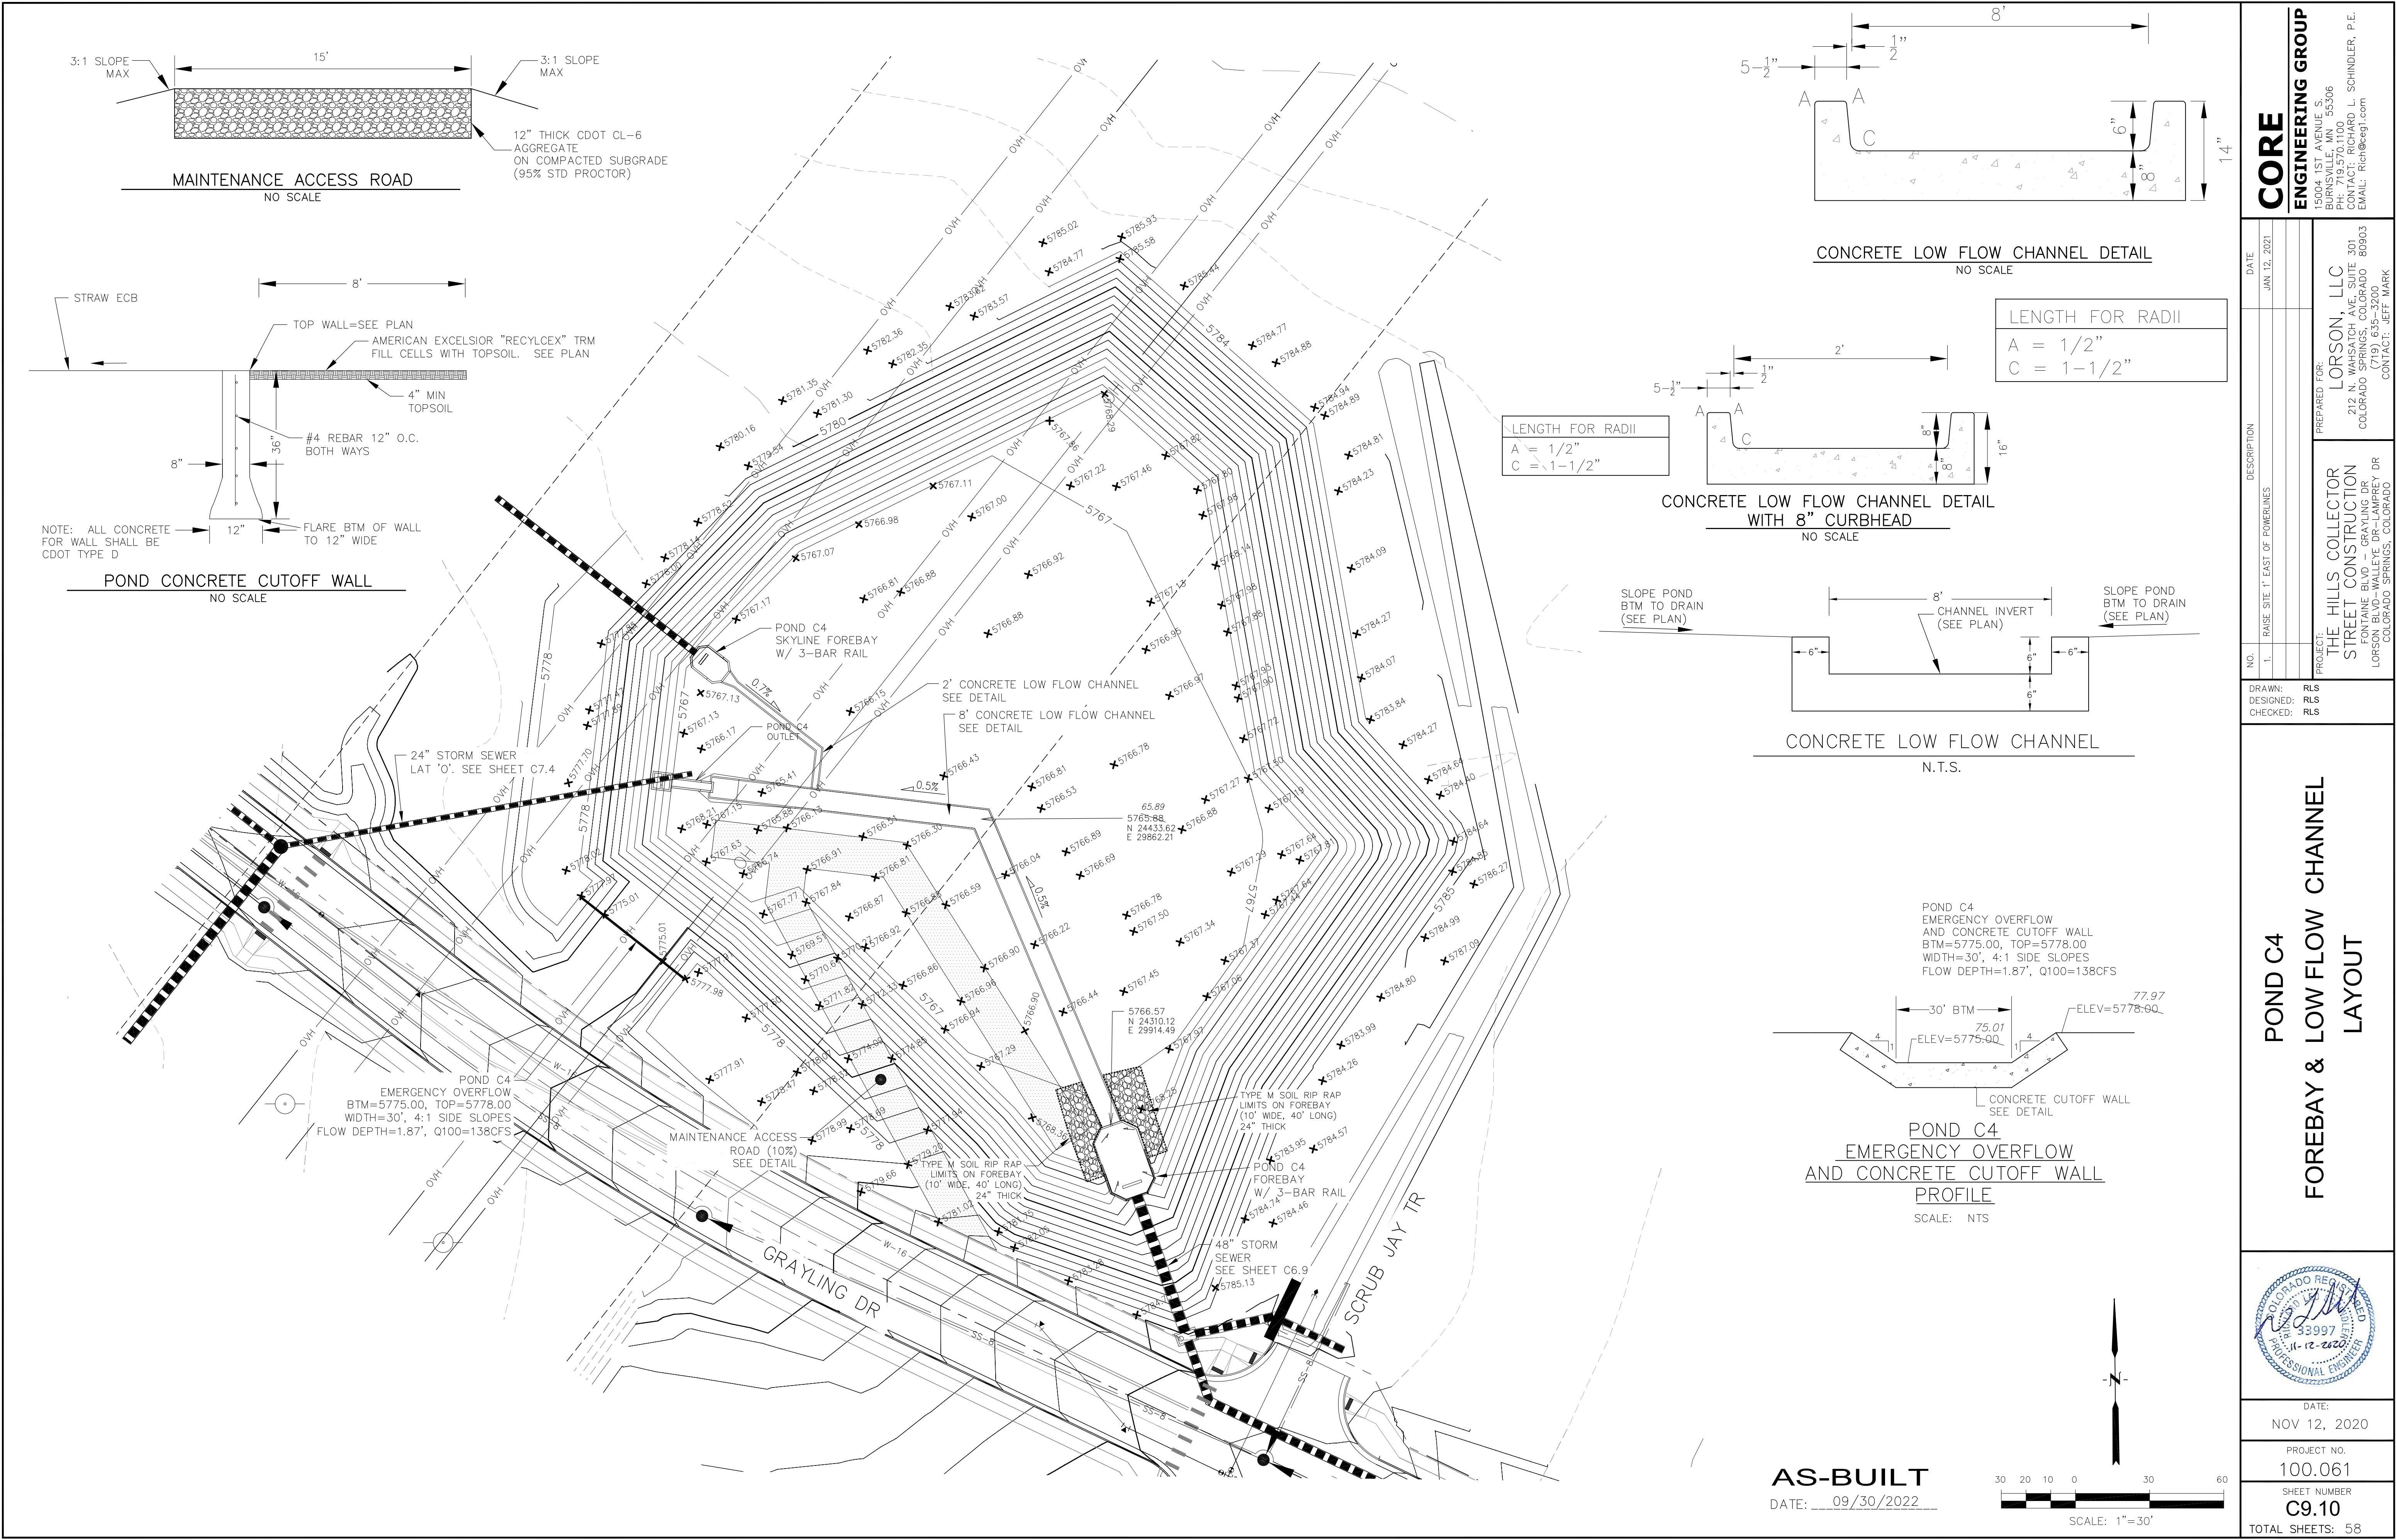


CONCRETE LOW FLOW CHANNEL DETAIL
NO SCALE

LENGTH FOR RADII	
A	= 1/2"
C	= 1-1/2"

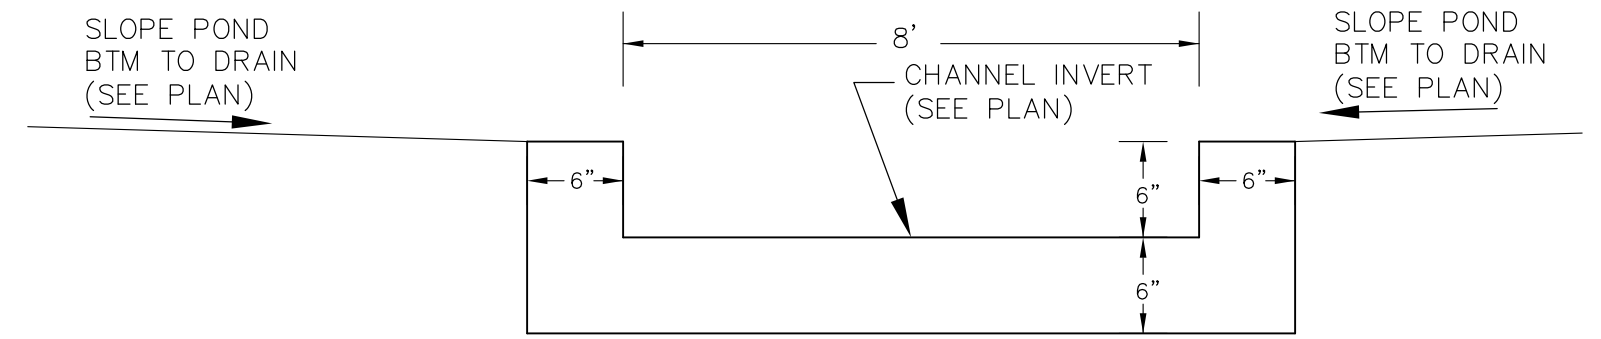


CONCRETE LOW FLOW CHANNEL
N.T.S.

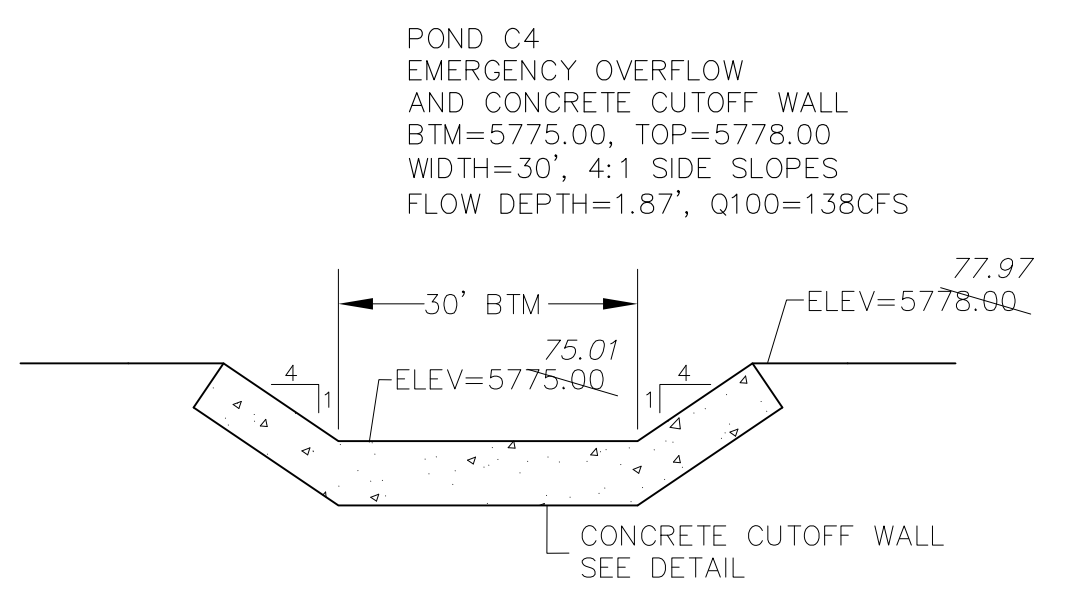

POND C4
EMERGENCY OVERFLOW
AND CONCRETE CUTOFF WALL
PROFILE
SCALE: NTS

AS-BUILT
DATE: 09/30/2022

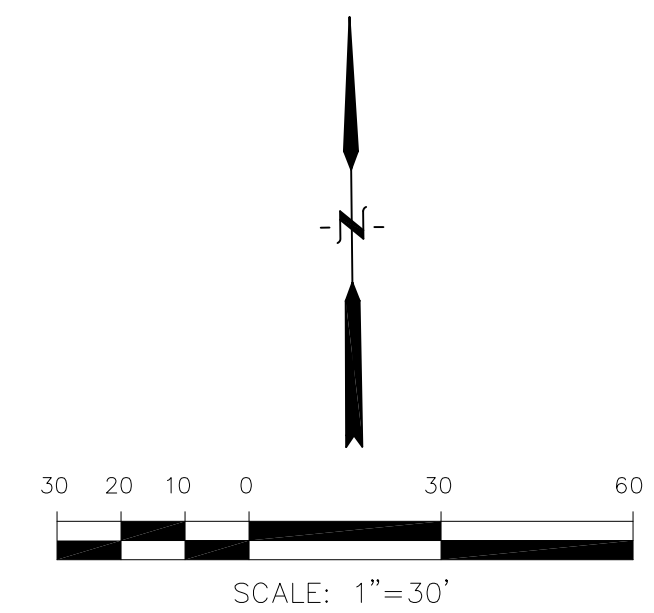

CORE
ENGINEERING GROUP
15004 1ST AVENUE S.
BURNING WOOD, CO 80903
CONTACT: RICHARD L. SCHINDLER, P.E.
EMAIL: Rich@ceg1.com

DATE: JAN 12, 2021

DESCRIPTION:

NO: 1


DRAWN: RLS
DESIGNED: RLS
CHECKED: RLS

PROJECT: THE HILLS COLLECTOR STREET CONSTRUCTION
212 N. WAHSATCH AVE. SUITE 301
COLORADO SPRINGS, COLORADO 80903
(719) 635-3200
CONTACT: JEFF MARK


PREPARED FOR: LORSON, LLC
212 N. WAHSATCH AVE. SUITE 301
COLORADO SPRINGS, COLORADO 80903
(719) 635-3200
CONTACT: JEFF MARK

POND C4
FOREBAY & LOW FLOW CHANNEL
LAYOUT


DATE: NOV 12, 2020
PROJECT NO: 100.061
SHEET NUMBER: C9.10
TOTAL SHEETS: 58

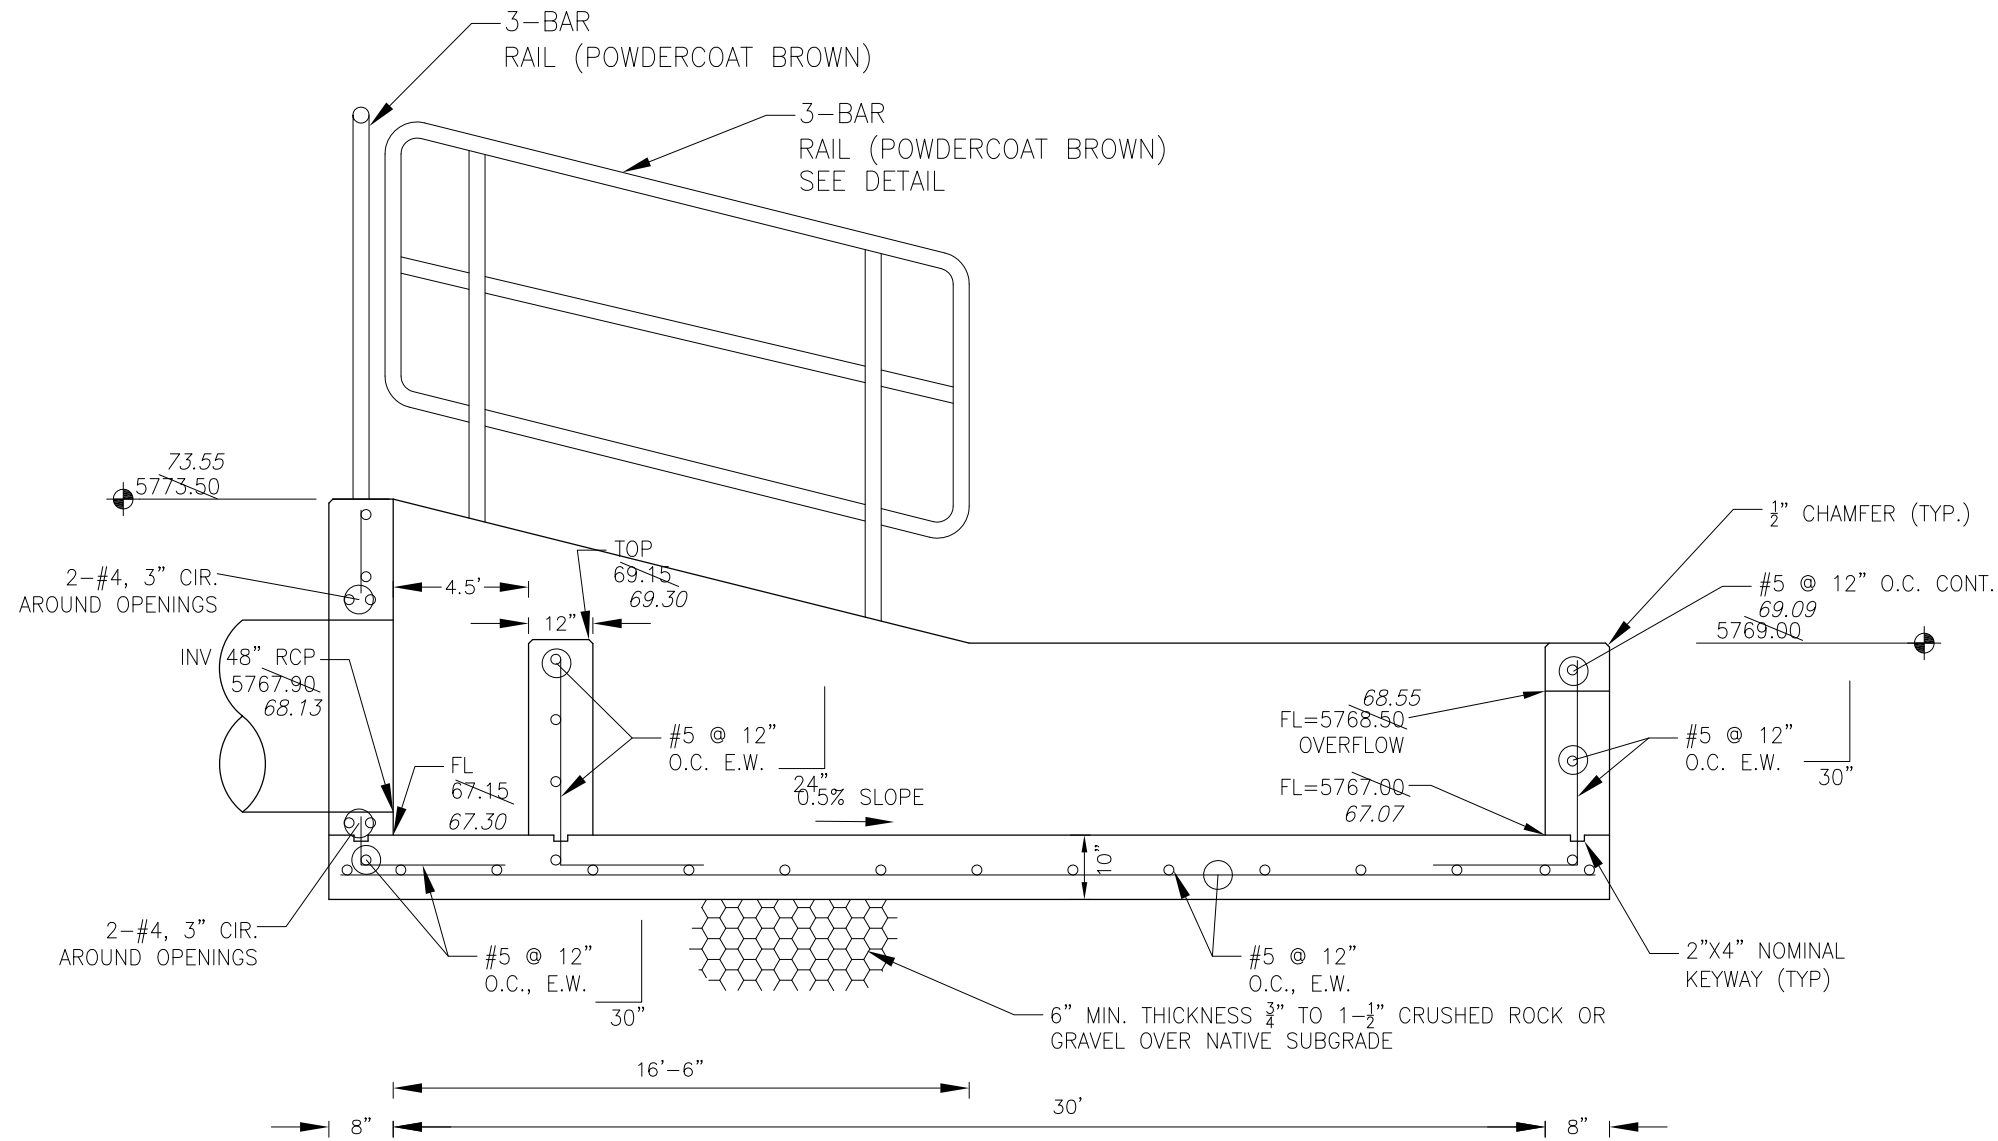

FOREBAY SECTION A-A
NO SCALE

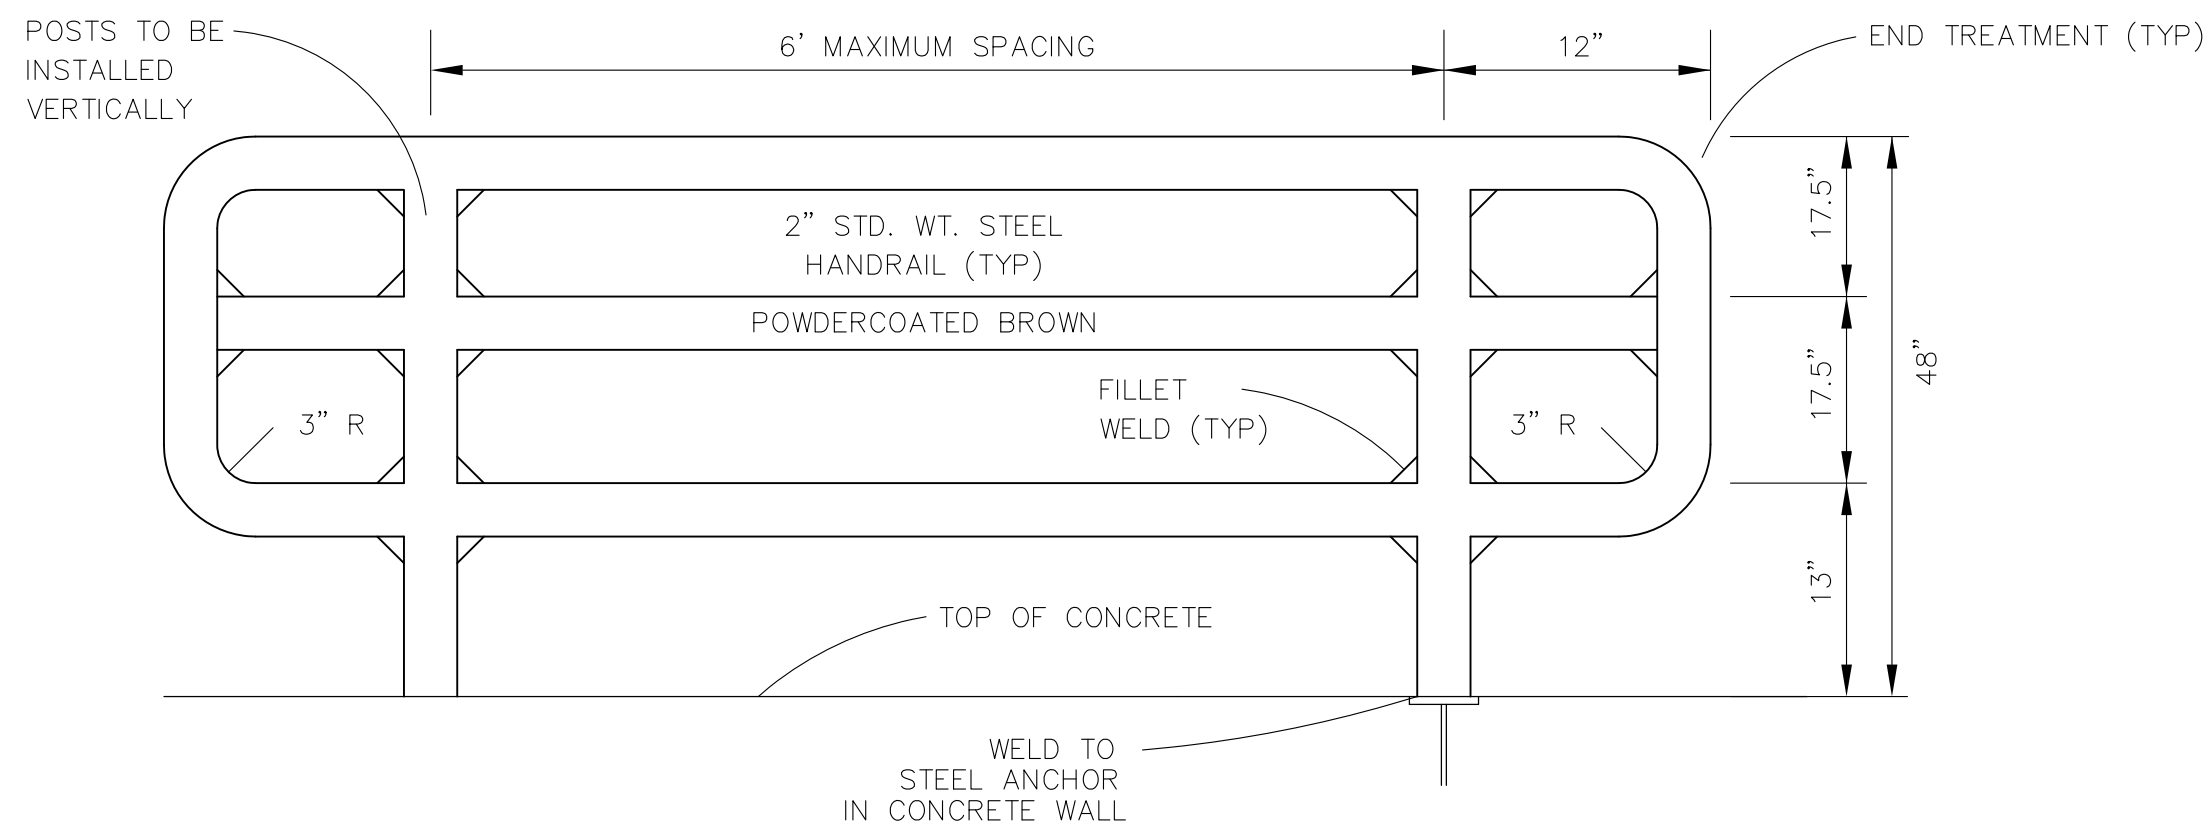


3-BAR RAIL DETAIL
NO SCALE

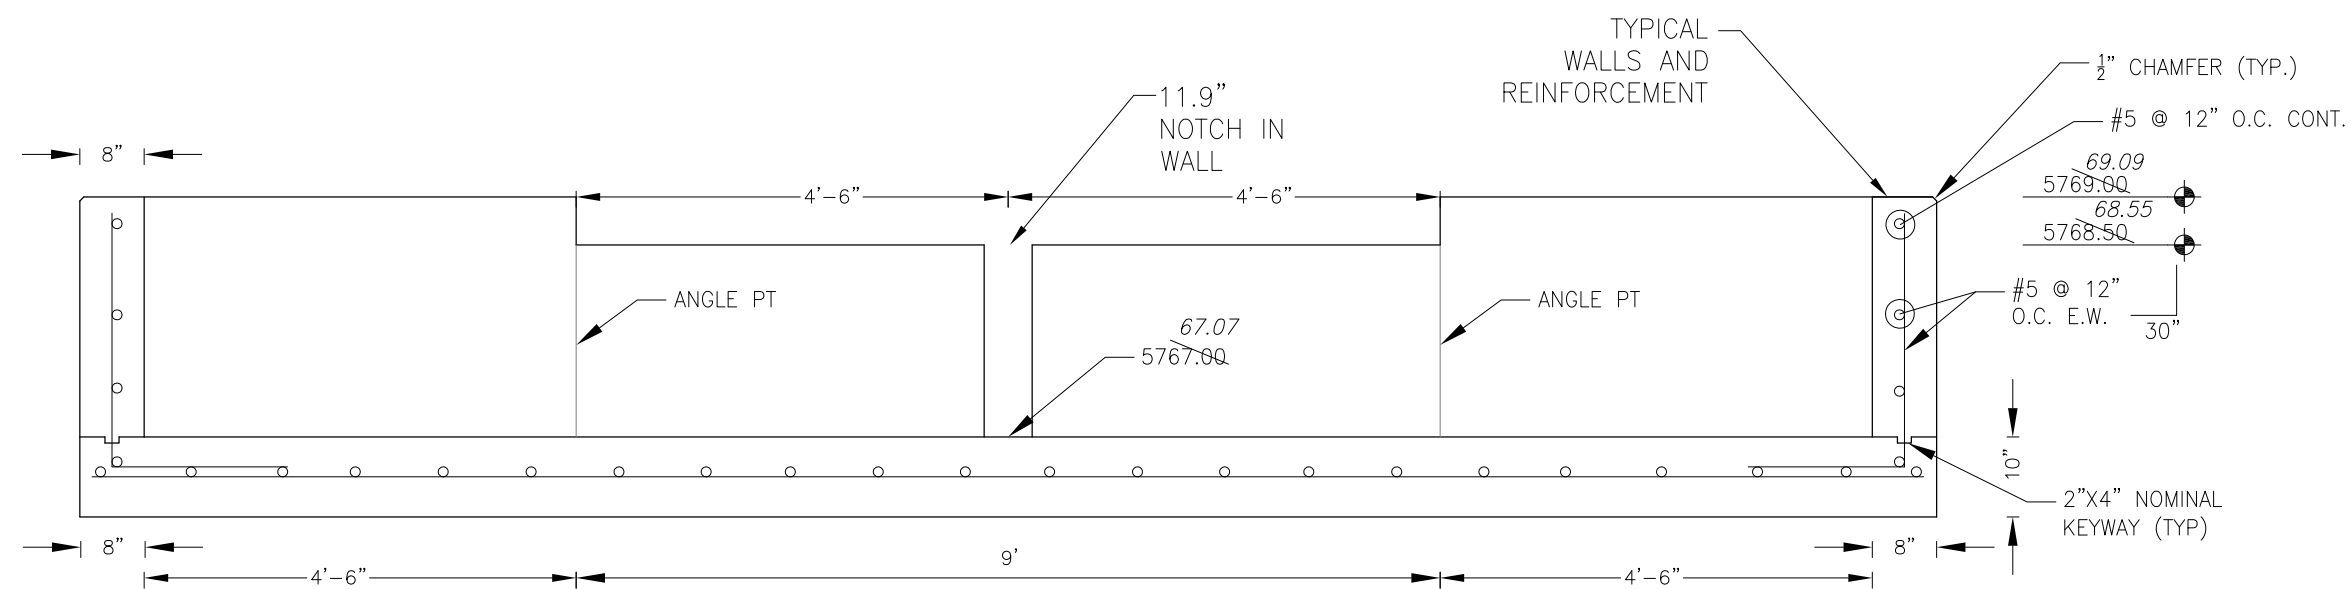


FOREBAY SECTION B-B
NO SCALE

NOTE: ALL CONCRETE
FOR FOREBAY SHALL BE
CDOT TYPE D

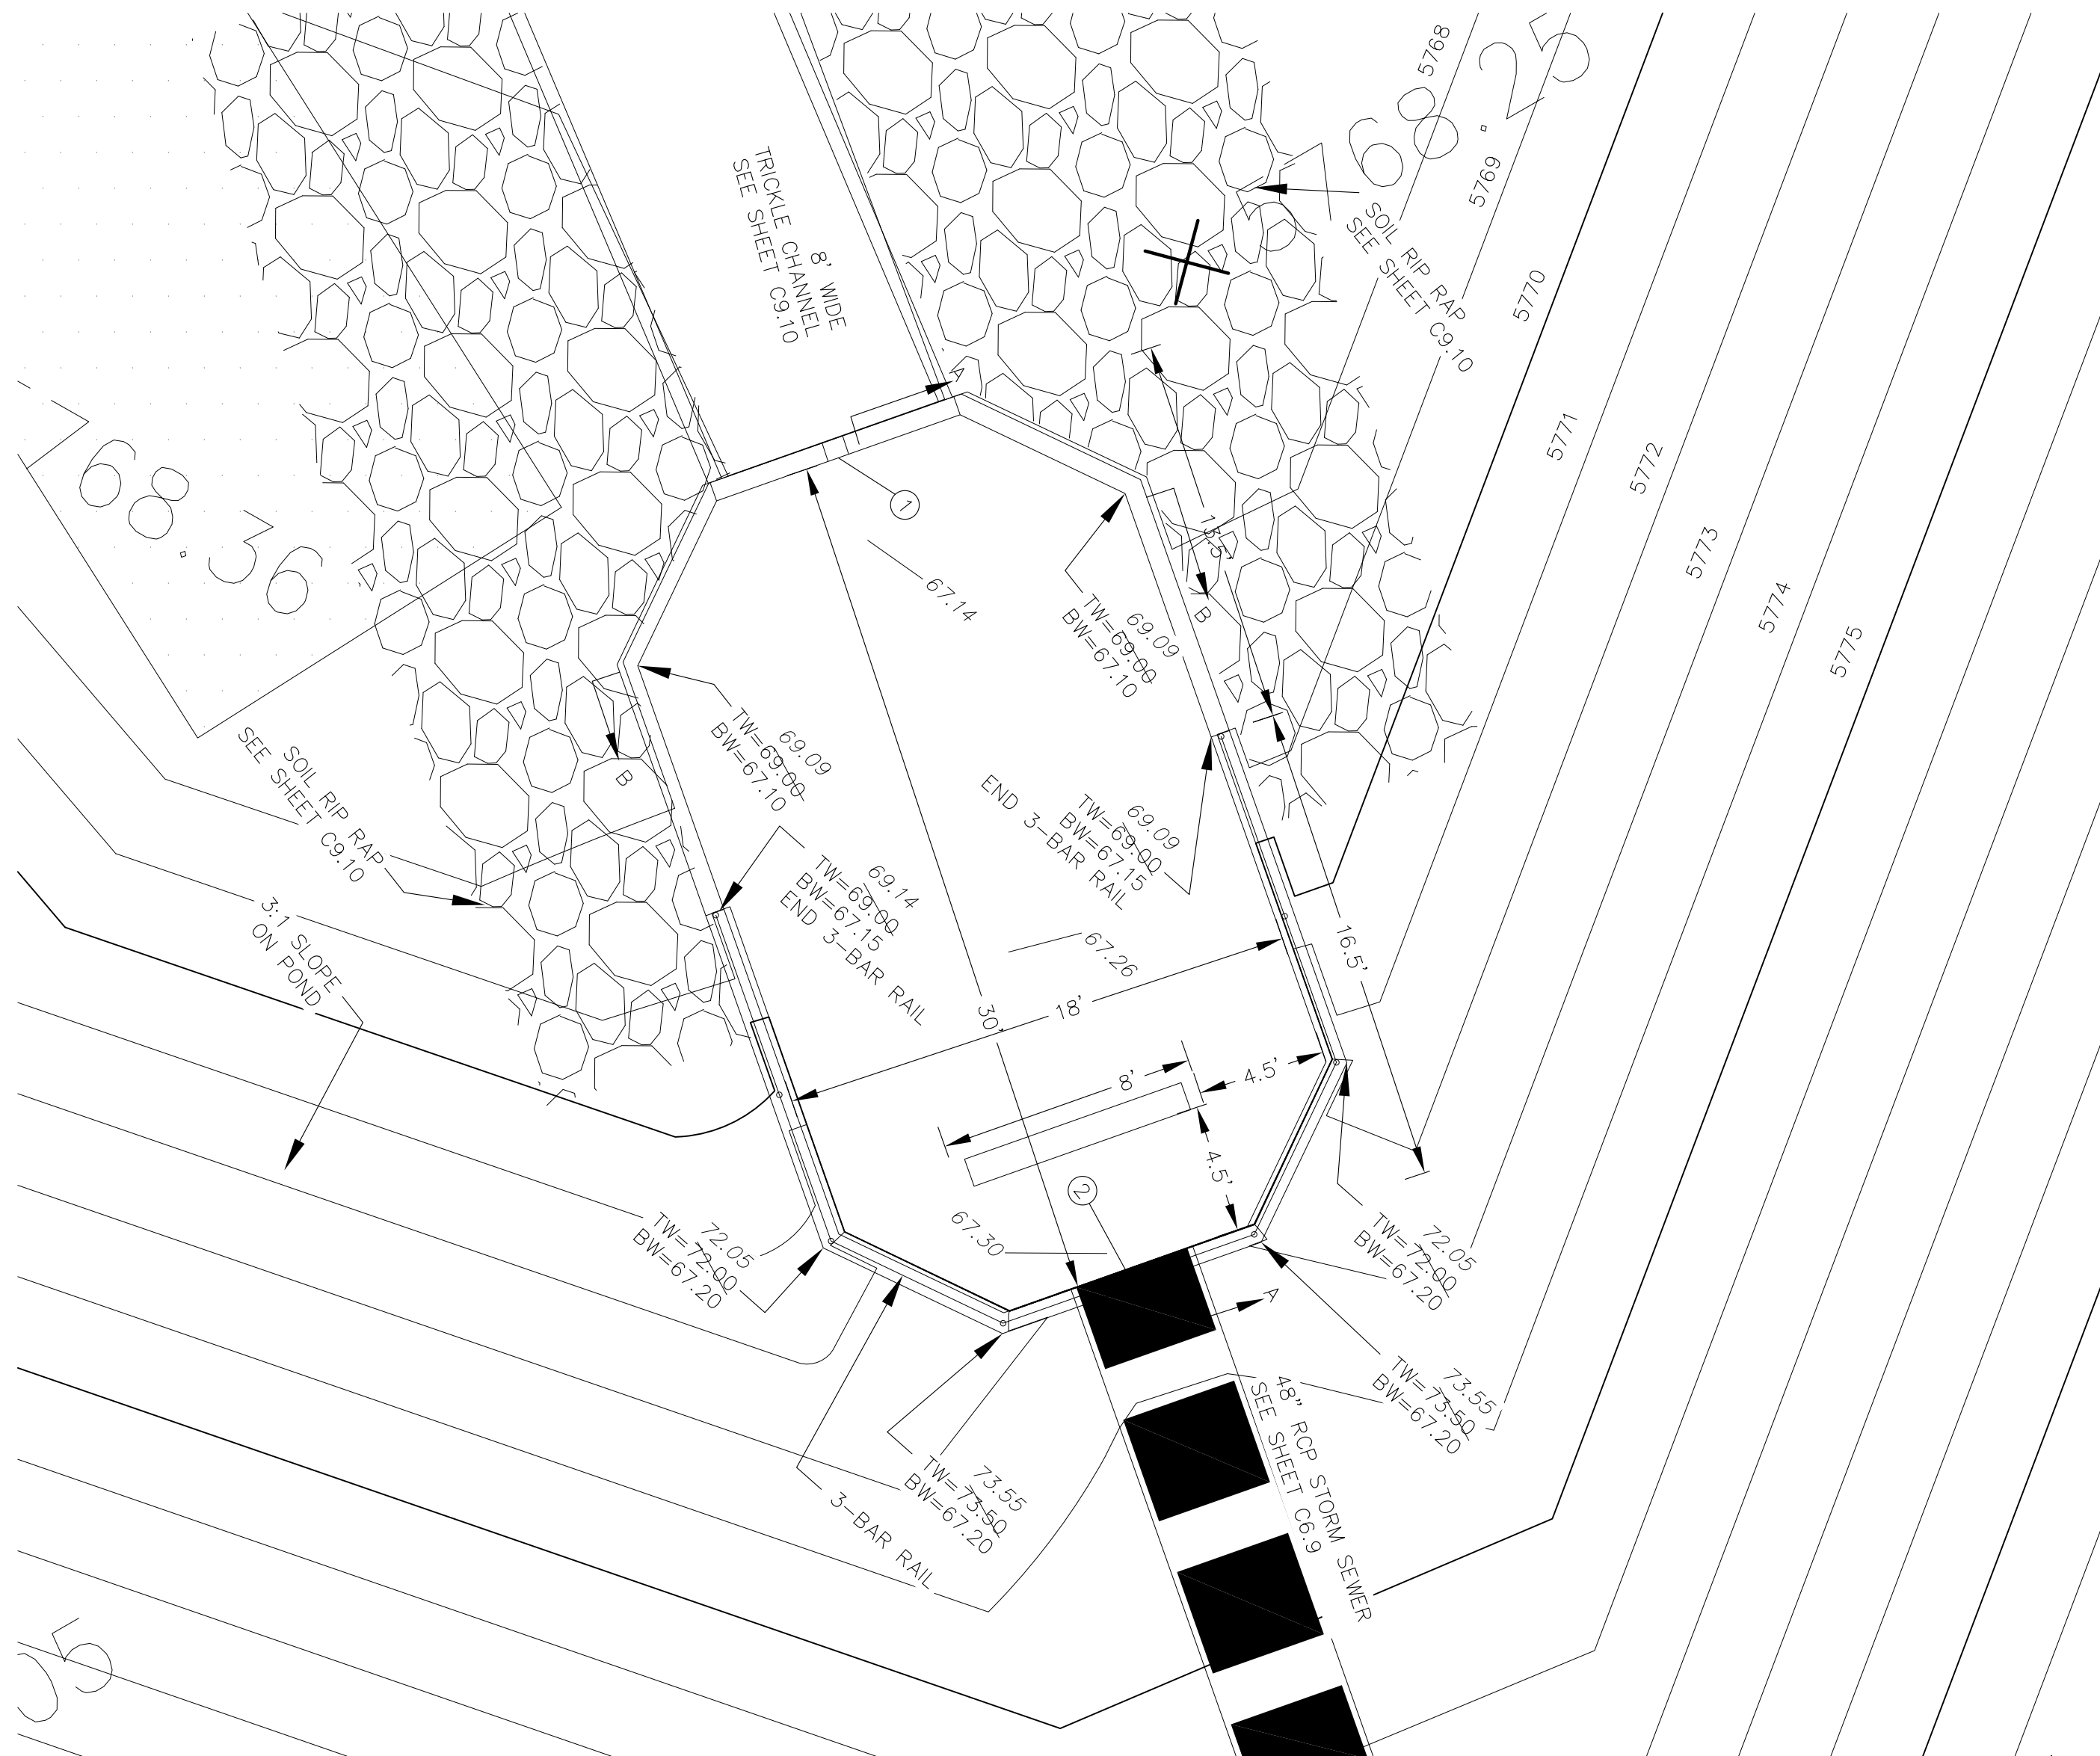

POND C4 - FOREBAY LAYOUT
SCALE: 1"=5'

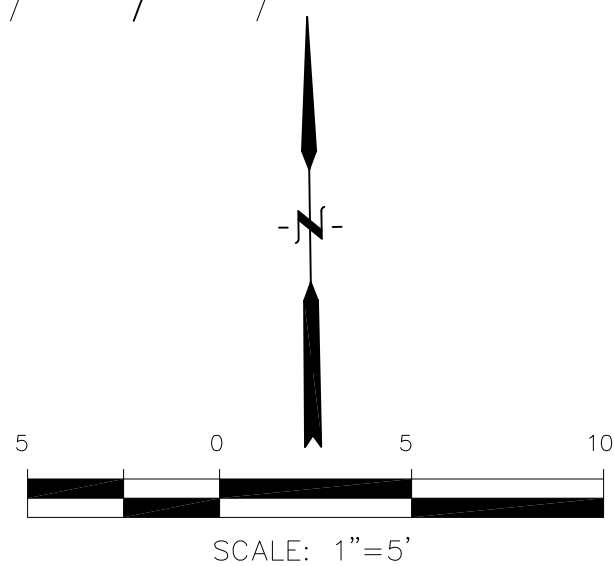

POINT TABLE (FOREBAY)				
NUMBER	NORTHING	EASTING	ELEVATION	NOTES
1	24309.51	29914.77	5767.00	FOREBAY BOTTOM
2	24281.30	29924.99	5767.15	FOREBAY BOTTOM, INV 48"=5767.90

CORE
ENGINEERING GROUP
15004 1ST AVENUE S.
BURNING WOOD, CO 80903
CONTACT: RICHARD L. SCHINDLER, P.E.
EMAIL: Rich@ceg1.com

DATE: JAN 12, 2021
DESCRIPTION: RAISE SITE 1' EAST OF POWERLINES
NO: 1
PROJECT: THE HILLS COLLECTOR STREET CONSTRUCTION
212 N. WAHSATCH AVE. SUITE 301
COLORADO SPRINGS, COLORADO 80903
CONTACT: JEFF MARK

PREPARED FOR: LORSON, LLC
212 N. WAHSATCH AVE. SUITE 301
COLORADO SPRINGS, COLORADO 80903
CONTACT: JEFF MARK

DRAWN: RLS
DESIGNED: RLS
CHECKED: RLS

POND C4
FOREBAY DETAILS



DATE: NOV 12, 2020

PROJECT NO. 100.061




SHEET NUMBER C9.11

TOTAL SHEETS: 58




AS-BUILT
DATE: 09/30/2022

1. ALL SPOT ELEVATIONS ARE FLOW LINE UNLESS OTHERWISE NOTED.
2. SEE GRADING PLAN FOR GRADING INFORMATION.
3. ALL STORM SEWER SHALL BE CLASS III RCP.
4. ALL MHs SHALL BE TYPE 1 UNLESS OTHERWISE NOTED.

- 1 CURVE DATA ID
2 CURB TRANSITIONS
3 PEDESTRIAN RAMP, SEE SHEET C10.1

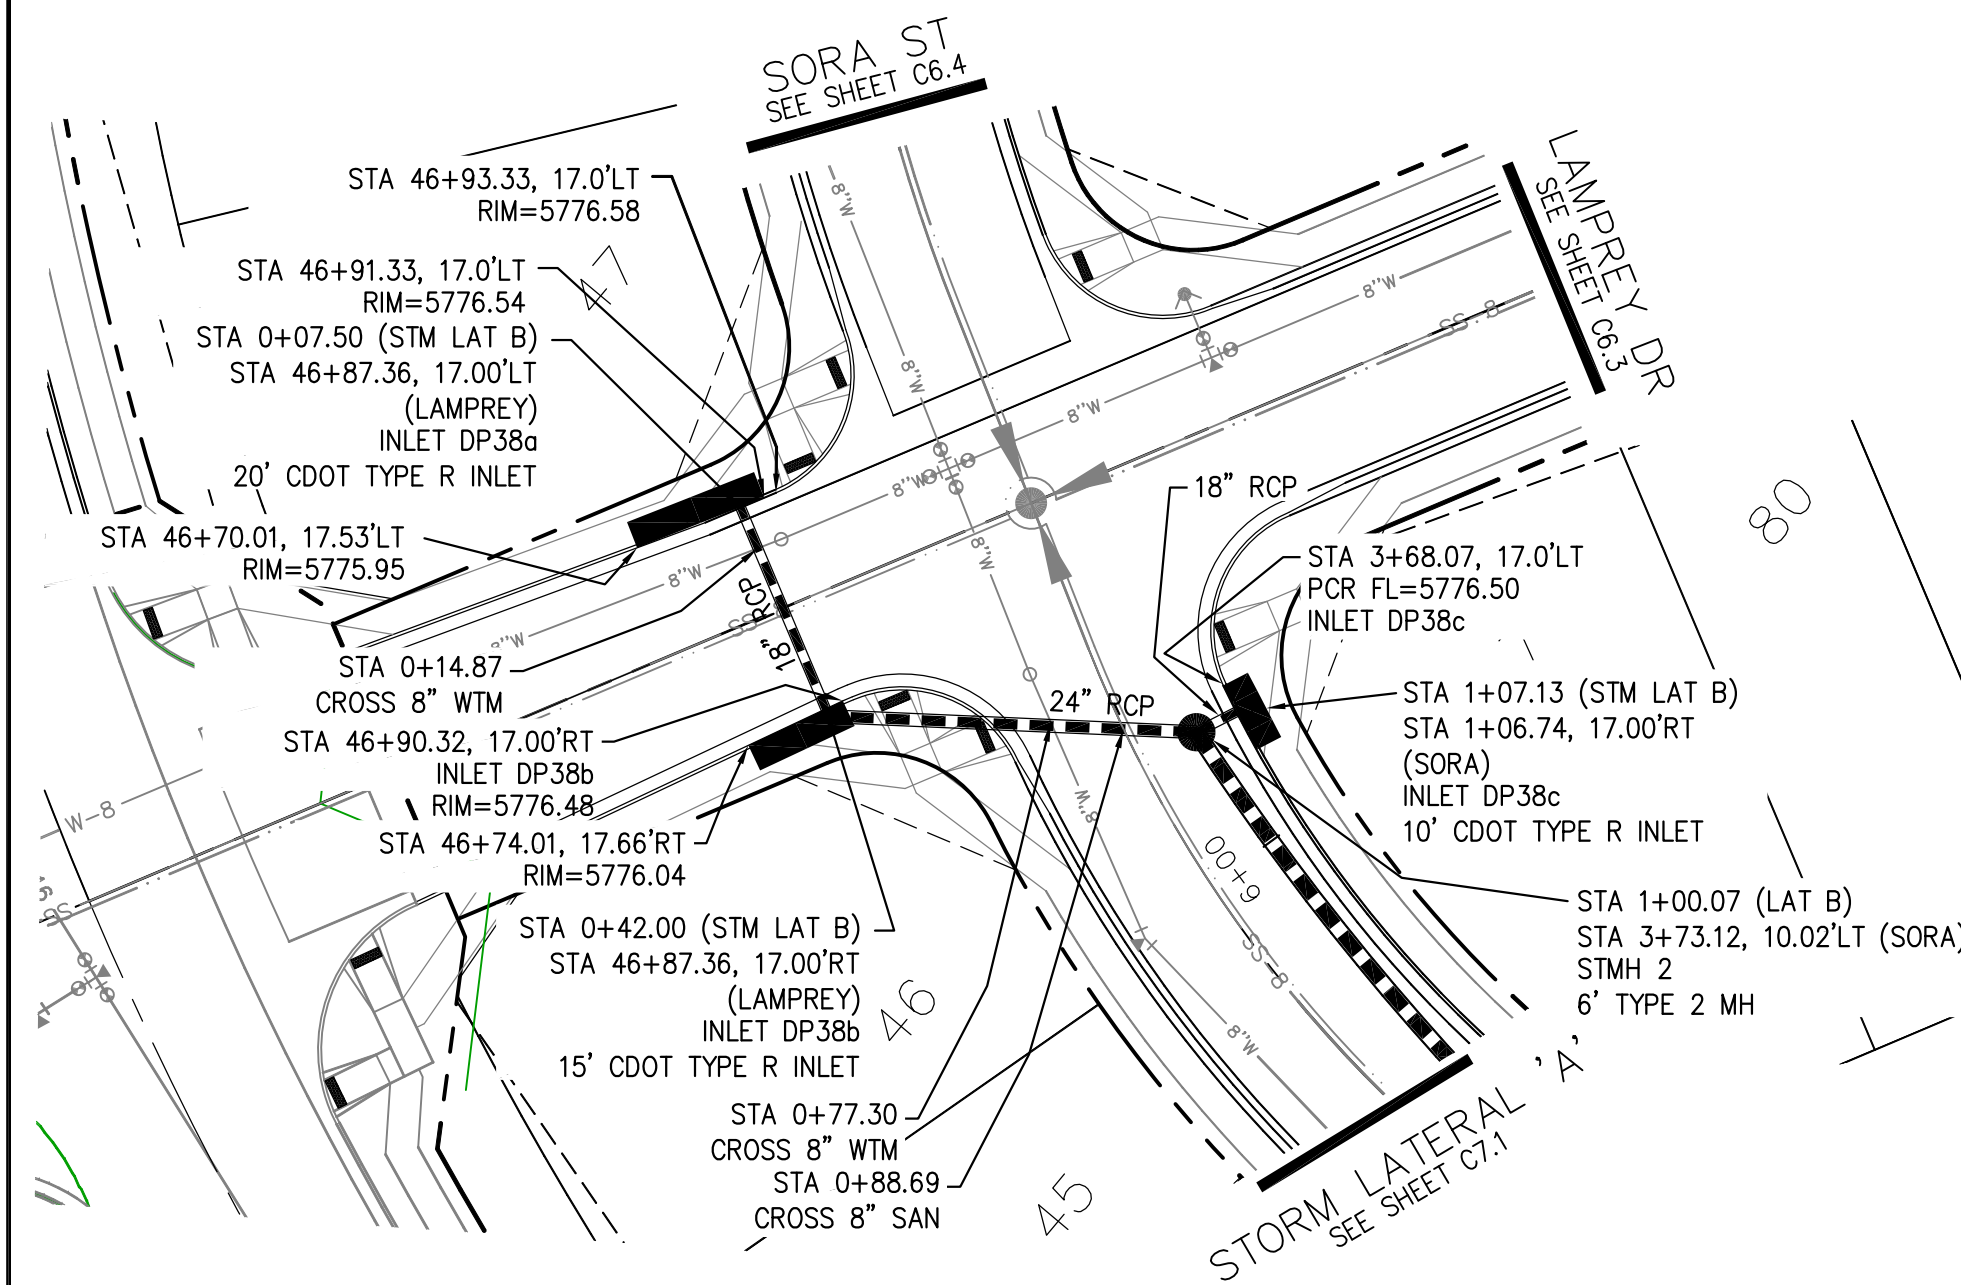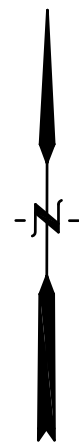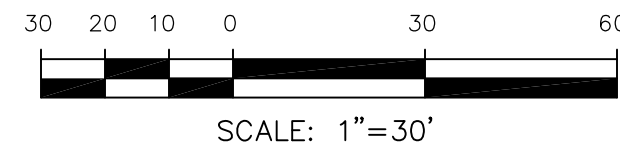


STORM LATERAL 'B' (PUBLIC)

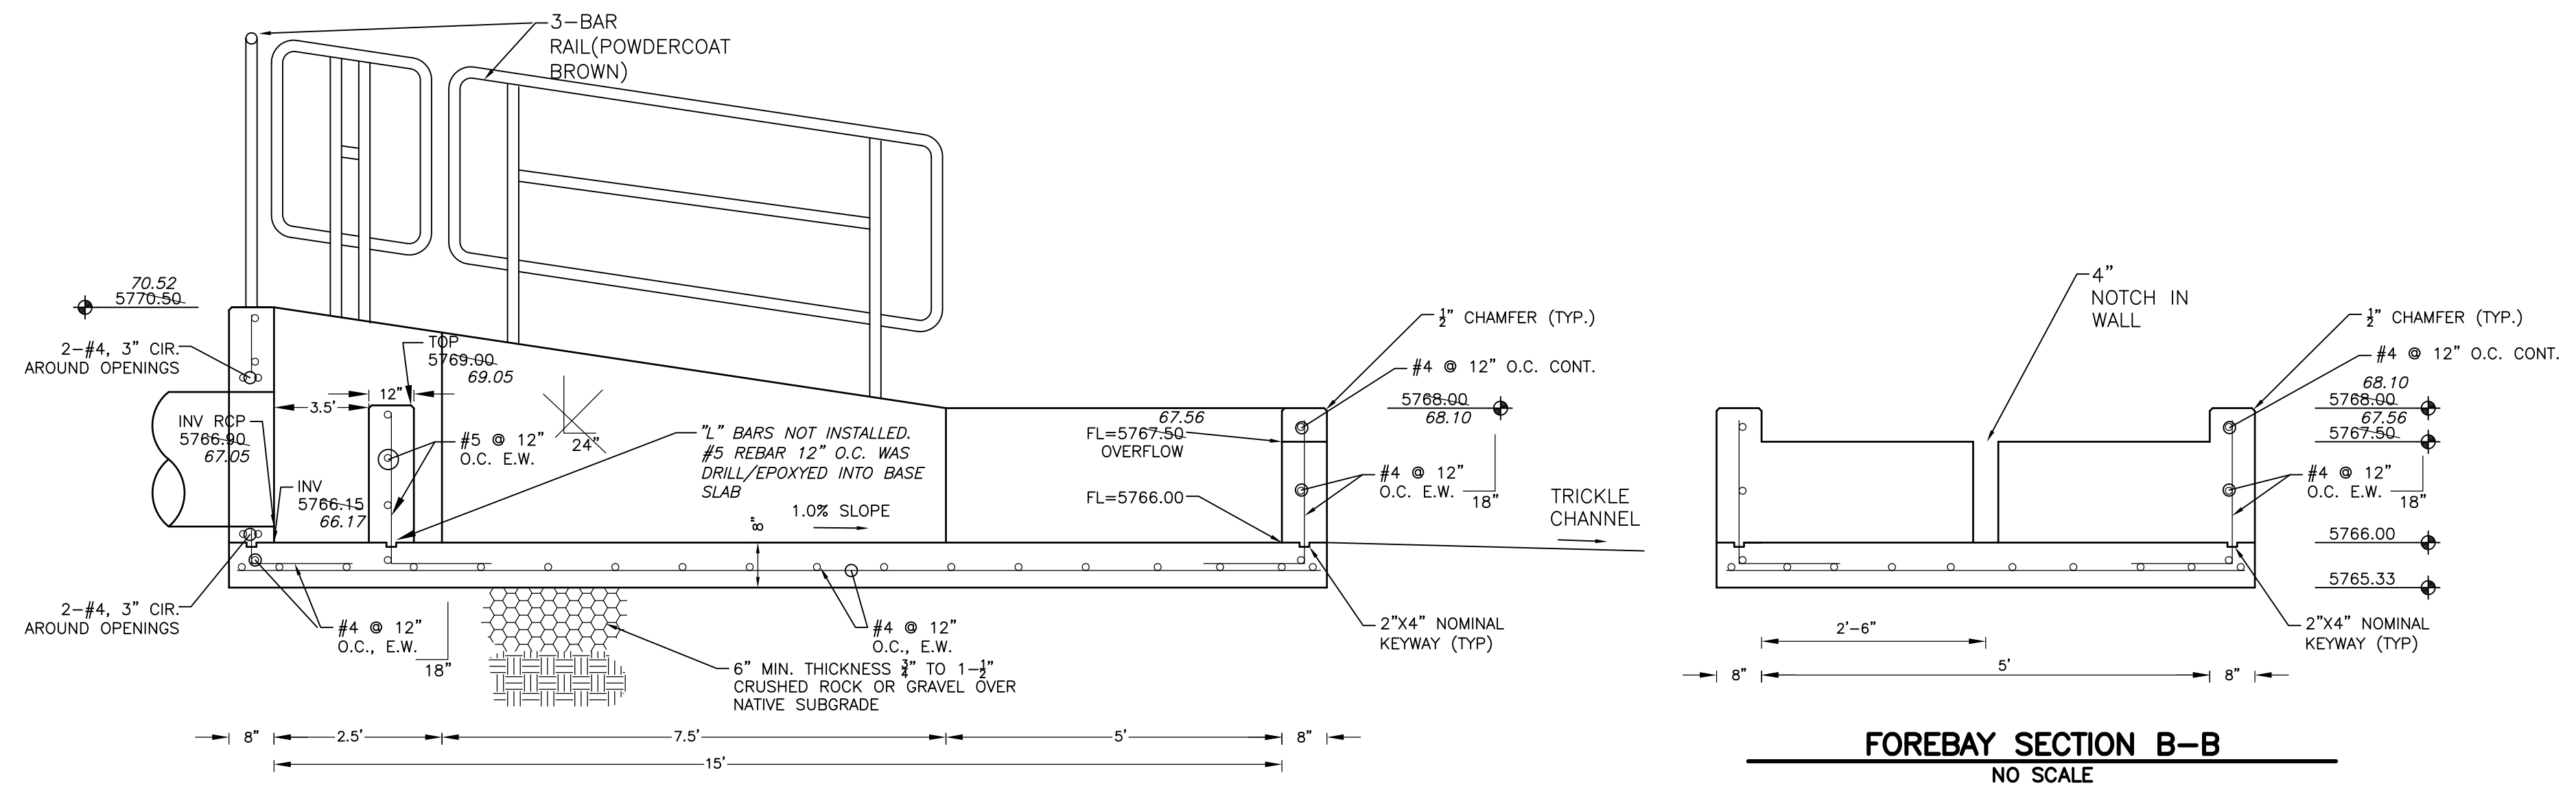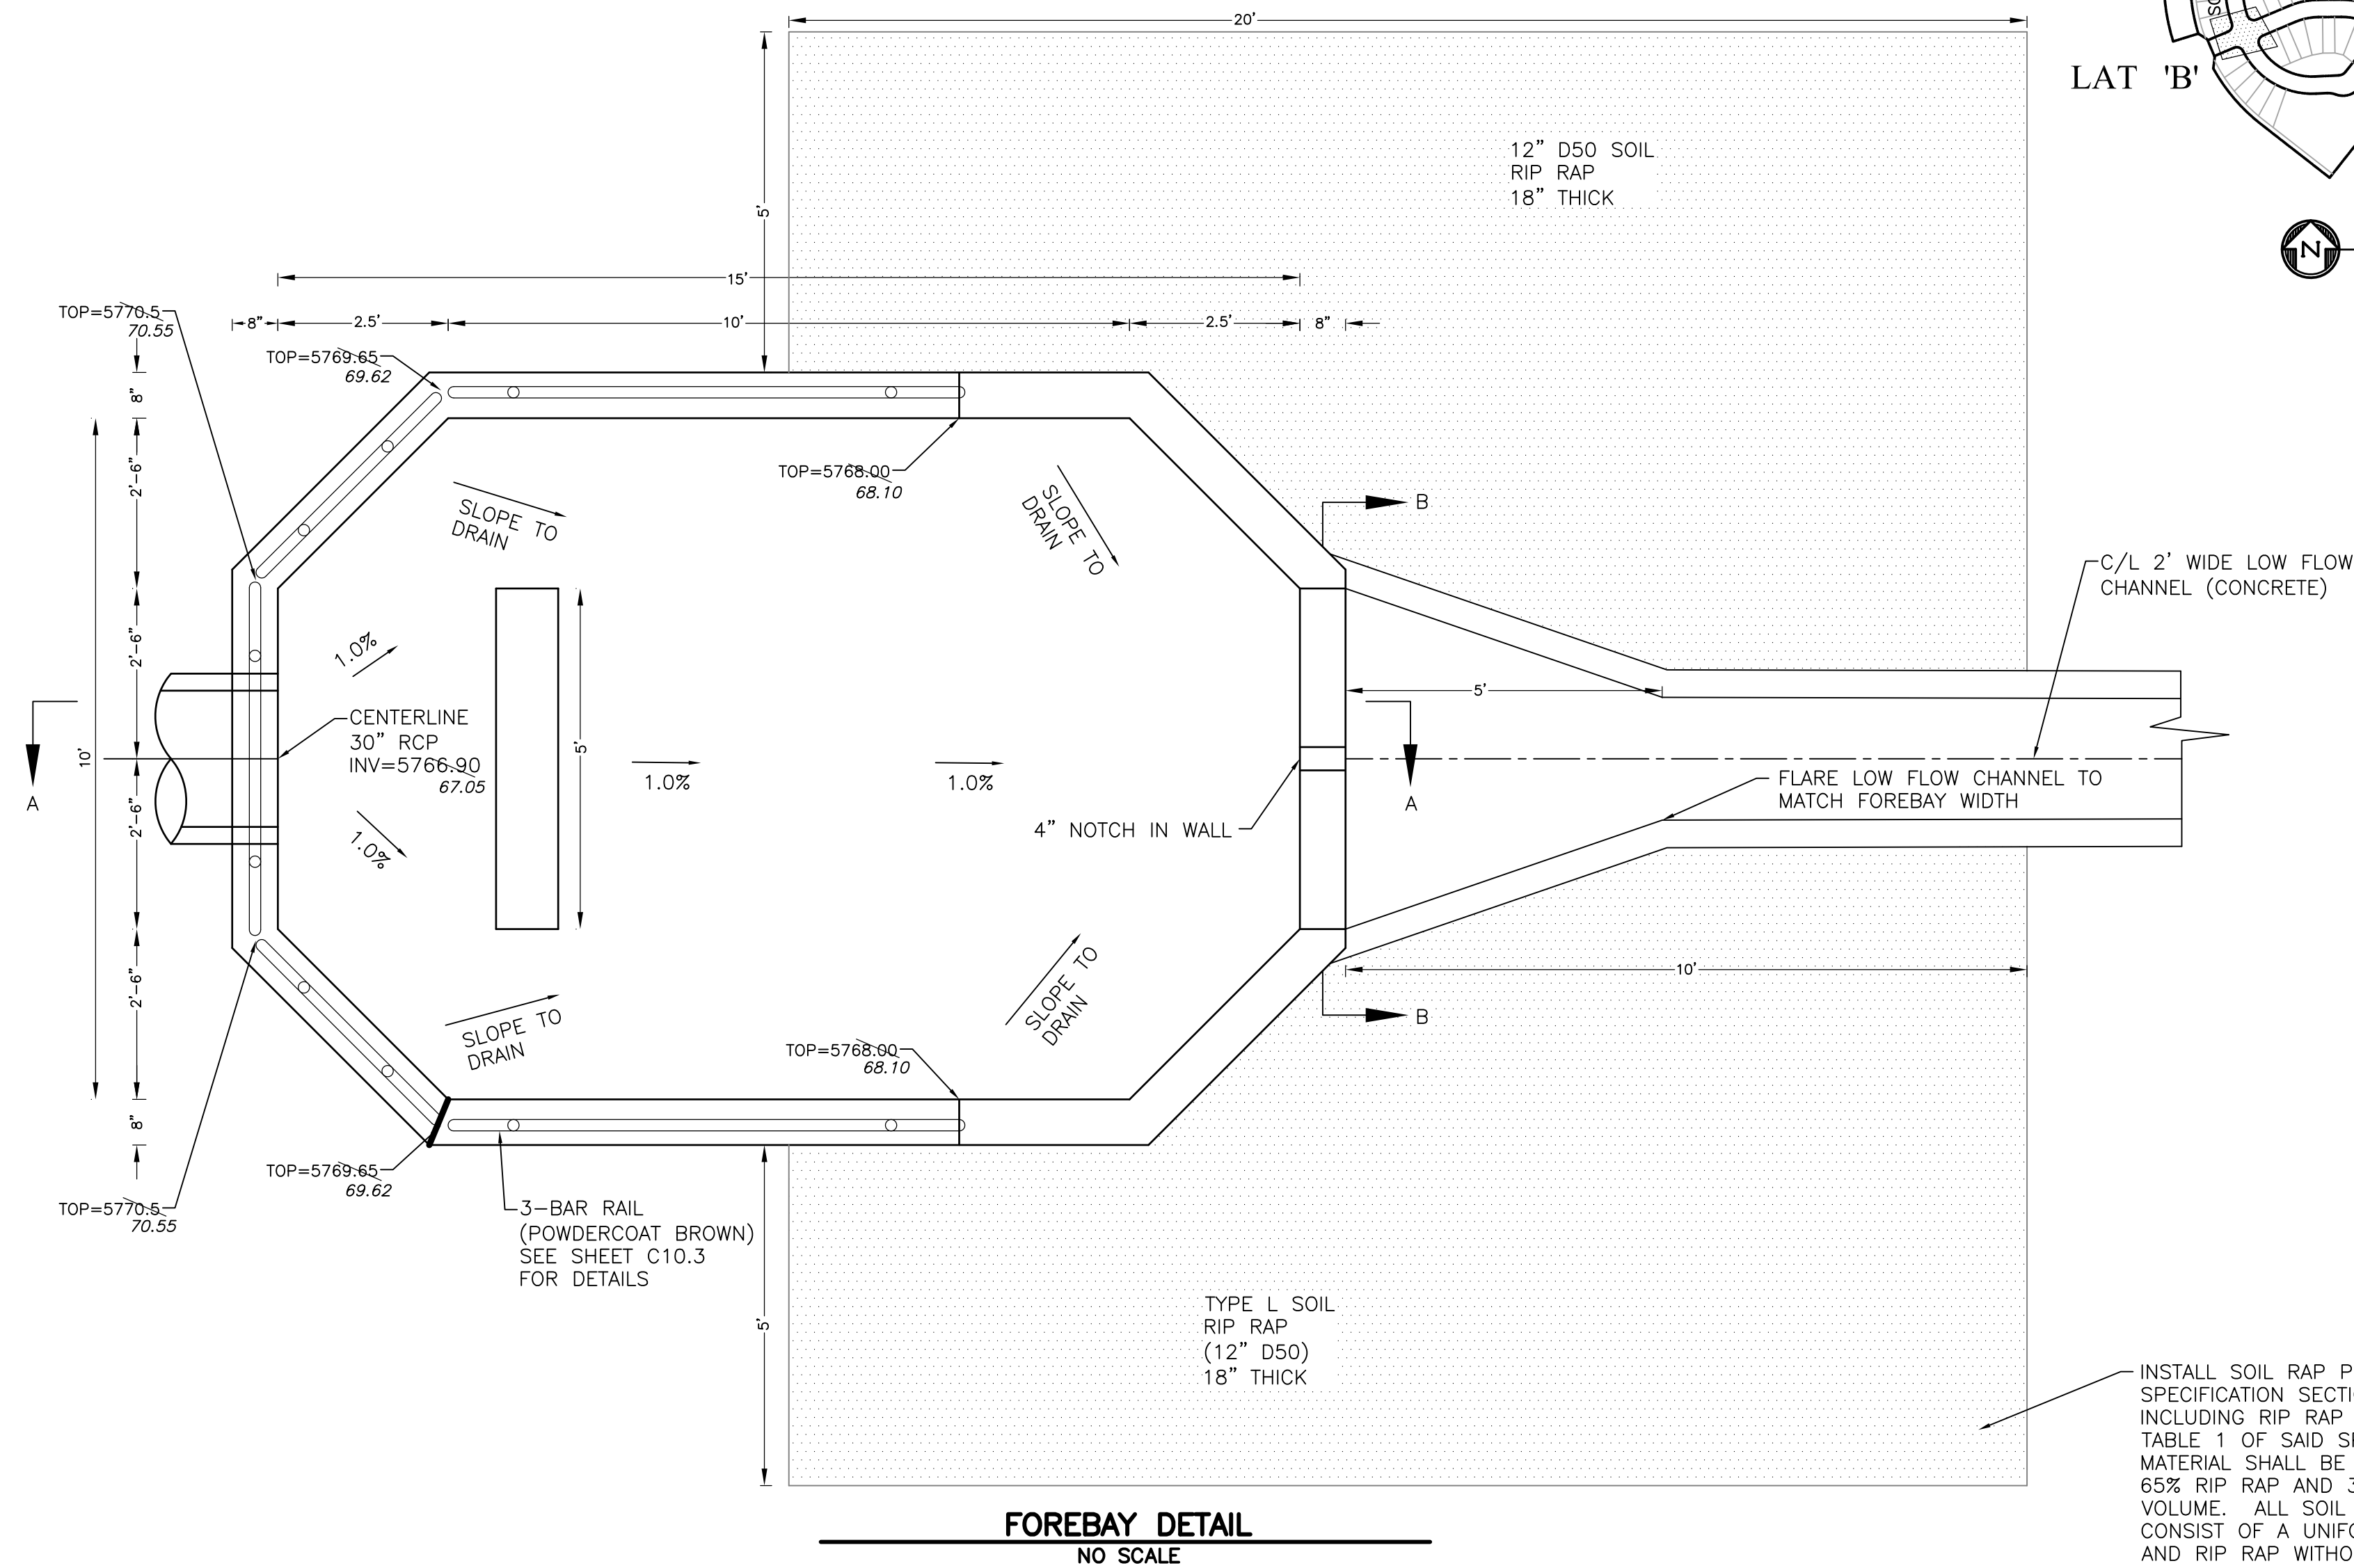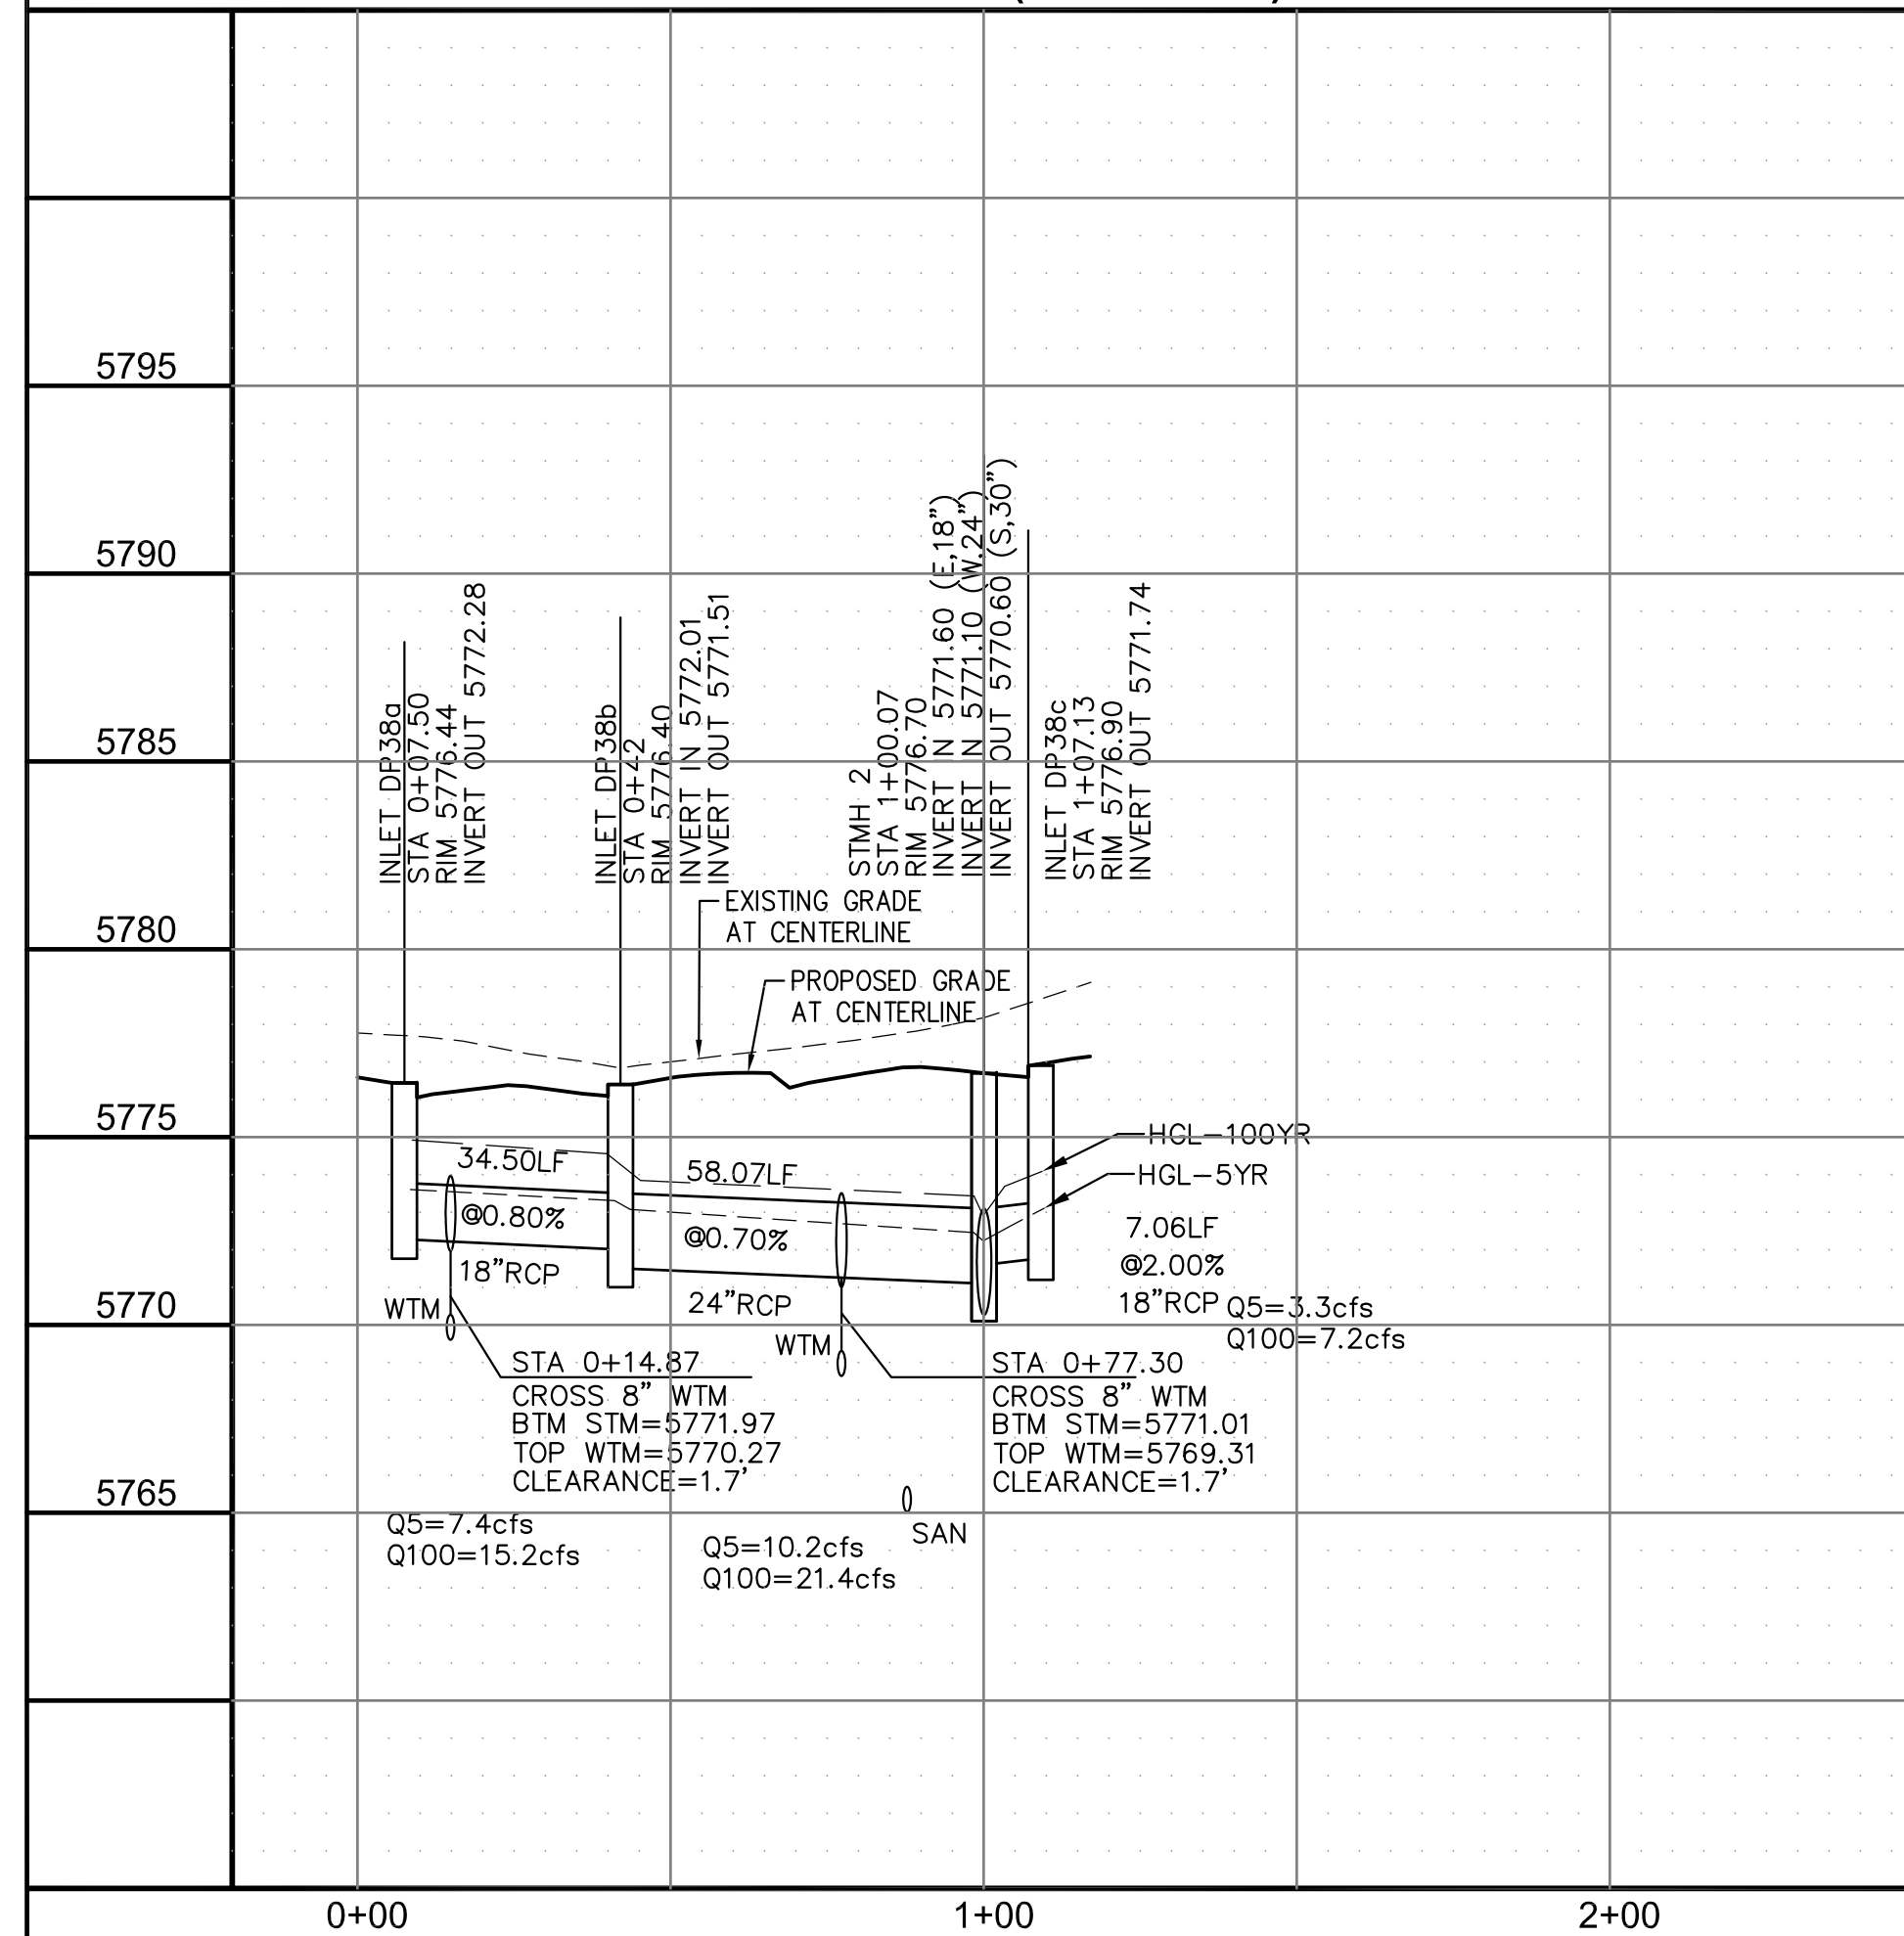

FOREBAY SECTION A-A
NO SCALE

AS-BUILT
DATE: 11/03/2022

DATE: 11/03/2022

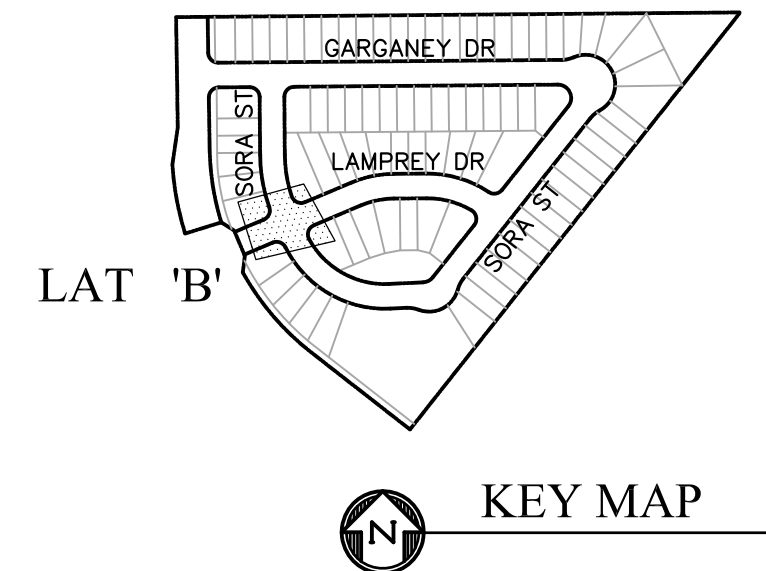

CORE
ENGINEERING GROUP
15004 1ST AVENUE S.
BURNSVILLE, MN 55306
PH: 719.570.1100
CONTACT: RICHARD L. SCHINDLER, P.E.
EMAIL: Rich@ceg1.com

[illegible]

DRAWN: RLS
DESIGNED: RLS
CHECKED: RLS

STORM SEWER LATERAL
STORM LATERAL 'B'
AND SKYLINE POND C4 FOREBAY




DATE:
MAY 2, 2022






PROJECT NO.
100.063

SHEET NUMBER
C7.2

TOTAL SHEETS: 17

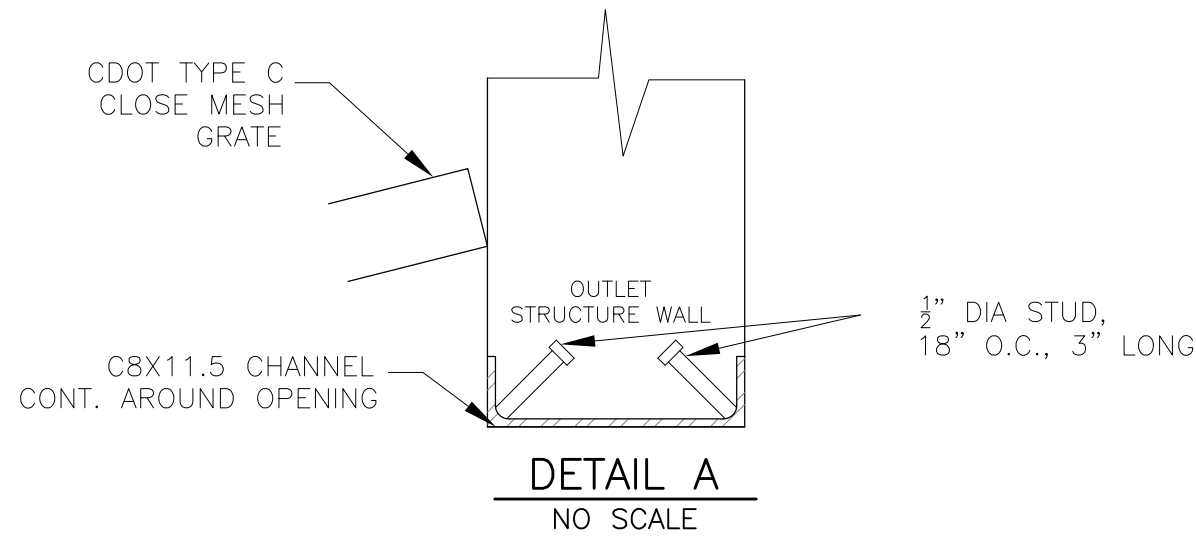

NOTE:
AFTER CONCRETE STRUCTURE HAS BEEN POURED
ALL GRATE DIMENSIONS SHALL BE FIELD VERIFIED
PRIOR TO GRATE CONSTRUCTION

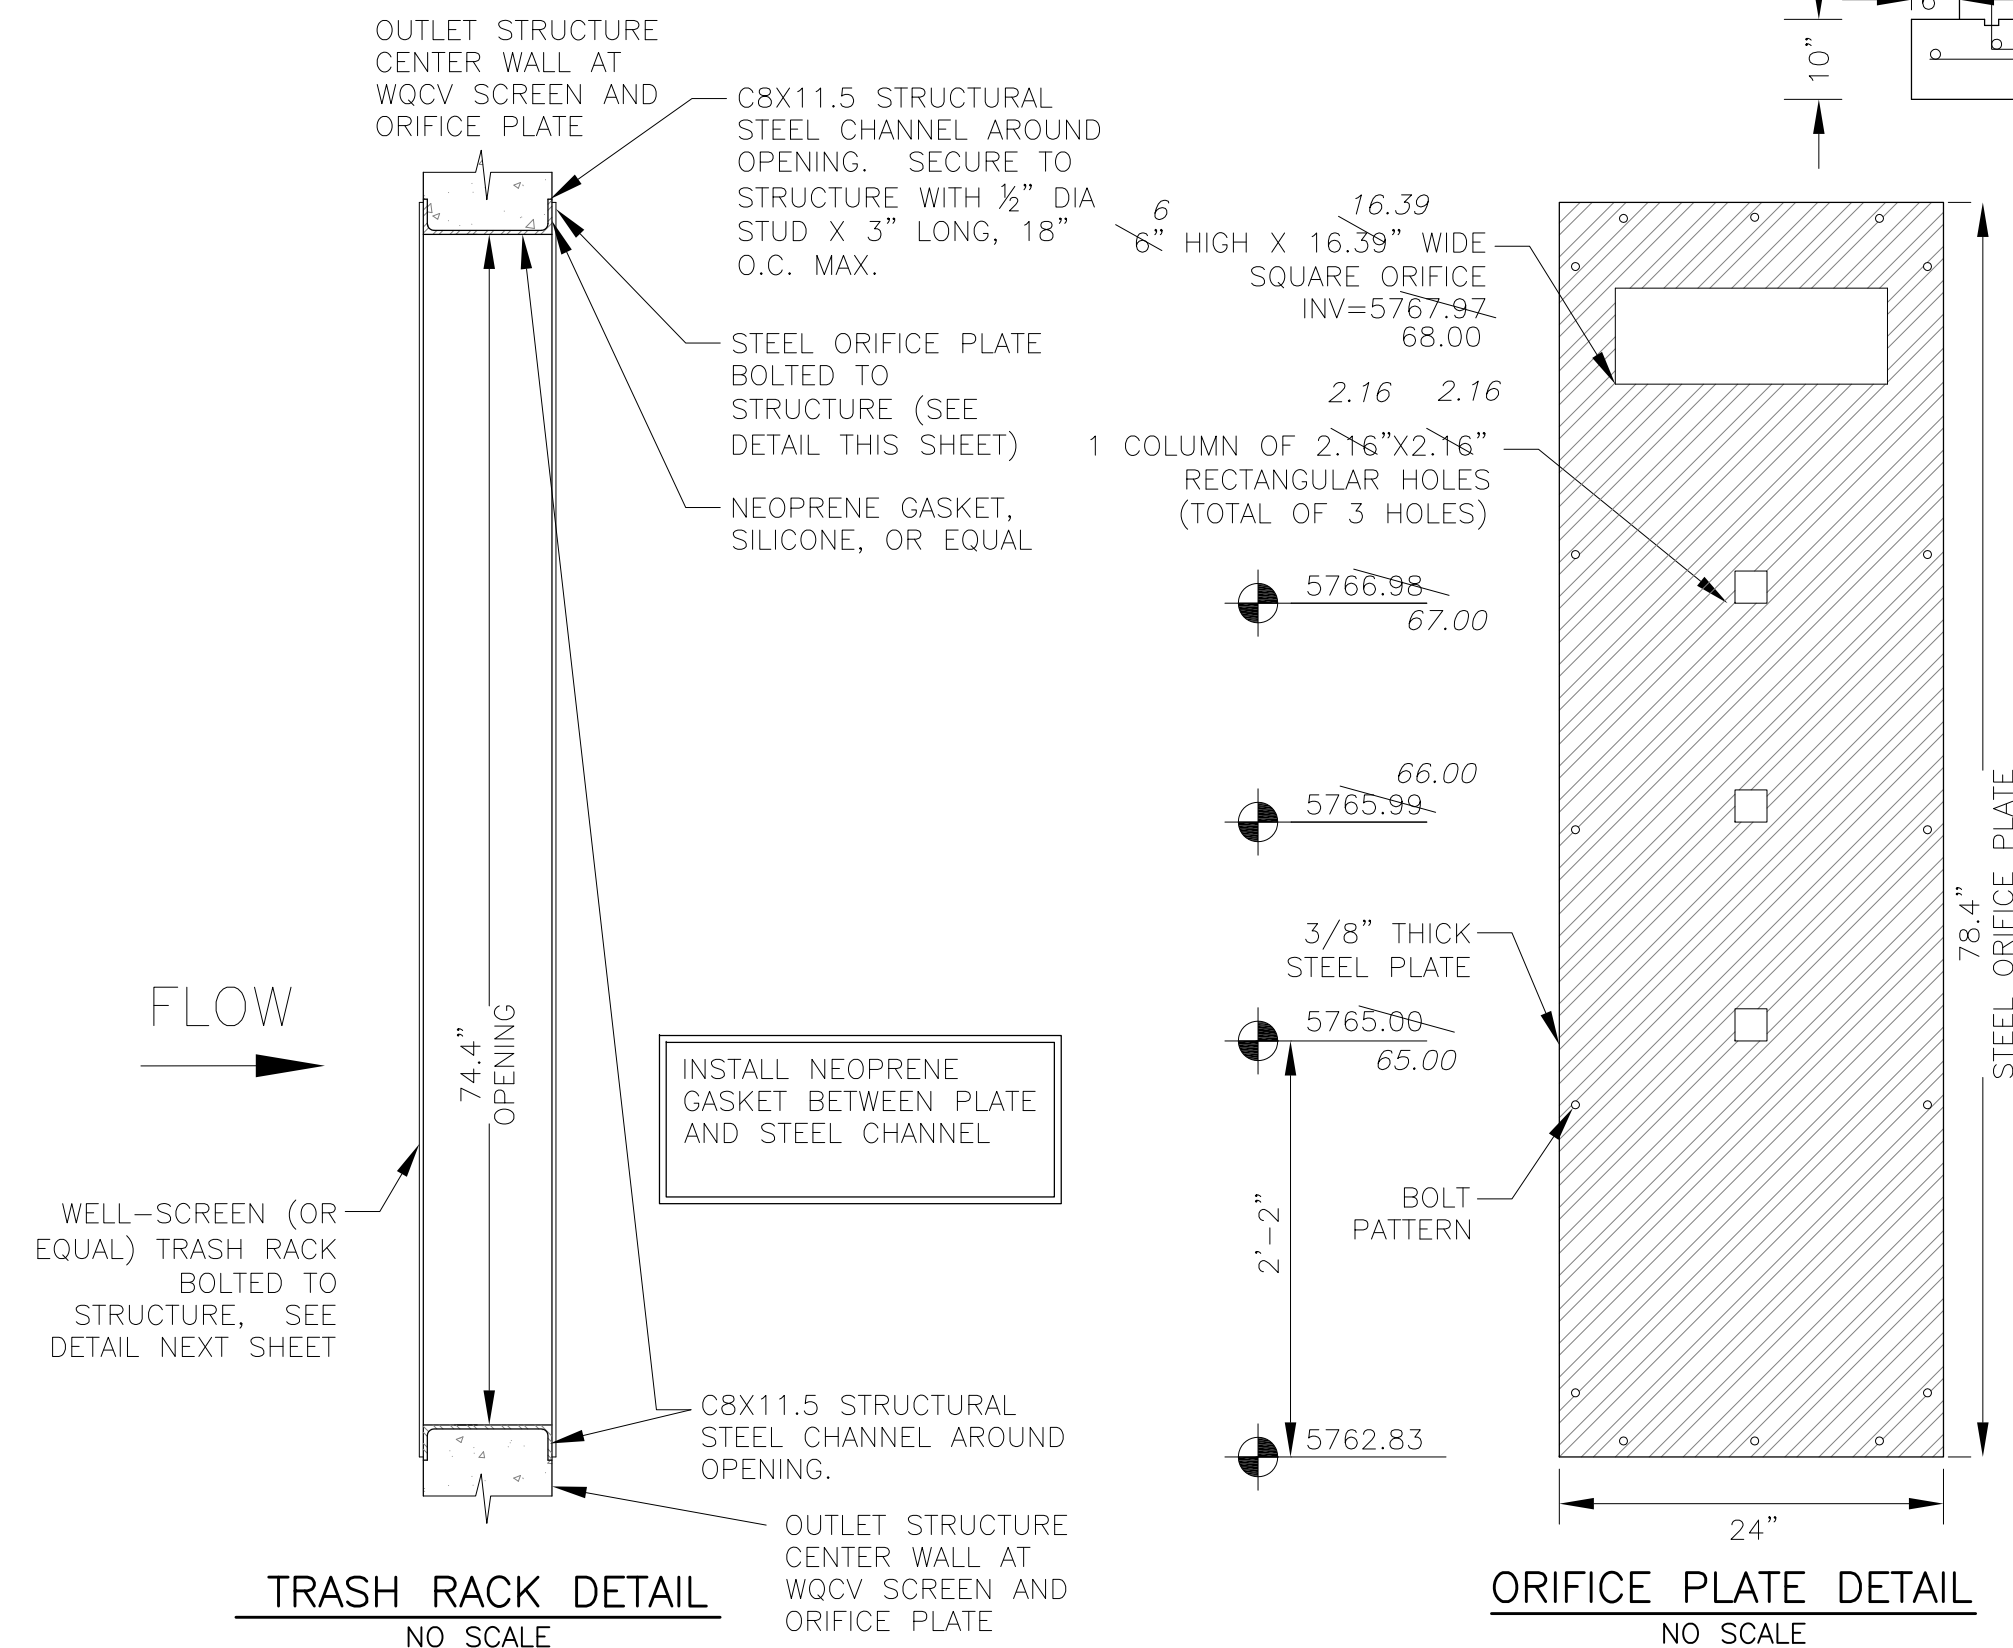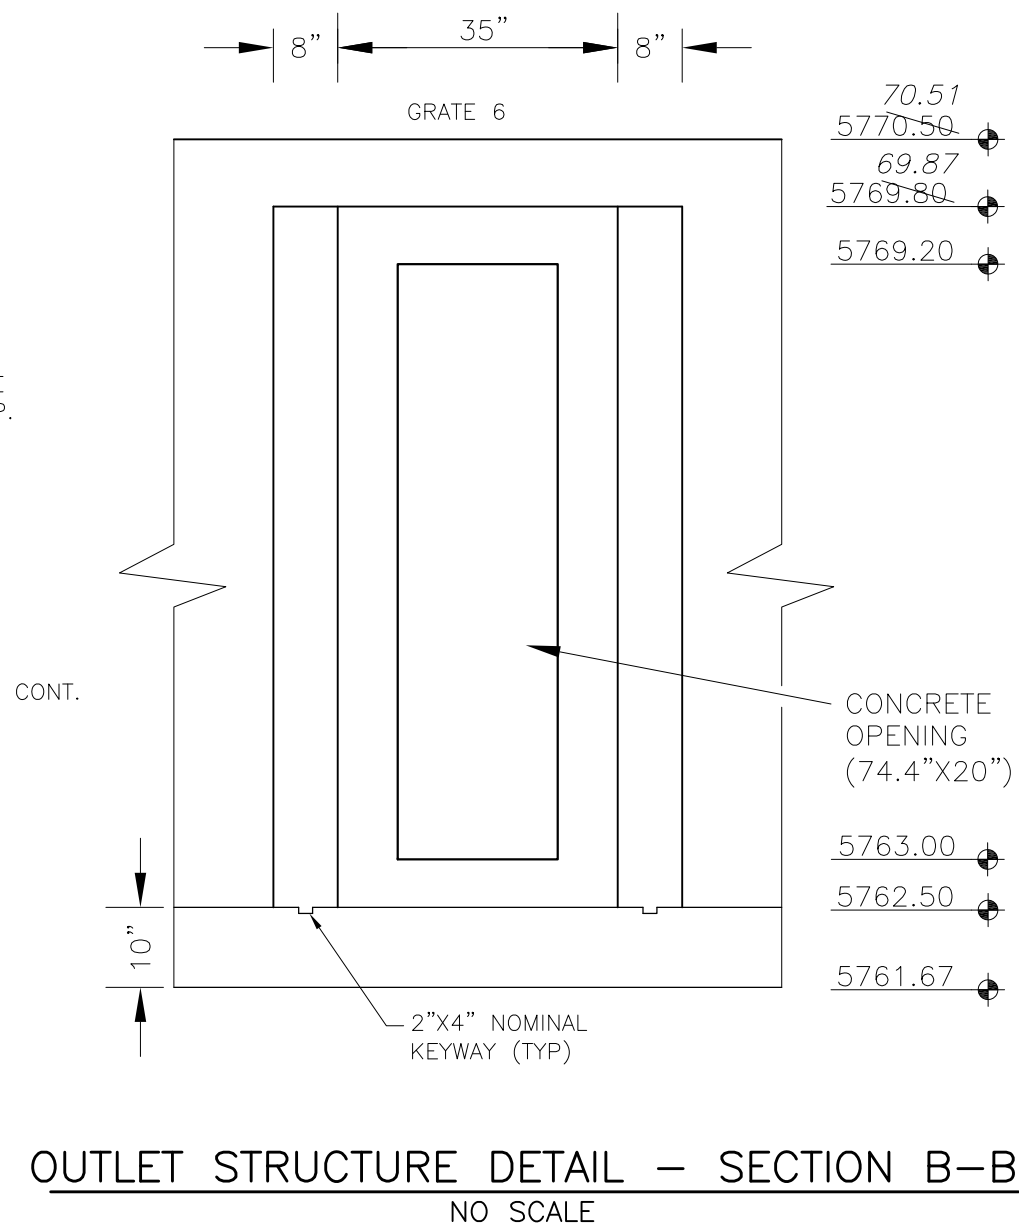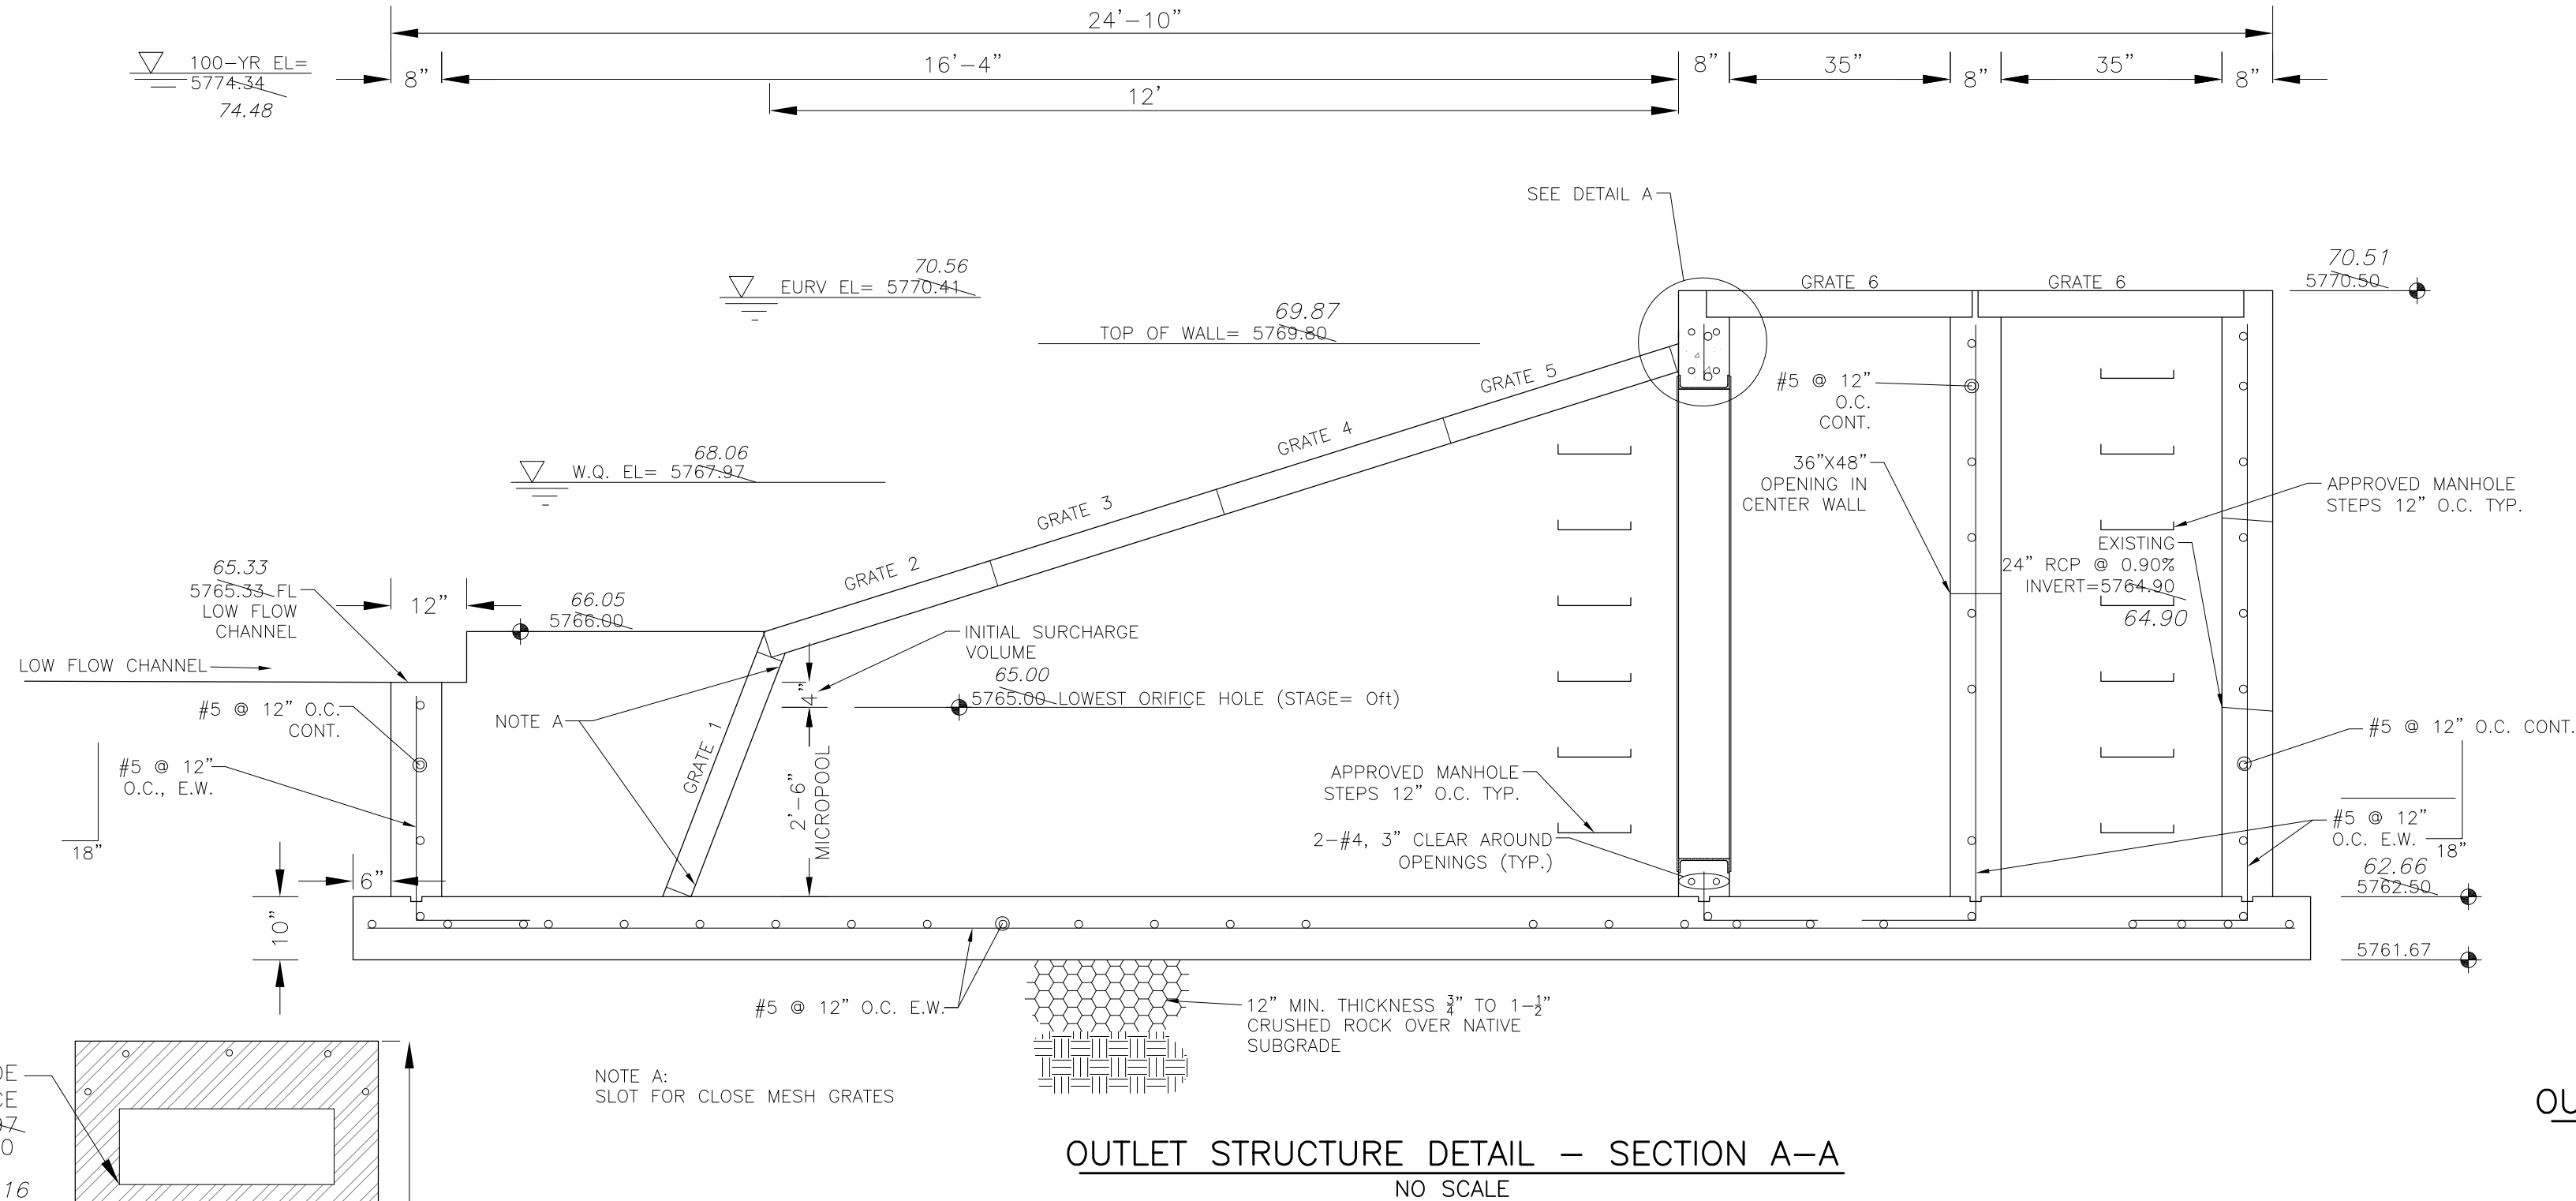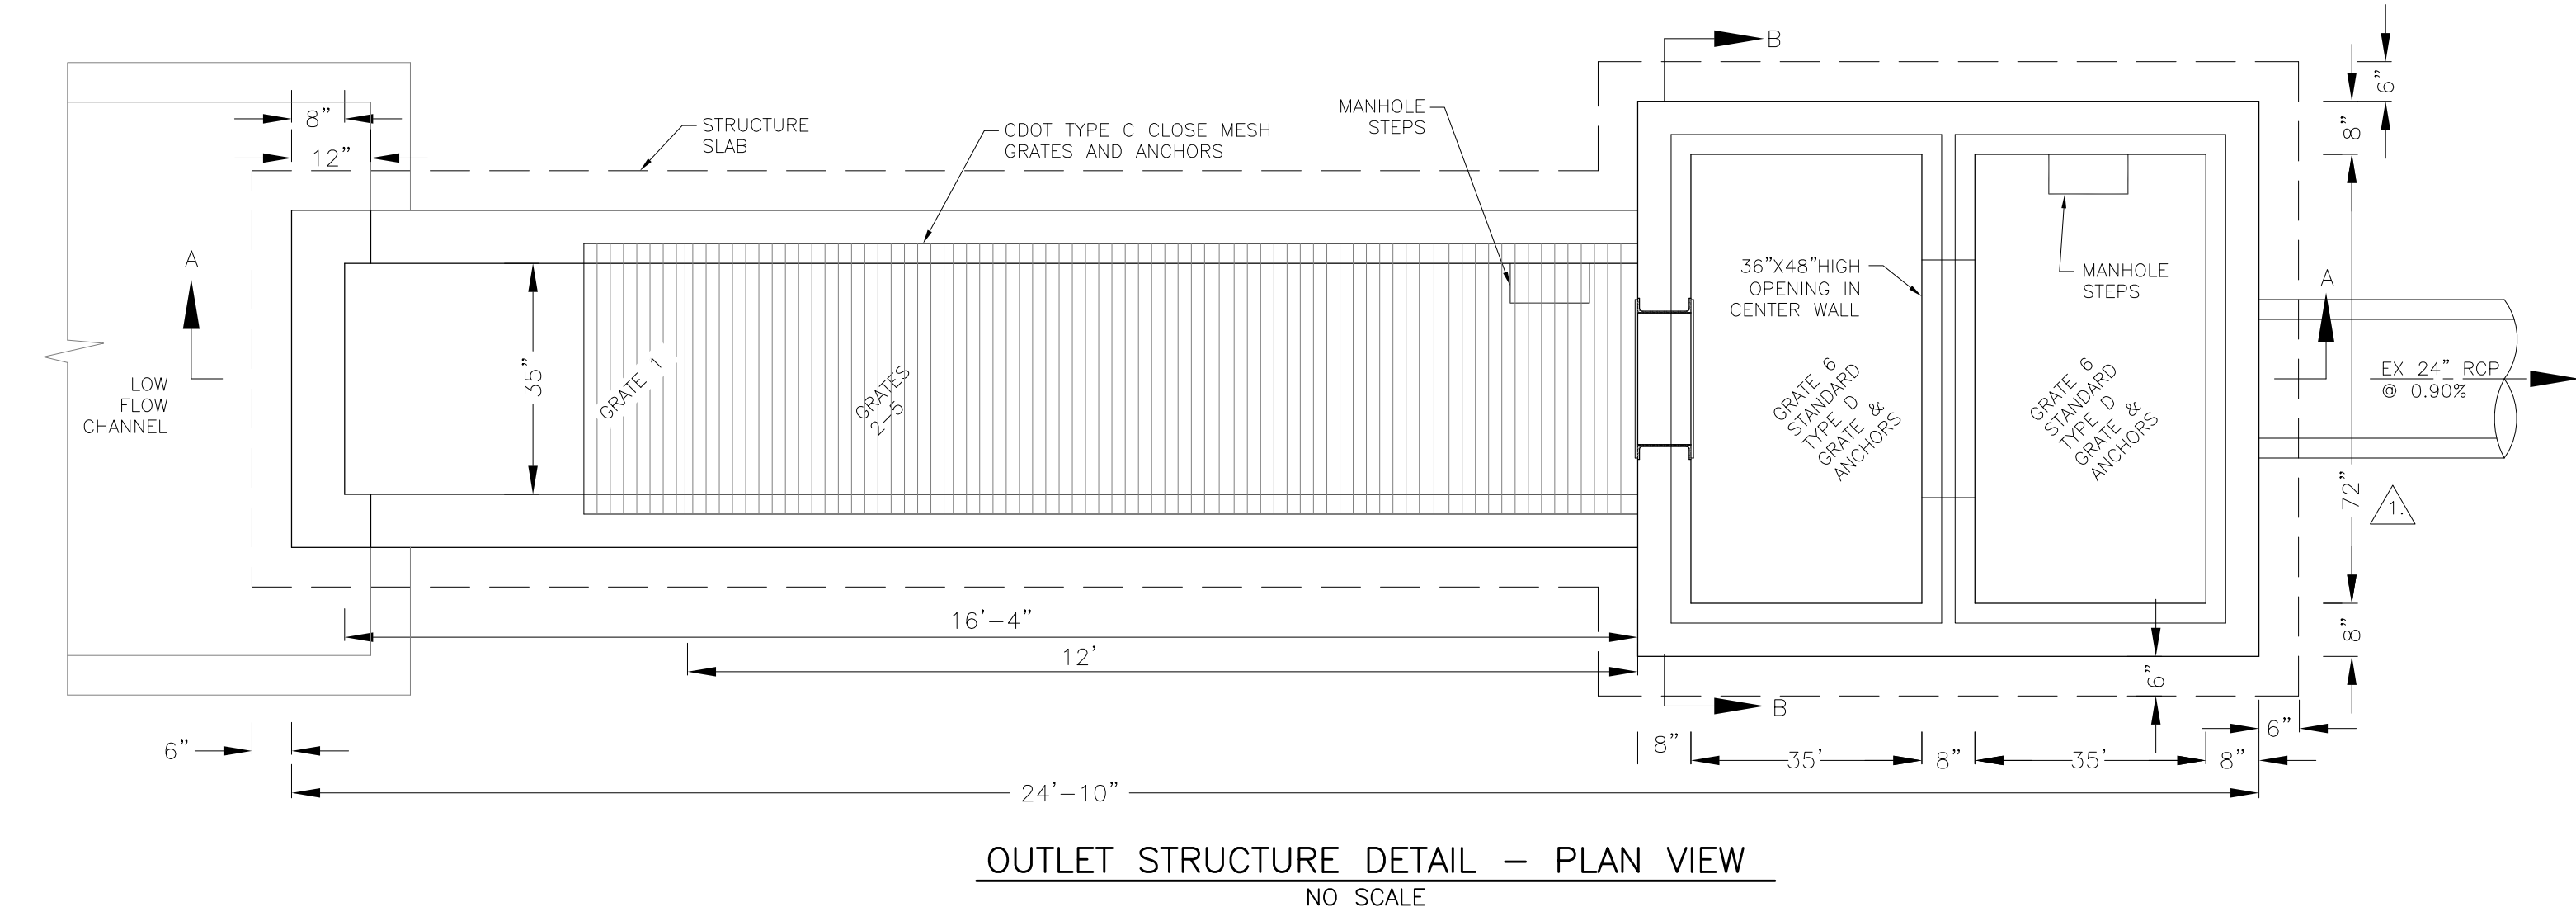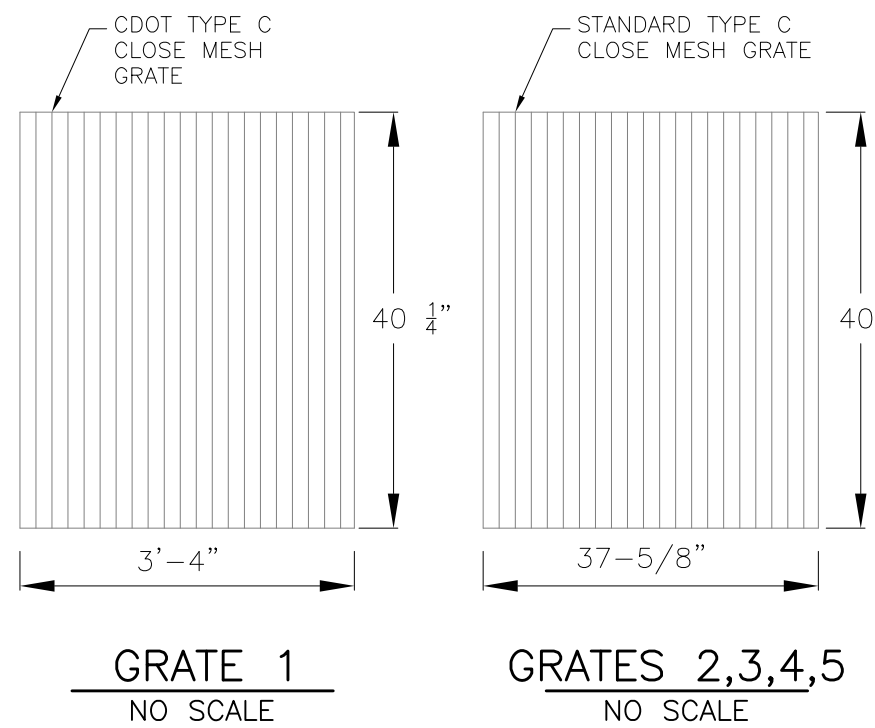


OUTLET STRUCTURE, FOREBAY, AND DRAIN CHANNEL NOTES:

- PRIOR TO CONSTRUCTION, CONTRACTOR SHALL PROVIDE SHOP DRAWINGS FOR ALL COMPONENTS OF THE OUTLET STRUCTURE.
- GRADE 60 REINFORCING STEEL REQUIRED. SEE TABLE FOR THE MINIMUM LAP SPLICE LENGTH FOR REINFORCING BARS. ALL REINFORCING STEEL SHALL HAVE A TWO-INCH MINIMUM CLEARANCE FROM EDGE OF CONCRETE, UNLESS OTHERWISE NOTED.
- CONCRETE FOR THE OUTLET STRUCTURE AND FOREBAY SHALL BE CDOT CLASS D CONCRETE.
- CONCRETE FOR DRAIN CHANNELS SHALL BE CDOT CLASS B CONCRETE
- EXPANSION JOINT MATERIAL SHALL MEET AASHTO SPECIFICATION M-213. EXPANSION JOINT MATERIAL SHALL BE 1/2" THICK, SHALL EXTEND THE FULL DEPTH OF CONTACT SURFACE AND THE JOINT SHALL BE SEALED, REFER TO DETAILS.
- ALL EXPOSED CONCRETE CORNERS SHALL HAVE A 3/8" CHAMFER UNLESS OTHERWISE NOTED.
- SUBGRADE TO BE 12" THICK CLEAN FILL COMPACTED TO 95% STANDARD PROCTOR DENSITY PER ASTM M698 UNDER STRUCTURE.
- REFER TO POND DETAILS FOR PRESEDIMENTATION/FOREBAY DESIGN.
- ENGINEER SHALL BE NOTIFIED PRIOR TO BEGINNING CONSTRUCTION OF OUTLET STRUCTURE TO SCHEDULE OBSERVATION VISITS FOR STRUCTURES.

WQCV WELL-SCREEN NOTES:

- Well-Screen shall be stainless steel and attached by stainless steel bolts along edge of the mounting frame.
- WQCV Well Screen
 - Type of Screen: Stainless steel #93 Vee Wire (Johnson Vee Wire (tm) Stainless Steel Screen or equivalent with 60% open area)
 - Screen slot opening dimension: 0.139" (Screen #93 Vee Wire Slot Opening)
 - Type and Size of Support Rod: TE 0.074"x0.50"
 - Spacing of Support Rod (O.C.): 1.0 Inch
 - Total Screen Thickness: 0.655"
 - Carbon Steel Holding Frame Type: 3/4" x 1.0" angle

AS-BUILT
DATE: 09/30/2022

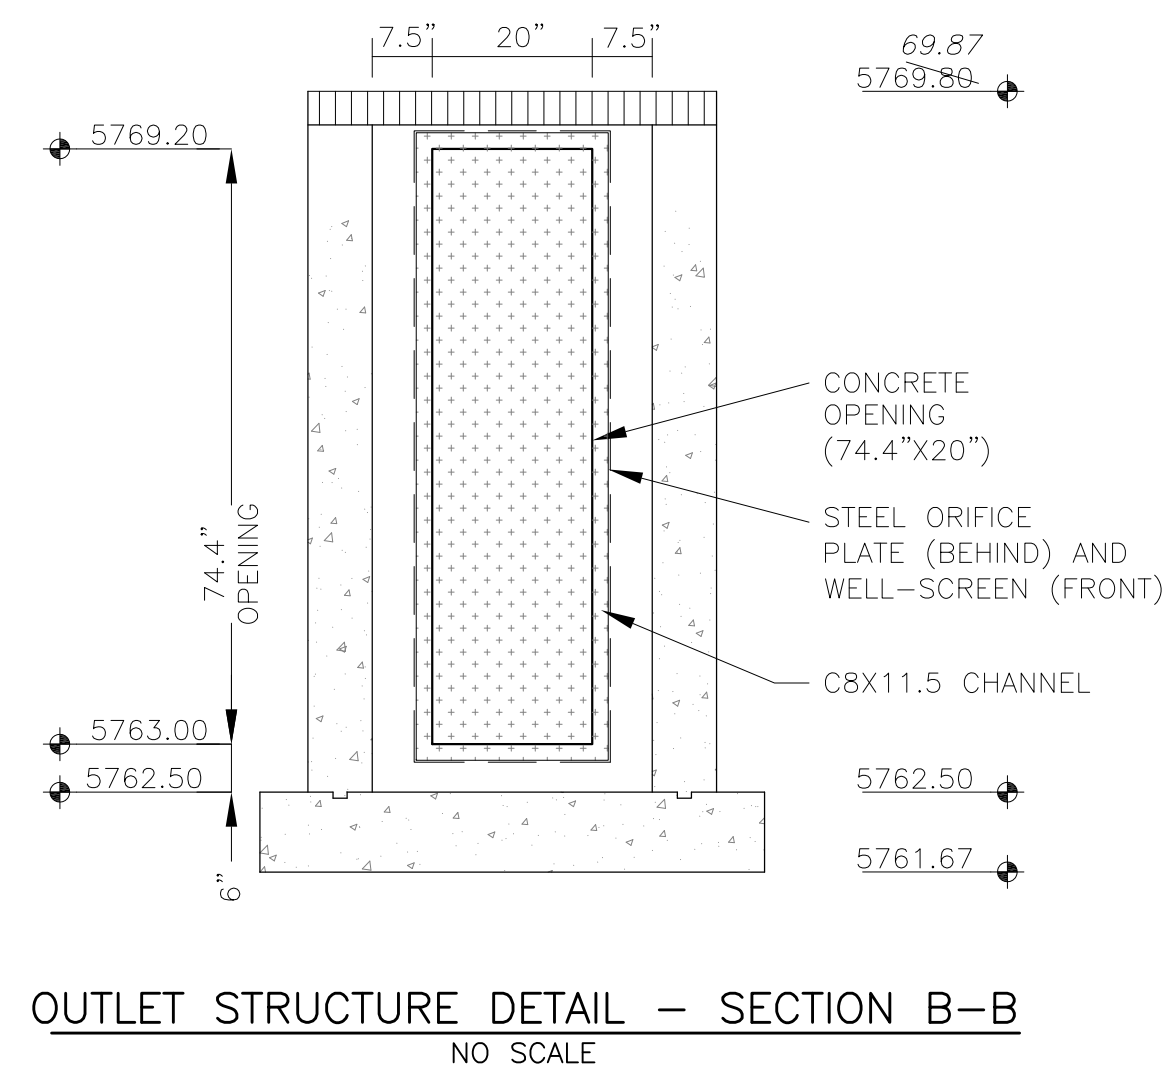


CORE
ENGINEERING GROUP
15004 1ST AVENUE S.
BURNING WOOD, CO 80903
CONTACT: RICHARD L. SCHINDLER, P.E.
EMAIL: Rich@ceg.com

DATE: 3/10/2022
DESCRIPTION: STRUCTURE WIDTH REVISED TO 72"
NO. 1:
PROJECT: THE RIDGE AT LORSON RANCH
PREPARED FOR: LORSON, LLC
212 N. WAHSATCH AVE. SUITE 301
COLORADO SPRINGS, COLORADO 80903
CONTACT: JEFF MARK

DRAWN: RLS
DESIGNED: RLS
CHECKED: RLS

POND C4
FULL SPECTRUM
OUTLET STRUCTURE DETAILS

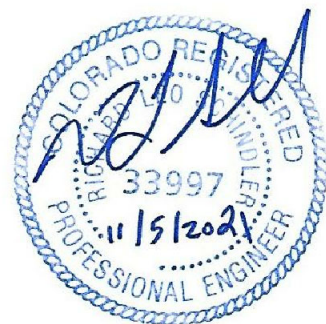

DATE: NOV 5, 2021
PROJECT NO. 100.064
SHEET NUMBER **C9.5**
TOTAL SHEETS: 23