

INDEX MAP

N.T.S.

LEGAL DESCRIPTION:

KNOW ALL MEN BY THESE PRESENTS: THAT GTL, INC. DBA GTL DEVELOPMENT, INC., THEODORE TOHANG, PRESIDENT AND MERIDIAN SERVICE METROPOLITAN DISTRICT BEING THE OWNERS OF THE FOLLOWING DESCRIBED TRACT OF LAND:

A PARCEL OF LAND LOCATED IN A PORTIONS OF SECTION 29, 30, AND 32, IN TOWNSHIP 12 SOUTH, RANGE 64 WEST OF THE 6TH PRINCIPAL MERIDIAN, INCLUDING ALL OF TRACT F OF THE METROPOLITAN DISTRICT, RECORDED WITH RECEPTION NO. 208712913 IN THE RECORDS OF EL PASO COUNTY, COLORADO, MORE PARTICULARLY DESCRIBED AS FOLLOWS:

BEGINNING AT A POINT ON THE SOUTHERN MOST CORNER OF TRACT D OF STONEBRIDGE FILING NO. 1 AT MERIDIAN RANCH, RECORDED WITH RECEPTION NO. 215713582 IN THE RECORDS OF EL PASO COUNTY;

THE FOLLOWING COURSE IS ON SAID SOUTHERLY LINE OF TRACT D:

- 1. THENCE N76°25'11"E A DISTANCE OF 375.00 FEET;
2. THENCE S78°55'18"E A DISTANCE OF 200.00 FEET;
3. THENCE S38°44'01"E A DISTANCE OF 300.00 FEET;
...
20. THENCE N31°45'35"W A DISTANCE OF 134.54 FEET TO A POINT ON THE BOUNDARY OF SAID STONEBRIDGE FILING NO. 1 AT MERIDIAN RANCH;

THE FOLLOWING THREE(3) COURSES ARE ON SAID BOUNDARY LINE:

- 21. THENCE N56°12'41"E A DISTANCE OF 25.16' TO A NON-TANGENT CURVE TO THE RIGHT;
22. THENCE ON THE ARC OF SAID CURVE, HAVING A RADIUS OF 1030.00 FEET, A DELTA ANGLE OF 1°44'31", AN ARC LENGTH OF 264.61 FEET, WHOSE LONG CHORD BEARS N16°55'44"W A DISTANCE OF 263.88 FEET;
...
23. THENCE N80°25'51"E A DISTANCE OF 60.00 FEET TO A POINT ON THE BOUNDARY OF STONEBRIDGE FILING NO. 3 AT MERIDIAN RANCH, RECORDED WITH RECEPTION NO. 217714053 IN THE RECORDS OF EL PASO COUNTY AND A NON-TANGENT CURVE TO THE LEFT;

THE FOLLOWING TWO(2) COURSES ARE ON SAID BOUNDARY LINE:

- 24. THENCE ON THE ARC OF SAID CURVE, HAVING A RADIUS OF 970.00 FEET, A DELTA ANGLE OF 1°31'45", AN ARC LENGTH OF 195.19 FEET, WHOSE LONG CHORD BEARS S15°20'02"E A DISTANCE OF 194.86 FEET;
25. THENCE S66°06'02"W A DISTANCE OF 30.00 FEET;
26. THENCE S31°38'39"E A DISTANCE OF 206.41 FEET;
...
56. THENCE N79°31'05"E A DISTANCE OF 28.00 FEET TO A CURVE TO THE LEFT;
57. THENCE ON THE ARC OF SAID CURVE, HAVING A RADIUS OF 1540.00 FEET, A DELTA ANGLE OF 2°22'50", AN ARC LENGTH OF 602.55 FEET, WHOSE LONG CHORD BEARS N68°18'33"E A DISTANCE OF 598.71 FEET TO A POINT ON THE SOUTHERN BOUNDARY OF THE VISTAS FILING NO. 1 AT MERIDIAN RANCH, RECORDED WITH RECEPTION NO. 217713953 IN THE RECORDS OF EL PASO COUNTY;

THE FOLLOWING NINE(9) COURSES ARE ON SAID BOUNDARY LINE:

- 58. THENCE S32°53'59"E A DISTANCE OF 20.55 FEET;
59. THENCE S35°51'09"E A DISTANCE OF 223.61 FEET;
60. THENCE S35°48'46"E A DISTANCE OF 205.06 FEET;
...
67. THENCE S38°44'41"W ALONG SAID EASTONVILLE RIGHT-OF-WAY A DISTANCE OF 408.79 FEET;
68. THENCE N89°23'27"W A DISTANCE OF 12.73 FEET TO THE NORTHEAST CORNER OF SAID TRACT F;

THE FOLLOWING SIX(6) COURSES ARE ON SAID TRACT LINE:

- 69. THENCE S38°47'27"W A DISTANCE OF 315.49 FEET;
70. THENCE N51°12'33"W A DISTANCE OF 21.28 FEET;
71. THENCE S38°47'27"W A DISTANCE OF 1.03 FEET;
72. THENCE S80°17'18"W A DISTANCE OF 55.16 FEET TO A POINT ON THE NORTHERLY RIGHT-OF-WAY LINE OF STAPLETON DRIVE;

THE FOLLOWING NINE(9) COURSES ARE ON SAID NORTHERLY RIGHT-OF-WAY LINE:

- 73. THENCE N54°42'42"W ON SAID NORTHERLY RIGHT-OF-WAY A DISTANCE OF 113.89 FEET TO A CURVE TO THE LEFT;
74. THENCE ON THE ARC OF SAID CURVE, HAVING A RADIUS OF 1415.00 FEET, A DELTA ANGLE OF 16°26'49", AN ARC LENGTH OF 406.18 FEET, WHOSE LONG CHORD BEARS N62°55'59"W A DISTANCE OF 404.78 FEET;
...
83. THENCE N36°20'59"W ON SAID TRACT LINE A DISTANCE OF 1691.39 FEET TO THE POINT OF BEGINNING.

THE ABOVE PARCEL OF LAND CONTAINS 113.911 ACRES, MORE OR LESS.

WINDINGWALK FILING No. 1 AT MERIDIAN RANCH A PARCEL OF LAND LOCATED IN A PORTION OF SECTION 29, 30, AND 32 IN TOWNSHIP 12 SOUTH, RANGE 64 WEST OF THE 6TH PRINCIPAL MERIDIAN EL PASO COUNTY, COLORADO.

NOTES:

- 1) BASIS OF BEARINGS FOR THIS DESCRIPTION IS THE NORTH LINE OF THE NORTHWEST QUARTER OF SECTION 19, T12S, R64W OF THE 6TH P.M., WHICH IS ASSUMED TO BEAR S89°18'12"E FROM THE NORTHWEST CORNER OF SECTION 19 ((2) REFERENCE MONUMENTS PLS 24964) TO THE NORTH QUARTER CORNER OF SECTION 19 (3.25" ALUM. CAP PLS 24964).
2) THERE SHALL BE NO VEHICULAR ACCESS FROM ANY RESIDENTIAL LOT IN THIS SUBDIVISION TO LAMBERT ROAD, STAPLETON DRIVE, OR RAINBOW BRIDGE DRIVE.
...
24) THIS SUBDIVISION IS INCLUDED WITHIN THE BOUNDARIES OF THE WOODMEN ROAD METROPOLITAN DISTRICT AND SHALL NOT BE REQUIRED TO PARTICIPATE IN THE EL PASO COUNTY ROAD IMPACT FEE PROGRAM, IN ACCORDANCE WITH THE PROVISIONS OF THE FIRST AMENDMENT TO THE INTERGOVERNMENTAL AGREEMENT CONCERNING WOODMEN ROAD ADOPTED PURSUANT TO RESOLUTION NO. 13--041.

FY: this is anticipated to be amended in 2020 where all may be subject to the TIF

26) FLOOD PLANS: WINDINGWALK FILING NO. 1 AT MERIDIAN RANCH, A PARCEL OF LAND LOCATED IN A PORTION OF SECTION 29, 30, AND 32 IN TOWNSHIP 12 SOUTH, RANGE 64 WEST OF THE 6TH PRINCIPAL MERIDIAN, EL PASO COUNTY, COLORADO, IS SHOWN WITHIN AN AREAS OF SPECIAL FLOOD HAZARD ZONE BASED ON LOMR CASE NO. 14-08-1121P, EFFECTIVE DATE MARCH 24, 2015 WHICH IS A REVISION TO THE FLOOD HAZARDS DEPICTED ON F.E.M.A. FIRM MAP 08041C0575-F DATED MARCH 17, 1997.
26) LOTS 1-345 ACREAGE: 61.833
TRACTS A-K ACREAGE: 27.009
STREETS ACREAGE: 25.069
TOTAL ACREAGE: 113.911

PLAT NO. \_\_\_\_\_

DEDICATION:

THE ABOVE OWNER(S) HAVING CAUSED SAID TRACT OF LAND TO BE PLATTED INTO LOTS, TRACTS, STREETS AND EASEMENTS AS SHOWN ON THE PLAT, WHICH SUBDIVISION SHALL BE ENTITLED "WINDINGWALK FILING NO. 1 AT MERIDIAN RANCH", A SUBDIVISION IN EL PASO COUNTY, COLORADO. ALL STREETS PLATTED ARE HEREBY DEDICATED TO PUBLIC USE AND SAID OWNER DOES HEREBY AGREE THAT ALL PLATTED STREETS WILL BE CONSTRUCTED AND PROPER DRAINAGE PROVIDED AT THE OWNER'S EXPENSE AND ALL TO THE SATISFACTION OF THE BOARD OF COUNTY COMMISSIONERS OF EL PASO COUNTY, COLORADO UPON ACCEPTANCE BY RESOLUTION. ALL STREETS SO DEDICATED WILL BECOME MATTERS OF MAINTENANCE BY EL PASO COUNTY, COLORADO WITH THE EXCEPTION OF MEDIANS WHICH WILL BE MAINTAINED BY THE MERIDIAN SERVICE METROPOLITAN DISTRICT.

IN WITNESS WHEREOF: GTL, INC. DBA GTL DEVELOPMENT, INC., RAUL GUZMAN, VICE PRESIDENT HAS CAUSED THESE PRESENTS TO BE EXECUTED THIS \_\_\_\_ DAY OF \_\_\_\_\_, 20\_\_

GTL, INC., DBA GTL DEVELOPMENT, INC.

BY: RAUL GUZMAN, VICE PRESIDENT

STATE OF COLORADO )
COUNTY OF EL PASO ) SS

THIS INSTRUMENT WAS ACKNOWLEDGED BEFORE ME THIS \_\_\_\_ DAY OF \_\_\_\_\_, 20\_\_, BY RAUL GUZMAN, VICE PRESIDENT, GTL, INC. DBA GTL DEVELOPMENT, INC.

NOTARY PUBLIC \_\_\_\_\_ ADDRESS \_\_\_\_\_
MY COMMISSION EXPIRES: \_\_\_\_\_

MERIDIAN SERVICE METROPOLITAN DISTRICT

BY: MILTON GABRIELSKI, PRESIDENT

STATE OF COLORADO )
COUNTY OF EL PASO ) SS

THIS INSTRUMENT WAS ACKNOWLEDGED BEFORE ME THIS \_\_\_\_ DAY OF \_\_\_\_\_, 20\_\_, BY MILTON GABRIELSKI, MERIDIAN SERVICE METROPOLITAN DISTRICT.


NOTARY PUBLIC \_\_\_\_\_ ADDRESS \_\_\_\_\_
MY COMMISSION EXPIRES: \_\_\_\_\_

SURVEYOR'S CERTIFICATION:

THE UNDERSIGNED PROFESSIONAL LAND SURVEYOR IN THE STATE OF COLORADO HEREBY STATES THAT THE ACCOMPANYING PLAT WAS SURVEYED AND DRAWN TO NORMAL STANDARDS AND CARE OF A PROFESSIONAL LAND SURVEYOR PRACTICING IN THE STATE OF COLORADO. THE SURVEY WAS PERFORMED AND PLAT PREPARED UNDER HIS SUPERVISION AND ACCURATELY SHOWS THE DESCRIBED TRACT OF LAND AND SUBDIVISION THEREOF, AND THE REQUIREMENTS OF TITLE 38 OF THE COLORADO REVISED STATUTES, 1973, AS AMENDED, HAVE BEEN MET TO THE BEST OF HIS KNOWLEDGE, INFORMATION AND BELIEF.

JAMES F. LENZ
PROFESSIONAL LAND SURVEYOR IN THE STATE OF COLORADO, PLS NO. 34583

NOTICE: ACCORDING TO COLORADO LAW, YOU MUST COMMENCE ANY LEGAL ACTION BASED UPON ANY DEFECT IN THIS SURVEY WITHIN THREE YEARS AFTER YOU FIRST DISCOVER SUCH DEFECT. IN NO EVENT, MAY ANY ACTION BASED UPON ANY DEFECT IN THIS SURVEY BE COMMENCED MORE THAN TEN YEARS FROM THE DATE OF CERTIFICATION SHOWN HEREON.

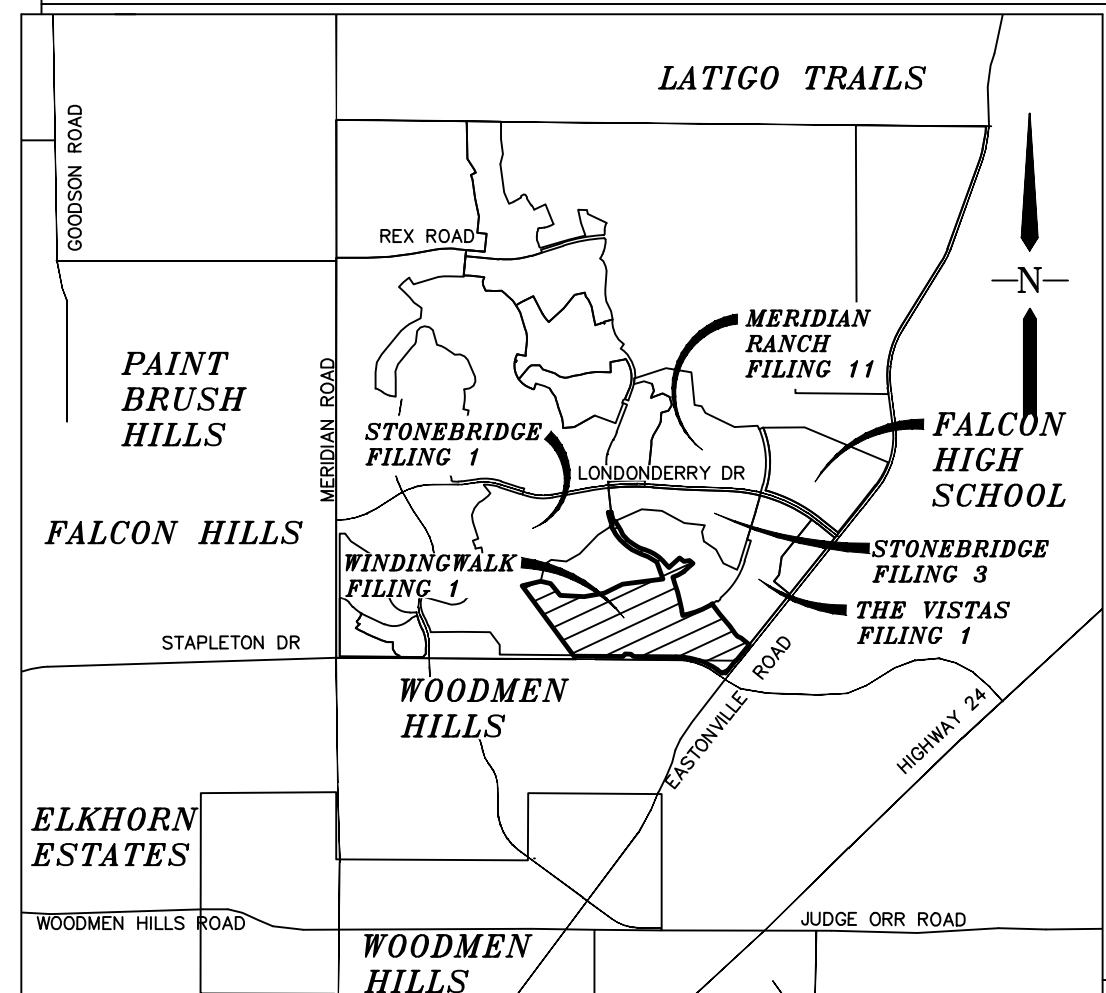

VICINITY MAP

N.T.S.

APPROVALS:

THE ACCOMPANYING PLAT OF "WINDINGWALK FILING NO. 1 AT MERIDIAN RANCH", EL PASO COUNTY, COLORADO, WAS APPROVED FOR FILING THIS \_\_\_\_ DAY OF \_\_\_\_\_, 20\_\_

DIRECTOR OF PLANNING AND COMMUNITY DEVELOPMENT
APPROVED BY THE BOARD OF COUNTY COMMISSIONERS OF EL PASO COUNTY, COLORADO, THIS \_\_\_\_ DAY OF \_\_\_\_\_, 20\_\_
EL PASO COUNTY CLERK AND RECORDER

APPROVED BY THE PRESIDENT, BOARD OF COUNTY COMMISSIONERS OF EL PASO COUNTY, COLORADO, THIS \_\_\_\_ DAY OF \_\_\_\_\_, 20\_\_

STATE OF COLORADO )
COUNTY OF EL PASO ) SS

I HEREBY CERTIFY THIS INSTRUMENT WAS FILED FOR RECORD IN MY OFFICE AT O'CLOCK \_\_\_\_ M., THIS \_\_\_\_ DAY OF \_\_\_\_\_, 20\_\_, AND IS DULY RECORDED AT RECEPTION NUMBER \_\_\_\_\_ OF THE RECORDS OF EL PASO COUNTY, COLORADO.

FEE: \_\_\_\_\_ BY: \_\_\_\_\_
DEPUTY

FEES:

- RECEIPT NO: \_\_\_\_\_
PLAT FEE: \_\_\_\_\_
SURCHARGE: \_\_\_\_\_
SCHOOL: \_\_\_\_\_
PARK: \_\_\_\_\_
BRIDGE: \_\_\_\_\_
DRAINAGE: \_\_\_\_\_

PCD File # SF-18-002

Table with 2 columns: DRAWN BY: LCG, CHECKED BY: TAK; DATE: DECEMBER 2017, SHEET: 1 OF 9



# WINDINGWALK FILING No. 1 AT MERIDIAN RANCH

A PARCEL OF LAND LOCATED IN A PORTION OF SECTION 29, 30, AND 32 IN TOWNSHIP 12 SOUTH,  
RANGE 64 WEST OF THE 6TH PRINCIPAL MERIDIAN

## EL PASO COUNTY, COLORADO.

STONEBRIDGE  
FILING NO. 1  
AT MERIDIAN RANCH  
RECEPTION NO.  
21517358  
(NOT A PART)


TRACT D  
(NOT A PART)

TRACT A  
8,504 ACRES

TRACT A  
8,504 ACRES

TRACT G  
(NOT A PART)


STONEBRIDGE  
FILING NO. 1  
AT MERIDIAN RANCH  
RECEPTION NO.  
21517358  
(NOT A PART)

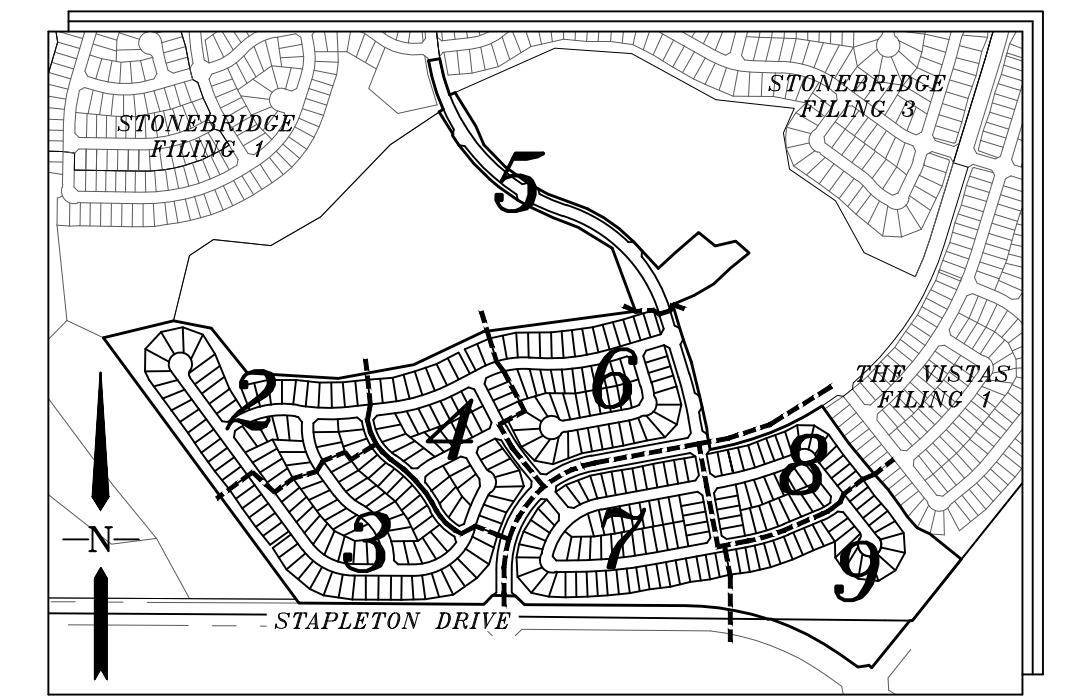

INDEX MAP  
N.T.S.



- LEGEND**
- = FOUND MONUMENT AS SHOWN
  - = FOUND #4 REBAR WITH CAP PLS 34583
  - = SET #4 REBAR W/CAP PLS 34583
  - NR = NON-RADIAL BEARING
  - (82.62) = EASEMENT OR NO-BUILD DIM.
  - (12345) = ADDRESS
  - - - = MATCHLINE

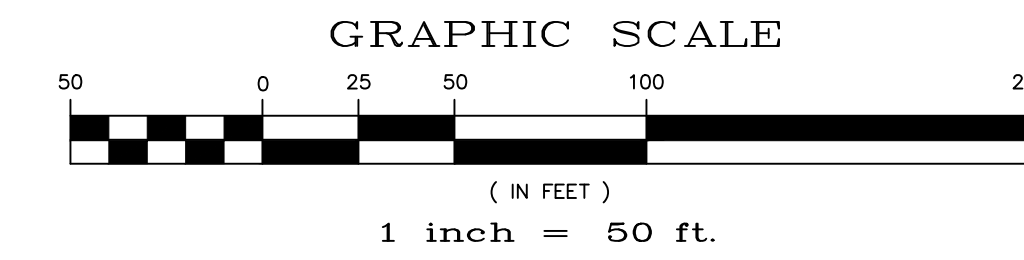

Label the road classification


Per ECM 2.3.F.3, a minimum tangent of 200 ft is required to separate all broken back curves. Revise or submit a deviation request.



# WINDINGWALK FILING No. 1 AT MERIDIAN RANCH


A PARCEL OF LAND LOCATED IN A PORTION OF SECTION 29, 30, AND 32 IN TOWNSHIP 12 SOUTH,  
RANGE 64 WEST OF THE 6TH PRINCIPAL MERIDIAN

## EL PASO COUNTY, COLORADO.

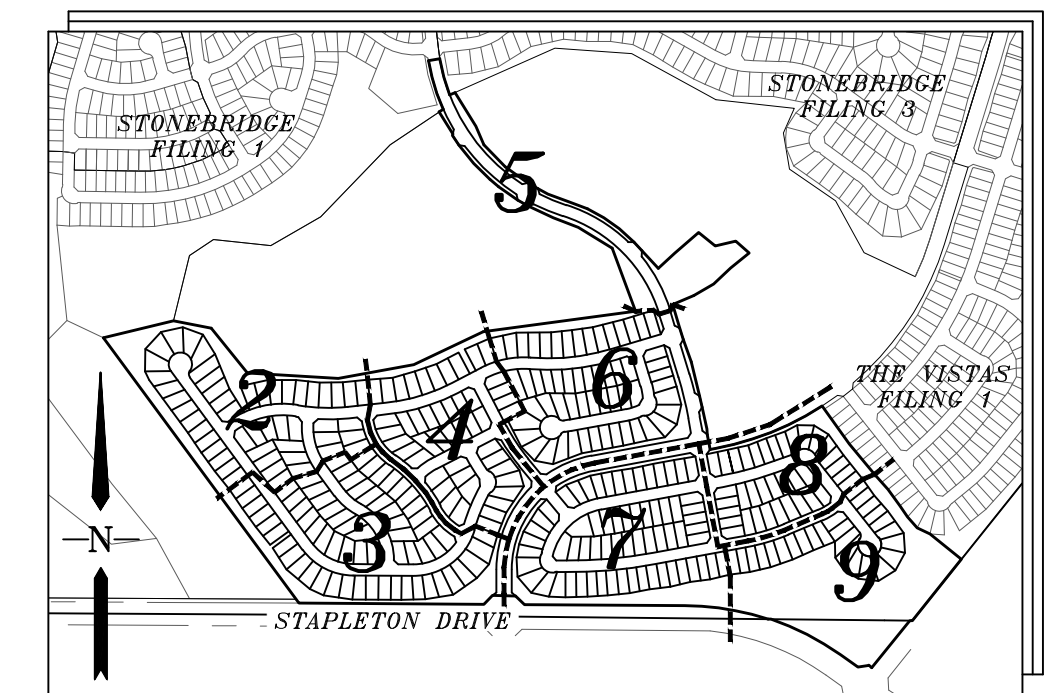

INDEX MAP  
N.T.S.

- LEGEND**
- = FOUND MONUMENT AS SHOWN
  - ⊙ = FOUND #4 REBAR WITH CAP PLS 34583
  - = SET #4 REBAR W/CAP PLS 34583
  - NR = NON-RADIAL BEARING
  - (82.62') = EASEMENT OR NO-BUILD DIM.
  - (12345) = ADDRESS
  - - - = MATCHLINE

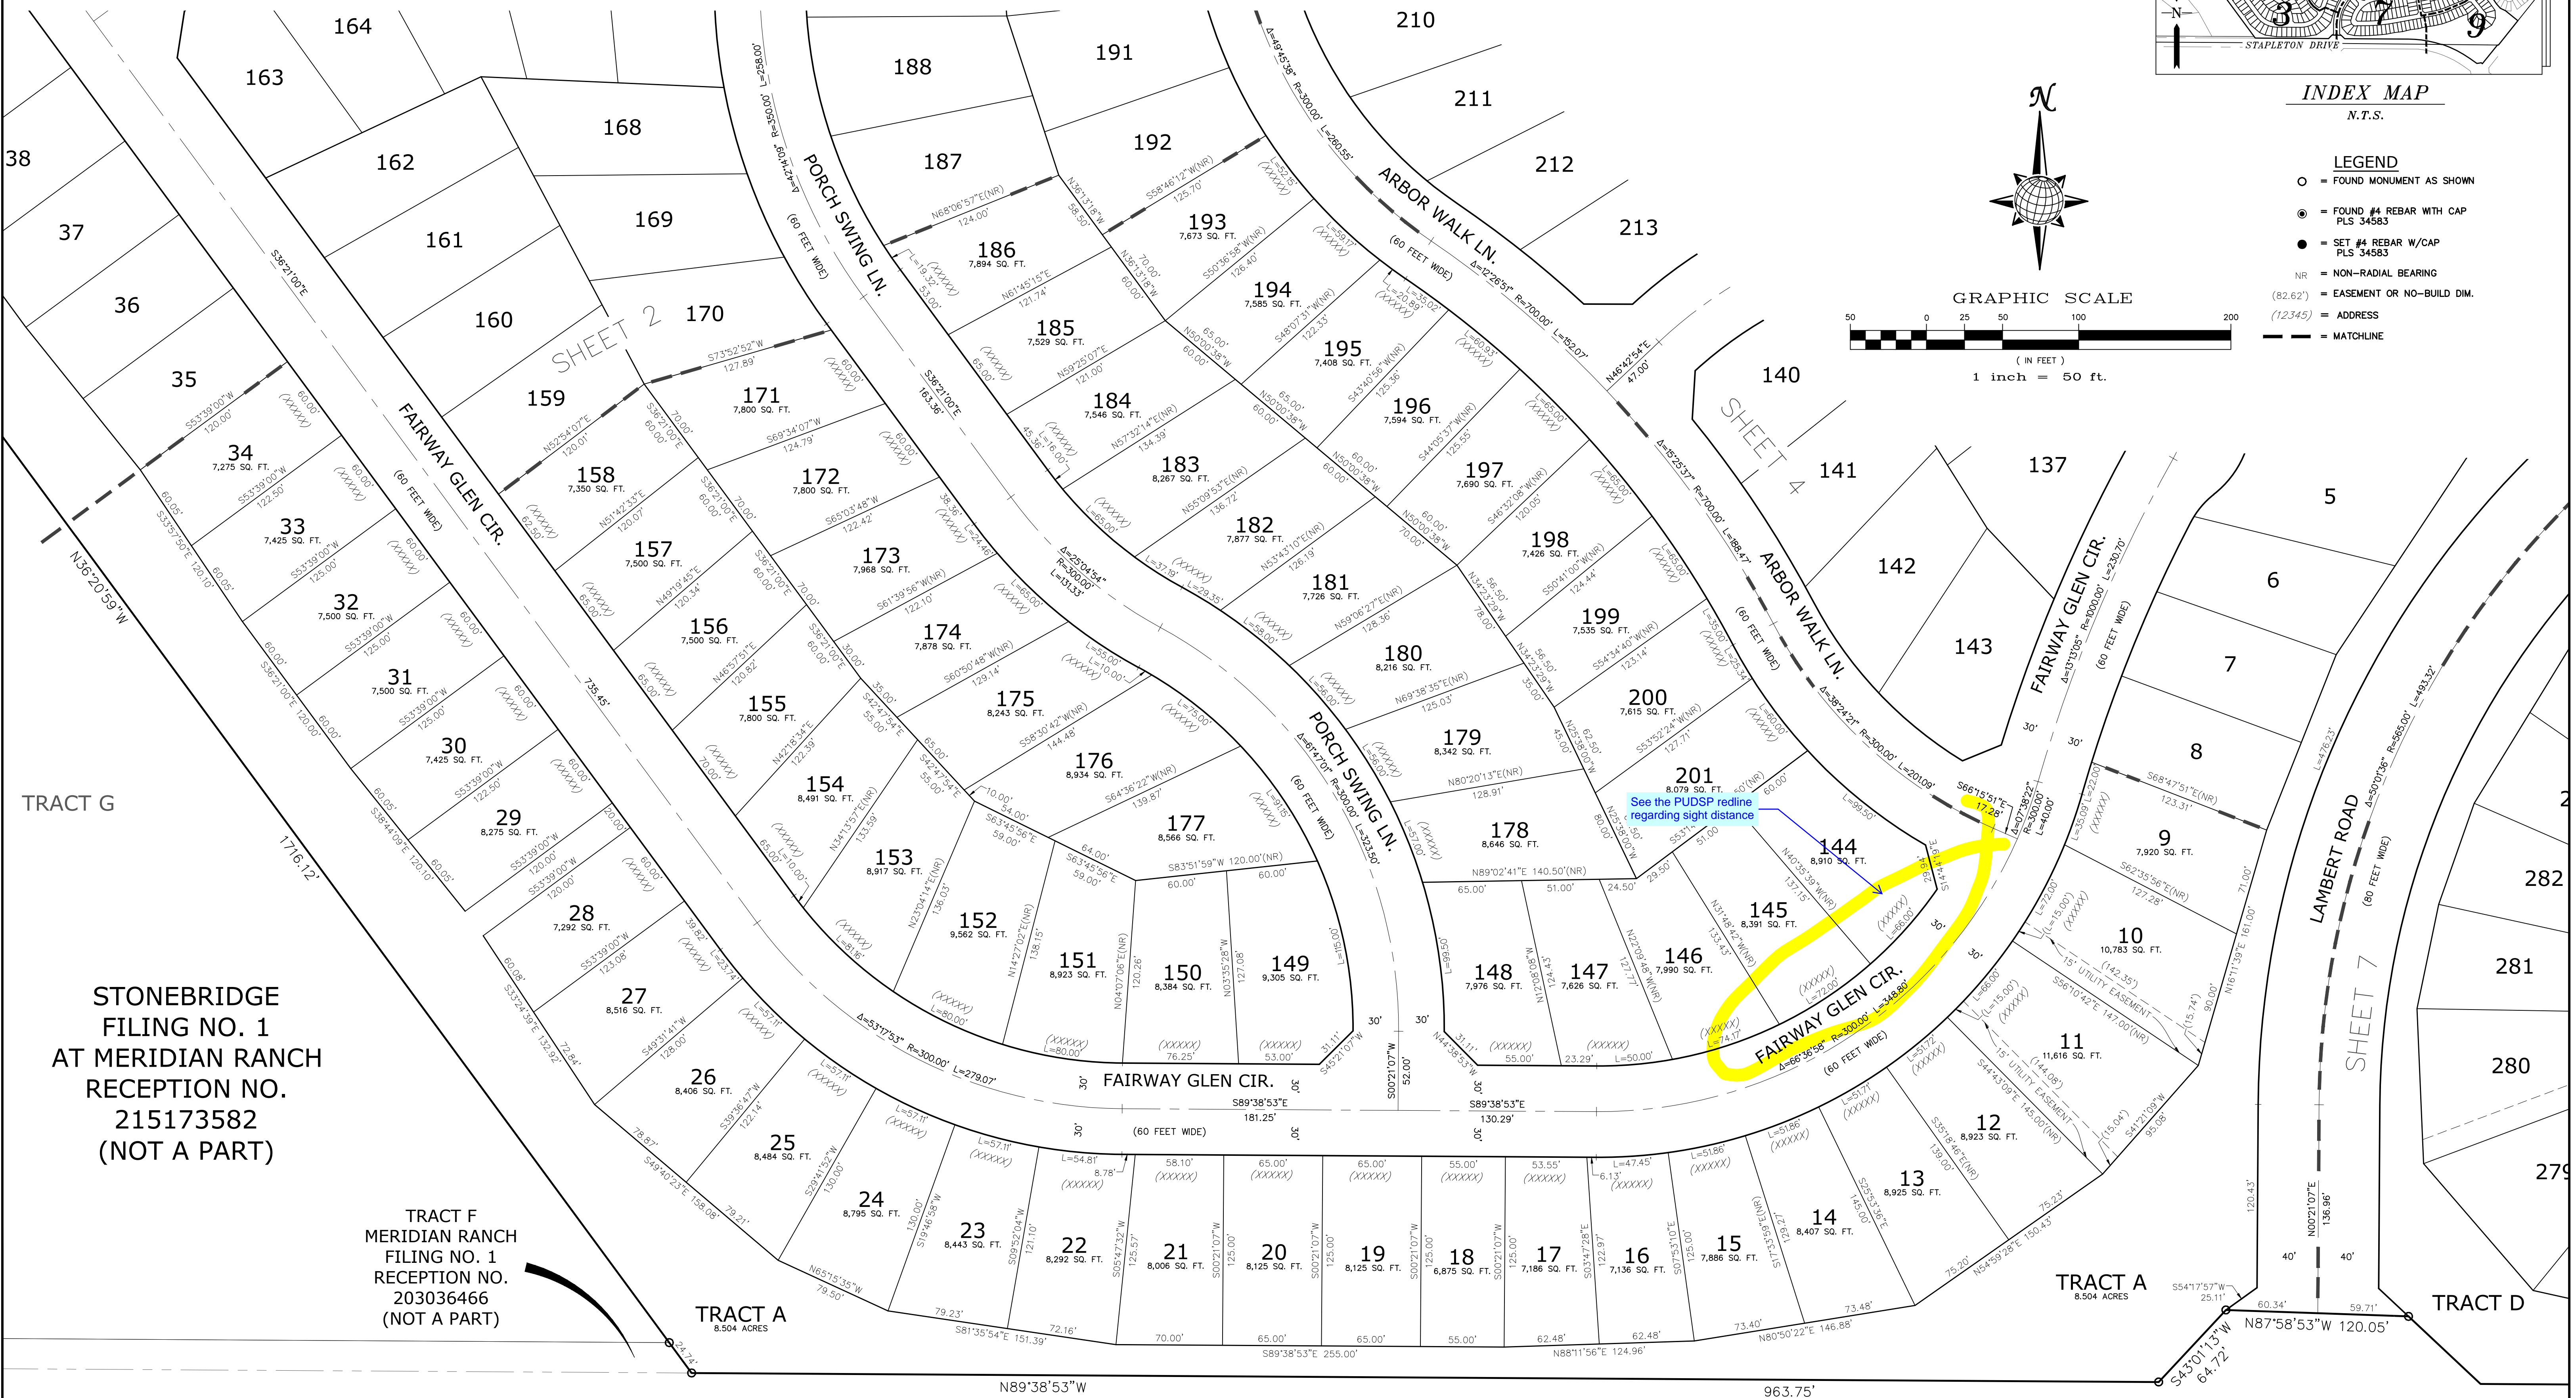

STONEBRIDGE FILING NO. 1 AT MERIDIAN RANCH RECEPTION NO. 215173582 (NOT A PART)

TRACT F MERIDIAN RANCH FILING NO. 1 RECEPTION NO. 203036466 (NOT A PART)

TRACT A 8.504 ACRES

TRACT A 8.504 ACRES

TRACT D

STAPLETON DRIVE (EXISTING ROW 120' WIDE)


SEC. 30  
SEC. 31

SEC. 29  
SEC. 32






# WINDINGWALK FILING No. 1 AT MERIDIAN RANCH

A PARCEL OF LAND LOCATED IN A PORTION OF SECTION 29, 30, AND 32 IN TOWNSHIP 12 SOUTH,  
RANGE 64 WEST OF THE 6TH PRINCIPAL MERIDIAN  
EL PASO COUNTY, COLORADO.

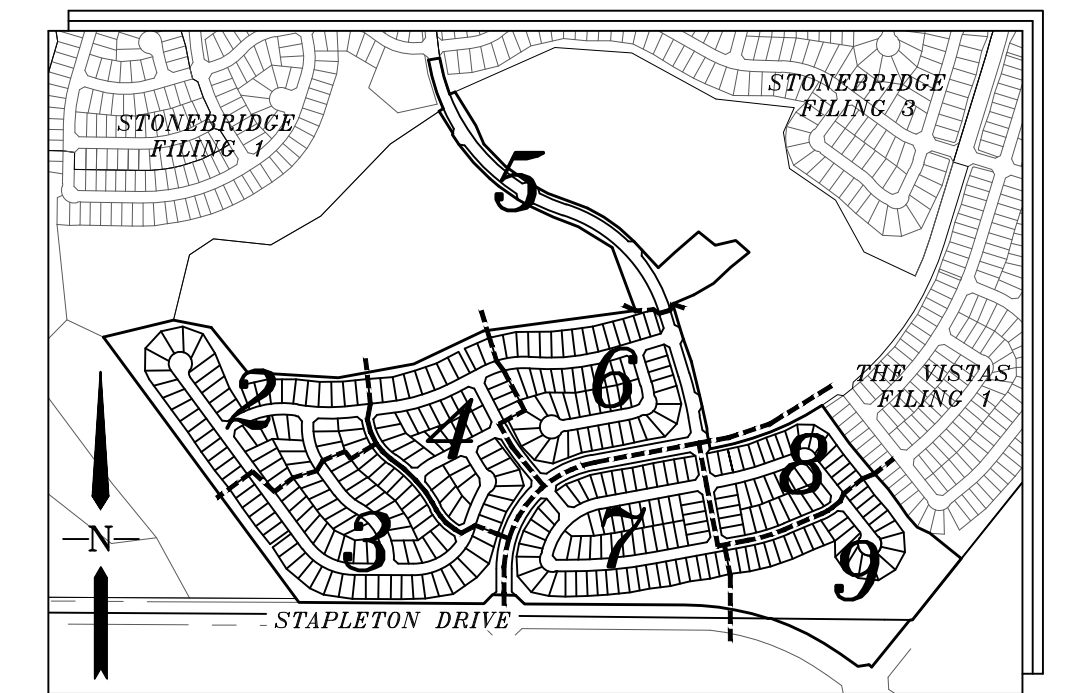

INDEX MAP  
N.T.S.


- LEGEND**
- = FOUND MONUMENT AS SHOWN
  - ⊙ = FOUND #4 REBAR WITH CAP PLS 34583
  - = SET #4 REBAR W/CAP PLS 34583
  - NR = NON-RADIAL BEARING
  - (82.62°) = EASEMENT OR NO-BUILD DIM.
  - (12345) = ADDRESS
  - = MATCHLINE

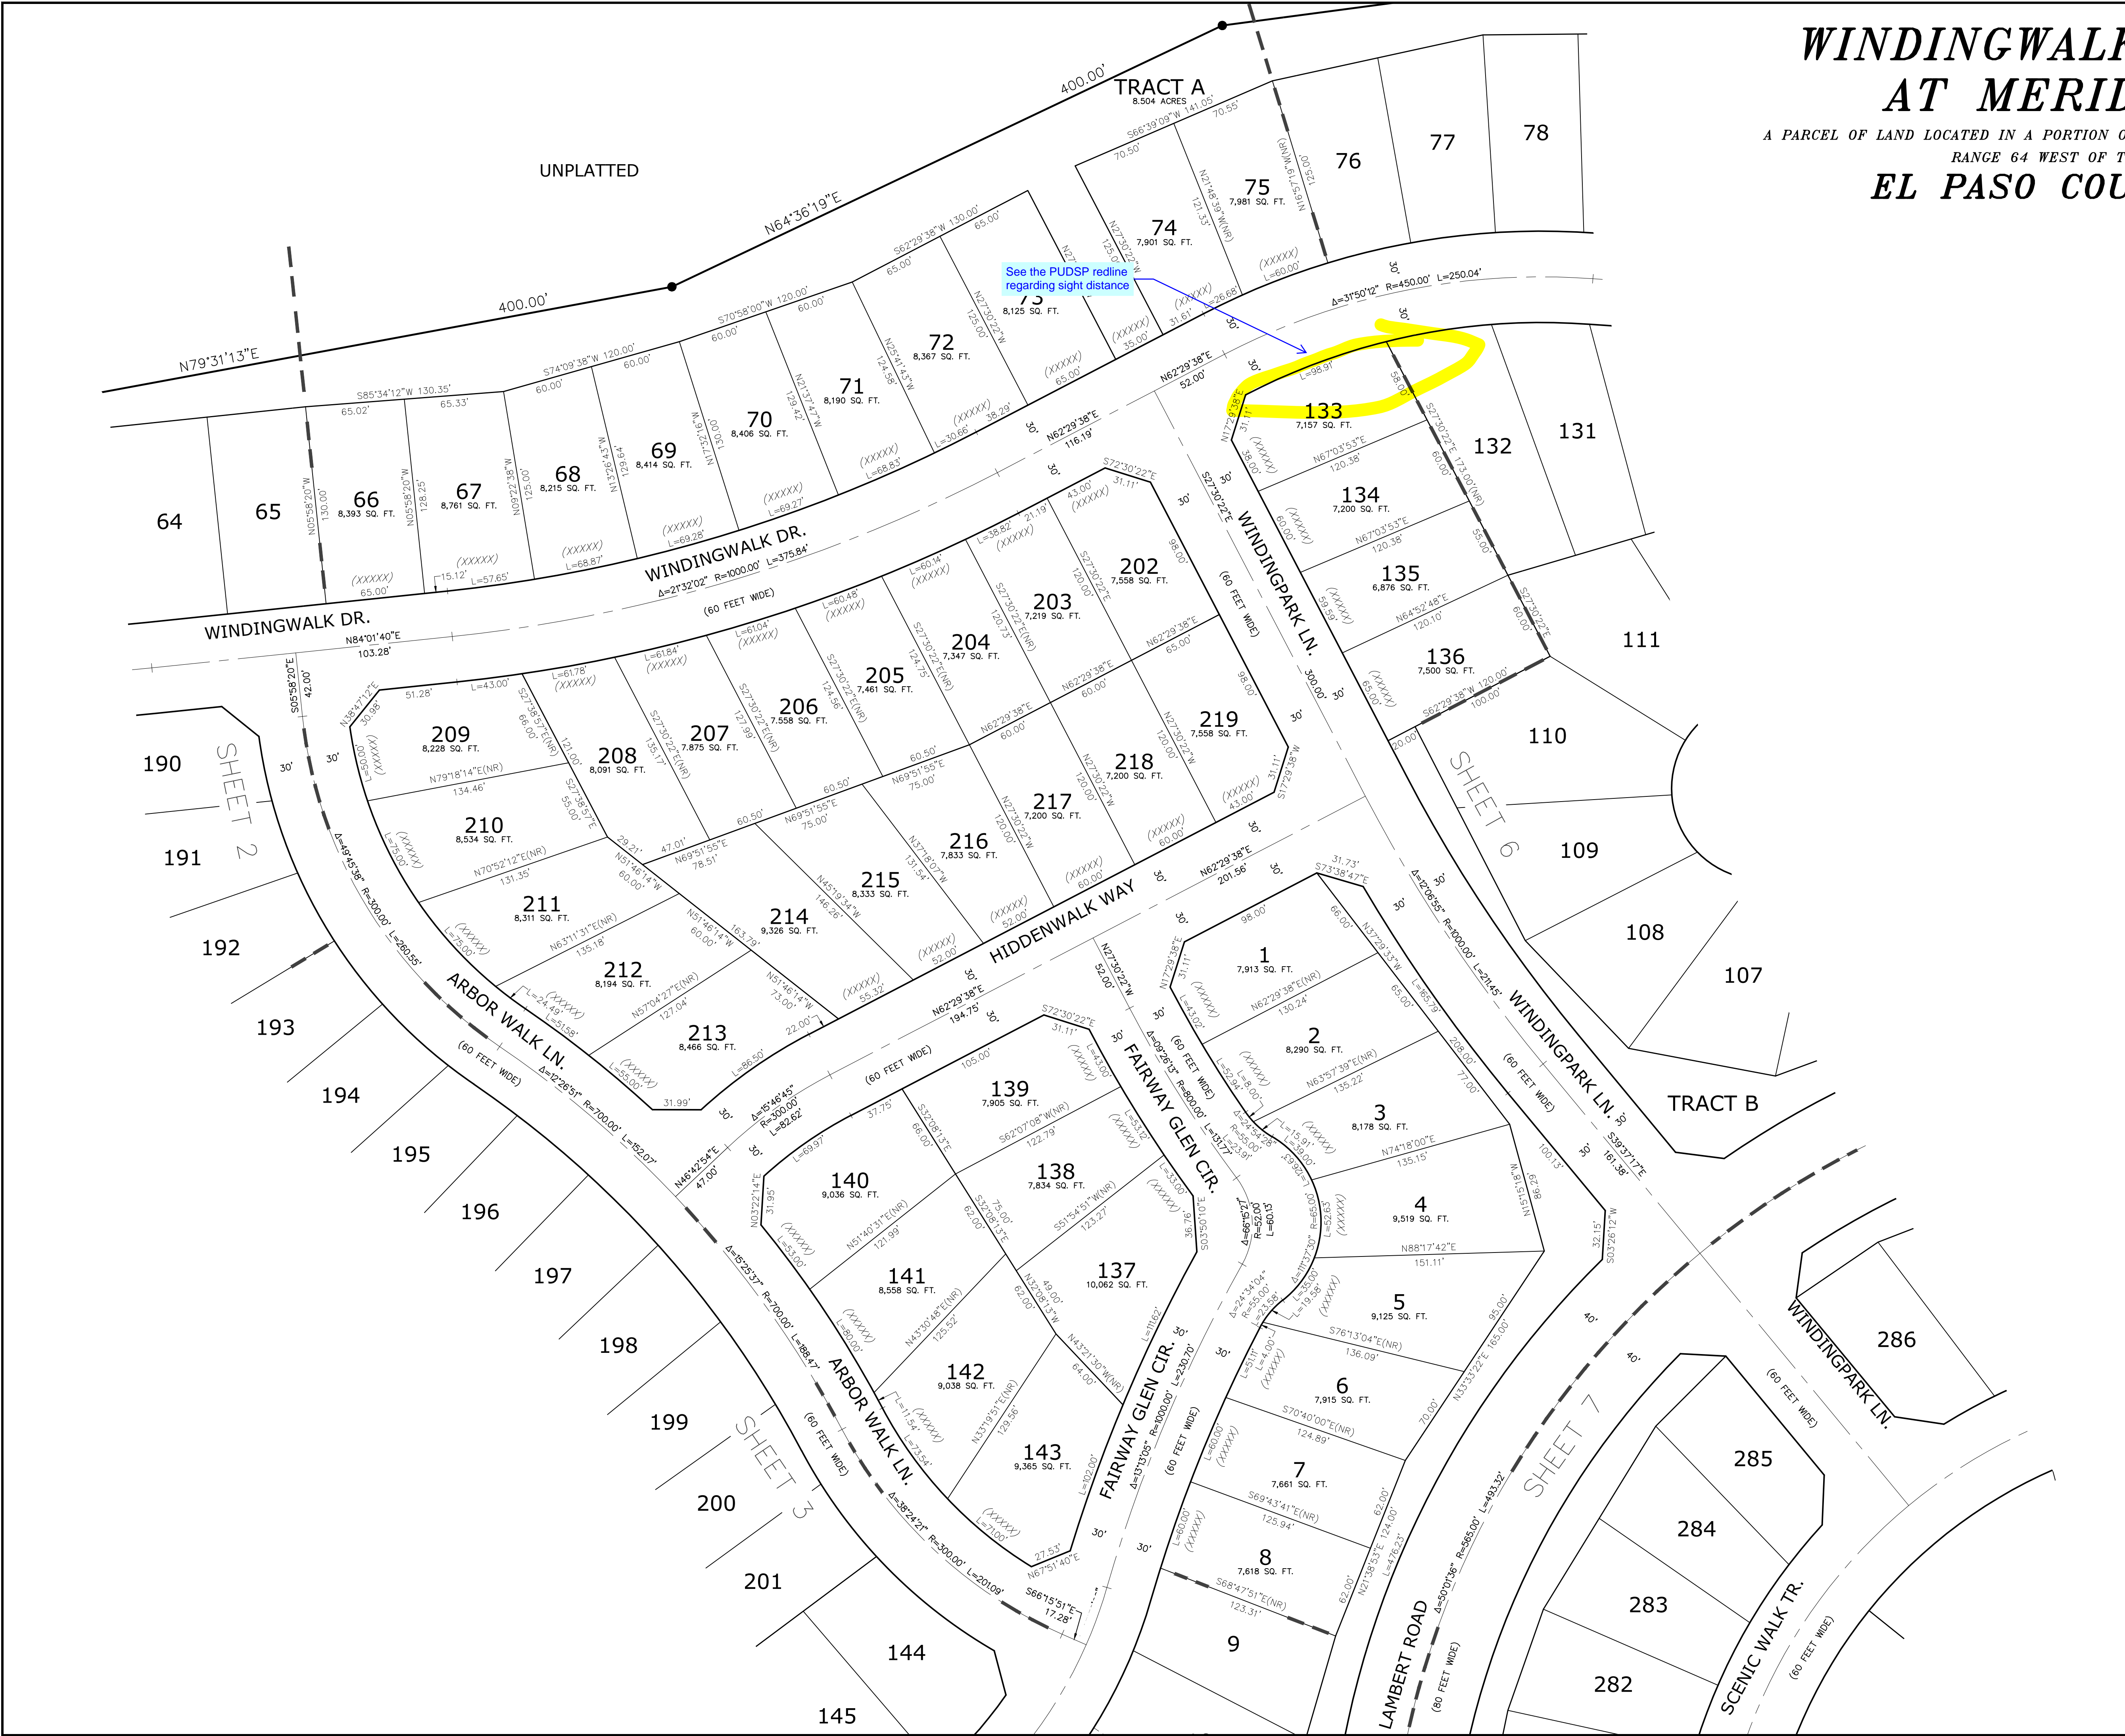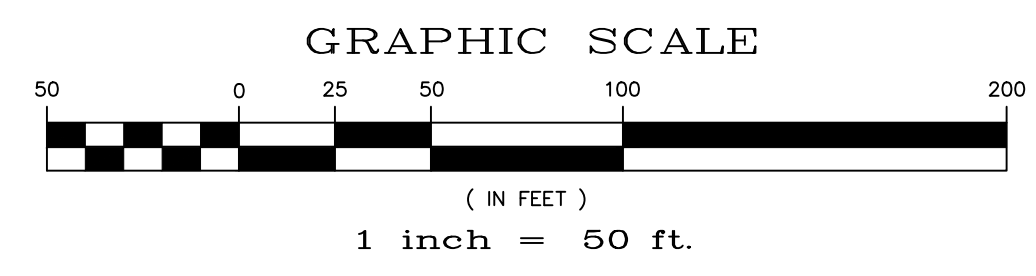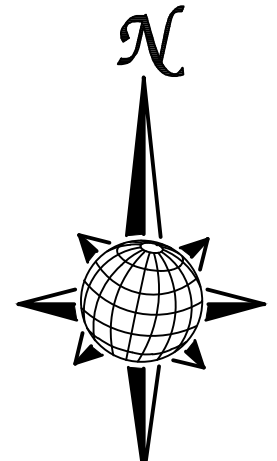



# WINDINGWALK FILING No. 1 AT MERIDIAN RANCH



A PARCEL OF LAND LOCATED IN A PORTION OF SECTION 29, 30, AND 32 IN TOWNSHIP 12 SOUTH,  
RANGE 64 WEST OF THE 6TH PRINCIPAL MERIDIAN  
EL PASO COUNTY, COLORADO.

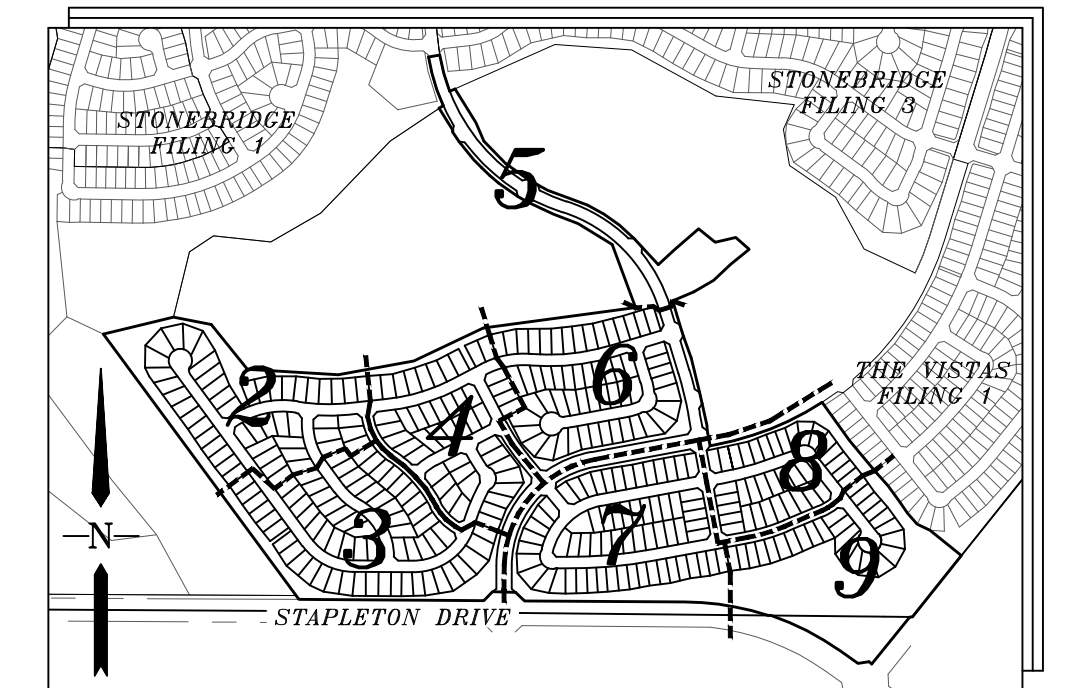

INDEX MAP  
N.T.S.

### LEGEND

- = FOUND MONUMENT AS SHOWN
- ⊙ = FOUND #4 REBAR WITH CAP  
PLS 34583
- = SET #4 REBAR W/CAP  
PLS 34583
- NR = NON-RADIAL BEARING
- (82.62') = EASEMENT OR NO-BUILD DIM.
- (12345) = ADDRESS
- = MATCHLINE

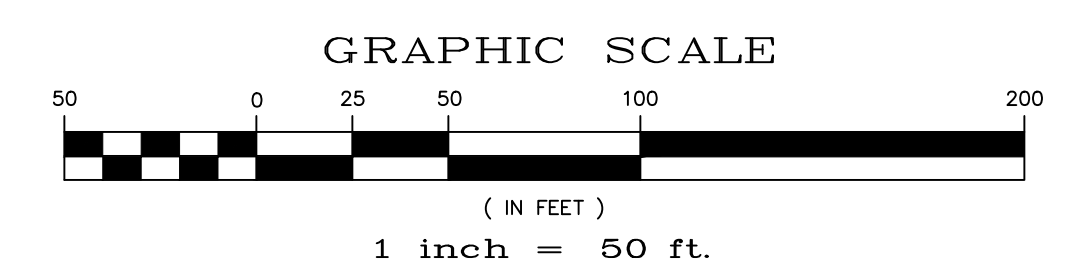
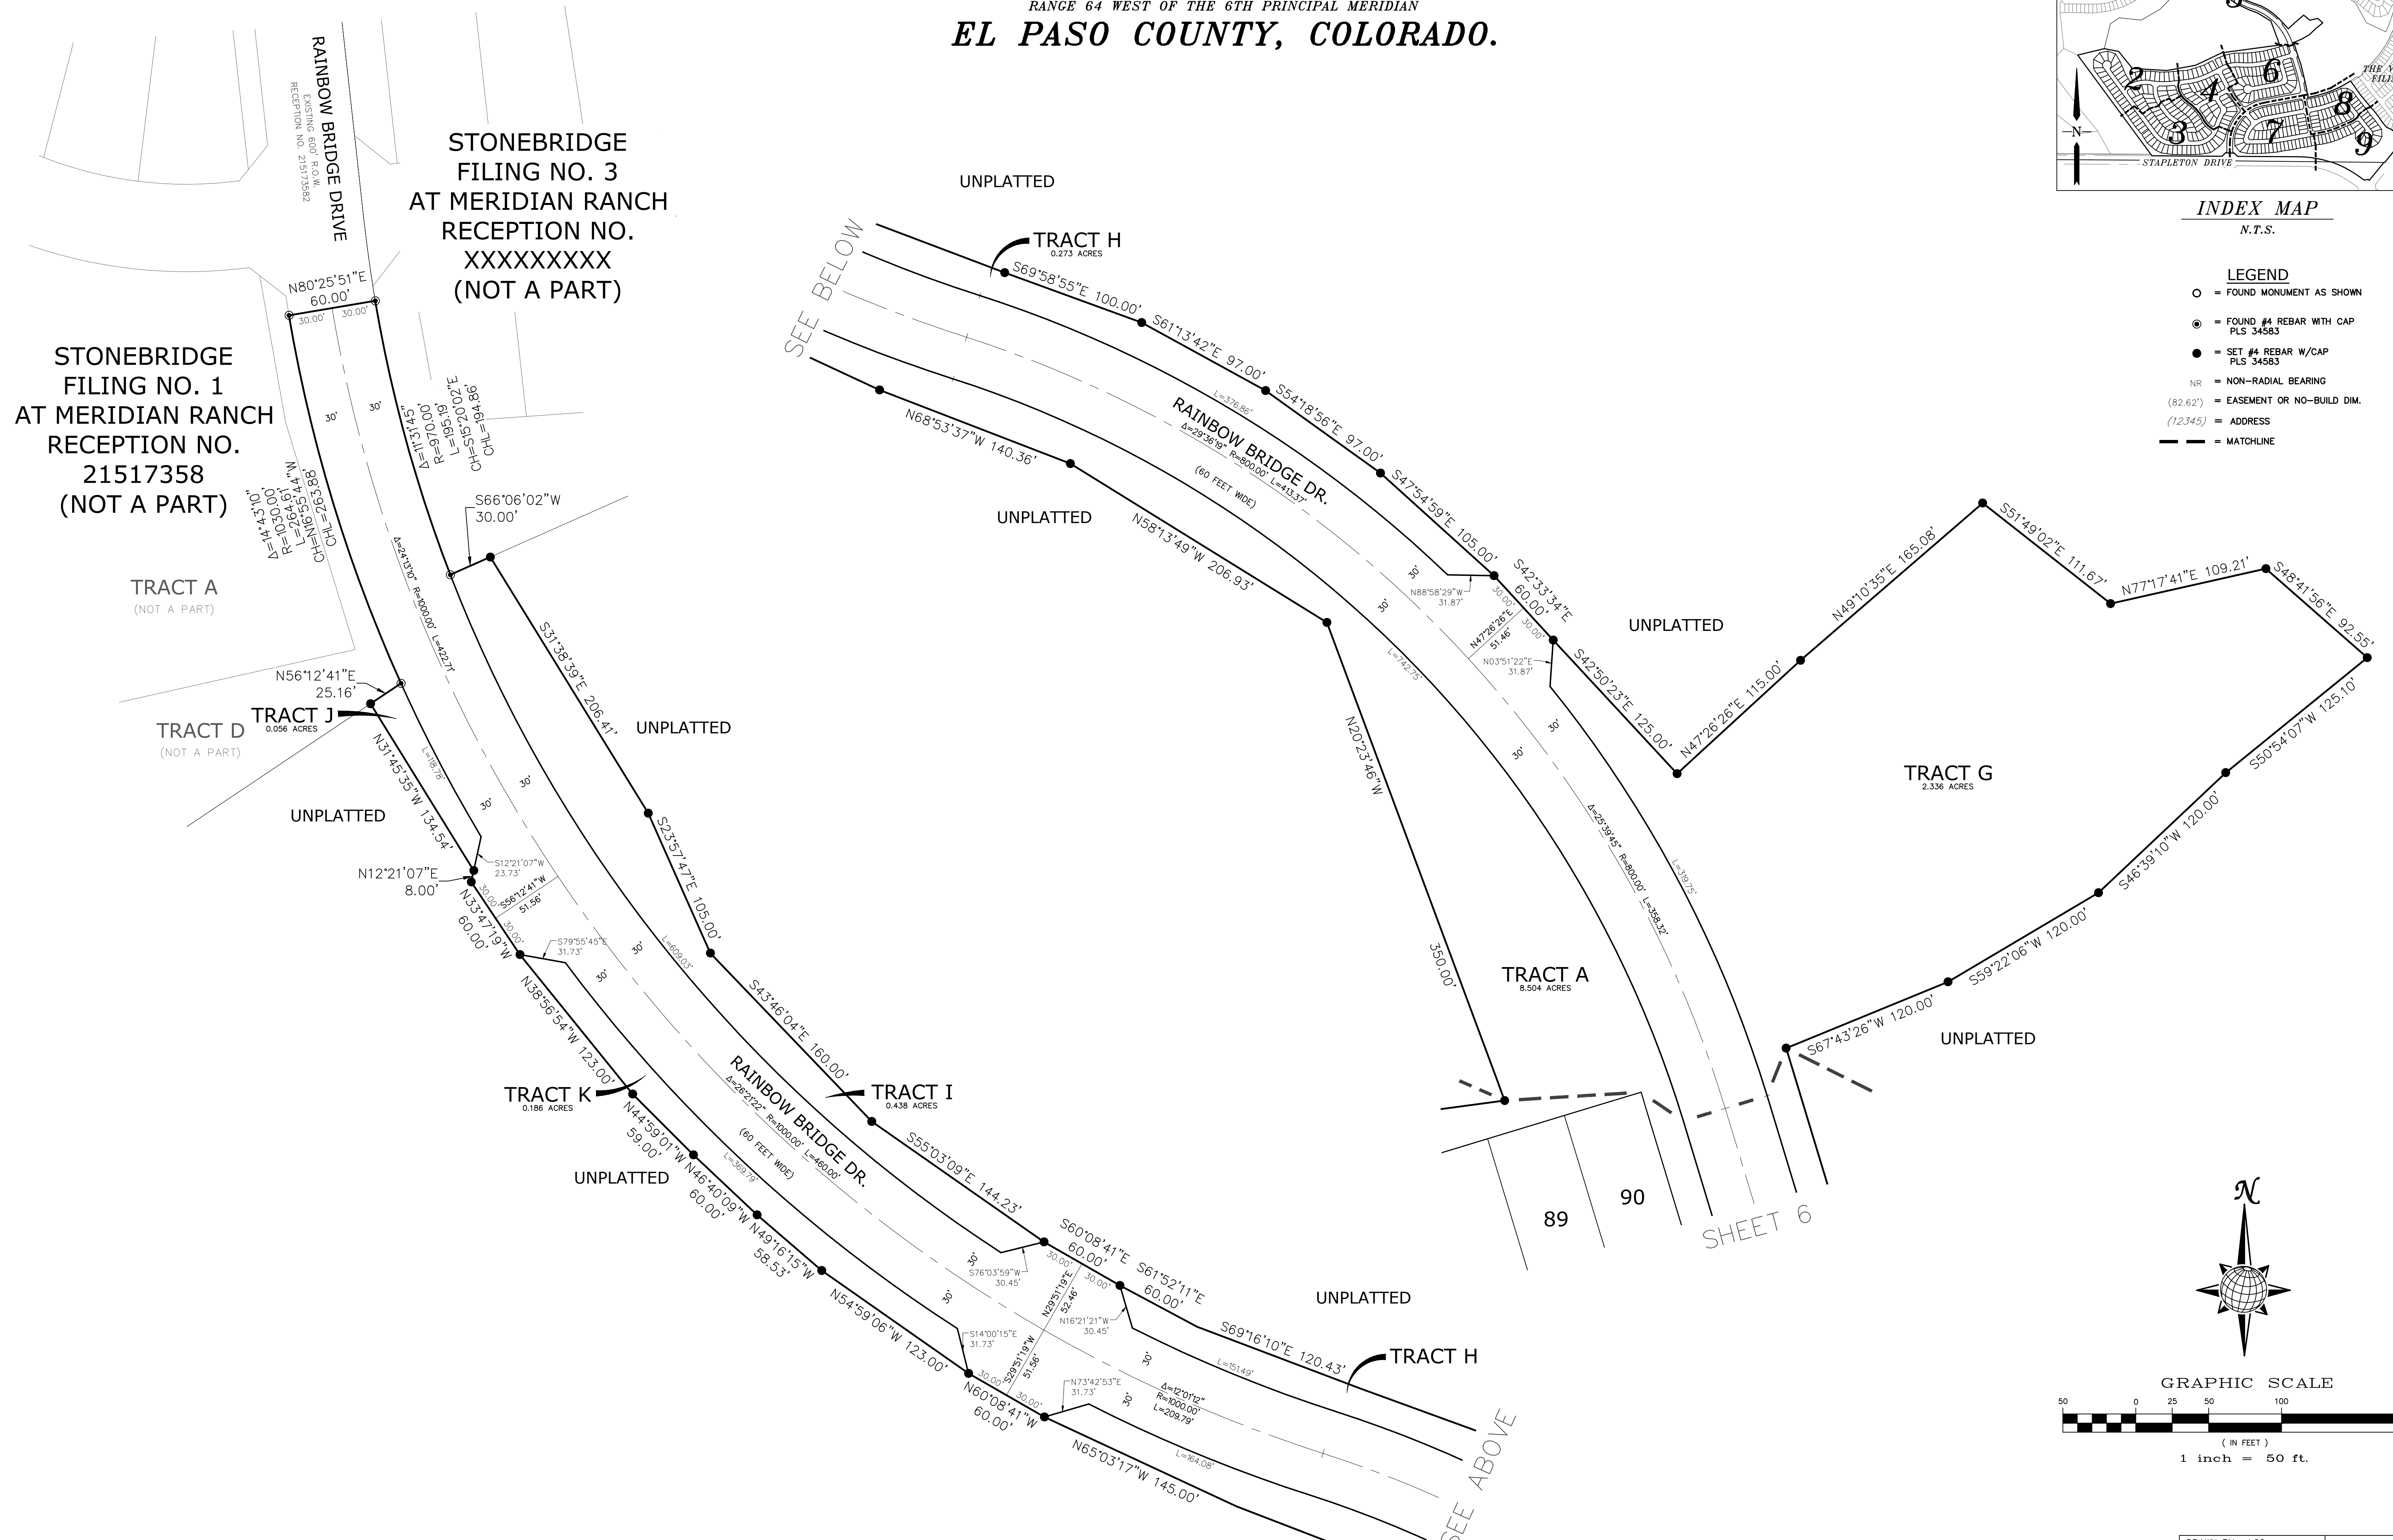




# WINDINGWALK FILING No. 1 AT MERIDIAN RANCH



A PARCEL OF LAND LOCATED IN A PORTION OF SECTION 29, 30, AND 32 IN TOWNSHIP 12 SOUTH,  
RANGE 64 WEST OF THE 6TH PRINCIPAL MERIDIAN  
EL PASO COUNTY, COLORADO.

SHEET 5

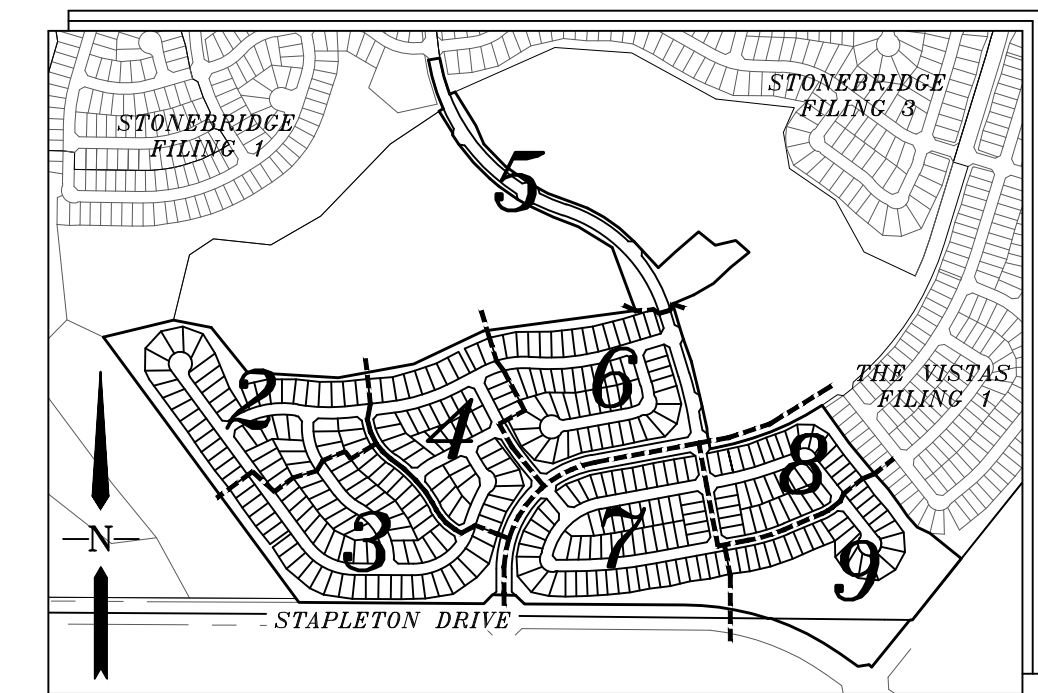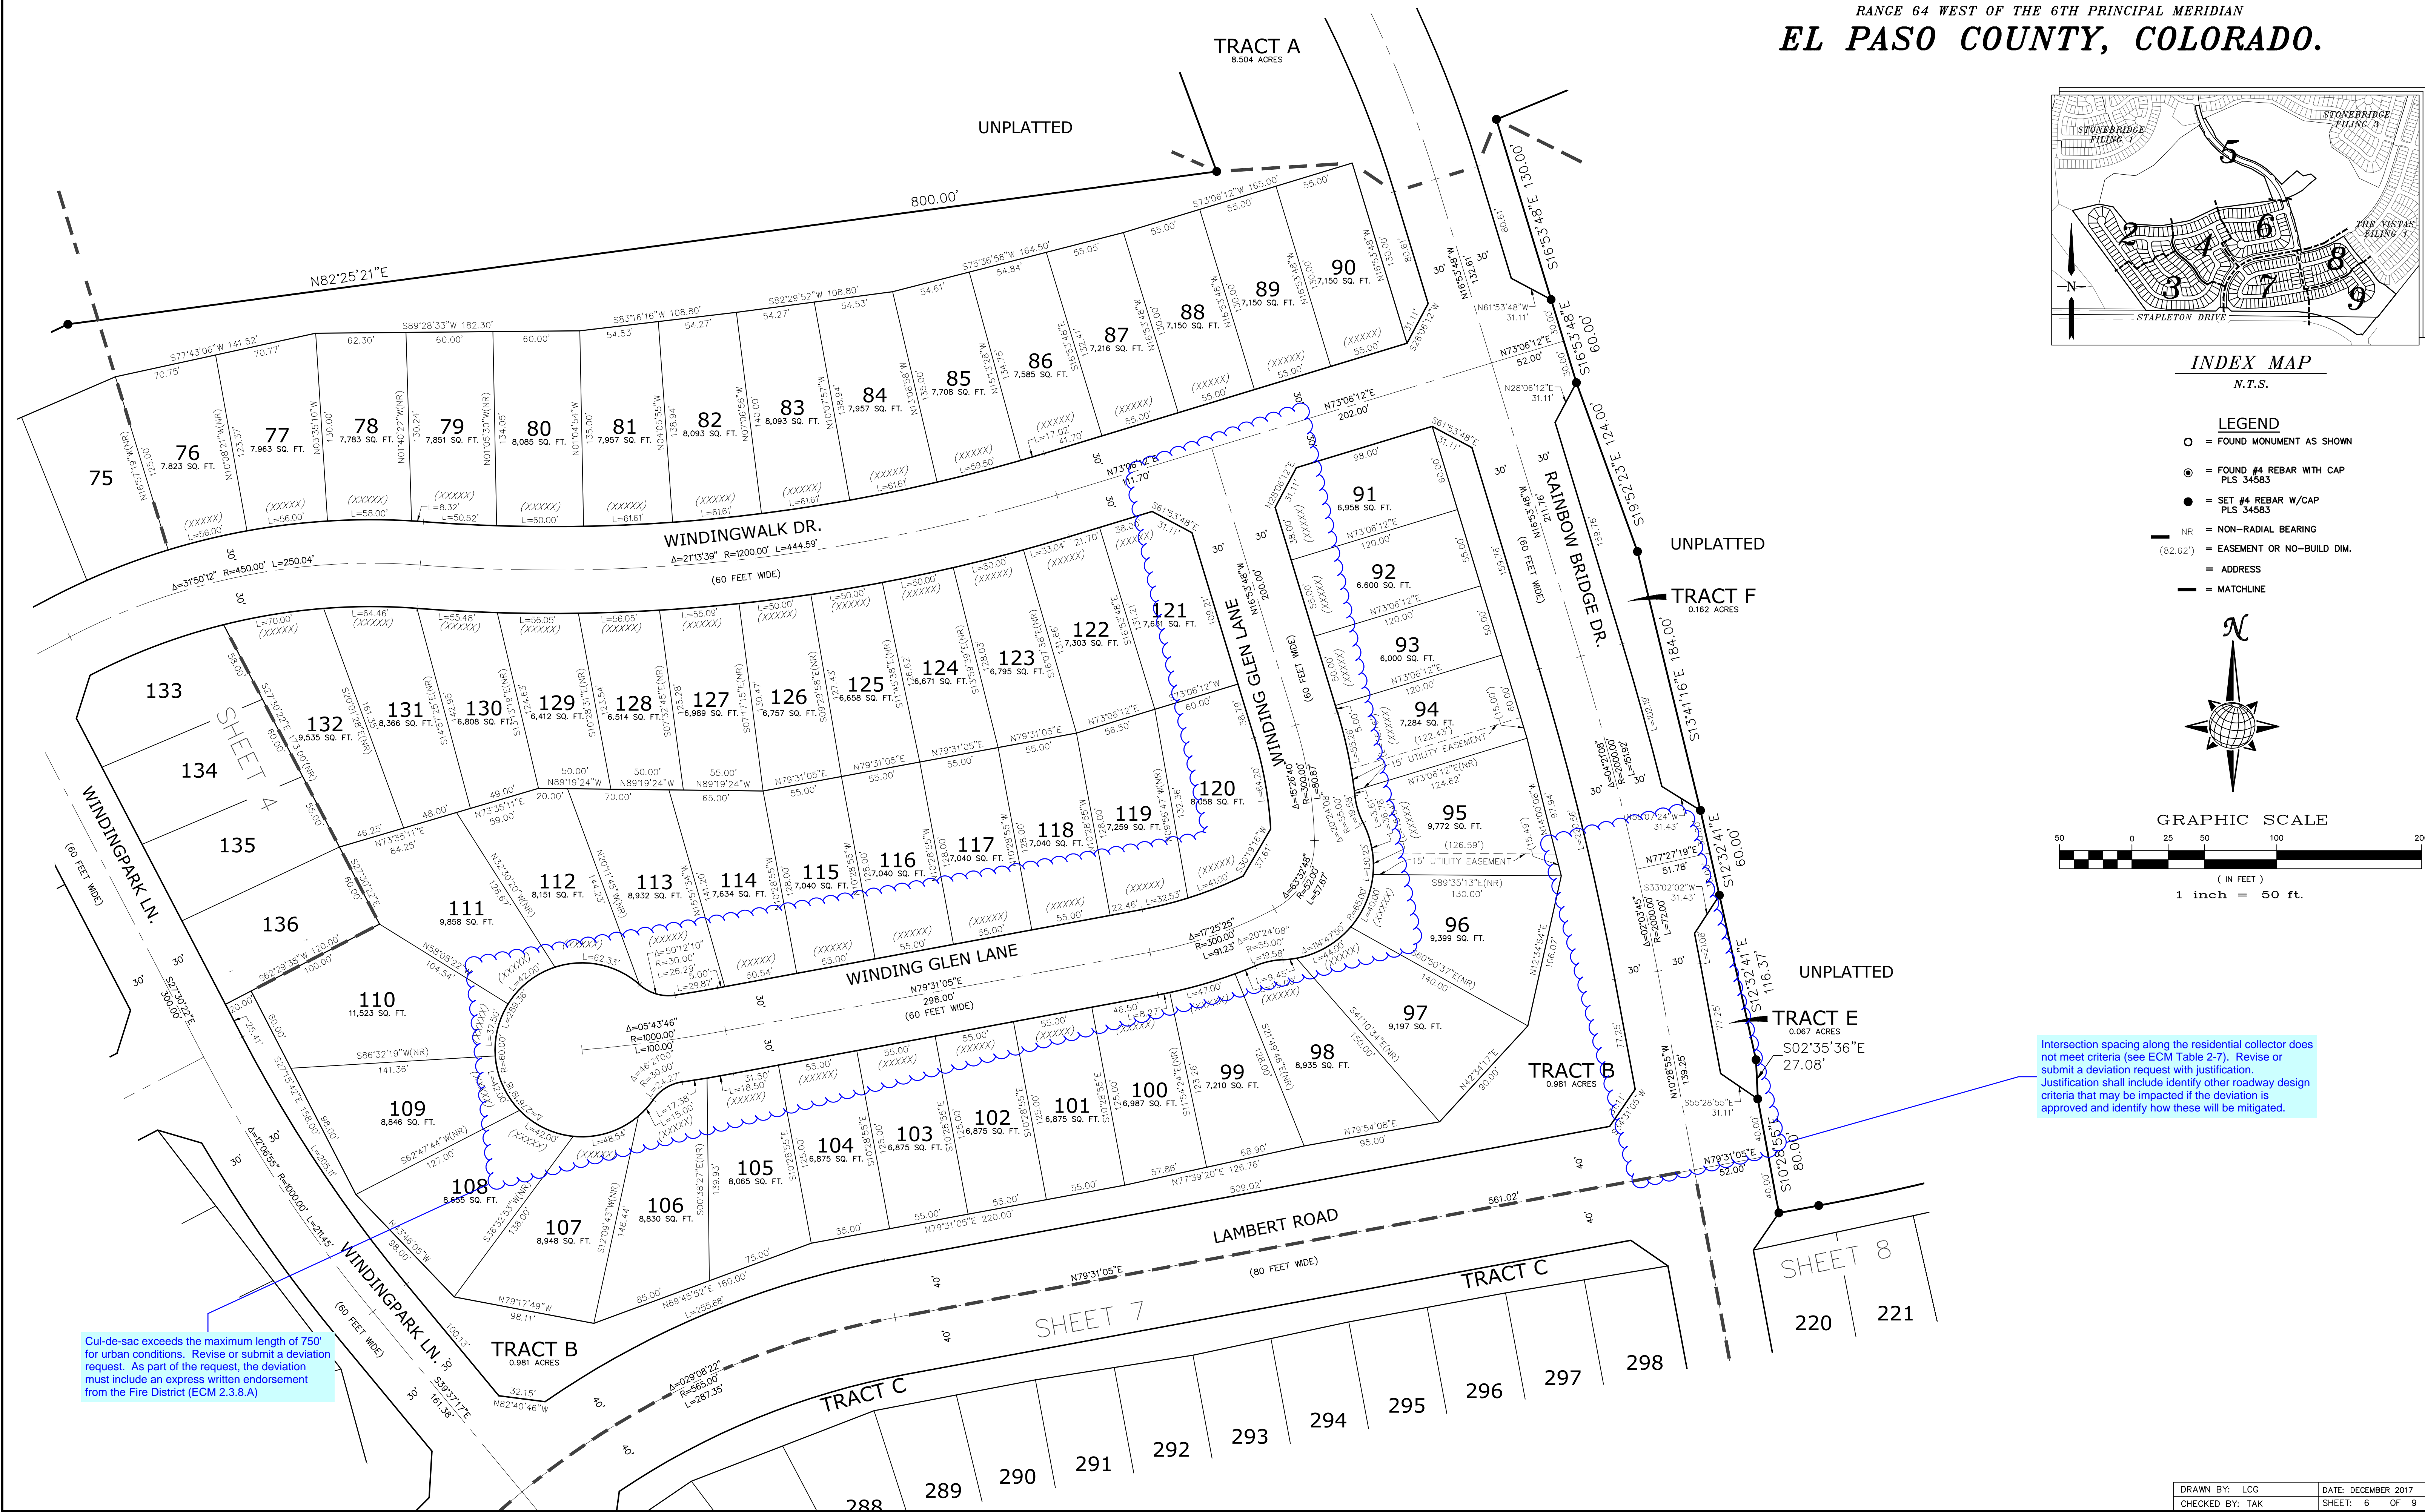

**INDEX MAP**  
N.T.S.

- LEGEND**
- = FOUND MONUMENT AS SHOWN
  - ⊙ = FOUND #4 REBAR WITH CAP PLS 34583
  - = SET #4 REBAR W/CAP PLS 34583
  - NR = NON-RADIAL BEARING
  - (82.62') = EASEMENT OR NO-BUILD DIM.
  - = ADDRESS
  - = MATCHLINE

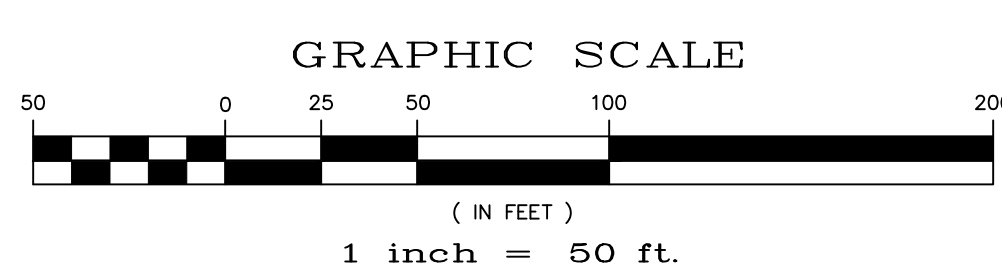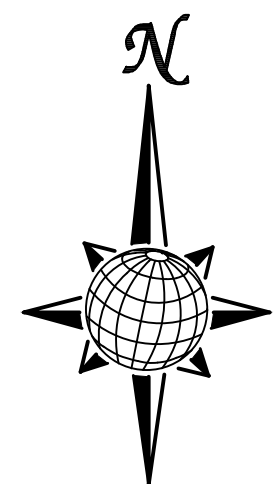


Cul-de-sac exceeds the maximum length of 750' for urban conditions. Revise or submit a deviation request. As part of the request, the deviation must include an express written endorsement from the Fire District (ECM 2.3.8.A)

Intersection spacing along the residential collector does not meet criteria (see ECM Table 2-7). Revise or submit a deviation request with justification. Justification shall include identify other roadway design criteria that may be impacted if the deviation is approved and identify how these will be mitigated.






# WINDINGWALK FILING No. 1 AT MERIDIAN RANCH

A PARCEL OF LAND LOCATED IN A PORTION OF SECTION 29, 30, AND 32 IN TOWNSHIP 12 SOUTH,  
RANGE 64 WEST OF THE 6TH PRINCIPAL MERIDIAN  
**EL PASO COUNTY, COLORADO.**

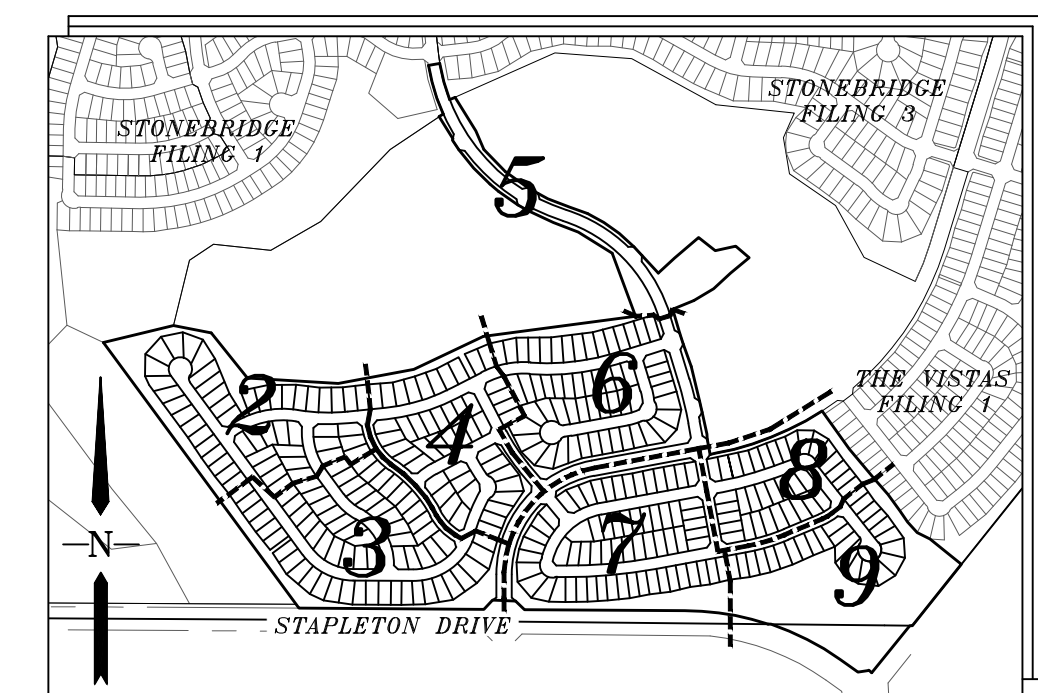

**INDEX MAP**  
N.T.S.

- LEGEND**
- = FOUND MONUMENT AS SHOWN
  - ⊙ = FOUND #4 REBAR WITH CAP PLS 34583
  - = SET #4 REBAR W/CAP PLS 34583
  - NR = NON-RADIAL BEARING
  - (82.62°) = EASEMENT OR NO-BUILD DIM.
  - (12345) = ADDRESS
  - = MATCHLINE

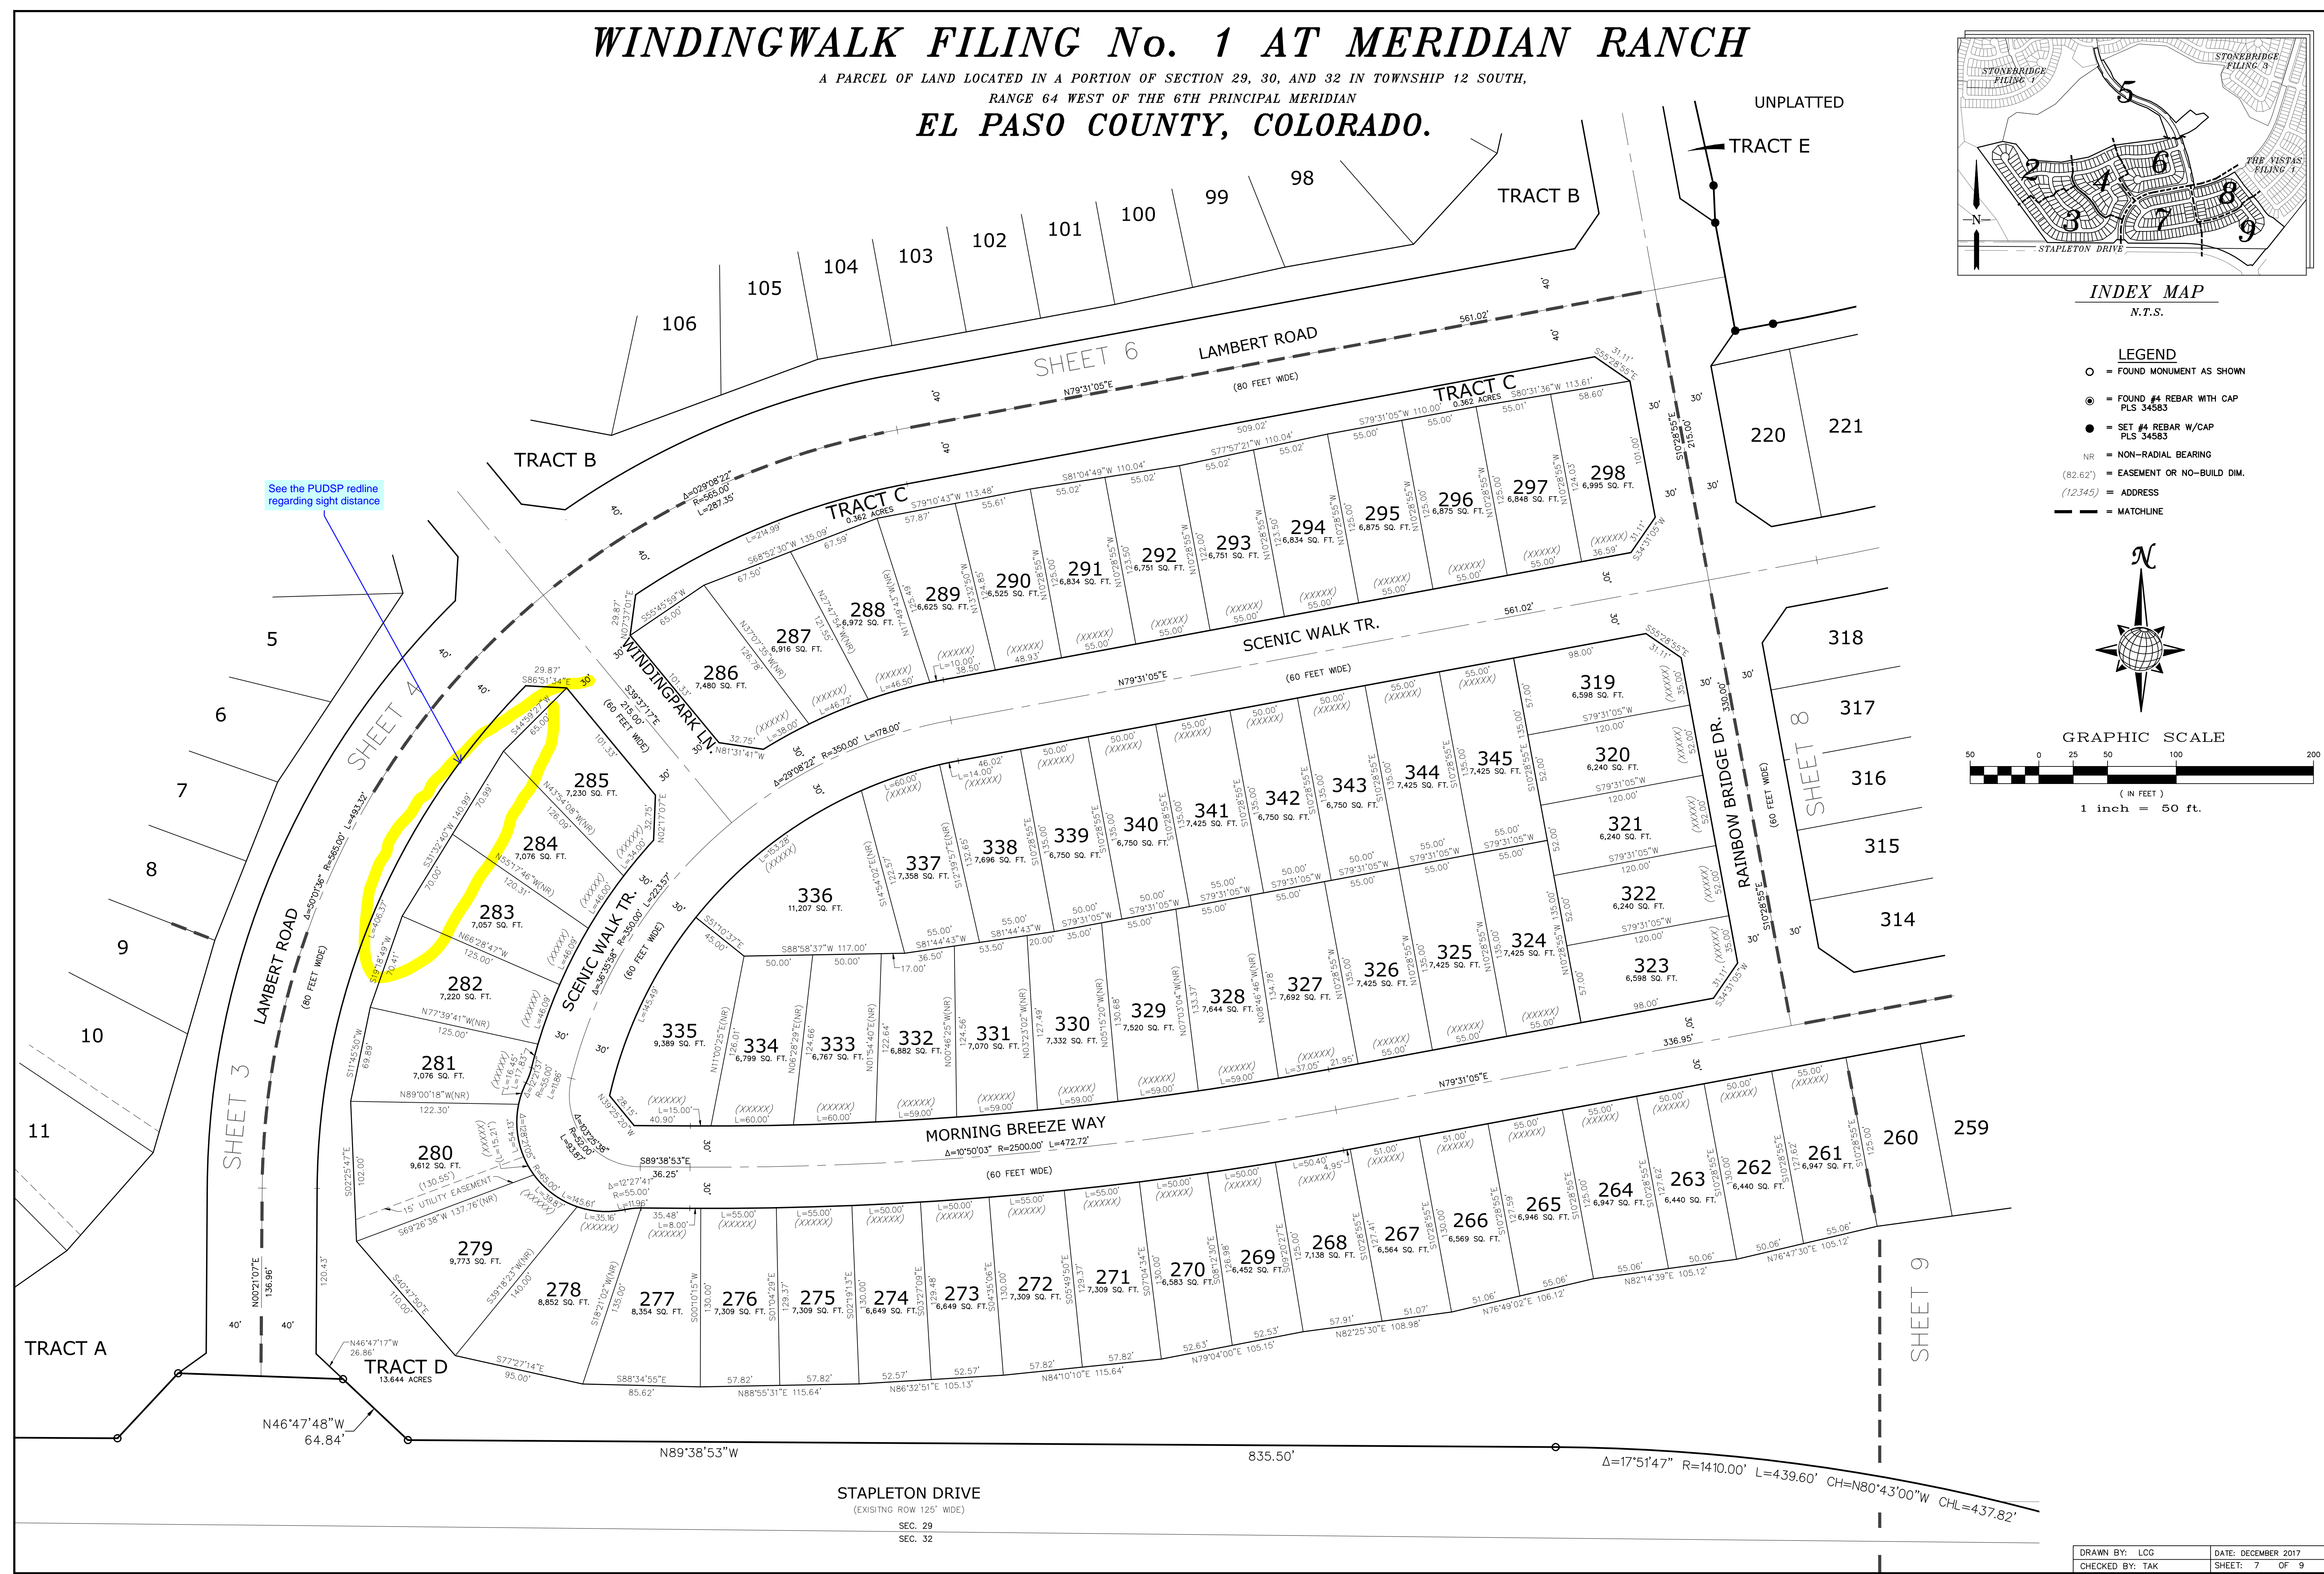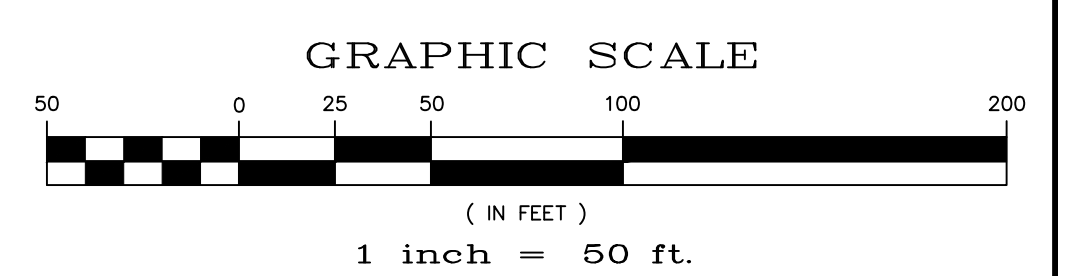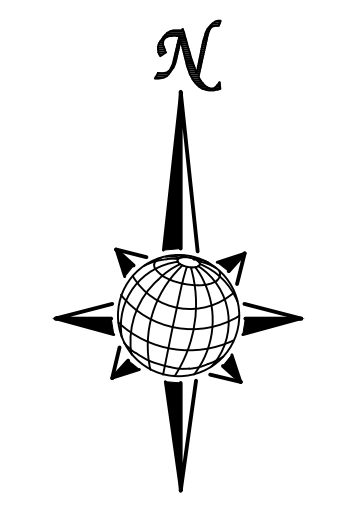


See the PUDSP redline regarding sight distance



# WINDINGWALK FILING No. 1 AT MERIDIAN RANCH


A PARCEL OF LAND LOCATED IN A PORTION OF SECTION 29, 30, AND 32 IN TOWNSHIP 12 SOUTH,  
RANGE 64 WEST OF THE 6TH PRINCIPAL MERIDIAN  
**EL PASO COUNTY, COLORADO.**

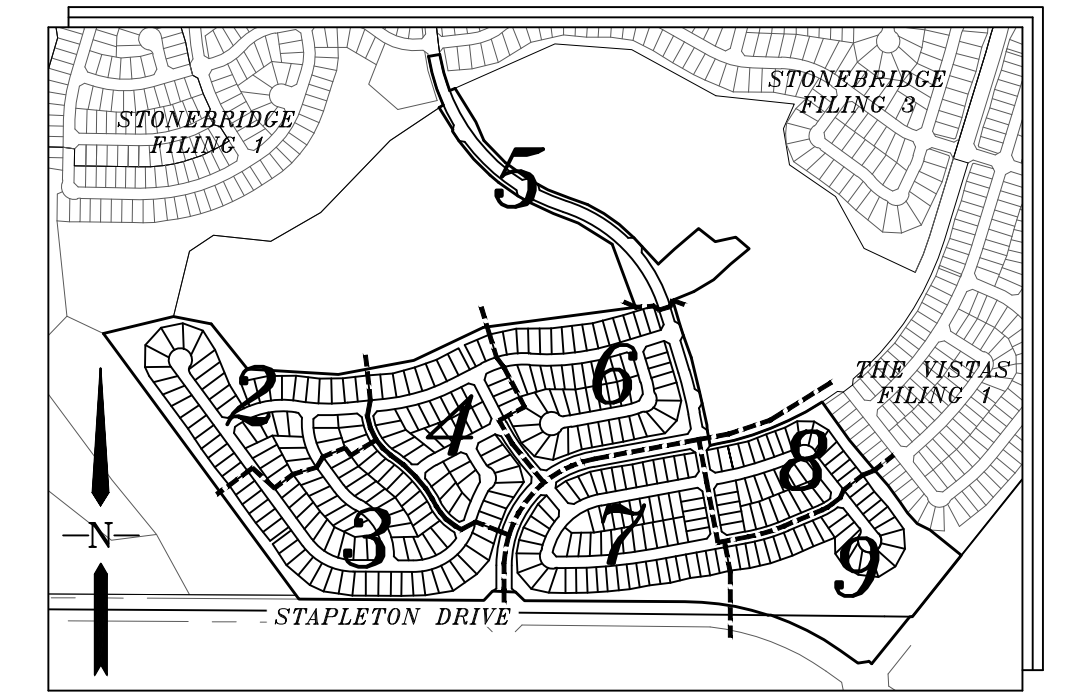


**INDEX MAP**  
N.T.S.

**LEGEND**


- = FOUND MONUMENT AS SHOWN
- ⊙ = FOUND #4 REBAR WITH CAP  
PLS 34583
- = SET #4 REBAR W/CAP  
PLS 34583
- NR = NON-RADIAL BEARING
- (82.62') = EASEMENT OR NO-BUILD DIM.
- (12345) = ADDRESS
- = MATCHLINE

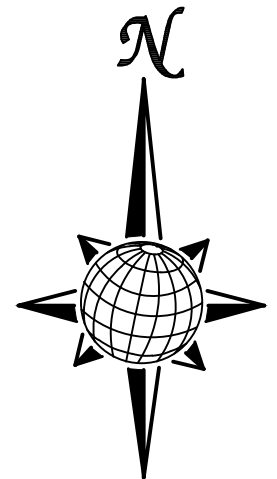

**GRAPHIC SCALE**

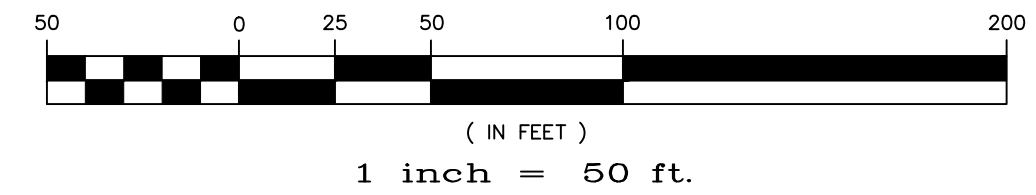

SHEET 6

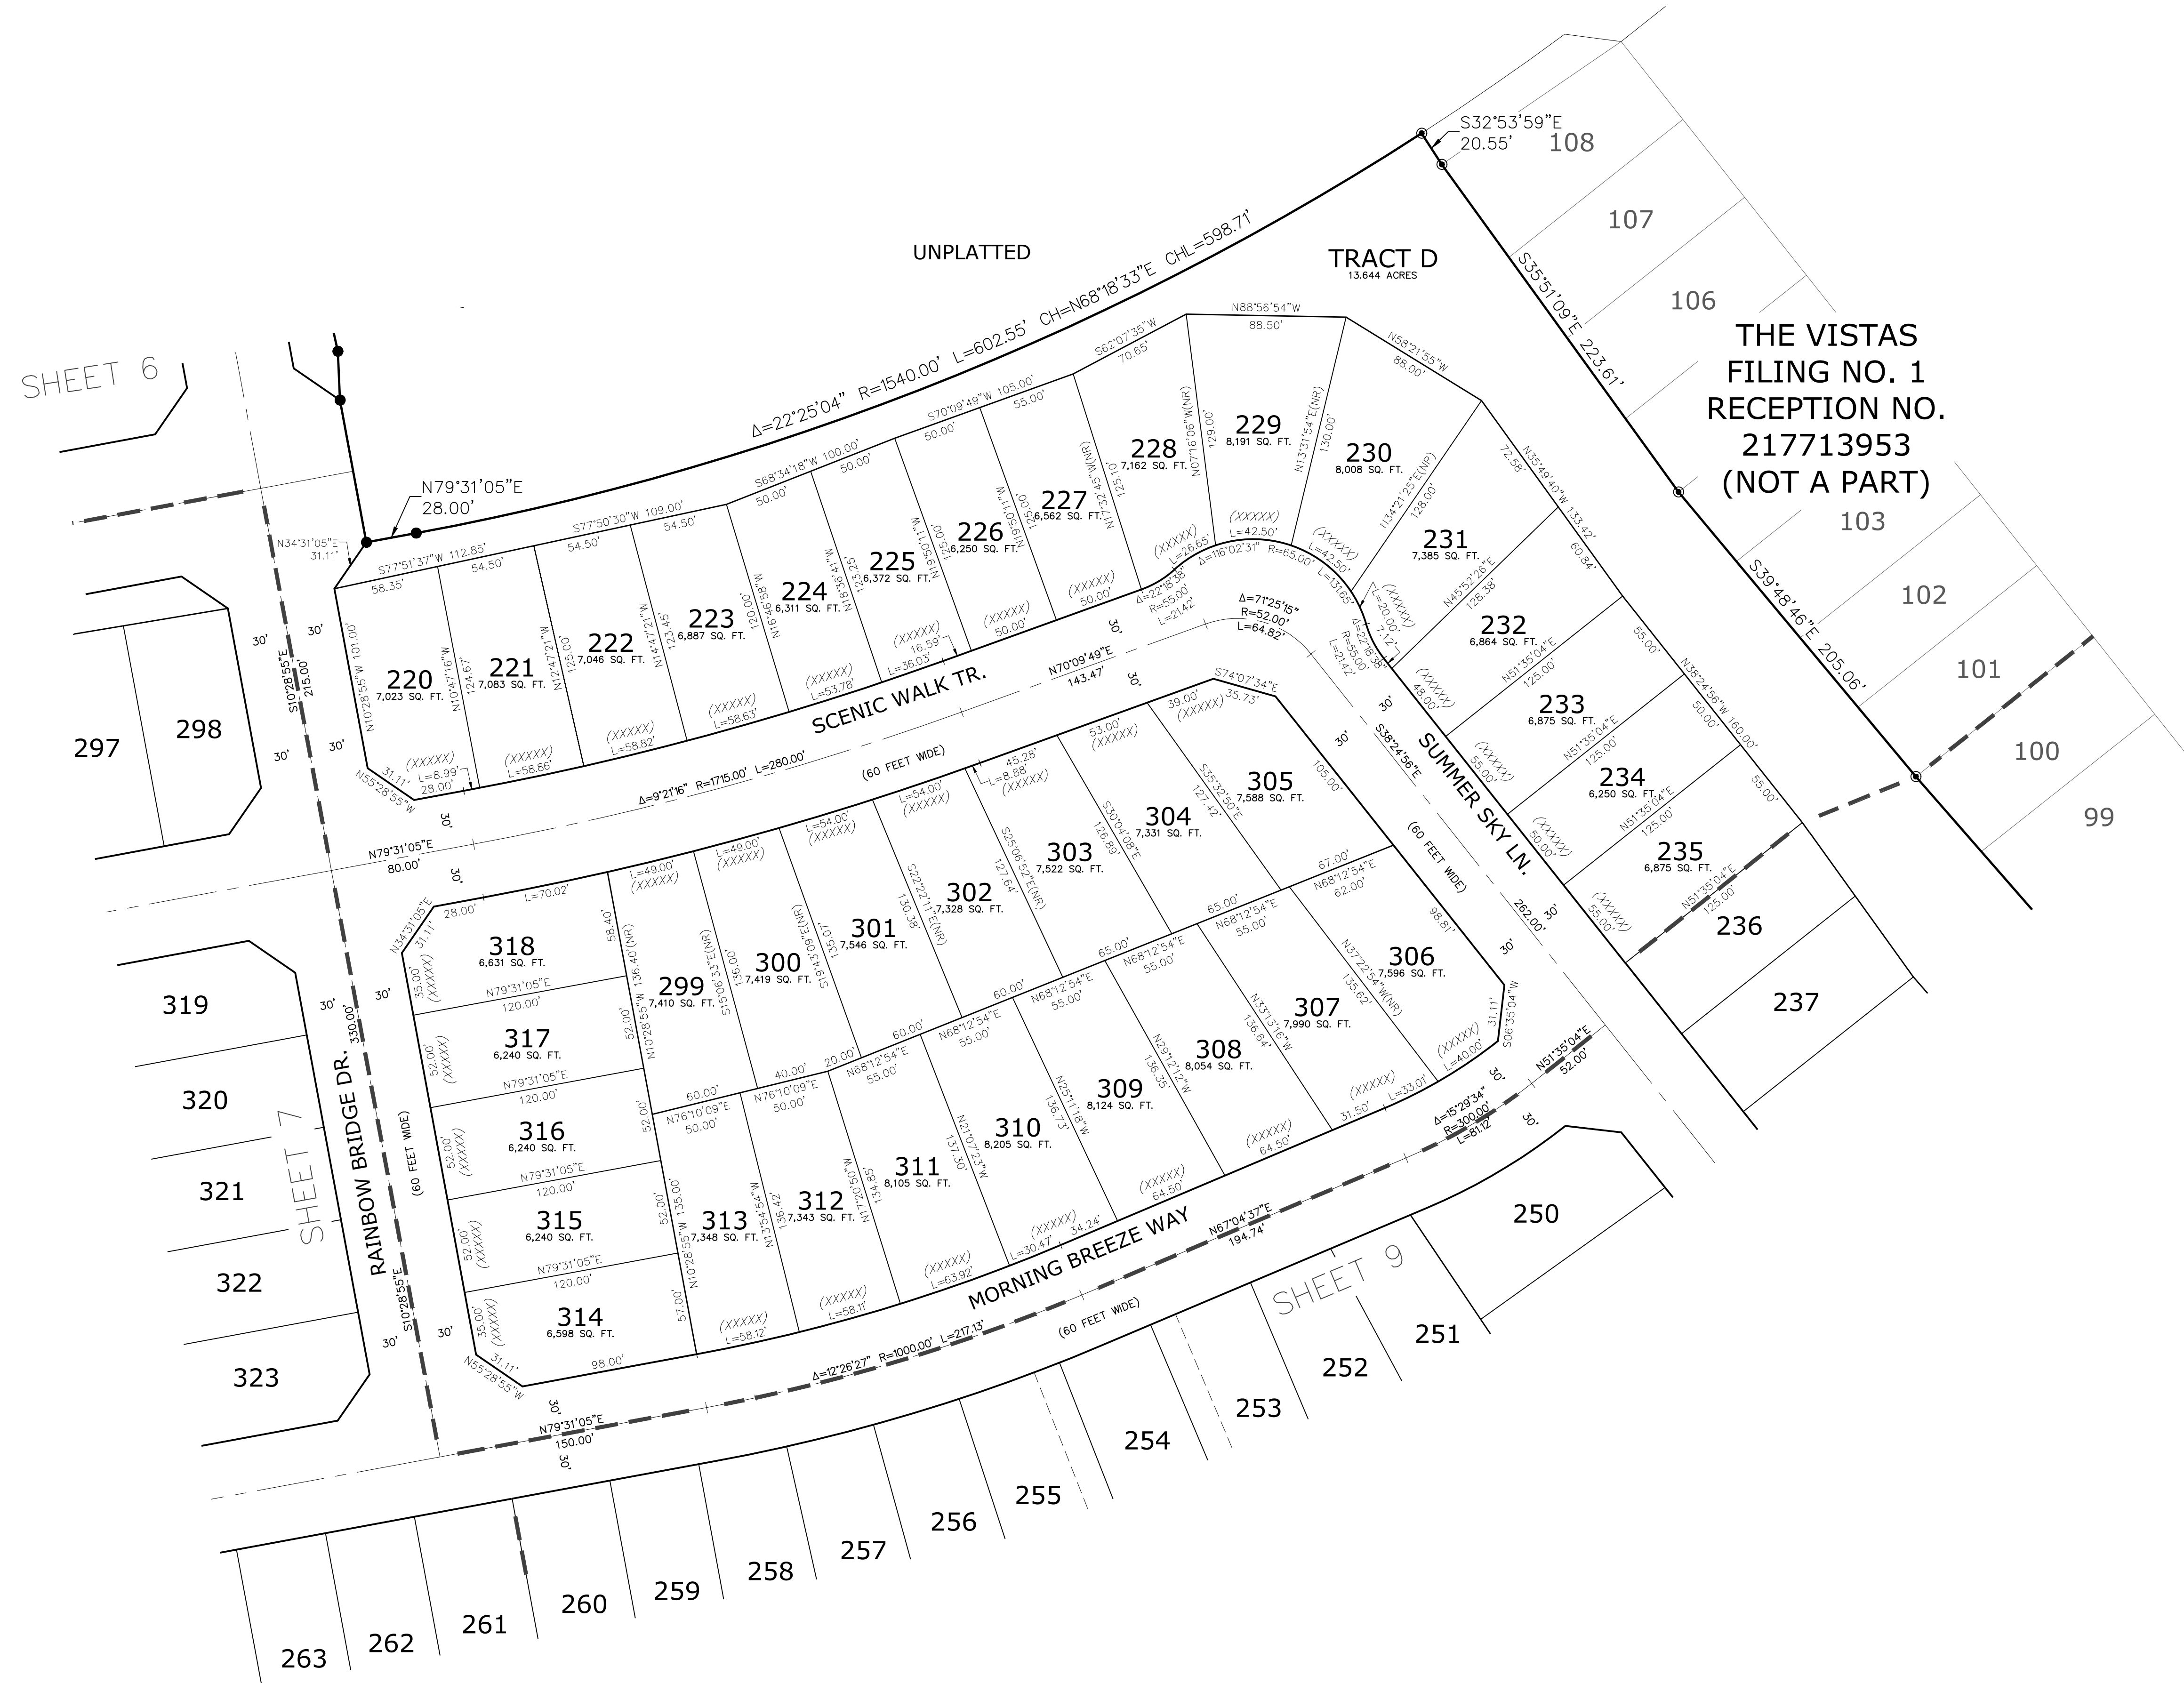




# WINDINGWALK FILING No. 1 AT MERIDIAN RANCH




A PARCEL OF LAND LOCATED IN A PORTION OF SECTION 29, 30, AND 32 IN TOWNSHIP 12 SOUTH,  
RANGE 64 WEST OF THE 6TH PRINCIPAL MERIDIAN  
**EL PASO COUNTY, COLORADO.**

THE VISTAS  
FILING NO. 1  
RECEPTION NO.  
217713953  
(NOT A PART)

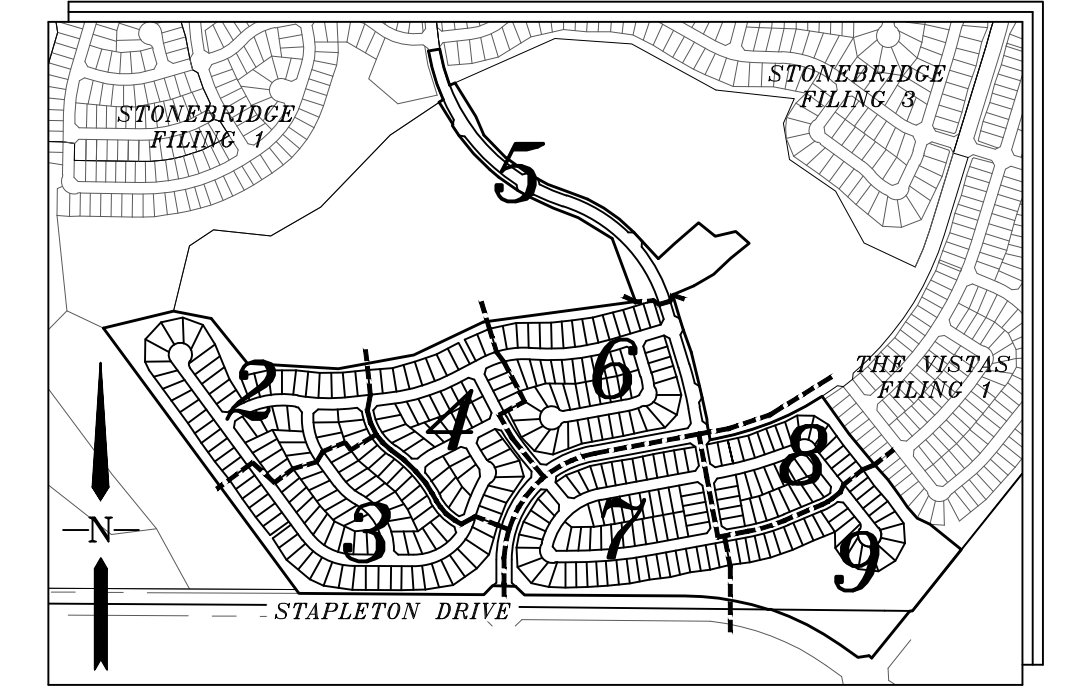

**INDEX MAP**  
N.T.S.

- LEGEND**
- = FOUND MONUMENT AS SHOWN
  - ⊙ = FOUND #4 REBAR WITH CAP PLS 34583
  - = SET #4 REBAR W/CAP PLS 34583
  - NR = NON-RADIAL BEARING
  - (82.62') = EASEMENT OR NO-BUILD DIM.
  - (12345) = ADDRESS
  - - - = MATCHLINE

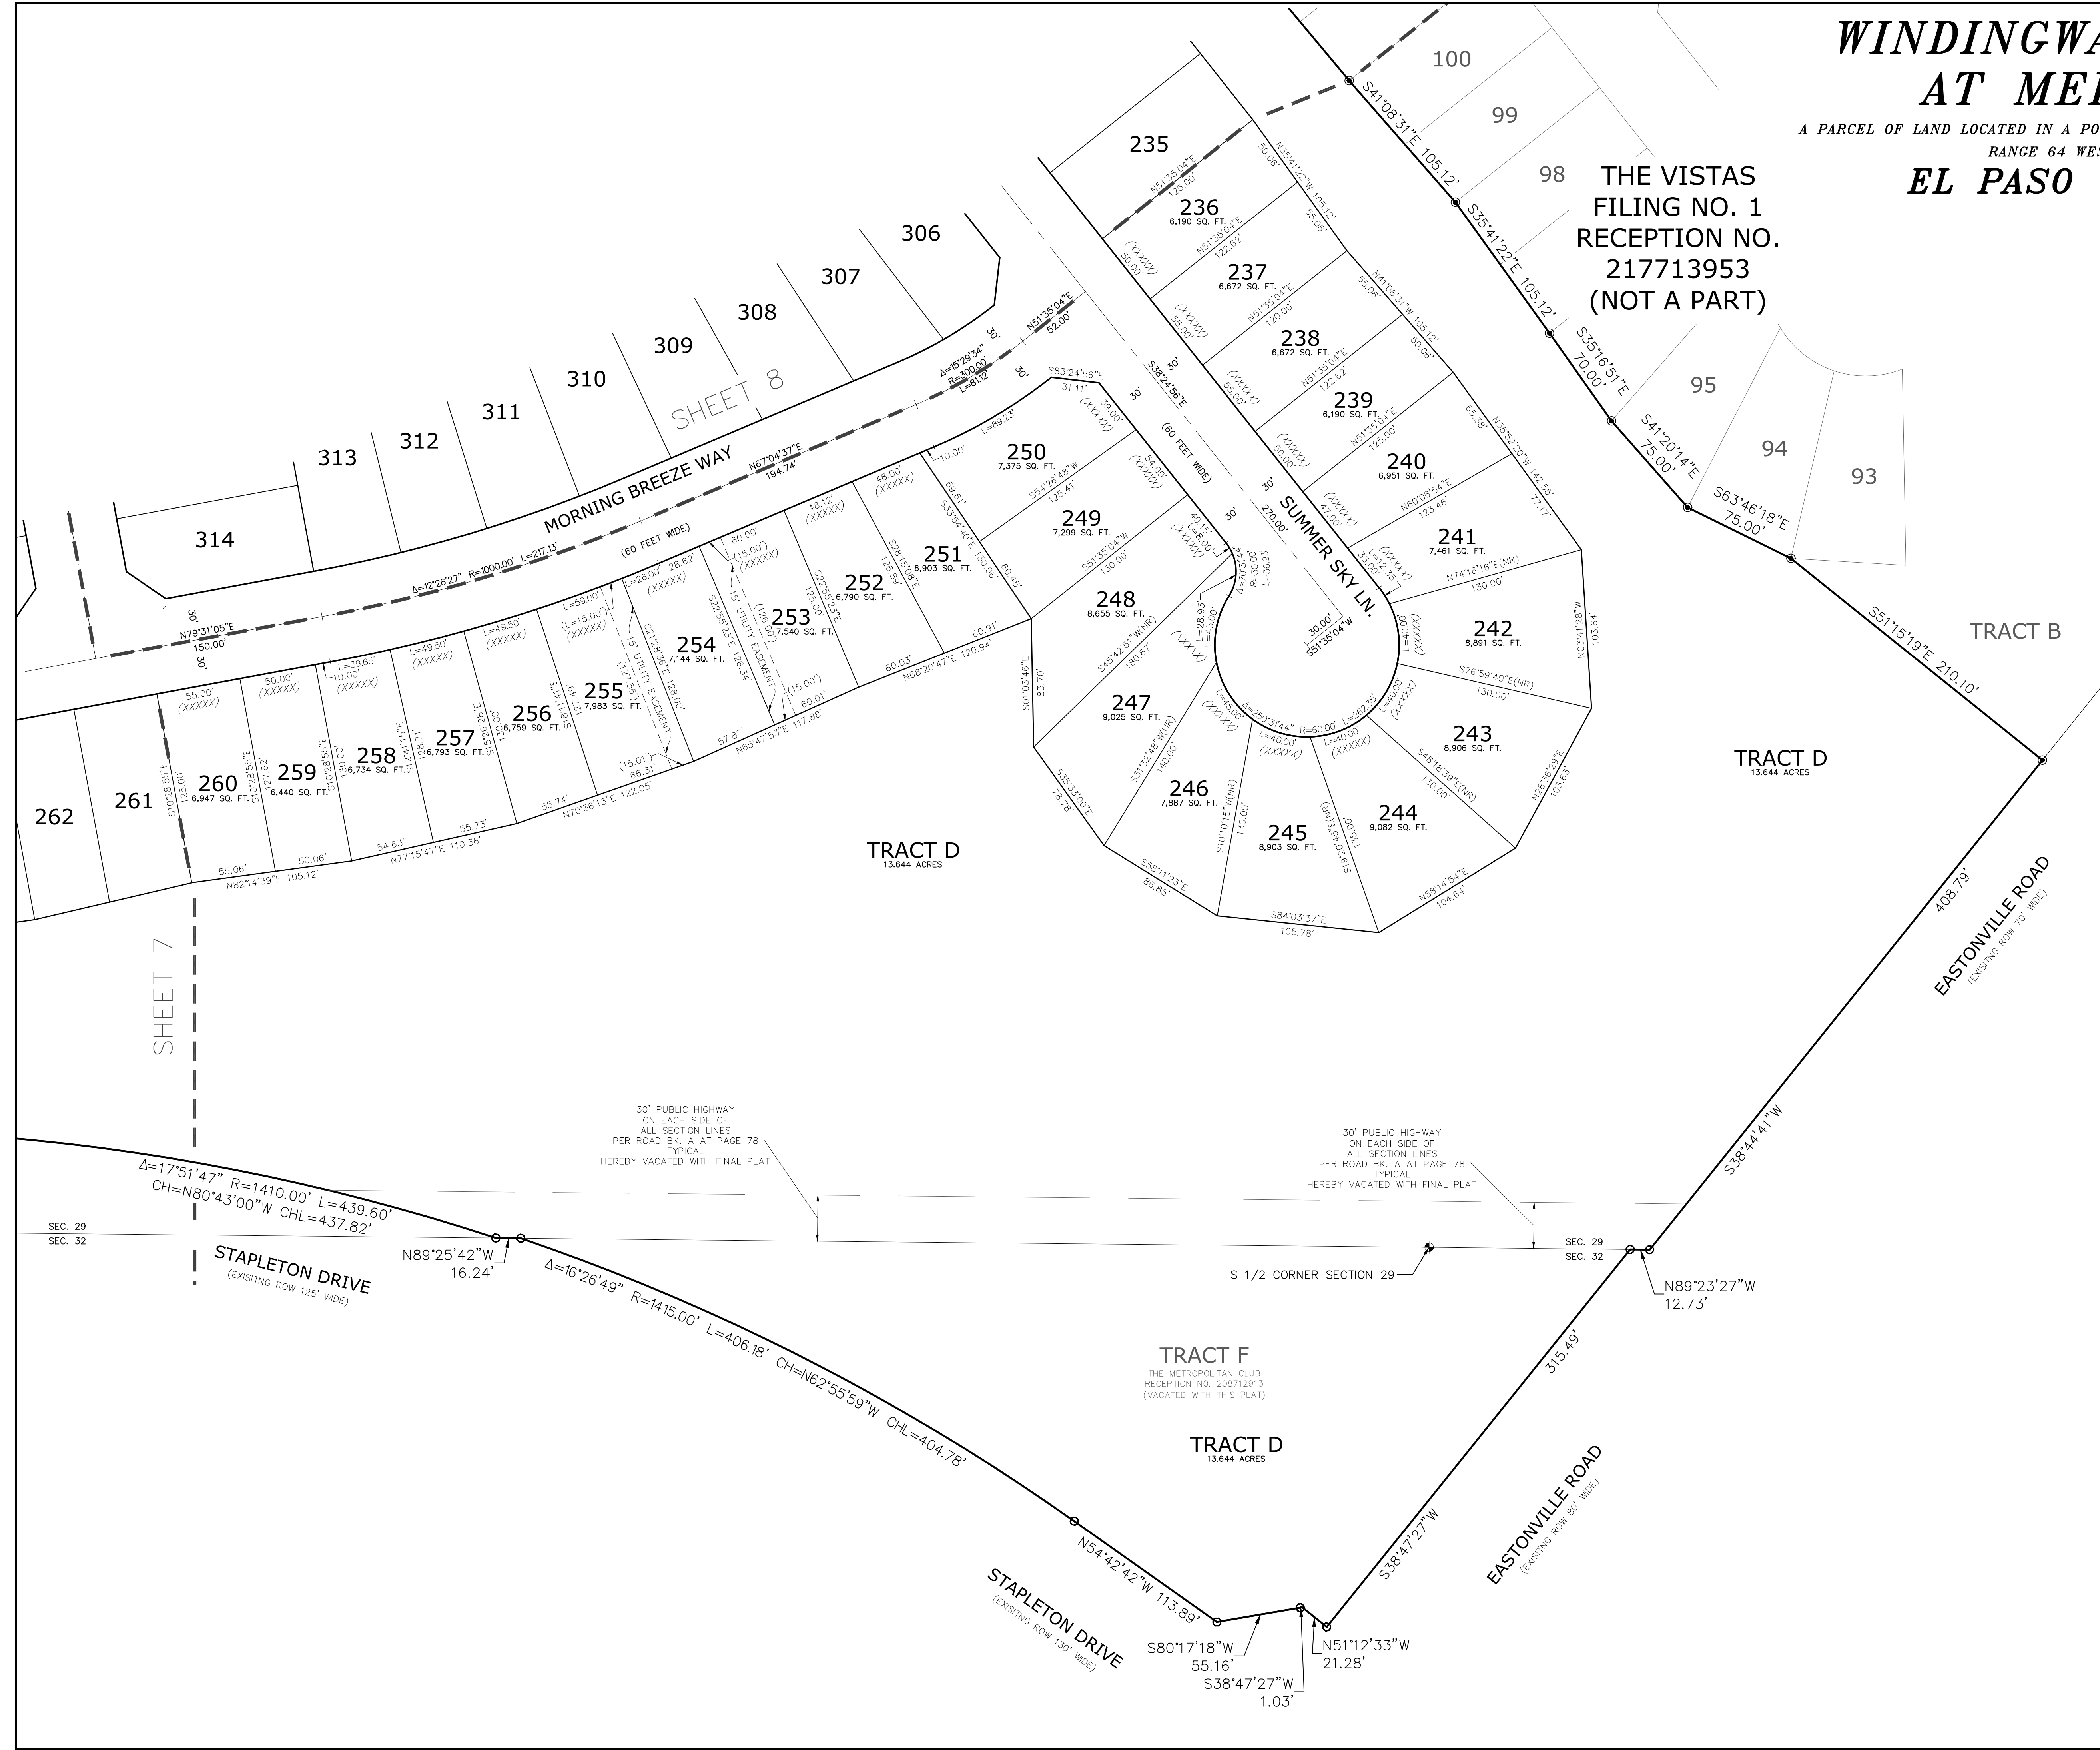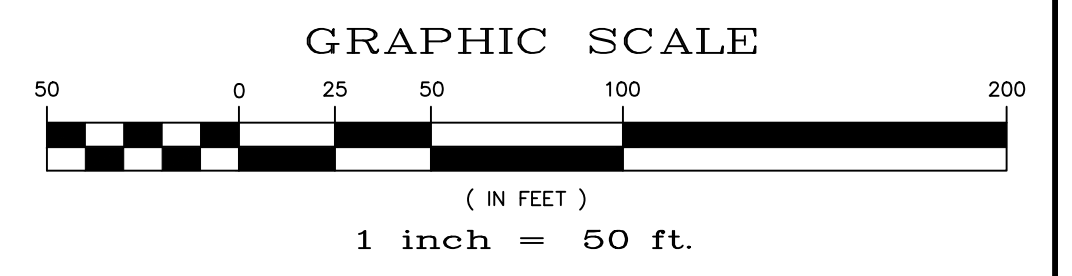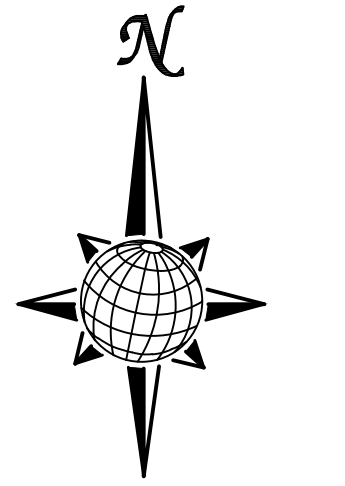

30' PUBLIC HIGHWAY  
ON EACH SIDE OF  
ALL SECTION LINES  
PER ROAD BK. A AT PAGE 78  
TYPICAL  
HEREBY VACATED WITH FINAL PLAT

30' PUBLIC HIGHWAY  
ON EACH SIDE OF  
ALL SECTION LINES  
PER ROAD BK. A AT PAGE 78  
TYPICAL  
HEREBY VACATED WITH FINAL PLAT

**TRACT F**  
THE METROPOLITAN CLUB  
RECEPTION NO. 208712913  
(VACATED WITH THIS PLAT)

**TRACT D**  
13.644 ACRES



Markup Summary

AutoCAD SHX Text (1919)

NOTARY PUBLIC  
MY COMMISSION E:

**Subject:**  
**Page Label:** [1] SHEET 1  
**Lock:** Unlocked  
**Author:** AutoCAD SHX Text

NOTARY PUBLIC



**Subject:**  
**Page Label:** [1] SHEET 1  
**Lock:** Unlocked  
**Author:** AutoCAD SHX Text

HIGHWAY 24

FORM ME THIS DAY OF 20  
NO. OR DTL DEVELOPMENT, INC.  
ADDRESS

**Subject:**  
**Page Label:** [1] SHEET 1  
**Lock:** Unlocked  
**Author:** AutoCAD SHX Text

DATE: DECEMBER 2017
SHEET: 1 OF 9
PCD PROJECT NO. SF- -

**Subject:**  
**Page Label:** [1] SHEET 1  
**Lock:** Unlocked  
**Author:** AutoCAD SHX Text

PCD PROJECT NO. SF- -



**Subject:**  
**Page Label:** [1] SHEET 1  
**Lock:** Unlocked  
**Author:** AutoCAD SHX Text

THE ABOVE OWNER(S) HAVING CAUSED SAID TRACT OF LAND TO BE PLATTED INTO LOTS, TRACTS, STREETS AND EASEMENTS AS SHOWN ON THE PLAT, WHICH SUBDIVISION SHALL BE ENTITLED "WINDINGWALK FILING NO. 1 AT MERIDIAN RANCH", A SUBDIVISION IN EL PASO COUNTY, COLORADO. ALL STREETS PLATTED ARE HEREBY DEDICATED TO PUBLIC USE AND SAID OWNER DOES HEREBY AGREE THAT ALL PLATTED STREETS WILL BE CONSTRUCTED AND PROPER DRAINAGE PROVIDED AT THE OWNER'S EXPENSE AND ALL TO THE SATISFACTION OF THE BOARD OF COUNTY COMMISSIONERS OF EL PASO COUNTY, COLORADO UPON ACCEPTANCE BY RESOLUTION, ALL STREETS SO DEDICATED WILL BECOME MATTERS OF MAINTENANCE BY EL PASO COUNTY, COLORADO WITH THE EXCEPTION OF MEDIANS WHICH WILL BE MAINTAINED BY THE MERIDIAN SERVICE METROPOLITAN DISTRICT.

APPROVALS:  
THE ACCOMPANYING  
EL PASO COUNTY

**Subject:**  
**Page Label:** [1] SHEET 1  
**Lock:** Unlocked  
**Author:** AutoCAD SHX Text

%%UAPPROVALS:

STATE OF COLORADO )  
COUNTY OF EL PASO ) SS  
THIS INSTRUMENT WAS ACKN  
BY RAUL GUZMAN, VICE PRE

**Subject:**  
**Page Label:** [1] SHEET 1  
**Lock:** Unlocked  
**Author:** AutoCAD SHX Text


STATE OF COLORADO )



STATE OF COLORADO )  
COUNTY OF EL PASO ) SS  
THIS INSTRUMENT WAS ACKN  
BY RAUL GUZMAN, VICE PRE

**Subject:**  
**Page Label:** [1] SHEET 1  
**Lock:** Unlocked  
**Author:** AutoCAD SHX Text

COUNTY OF EL PASO )

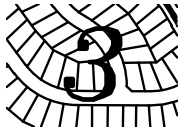

**Subject:**  
**Page Label:** [1] SHEET 1  
**Lock:** Unlocked  
**Author:** AutoCAD SHX Text

3

DIRECTOR OF PLANNING AND COMMUNITY DEVELOPMENT  
COUNTY COMMISSIONERS OF EL PASO COUNTY, COLORADO  
EL PASO COUNTY CLERK AND RECORDER  
BOARD OF COUNTY COMMISSIONERS OF EL PASO COUNTY

**Subject:**  
**Page Label:** [1] SHEET 1  
**Lock:** Unlocked  
**Author:** AutoCAD SHX Text

EL PASO COUNTY CLERK AND RECORDER

ADDRESS

**Subject:**  
**Page Label:** [1] SHEET 1  
**Lock:** Unlocked  
**Author:** AutoCAD SHX Text

ADDRESS



**Subject:**  
**Page Label:** [1] SHEET 1  
**Lock:** Unlocked  
**Author:** AutoCAD SHX Text

5

JAMES F. LENZ  
PROFESSIONAL LAND SURVEYOR IN THE  
STATE OF COLORADO, PLS NO. 34483  
NOTICE: ACCORDING TO COLORADO LAW, YOU  
ACTOR BASED UPON ANY DEFECT IN THIS INSTRUMENT.  
YOU FIRST DISCOVER SUCH DEFECT. IN NO EVENT  
SHALL ANY DEFECT IN THIS INSTRUMENT BE COME  
FROM THE DATE OF CERTIFICATION SHOWN HEREON

**Subject:**  
**Page Label:** [1] SHEET 1  
**Lock:** Unlocked  
**Author:** AutoCAD SHX Text


JAMES F. LENZ PROFESSIONAL LAND  
SURVEYOR IN THE STATE OF COLORADO,  
PLS NO. 34583



**Subject:**  
**Page Label:** [1] SHEET 1  
**Lock:** Unlocked  
**Author:** AutoCAD SHX Text

STAPLETON DRIVE

INDR

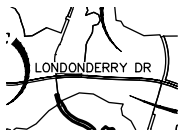

**Subject:**  
**Page Label:** [1] SHEET 1  
**Lock:** Unlocked  
**Author:** AutoCAD SHX Text

LONDONDERRY DR

DATE: DECEMBER 2017  
SHEET: 1 OF 9  
PCD PROJECT NO. SF-\_\_\_

**Subject:**  
**Page Label:** [1] SHEET 1  
**Lock:** Unlocked  
**Author:** AutoCAD SHX Text

DATE: DECEMBER 2017

**FEES:**

**Subject:**  
**Page Label:** [1] SHEET 1  
**Lock:** Unlocked  
**Author:** AutoCAD SHX Text

%%UFEEES:



FALCON HILLS  
FALCON HILLS  
STAPLETON DR

**Subject:**  
**Page Label:** [1] SHEET 1  
**Lock:** Unlocked  
**Author:** AutoCAD SHX Text

FALCON HILLS

STAPLETON DR

**Subject:**  
**Page Label:** [1] SHEET 1  
**Lock:** Unlocked  
**Author:** AutoCAD SHX Text

STAPLETON DR

STATE OF COLORADO )  
COUNTY OF EL PASO ) SS  
I HEREBY CERTIFY THIS IN  
STRUMENT WAS FILED IN MY OFFICE AT  
MIDNIGHT, MARCH 1, 2008.

**Subject:**  
**Page Label:** [1] SHEET 1  
**Lock:** Unlocked  
**Author:** AutoCAD SHX Text

STATE OF COLORADO)

STATE OF COLORADO )  
COUNTY OF EL PASO ) SS  
I HEREBY CERTIFY THIS INSTRUMENT WAS  
FILED FOR RECORD IN MY OFFICE AT \_\_\_\_\_  
O'CLOCK \_\_\_\_\_ M., THIS \_\_\_\_\_ DAY OF \_\_\_\_\_,  
20\_\_\_\_, AND IS DULY RECORDED AT  
RECEPTION NUMBER \_\_\_\_\_ OF  
THE RECORDS OF EL PASO COUNTY,  
COLORADO.

**Subject:**  
**Page Label:** [1] SHEET 1  
**Lock:** Unlocked  
**Author:** AutoCAD SHX Text

I HEREBY CERTIFY THIS INSTRUMENT WAS  
FILED FOR RECORD IN MY OFFICE AT \_\_\_\_\_  
O'CLOCK \_\_\_\_\_ M., THIS \_\_\_\_\_ DAY OF \_\_\_\_\_,  
20\_\_\_\_, AND IS DULY RECORDED AT  
RECEPTION NUMBER \_\_\_\_\_ OF  
THE RECORDS OF EL PASO COUNTY,  
COLORADO.

MERIDIAN SERVICE METROPOLITAN DISTRICT  
BY: MITLON GABRIELSKI, PRESIDENT  
STATE OF COLORADO )  
COUNTY OF EL PASO ) SS  
THIS INSTRUMENT WAS ACKNOWLEDGED BY  
MITLON GABRIELSKI, MERIDIAN SERVICE

**Subject:**  
**Page Label:** [1] SHEET 1  
**Lock:** Unlocked  
**Author:** AutoCAD SHX Text

MITLON GABRIELSKI, PRESIDENT

WINDINGWALK FILING No. 1  
AT MERIDIAN RANCH  
EL PASO COUNTY, COLORADO

**Subject:**  
**Page Label:** [1] SHEET 1  
**Lock:** Unlocked  
**Author:** AutoCAD SHX Text

WINDINGWALK FILING No. 1 AT MERIDIAN  
RANCH

ADDRESS

**Subject:**  
**Page Label:** [1] SHEET 1  
**Lock:** Unlocked  
**Author:** AutoCAD SHX Text

ADDRESS

STATE OF COLORADO )  
COUNTY OF EL PASO ) SS  
I HEREBY CERTIFY THIS INSTRUMENT WAS  
FILED FOR RECORD IN MY OFFICE AT \_\_\_\_\_  
O'CLOCK \_\_\_\_\_ M., THIS \_\_\_\_\_ DAY OF \_\_\_\_\_,  
20\_\_\_\_, AND IS DULY RECORDED AT  
RECEPTION NUMBER \_\_\_\_\_ OF  
THE RECORDS OF EL PASO COUNTY,  
COLORADO.

**Subject:**  
**Page Label:** [1] SHEET 1  
**Lock:** Unlocked  
**Author:** AutoCAD SHX Text

IN WITNESS WHEREOF: GTL, INC. DBA GTL  
DEVELOPMENT, INC., RAUL GUZMAN, VICE  
PRESIDENT HAS CAUSED THESE PRESENTS  
TO BE EXECUTED THIS \_\_\_\_\_ DAY OF  
\_\_\_\_\_, 20\_\_\_\_.

MERIDIAN SERVICE METROPOLITAN DISTRICT  
BY: MITLON GABRIELSKI, PRESIDENT  
STATE OF COLORADO )  
COUNTY OF EL PASO ) SS  
THIS INSTRUMENT WAS ACKNOWLEDGED BY  
MITLON GABRIELSKI, MERIDIAN SERVICE

**Subject:**  
**Page Label:** [1] SHEET 1  
**Lock:** Unlocked  
**Author:** AutoCAD SHX Text

MERIDIAN SERVICE METROPOLITAN DISTRICT

GTL, INC., DBA GTL DEVELOPMENT, INC.


BY: RAUL GUZMAN, VICE PRESIDENT

STATE OF COLORADO )  
cc

**Subject:**  
**Page Label:** [1] SHEET 1  
**Lock:** Unlocked  
**Author:** AutoCAD SHX Text


RAUL GUZMAN, VICE PRESIDENT



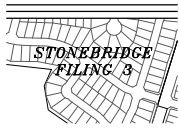

**Subject:**  
**Page Label:** [1] SHEET 1  
**Lock:** Unlocked  
**Author:** AutoCAD SHX Text

STONEBRIDGE FILING 3

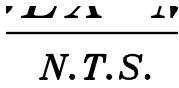


**Subject:**  
**Page Label:** [1] SHEET 1  
**Lock:** Unlocked  
**Author:** AutoCAD SHX Text

N.T.S.



**Subject:**  
**Page Label:** [1] SHEET 1  
**Lock:** Unlocked  
**Author:** AutoCAD SHX Text

4

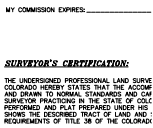

**Subject:**  
**Page Label:** [1] SHEET 1  
**Lock:** Unlocked  
**Author:** AutoCAD SHX Text

%%USURVEYOR'S CERTIFICATION:




**Subject:**  
**Page Label:** [1] SHEET 1  
**Lock:** Unlocked  
**Author:** AutoCAD SHX Text

THE VISTAS FILING 1




**Subject:**  
**Page Label:** [1] SHEET 1  
**Lock:** Unlocked  
**Author:** AutoCAD SHX Text

8

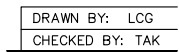

**Subject:**  
**Page Label:** [1] SHEET 1  
**Lock:** Unlocked  
**Author:** AutoCAD SHX Text

DRAWN BY: LCG

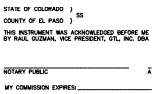

**Subject:**  
**Page Label:** [1] SHEET 1  
**Lock:** Unlocked  
**Author:** AutoCAD SHX Text



**Subject:**  
**Page Label:** [1] SHEET 1  
**Lock:** Unlocked  
**Author:** AutoCAD SHX Text

WOODMEN HILLS



**Subject:**  
**Page Label:** [1] SHEET 1  
**Lock:** Unlocked  
**Author:** AutoCAD SHX Text

SS






Subject:  
Page Label: [1] SHEET 1  
Lock: Unlocked  
Author: AutoCAD SHX Text

2

"INDEMNITY FILING NO. 1 AT MERRIAM BRIDGE"  
WAS APPROVED FOR FILING THIS \_\_\_\_\_ DAY OF \_\_\_\_\_  
\_\_\_\_\_  
DIRECTOR OF PLANNING AND COMMUNITY DEVELOPMENT  
COUNTY COMMISSIONERS OF EL PASO COUNTY, COLORADO,  
EL PASO  
EL PASO COUNTY CLERK AND RECORDER  
\_\_\_\_\_  
BOARD OF COUNTY COMMISSIONERS OF EL PASO COUNTY,  
EL PASO, COLORADO

Subject:  
Page Label: [1] SHEET 1  
Lock: Unlocked  
Author: AutoCAD SHX Text

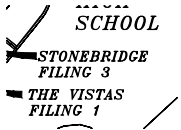

Subject:  
Page Label: [1] SHEET 1  
Lock: Unlocked  
Author: AutoCAD SHX Text

STONEBRIDGE FILING 3

DATE: DECEMBER  
SHEET: 1  
PROJECT NO.

Subject:  
Page Label: [1] SHEET 1  
Lock: Unlocked  
Author: AutoCAD SHX Text

SHEET: 1

STATE OF COLORADO) SS  
COUNTY OF EL PASO) SS  
I HEREBY CERTIFY THIS INSTRUMENT WAS FILED FOR RECORD IN EL PASO COUNTY, COLORADO, ON \_\_\_\_\_ O'CLOCK \_\_\_\_\_ M., 19\_\_\_\_, RECORDED AT RECEPTION EL PASO COUNTY, COLORADO.

Subject:  
Page Label: [1] SHEET 1  
Lock: Unlocked  
Author: AutoCAD SHX Text

COUNTY OF EL PASO)

FILE OF RECORD  
COUNTY OF EL PASO  
I HEREBY CERTIFY THIS INSTRUMENT WAS FILED FOR RECORD IN EL PASO COUNTY, COLORADO, ON \_\_\_\_\_ O'CLOCK \_\_\_\_\_ M., 19\_\_\_\_, RECORDED AT RECEPTION EL PASO COUNTY, COLORADO.

Subject:  
Page Label: [1] SHEET 1  
Lock: Unlocked  
Author: AutoCAD SHX Text

FEE: \_\_\_\_\_  
BY: \_\_\_\_\_

BY: \_\_\_\_\_  
DEPUTY

Subject:  
Page Label: [1] SHEET 1  
Lock: Unlocked  
Author: AutoCAD SHX Text

DEPUTY

DEDICATION:  
THE ABOVE OWNER(S)  
TRAFFIC STREETS A


Subject:  
Page Label: [1] SHEET 1  
Lock: Unlocked  
Author: AutoCAD SHX Text

%%UEDICATION:

"INDEMNITY FILING NO. 1 AT MERRIAM BRIDGE"  
WAS APPROVED FOR FILING THIS \_\_\_\_\_ DAY OF \_\_\_\_\_  
\_\_\_\_\_  
DIRECTOR OF PLANNING AND COMMUNITY DEVELOPMENT  
COUNTY COMMISSIONERS OF EL PASO COUNTY, COLORADO,  
EL PASO  
EL PASO COUNTY CLERK AND RECORDER  
\_\_\_\_\_  
BOARD OF COUNTY COMMISSIONERS OF EL PASO COUNTY,  
EL PASO, COLORADO

Subject:  
Page Label: [1] SHEET 1  
Lock: Unlocked  
Author: AutoCAD SHX Text


DIRECTOR OF PLANNING  
AND COMMUNITY DEVELOPMENT

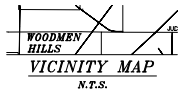

Subject:  
Page Label: [1] SHEET 1  
Lock: Unlocked  
Author: AutoCAD SHX Text


VICINITY MAP



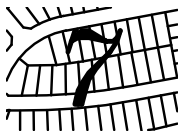


Subject:  
Page Label: [1] SHEET 1  
Lock: Unlocked  
Author: AutoCAD SHX Text

7

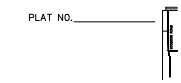


Subject:  
Page Label: [1] SHEET 1  
Lock: Unlocked  
Author: AutoCAD SHX Text

PLAT NO.

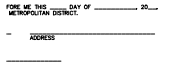

Subject:  
Page Label: [1] SHEET 1  
Lock: Unlocked  
Author: AutoCAD SHX Text

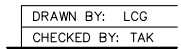

Subject:  
Page Label: [1] SHEET 1  
Lock: Unlocked  
Author: AutoCAD SHX Text

CHECKED BY: TAK



Subject:  
Page Label: [1] SHEET 1  
Lock: Unlocked  
Author: AutoCAD SHX Text

FALCON HIGH SCHOOL




Subject:  
Page Label: [1] SHEET 1  
Lock: Unlocked  
Author: AutoCAD SHX Text

N




Subject:  
Page Label: [1] SHEET 1  
Lock: Unlocked  
Author: AutoCAD SHX Text

APPROVED BY THE PRESIDENT, BOARD OF COUNTY COMMISSIONERS OF EL PASO COUNTY, COLORADO, THIS \_\_\_\_ DAY OF \_\_\_\_\_, 20\_\_.

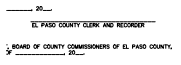


Subject:  
Page Label: [1] SHEET 1  
Lock: Unlocked  
Author: AutoCAD SHX Text

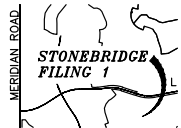

Subject:  
Page Label: [1] SHEET 1  
Lock: Unlocked  
Author: AutoCAD SHX Text


STONEBRIDGE FILING 1

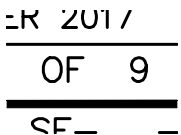

Subject:  
Page Label: [1] SHEET 1  
Lock: Unlocked  
Author: AutoCAD SHX Text

OF 9



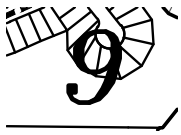

-----  
**Subject:**  
**Page Label:** [1] SHEET 1  
**Lock:** Unlocked  
**Author:** AutoCAD SHX Text





**Subject:**  
**Page Label:** [1] SHEET 1  
**Lock:** Unlocked  
**Author:** AutoCAD SHX Text

KNOW ALL MEN BY THESE PRESENTS: THAT GTL, INC. DBA GTL DEVELOPMENT, INC., THEODORE TCHANG, PRESIDENT AND MERIDIAN SERVICE METROPOLITAN DISTRICT BEING THE OWNERS OF THE FOLLOWING DESCRIBED TRACT OF LAND: A PARCEL OF LAND LOCATED IN A PORTIONS OF SECTION 29, 30, AND 32, IN TOWNSHIP 12 SOUTH, RANGE 64 WEST OF THE 6TH PRINCIPAL MERIDIAN, INCLUDING ALL OF TRACT F OF THE METROPOLITAN CLUB RECORDED WITH RECEPTION NO. 208712913 IN THE RECORDS OF EL PASO COUNTY, COLORADO, MORE PARTICULARLY DESCRIBED AS FOLLOWS: BEGINNING AT A POINT ON THE SOUTHERN MOST CORNER OF TRACT D OF STONEBRIDGE FILING NO. 1 AT MERIDIAN RANCH, RECORDED WITH RECEPTION NO. 215713582 IN THE RECORDS OF EL PASO COUNTY; THE FOLLOWING COURSE IS ON SAID SOUTHERLY LINE OF TRACT D: 1. THENCE N76°25'11"E A DISTANCE OF 375.00 FEET; THENCE N76°25'11"E A DISTANCE OF 375.00 FEET; 2. THENCE S78°55'18"E A DISTANCE OF 200.00 FEET; THENCE S78°55'18"E A DISTANCE OF 200.00 FEET; 3. THENCE S38°44'01"E A DISTANCE OF 300.00 FEET; THENCE S38°44'01"E A DISTANCE OF 300.00 FEET; 4. THENCE S86°37'24"E A DISTANCE OF 475.00 FEET; THENCE S86°37'24"E A DISTANCE OF 475.00 FEET; 5. THENCE N79°31'13"E A DISTANCE OF 400.00 FEET; THENCE N79°31'13"E A DISTANCE OF 400.00 FEET; 6. THENCE N64°36'19"E A DISTANCE OF 400.00 FEET; THENCE N64°36'19"E A DISTANCE OF 400.00 FEET; 7. THENCE N82°25'21"E A DISTANCE OF 800.00 FEET; THENCE N82°25'21"E A DISTANCE OF 800.00 FEET; 8. THENCE N20°23'46"W A DISTANCE OF 350.00 FEET; THENCE N20°23'46"W A DISTANCE OF 350.00 FEET; 9. THENCE N58°13'49"W A DISTANCE OF 206.93 FEET; THENCE N58°13'49"W A DISTANCE OF 206.93 FEET; 10. THENCE N68°53'37"W A DISTANCE OF 140.36 FEET; THENCE N68°53'37"W A DISTANCE OF 140.36 FEET; 11. THENCE N65°03'17"W A DISTANCE OF 145.00 FEET; THENCE N65°03'17"W A DISTANCE OF 145.00 FEET; 12. THENCE N60°08'41"W A DISTANCE OF 60.00 FEET; THENCE N60°08'41"W A DISTANCE OF 60.00 FEET; 13. THENCE N54°59'06"W A DISTANCE OF 123.00 FEET; THENCE N54°59'06"W A DISTANCE OF 123.00 FEET; 14. THENCE N49°16'15"W A DISTANCE OF 58.53 FEET; THENCE N49°16'15"W A DISTANCE OF 58.53 FEET; 15. THENCE N46°40'09"W A DISTANCE OF 60.00 FEET; THENCE N46°40'09"W A DISTANCE OF 60.00 FEET; 16. THENCE N44 59'01"W A DISTANCE OF 59.00 FEET; THENCE N44°59'01"W A DISTANCE OF 59.00 FEET; 17. THENCE N38°56'54"W A DISTANCE OF 123.00 FEET; THENCE N38°56'54"W A DISTANCE OF 123.00 FEET; 18. THENCE N33°47'19"W A DISTANCE OF 60.00 FEET; THENCE N33°47'19"W A DISTANCE OF 60.00 FEET; 19. THENCE N12°21'07"E A DISTANCE OF 8.00 FEET; THENCE N12°21'07"E A DISTANCE OF 8.00 FEET; 20. THENCE N31 45'35"W A DISTANCE OF 134.54 FEET TO A POINT ON THE THENCE N31°45'35"W A DISTANCE OF



STATE OF CALIFORNIA )  
COUNTY OF EL PASO )  
BY \_\_\_\_\_, VICE PRESIDENT, FOR AND ON BEHALF OF \_\_\_\_\_ )  
COUNTY CLERK )  
BY \_\_\_\_\_ )

**Subject:**  
**Page Label:** [1] SHEET 1  
**Lock:** Unlocked  
**Author:** AutoCAD SHX Text

MY COMMISSION  
EXPIRES: \_\_\_\_\_

\*\*\*\*\* PRINT \*\*\*\*\*

RECEIPT NO: \_\_\_\_\_  
PLAT FEE: \_\_\_\_\_  
SURCHARGE: \_\_\_\_\_  
SCHOOL: \_\_\_\_\_  
PARK: \_\_\_\_\_  
BRIDGE: \_\_\_\_\_  
DRAINAGE: \_\_\_\_\_

**Subject:**  
**Page Label:** [1] SHEET 1  
**Lock:** Unlocked  
**Author:** AutoCAD SHX Text

RECEIPT NO: \_\_\_\_\_ PLAT FEE: \_\_\_\_\_  
SURCHARGE: \_\_\_\_\_  
SCHOOL: \_\_\_\_\_  
PARK: \_\_\_\_\_  
BRIDGE: \_\_\_\_\_ DRAINAGE: \_\_\_\_\_

***PAINT  
BRUSH  
HILLS***

**Subject:**  
**Page Label:** [1] SHEET 1  
**Lock:** Unlocked  
**Author:** AutoCAD SHX Text

PAINT BRUSH HILLS

STATE OF CALIFORNIA )  
COUNTY OF EL PASO )  
BY \_\_\_\_\_, VICE PRESIDENT, FOR AND ON BEHALF OF \_\_\_\_\_ )  
COUNTY CLERK )  
BY \_\_\_\_\_ )

**Subject:**  
**Page Label:** [1] SHEET 1  
**Lock:** Unlocked  
**Author:** AutoCAD SHX Text

THIS INSTRUMENT WAS ACKNOWLEDGED  
BEFORE ME THIS \_\_\_\_ DAY OF \_\_\_\_\_,  
20\_\_, BY RAUL GUZMAN, VICE PRESIDENT,  
GTL, INC. DBA GTL DEVELOPMENT, INC.



**Subject:**  
**Page Label:** [1] SHEET 1  
**Lock:** Unlocked  
**Author:** AutoCAD SHX Text

KNOW ALL MEN BY THESE PRESENTS: THAT  
GTL, INC. DBA GTL DEVELOPMENT, INC.,  
THEODORE TCHANG, PRESIDENT AND  
MERIDIAN SERVICE METROPOLITAN DISTRICT  
BEING THE OWNERS OF THE FOLLOWING  
DESCRIBED TRACT OF LAND: A PARCEL OF  
LAND LOCATED IN A PORTIONS OF SECTION  
29, 30, AND 32, IN TOWNSHIP 12 SOUTH,  
RANGE 64 WEST OF THE 6TH PRINCIPAL  
MERIDIAN, INCLUDING ALL OF TRACT F OF  
THE METROPOLITAN CLUB RECORDED WITH  
RECEPTION NO. 208712913 IN THE RECORDS  
OF EL PASO COUNTY, COLORADO, MORE  
PARTICULARLY DESCRIBED AS FOLLOWS:  
BEGINNING AT A POINT ON THE SOUTHERN  
MOST CORNER OF TRACT D OF  
STONEBRIDGE FILING NO. 1 AT MERIDIAN  
RANCH, RECORDED WITH RECEPTION NO.  
215713582 IN THE RECORDS OF EL PASO  
COUNTY; THE FOLLOWING COURSE IS ON  
SAID SOUTHERLY LINE OF TRACT D: 1.  
THENCE N76°25'11"E A DISTANCE OF 375.00  
FEET; THENCE N76°25'11"E A DISTANCE OF  
375.00 FEET; 2. THENCE S78°55'18"E A  
DISTANCE OF 200.00 FEET; THENCE  
S78°55'18"E A DISTANCE OF 200.00 FEET; 3.  
THENCE S38°44'01"E A DISTANCE OF 300.00  
FEET; THENCE S38°44'01"E A DISTANCE OF  
300.00 FEET; 4. THENCE S86°37'24"E A  
DISTANCE OF 475.00 FEET; THENCE  
S86°37'24"E A DISTANCE OF 475.00 FEET; 5.  
THENCE N79°31'13"E A DISTANCE OF 400.00  
FEET; THENCE N79°31'13"E A DISTANCE OF  
400.00 FEET; 6. THENCE N64°36'19"E A  
DISTANCE OF 400.00 FEET; THENCE  
N64°36'19"E A DISTANCE OF 400.00 FEET; 7.  
THENCE N82°25'21"E A DISTANCE OF 800.00  
FEET; THENCE N82°25'21"E A DISTANCE OF  
800.00 FEET; 8. THENCE N20°23'46"W A  
DISTANCE OF 350.00 FEET; THENCE  
N20°23'46"W A DISTANCE OF 350.00 FEET; 9.  
THENCE N58°13'49"W A DISTANCE OF 206.93  
FEET; THENCE N58°13'49"W A DISTANCE OF  
206.93 FEET; 10. THENCE N68°53'37"W A  
DISTANCE OF 140.36 FEET; THENCE  
N68°53'37"W A DISTANCE OF 140.36 FEET; 11.  
THENCE N65°03'17"W A DISTANCE OF 145.00  
FEET; THENCE N65°03'17"W A DISTANCE OF  
145.00 FEET; 12. THENCE N60°08'41"W A  
DISTANCE OF 60.00 FEET; THENCE  
N60°08'41"W A DISTANCE OF 60.00 FEET; 13.  
THENCE N54°59'06"W A DISTANCE OF 123.00  
FEET; THENCE N54°59'06"W A DISTANCE OF  
123.00 FEET; 14. THENCE N49°16'15"W A  
DISTANCE OF 58.53 FEET; THENCE  
N49°16'15"W A DISTANCE OF 58.53 FEET; 15.  
THENCE N46°40'09"W A DISTANCE OF 60.00  
FEET; THENCE N46°40'09"W A DISTANCE OF  
60.00 FEET; 16. THENCE N44 59'01"W A  
DISTANCE OF 59.00 FEET; THENCE  
N44°59'01"W A DISTANCE OF 59.00 FEET; 17.  
THENCE N38°56'54"W A DISTANCE OF 123.00  
FEET; THENCE N38°56'54"W A DISTANCE OF  
123.00 FEET; 18. THENCE N33°47'19"W A  
DISTANCE OF 60.00 FEET; THENCE  
N33°47'19"W A DISTANCE OF 60.00 FEET; 19.  
THENCE N12°21'07"E A DISTANCE OF 8.00  
FEET; THENCE N12°21'07"E A DISTANCE OF  
8.00 FEET; 20. THENCE N31 45'35"W A  
DISTANCE OF 134.54 FEET TO A POINT ON  
THE THENCE N31°45'35"W A DISTANCE OF



STATE OF COLORADO )  
COUNTY OF EL PASO ) SS  
THIS INSTRUMENT WAS ACKNOWLEDGED BEFORE ME  
BY WALTON GAMBRELL, MERIDIAN SERVICE METROCO,  
NOTARY PUBLIC: \_\_\_\_\_ R  
BY COMMISSION EXPIRES: \_\_\_\_\_

**Subject:**  
**Page Label:** [1] SHEET 1  
**Lock:** Unlocked  
**Author:** AutoCAD SHX Text



**INDEX MAP**  
N.T.S.

**Subject:**  
**Page Label:** [1] SHEET 1  
**Lock:** Unlocked  
**Author:** AutoCAD SHX Text

INDEX MAP




IN WITNESS WHEREOF,  
GTL, INC., DBA GTL DEVELOPMENT, INC., RAUL,  
CAUSED THESE PRESENTS TO BE EXECUTED IN  
BY:  
GTL, INC., DBA GTL DEVELOPMENT, INC.  
BY: RAUL GUTMAN, VICE PRESIDENT

**Subject:**  
**Page Label:** [1] SHEET 1  
**Lock:** Unlocked  
**Author:** AutoCAD SHX Text

WOODMEN HILLS


**Subject:**  
**Page Label:** [1] SHEET 1  
**Lock:** Unlocked  
**Author:** AutoCAD SHX Text

GTL, INC., DBA GTL DEVELOPMENT, INC.

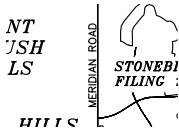

**Subject:**  
**Page Label:** [1] SHEET 1  
**Lock:** Unlocked  
**Author:** AutoCAD SHX Text

MERIDIAN ROAD

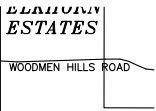

**Subject:**  
**Page Label:** [1] SHEET 1  
**Lock:** Unlocked  
**Author:** AutoCAD SHX Text

WOODMEN HILLS ROAD



**Subject:**  
**Page Label:** [1] SHEET 1  
**Lock:** Unlocked  
**Author:** AutoCAD SHX Text

LATIGO TRAILS




**Subject:**  
**Page Label:** [1] SHEET 1  
**Lock:** Unlocked  
**Author:** AutoCAD SHX Text

EL PASO COUNTY, COLORADO.



**Subject:**  
**Page Label:** [1] SHEET 1  
**Lock:** Unlocked  
**Author:** AutoCAD SHX Text

SS

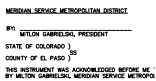

**Subject:**  
**Page Label:** [1] SHEET 1  
**Lock:** Unlocked  
**Author:** AutoCAD SHX Text

BY:



**Subject:**  
**Page Label:** [1] SHEET 1  
**Lock:** Unlocked  
**Author:** AutoCAD SHX Text

A PARCEL OF LAND LOCATED IN A PORTION OF SECTION 29, 30, AND 32 IN TOWNSHIP 12 SOUTH, RANGE 64 WEST OF THE 6TH PRINCIPAL MERIDIAN



**Subject:**  
**Page Label:** [1] SHEET 1  
**Lock:** Unlocked  
**Author:** AutoCAD SHX Text

EASTONVILLE ROAD



**Subject:**  
**Page Label:** [1] SHEET 1  
**Lock:** Unlocked  
**Author:** AutoCAD SHX Text

THE UNDERSIGNED PROFESSIONAL LAND SURVEYOR IN THE STATE OF COLORADO HEREBY STATES THAT THE ACCOMPANYING PLAT WAS SURVEYED AND DRAWN TO NORMAL STANDARDS AND CARE OF A PROFESSIONAL LAND SURVEYOR PRACTICING IN THE STATE OF COLORADO. THE SURVEY WAS PERFORMED AND PLAT PREPARED UNDER HIS SUPERVISION AND ACCURATELY SHOWS THE DESCRIBED TRACT OF LAND AND SUBDIVISION THEREOF, AND THE REQUIREMENTS OF TITLE 38 OF THE COLORADO REVISED STATUTES, 1973, AS AMENDED, HAVE BEEN MET TO THE BEST OF HIS KNOWLEDGE, INFORMATION AND BELIEF.





**Subject:**  
**Page Label:** [1] SHEET 1  
**Lock:** Unlocked  
**Author:** AutoCAD SHX Text

NOTES: 1) BASIS OF BEARINGS FOR THIS DESCRIPTION IS THE NORTH LINE OF THE NORTHWEST QUARTER OF SECTION BASIS OF BEARINGS FOR THIS DESCRIPTION IS THE NORTH LINE OF THE NORTHWEST QUARTER OF SECTION 19, T12S, R64W OF THE 6TH P.M., WHICH IS ASSUMED TO BEAR S89°18'12"E FROM THE NORTHWEST CORNER OF SECTION 19 ((2) REFERENCE MONUMENTS PLS 24964) TO THE NORTH QUARTER CORNER OF SECTION 19 (3.25" ALUM. CAP PLS 24964). 2) THERE SHALL BE NO VEHICULAR ACCESS FROM ANY RESIDENTIAL LOT IN THIS SUBDIVISION TO LAMBERT THERE SHALL BE NO VEHICULAR ACCESS FROM ANY RESIDENTIAL LOT IN THIS SUBDIVISION TO LAMBERT BE NO VEHICULAR ACCESS FROM ANY RESIDENTIAL LOT IN THIS SUBDIVISION TO LAMBERT NO VEHICULAR ACCESS FROM ANY RESIDENTIAL LOT IN THIS SUBDIVISION TO LAMBERT VEHICULAR ACCESS FROM ANY RESIDENTIAL LOT IN THIS SUBDIVISION TO LAMBERT FROM ANY RESIDENTIAL LOT IN THIS SUBDIVISION TO LAMBERT ANY RESIDENTIAL LOT IN THIS SUBDIVISION TO LAMBERT RESIDENTIAL LOT IN THIS SUBDIVISION TO LAMBERT ROAD, STAPLETON DRIVE, OR RAINBOW BRIDGE DRIVE. 3) ALL LOT LINES ADJACENT TO STREETS ARE HEREBY PLATTED WITH A 10 FOOT EASEMENT FOR PUBLIC ALL LOT LINES ADJACENT TO STREETS ARE HEREBY PLATTED WITH A 10 FOOT EASEMENT FOR PUBLIC UTILITIES AND DRAINAGE PURPOSES. THE ENTIRE AREA OF THESE EASEMENTS ARE HEREBY RESERVED FOR UTILITY PURPOSES, WITH MERIDIAN SERVICE METROPOLITAN DISTRICT AND GTL, INC., DBA GTL DEVELOPMENT, INC. RESERVING THE RIGHT TO PERMIT ANY SUCH UTILITIES. THE SOLE RESPONSIBILITY FOR MAINTENANCE OF THESE EASEMENTS IS VESTED WITH THE INDIVIDUAL PROPERTY OWNERS. 4) UNLESS OTHERWISE SHOWN, ALL SIDE LOT LINES ARE HEREBY PLATTED WITH A 5 FOOT PUBLIC UTILITY AND UNLESS OTHERWISE SHOWN, ALL SIDE LOT LINES ARE HEREBY PLATTED WITH A 5 FOOT PUBLIC UTILITY AND DRAINAGE EASEMENT AND ALL REAR LOT LINES ARE HEREBY PLATTED WITH A 7.5 FOOT PUBLIC UTILITY AND DRAINAGE EASEMENT. THE SOLE RESPONSIBILITY FOR MAINTENANCE OF THESE EASEMENTS IS VESTED WITH THE INDIVIDUAL PROPERTY OWNERS. 5) ALL STRUCTURAL FOUNDATIONS SHALL BE LOCATED AND DESIGNED BY A PROFESSIONAL ENGINEER, ALL STRUCTURAL FOUNDATIONS SHALL BE LOCATED AND DESIGNED BY A PROFESSIONAL ENGINEER, CURRENTLY REGISTERED IN THE STATE OF COLORADO. 6) THE WATER AND SEWER PROVIDER SHALL BE MERIDIAN SERVICE METROPOLITAN DISTRICT. THE WATER AND SEWER PROVIDER SHALL BE MERIDIAN SERVICE METROPOLITAN DISTRICT. 7) NO STRUCTURES OR MATERIAL STORAGE ACTIVITIES ARE PERMITTED WITHIN THE DESIGNATED DRAINAGE NO STRUCTURES OR MATERIAL STORAGE ACTIVITIES ARE PERMITTED WITHIN THE DESIGNATED DRAINAGE EASEMENTS OR NO-BUILD ZONES.

**N.T.S.**


**Subject:**  
**Page Label:** [1] SHEET 1  
**Lock:** Unlocked  
**Author:** AutoCAD SHX Text

N.T.S.

BY: MITLON GABRIELSKI, P  
STATE OF COLORADO )  
COUNTY OF EL PASO )  
THIS INSTRUMENT WAS ACK  
BY MITLON GABRIELSKI, MEI


**Subject:**  
**Page Label:** [1] SHEET 1  
**Lock:** Unlocked  
**Author:** AutoCAD SHX Text

STATE OF COLORADO )

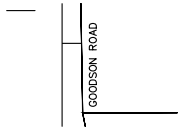


**Subject:**  
**Page Label:** [1] SHEET 1  
**Lock:** Unlocked  
**Author:** AutoCAD SHX Text

GOODSON ROAD

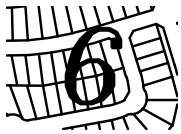

**Subject:**  
**Page Label:** [1] SHEET 1  
**Lock:** Unlocked  
**Author:** AutoCAD SHX Text

6

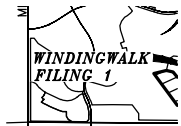

**Subject:**  
**Page Label:** [1] SHEET 1  
**Lock:** Unlocked  
**Author:** AutoCAD SHX Text

WINDINGWALK FILING 1

EL PASO COUNTY CLERK AND RECORDER  
STATE OF COLORADO  
COUNTY OF EL PASO, COLORADO

**Subject:**  
**Page Label:** [1] SHEET 1  
**Lock:** Unlocked  
**Author:** AutoCAD SHX Text

\_\_\_\_\_



**Subject:**  
**Page Label:** [1] SHEET 1  
**Lock:** Unlocked  
**Author:** AutoCAD SHX Text

ELKHORN ESTATES

EL PASO COUNTY CLERK AND RECORDER  
STATE OF COLORADO  
COUNTY OF EL PASO, COLORADO


**Subject:**  
**Page Label:** [1] SHEET 1  
**Lock:** Unlocked  
**Author:** AutoCAD SHX Text

APPROVED BY THE BOARD OF COUNTY  
COMMISSIONERS OF EL PASO COUNTY,  
COLORADO, THIS \_\_\_\_ DAY OF \_\_\_\_\_,  
20\_\_.



**Subject:**  
**Page Label:** [1] SHEET 1  
**Lock:** Unlocked  
**Author:** AutoCAD SHX Text

THE VISTAS FILING 1

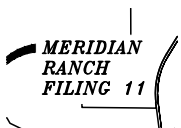

**Subject:**  
**Page Label:** [1] SHEET 1  
**Lock:** Unlocked  
**Author:** AutoCAD SHX Text

MERIDIAN RANCH FILING 11






**Subject:**  
**Page Label:** [1] SHEET 1  
**Lock:** Unlocked  
**Author:** AutoCAD SHX Text

N

BY: MILTON GABRIELSKI, P  
STATE OF COLORADO )  
COUNTY OF EL PASO ) SS  
THIS INSTRUMENT WAS ACK  
BY MILTON GABRIELSKI, MEI

**Subject:**  
**Page Label:** [1] SHEET 1  
**Lock:** Unlocked  
**Author:** AutoCAD SHX Text

COUNTY OF EL PASO )

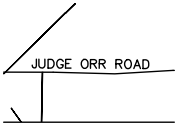

**Subject:**  
**Page Label:** [1] SHEET 1  
**Lock:** Unlocked  
**Author:** AutoCAD SHX Text

JUDGE ORR ROAD



**Subject:**  
**Page Label:** [1] SHEET 1  
**Lock:** Unlocked  
**Author:** AutoCAD SHX Text

REX ROAD

SS

**Subject:**  
**Page Label:** [1] SHEET 1  
**Lock:** Unlocked  
**Author:** AutoCAD SHX Text

SS

NOTICE: ACCORDING TO COLORADO LAW, YOU MUST COMMENCE ANY LEGAL ACTION BASED UPON ANY DEFECT IN THIS SURVEY WITHIN THREE YEARS AFTER YOU FIRST DISCOVER SUCH DEFECT. IN NO EVENT, MAY ANY ACTION BASED UPON ANY DEFECT IN THIS SURVEY BE COMMENCED MORE THAN TEN YEARS FROM THE DATE OF CERTIFICATION SHOWN HEREON.

**Subject:**  
**Page Label:** [1] SHEET 1  
**Lock:** Unlocked  
**Author:** AutoCAD SHX Text

NOTICE: ACCORDING TO COLORADO LAW, YOU MUST COMMENCE ANY LEGAL ACTION BASED UPON ANY DEFECT IN THIS SURVEY WITHIN THREE YEARS AFTER YOU FIRST DISCOVER SUCH DEFECT. IN NO EVENT, MAY ANY ACTION BASED UPON ANY DEFECT IN THIS SURVEY BE COMMENCED MORE THAN TEN YEARS FROM THE DATE OF CERTIFICATION SHOWN HEREON.

THE ACCOMPANYING PLAT OF "WINDINGWALK FILING NO. 1 AT MERIDIAN RANCH", EL PASO COUNTY, COLORADO, WAS APPROVED FOR FILING THIS \_\_\_\_ DAY OF \_\_\_\_\_, 20\_\_.

**Subject:**  
**Page Label:** [1] SHEET 1  
**Lock:** Unlocked  
**Author:** AutoCAD SHX Text

THE ACCOMPANYING PLAT OF "WINDINGWALK FILING NO. 1 AT MERIDIAN RANCH", EL PASO COUNTY, COLORADO, WAS APPROVED FOR FILING THIS \_\_\_\_ DAY OF \_\_\_\_\_, 20\_\_.

BY: RAUL SUZMAN, VICE PRESIDENT  
STATE OF COLORADO )  
COUNTY OF EL PASO ) SS

**Subject:**  
**Page Label:** [1] SHEET 1  
**Lock:** Unlocked  
**Author:** AutoCAD SHX Text

BY:



**Subject:**  
**Page Label:** [1] SHEET 1  
**Lock:** Unlocked  
**Author:** AutoCAD SHX Text

STONEBRIDGE FILING 1

MY COMMISSION EXPIRES: \_\_\_\_\_  
STATE OF COLORADO )  
COUNTY OF EL PASO ) SS

**Subject:**  
**Page Label:** [1] SHEET 1  
**Lock:** Unlocked  
**Author:** AutoCAD SHX Text

MY COMMISSION EXPIRES: \_\_\_\_\_

NOTARY PUBLIC

MY COMMISSION EX

**Subject:**  
**Page Label:** [1] SHEET 1  
**Lock:** Unlocked  
**Author:** AutoCAD SHX Text

NOTARY PUBLIC

INDEX MAP  
K252

**LEGAL DESCRIPTION**  
SHOW ALL SIDES OF THIS PARCEL.  
THAT 271, INC. HAS DEVELOPED, INC. THROUGH  
AND HAD TO BE METROPLAN DISTRICT BEING  
FOLLOWING DESCRIBED TRACT OF LAND:  
  
A PARCEL OF LAND LOCATED IN A PORTION OF SECT  
24 TOWNSHIP 12 SOUTH RANGE 44 WEST OF THE 6TH  
RANGE 64 OF TWP. 12 OF THE METROPOLITAN DISTRICT

**Subject:**  
**Page Label:** [1] SHEET 1  
**Lock:** Unlocked  
**Author:** AutoCAD SHX Text

%%ULEGAL DESCRIPTION:



**Subject:**  
**Page Label:** [1] SHEET 1  
**Lock:** Unlocked  
**Author:** AutoCAD SHX Text

THIS INSTRUMENT WAS ACKNOWLEDGED  
BEFORE ME THIS \_\_\_\_ DAY OF \_\_\_\_\_,  
20\_\_, BY MILTON GABRIELSKI, MERIDIAN  
SERVICE METROPOLITAN DISTRICT.

(XXXXX)  
L=67.49'

**Subject:**  
**Page Label:** [1] SHEET 2  
**Lock:** Unlocked  
**Author:** AutoCAD SHX Text

(XXXXX)

NR

**Subject:**  
**Page Label:** [1] SHEET 2  
**Lock:** Unlocked  
**Author:** AutoCAD SHX Text

NR



**Subject:**  
**Page Label:** [1] SHEET 2  
**Lock:** Unlocked  
**Author:** AutoCAD SHX Text

THE VISTAS FILING 1

184

**Subject:**  
**Page Label:** [1] SHEET 2  
**Lock:** Unlocked  
**Author:** AutoCAD SHX Text

7,546 SQ. FT.

171

**Subject:**  
**Page Label:** [1] SHEET 2  
**Lock:** Unlocked  
**Author:** AutoCAD SHX Text

7,800 SQ. FT.

(XXXXX)  
L=52.00'  
(XXXXX) 5.00'

**Subject:**  
**Page Label:** [1] SHEET 2  
**Lock:** Unlocked  
**Author:** AutoCAD SHX Text

(XXXXX)

**Subject:**  
**Page Label:** [1] SHEET 2  
**Lock:** Unlocked  
**Author:** AutoCAD SHX Text

(XXXXX)



172

**Subject:**  
**Page Label:** [1] SHEET 2  
**Lock:** Unlocked  
**Author:** AutoCAD SHX Text

7,800 SQ. FT.

**Subject:**  
**Page Label:** [1] SHEET 2  
**Lock:** Unlocked  
**Author:** AutoCAD SHX Text

(XXXXXX)

61  
8,426 SQ. FT.

**Subject:**  
**Page Label:** [1] SHEET 2  
**Lock:** Unlocked  
**Author:** AutoCAD SHX Text

8,426 SQ. FT.

(HHHH)  
65.00'

**Subject:**  
**Page Label:** [1] SHEET 2  
**Lock:** Unlocked  
**Author:** AutoCAD SHX Text

(XXXXXX)

59  
8,290 SQ. FT.

**Subject:**  
**Page Label:** [1] SHEET 2  
**Lock:** Unlocked  
**Author:** AutoCAD SHX Text

8,290 SQ. FT.

63.00'  
(HHHH)

**Subject:**  
**Page Label:** [1] SHEET 2  
**Lock:** Unlocked  
**Author:** AutoCAD SHX Text

(XXXXXX)

5'47" R=450.00  
(60 FEET WIDE)  
L=87.00'

**Subject:**  
**Page Label:** [1] SHEET 2  
**Lock:** Unlocked  
**Author:** AutoCAD SHX Text

(60 FEET WIDE)

15.12'

**Subject:**  
**Page Label:** [1] SHEET 2  
**Lock:** Unlocked  
**Author:** AutoCAD SHX Text

15.12'

158


**Subject:**  
**Page Label:** [1] SHEET 2  
**Lock:** Unlocked  
**Author:** AutoCAD SHX Text

7,350 SQ. FT.

210

**Subject:**  
**Page Label:** [1] SHEET 2  
**Lock:** Unlocked  
**Author:** AutoCAD SHX Text

8,534 SQ. FT.

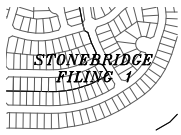

**Subject:** STONEBRIDGE FILING 1  
**Page Label:** [1] SHEET 2  
**Lock:** Unlocked  
**Author:** AutoCAD SHX Text

50

**Subject:** 50  
**Page Label:** [1] SHEET 2  
**Lock:** Unlocked  
**Author:** AutoCAD SHX Text

**Subject:** (XXXXX)  
**Page Label:** [1] SHEET 2  
**Lock:** Unlocked  
**Author:** AutoCAD SHX Text

197

**Subject:** 7,690 SQ. FT.  
**Page Label:** [1] SHEET 2  
**Lock:** Unlocked  
**Author:** AutoCAD SHX Text

49  
10,311 SQ. FT.

**Subject:** 10,311 SQ. FT.  
**Page Label:** [1] SHEET 2  
**Lock:** Unlocked  
**Author:** AutoCAD SHX Text

**Subject:** (XXXXX)  
**Page Label:** [1] SHEET 2  
**Lock:** Unlocked  
**Author:** AutoCAD SHX Text

165  
8,773 SQ. FT.

**Subject:** 8,773 SQ. FT.  
**Page Label:** [1] SHEET 2  
**Lock:** Unlocked  
**Author:** AutoCAD SHX Text

68

**Subject:** 8,215 SQ. FT.  
**Page Label:** [1] SHEET 2  
**Lock:** Unlocked  
**Author:** AutoCAD SHX Text

66

**Subject:** 8,393 SQ. FT.  
**Page Label:** [1] SHEET 2  
**Lock:** Unlocked  
**Author:** AutoCAD SHX Text



**Subject:** STONEBRIDGE FILING 3  
**Page Label:** [1] SHEET 2  
**Lock:** Unlocked  
**Author:** AutoCAD SHX Text







Subject: (60 FEET WIDE)  
Page Label: [1] SHEET 2  
Lock: Unlocked  
Author: AutoCAD SHX Text

44  
8,520 SQ. FT.

Subject: 8,520 SQ. FT.  
Page Label: [1] SHEET 2  
Lock: Unlocked  
Author: AutoCAD SHX Text

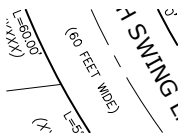


Subject: (60 FEET WIDE)  
Page Label: [1] SHEET 2  
Lock: Unlocked  
Author: AutoCAD SHX Text

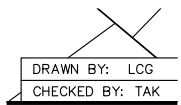


Subject: DRAWN BY: LCG  
Page Label: [1] SHEET 2  
Lock: Unlocked  
Author: AutoCAD SHX Text

50  
11,301 SQ. FT.


Subject: 11,301 SQ. FT.  
Page Label: [1] SHEET 2  
Lock: Unlocked  
Author: AutoCAD SHX Text

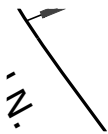

Subject: L=19.32'  
Page Label: [1] SHEET 2  
Lock: Unlocked  
Author: AutoCAD SHX Text

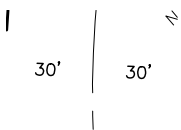

Subject: 30' 30'  
Page Label: [1] SHEET 2  
Lock: Unlocked  
Author: AutoCAD SHX Text

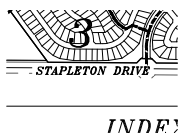

Subject: STAPLETON DRIVE  
Page Label: [1] SHEET 2  
Lock: Unlocked  
Author: AutoCAD SHX Text

(XXXXX)  
L=57.60'

Subject: (XXXXX)  
Page Label: [1] SHEET 2  
Lock: Unlocked  
Author: AutoCAD SHX Text

46  
10,297 SQ. FT.

Subject: 10,297 SQ. FT.  
Page Label: [1] SHEET 2  
Lock: Unlocked  
Author: AutoCAD SHX Text

208


Subject:  
Page Label: [1] SHEET 2  
Lock: Unlocked  
Author: AutoCAD SHX Text

8,091 SQ. FT.




Subject:  
Page Label: [1] SHEET 2  
Lock: Unlocked  
Author: AutoCAD SHX Text

4

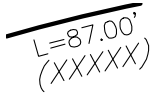


Subject:  
Page Label: [1] SHEET 2  
Lock: Unlocked  
Author: AutoCAD SHX Text

(XXXXX)

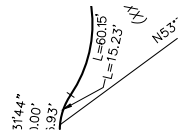


Subject:  
Page Label: [1] SHEET 2  
Lock: Unlocked  
Author: AutoCAD SHX Text

L=15.23'

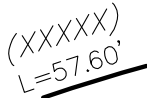

Subject:  
Page Label: [1] SHEET 2  
Lock: Unlocked  
Author: AutoCAD SHX Text

(XXXXX)

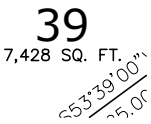

39  
7,428 SQ. FT.  
553'39'00"  
25.00'


Subject:  
Page Label: [1] SHEET 2  
Lock: Unlocked  
Author: AutoCAD SHX Text

7,428 SQ. FT.

100

Subject:  
Page Label: [1] SHEET 2  
Lock: Unlocked  
Author: AutoCAD SHX Text

100

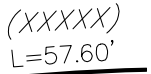

Subject:  
Page Label: [1] SHEET 2  
Lock: Unlocked  
Author: AutoCAD SHX Text

(XXXXX)



Subject:  
Page Label: [1] SHEET 2  
Lock: Unlocked  
Author: AutoCAD SHX Text

30' 30'

50

Subject:  
Page Label: [1] SHEET 2  
Lock: Unlocked  
Author: AutoCAD SHX Text


50



67


**Subject:**  
**Page Label:** [1] SHEET 2  
**Lock:** Unlocked  
**Author:** AutoCAD SHX Text

8,761 SQ. FT.

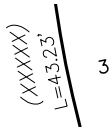


**Subject:**  
**Page Label:** [1] SHEET 2  
**Lock:** Unlocked  
**Author:** AutoCAD SHX Text

(XXXXX)

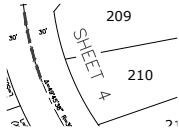


**Subject:**  
**Page Label:** [1] SHEET 2  
**Lock:** Unlocked  
**Author:** AutoCAD SHX Text

SHEET 44

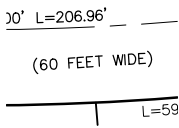

**Subject:**  
**Page Label:** [1] SHEET 2  
**Lock:** Unlocked  
**Author:** AutoCAD SHX Text

(60 FEET WIDE)

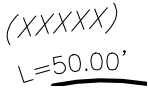


**Subject:**  
**Page Label:** [1] SHEET 2  
**Lock:** Unlocked  
**Author:** AutoCAD SHX Text

(XXXXX)




**Subject:**  
**Page Label:** [1] SHEET 2  
**Lock:** Unlocked  
**Author:** AutoCAD SHX Text

735.45'

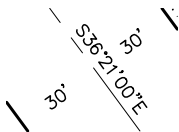


**Subject:**  
**Page Label:** [1] SHEET 2  
**Lock:** Unlocked  
**Author:** AutoCAD SHX Text

30' 30'

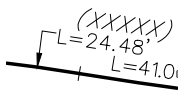

**Subject:**  
**Page Label:** [1] SHEET 2  
**Lock:** Unlocked  
**Author:** AutoCAD SHX Text

L=24.48'

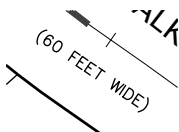

**Subject:**  
**Page Label:** [1] SHEET 2  
**Lock:** Unlocked  
**Author:** AutoCAD SHX Text

(60 FEET WIDE)

38  
7,500 SQ. FT.

**Subject:**  
**Page Label:** [1] SHEET 2  
**Lock:** Unlocked  
**Author:** AutoCAD SHX Text

7,500 SQ. FT.



-----  
**Subject:**  
**Page Label:** [1] SHEET 2 (XXXXXX)  
**Lock:** Unlocked  
**Author:** AutoCAD SHX Text


-----  
**Subject:**  
**Page Label:** [1] SHEET 2 (XXXXXX)  
**Lock:** Unlocked  
**Author:** AutoCAD SHX Text

186


-----  
**Subject:**  
**Page Label:** [1] SHEET 2 7,894 SQ. FT.  
**Lock:** Unlocked  
**Author:** AutoCAD SHX Text

FEET

-----  
**Subject:**  
**Page Label:** [1] SHEET 2 30' 30'  
**Lock:** Unlocked  
**Author:** AutoCAD SHX Text

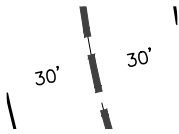

-----  
**Subject:**  
**Page Label:** [1] SHEET 2 (60 FEET WIDE)  
**Lock:** Unlocked  
**Author:** AutoCAD SHX Text

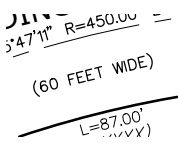

-----  
**Subject:**  
**Page Label:** [1] SHEET 2 (XXXXXX)  
**Lock:** Unlocked  
**Author:** AutoCAD SHX Text



-----  
**Subject:**  
**Page Label:** [1] SHEET 2 (XXXXXX)  
**Lock:** Unlocked  
**Author:** AutoCAD SHX Text



169

8,506 SQ. FT.


-----  
**Subject:**  
**Page Label:** [1] SHEET 2 8,506 SQ. FT.  
**Lock:** Unlocked  
**Author:** AutoCAD SHX Text

CR 7'05'34"

-----  
**Subject:**  
**Page Label:** [1] SHEET 2 (XXXXXX)  
**Lock:** Unlocked  
**Author:** AutoCAD SHX Text



-----  
**Subject:**  
**Page Label:** [1] SHEET 2 L=20.89'  
**Lock:** Unlocked  
**Author:** AutoCAD SHX Text

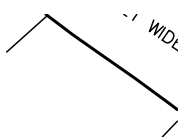

164  
8,792 SQ. FT.  
S36°21'00"E  
(60 FEET WIDE)

**Subject:**  
**Page Label:** [1] SHEET 2  
**Lock:** Unlocked  
**Author:** AutoCAD SHX Text

8,792 SQ. FT.

34

**Subject:**  
**Page Label:** [1] SHEET 2  
**Lock:** Unlocked  
**Author:** AutoCAD SHX Text

7,275 SQ. FT.

TY GLEN  
735.45  
(60 FEET WIDE)

**Subject:**  
**Page Label:** [1] SHEET 2  
**Lock:** Unlocked  
**Author:** AutoCAD SHX Text

(60 FEET WIDE)

S36°21'00"E  
163.36

**Subject:**  
**Page Label:** [1] SHEET 2  
**Lock:** Unlocked  
**Author:** AutoCAD SHX Text

S36°21'00"E163.36'

190  
7,989 SQ. FT.  
S84°01'40"W(NF)

**Subject:**  
**Page Label:** [1] SHEET 2  
**Lock:** Unlocked  
**Author:** AutoCAD SHX Text

7,989 SQ. FT.

65.00'  
(XXXX)

**Subject:**  
**Page Label:** [1] SHEET 2  
**Lock:** Unlocked  
**Author:** AutoCAD SHX Text

(XXXXXX)

1'00"W 30'  
53°39'00"E  
52.00' 30' E

**Subject:**  
**Page Label:** [1] SHEET 2  
**Lock:** Unlocked  
**Author:** AutoCAD SHX Text

30' 30'

53  
8,978 SQ. FT.  
S39°00"

**Subject:**  
**Page Label:** [1] SHEET 2  
**Lock:** Unlocked  
**Author:** AutoCAD SHX Text

8,978 SQ. FT.

DATE: DECEMBER 2017  
SHEET: 2 OF 9  
PCD PROJECT NO. SF-\_\_\_\_-

**Subject:**  
**Page Label:** [1] SHEET 2  
**Lock:** Unlocked  
**Author:** AutoCAD SHX Text


PCD PROJECT NO. SF-\_\_\_\_-

DATE: DECEMBER  
SHEET: 2  
PCD PROJECT NO


**Subject:**  
**Page Label:** [1] SHEET 2  
**Lock:** Unlocked  
**Author:** AutoCAD SHX Text

SHEET: 2



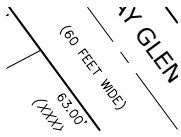


**Subject:**  
**Page Label:** [1] SHEET 2 (60 FEET WIDE)  
**Lock:** Unlocked  
**Author:** AutoCAD SHX Text

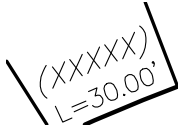

**Subject:**  
**Page Label:** [1] SHEET 2 (XXXXXX)  
**Lock:** Unlocked  
**Author:** AutoCAD SHX Text




**Subject:**  
**Page Label:** [1] SHEET 2 (XXXXXX)  
**Lock:** Unlocked  
**Author:** AutoCAD SHX Text

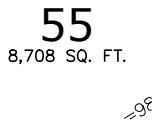


**Subject:**  
**Page Label:** [1] SHEET 2 8,708 SQ. FT.  
**Lock:** Unlocked  
**Author:** AutoCAD SHX Text



**Subject:**  
**Page Label:** [1] SHEET 2 (XXXXXX)  
**Lock:** Unlocked  
**Author:** AutoCAD SHX Text

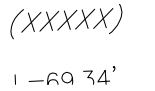


**Subject:**  
**Page Label:** [1] SHEET 2 (XXXXXX)  
**Lock:** Unlocked  
**Author:** AutoCAD SHX Text

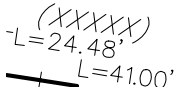


**Subject:**  
**Page Label:** [1] SHEET 2 (XXXXXX)  
**Lock:** Unlocked  
**Author:** AutoCAD SHX Text




**Subject:**  
**Page Label:** [1] SHEET 2 N36°20'59"W  
**Lock:** Unlocked  
**Author:** AutoCAD SHX Text

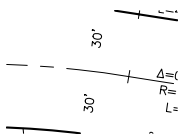

**Subject:**  
**Page Label:** [1] SHEET 2 30' 30'  
**Lock:** Unlocked  
**Author:** AutoCAD SHX Text

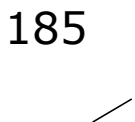

**Subject:**  
**Page Label:** [1] SHEET 2 7,529 SQ. FT.  
**Lock:** Unlocked  
**Author:** AutoCAD SHX Text

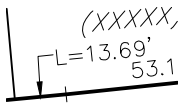

**Subject:** L=13.69'  
**Page Label:** [1] SHEET 2  
**Lock:** Unlocked  
**Author:** AutoCAD SHX Text

194


**Subject:** 7,585 SQ. FT.  
**Page Label:** [1] SHEET 2  
**Lock:** Unlocked  
**Author:** AutoCAD SHX Text



**Subject:** (XXXXX)  
**Page Label:** [1] SHEET 2  
**Lock:** Unlocked  
**Author:** AutoCAD SHX Text

43  
8,280 SQ. FT.

**Subject:** 8,280 SQ. FT.  
**Page Label:** [1] SHEET 2  
**Lock:** Unlocked  
**Author:** AutoCAD SHX Text

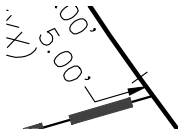

**Subject:** 5.00'  
**Page Label:** [1] SHEET 2  
**Lock:** Unlocked  
**Author:** AutoCAD SHX Text



**Subject:** L=24.49'  
**Page Label:** [1] SHEET 2  
**Lock:** Unlocked  
**Author:** AutoCAD SHX Text

64  
8,569 SQ. FT.

**Subject:** 8,569 SQ. FT.  
**Page Label:** [1] SHEET 2  
**Lock:** Unlocked  
**Author:** AutoCAD SHX Text

183


**Subject:** 8,267 SQ. FT.  
**Page Label:** [1] SHEET 2  
**Lock:** Unlocked  
**Author:** AutoCAD SHX Text

37  
7,500 SQ. FT.


**Subject:** 7,500 SQ. FT.  
**Page Label:** [1] SHEET 2  
**Lock:** Unlocked  
**Author:** AutoCAD SHX Text

45  
9,034 SQ. FT.

**Subject:** 9,034 SQ. FT.  
**Page Label:** [1] SHEET 2  
**Lock:** Unlocked  
**Author:** AutoCAD SHX Text

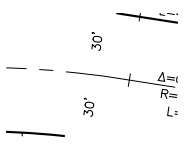

Subject: 30' 30'  
Page Label: [1] SHEET 2  
Lock: Unlocked  
Author: AutoCAD SHX Text

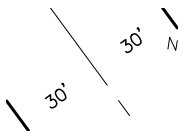

Subject: 30' 30'  
Page Label: [1] SHEET 2  
Lock: Unlocked  
Author: AutoCAD SHX Text

160  
8,225 SQ. FT.



Subject: 8,225 SQ. FT.  
Page Label: [1] SHEET 2  
Lock: Unlocked  
Author: AutoCAD SHX Text




Subject: (XXXXXX)  
Page Label: [1] SHEET 2  
Lock: Unlocked  
Author: AutoCAD SHX Text



Subject: (XXXXXX)  
Page Label: [1] SHEET 2  
Lock: Unlocked  
Author: AutoCAD SHX Text



Subject: (XXXXXX)  
Page Label: [1] SHEET 2  
Lock: Unlocked  
Author: AutoCAD SHX Text

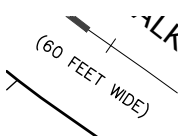


Subject: (60 FEET WIDE)  
Page Label: [1] SHEET 2  
Lock: Unlocked  
Author: AutoCAD SHX Text




Subject: 5  
Page Label: [1] SHEET 2  
Lock: Unlocked  
Author: AutoCAD SHX Text

182

Subject: 7,877 SQ. FT.  
Page Label: [1] SHEET 2  
Lock: Unlocked  
Author: AutoCAD SHX Text

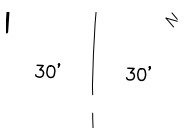

Subject: 30' 30'  
Page Label: [1] SHEET 2  
Lock: Unlocked  
Author: AutoCAD SHX Text

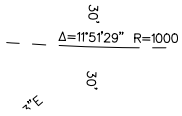


**Subject:**  
**Page Label:** [1] SHEET 2 30' 30'  
**Lock:** Unlocked  
**Author:** AutoCAD SHX Text




**Subject:**  
**Page Label:** [1] SHEET 2 (XXXXX)  
**Lock:** Unlocked  
**Author:** AutoCAD SHX Text



**Subject:**  
**Page Label:** [1] SHEET 2 (XXXXX)  
**Lock:** Unlocked  
**Author:** AutoCAD SHX Text

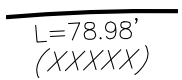


**Subject:**  
**Page Label:** [1] SHEET 2 (XXXXX)  
**Lock:** Unlocked  
**Author:** AutoCAD SHX Text

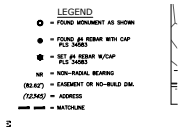

**Subject:**  
**Page Label:** [1] SHEET 2 = FOUND MONUMENT AS SHOWN = FOUND #4 REBAR WITH CAP PLS 34583 = SET #4 REBAR W/CAP PLS 34583 = NON-RADIAL BEARING = EASEMENT OR NO-BUILD DIM. = ADDRESS ADDRESS = MATCHLINE  
**Lock:** Unlocked  
**Author:** AutoCAD SHX Text



**Subject:**  
**Page Label:** [1] SHEET 2 (XXXXX)  
**Lock:** Unlocked  
**Author:** AutoCAD SHX Text

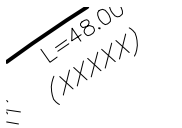

**Subject:**  
**Page Label:** [1] SHEET 2 (XXXXX)  
**Lock:** Unlocked  
**Author:** AutoCAD SHX Text

ft.

**Subject:**  
**Page Label:** [1] SHEET 2 ft.  
**Lock:** Unlocked  
**Author:** AutoCAD SHX Text

50

**Subject:**  
**Page Label:** [1] SHEET 2 50  
**Lock:** Unlocked  
**Author:** AutoCAD SHX Text

187

8,764 SQ. FT.

**Subject:**  
**Page Label:** [1] SHEET 2 8,764 SQ. FT.  
**Lock:** Unlocked  
**Author:** AutoCAD SHX Text





**Subject:**  
**Page Label:** [1] SHEET 2 (XXXXXX)  
**Lock:** Unlocked  
**Author:** AutoCAD SHX Text

58  
8,287 SQ. FT.  
**Subject:**  
**Page Label:** [1] SHEET 2 8,287 SQ. FT.  
**Lock:** Unlocked  
**Author:** AutoCAD SHX Text

**N**  
**Subject:**  
**Page Label:** [1] SHEET 2 N  
**Lock:** Unlocked  
**Author:** AutoCAD SHX Text

(77777)  
65.00'  
**Subject:**  
**Page Label:** [1] SHEET 2 (XXXXXX)  
**Lock:** Unlocked  
**Author:** AutoCAD SHX Text

48  
10,525 SQ. FT.  
**Subject:**  
**Page Label:** [1] SHEET 2 10,525 SQ. FT.  
**Lock:** Unlocked  
**Author:** AutoCAD SHX Text

189  
8,319 SQ. FT.  
N89°41'54"E(NR)  
**Subject:**  
**Page Label:** [1] SHEET 2 8,319 SQ. FT.  
**Lock:** Unlocked  
**Author:** AutoCAD SHX Text

(77777)  
60.00'  
**Subject:**  
**Page Label:** [1] SHEET 2 (XXXXXX)  
**Lock:** Unlocked  
**Author:** AutoCAD SHX Text

(77777)  
L=50.78'  
**Subject:**  
**Page Label:** [1] SHEET 2 (XXXXXX)  
**Lock:** Unlocked  
**Author:** AutoCAD SHX Text

**Subject:**  
**Page Label:** [1] SHEET 2 DATE: DECEMBER 2017  
**Lock:** Unlocked  
**Author:** AutoCAD SHX Text

DATE: DECEMBER 2017  
SHEET: 2 OF 9  
PCD PROJECT NO. SF-\_\_-\_\_


**Subject:**  
**Page Label:** [1] SHEET 2 (XXXXXX)  
**Lock:** Unlocked  
**Author:** AutoCAD SHX Text



**Subject:**  
**Page Label:** [1] SHEET 2 (XXXXXX)  
**Lock:** Unlocked  
**Author:** AutoCAD SHX Text

**TRACT** /  
 8.504 ACRES


**Subject:**  
**Page Label:** [1] SHEET 2 8.504 ACRES  
**Lock:** Unlocked  
**Author:** AutoCAD SHX Text

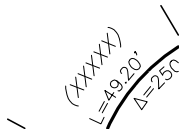


**Subject:**  
**Page Label:** [1] SHEET 2 (XXXXXX)  
**Lock:** Unlocked  
**Author:** AutoCAD SHX Text

211

**Subject:**  
**Page Label:** [1] SHEET 2 8,311 SQ. FT.  
**Lock:** Unlocked  
**Author:** AutoCAD SHX Text

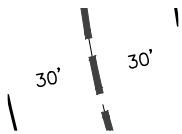

**Subject:**  
**Page Label:** [1] SHEET 2 30' 30'  
**Lock:** Unlocked  
**Author:** AutoCAD SHX Text

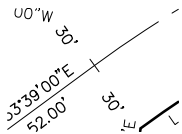

**Subject:**  
**Page Label:** [1] SHEET 2 30' 30'  
**Lock:** Unlocked  
**Author:** AutoCAD SHX Text




**Subject:**  
**Page Label:** [1] SHEET 2 (XXXXXX)  
**Lock:** Unlocked  
**Author:** AutoCAD SHX Text

51  
 10,963 SQ. FT.



**Subject:**  
**Page Label:** [1] SHEET 2 10,963 SQ. FT.  
**Lock:** Unlocked  
**Author:** AutoCAD SHX Text

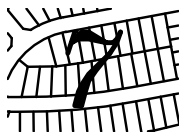


**Subject:**  
**Page Label:** [1] SHEET 2 7  
**Lock:** Unlocked  
**Author:** AutoCAD SHX Text

52  
 9,225 SQ. FT.



**Subject:**  
**Page Label:** [1] SHEET 2 9,225 SQ. FT.  
**Lock:** Unlocked  
**Author:** AutoCAD SHX Text

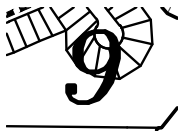

-----  
**Subject:** 9  
**Page Label:** [1] SHEET 2  
**Lock:** Unlocked  
**Author:** AutoCAD SHX Text

.....  
 (82.62')  
 (12345)


-----  
**Subject:** (82.62')  
**Page Label:** [1] SHEET 2  
**Lock:** Unlocked  
**Author:** AutoCAD SHX Text



-----  
**Subject:** (XXXXX)  
**Page Label:** [1] SHEET 2  
**Lock:** Unlocked  
**Author:** AutoCAD SHX Text

.....  
 65  
 8,450 SQ. FT.

-----  
**Subject:** 8,450 SQ. FT.  
**Page Label:** [1] SHEET 2  
**Lock:** Unlocked  
**Author:** AutoCAD SHX Text

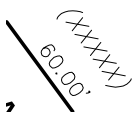


-----  
**Subject:** (XXXXX)  
**Page Label:** [1] SHEET 2  
**Lock:** Unlocked  
**Author:** AutoCAD SHX Text

.....  
 170  
 8,075 SQ. FT.  
 73'52"5

-----  
**Subject:** 8,075 SQ. FT.  
**Page Label:** [1] SHEET 2  
**Lock:** Unlocked  
**Author:** AutoCAD SHX Text



-----  
**Subject:** (XXXXX)  
**Page Label:** [1] SHEET 2  
**Lock:** Unlocked  
**Author:** AutoCAD SHX Text

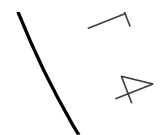

-----  
**Subject:** (XXXXX)  
**Page Label:** [1] SHEET 2  
**Lock:** Unlocked  
**Author:** AutoCAD SHX Text

.....  
 TRACT D  
 (NOT A PART)

-----  
**Subject:** (NOT A PART)  
**Page Label:** [1] SHEET 2  
**Lock:** Unlocked  
**Author:** AutoCAD SHX Text


.....  
 0  
 |

-----  
**Subject:** 0  
**Page Label:** [1] SHEET 2  
**Lock:** Unlocked  
**Author:** AutoCAD SHX Text

Subject: (XXXXX)  
Page Label: [1] SHEET 2  
Lock: Unlocked  
Author: AutoCAD SHX Text




Subject: (XXXXX)  
Page Label: [1] SHEET 2  
Lock: Unlocked  
Author: AutoCAD SHX Text

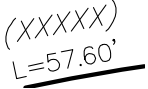

Subject: 8  
Page Label: [1] SHEET 2  
Lock: Unlocked  
Author: AutoCAD SHX Text



Subject: 8,630 SQ. FT.  
Page Label: [1] SHEET 2  
Lock: Unlocked  
Author: AutoCAD SHX Text

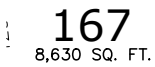


Subject: (60 FEET WIDE)  
Page Label: [1] SHEET 2  
Lock: Unlocked  
Author: AutoCAD SHX Text



Subject: 8,228 SQ. FT.  
Page Label: [1] SHEET 2  
Lock: Unlocked  
Author: AutoCAD SHX Text



Subject: SHEET 33  
Page Label: [1] SHEET 2  
Lock: Unlocked  
Author: AutoCAD SHX Text

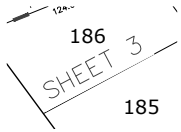


Subject: (XXXXX)  
Page Label: [1] SHEET 2  
Lock: Unlocked  
Author: AutoCAD SHX Text




Subject: (XXXXX)  
Page Label: [1] SHEET 2  
Lock: Unlocked  
Author: AutoCAD SHX Text



Subject: 7,275 SQ. FT.  
Page Label: [1] SHEET 2  
Lock: Unlocked  
Author: AutoCAD SHX Text

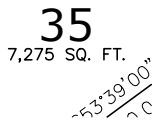



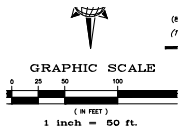

Subject: GRAPHIC SCALE  
 Page Label: [1] SHEET 2  
 Lock: Unlocked  
 Author: AutoCAD SHX Text



Subject: 2  
 Page Label: [1] SHEET 2  
 Lock: Unlocked  
 Author: AutoCAD SHX Text

TRACT G  
 (NOT A PART)

Subject: (NOT A PART)  
 Page Label: [1] SHEET 2  
 Lock: Unlocked  
 Author: AutoCAD SHX Text

196

Subject: 7,594 SQ. FT.  
 Page Label: [1] SHEET 2  
 Lock: Unlocked  
 Author: AutoCAD SHX Text

41

8,040 SQ. FT.

739'0"

Subject: 8,040 SQ. FT.  
 Page Label: [1] SHEET 2  
 Lock: Unlocked  
 Author: AutoCAD SHX Text

33

Subject: 7,425 SQ. FT.  
 Page Label: [1] SHEET 2  
 Lock: Unlocked  
 Author: AutoCAD SHX Text

166

8,803 SQ. FT.

739'0"

Subject: 8,803 SQ. FT.  
 Page Label: [1] SHEET 2  
 Lock: Unlocked  
 Author: AutoCAD SHX Text

Subject: (XXXXX)  
 Page Label: [1] SHEET 2  
 Lock: Unlocked  
 Author: AutoCAD SHX Text

56

8,561 SQ. FT.

739'0"

Subject: 8,561 SQ. FT.  
 Page Label: [1] SHEET 2  
 Lock: Unlocked  
 Author: AutoCAD SHX Text



Subject: WINDINGWALK FILING No. 1 AT MERIDIAN RANCH  
 Page Label: [1] SHEET 2  
 Lock: Unlocked  
 Author: AutoCAD SHX Text

L=80.00'  
(HHHH)  
H

Subject:  
Page Label: [1] SHEET 2 (XXXXX)  
Lock: Unlocked  
Author: AutoCAD SHX Text

Subject:  
Page Label: [1] SHEET 2 (XXXXX)  
Lock: Unlocked  
Author: AutoCAD SHX Text

54  
8,304 SQ. FT.

3'39"00"  
5'

Subject:  
Page Label: [1] SHEET 2 8,304 SQ. FT.  
Lock: Unlocked  
Author: AutoCAD SHX Text

161  
8,711 SQ. FT.

7'40"16"  
-

Subject:  
Page Label: [1] SHEET 2 8,711 SQ. FT.  
Lock: Unlocked  
Author: AutoCAD SHX Text

48.00'  
(HHHH)

Subject:  
Page Label: [1] SHEET 2 (XXXXX)  
Lock: Unlocked  
Author: AutoCAD SHX Text

0.00'  
L=80.00'  
(XXXXXX)

Subject:  
Page Label: [1] SHEET 2 (XXXXX)  
Lock: Unlocked  
Author: AutoCAD SHX Text

0.15'  
3'  
(HHHH)  
15.7'

Subject:  
Page Label: [1] SHEET 2 (XXXXX)  
Lock: Unlocked  
Author: AutoCAD SHX Text

193

Subject:  
Page Label: [1] SHEET 2 7,673 SQ. FT.  
Lock: Unlocked  
Author: AutoCAD SHX Text

L=36'  
L=21.69'  
45.7'  
(HHHH)

Subject:  
Page Label: [1] SHEET 2 L=21.69'  
Lock: Unlocked  
Author: AutoCAD SHX Text

163  
8,498 SQ. FT.

8.00'

Subject:  
Page Label: [1] SHEET 2 8,498 SQ. FT.  
Lock: Unlocked  
Author: AutoCAD SHX Text

Subject:  
Page Label: [1] SHEET 2 (XXXXXX)  
Lock: Unlocked  
Author: AutoCAD SHX Text

188  
8,970 SQ. FT.

Subject:  
Page Label: [1] SHEET 2 8,970 SQ. FT.  
Lock: Unlocked  
Author: AutoCAD SHX Text

L=39'02"E(1)

Subject:  
Page Label: [1] SHEET 2 (XXXXXX)  
Lock: Unlocked  
Author: AutoCAD SHX Text

(XXXXXX)  
L=52  
L=27

Subject:  
Page Label: [1] SHEET 2 (XXXXXX)  
Lock: Unlocked  
Author: AutoCAD SHX Text

(XXXXXX)  
L=21.69'  
45'

36  
7,425 SQ. FT.


Subject:  
Page Label: [1] SHEET 2 7,425 SQ. FT.  
Lock: Unlocked  
Author: AutoCAD SHX Text

L=33'00"

Subject:  
Page Label: [1] SHEET 2 (XXXXXX)  
Lock: Unlocked  
Author: AutoCAD SHX Text

(XXXXXX)  
65.00'

Subject:  
Page Label: [1] SHEET 2 L=16.00'  
Lock: Unlocked  
Author: AutoCAD SHX Text

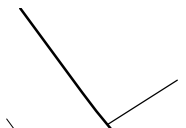

( IN FEET )  
1 inch =

Subject:  
Page Label: [1] SHEET 2 1 inch =  
Lock: Unlocked  
Author: AutoCAD SHX Text

(XXXXXX)  
L=13.69'  
53.14'

Subject:  
Page Label: [1] SHEET 2 (XXXXXX)  
Lock: Unlocked  
Author: AutoCAD SHX Text

(XXXXXX)  
63.00'

Subject:  
Page Label: [1] SHEET 2 (XXXXXX)  
Lock: Unlocked  
Author: AutoCAD SHX Text

191  
8,284 SQ. FT.

50'19"W

Subject:  
Page Label: [1] SHEET 2  
Lock: Unlocked  
Author: AutoCAD SHX Text

8,284 SQ. FT.

\_\_\_\_\_

Subject:  
Page Label: [1] SHEET 2  
Lock: Unlocked  
Author: AutoCAD SHX Text

(XXXXX)

1691.35'  
1716.12'

Subject:  
Page Label: [1] SHEET 2  
Lock: Unlocked  
Author: AutoCAD SHX Text

1716.12'

(XXXXX)  
65.00'

Subject:  
Page Label: [1] SHEET 2  
Lock: Unlocked  
Author: AutoCAD SHX Text

(XXXXX)

(XXXXX)  
L=69.34'

Subject:  
Page Label: [1] SHEET 2  
Lock: Unlocked  
Author: AutoCAD SHX Text

(XXXXX)

47  
11,014 SQ. FT.

Subject:  
Page Label: [1] SHEET 2  
Lock: Unlocked  
Author: AutoCAD SHX Text

11,014 SQ. FT.

~~1111~~  
N.T.S.

Subject:  
Page Label: [1] SHEET 2  
Lock: Unlocked  
Author: AutoCAD SHX Text

N.T.S.

DRAWN BY: LCG  
CHECKED BY: TAK

Subject:  
Page Label: [1] SHEET 2  
Lock: Unlocked  
Author: AutoCAD SHX Text

CHECKED BY: TAK

200  
I

Subject:  
Page Label: [1] SHEET 2  
Lock: Unlocked  
Author: AutoCAD SHX Text

200

30'

Subject:  
Page Label: [1] SHEET 2  
Lock: Unlocked  
Author: AutoCAD SHX Text

30' 30'

159  
7,543 SQ. FT.

2°54'07"W

**Subject:**  
**Page Label:** [1] SHEET 2  
**Lock:** Unlocked  
**Author:** AutoCAD SHX Text

7,543 SQ. FT.

60  
8,469 SQ. FT.

N05°59'54"W

**Subject:**  
**Page Label:** [1] SHEET 2  
**Lock:** Unlocked  
**Author:** AutoCAD SHX Text

8,469 SQ. FT.

63  
8,492 SQ. FT.

S89°26'04"W

**Subject:**  
**Page Label:** [1] SHEET 2  
**Lock:** Unlocked  
**Author:** AutoCAD SHX Text

8,492 SQ. FT.



**Subject:**  
**Page Label:** [1] SHEET 2  
**Lock:** Unlocked  
**Author:** AutoCAD SHX Text

A PARCEL OF LAND LOCATED IN A PORTION OF SECTION 29, 30, AND 32 IN TOWNSHIP 12 SOUTH, RANGE 64 WEST OF THE 6TH PRINCIPAL MERIDIAN

195

**Subject:**  
**Page Label:** [1] SHEET 2  
**Lock:** Unlocked  
**Author:** AutoCAD SHX Text

7,408 SQ. FT.

( IN FEET )  
ch = 50

**Subject:**  
**Page Label:** [1] SHEET 2  
**Lock:** Unlocked  
**Author:** AutoCAD SHX Text

( IN FEET )

192  
8,283 SQ. FT.

N6°12'W

**Subject:**  
**Page Label:** [1] SHEET 2  
**Lock:** Unlocked  
**Author:** AutoCAD SHX Text

8,283 SQ. FT.



**Subject:**  
**Page Label:** [1] SHEET 2  
**Lock:** Unlocked  
**Author:** AutoCAD SHX Text

3

62  
8,495 SQ. FT.

S89°26'04"W

**Subject:**  
**Page Label:** [1] SHEET 2  
**Lock:** Unlocked  
**Author:** AutoCAD SHX Text

8,495 SQ. FT.

168  
9,012 SQ. FT.


S89°26'04"W

**Subject:**  
**Page Label:** [1] SHEET 2  
**Lock:** Unlocked  
**Author:** AutoCAD SHX Text

9,012 SQ. FT.




-----  
**Subject:**  
**Page Label:** [1] SHEET 2 (XXXXX)  
**Lock:** Unlocked  
**Author:** AutoCAD SHX Text

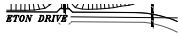


*INDEX MAP*  
N.T.S.

-----  
**Subject:**  
**Page Label:** [1] SHEET 2 INDEX MAP  
**Lock:** Unlocked  
**Author:** AutoCAD SHX Text

-----  
**Subject:**  
**Page Label:** [1] SHEET 2 (XXXXX)  
**Lock:** Unlocked  
**Author:** AutoCAD SHX Text

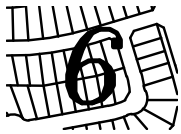

-----  
**Subject:**  
**Page Label:** [1] SHEET 2 6  
**Lock:** Unlocked  
**Author:** AutoCAD SHX Text

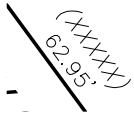

-----  
**Subject:**  
**Page Label:** [1] SHEET 2 (XXXXX)  
**Lock:** Unlocked  
**Author:** AutoCAD SHX Text

**TRACT A**  
8.504 ACRES

-----  
**Subject:**  
**Page Label:** [1] SHEET 2 8.504 ACRES  
**Lock:** Unlocked  
**Author:** AutoCAD SHX Text



-----  
**Subject:**  
**Page Label:** [1] SHEET 2 (XXXXX)  
**Lock:** Unlocked  
**Author:** AutoCAD SHX Text



-----  
**Subject:**  
**Page Label:** [1] SHEET 2 (XXXXX)  
**Lock:** Unlocked  
**Author:** AutoCAD SHX Text



-----  
**Subject:**  
**Page Label:** [1] SHEET 2 (XXXXX)  
**Lock:** Unlocked  
**Author:** AutoCAD SHX Text

00' L=206.96'  
(60 FEET WIDE)

-----  
**Subject:**  
**Page Label:** [1] SHEET 2 (60 FEET WIDE)  
**Lock:** Unlocked  
**Author:** AutoCAD SHX Text



(02.02)

(12345)

**Subject:**  
**Page Label:** [1] SHEET 2  
**Lock:** Unlocked  
**Author:** AutoCAD SHX Text

(12345)

42

8,280 SQ. FT.

6'30" Δ

**Subject:**  
**Page Label:** [1] SHEET 2  
**Lock:** Unlocked  
**Author:** AutoCAD SHX Text

8,280 SQ. FT.

**Subject:**  
**Page Label:** [1] SHEET 2  
**Lock:** Unlocked  
**Author:** AutoCAD SHX Text

(XXXXX)

162

8,836 SQ. FT.

60'24" 34"  
6P

**Subject:**  
**Page Label:** [1] SHEET 2  
**Lock:** Unlocked  
**Author:** AutoCAD SHX Text

8,836 SQ. FT.

212

**Subject:**  
**Page Label:** [1] SHEET 2  
**Lock:** Unlocked  
**Author:** AutoCAD SHX Text

8,194 SQ. FT.

**Subject:**  
**Page Label:** [1] SHEET 2  
**Lock:** Unlocked  
**Author:** AutoCAD SHX Text

(XXXXX)

40

7,885 SQ. FT.

4'39" 0"

**Subject:**  
**Page Label:** [1] SHEET 2  
**Lock:** Unlocked  
**Author:** AutoCAD SHX Text

7,885 SQ. FT.

25

**Subject:**  
**Page Label:** [1] SHEET 2  
**Lock:** Unlocked  
**Author:** AutoCAD SHX Text

25

57

8,379 SQ. FT.

1'00"

**Subject:**  
**Page Label:** [1] SHEET 2  
**Lock:** Unlocked  
**Author:** AutoCAD SHX Text

8,379 SQ. FT.

±R 201 /

OF 9

CF \_ \_

**Subject:**  
**Page Label:** [1] SHEET 2  
**Lock:** Unlocked  
**Author:** AutoCAD SHX Text

OF 9

L=76.00'  
(XXXXXX)

Subject: (XXXXXX)  
Page Label: [1] SHEET 2  
Lock: Unlocked  
Author: AutoCAD SHX Text

ALK FILING No. 1 AT MERIDIAN  
EL PASO COUNTY, COLORADO.

Subject: EL PASO COUNTY, COLORADO.  
Page Label: [1] SHEET 2  
Lock: Unlocked  
Author: AutoCAD SHX Text

LINE

L=11.82'  
(XXXXXX)

Subject: (XXXXXX)  
Page Label: [1] SHEET 2  
Lock: Unlocked  
Author: AutoCAD SHX Text

OS  
Δ=11°51'29" R=1000  
OS  
FE

Subject: 30' 30'  
Page Label: [1] SHEET 2  
Lock: Unlocked  
Author: AutoCAD SHX Text

L=52.15'  
(XXXXXX)

Subject: (XXXXXX)  
Page Label: [1] SHEET 3  
Lock: Unlocked  
Author: AutoCAD SHX Text

Subject: (60 FEET WIDE)  
Page Label: [1] SHEET 3  
Lock: Unlocked  
Author: AutoCAD SHX Text

SCALE

Subject: (XXXXXX)  
Page Label: [1] SHEET 3  
Lock: Unlocked  
Author: AutoCAD SHX Text

(XXXXXX)  
L=80.00'

Subject: (XXXXXX)  
Page Label: [1] SHEET 3  
Lock: Unlocked  
Author: AutoCAD SHX Text

Subject: 9,326 SQ. FT.  
Page Label: [1] SHEET 3  
Lock: Unlocked  
Author: AutoCAD SHX Text

L=66.0  
L(L=15.00')  
(XXXXXX)

Subject: (XXXXXX)  
Page Label: [1] SHEET 3  
Lock: Unlocked  
Author: AutoCAD SHX Text

162

**Subject:**  
**Page Label:** [1] SHEET 3  
**Lock:** Unlocked  
**Author:** AutoCAD SHX Text

8,836 SQ. FT.




**Subject:**  
**Page Label:** [1] SHEET 3  
**Lock:** Unlocked  
**Author:** AutoCAD SHX Text

9



**Subject:**  
**Page Label:** [1] SHEET 3  
**Lock:** Unlocked  
**Author:** AutoCAD SHX Text

(XXXXX)

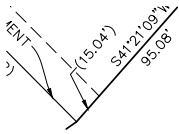

**Subject:**  
**Page Label:** [1] SHEET 3  
**Lock:** Unlocked  
**Author:** AutoCAD SHX Text

(15.04')



**Subject:**  
**Page Label:** [1] SHEET 3  
**Lock:** Unlocked  
**Author:** AutoCAD SHX Text

INDEX MAP



**Subject:**  
**Page Label:** [1] SHEET 3  
**Lock:** Unlocked  
**Author:** AutoCAD SHX Text

(XXXXX)

11  
11,616 SQ. FT.  
(144.08')

**Subject:**  
**Page Label:** [1] SHEET 3  
**Lock:** Unlocked  
**Author:** AutoCAD SHX Text

11,616 SQ. FT.



**Subject:**  
**Page Label:** [1] SHEET 3  
**Lock:** Unlocked  
**Author:** AutoCAD SHX Text

N

- LEGEND
- = FOUND MONUMENT AS SHOWN
  - = FOUND REBAR WITH CAP PLS 34583
  - = SET #4 REBAR W/CAP PLS 34583
  - ▬ = NON-RADIAL BEARING
  - (EASEM) = EASEMENT OR NO-BUILD DIM.
  - (12345) = ADDRESS
  - = MATCHLINE


**Subject:**  
**Page Label:** [1] SHEET 3  
**Lock:** Unlocked  
**Author:** AutoCAD SHX Text

= FOUND MONUMENT AS SHOWN = FOUND #4  
REBAR WITH CAP PLS 34583 = SET #4  
REBAR W/CAP PLS 34583 = NON-RADIAL  
BEARING = EASEMENT OR NO-BUILD DIM. =  
ADDRESS ADDRESS = MATCHLINE




**Subject:**  
**Page Label:** [1] SHEET 3  
**Lock:** Unlocked  
**Author:** AutoCAD SHX Text

(XXXXX)

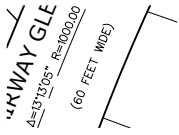


**Subject:**  
**Page Label:** [1] SHEET 3 (60 FEET WIDE)  
**Lock:** Unlocked  
**Author:** AutoCAD SHX Text

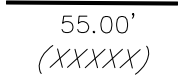


**Subject:**  
**Page Label:** [1] SHEET 3 (XXXXX)  
**Lock:** Unlocked  
**Author:** AutoCAD SHX Text



**Subject:**  
**Page Label:** [1] SHEET 3 (XXXXX)  
**Lock:** Unlocked  
**Author:** AutoCAD SHX Text

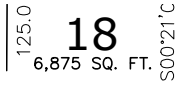


**Subject:**  
**Page Label:** [1] SHEET 3 6,875 SQ. FT.  
**Lock:** Unlocked  
**Author:** AutoCAD SHX Text

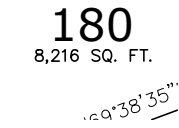

**Subject:**  
**Page Label:** [1] SHEET 3 8,216 SQ. FT.  
**Lock:** Unlocked  
**Author:** AutoCAD SHX Text



**Subject:**  
**Page Label:** [1] SHEET 3 (XXXXX)  
**Lock:** Unlocked  
**Author:** AutoCAD SHX Text

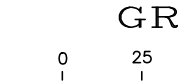

**Subject:**  
**Page Label:** [1] SHEET 3 7,905 SQ. FT.  
**Lock:** Unlocked  
**Author:** AutoCAD SHX Text



**Subject:**  
**Page Label:** [1] SHEET 3 (XXXXX)  
**Lock:** Unlocked  
**Author:** AutoCAD SHX Text


**Subject:**  
**Page Label:** [1] SHEET 3 (XXXXX)  
**Lock:** Unlocked  
**Author:** AutoCAD SHX Text

**Subject:**  
**Page Label:** [1] SHEET 3 (XXXXX)  
**Lock:** Unlocked  
**Author:** AutoCAD SHX Text



---

**Subject:** 8,333 SQ. FT.  
**Page Label:** [1] SHEET 3  
**Lock:** Unlocked  
**Author:** AutoCAD SHX Text

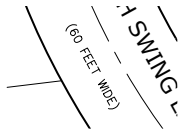


---

**Subject:** (60 FEET WIDE)  
**Page Label:** [1] SHEET 3  
**Lock:** Unlocked  
**Author:** AutoCAD SHX Text




---

**Subject:** STONEBRIDGE FILING 3  
**Page Label:** [1] SHEET 3  
**Lock:** Unlocked  
**Author:** AutoCAD SHX Text

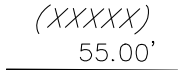


---

**Subject:** (XXXXX)  
**Page Label:** [1] SHEET 3  
**Lock:** Unlocked  
**Author:** AutoCAD SHX Text

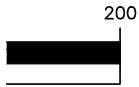

---

**Subject:** L=15.91'  
**Page Label:** [1] SHEET 3  
**Lock:** Unlocked  
**Author:** AutoCAD SHX Text

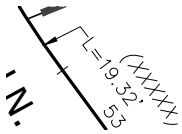

---

**Subject:** L=19.32'  
**Page Label:** [1] SHEET 3  
**Lock:** Unlocked  
**Author:** AutoCAD SHX Text

161

---

**Subject:** 8,711 SQ. FT.  
**Page Label:** [1] SHEET 3  
**Lock:** Unlocked  
**Author:** AutoCAD SHX Text

DATE: DECEMB
SHEET: 3
PROJECT NO


---

**Subject:** SHEET: 3  
**Page Label:** [1] SHEET 3  
**Lock:** Unlocked  
**Author:** AutoCAD SHX Text



---

**Subject:** (XXXXX)  
**Page Label:** [1] SHEET 3  
**Lock:** Unlocked  
**Author:** AutoCAD SHX Text

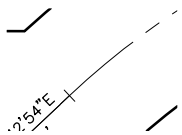

---

**Subject:** 30' 30'  
**Page Label:** [1] SHEET 3  
**Lock:** Unlocked  
**Author:** AutoCAD SHX Text

70.00'  
(H H H H)

**Subject:**  
**Page Label:** [1] SHEET 3 (XXXXXX)  
**Lock:** Unlocked  
**Author:** AutoCAD SHX Text

LAMBERT RC  
(80 FEET WIDE)

**Subject:**  
**Page Label:** [1] SHEET 3 (80 FEET WIDE)  
**Lock:** Unlocked  
**Author:** AutoCAD SHX Text




**Subject:**  
**Page Label:** [1] SHEET 3 WINDINGWALK FILING No. 1 AT MERIDIAN RANCH  
**Lock:** Unlocked  
**Author:** AutoCAD SHX Text

SHEET

**Subject:**  
**Page Label:** [1] SHEET 3 (XXXXXX)  
**Lock:** Unlocked  
**Author:** AutoCAD SHX Text

157  
7,500 SQ. FT.  
219' 45"


**Subject:**  
**Page Label:** [1] SHEET 3 7,500 SQ. FT.  
**Lock:** Unlocked  
**Author:** AutoCAD SHX Text

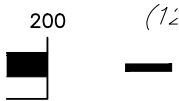

**Subject:**  
**Page Label:** [1] SHEET 3 (XXXXXX)  
**Lock:** Unlocked  
**Author:** AutoCAD SHX Text

159  
2154' 07"

**Subject:**  
**Page Label:** [1] SHEET 3 7,543 SQ. FT.  
**Lock:** Unlocked  
**Author:** AutoCAD SHX Text

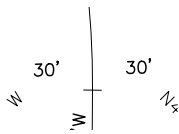

**Subject:**  
**Page Label:** [1] SHEET 3 30' 30'  
**Lock:** Unlocked  
**Author:** AutoCAD SHX Text

53.55'  
(XXXXXX)

**Subject:**  
**Page Label:** [1] SHEET 3 (XXXXXX)  
**Lock:** Unlocked  
**Author:** AutoCAD SHX Text



**Subject:**  
**Page Label:** [1] SHEET 3 (XXXXXX)  
**Lock:** Unlocked  
**Author:** AutoCAD SHX Text

82' L=23.1'  
(XXXX)

Subject:  
Page Label: [1] SHEET 3 (XXXXX)  
Lock: Unlocked  
Author: AutoCAD SHX Text

L=75.00'  
(XXXX)

Subject:  
Page Label: [1] SHEET 3 (XXXXX)  
Lock: Unlocked  
Author: AutoCAD SHX Text

±R 201 /  
OF 9  
CF \_ \_

Subject:  
Page Label: [1] SHEET 3 OF 9  
Lock: Unlocked  
Author: AutoCAD SHX Text

L=91.15'  
(XXXX)

Subject:  
Page Label: [1] SHEET 3 (XXXXX)  
Lock: Unlocked  
Author: AutoCAD SHX Text

60.00'  
(XXXX)

Subject:  
Page Label: [1] SHEET 3 (XXXXX)  
Lock: Unlocked  
Author: AutoCAD SHX Text

100  
I

Subject:  
Page Label: [1] SHEET 3 100  
Lock: Unlocked  
Author: AutoCAD SHX Text

186

7,894 SQ. FT.

161' \* 45.1'

Subject:  
Page Label: [1] SHEET 3 7,894 SQ. FT.  
Lock: Unlocked  
Author: AutoCAD SHX Text

176

8,934 SQ. FT.

56' \* 36'

Subject:  
Page Label: [1] SHEET 3 8,934 SQ. FT.  
Lock: Unlocked  
Author: AutoCAD SHX Text

W/CAP

BEARING

NO-BUILD DIM.

Subject:  
Page Label: [1] SHEET 3 (60 FEET WIDE)  
Lock: Unlocked  
Author: AutoCAD SHX Text


L=60.93'  
(XXXX)

Subject:  
Page Label: [1] SHEET 3 (XXXXX)  
Lock: Unlocked  
Author: AutoCAD SHX Text

140

**Subject:**  
**Page Label:** [1] SHEET 3  
**Lock:** Unlocked  
**Author:** AutoCAD SHX Text

9,036 SQ. FT.

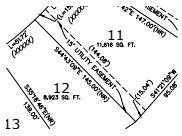

**Subject:**  
**Page Label:** [1] SHEET 3  
**Lock:** Unlocked  
**Author:** AutoCAD SHX Text

15' UTILITY EASEMENT

**Subject:**  
**Page Label:** [1] SHEET 3  
**Lock:** Unlocked  
**Author:** AutoCAD SHX Text

30' 30'



7.8

**Subject:**  
**Page Label:** [1] SHEET 3  
**Lock:** Unlocked  
**Author:** AutoCAD SHX Text

(XXXXXX)

191

**Subject:**  
**Page Label:** [1] SHEET 3  
**Lock:** Unlocked  
**Author:** AutoCAD SHX Text

8,284 SQ. FT.

169

**Subject:**  
**Page Label:** [1] SHEET 3  
**Lock:** Unlocked  
**Author:** AutoCAD SHX Text

8,506 SQ. FT.



**Subject:**  
**Page Label:** [1] SHEET 3  
**Lock:** Unlocked  
**Author:** AutoCAD SHX Text

(XXXXXX)

125.00' 15  
7,886 SQ. FT.

125.00'

**Subject:**  
**Page Label:** [1] SHEET 3  
**Lock:** Unlocked  
**Author:** AutoCAD SHX Text

7,886 SQ. FT.


**Subject:**  
**Page Label:** [1] SHEET 3  
**Lock:** Unlocked  
**Author:** AutoCAD SHX Text

(XXXXXX)

8

**Subject:**  
**Page Label:** [1] SHEET 3  
**Lock:** Unlocked  
**Author:** AutoCAD SHX Text

7,618 SQ. FT.

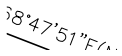

34  
7,275 SQ. FT.  
-53°39'00" W  
2 50'


**Subject:**  
**Page Label:** [1] SHEET 3  
**Lock:** Unlocked  
**Author:** AutoCAD SHX Text

7,275 SQ. FT.

137

**Subject:**  
**Page Label:** [1] SHEET 3  
**Lock:** Unlocked  
**Author:** AutoCAD SHX Text

10,062 SQ. FT.

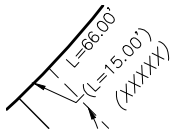

**Subject:**  
**Page Label:** [1] SHEET 3  
**Lock:** Unlocked  
**Author:** AutoCAD SHX Text

(L=15.00')

154  
8,491 SQ. FT.  
3°57' E

**Subject:**  
**Page Label:** [1] SHEET 3  
**Lock:** Unlocked  
**Author:** AutoCAD SHX Text

8,491 SQ. FT.

DATE: DECEMBER 2017
SHEET: 3 OF 9
PCD PROJECT NO. SF-____-

**Subject:**  
**Page Label:** [1] SHEET 3  
**Lock:** Unlocked  
**Author:** AutoCAD SHX Text

PCD PROJECT NO. SF-\_\_\_\_-




**Subject:**  
**Page Label:** [1] SHEET 3  
**Lock:** Unlocked  
**Author:** AutoCAD SHX Text

2

SEC. 30  
SEC. 31

**Subject:**  
**Page Label:** [1] SHEET 3  
**Lock:** Unlocked  
**Author:** AutoCAD SHX Text

SEC. 31

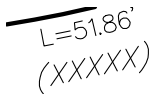


**Subject:**  
**Page Label:** [1] SHEET 3  
**Lock:** Unlocked  
**Author:** AutoCAD SHX Text

(XXXXX)

**Subject:**  
**Page Label:** [1] SHEET 3  
**Lock:** Unlocked  
**Author:** AutoCAD SHX Text

7,833 SQ. FT.

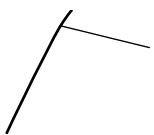

**Subject:**  
**Page Label:** [1] SHEET 3  
**Lock:** Unlocked  
**Author:** AutoCAD SHX Text

L=4.00'



Subject: (XXXXXX)  
 Page Label: [1] SHEET 3  
 Lock: Unlocked  
 Author: AutoCAD SHX Text



Subject: (XXXXXX)  
 Page Label: [1] SHEET 3  
 Lock: Unlocked  
 Author: AutoCAD SHX Text

174  
 7,878 SQ. FT.

60°50'48"

Subject: 7,878 SQ. FT.  
 Page Label: [1] SHEET 3  
 Lock: Unlocked  
 Author: AutoCAD SHX Text

19  
 8,125 SQ. FT.

COMMERCIAL

Subject: 8,125 SQ. FT.  
 Page Label: [1] SHEET 3  
 Lock: Unlocked  
 Author: AutoCAD SHX Text

Subject: (XXXXXX)  
 Page Label: [1] SHEET 3  
 Lock: Unlocked  
 Author: AutoCAD SHX Text

8.78  
 (XXXXXX)

Subject: (XXXXXX)  
 Page Label: [1] SHEET 3  
 Lock: Unlocked  
 Author: AutoCAD SHX Text

23  
 8,443 SQ. FT.

COMMERCIAL

Subject: 8,443 SQ. FT.  
 Page Label: [1] SHEET 3  
 Lock: Unlocked  
 Author: AutoCAD SHX Text

152  
 9,562 SQ. FT.

4'27"

Subject: 9,562 SQ. FT.  
 Page Label: [1] SHEET 3  
 Lock: Unlocked  
 Author: AutoCAD SHX Text

NR

Subject: NR  
 Page Label: [1] SHEET 3  
 Lock: Unlocked  
 Author: AutoCAD SHX Text

60 FEET WIDE  
 (60 FEET WIDE)  
 R WALLS

Subject: (60 FEET WIDE)  
 Page Label: [1] SHEET 3  
 Lock: Unlocked  
 Author: AutoCAD SHX Text



125.00  
17  
7,186 SQ. FT.  
50°34'47.2"

**Subject:**  
**Page Label:** [1] SHEET 3  
**Lock:** Unlocked  
**Author:** AutoCAD SHX Text

7,186 SQ. FT.

156  
7,500 SQ. FT.  
5°57'51.1"

**Subject:**  
**Page Label:** [1] SHEET 3  
**Lock:** Unlocked  
**Author:** AutoCAD SHX Text

7,500 SQ. FT.

30' 30'

**Subject:**  
**Page Label:** [1] SHEET 3  
**Lock:** Unlocked  
**Author:** AutoCAD SHX Text

30' 30'

(XXXXX)

**Subject:**  
**Page Label:** [1] SHEET 3  
**Lock:** Unlocked  
**Author:** AutoCAD SHX Text

(XXXXX)

29  
8,275 SQ. FT.  
53°39'00.0"

**Subject:**  
**Page Label:** [1] SHEET 3  
**Lock:** Unlocked  
**Author:** AutoCAD SHX Text

8,275 SQ. FT.

ALK FILING No. 1 AT MERIDIAN  
EL PASO COUNTY, COLORADO.

**Subject:**  
**Page Label:** [1] SHEET 3  
**Lock:** Unlocked  
**Author:** AutoCAD SHX Text

EL PASO COUNTY, COLORADO.

L=35.09' L=22'  
(XXXXX)

**Subject:**  
**Page Label:** [1] SHEET 3  
**Lock:** Unlocked  
**Author:** AutoCAD SHX Text

(XXXXX)

30'  
S89°38'53"E  
130.29'  
30'

**Subject:**  
**Page Label:** [1] SHEET 3  
**Lock:** Unlocked  
**Author:** AutoCAD SHX Text

30' 30'

(82.62)  
(12345)

**Subject:**  
**Page Label:** [1] SHEET 3  
**Lock:** Unlocked  
**Author:** AutoCAD SHX Text

(12345)

15' UTILITY EASEMENT

**Subject:**  
**Page Label:** [1] SHEET 3  
**Lock:** Unlocked  
**Author:** AutoCAD SHX Text

15' UTILITY EASEMENT

200  
7,615 SQ. FT.  
52' 24" WIDE

Subject:  
Page Label: [1] SHEET 3  
Lock: Unlocked  
Author: AutoCAD SHX Text

7,615 SQ. FT.

Subject:  
Page Label: [1] SHEET 3  
Lock: Unlocked  
Author: AutoCAD SHX Text

(XXXXX)

38

Subject:  
Page Label: [1] SHEET 3  
Lock: Unlocked  
Author: AutoCAD SHX Text

7,500 SQ. FT.

151  
8,923 SQ. FT.

Subject:  
Page Label: [1] SHEET 3  
Lock: Unlocked  
Author: AutoCAD SHX Text

8,923 SQ. FT.

STAPLETON DRIVE  
(EXISTING ROW 120' WIDE)

Subject:  
Page Label: [1] SHEET 3  
Lock: Unlocked  
Author: AutoCAD SHX Text

(EXISTING ROW 120' WIDE)

(60 FEET WIDE)  
58.10'

Subject:  
Page Label: [1] SHEET 3  
Lock: Unlocked  
Author: AutoCAD SHX Text


(60 FEET WIDE)

Subject:  
Page Label: [1] SHEET 3  
Lock: Unlocked  
Author: AutoCAD SHX Text

(60 FEET WIDE)

Subject:  
Page Label: [1] SHEET 3  
Lock: Unlocked  
Author: AutoCAD SHX Text

9,519 SQ. FT.

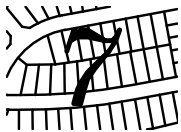

Subject:  
Page Label: [1] SHEET 3  
Lock: Unlocked  
Author: AutoCAD SHX Text

7

CIR.  
589°38'53"E  
181.25'

Subject:  
Page Label: [1] SHEET 3  
Lock: Unlocked  
Author: AutoCAD SHX Text

30' 30'



**Subject:**  
**Page Label:** [1] SHEET 3 (XXXXXX)  
**Lock:** Unlocked  
**Author:** AutoCAD SHX Text

**178**  
8,646 SQ. FT.  
N89°02'41"E 140.


**Subject:**  
**Page Label:** [1] SHEET 3 8,646 SQ. FT.  
**Lock:** Unlocked  
**Author:** AutoCAD SHX Text



**Subject:**  
**Page Label:** [1] SHEET 3 STAPLETON DRIVE  
**Lock:** Unlocked  
**Author:** AutoCAD SHX Text

65.00'  
(XXXXXX)

**Subject:**  
**Page Label:** [1] SHEET 3 (XXXXXX)  
**Lock:** Unlocked  
**Author:** AutoCAD SHX Text

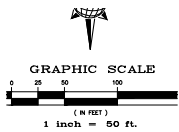

**Subject:**  
**Page Label:** [1] SHEET 3 GRAPHIC SCALE  
**Lock:** Unlocked  
**Author:** AutoCAD SHX Text

**21**  
8,006 SQ. FT.

**Subject:**  
**Page Label:** [1] SHEET 3 8,006 SQ. FT.  
**Lock:** Unlocked  
**Author:** AutoCAD SHX Text

L=47.40  
6.13'  
(XXXXXX)

**Subject:**  
**Page Label:** [1] SHEET 3 (XXXXXX)  
**Lock:** Unlocked  
**Author:** AutoCAD SHX Text

**28**  
7,292 SQ. FT.  
139'00"

**Subject:**  
**Page Label:** [1] SHEET 3 7,292 SQ. FT.  
**Lock:** Unlocked  
**Author:** AutoCAD SHX Text

L=51.72  
(XXXXXX)

**Subject:**  
**Page Label:** [1] SHEET 3 (XXXXXX)  
**Lock:** Unlocked  
**Author:** AutoCAD SHX Text

**5**

**Subject:**  
**Page Label:** [1] SHEET 3 5  
**Lock:** Unlocked  
**Author:** AutoCAD SHX Text

187

S57°57"E

**Subject:**  
**Page Label:** [1] SHEET 3  
**Lock:** Unlocked  
**Author:** AutoCAD SHX Text

8,764 SQ. FT.

L=20.89'  
L=3.4'  
(XXXXX)

**Subject:**  
**Page Label:** [1] SHEET 3  
**Lock:** Unlocked  
**Author:** AutoCAD SHX Text

(XXXXX)

S36°21'00"E

**Subject:**  
**Page Label:** [1] SHEET 3  
**Lock:** Unlocked  
**Author:** AutoCAD SHX Text

S36°21'00"E

30'

**Subject:**  
**Page Label:** [1] SHEET 3  
**Lock:** Unlocked  
**Author:** AutoCAD SHX Text

30' 30'

10.00'  
54.0'

**Subject:**  
**Page Label:** [1] SHEET 3  
**Lock:** Unlocked  
**Author:** AutoCAD SHX Text

10.00'

183

8,267 SQ. FT.

S55°09'53"E

**Subject:**  
**Page Label:** [1] SHEET 3  
**Lock:** Unlocked  
**Author:** AutoCAD SHX Text

8,267 SQ. FT.

50

**Subject:**  
**Page Label:** [1] SHEET 3  
**Lock:** Unlocked  
**Author:** AutoCAD SHX Text

50

**Subject:**  
**Page Label:** [1] SHEET 3  
**Lock:** Unlocked  
**Author:** AutoCAD SHX Text

8,290 SQ. FT.

L=56.00'  
(XXXXX)

**Subject:**  
**Page Label:** [1] SHEET 3  
**Lock:** Unlocked  
**Author:** AutoCAD SHX Text

(XXXXX)

L=55.0'  
L=10.0'  
(XXXXX)

**Subject:**  
**Page Label:** [1] SHEET 3  
**Lock:** Unlocked  
**Author:** AutoCAD SHX Text

(XXXXX)

170

c73°52'5"

**Subject:**  
**Page Label:** [1] SHEET 3  
**Lock:** Unlocked  
**Author:** AutoCAD SHX Text

8,075 SQ. FT.

146

7,990 SQ. FT.

WYR

**Subject:**  
**Page Label:** [1] SHEET 3  
**Lock:** Unlocked  
**Author:** AutoCAD SHX Text

7,990 SQ. FT.

N.T.S.

**Subject:**  
**Page Label:** [1] SHEET 3  
**Lock:** Unlocked  
**Author:** AutoCAD SHX Text

N.T.S.

60.00'  
(XXXX)

**Subject:**  
**Page Label:** [1] SHEET 3  
**Lock:** Unlocked  
**Author:** AutoCAD SHX Text

(XXXXX)

(XXXXX)  
L=80.00'

**Subject:**  
**Page Label:** [1] SHEET 3  
**Lock:** Unlocked  
**Author:** AutoCAD SHX Text

(XXXXX)



**Subject:**  
**Page Label:** [1] SHEET 3  
**Lock:** Unlocked  
**Author:** AutoCAD SHX Text

3

179

8,342 SQ. FT.

N1R0°20'13"E

**Subject:**  
**Page Label:** [1] SHEET 3  
**Lock:** Unlocked  
**Author:** AutoCAD SHX Text

8,342 SQ. FT.

( IN FEET )

.ch = 50

**Subject:**  
**Page Label:** [1] SHEET 3  
**Lock:** Unlocked  
**Author:** AutoCAD SHX Text

( IN FEET )

210

**Subject:**  
**Page Label:** [1] SHEET 3  
**Lock:** Unlocked  
**Author:** AutoCAD SHX Text

8,534 SQ. FT.



**Subject:**  
**Page Label:** [1] SHEET 3  
**Lock:** Unlocked  
**Author:** AutoCAD SHX Text

L=19.58'

30  
7,425 SQ. FT.

33'39"00"  
R

**Subject:**  
**Page Label:** [1] SHEET 3  
**Lock:** Unlocked  
**Author:** AutoCAD SHX Text

7,425 SQ. FT.

(82.62')

(12345)

**Subject:**  
**Page Label:** [1] SHEET 3  
**Lock:** Unlocked  
**Author:** AutoCAD SHX Text

(82.62')

196  
7,594 SQ. FT.

4\*05'37"  
R

**Subject:**  
**Page Label:** [1] SHEET 3  
**Lock:** Unlocked  
**Author:** AutoCAD SHX Text

7,594 SQ. FT.

177  
8,566 SQ. FT.

883'51'59"W

**Subject:**  
**Page Label:** [1] SHEET 3  
**Lock:** Unlocked  
**Author:** AutoCAD SHX Text

8,566 SQ. FT.

44'KWAY GLE  
Δ=19'13"05" R=1000'00"  
(60 FEET WIDE)

**Subject:**  
**Page Label:** [1] SHEET 3  
**Lock:** Unlocked  
**Author:** AutoCAD SHX Text

(60 FEET WIDE)

6

**Subject:**  
**Page Label:** [1] SHEET 3  
**Lock:** Unlocked  
**Author:** AutoCAD SHX Text

7,915 SQ. FT.

58.10'  
(XXXXXX)

**Subject:**  
**Page Label:** [1] SHEET 3  
**Lock:** Unlocked  
**Author:** AutoCAD SHX Text

(XXXXXX)

195  
7,408 SQ. FT.

3\*40'56"  
R

**Subject:**  
**Page Label:** [1] SHEET 3  
**Lock:** Unlocked  
**Author:** AutoCAD SHX Text

7,408 SQ. FT.

25  
8,484 SQ. FT.

29'47"  
R

**Subject:**  
**Page Label:** [1] SHEET 3  
**Lock:** Unlocked  
**Author:** AutoCAD SHX Text

8,484 SQ. FT.

**Subject:**  
**Page Label:** [1] SHEET 3  
**Lock:** Unlocked  
**Author:** AutoCAD SHX Text

(XXXXXX)



27  
8,516 SQ. FT.

37' 4"

**Subject:**  
**Page Label:** [1] SHEET 3  
**Lock:** Unlocked  
**Author:** AutoCAD SHX Text

8,516 SQ. FT.

149  
9,305 SQ. FT.

**Subject:**  
**Page Label:** [1] SHEET 3  
**Lock:** Unlocked  
**Author:** AutoCAD SHX Text

9,305 SQ. FT.

N36°20'59"W

**Subject:**  
**Page Label:** [1] SHEET 3  
**Lock:** Unlocked  
**Author:** AutoCAD SHX Text

N36°20'59"W

XXXXXX

**Subject:**  
**Page Label:** [1] SHEET 3  
**Lock:** Unlocked  
**Author:** AutoCAD SHX Text

(XXXXXX)

XXXXXX

**Subject:**  
**Page Label:** [1] SHEET 3  
**Lock:** Unlocked  
**Author:** AutoCAD SHX Text

(XXXXXX)

V/CAP

ARING

**Subject:**  
**Page Label:** [1] SHEET 3  
**Lock:** Unlocked  
**Author:** AutoCAD SHX Text

(60 FEET WIDE)

26  
8,406 SQ. FT.

39' 36"

**Subject:**  
**Page Label:** [1] SHEET 3  
**Lock:** Unlocked  
**Author:** AutoCAD SHX Text

8,406 SQ. FT.

185  
7,529 SQ. FT.

59' 25' 07"

**Subject:**  
**Page Label:** [1] SHEET 3  
**Lock:** Unlocked  
**Author:** AutoCAD SHX Text

7,529 SQ. FT.

50 ft.


**Subject:**  
**Page Label:** [1] SHEET 3  
**Lock:** Unlocked  
**Author:** AutoCAD SHX Text

(XXXXXX)


65.00'

**Subject:**  
**Page Label:** [1] SHEET 3  
**Lock:** Unlocked  
**Author:** AutoCAD SHX Text


(XXXXXX)

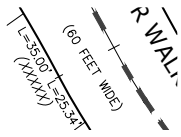

**Subject:** (60 FEET WIDE)  
**Page Label:** [1] SHEET 3  
**Lock:** Unlocked  
**Author:** AutoCAD SHX Text

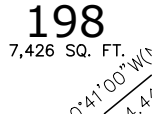

**Subject:** 7,426 SQ. FT.  
**Page Label:** [1] SHEET 3  
**Lock:** Unlocked  
**Author:** AutoCAD SHX Text

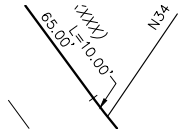

**Subject:** L=10.00'  
**Page Label:** [1] SHEET 3  
**Lock:** Unlocked  
**Author:** AutoCAD SHX Text




**Subject:** 8,558 SQ. FT.  
**Page Label:** [1] SHEET 3  
**Lock:** Unlocked  
**Author:** AutoCAD SHX Text




**Subject:** 30' 30'  
**Page Label:** [1] SHEET 3  
**Lock:** Unlocked  
**Author:** AutoCAD SHX Text



**Subject:** (XXXXXX)  
**Page Label:** [1] SHEET 3  
**Lock:** Unlocked  
**Author:** AutoCAD SHX Text

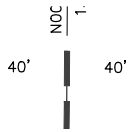

**Subject:** 40' 40'  
**Page Label:** [1] SHEET 3  
**Lock:** Unlocked  
**Author:** AutoCAD SHX Text

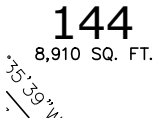

**Subject:** 8,910 SQ. FT.  
**Page Label:** [1] SHEET 3  
**Lock:** Unlocked  
**Author:** AutoCAD SHX Text



**Subject:** (XXXXXX)  
**Page Label:** [1] SHEET 3  
**Lock:** Unlocked  
**Author:** AutoCAD SHX Text



**Subject:** (60 FEET WIDE)  
**Page Label:** [1] SHEET 3  
**Lock:** Unlocked  
**Author:** AutoCAD SHX Text

SCALE

32  
7,500 SQ. FT.  
-53°39'00"  
5.00

**Subject:**  
**Page Label:** [1] SHEET 3  
**Lock:** Unlocked  
**Author:** AutoCAD SHX Text

7,500 SQ. FT.

143

**Subject:**  
**Page Label:** [1] SHEET 3  
**Lock:** Unlocked  
**Author:** AutoCAD SHX Text

9,365 SQ. FT.

L=51.71'  
(XXXXXX)

**Subject:**  
**Page Label:** [1] SHEET 3  
**Lock:** Unlocked  
**Author:** AutoCAD SHX Text

(XXXXXX)

SHEET 7

**Subject:**  
**Page Label:** [1] SHEET 3  
**Lock:** Unlocked  
**Author:** AutoCAD SHX Text

SHEET 77

DRAWN BY: LCG  
CHECKED BY: TAK

**Subject:**  
**Page Label:** [1] SHEET 3  
**Lock:** Unlocked  
**Author:** AutoCAD SHX Text

DRAWN BY: LCG

10  
10,783 SQ. FT.

(142.35'  
TILT

**Subject:**  
**Page Label:** [1] SHEET 3  
**Lock:** Unlocked  
**Author:** AutoCAD SHX Text

10,783 SQ. FT.

8

**Subject:**  
**Page Label:** [1] SHEET 3  
**Lock:** Unlocked  
**Author:** AutoCAD SHX Text

8

LAMBERT RC  
(80 FEET WIDE)

**Subject:**  
**Page Label:** [1] SHEET 3  
**Lock:** Unlocked  
**Author:** AutoCAD SHX Text

(80 FEET WIDE)

(XXXX)  
62.50'

**Subject:**  
**Page Label:** [1] SHEET 3  
**Lock:** Unlocked  
**Author:** AutoCAD SHX Text

(XXXXXX)

1 inch

**Subject:**  
**Page Label:** [1] SHEET 3  
**Lock:** Unlocked  
**Author:** AutoCAD SHX Text

7,834 SQ. FT.

**Subject:**  
**Page Label:** [1] SHEET 3 (XXXXXX)  
**Lock:** Unlocked  
**Author:** AutoCAD SHX Text

**Subject:**  
**Page Label:** [1] SHEET 3 (XXXXXX)  
**Lock:** Unlocked  
**Author:** AutoCAD SHX Text

**Subject:**  
**Page Label:** [1] SHEET 3 13.644 ACRES  
**Lock:** Unlocked  
**Author:** AutoCAD SHX Text

**Subject:**  
**Page Label:** [1] SHEET 3 L=16.00'  
**Lock:** Unlocked  
**Author:** AutoCAD SHX Text

**5**  
**Subject:**  
**Page Label:** [1] SHEET 3 9,125 SQ. FT.  
**Lock:** Unlocked  
**Author:** AutoCAD SHX Text


**Subject:**  
**Page Label:** [1] SHEET 3 (XXXXXX)  
**Lock:** Unlocked  
**Author:** AutoCAD SHX Text

**22**  
8,292 SQ. FT.  
**Subject:**  
**Page Label:** [1] SHEET 3 8,292 SQ. FT.  
**Lock:** Unlocked  
**Author:** AutoCAD SHX Text

**142**  
**Subject:**  
**Page Label:** [1] SHEET 3 9,038 SQ. FT.  
**Lock:** Unlocked  
**Author:** AutoCAD SHX Text

**173**  
7,968 SQ. FT.  
**Subject:**  
**Page Label:** [1] SHEET 3 7,968 SQ. FT.  
**Lock:** Unlocked  
**Author:** AutoCAD SHX Text

**Subject:**  
**Page Label:** [1] SHEET 3 (60 FEET WIDE)  
**Lock:** Unlocked  
**Author:** AutoCAD SHX Text

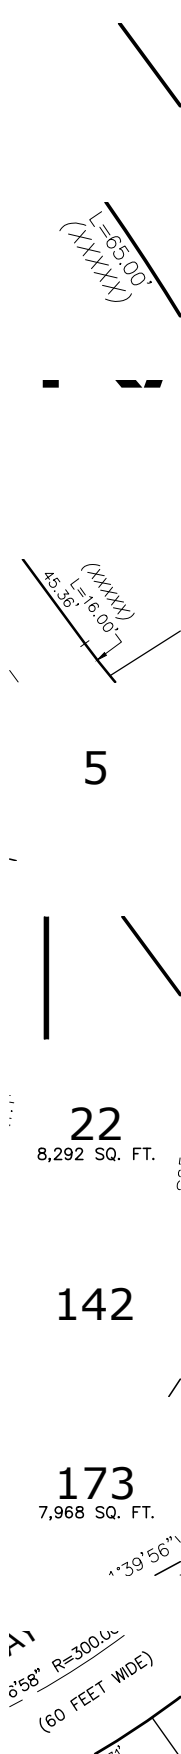

(XXXXXX)  
L=72.00'  
-1 F

Subject: (XXXXXX)  
Page Label: [1] SHEET 3  
Lock: Unlocked  
Author: AutoCAD SHX Text

Subject: (XXXXXX)  
Page Label: [1] SHEET 3  
Lock: Unlocked  
Author: AutoCAD SHX Text

20  
8,125 SQ. FT.

Subject: 8,125 SQ. FT.  
Page Label: [1] SHEET 3  
Lock: Unlocked  
Author: AutoCAD SHX Text

Subject: (XXXXXX)  
Page Label: [1] SHEET 3  
Lock: Unlocked  
Author: AutoCAD SHX Text

Subject: (XXXXXX)  
Page Label: [1] SHEET 3  
Lock: Unlocked  
Author: AutoCAD SHX Text

SEC. 29  
SEC. 32

Subject: SEC. 29  
Page Label: [1] SHEET 3  
Lock: Unlocked  
Author: AutoCAD SHX Text

24  
8,795 SQ. FT.

Subject: 8,795 SQ. FT.  
Page Label: [1] SHEET 3  
Lock: Unlocked  
Author: AutoCAD SHX Text

60.00'  
(XXXXX)

Subject: (XXXXXX)  
Page Label: [1] SHEET 3  
Lock: Unlocked  
Author: AutoCAD SHX Text

A1  
ø58" R=300.00'  
(60 FEET WIDE)

Subject: (60 FEET WIDE)  
Page Label: [1] SHEET 3  
Lock: Unlocked  
Author: AutoCAD SHX Text

TRACT /  
8.504 ACRES

Subject: 8.504 ACRES  
Page Label: [1] SHEET 3  
Lock: Unlocked  
Author: AutoCAD SHX Text

155  
7,800 SQ. FT.

118'34" / 4

**Subject:**  
**Page Label:** [1] SHEET 3  
**Lock:** Unlocked  
**Author:** AutoCAD SHX Text

7,800 SQ. FT.

124'4" / 127'1" / 147  
7,626 SQ. FT.

**Subject:**  
**Page Label:** [1] SHEET 3  
**Lock:** Unlocked  
**Author:** AutoCAD SHX Text

7,626 SQ. FT.

188

**Subject:**  
**Page Label:** [1] SHEET 3  
**Lock:** Unlocked  
**Author:** AutoCAD SHX Text

8,970 SQ. FT.

125'4" / 150'0" / 14  
8,407 SQ. FT.

**Subject:**  
**Page Label:** [1] SHEET 3  
**Lock:** Unlocked  
**Author:** AutoCAD SHX Text

8,407 SQ. FT.

175  
8,243 SQ. FT.

558'30"4" / 4

**Subject:**  
**Page Label:** [1] SHEET 3  
**Lock:** Unlocked  
**Author:** AutoCAD SHX Text

8,243 SQ. FT.

**Subject:**  
**Page Label:** [1] SHEET 3  
**Lock:** Unlocked  
**Author:** AutoCAD SHX Text

(XXXXXX)

33  
7,425 SQ. FT.

53'39"00" / 00

**Subject:**  
**Page Label:** [1] SHEET 3  
**Lock:** Unlocked  
**Author:** AutoCAD SHX Text

7,425 SQ. FT.

L=55.00'  
L=10.00'  
(XXXX)

**Subject:**  
**Page Label:** [1] SHEET 3  
**Lock:** Unlocked  
**Author:** AutoCAD SHX Text

L=10.00'

148  
7,976 SQ. FT.

100'0" / 100'0"

**Subject:**  
**Page Label:** [1] SHEET 3  
**Lock:** Unlocked  
**Author:** AutoCAD SHX Text

7,976 SQ. FT.

213

**Subject:**  
**Page Label:** [1] SHEET 3  
**Lock:** Unlocked  
**Author:** AutoCAD SHX Text

8,466 SQ. FT.

160

**Subject:**  
**Page Label:** [1] SHEET 3  
**Lock:** Unlocked  
**Author:** AutoCAD SHX Text

8,225 SQ. FT.

**Subject:**  
**Page Label:** [1] SHEET 3  
**Lock:** Unlocked  
**Author:** AutoCAD SHX Text

(XXXXX)

**Subject:**  
**Page Label:** [1] SHEET 3  
**Lock:** Unlocked  
**Author:** AutoCAD SHX Text

(XXXXX)

164


**Subject:**  
**Page Label:** [1] SHEET 3  
**Lock:** Unlocked  
**Author:** AutoCAD SHX Text

8,792 SQ. FT.

0


**Subject:**  
**Page Label:** [1] SHEET 3  
**Lock:** Unlocked  
**Author:** AutoCAD SHX Text

0

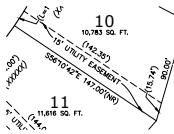

**Subject:**  
**Page Label:** [1] SHEET 3  
**Lock:** Unlocked  
**Author:** AutoCAD SHX Text

15' UTILITY EASEMENT

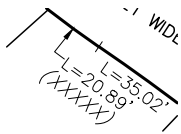

**Subject:**  
**Page Label:** [1] SHEET 3  
**Lock:** Unlocked  
**Author:** AutoCAD SHX Text

L=20.89'

**Subject:**  
**Page Label:** [1] SHEET 3  
**Lock:** Unlocked  
**Author:** AutoCAD SHX Text

30' 30'

172

7,800 SQ. FT.

**Subject:**  
**Page Label:** [1] SHEET 3  
**Lock:** Unlocked  
**Author:** AutoCAD SHX Text

7,800 SQ. FT.


<65'03" A

**Subject:**  
**Page Label:** [1] SHEET 3  
**Lock:** Unlocked  
**Author:** AutoCAD SHX Text


(XXXXX)





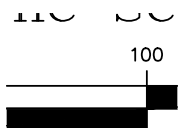


**Subject:** (XXXXX)  
**Page Label:** [1] SHEET 3  
**Lock:** Unlocked  
**Author:** AutoCAD SHX Text

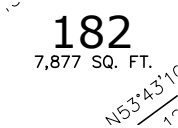


**Subject:** 7,877 SQ. FT.  
**Page Label:** [1] SHEET 3  
**Lock:** Unlocked  
**Author:** AutoCAD SHX Text




**Subject:** THE VISTAS FILING 1  
**Page Label:** [1] SHEET 3  
**Lock:** Unlocked  
**Author:** AutoCAD SHX Text

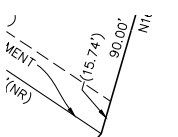


**Subject:** (15.74')  
**Page Label:** [1] SHEET 3  
**Lock:** Unlocked  
**Author:** AutoCAD SHX Text

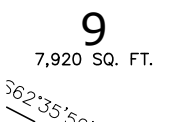

**Subject:** 7,920 SQ. FT.  
**Page Label:** [1] SHEET 3  
**Lock:** Unlocked  
**Author:** AutoCAD SHX Text

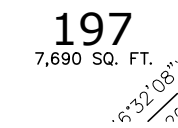

**Subject:** 7,690 SQ. FT.  
**Page Label:** [1] SHEET 3  
**Lock:** Unlocked  
**Author:** AutoCAD SHX Text

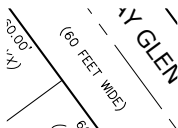

**Subject:** (60 FEET WIDE)  
**Page Label:** [1] SHEET 3  
**Lock:** Unlocked  
**Author:** AutoCAD SHX Text




**Subject:** (XXXXX)  
**Page Label:** [1] SHEET 3  
**Lock:** Unlocked  
**Author:** AutoCAD SHX Text

**Subject:** 7,913 SQ. FT.  
**Page Label:** [1] SHEET 3  
**Lock:** Unlocked  
**Author:** AutoCAD SHX Text

**Subject:** (XXXXX)  
**Page Label:** [1] SHEET 3  
**Lock:** Unlocked  
**Author:** AutoCAD SHX Text

---

**Subject:**  
**Page Label:** [1] SHEET 3 (XXXXX)  
**Lock:** Unlocked  
**Author:** AutoCAD SHX Text

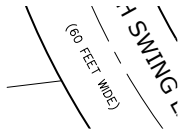

---

**Subject:**  
**Page Label:** [1] SHEET 3 (60 FEET WIDE)  
**Lock:** Unlocked  
**Author:** AutoCAD SHX Text




---

**Subject:**  
**Page Label:** [1] SHEET 3 (XXXXX)  
**Lock:** Unlocked  
**Author:** AutoCAD SHX Text




---

**Subject:**  
**Page Label:** [1] SHEET 3 (XXXXX)  
**Lock:** Unlocked  
**Author:** AutoCAD SHX Text

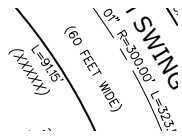


---

**Subject:**  
**Page Label:** [1] SHEET 3 (60 FEET WIDE)  
**Lock:** Unlocked  
**Author:** AutoCAD SHX Text

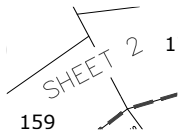

---

**Subject:**  
**Page Label:** [1] SHEET 3 SHEET 22  
**Lock:** Unlocked  
**Author:** AutoCAD SHX Text

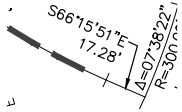


---

**Subject:**  
**Page Label:** [1] SHEET 3 S66°15'51"E17.28'  
**Lock:** Unlocked  
**Author:** AutoCAD SHX Text



---

**Subject:**  
**Page Label:** [1] SHEET 3 (XXXXX)  
**Lock:** Unlocked  
**Author:** AutoCAD SHX Text

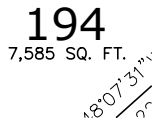

---

**Subject:**  
**Page Label:** [1] SHEET 3 7,585 SQ. FT.  
**Lock:** Unlocked  
**Author:** AutoCAD SHX Text



---

**Subject:**  
**Page Label:** [1] SHEET 3 L=11.54'  
**Lock:** Unlocked  
**Author:** AutoCAD SHX Text

-----  
**Subject:**  
**Page Label:** [1] SHEET 3 (XXXXXX)  
**Lock:** Unlocked  
**Author:** AutoCAD SHX Text

-----  
**Subject:**  
**Page Label:** [1] SHEET 3 (XXXXXX)  
**Lock:** Unlocked  
**Author:** AutoCAD SHX Text

212

-----  
**Subject:**  
**Page Label:** [1] SHEET 3 8,194 SQ. FT.  
**Lock:** Unlocked  
**Author:** AutoCAD SHX Text

-----  
**Subject:**  
**Page Label:** [1] SHEET 3 (XXXXXX)  
**Lock:** Unlocked  
**Author:** AutoCAD SHX Text

-----  
**Subject:**  
**Page Label:** [1] SHEET 3 (XXXXXX)  
**Lock:** Unlocked  
**Author:** AutoCAD SHX Text

-----  
**Subject:**  
**Page Label:** [1] SHEET 3 30' 30'  
**Lock:** Unlocked  
**Author:** AutoCAD SHX Text

-----  
**Subject:**  
**Page Label:** [1] SHEET 3 DATE: DECEMBER 2017  
**Lock:** Unlocked  
**Author:** AutoCAD SHX Text

DATE: DECEMBER 2017
SHEET: 3 OF 9
PCD PROJECT NO. SF-___-

192

-----  
**Subject:**  
**Page Label:** [1] SHEET 3 8,283 SQ. FT.  
**Lock:** Unlocked  
**Author:** AutoCAD SHX Text

-----  
**Subject:**  
**Page Label:** [1] SHEET 3 (XXXXXX)  
**Lock:** Unlocked  
**Author:** AutoCAD SHX Text

50

-----  
**Subject:**  
**Page Label:** [1] SHEET 3 50  
**Lock:** Unlocked  
**Author:** AutoCAD SHX Text

181  
7,726 SQ. FT.

N59°06'2" / 2

**Subject:**  
**Page Label:** [1] SHEET 3  
**Lock:** Unlocked  
**Author:** AutoCAD SHX Text

7,726 SQ. FT.

193  
7,673 SQ. FT.

N36°58'W / 2

**Subject:**  
**Page Label:** [1] SHEET 3  
**Lock:** Unlocked  
**Author:** AutoCAD SHX Text

7,673 SQ. FT.

25

**Subject:**  
**Page Label:** [1] SHEET 3  
**Lock:** Unlocked  
**Author:** AutoCAD SHX Text

25

65.00'  
(XXXXXX)

**Subject:**  
**Page Label:** [1] SHEET 3  
**Lock:** Unlocked  
**Author:** AutoCAD SHX Text

(XXXXXX)



**Subject:**  
**Page Label:** [1] SHEET 3  
**Lock:** Unlocked  
**Author:** AutoCAD SHX Text

A PARCEL OF LAND LOCATED IN A PORTION OF SECTION 29, 30, AND 32 IN TOWNSHIP 12 SOUTH, RANGE 64 WEST OF THE 6TH PRINCIPAL MERIDIAN

168

**Subject:**  
**Page Label:** [1] SHEET 3  
**Lock:** Unlocked  
**Author:** AutoCAD SHX Text

9,012 SQ. FT.



**Subject:**  
**Page Label:** [1] SHEET 3  
**Lock:** Unlocked  
**Author:** AutoCAD SHX Text

L=24.49'

158  
7,350 SQ. FT.

S1°42'33" / 2


**Subject:**  
**Page Label:** [1] SHEET 3  
**Lock:** Unlocked  
**Author:** AutoCAD SHX Text

7,350 SQ. FT.

TRACT /  
8.504 ACRES

**Subject:**  
**Page Label:** [1] SHEET 3  
**Lock:** Unlocked  
**Author:** AutoCAD SHX Text

8.504 ACRES

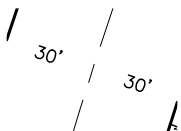

**Subject:**  
**Page Label:** [1] SHEET 3  
**Lock:** Unlocked  
**Author:** AutoCAD SHX Text

30' 30'

(XXXXXX)  
L=65.00'

-----  
**Subject:**  
**Page Label:** [1] SHEET 3 (XXXXXX)  
**Lock:** Unlocked  
**Author:** AutoCAD SHX Text

(XXXXXX)  
L=65.00'

-----  
**Subject:**  
**Page Label:** [1] SHEET 3 (XXXXXX)  
**Lock:** Unlocked  
**Author:** AutoCAD SHX Text

7

-----  
**Subject:**  
**Page Label:** [1] SHEET 3 7,661 SQ. FT.  
**Lock:** Unlocked  
**Author:** AutoCAD SHX Text

13  
8,925 SQ. FT.  
5.3' 3.96"


-----  
**Subject:**  
**Page Label:** [1] SHEET 3 8,925 SQ. FT.  
**Lock:** Unlocked  
**Author:** AutoCAD SHX Text

(XXXXXX)  
.29' L=50'

-----  
**Subject:**  
**Page Label:** [1] SHEET 3 (XXXXXX)  
**Lock:** Unlocked  
**Author:** AutoCAD SHX Text

211

-----  
**Subject:**  
**Page Label:** [1] SHEET 3 8,311 SQ. FT.  
**Lock:** Unlocked  
**Author:** AutoCAD SHX Text

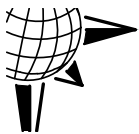

-----  
**Subject:**  
**Page Label:** [1] SHEET 3 30' 30'  
**Lock:** Unlocked  
**Author:** AutoCAD SHX Text

DRAWN BY: LCG  
CHECKED BY: TAK

-----  
**Subject:**  
**Page Label:** [1] SHEET 3 CHECKED BY: TAK  
**Lock:** Unlocked  
**Author:** AutoCAD SHX Text

L=51.86  
(XXXXXX)

-----  
**Subject:**  
**Page Label:** [1] SHEET 3 (XXXXXX)  
**Lock:** Unlocked  
**Author:** AutoCAD SHX Text

200

-----  
**Subject:**  
**Page Label:** [1] SHEET 3 200  
**Lock:** Unlocked  
**Author:** AutoCAD SHX Text

|

ft.

Subject:  
Page Label: [1] SHEET 3  
Lock: Unlocked  
Author: AutoCAD SHX Text

ft.

SEC. 29  
SEC. 32

Subject:  
Page Label: [1] SHEET 3  
Lock: Unlocked  
Author: AutoCAD SHX Text

SEC. 32

35


53'39.00"

Subject:  
Page Label: [1] SHEET 3  
Lock: Unlocked  
Author: AutoCAD SHX Text

7,275 SQ. FT.

Subject:  
Page Label: [1] SHEET 3  
Lock: Unlocked  
Author: AutoCAD SHX Text

(XXXXXX)

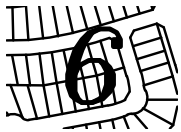

Subject:  
Page Label: [1] SHEET 3  
Lock: Unlocked  
Author: AutoCAD SHX Text

6

L=57.11'  
(XXXXXX)


Subject:  
Page Label: [1] SHEET 3  
Lock: Unlocked  
Author: AutoCAD SHX Text

(XXXXXX)

50

Subject:  
Page Label: [1] SHEET 3  
Lock: Unlocked  
Author: AutoCAD SHX Text

50

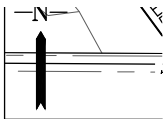

Subject:  
Page Label: [1] SHEET 3  
Lock: Unlocked  
Author: AutoCAD SHX Text

30' 30'

7  
(HHHH)  
85.00'

Subject:  
Page Label: [1] SHEET 3  
Lock: Unlocked  
Author: AutoCAD SHX Text

(XXXXXX)

(HHHH)  
L=56.00'

Subject:  
Page Label: [1] SHEET 3  
Lock: Unlocked  
Author: AutoCAD SHX Text

(XXXXXX)

145  
8,391 SQ. FT.  
S 42° W

**Subject:** 8,391 SQ. FT.  
**Page Label:** [1] SHEET 3  
**Lock:** Unlocked  
**Author:** AutoCAD SHX Text

(XXXXX)  
L=81.16'

**Subject:** (XXXXX)  
**Page Label:** [1] SHEET 3  
**Lock:** Unlocked  
**Author:** AutoCAD SHX Text

140  
141

**Subject:** (XXXXX)  
**Page Label:** [1] SHEET 3  
**Lock:** Unlocked  
**Author:** AutoCAD SHX Text

140  
SHEET  
141  
A

**Subject:** SHEET 44  
**Page Label:** [1] SHEET 3  
**Lock:** Unlocked  
**Author:** AutoCAD SHX Text

30.70'

**Subject:** 30' 30'  
**Page Label:** [1] SHEET 3  
**Lock:** Unlocked  
**Author:** AutoCAD SHX Text

SEC. 30  
SEC. 31

**Subject:** SEC. 30  
**Page Label:** [1] SHEET 3  
**Lock:** Unlocked  
**Author:** AutoCAD SHX Text

**Subject:** (60 FEET WIDE)  
**Page Label:** [1] SHEET 3  
**Lock:** Unlocked  
**Author:** AutoCAD SHX Text

140

**Subject:** (XXXXX)  
**Page Label:** [1] SHEET 3  
**Lock:** Unlocked  
**Author:** AutoCAD SHX Text

L=7200  
L=15,000'  
(XXXXX)

**Subject:** (L=15.00')  
**Page Label:** [1] SHEET 3  
**Lock:** Unlocked  
**Author:** AutoCAD SHX Text


201  
8,079 SQ. FT.  
S 35° W 140'

**Subject:** 8,079 SQ. FT.  
**Page Label:** [1] SHEET 3  
**Lock:** Unlocked  
**Author:** AutoCAD SHX Text






**Subject:**  
**Page Label:** [1] SHEET 3 (XXXXXX)  
**Lock:** Unlocked  
**Author:** AutoCAD SHX Text

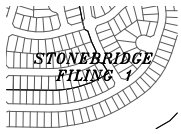

**Subject:**  
**Page Label:** [1] SHEET 3 STONEBRIDGE FILING 1  
**Lock:** Unlocked  
**Author:** AutoCAD SHX Text

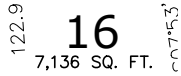


**Subject:**  
**Page Label:** [1] SHEET 3 7,136 SQ. FT.  
**Lock:** Unlocked  
**Author:** AutoCAD SHX Text




**Subject:**  
**Page Label:** [1] SHEET 3 8,384 SQ. FT.  
**Lock:** Unlocked  
**Author:** AutoCAD SHX Text



**Subject:**  
**Page Label:** [1] SHEET 3 (XXXXXX)  
**Lock:** Unlocked  
**Author:** AutoCAD SHX Text

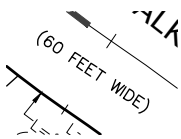


**Subject:**  
**Page Label:** [1] SHEET 3 (60 FEET WIDE)  
**Lock:** Unlocked  
**Author:** AutoCAD SHX Text

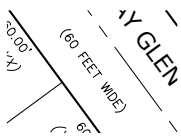


**Subject:**  
**Page Label:** [1] SHEET 3 (60 FEET WIDE)  
**Lock:** Unlocked  
**Author:** AutoCAD SHX Text



**Subject:**  
**Page Label:** [1] SHEET 3 4  
**Lock:** Unlocked  
**Author:** AutoCAD SHX Text

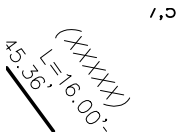

**Subject:**  
**Page Label:** [1] SHEET 3 (XXXXXX)  
**Lock:** Unlocked  
**Author:** AutoCAD SHX Text

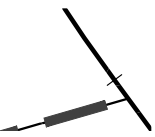

**Subject:**  
**Page Label:** [1] SHEET 3 5.00'  
**Lock:** Unlocked  
**Author:** AutoCAD SHX Text

-----  
**Subject:**  
**Page Label:** [1] SHEET 3 (XXXXX)  
**Lock:** Unlocked  
**Author:** AutoCAD SHX Text

36

-----  
**Subject:**  
**Page Label:** [1] SHEET 3 7,425 SQ. FT.  
**Lock:** Unlocked  
**Author:** AutoCAD SHX Text

60.00'  
(HHHH)

-----  
**Subject:**  
**Page Label:** [1] SHEET 3 (XXXXX)  
**Lock:** Unlocked  
**Author:** AutoCAD SHX Text

153  
8,917 SQ. FT.  
4'14"E(N)

-----  
**Subject:**  
**Page Label:** [1] SHEET 3 8,917 SQ. FT.  
**Lock:** Unlocked  
**Author:** AutoCAD SHX Text

-----  
**Subject:**  
**Page Label:** [1] SHEET 3 L=8.00'  
**Lock:** Unlocked  
**Author:** AutoCAD SHX Text

2'

L=57.11'  
(XXXXX)

-----  
**Subject:**  
**Page Label:** [1] SHEET 3 (XXXXX)  
**Lock:** Unlocked  
**Author:** AutoCAD SHX Text

31  
7,500 SQ. FT.  
53'39.00"  
5.10'

-----  
**Subject:**  
**Page Label:** [1] SHEET 3 7,500 SQ. FT.  
**Lock:** Unlocked  
**Author:** AutoCAD SHX Text

12  
8,923 SQ. FT.  
3'46"E(N)

-----  
**Subject:**  
**Page Label:** [1] SHEET 3 8,923 SQ. FT.  
**Lock:** Unlocked  
**Author:** AutoCAD SHX Text

-----  
+-----+  
(60 FEET WIDE)  
-----  
58.10'

-----  
**Subject:**  
**Page Label:** [1] SHEET 3 (60 FEET WIDE)  
**Lock:** Unlocked  
**Author:** AutoCAD SHX Text

184  
7,546 SQ. FT.  
N57°32'14"  
3.4

-----  
**Subject:**  
**Page Label:** [1] SHEET 3 7,546 SQ. FT.  
**Lock:** Unlocked  
**Author:** AutoCAD SHX Text

(XXXXX)  
L=66.00'

-----  
**Subject:**  
**Page Label:** [1] SHEET 3 (XXXXXX)  
**Lock:** Unlocked  
**Author:** AutoCAD SHX Text

N36°20'59"W  
37'

-----  
**Subject:**  
**Page Label:** [1] SHEET 3 N36°20'59"W  
**Lock:** Unlocked  
**Author:** AutoCAD SHX Text

-----  
/

-----  
**Subject:**  
**Page Label:** [1] SHEET 3 (XXXXXX)  
**Lock:** Unlocked  
**Author:** AutoCAD SHX Text

(XXXXX)  
53.00'

-----  
**Subject:**  
**Page Label:** [1] SHEET 3 (XXXXXX)  
**Lock:** Unlocked  
**Author:** AutoCAD SHX Text

-----  
/

-----  
**Subject:**  
**Page Label:** [1] SHEET 3 (XXXXXX)  
**Lock:** Unlocked  
**Author:** AutoCAD SHX Text

60.00'  
(XXXX)

-----  
**Subject:**  
**Page Label:** [1] SHEET 3 (XXXXXX)  
**Lock:** Unlocked  
**Author:** AutoCAD SHX Text

SWING  
60 FEET WIDE  
L=91.5'  
(XXXX)

-----  
**Subject:**  
**Page Label:** [1] SHEET 3 (60 FEET WIDE)  
**Lock:** Unlocked  
**Author:** AutoCAD SHX Text

( IN FEET )  
1 inch =

-----  
**Subject:**  
**Page Label:** [1] SHEET 3 1 inch =  
**Lock:** Unlocked  
**Author:** AutoCAD SHX Text

60 FEET WIDE  
L=74.17'

-----  
**Subject:**  
**Page Label:** [1] SHEET 3 (60 FEET WIDE)  
**Lock:** Unlocked  
**Author:** AutoCAD SHX Text

(XXXXX)  
L=74.17'

-----  
**Subject:**  
**Page Label:** [1] SHEET 3 (XXXXXX)  
**Lock:** Unlocked  
**Author:** AutoCAD SHX Text

(XXXXX)  
76.25'

-----  
**Subject:**  
**Page Label:** [1] SHEET 3 (XXXXX)  
**Lock:** Unlocked  
**Author:** AutoCAD SHX Text

37

-----  
**Subject:**  
**Page Label:** [1] SHEET 3 7,500 SQ. FT.  
**Lock:** Unlocked  
**Author:** AutoCAD SHX Text

163

-----  
**Subject:**  
**Page Label:** [1] SHEET 3 8,498 SQ. FT.  
**Lock:** Unlocked  
**Author:** AutoCAD SHX Text

-----  
**Subject:**  
**Page Label:** [1] SHEET 3 22.00'  
**Lock:** Unlocked  
**Author:** AutoCAD SHX Text

199

7,535 SQ. FT.  
- 4'34" AO" W  
3.1

-----  
**Subject:**  
**Page Label:** [1] SHEET 3 7,535 SQ. FT.  
**Lock:** Unlocked  
**Author:** AutoCAD SHX Text

(82.62') = CAS  
(12345) = ADI  
- - - = MAT

-----  
**Subject:**  
**Page Label:** [1] SHEET 3 8,178 SQ. FT.  
**Lock:** Unlocked  
**Author:** AutoCAD SHX Text

171

7,800 SQ. FT.  
669'34" C

-----  
**Subject:**  
**Page Label:** [1] SHEET 3 7,800 SQ. FT.  
**Lock:** Unlocked  
**Author:** AutoCAD SHX Text

L=65.00'  
(XXXXX)

-----  
**Subject:**  
**Page Label:** [1] SHEET 3 (XXXXX)  
**Lock:** Unlocked  
**Author:** AutoCAD SHX Text

(XXXXX)  
65.00' L=10

-----  
**Subject:**  
**Page Label:** [1] SHEET 3 (XXXXX)  
**Lock:** Unlocked  
**Author:** AutoCAD SHX Text

-----  
**Subject:**  
**Page Label:** [1] SHEET 3 (XXXXX)  
**Lock:** Unlocked  
**Author:** AutoCAD SHX Text

-----  
**Subject:**  
**Page Label:** [1] SHEET 4 (XXXXXX)  
**Lock:** Unlocked  
**Author:** AutoCAD SHX Text



-----  
**Subject:**  
**Page Label:** [1] SHEET 4 (60 FEET WIDE)  
**Lock:** Unlocked  
**Author:** AutoCAD SHX Text

-----  
**Subject:**  
**Page Label:** [1] SHEET 4 (XXXXXX)  
**Lock:** Unlocked  
**Author:** AutoCAD SHX Text



-----  
**Subject:**  
**Page Label:** [1] SHEET 4 (XXXXXX)  
**Lock:** Unlocked  
**Author:** AutoCAD SHX Text




-----  
**Subject:**  
**Page Label:** [1] SHEET 4 (60 FEET WIDE)  
**Lock:** Unlocked  
**Author:** AutoCAD SHX Text

-----  
**Subject:**  
**Page Label:** [1] SHEET 4 7,894 SQ. FT.  
**Lock:** Unlocked  
**Author:** AutoCAD SHX Text

190

-----  
**Subject:**  
**Page Label:** [1] SHEET 4 7,989 SQ. FT.  
**Lock:** Unlocked  
**Author:** AutoCAD SHX Text

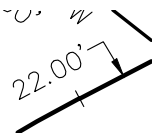

-----  
**Subject:**  
**Page Label:** [1] SHEET 4 22.00'  
**Lock:** Unlocked  
**Author:** AutoCAD SHX Text

195

-----  
**Subject:**  
**Page Label:** [1] SHEET 4 7,408 SQ. FT.  
**Lock:** Unlocked  
**Author:** AutoCAD SHX Text

-----  
**Subject:**  
**Page Label:** [1] SHEET 4 7,851 SQ. FT.  
**Lock:** Unlocked  
**Author:** AutoCAD SHX Text

SHEET

3

**Subject:**  
**Page Label:** [1] SHEET 4  
**Lock:** Unlocked  
**Author:** AutoCAD SHX Text

(XXXXX)



**Subject:**  
**Page Label:** [1] SHEET 4  
**Lock:** Unlocked  
**Author:** AutoCAD SHX Text

WINDINGWALK FILING No. 1 AT MERIDIAN RANCH A PARCEL OF LAND LOCATED IN A PORTION OF SECTION 29, 30, AND 32 IN TOWNSHIP 12 SOUTH, RANGE 64 WEST OF THE 6TH PRINCIPAL MERIDIAN EL PASO COUNTY, COLORADO.

193

**Subject:**  
**Page Label:** [1] SHEET 4  
**Lock:** Unlocked  
**Author:** AutoCAD SHX Text

7,673 SQ. FT.

**LEGEND**  
● = FOUND MONUMENT AS SHOWN  
○ = FOUND AS REBAR WITH CAP PLS 34583  
■ = SET IN REBAR W/CAP PLS 34583  
NR = NON-RADIAL BEARING  
(EASE) = EASEMENT OR NO-BUILD DIM.  
(2345) = ADDRESS  
--- = MATCHLINE

**Subject:**  
**Page Label:** [1] SHEET 4  
**Lock:** Unlocked  
**Author:** AutoCAD SHX Text

= FOUND MONUMENT AS SHOWN = FOUND #4 REBAR WITH CAP PLS 34583 = SET #4 REBAR W/CAP PLS 34583 = NON-RADIAL BEARING = EASEMENT OR NO-BUILD DIM. = ADDRESS ADDRESS = MATCHLINE

DRAWN BY: LCG  
CHECKED BY: TAK

**Subject:**  
**Page Label:** [1] SHEET 4  
**Lock:** Unlocked  
**Author:** AutoCAD SHX Text

DRAWN BY: LCG

136

7,500 SQ. FT.

12' 38" W 12'

**Subject:**  
**Page Label:** [1] SHEET 4  
**Lock:** Unlocked  
**Author:** AutoCAD SHX Text

7,500 SQ. FT.

(XXXXX)  
L=75.00'

**Subject:**  
**Page Label:** [1] SHEET 4  
**Lock:** Unlocked  
**Author:** AutoCAD SHX Text

(XXXXX)

**Subject:**  
**Page Label:** [1] SHEET 4  
**Lock:** Unlocked  
**Author:** AutoCAD SHX Text

(XXXXX)

(XXXXX)  
59.59'

6

**Subject:**  
**Page Label:** [1] SHEET 4  
**Lock:** Unlocked  
**Author:** AutoCAD SHX Text


(XXXXX)

**Subject:**  
**Page Label:** [1] SHEET 4  
**Lock:** Unlocked  
**Author:** AutoCAD SHX Text


(XXXXX)

(XXXXXX)  
55.32'

Subject:  
Page Label: [1] SHEET 4 (XXXXXX)  
Lock: Unlocked  
Author: AutoCAD SHX Text

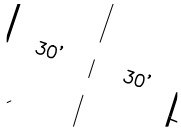


Subject:  
Page Label: [1] SHEET 4 30' 30'  
Lock: Unlocked  
Author: AutoCAD SHX Text

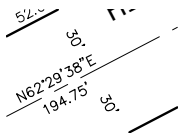

Subject:  
Page Label: [1] SHEET 4 30' 30'  
Lock: Unlocked  
Author: AutoCAD SHX Text

139  
7,905 SQ. FT.

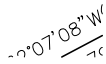


Subject:  
Page Label: [1] SHEET 4 7,905 SQ. FT.  
Lock: Unlocked  
Author: AutoCAD SHX Text

Subject:  
Page Label: [1] SHEET 4 (XXXXXX)  
Lock: Unlocked  
Author: AutoCAD SHX Text



Subject:  
Page Label: [1] SHEET 4 (XXXXXX)  
Lock: Unlocked  
Author: AutoCAD SHX Text

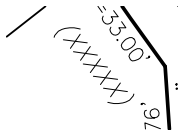

Subject:  
Page Label: [1] SHEET 4 (XXXXXX)  
Lock: Unlocked  
Author: AutoCAD SHX Text

4  
9,519 SQ. FT.

N 88° 17' 42\"/>

Subject:  
Page Label: [1] SHEET 4 9,519 SQ. FT.  
Lock: Unlocked  
Author: AutoCAD SHX Text



Subject:  
Page Label: [1] SHEET 4 (XXXXXX)  
Lock: Unlocked  
Author: AutoCAD SHX Text

67  
8,761 SQ. FT.

Subject:  
Page Label: [1] SHEET 4 8,761 SQ. FT.  
Lock: Unlocked  
Author: AutoCAD SHX Text

-----  
**Subject:**  
**Page Label:** [1] SHEET 4 (XXXXXX)  
**Lock:** Unlocked  
**Author:** AutoCAD SHX Text

214  
9,326 SQ. FT.  
79'  
60'

-----  
**Subject:**  
**Page Label:** [1] SHEET 4 9,326 SQ. FT.  
**Lock:** Unlocked  
**Author:** AutoCAD SHX Text

(XXXXXX)  
65.00'

-----  
**Subject:**  
**Page Label:** [1] SHEET 4 (XXXXXX)  
**Lock:** Unlocked  
**Author:** AutoCAD SHX Text

209  
8,228 SQ. FT.  
170°18'14"E(N)

-----  
**Subject:**  
**Page Label:** [1] SHEET 4 8,228 SQ. FT.  
**Lock:** Unlocked  
**Author:** AutoCAD SHX Text

Y

-----  
**Subject:**  
**Page Label:** [1] SHEET 4 (XXXXXX)  
**Lock:** Unlocked  
**Author:** AutoCAD SHX Text

/

-----  
**Subject:**  
**Page Label:** [1] SHEET 4 (XXXXXX)  
**Lock:** Unlocked  
**Author:** AutoCAD SHX Text

215  
8,333 SQ. FT.  
35' W

-----  
**Subject:**  
**Page Label:** [1] SHEET 4 8,333 SQ. FT.  
**Lock:** Unlocked  
**Author:** AutoCAD SHX Text

/

-----  
**Subject:**  
**Page Label:** [1] SHEET 4 (XXXXXX)  
**Lock:** Unlocked  
**Author:** AutoCAD SHX Text

-----  
**Subject:**  
**Page Label:** [1] SHEET 4 (XXXXXX)  
**Lock:** Unlocked  
**Author:** AutoCAD SHX Text

78

-----  
**Subject:**  
**Page Label:** [1] SHEET 4 7,783 SQ. FT.  
**Lock:** Unlocked  
**Author:** AutoCAD SHX Text



NR


**Subject:**  
**Page Label:** [1] SHEET 4  
**Lock:** Unlocked  
**Author:** AutoCAD SHX Text

NR



**Subject:**  
**Page Label:** [1] SHEET 4  
**Lock:** Unlocked  
**Author:** AutoCAD SHX Text

(XXXXX)

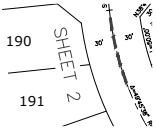

**Subject:**  
**Page Label:** [1] SHEET 4  
**Lock:** Unlocked  
**Author:** AutoCAD SHX Text

SHEET 22

192

**Subject:**  
**Page Label:** [1] SHEET 4  
**Lock:** Unlocked  
**Author:** AutoCAD SHX Text

8,283 SQ. FT.



**Subject:**  
**Page Label:** [1] SHEET 4  
**Lock:** Unlocked  
**Author:** AutoCAD SHX Text

5

WIDE)

**Subject:**  
**Page Label:** [1] SHEET 4  
**Lock:** Unlocked  
**Author:** AutoCAD SHX Text

(80 FEET WIDE)




**Subject:**  
**Page Label:** [1] SHEET 4  
**Lock:** Unlocked  
**Author:** AutoCAD SHX Text

L=4.00'

**Subject:**  
**Page Label:** [1] SHEET 4  
**Lock:** Unlocked  
**Author:** AutoCAD SHX Text

(60 FEET WIDE)

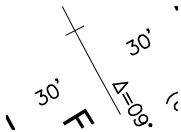

**Subject:**  
**Page Label:** [1] SHEET 4  
**Lock:** Unlocked  
**Author:** AutoCAD SHX Text

30' 30'



**Subject:**  
**Page Label:** [1] SHEET 4  
**Lock:** Unlocked  
**Author:** AutoCAD SHX Text

(XXXXX)

**TRACT A**  
8.504 ACRES  
S 39° 09' W 141'

**Subject:** 8.504 ACRES  
**Page Label:** [1] SHEET 4  
**Lock:** Unlocked  
**Author:** AutoCAD SHX Text

25

**Subject:** 25  
**Page Label:** [1] SHEET 4  
**Lock:** Unlocked  
**Author:** AutoCAD SHX Text

1  
2

**Subject:** (XXXXX)  
**Page Label:** [1] SHEET 4  
**Lock:** Unlocked  
**Author:** AutoCAD SHX Text

3

**Subject:** (XXXXX)  
**Page Label:** [1] SHEET 4  
**Lock:** Unlocked  
**Author:** AutoCAD SHX Text

3

**Subject:** (XXXXX)  
**Page Label:** [1] SHEET 4  
**Lock:** Unlocked  
**Author:** AutoCAD SHX Text

284

**Subject:** 7,076 SQ. FT.  
**Page Label:** [1] SHEET 4  
**Lock:** Unlocked  
**Author:** AutoCAD SHX Text

**Subject:** L=16.00'  
**Page Label:** [1] SHEET 4  
**Lock:** Unlocked  
**Author:** AutoCAD SHX Text

L=75.00'

**Subject:** (XXXXX)  
**Page Label:** [1] SHEET 4  
**Lock:** Unlocked  
**Author:** AutoCAD SHX Text



**Subject:** STONEBRIDGE FILING 3  
**Page Label:** [1] SHEET 4  
**Lock:** Unlocked  
**Author:** AutoCAD SHX Text

**Subject:** 7,877 SQ. FT.  
**Page Label:** [1] SHEET 4  
**Lock:** Unlocked  
**Author:** AutoCAD SHX Text

198

**Subject:**  
**Page Label:** [1] SHEET 4  
**Lock:** Unlocked  
**Author:** AutoCAD SHX Text

7,426 SQ. FT.

**Subject:**  
**Page Label:** [1] SHEET 4  
**Lock:** Unlocked  
**Author:** AutoCAD SHX Text

(XXXXXX)

132

173.00'

**Subject:**  
**Page Label:** [1] SHEET 4  
**Lock:** Unlocked  
**Author:** AutoCAD SHX Text

9,535 SQ. FT.

**Subject:**  
**Page Label:** [1] SHEET 4  
**Lock:** Unlocked  
**Author:** AutoCAD SHX Text

(XXXXXX)

2'02" R=1000.00  
(60 FEET WIDE)  
L=61.04'  
(XXXXXX)

**Subject:**  
**Page Label:** [1] SHEET 4  
**Lock:** Unlocked  
**Author:** AutoCAD SHX Text

(60 FEET WIDE)

135

6,876 SQ. FT.

164'52"48"

**Subject:**  
**Page Label:** [1] SHEET 4  
**Lock:** Unlocked  
**Author:** AutoCAD SHX Text

6,876 SQ. FT.

4=ft  
L=35.00'  
L=19.38'  
(XXXXXX)

**Subject:**  
**Page Label:** [1] SHEET 4  
**Lock:** Unlocked  
**Author:** AutoCAD SHX Text

(XXXXXX)

30'  
30.00' 30'

**Subject:**  
**Page Label:** [1] SHEET 4  
**Lock:** Unlocked  
**Author:** AutoCAD SHX Text

30' 30'

74

7,901 SQ. FT.

10'22"48"

**Subject:**  
**Page Label:** [1] SHEET 4  
**Lock:** Unlocked  
**Author:** AutoCAD SHX Text

7,901 SQ. FT.

**Subject:**  
**Page Label:** [1] SHEET 4  
**Lock:** Unlocked  
**Author:** AutoCAD SHX Text

(XXXXXX)

30'  
=31°50'12" R=450.00' L=22'  
30'

-----  
**Subject:**  
**Page Label:** [1] SHEET 4 30' 30'  
**Lock:** Unlocked  
**Author:** AutoCAD SHX Text

111

-----  
**Subject:**  
**Page Label:** [1] SHEET 4 9,858 SQ. FT.  
**Lock:** Unlocked  
**Author:** AutoCAD SHX Text

-----  
**Subject:**  
**Page Label:** [1] SHEET 4 (XXXXX)  
**Lock:** Unlocked  
**Author:** AutoCAD SHX Text

283

-----  
**Subject:**  
**Page Label:** [1] SHEET 4 7,057 SQ. FT.  
**Lock:** Unlocked  
**Author:** AutoCAD SHX Text

7

7,661 SQ. FT.

=9°43'41"E(N)

-----  
**Subject:**  
**Page Label:** [1] SHEET 4 7,661 SQ. FT.  
**Lock:** Unlocked  
**Author:** AutoCAD SHX Text

-----  
**Subject:**  
**Page Label:** [1] SHEET 4 8,267 SQ. FT.  
**Lock:** Unlocked  
**Author:** AutoCAD SHX Text

-----  
**Subject:**  
**Page Label:** [1] SHEET 4 10.00'  
**Lock:** Unlocked  
**Author:** AutoCAD SHX Text

(XXXXXX)  
=24.49'  
L=57'

-----  
**Subject:**  
**Page Label:** [1] SHEET 4 (XXXXX)  
**Lock:** Unlocked  
**Author:** AutoCAD SHX Text

199

-----  
**Subject:**  
**Page Label:** [1] SHEET 4 7,535 SQ. FT.  
**Lock:** Unlocked  
**Author:** AutoCAD SHX Text

OR WAI  
L=11.54'  
(XXXXX)

-----  
**Subject:**  
**Page Label:** [1] SHEET 4 L=11.54'  
**Lock:** Unlocked  
**Author:** AutoCAD SHX Text

Subject: (XXXXX)  
 Page Label: [1] SHEET 4  
 Lock: Unlocked  
 Author: AutoCAD SHX Text



Subject: (60 FEET WIDE)  
 Page Label: [1] SHEET 4  
 Lock: Unlocked  
 Author: AutoCAD SHX Text


**5**  
 9,125 SQ. FT.  
 '04"E(NRD)

Subject: 9,125 SQ. FT.  
 Page Label: [1] SHEET 4  
 Lock: Unlocked  
 Author: AutoCAD SHX Text

DATE: DECEMB
SHEET: 4

PROJECT NO.


Subject: SHEET: 4  
 Page Label: [1] SHEET 4  
 Lock: Unlocked  
 Author: AutoCAD SHX Text

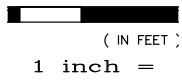

Subject: 1 inch =  
 Page Label: [1] SHEET 4  
 Lock: Unlocked  
 Author: AutoCAD SHX Text

**9**

Subject: 7,920 SQ. FT.  
 Page Label: [1] SHEET 4  
 Lock: Unlocked  
 Author: AutoCAD SHX Text

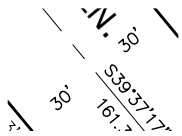


Subject: 30' 30'  
 Page Label: [1] SHEET 4  
 Lock: Unlocked  
 Author: AutoCAD SHX Text

**194**


Subject: 7,585 SQ. FT.  
 Page Label: [1] SHEET 4  
 Lock: Unlocked  
 Author: AutoCAD SHX Text

**6**  
 7,915 SQ. FT.  
 '40'00"E(NRD)


Subject: 7,915 SQ. FT.  
 Page Label: [1] SHEET 4  
 Lock: Unlocked  
 Author: AutoCAD SHX Text

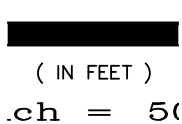

Subject: ( IN FEET )  
 Page Label: [1] SHEET 4  
 Lock: Unlocked  
 Author: AutoCAD SHX Text

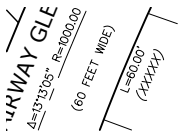


Subject: (60 FEET WIDE)  
Page Label: [1] SHEET 4  
Lock: Unlocked  
Author: AutoCAD SHX Text

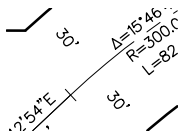


Subject: 30' 30'  
Page Label: [1] SHEET 4  
Lock: Unlocked  
Author: AutoCAD SHX Text


Subject: (XXXXX)  
Page Label: [1] SHEET 4  
Lock: Unlocked  
Author: AutoCAD SHX Text

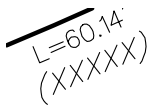


Subject: (XXXXX)  
Page Label: [1] SHEET 4  
Lock: Unlocked  
Author: AutoCAD SHX Text

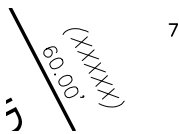

Subject: (XXXXX)  
Page Label: [1] SHEET 4  
Lock: Unlocked  
Author: AutoCAD SHX Text

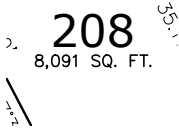

Subject: 8,091 SQ. FT.  
Page Label: [1] SHEET 4  
Lock: Unlocked  
Author: AutoCAD SHX Text

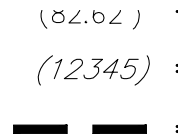


Subject: (12345)  
Page Label: [1] SHEET 4  
Lock: Unlocked  
Author: AutoCAD SHX Text



Subject: (XXXXX)  
Page Label: [1] SHEET 4  
Lock: Unlocked  
Author: AutoCAD SHX Text

Subject: 8,085 SQ. FT.  
Page Label: [1] SHEET 4  
Lock: Unlocked  
Author: AutoCAD SHX Text

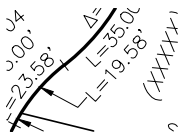

Subject: L=19.58'  
Page Label: [1] SHEET 4  
Lock: Unlocked  
Author: AutoCAD SHX Text

142  
9,038 SQ. FT.

57' E.N.R.

**Subject:**  
**Page Label:** [1] SHEET 4  
**Lock:** Unlocked  
**Author:** AutoCAD SHX Text

9,038 SQ. FT.

211  
8,311 SQ. FT.

N63°11'

**Subject:**  
**Page Label:** [1] SHEET 4  
**Lock:** Unlocked  
**Author:** AutoCAD SHX Text

8,311 SQ. FT.

(XXXXXX)  
L=68.83'

**Subject:**  
**Page Label:** [1] SHEET 4  
**Lock:** Unlocked  
**Author:** AutoCAD SHX Text

(XXXXXX)

(XXXXXX)  
L=43.02'

**Subject:**  
**Page Label:** [1] SHEET 4  
**Lock:** Unlocked  
**Author:** AutoCAD SHX Text

(XXXXXX)

204  
7,347 SQ. FT.

13'

22' E.N.R.

**Subject:**  
**Page Label:** [1] SHEET 4  
**Lock:** Unlocked  
**Author:** AutoCAD SHX Text

7,347 SQ. FT.

**Subject:**  
**Page Label:** [1] SHEET 4  
**Lock:** Unlocked  
**Author:** AutoCAD SHX Text

(XXXXXX)

100  
I

**Subject:**  
**Page Label:** [1] SHEET 4  
**Lock:** Unlocked  
**Author:** AutoCAD SHX Text

100

**Subject:**  
**Page Label:** [1] SHEET 4  
**Lock:** Unlocked  
**Author:** AutoCAD SHX Text

8,151 SQ. FT.

9

**Subject:**  
**Page Label:** [1] SHEET 4  
**Lock:** Unlocked  
**Author:** AutoCAD SHX Text

9

143  
9,365 SQ. FT.

**Subject:**  
**Page Label:** [1] SHEET 4  
**Lock:** Unlocked  
**Author:** AutoCAD SHX Text

9,365 SQ. FT.



**Subject:** 8,948 SQ. FT.  
**Page Label:** [1] SHEET 4  
**Lock:** Unlocked  
**Author:** AutoCAD SHX Text

**Subject:** 7,529 SQ. FT.  
**Page Label:** [1] SHEET 4  
**Lock:** Unlocked  
**Author:** AutoCAD SHX Text

200

**Subject:** 7,615 SQ. FT.  
**Page Label:** [1] SHEET 4  
**Lock:** Unlocked  
**Author:** AutoCAD SHX Text

(XXXXXX)  
52.00'

**Subject:** (XXXXXX)  
**Page Label:** [1] SHEET 4  
**Lock:** Unlocked  
**Author:** AutoCAD SHX Text

**Subject:** 8,492 SQ. FT.  
**Page Label:** [1] SHEET 4  
**Lock:** Unlocked  
**Author:** AutoCAD SHX Text

**Subject:** (60 FEET WIDE)  
**Page Label:** [1] SHEET 4  
**Lock:** Unlocked  
**Author:** AutoCAD SHX Text



**Subject:** (XXXXXX)  
**Page Label:** [1] SHEET 4  
**Lock:** Unlocked  
**Author:** AutoCAD SHX Text

**Subject:** (XXXXXX)  
**Page Label:** [1] SHEET 4  
**Lock:** Unlocked  
**Author:** AutoCAD SHX Text

50

**Subject:** 50  
**Page Label:** [1] SHEET 4  
**Lock:** Unlocked  
**Author:** AutoCAD SHX Text

207  
7.875 SQ. FT.  
1.93'  
1.92'(NR)

**Subject:** 7.875 SQ. FT.  
**Page Label:** [1] SHEET 4  
**Lock:** Unlocked  
**Author:** AutoCAD SHX Text



138  
7,834 SQ. FT.

54'51" W

**Subject:**  
**Page Label:** [1] SHEET 4  
**Lock:** Unlocked  
**Author:** AutoCAD SHX Text

7,834 SQ. FT.

38.82'  
(XXXXXX)

**Subject:**  
**Page Label:** [1] SHEET 4  
**Lock:** Unlocked  
**Author:** AutoCAD SHX Text

(XXXXXX)

**Subject:**  
**Page Label:** [1] SHEET 4  
**Lock:** Unlocked  
**Author:** AutoCAD SHX Text

L=13.69'

**Subject:**  
**Page Label:** [1] SHEET 4  
**Lock:** Unlocked  
**Author:** AutoCAD SHX Text

(XXXXXX)

60 FEET WIDE  
INGPARK L  
38°E  
5.00'

**Subject:**  
**Page Label:** [1] SHEET 4  
**Lock:** Unlocked  
**Author:** AutoCAD SHX Text

(60 FEET WIDE)

212  
8,194 SQ. FT.

57'04"

**Subject:**  
**Page Label:** [1] SHEET 4  
**Lock:** Unlocked  
**Author:** AutoCAD SHX Text

8,194 SQ. FT.

**Subject:**  
**Page Label:** [1] SHEET 4  
**Lock:** Unlocked  
**Author:** AutoCAD SHX Text

(XXXXXX)

201

**Subject:**  
**Page Label:** [1] SHEET 4  
**Lock:** Unlocked  
**Author:** AutoCAD SHX Text

8,079 SQ. FT.

60 FEET WIDE  
R WALK

**Subject:**  
**Page Label:** [1] SHEET 4  
**Lock:** Unlocked  
**Author:** AutoCAD SHX Text

(60 FEET WIDE)

71  
8,190 SQ. FT.

47' W

**Subject:**  
**Page Label:** [1] SHEET 4  
**Lock:** Unlocked  
**Author:** AutoCAD SHX Text

8,190 SQ. FT.

64

**Subject:**  
**Page Label:** [1] SHEET 4  
**Lock:** Unlocked  
**Author:** AutoCAD SHX Text

8,569 SQ. FT.

141

8,558 SQ. FT.

48' E.C.


**Subject:**  
**Page Label:** [1] SHEET 4  
**Lock:** Unlocked  
**Author:** AutoCAD SHX Text

8,558 SQ. FT.



**Subject:**  
**Page Label:** [1] SHEET 4  
**Lock:** Unlocked  
**Author:** AutoCAD SHX Text

(XXXXX)

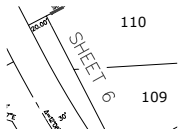

**Subject:**  
**Page Label:** [1] SHEET 4  
**Lock:** Unlocked  
**Author:** AutoCAD SHX Text

SHEET 66

**Subject:**  
**Page Label:** [1] SHEET 4  
**Lock:** Unlocked  
**Author:** AutoCAD SHX Text

8,342 SQ. FT.



**Subject:**  
**Page Label:** [1] SHEET 4  
**Lock:** Unlocked  
**Author:** AutoCAD SHX Text

STONEBRIDGE FILING 1



**Subject:**  
**Page Label:** [1] SHEET 4  
**Lock:** Unlocked  
**Author:** AutoCAD SHX Text

(60 FEET WIDE)



**Subject:**  
**Page Label:** [1] SHEET 4  
**Lock:** Unlocked  
**Author:** AutoCAD SHX Text

STAPLETON DRIVE

INDEX

219

7,558 SQ. FT.

20' 2 1/2" W

**Subject:**  
**Page Label:** [1] SHEET 4  
**Lock:** Unlocked  
**Author:** AutoCAD SHX Text

7,558 SQ. FT.

TRACT 1

**Subject:**  
**Page Label:** [1] SHEET 4  
**Lock:** Unlocked  
**Author:** AutoCAD SHX Text

0.981 ACRES

206  
7,558 SQ. FT.  
A.55'  
202'(NR)

-----  
**Subject:** 7,558 SQ. FT.  
**Page Label:** [1] SHEET 4  
**Lock:** Unlocked  
**Author:** AutoCAD SHX Text

-----  
**Subject:**  
**Page Label:** [1] SHEET 4 8,216 SQ. FT.  
**Lock:** Unlocked  
**Author:** AutoCAD SHX Text

69  
8,414 SQ. FT.  
125'

-----  
**Subject:**  
**Page Label:** [1] SHEET 4 8,414 SQ. FT.  
**Lock:** Unlocked  
**Author:** AutoCAD SHX Text

2'02" R=1000.00  
(60 FEET WIDE)  
L=61.04'  
(XXXX)

-----  
**Subject:**  
**Page Label:** [1] SHEET 4 (60 FEET WIDE)  
**Lock:** Unlocked  
**Author:** AutoCAD SHX Text

(82.62')  
(12345)

-----  
**Subject:**  
**Page Label:** [1] SHEET 4 (82.62')  
**Lock:** Unlocked  
**Author:** AutoCAD SHX Text

-----  
**Subject:**  
**Page Label:** [1] SHEET 4 7,726 SQ. FT.  
**Lock:** Unlocked  
**Author:** AutoCAD SHX Text

(XXXXX)  
52.00'

-----  
**Subject:**  
**Page Label:** [1] SHEET 4 (XXXXX)  
**Lock:** Unlocked  
**Author:** AutoCAD SHX Text

110


-----  
**Subject:**  
**Page Label:** [1] SHEET 4 11,523 SQ. FT.  
**Lock:** Unlocked  
**Author:** AutoCAD SHX Text

2  
8,290 SQ. FT.  
3'57'39"


-----  
**Subject:**  
**Page Label:** [1] SHEET 4 8,290 SQ. FT.  
**Lock:** Unlocked  
**Author:** AutoCAD SHX Text

65


-----  
**Subject:**  
**Page Label:** [1] SHEET 4 8,450 SQ. FT.  
**Lock:** Unlocked  
**Author:** AutoCAD SHX Text

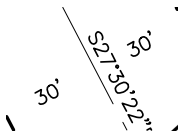

**Subject:**  
**Page Label:** [1] SHEET 4 30' 30'  
**Lock:** Unlocked  
**Author:** AutoCAD SHX Text

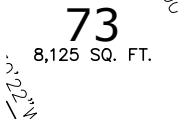


**Subject:**  
**Page Label:** [1] SHEET 4 8,125 SQ. FT.  
**Lock:** Unlocked  
**Author:** AutoCAD SHX Text

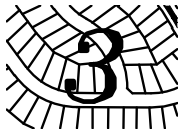

**Subject:**  
**Page Label:** [1] SHEET 4 3  
**Lock:** Unlocked  
**Author:** AutoCAD SHX Text



**Subject:**  
**Page Label:** [1] SHEET 4 (XXXXX)  
**Lock:** Unlocked  
**Author:** AutoCAD SHX Text

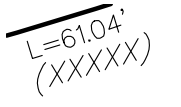

**Subject:**  
**Page Label:** [1] SHEET 4 (XXXXX)  
**Lock:** Unlocked  
**Author:** AutoCAD SHX Text




**Subject:**  
**Page Label:** [1] SHEET 4 10,062 SQ. FT.  
**Lock:** Unlocked  
**Author:** AutoCAD SHX Text



**Subject:**  
**Page Label:** [1] SHEET 4 (XXXXX)  
**Lock:** Unlocked  
**Author:** AutoCAD SHX Text



**Subject:**  
**Page Label:** [1] SHEET 4 8  
**Lock:** Unlocked  
**Author:** AutoCAD SHX Text

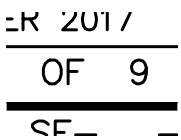

**Subject:**  
**Page Label:** [1] SHEET 4 OF 9  
**Lock:** Unlocked  
**Author:** AutoCAD SHX Text




**Subject:**  
**Page Label:** [1] SHEET 4 7,219 SQ. FT.  
**Lock:** Unlocked  
**Author:** AutoCAD SHX Text

43.00'  
(XXXXXX) 3;

Subject: (XXXXXX)  
Page Label: [1] SHEET 4  
Lock: Unlocked  
Author: AutoCAD SHX Text

Subject: (XXXXXX)  
Page Label: [1] SHEET 4  
Lock: Unlocked  
Author: AutoCAD SHX Text

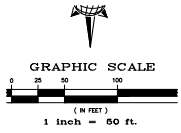

Subject: GRAPHIC SCALE  
Page Label: [1] SHEET 4  
Lock: Unlocked  
Author: AutoCAD SHX Text


140  
9,036 SQ. FT.

Subject: 9,036 SQ. FT.  
Page Label: [1] SHEET 4  
Lock: Unlocked  
Author: AutoCAD SHX Text

31' E

Subject: (XXXXXX)  
Page Label: [1] SHEET 4  
Lock: Unlocked  
Author: AutoCAD SHX Text

Subject: 8,646 SQ. FT.  
Page Label: [1] SHEET 4  
Lock: Unlocked  
Author: AutoCAD SHX Text

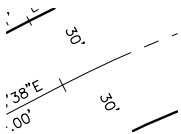

Subject: 30' 30'  
Page Label: [1] SHEET 4  
Lock: Unlocked  
Author: AutoCAD SHX Text


Subject: (XXXXXX)  
Page Label: [1] SHEET 4  
Lock: Unlocked  
Author: AutoCAD SHX Text

218  
7,200 SQ. FT.  
30' 22" W


Subject: 7,200 SQ. FT.  
Page Label: [1] SHEET 4  
Lock: Unlocked  
Author: AutoCAD SHX Text

SHEET


Subject: (XXXXXX)  
Page Label: [1] SHEET 4  
Lock: Unlocked  
Author: AutoCAD SHX Text

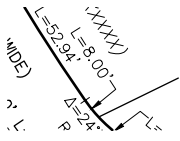


**Subject:**  
**Page Label:** [1] SHEET 4 L=8.00'  
**Lock:** Unlocked  
**Author:** AutoCAD SHX Text

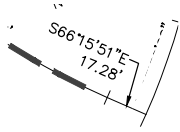


**Subject:**  
**Page Label:** [1] SHEET 4 S66°15'51"E17.28'  
**Lock:** Unlocked  
**Author:** AutoCAD SHX Text

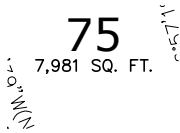


**Subject:**  
**Page Label:** [1] SHEET 4 7,981 SQ. FT.  
**Lock:** Unlocked  
**Author:** AutoCAD SHX Text

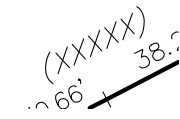


**Subject:**  
**Page Label:** [1] SHEET 4 (XXXXXX)  
**Lock:** Unlocked  
**Author:** AutoCAD SHX Text

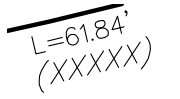


**Subject:**  
**Page Label:** [1] SHEET 4 (XXXXXX)  
**Lock:** Unlocked  
**Author:** AutoCAD SHX Text

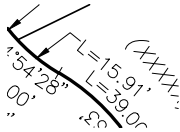

**Subject:**  
**Page Label:** [1] SHEET 4 L=15.91'  
**Lock:** Unlocked  
**Author:** AutoCAD SHX Text

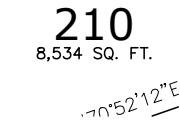


**Subject:**  
**Page Label:** [1] SHEET 4 8,534 SQ. FT.  
**Lock:** Unlocked  
**Author:** AutoCAD SHX Text

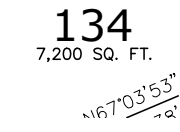

**Subject:**  
**Page Label:** [1] SHEET 4 7,200 SQ. FT.  
**Lock:** Unlocked  
**Author:** AutoCAD SHX Text



**Subject:**  
**Page Label:** [1] SHEET 4 6  
**Lock:** Unlocked  
**Author:** AutoCAD SHX Text

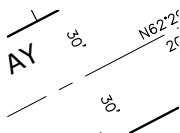


**Subject:**  
**Page Label:** [1] SHEET 4 30' 30'  
**Lock:** Unlocked  
**Author:** AutoCAD SHX Text

191


**Subject:**  
**Page Label:** [1] SHEET 4  
**Lock:** Unlocked  
**Author:** AutoCAD SHX Text

8,284 SQ. FT.

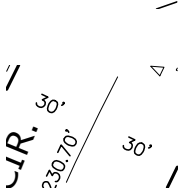

**Subject:**  
**Page Label:** [1] SHEET 4  
**Lock:** Unlocked  
**Author:** AutoCAD SHX Text

30' 30'

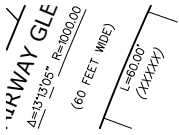

**Subject:**  
**Page Label:** [1] SHEET 4  
**Lock:** Unlocked  
**Author:** AutoCAD SHX Text

(60 FEET WIDE)


1

7,913 SQ. FT.




**Subject:**  
**Page Label:** [1] SHEET 4  
**Lock:** Unlocked  
**Author:** AutoCAD SHX Text

7,913 SQ. FT.

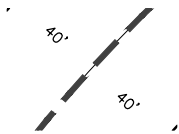


**Subject:**  
**Page Label:** [1] SHEET 4  
**Lock:** Unlocked  
**Author:** AutoCAD SHX Text

40' 40'

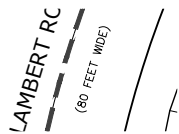


**Subject:**  
**Page Label:** [1] SHEET 4  
**Lock:** Unlocked  
**Author:** AutoCAD SHX Text

(80 FEET WIDE)

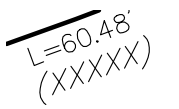

**Subject:**  
**Page Label:** [1] SHEET 4  
**Lock:** Unlocked  
**Author:** AutoCAD SHX Text

(XXXXXX)

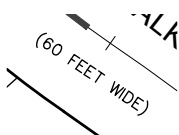

**Subject:**  
**Page Label:** [1] SHEET 4  
**Lock:** Unlocked  
**Author:** AutoCAD SHX Text

(60 FEET WIDE)



**Subject:**  
**Page Label:** [1] SHEET 4  
**Lock:** Unlocked  
**Author:** AutoCAD SHX Text

N



**Subject:**  
**Page Label:** [1] SHEET 4  
**Lock:** Unlocked  
**Author:** AutoCAD SHX Text


INDEX MAP

217  
7,200 SQ. FT.  
30' 22" W

Subject: 7,200 SQ. FT.  
Page Label: [1] SHEET 4  
Lock: Unlocked  
Author: AutoCAD SHX Text

Subject: 7,230 SQ. FT.  
Page Label: [1] SHEET 4  
Lock: Unlocked  
Author: AutoCAD SHX Text


Subject: L=10.00'  
Page Label: [1] SHEET 4  
Lock: Unlocked  
Author: AutoCAD SHX Text

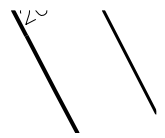

Subject: 25.41'  
Page Label: [1] SHEET 4  
Lock: Unlocked  
Author: AutoCAD SHX Text

(XXXXX)  
L=68.87'

Subject: (XXXXX)  
Page Label: [1] SHEET 4  
Lock: Unlocked  
Author: AutoCAD SHX Text

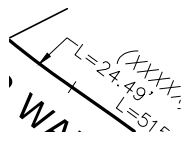


Subject: L=24.49'  
Page Label: [1] SHEET 4  
Lock: Unlocked  
Author: AutoCAD SHX Text

DATE: DECEMBER 2017
SHEET: 4 OF 9
PCD PROJECT NO. SF-___-___

Subject: PCD PROJECT NO. SF-\_\_\_-\_\_\_  
Page Label: [1] SHEET 4  
Lock: Unlocked  
Author: AutoCAD SHX Text

Subject: (XXXXX)  
Page Label: [1] SHEET 4  
Lock: Unlocked  
Author: AutoCAD SHX Text

Subject: (60 FEET WIDE)  
Page Label: [1] SHEET 4  
Lock: Unlocked  
Author: AutoCAD SHX Text

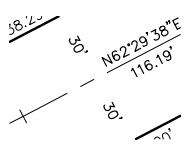

Subject: 30' 30'  
Page Label: [1] SHEET 4  
Lock: Unlocked  
Author: AutoCAD SHX Text




(XXXXXX)  
61' L=26'


Subject: (XXXXXX)  
Page Label: [1] SHEET 4  
Lock: Unlocked  
Author: AutoCAD SHX Text

0

Subject: 0  
Page Label: [1] SHEET 4  
Lock: Unlocked  
Author: AutoCAD SHX Text

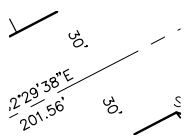

Subject: 30' 30'  
Page Label: [1] SHEET 4  
Lock: Unlocked  
Author: AutoCAD SHX Text

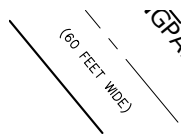

Subject: (60 FEET WIDE)  
Page Label: [1] SHEET 4  
Lock: Unlocked  
Author: AutoCAD SHX Text

(XXXXXX)  
L=71.00'


Subject: (XXXXXX)  
Page Label: [1] SHEET 4  
Lock: Unlocked  
Author: AutoCAD SHX Text

66  
8,393 SQ. FT.

Subject: 8,393 SQ. FT.  
Page Label: [1] SHEET 4  
Lock: Unlocked  
Author: AutoCAD SHX Text

(XXXXXX)  
5.12' L=57.65'

Subject: (XXXXXX)  
Page Label: [1] SHEET 4  
Lock: Unlocked  
Author: AutoCAD SHX Text

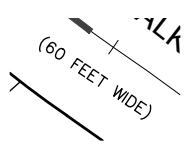

Subject: (60 FEET WIDE)  
Page Label: [1] SHEET 4  
Lock: Unlocked  
Author: AutoCAD SHX Text

Subject: (XXXXXX)  
Page Label: [1] SHEET 4  
Lock: Unlocked  
Author: AutoCAD SHX Text

L=51.17'  
L=4.00'  
(XXXXXX)

Subject: (XXXXXX)  
Page Label: [1] SHEET 4  
Lock: Unlocked  
Author: AutoCAD SHX Text



-----  
**Subject:** 4  
**Page Label:** [1] SHEET 4  
**Lock:** Unlocked  
**Author:** AutoCAD SHX Text

131


-----  
**Subject:** 8,366 SQ. FT.  
**Page Label:** [1] SHEET 4  
**Lock:** Unlocked  
**Author:** AutoCAD SHX Text

-----  
**Subject:** 8,243 SQ. FT.  
**Page Label:** [1] SHEET 4  
**Lock:** Unlocked  
**Author:** AutoCAD SHX Text

77

-----  
**Subject:** 7.963 SQ. FT.  
**Page Label:** [1] SHEET 4  
**Lock:** Unlocked  
**Author:** AutoCAD SHX Text

-----  
**Subject:** 8,934 SQ. FT.  
**Page Label:** [1] SHEET 4  
**Lock:** Unlocked  
**Author:** AutoCAD SHX Text

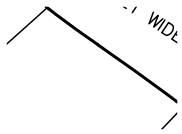

-----  
**Subject:** L=20.89'  
**Page Label:** [1] SHEET 4  
**Lock:** Unlocked  
**Author:** AutoCAD SHX Text

197

-----  
**Subject:** 7,690 SQ. FT.  
**Page Label:** [1] SHEET 4  
**Lock:** Unlocked  
**Author:** AutoCAD SHX Text

-----  
**Subject:** (XXXXX)  
**Page Label:** [1] SHEET 4  
**Lock:** Unlocked  
**Author:** AutoCAD SHX Text

-----  
**Subject:** (XXXXX)  
**Page Label:** [1] SHEET 4  
**Lock:** Unlocked  
**Author:** AutoCAD SHX Text

-----  
**Subject:** CHECKED BY: TAK  
**Page Label:** [1] SHEET 4  
**Lock:** Unlocked  
**Author:** AutoCAD SHX Text

DRAWN BY: LCG
CHECKED BY: TAK

50

Subject:  
Page Label: [1] SHEET 4  
Lock: Unlocked  
Author: AutoCAD SHX Text

50

(XXXXX)  
=15.91'  
L=39.0'  
EQ.

Subject:  
Page Label: [1] SHEET 4  
Lock: Unlocked  
Author: AutoCAD SHX Text

(XXXXX)

196

Subject:  
Page Label: [1] SHEET 4  
Lock: Unlocked  
Author: AutoCAD SHX Text

7,594 SQ. FT.

Subject:  
Page Label: [1] SHEET 4  
Lock: Unlocked  
Author: AutoCAD SHX Text

(XXXXX)

(XXXXX)  
60.00'

Subject:  
Page Label: [1] SHEET 4  
Lock: Unlocked  
Author: AutoCAD SHX Text

(XXXXX)

Subject:  
Page Label: [1] SHEET 4  
Lock: Unlocked  
Author: AutoCAD SHX Text

8,566 SQ. FT.

(^ ^ ^ ^)  
15.12'

Subject:  
Page Label: [1] SHEET 4  
Lock: Unlocked  
Author: AutoCAD SHX Text

15.12'

WID  
L=60.00'  
(XXXXX)

Subject:  
Page Label: [1] SHEET 4  
Lock: Unlocked  
Author: AutoCAD SHX Text

(XXXXX)

INGPARK L  
60 FEET WIDE  
3.38'E  
5.00'

Subject:  
Page Label: [1] SHEET 4  
Lock: Unlocked  
Author: AutoCAD SHX Text

(60 FEET WIDE)

FEET  
60 FEET WIDE  
R WALK

Subject:  
Page Label: [1] SHEET 4  
Lock: Unlocked  
Author: AutoCAD SHX Text


(60 FEET WIDE)

200

I

Subject:  
Page Label: [1] SHEET 4  
Lock: Unlocked  
Author: AutoCAD SHX Text

200

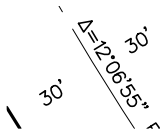

Subject:  
Page Label: [1] SHEET 4  
Lock: Unlocked  
Author: AutoCAD SHX Text

30' 30'



Subject:  
Page Label: [1] SHEET 4  
Lock: Unlocked  
Author: AutoCAD SHX Text

(XXXXXX)

213

8,466 SQ. FT.

L=86'

Subject:  
Page Label: [1] SHEET 4  
Lock: Unlocked  
Author: AutoCAD SHX Text

8,466 SQ. FT.




Subject:  
Page Label: [1] SHEET 4  
Lock: Unlocked  
Author: AutoCAD SHX Text

(XXXXXX)

8

7,618 SQ. FT.

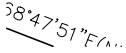

Subject:  
Page Label: [1] SHEET 4  
Lock: Unlocked  
Author: AutoCAD SHX Text

7,618 SQ. FT.

**N.T.S.**


Subject:  
Page Label: [1] SHEET 4  
Lock: Unlocked  
Author: AutoCAD SHX Text

N.T.S.



Subject:  
Page Label: [1] SHEET 4  
Lock: Unlocked  
Author: AutoCAD SHX Text

(XXXXXX)

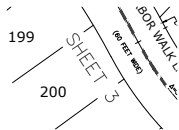

Subject:  
Page Label: [1] SHEET 4  
Lock: Unlocked  
Author: AutoCAD SHX Text

SHEET 33



Subject:  
Page Label: [1] SHEET 4  
Lock: Unlocked  
Author: AutoCAD SHX Text

(XXXXXX)

(XXXXX)  
L=69.27'

Subject: (XXXXX)  
Page Label: [1] SHEET 4  
Lock: Unlocked  
Author: AutoCAD SHX Text

205  
7,461 SQ. FT.  
3/2'E(NR)  
x 1/2'

Subject: 7,461 SQ. FT.  
Page Label: [1] SHEET 4  
Lock: Unlocked  
Author: AutoCAD SHX Text

Subject: 7,546 SQ. FT.  
Page Label: [1] SHEET 4  
Lock: Unlocked  
Author: AutoCAD SHX Text

202  
7,558 SQ. FT.  
3/2'E

Subject: 7,558 SQ. FT.  
Page Label: [1] SHEET 4  
Lock: Unlocked  
Author: AutoCAD SHX Text

38.00'  
30°  
(HHHH)

Subject: (XXXXX)  
Page Label: [1] SHEET 4  
Lock: Unlocked  
Author: AutoCAD SHX Text

30' 30'

Subject: 30' 30'  
Page Label: [1] SHEET 4  
Lock: Unlocked  
Author: AutoCAD SHX Text

SHEET 7  
2

Subject: SHEET 77  
Page Label: [1] SHEET 4  
Lock: Unlocked  
Author: AutoCAD SHX Text

DATE: DECEMBER 2017  
SHEET: 4 OF 9  
CD PROJECT NO. SF-\_\_\_

Subject: DATE: DECEMBER 2017  
Page Label: [1] SHEET 4  
Lock: Unlocked  
Author: AutoCAD SHX Text

L=43.00'  
(HHHH)

Subject: (XXXXX)  
Page Label: [1] SHEET 4  
Lock: Unlocked  
Author: AutoCAD SHX Text

L=11.54'  
(HHHH)  
L=7'

Subject: (XXXXX)  
Page Label: [1] SHEET 4  
Lock: Unlocked  
Author: AutoCAD SHX Text



-----  
**Subject:** 2  
**Page Label:** [1] SHEET 4  
**Lock:** Unlocked  
**Author:** AutoCAD SHX Text

108

-----  
**Subject:** 8,655 SQ. FT.  
**Page Label:** [1] SHEET 4  
**Lock:** Unlocked  
**Author:** AutoCAD SHX Text

(XXXXXX)  
L=69.28'

-----  
**Subject:** (XXXXXX)  
**Page Label:** [1] SHEET 4  
**Lock:** Unlocked  
**Author:** AutoCAD SHX Text

(XXXXXX)  
L=60.00'

-----  
**Subject:** (XXXXXX)  
**Page Label:** [1] SHEET 4  
**Lock:** Unlocked  
**Author:** AutoCAD SHX Text

(XXXXXX)  
L=55.00'

-----  
**Subject:** (XXXXXX)  
**Page Label:** [1] SHEET 4  
**Lock:** Unlocked  
**Author:** AutoCAD SHX Text

ft.

-----  
**Subject:** ft.  
**Page Label:** [1] SHEET 4  
**Lock:** Unlocked  
**Author:** AutoCAD SHX Text

-----  
**Subject:** (XXXXXX)  
**Page Label:** [1] SHEET 4  
**Lock:** Unlocked  
**Author:** AutoCAD SHX Text

133  
 7,157 SQ. FT.

-----  
**Subject:** 7,157 SQ. FT.  
**Page Label:** [1] SHEET 4  
**Lock:** Unlocked  
**Author:** AutoCAD SHX Text

77°03'53"E

216  
 7,833 SQ. FT.

-----  
**Subject:** 7,833 SQ. FT.  
**Page Label:** [1] SHEET 4  
**Lock:** Unlocked  
**Author:** AutoCAD SHX Text

3.00'  
81°07'W

70  
 8,406 SQ. FT.

-----  
**Subject:** 8,406 SQ. FT.  
**Page Label:** [1] SHEET 4  
**Lock:** Unlocked  
**Author:** AutoCAD SHX Text

1.30'  
74°

125.00

76

**Subject:**  
**Page Label:** [1] SHEET 4  
**Lock:** Unlocked  
**Author:** AutoCAD SHX Text

7.823 SQ. FT.

125.00

68

8,215 SQ. FT.

**Subject:**  
**Page Label:** [1] SHEET 4  
**Lock:** Unlocked  
**Author:** AutoCAD SHX Text

8,215 SQ. FT.

L=53.12'  
(XXXX)

**Subject:**  
**Page Label:** [1] SHEET 4  
**Lock:** Unlocked  
**Author:** AutoCAD SHX Text

(XXXXX)

**Subject:**  
**Page Label:** [1] SHEET 4  
**Lock:** Unlocked  
**Author:** AutoCAD SHX Text

(XXXXX)

**Subject:**  
**Page Label:** [1] SHEET 4  
**Lock:** Unlocked  
**Author:** AutoCAD SHX Text

(XXXXX)

(60 FEET WIDE)

**Subject:**  
**Page Label:** [1] SHEET 4  
**Lock:** Unlocked  
**Author:** AutoCAD SHX Text

(60 FEET WIDE)

50

**Subject:**  
**Page Label:** [1] SHEET 4  
**Lock:** Unlocked  
**Author:** AutoCAD SHX Text

50

3  
8,178 SQ. FT.

N74°18'0"


**Subject:**  
**Page Label:** [1] SHEET 4  
**Lock:** Unlocked  
**Author:** AutoCAD SHX Text

8,178 SQ. FT.

L=60.00'  
(XXXX)


**Subject:**  
**Page Label:** [1] SHEET 4  
**Lock:** Unlocked  
**Author:** AutoCAD SHX Text

(XXXXX)

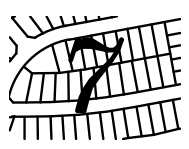

**Subject:**  
**Page Label:** [1] SHEET 4  
**Lock:** Unlocked  
**Author:** AutoCAD SHX Text

7

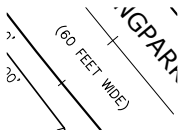

**Subject:**  
**Page Label:** [1] SHEET 4 (60 FEET WIDE)  
**Lock:** Unlocked  
**Author:** AutoCAD SHX Text



**Subject:**  
**Page Label:** [1] SHEET 4 THE VISTAS FILING 1  
**Lock:** Unlocked  
**Author:** AutoCAD SHX Text




8 **Subject:**  
**Page Label:** [1] SHEET 4 (XXXX)  
**Lock:** Unlocked  
**Author:** AutoCAD SHX Text



**Subject:**  
**Page Label:** [1] SHEET 4 (60 FEET WIDE)  
**Lock:** Unlocked  
**Author:** AutoCAD SHX Text

**Subject:**  
**Page Label:** [1] SHEET 4 (60 FEET WIDE)  
**Lock:** Unlocked  
**Author:** AutoCAD SHX Text

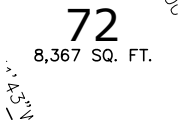

**Subject:**  
**Page Label:** [1] SHEET 4 8,367 SQ. FT.  
**Lock:** Unlocked  
**Author:** AutoCAD SHX Text

**Subject:**  
**Page Label:** [1] SHEET 4 6,808 SQ. FT.  
**Lock:** Unlocked  
**Author:** AutoCAD SHX Text



**Subject:**  
**Page Label:** [1] SHEET 4 8,846 SQ. FT.  
**Lock:** Unlocked  
**Author:** AutoCAD SHX Text

**Subject:**  
**Page Label:** [1] SHEET 4 6,412 SQ. FT.  
**Lock:** Unlocked  
**Author:** AutoCAD SHX Text

**Subject:**  
**Page Label:** [1] SHEET 4 (XXXX)  
**Lock:** Unlocked  
**Author:** AutoCAD SHX Text



L=61.78'  
(XXXXX)


**Subject:** (XXXXX)  
**Page Label:** [1] SHEET 4  
**Lock:** Unlocked  
**Author:** AutoCAD SHX Text

50


**Subject:** 50  
**Page Label:** [1] SHEET 5  
**Lock:** Unlocked  
**Author:** AutoCAD SHX Text



**Subject:** 8  
**Page Label:** [1] SHEET 5  
**Lock:** Unlocked  
**Author:** AutoCAD SHX Text

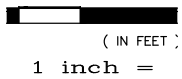

**Subject:** 1 inch =  
**Page Label:** [1] SHEET 5  
**Lock:** Unlocked  
**Author:** AutoCAD SHX Text

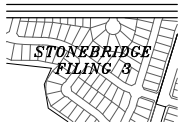


**Subject:** STONEBRIDGE FILING 3  
**Page Label:** [1] SHEET 5  
**Lock:** Unlocked  
**Author:** AutoCAD SHX Text



**Subject:** SEE ABOVE  
**Page Label:** [1] SHEET 5  
**Lock:** Unlocked  
**Author:** AutoCAD SHX Text



**Subject:** 0.056 ACRES  
**Page Label:** [1] SHEET 5  
**Lock:** Unlocked  
**Author:** AutoCAD SHX Text

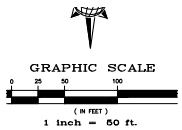

**Subject:** GRAPHIC SCALE  
**Page Label:** [1] SHEET 5  
**Lock:** Unlocked  
**Author:** AutoCAD SHX Text

DATE: DECEMB
SHEET: 5
PROJECT NO

**Subject:** SHEET: 5  
**Page Label:** [1] SHEET 5  
**Lock:** Unlocked  
**Author:** AutoCAD SHX Text



**Subject:** N  
**Page Label:** [1] SHEET 5  
**Lock:** Unlocked  
**Author:** AutoCAD SHX Text

NR

**Subject:**  
**Page Label:** [1] SHEET 5  
**Lock:** Unlocked  
**Author:** AutoCAD SHX Text

NR

**LEGEND**  
○ = FOUND MONUMENT AS SHOWN  
● = FOUND REBAR WITH CAP PLS 34583  
⊙ = SET #4 REBAR W/CAP PLS 34583  
⊖ = NON-RADIAL BEARING  
(EASEM) = EASEMENT OR NO-BUILD DIM.  
(ADDRESS) = ADDRESS  
--- = MATCHLINE

**Subject:**  
**Page Label:** [1] SHEET 5  
**Lock:** Unlocked  
**Author:** AutoCAD SHX Text

= FOUND MONUMENT AS SHOWN = FOUND #4 REBAR WITH CAP PLS 34583 = SET #4 REBAR W/CAP PLS 34583 = NON-RADIAL BEARING = EASEMENT OR NO-BUILD DIM. = ADDRESS ADDRESS = MATCHLINE

100


**Subject:**  
**Page Label:** [1] SHEET 5  
**Lock:** Unlocked  
**Author:** AutoCAD SHX Text

100

TRACT (C  
2.336 ACRES

**Subject:**  
**Page Label:** [1] SHEET 5  
**Lock:** Unlocked  
**Author:** AutoCAD SHX Text

2.336 ACRES

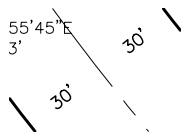

**Subject:**  
**Page Label:** [1] SHEET 5  
**Lock:** Unlocked  
**Author:** AutoCAD SHX Text

30' 30'



**Subject:**  
**Page Label:** [1] SHEET 5  
**Lock:** Unlocked  
**Author:** AutoCAD SHX Text

SHEET 66

DRAWN BY: LCG  
CHECKED BY: TAK

**Subject:**  
**Page Label:** [1] SHEET 5  
**Lock:** Unlocked  
**Author:** AutoCAD SHX Text

DRAWN BY: LCG

25

**Subject:**  
**Page Label:** [1] SHEET 5  
**Lock:** Unlocked  
**Author:** AutoCAD SHX Text

25

0

**Subject:**  
**Page Label:** [1] SHEET 5  
**Lock:** Unlocked  
**Author:** AutoCAD SHX Text

0

TRACT T

**Subject:**  
**Page Label:** [1] SHEET 5  
**Lock:** Unlocked  
**Author:** AutoCAD SHX Text

0.273 ACRES

50

**Subject:**  
**Page Label:** [1] SHEET 5  
**Lock:** Unlocked  
**Author:** AutoCAD SHX Text

50

*N.T.S.*


**Subject:**  
**Page Label:** [1] SHEET 5  
**Lock:** Unlocked  
**Author:** AutoCAD SHX Text

N.T.S.



**Subject:**  
**Page Label:** [1] SHEET 5  
**Lock:** Unlocked  
**Author:** AutoCAD SHX Text

2

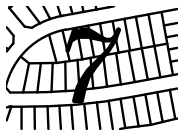

**Subject:**  
**Page Label:** [1] SHEET 5  
**Lock:** Unlocked  
**Author:** AutoCAD SHX Text

7

**TRACT**  
0.186 ACRES

**Subject:**  
**Page Label:** [1] SHEET 5  
**Lock:** Unlocked  
**Author:** AutoCAD SHX Text

0.186 ACRES

DATE: DECEMBER 2017  
SHEET: 5 OF 9  
PCD PROJECT NO. SF-\_\_\_-


**Subject:**  
**Page Label:** [1] SHEET 5  
**Lock:** Unlocked  
**Author:** AutoCAD SHX Text

DATE: DECEMBER 2017



**Subject:**  
**Page Label:** [1] SHEET 5  
**Lock:** Unlocked  
**Author:** AutoCAD SHX Text

INDEX MAP

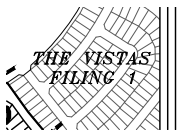

**Subject:**  
**Page Label:** [1] SHEET 5  
**Lock:** Unlocked  
**Author:** AutoCAD SHX Text

THE VISTAS FILING 1

50


**Subject:**  
**Page Label:** [1] SHEET 5  
**Lock:** Unlocked  
**Author:** AutoCAD SHX Text

50




**Subject:**  
**Page Label:** [1] SHEET 5  
**Lock:** Unlocked  
**Author:** AutoCAD SHX Text

WINDINGWALK FILING No. 1 AT MERIDIAN RANCH A PARCEL OF LAND LOCATED IN A PORTION OF SECTION 29, 30, AND 32 IN TOWNSHIP 12 SOUTH, RANGE 64 WEST OF THE 6TH PRINCIPAL MERIDIAN EL PASO COUNTY, COLORADO.

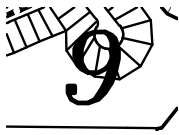


**Subject:**  
**Page Label:** [1] SHEET 5  
**Lock:** Unlocked  
**Author:** AutoCAD SHX Text

9

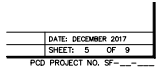


**Subject:**  
**Page Label:** [1] SHEET 5  
**Lock:** Unlocked  
**Author:** AutoCAD SHX Text

PCD PROJECT NO. SF-\_\_\_-\_\_\_

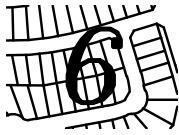

**Subject:**  
**Page Label:** [1] SHEET 5  
**Lock:** Unlocked  
**Author:** AutoCAD SHX Text

6

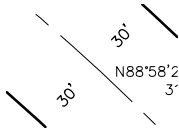

**Subject:**  
**Page Label:** [1] SHEET 5  
**Lock:** Unlocked  
**Author:** AutoCAD SHX Text

30' 30'




**Subject:**  
**Page Label:** [1] SHEET 5  
**Lock:** Unlocked  
**Author:** AutoCAD SHX Text

3

TRACT D  
 (NOT A PART)


**Subject:**  
**Page Label:** [1] SHEET 5  
**Lock:** Unlocked  
**Author:** AutoCAD SHX Text

(NOT A PART)

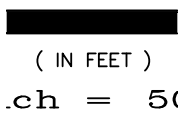


**Subject:**  
**Page Label:** [1] SHEET 5  
**Lock:** Unlocked  
**Author:** AutoCAD SHX Text

( IN FEET )

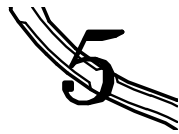


**Subject:**  
**Page Label:** [1] SHEET 5  
**Lock:** Unlocked  
**Author:** AutoCAD SHX Text

5

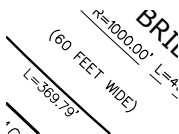

**Subject:**  
**Page Label:** [1] SHEET 5  
**Lock:** Unlocked  
**Author:** AutoCAD SHX Text

(60 FEET WIDE)

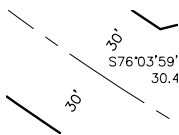


**Subject:**  
**Page Label:** [1] SHEET 5  
**Lock:** Unlocked  
**Author:** AutoCAD SHX Text

30' 30'

ft.

**Subject:**  
**Page Label:** [1] SHEET 5  
**Lock:** Unlocked  
**Author:** AutoCAD SHX Text

ft.

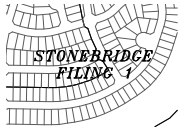

**Subject:**  
**Page Label:** [1] SHEET 5  
**Lock:** Unlocked  
**Author:** AutoCAD SHX Text

STONEBRIDGE FILING 1

TRACT 1  
0.273 ACRES

58'

**Subject:**  
**Page Label:** [1] SHEET 5  
**Lock:** Unlocked  
**Author:** AutoCAD SHX Text

0.273 ACRES

200  
I

**Subject:**  
**Page Label:** [1] SHEET 5  
**Lock:** Unlocked  
**Author:** AutoCAD SHX Text

200



**Subject:**  
**Page Label:** [1] SHEET 5  
**Lock:** Unlocked  
**Author:** AutoCAD SHX Text

SEE BELOW

(82.62')  
(12345)

**Subject:**  
**Page Label:** [1] SHEET 5  
**Lock:** Unlocked  
**Author:** AutoCAD SHX Text

(82.62')

TRACT A  
8.504 ACRES

**Subject:**  
**Page Label:** [1] SHEET 5  
**Lock:** Unlocked  
**Author:** AutoCAD SHX Text

8.504 ACRES

OF 9  
CF

**Subject:**  
**Page Label:** [1] SHEET 5  
**Lock:** Unlocked  
**Author:** AutoCAD SHX Text

OF 9

DRAWN BY: LCG  
CHECKED BY: TAK

**Subject:**  
**Page Label:** [1] SHEET 5  
**Lock:** Unlocked  
**Author:** AutoCAD SHX Text


CHECKED BY: TAK



**Subject:**  
**Page Label:** [1] SHEET 5  
**Lock:** Unlocked  
**Author:** AutoCAD SHX Text

STAPLETON DRIVE


INDEX

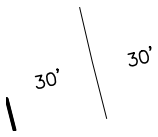

**Subject:**  
**Page Label:** [1] SHEET 5 30' 30'  
**Lock:** Unlocked  
**Author:** AutoCAD SHX Text

(02.02)  
(12345)


**Subject:**  
**Page Label:** [1] SHEET 5 (12345)  
**Lock:** Unlocked  
**Author:** AutoCAD SHX Text

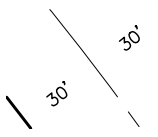

**Subject:**  
**Page Label:** [1] SHEET 5 30' 30'  
**Lock:** Unlocked  
**Author:** AutoCAD SHX Text




**Subject:**  
**Page Label:** [1] SHEET 5 4  
**Lock:** Unlocked  
**Author:** AutoCAD SHX Text

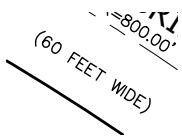


**Subject:**  
**Page Label:** [1] SHEET 5 (60 FEET WIDE)  
**Lock:** Unlocked  
**Author:** AutoCAD SHX Text


**Subject:**  
**Page Label:** [1] SHEET 5 (XXXXX)  
**Lock:** Unlocked  
**Author:** AutoCAD SHX Text

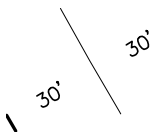

**Subject:**  
**Page Label:** [1] SHEET 5 30' 30'  
**Lock:** Unlocked  
**Author:** AutoCAD SHX Text

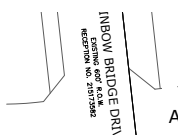

**Subject:**  
**Page Label:** [1] SHEET 5 EXISTING 600' R.O.W. RECEPTION NO. 215173582  
**Lock:** Unlocked  
**Author:** AutoCAD SHX Text

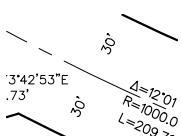

**Subject:**  
**Page Label:** [1] SHEET 5 30' 30'  
**Lock:** Unlocked  
**Author:** AutoCAD SHX Text

TRACT A  
(NOT A PART)

**Subject:**  
**Page Label:** [1] SHEET 5 (NOT A PART)  
**Lock:** Unlocked  
**Author:** AutoCAD SHX Text

TRACT ]  
0.438 ACRES

Subject:  
Page Label: [1] SHEET 5  
Lock: Unlocked  
Author: AutoCAD SHX Text

0.438 ACRES

50

Subject:  
Page Label: [1] SHEET 6  
Lock: Unlocked  
Author: AutoCAD SHX Text

50

TRACT ]  
0.981 ACRES

Subject:  
Page Label: [1] SHEET 6  
Lock: Unlocked  
Author: AutoCAD SHX Text

0.981 ACRES

ft.

Subject:  
Page Label: [1] SHEET 6  
Lock: Unlocked  
Author: AutoCAD SHX Text

30' 30'


134

Subject:  
Page Label: [1] SHEET 6  
Lock: Unlocked  
Author: AutoCAD SHX Text

ft.


Subject:  
Page Label: [1] SHEET 6  
Lock: Unlocked  
Author: AutoCAD SHX Text

7,200 SQ. FT.

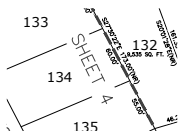


Subject:  
Page Label: [1] SHEET 6  
Lock: Unlocked  
Author: AutoCAD SHX Text

SHEET 44

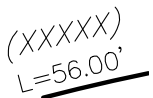

Subject:  
Page Label: [1] SHEET 6  
Lock: Unlocked  
Author: AutoCAD SHX Text

(XXXXX)

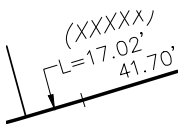

Subject:  
Page Label: [1] SHEET 6  
Lock: Unlocked  
Author: AutoCAD SHX Text

L=17.02'

TRACT /  
8.504 ACRES

Subject:  
Page Label: [1] SHEET 6  
Lock: Unlocked  
Author: AutoCAD SHX Text

8.504 ACRES

0  
1

-----  
**Subject:**  
**Page Label:** [1] SHEET 6 0  
**Lock:** Unlocked  
**Author:** AutoCAD SHX Text

-----  
**Subject:**  
**Page Label:** [1] SHEET 6 (XXXXX)  
**Lock:** Unlocked  
**Author:** AutoCAD SHX Text


-----  
**Subject:**  
**Page Label:** [1] SHEET 6 (XXXXX)  
**Lock:** Unlocked  
**Author:** AutoCAD SHX Text

(XXXXXX)  
L=17.02'  
41.70'

-----  
**Subject:**  
**Page Label:** [1] SHEET 6 (XXXXX)  
**Lock:** Unlocked  
**Author:** AutoCAD SHX Text

110  
11,523 SQ. FT.

-----  
**Subject:**  
**Page Label:** [1] SHEET 6 11,523 SQ. FT.  
**Lock:** Unlocked  
**Author:** AutoCAD SHX Text

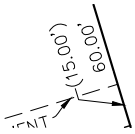


-----  
**Subject:**  
**Page Label:** [1] SHEET 6 (15.00')  
**Lock:** Unlocked  
**Author:** AutoCAD SHX Text

46.50  
L=8.27'  
(XXXXXX)

-----  
**Subject:**  
**Page Label:** [1] SHEET 6 (XXXXX)  
**Lock:** Unlocked  
**Author:** AutoCAD SHX Text

138.94  
8,093 SQ. FT.  
NO 7'06"

-----  
**Subject:**  
**Page Label:** [1] SHEET 6 8,093 SQ. FT.  
**Lock:** Unlocked  
**Author:** AutoCAD SHX Text

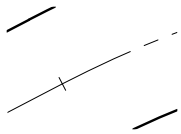


-----  
**Subject:**  
**Page Label:** [1] SHEET 6 30' 30'  
**Lock:** Unlocked  
**Author:** AutoCAD SHX Text




-----  
**Subject:**  
**Page Label:** [1] SHEET 6 4  
**Lock:** Unlocked  
**Author:** AutoCAD SHX Text



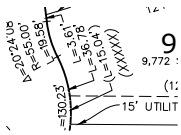


**Subject:** (L=15.04')  
**Page Label:** [1] SHEET 6  
**Lock:** Unlocked  
**Author:** AutoCAD SHX Text


**Subject:** (XXXXXX)  
**Page Label:** [1] SHEET 6  
**Lock:** Unlocked  
**Author:** AutoCAD SHX Text

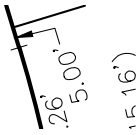

**Subject:** 5.00'  
**Page Label:** [1] SHEET 6  
**Lock:** Unlocked  
**Author:** AutoCAD SHX Text

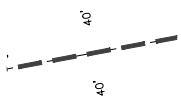


**Subject:** 40' 40'  
**Page Label:** [1] SHEET 6  
**Lock:** Unlocked  
**Author:** AutoCAD SHX Text

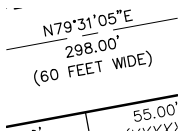

**Subject:** (60 FEET WIDE)  
**Page Label:** [1] SHEET 6  
**Lock:** Unlocked  
**Author:** AutoCAD SHX Text

297

**Subject:** 6,848 SQ. FT.  
**Page Label:** [1] SHEET 6  
**Lock:** Unlocked  
**Author:** AutoCAD SHX Text

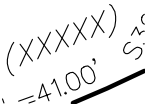


**Subject:** (XXXXXX)  
**Page Label:** [1] SHEET 6  
**Lock:** Unlocked  
**Author:** AutoCAD SHX Text



**Subject:** (XXXXXX)  
**Page Label:** [1] SHEET 6  
**Lock:** Unlocked  
**Author:** AutoCAD SHX Text



**Subject:** 5  
**Page Label:** [1] SHEET 6  
**Lock:** Unlocked  
**Author:** AutoCAD SHX Text

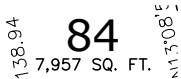

**Subject:** 7,957 SQ. FT.  
**Page Label:** [1] SHEET 6  
**Lock:** Unlocked  
**Author:** AutoCAD SHX Text

---

**Subject:**  
**Page Label:** [1] SHEET 6 9,519 SQ. FT.  
**Lock:** Unlocked  
**Author:** AutoCAD SHX Text

123.5' 77 7.963 SQ. FT. 110' 3" 4" 5"  
**Subject:**  
**Page Label:** [1] SHEET 6 7.963 SQ. FT.  
**Lock:** Unlocked  
**Author:** AutoCAD SHX Text

123.5' 128 6.514 SQ. FT. 107' 32" 45"  
**Subject:**  
**Page Label:** [1] SHEET 6 6.514 SQ. FT.  
**Lock:** Unlocked  
**Author:** AutoCAD SHX Text

---

**Subject:**  
**Page Label:** [1] SHEET 6 L=8.00'  
**Lock:** Unlocked  
**Author:** AutoCAD SHX Text

130.00 78 7.783 SQ. FT. 101' 40" 22" V  
**Subject:**  
**Page Label:** [1] SHEET 6 7,783 SQ. FT.  
**Lock:** Unlocked  
**Author:** AutoCAD SHX Text

134.1' 86 7.585 SQ. FT. 5' 16" 5"  
**Subject:**  
**Page Label:** [1] SHEET 6 7,585 SQ. FT.  
**Lock:** Unlocked  
**Author:** AutoCAD SHX Text

50  
**Subject:**  
**Page Label:** [1] SHEET 6 50  
**Lock:** Unlocked  
**Author:** AutoCAD SHX Text

L=42.00  
(XXXXXX)  
**Subject:**  
**Page Label:** [1] SHEET 6 (XXXXXX)  
**Lock:** Unlocked  
**Author:** AutoCAD SHX Text

---

**Subject:**  
**Page Label:** [1] SHEET 6 (XXXXXX)  
**Lock:** Unlocked  
**Author:** AutoCAD SHX Text

(XXXXXX)  
55.00'  
**Subject:**  
**Page Label:** [1] SHEET 6 (XXXXXX)  
**Lock:** Unlocked  
**Author:** AutoCAD SHX Text

298

**Subject:**  
**Page Label:** [1] SHEET 6 6,995 SQ. FT.  
**Lock:** Unlocked  
**Author:** AutoCAD SHX Text

L=56.05'  
(XXXXX)

**Subject:**  
**Page Label:** [1] SHEET 6 (XXXXX)  
**Lock:** Unlocked  
**Author:** AutoCAD SHX Text

( IN FEET )  
.ch = 50

**Subject:**  
**Page Label:** [1] SHEET 6 ( IN FEET )  
**Lock:** Unlocked  
**Author:** AutoCAD SHX Text

125.00  
101  
6,875 SQ. FT. S10'28"

**Subject:**  
**Page Label:** [1] SHEET 6 6,875 SQ. FT.  
**Lock:** Unlocked  
**Author:** AutoCAD SHX Text

**Subject:**  
**Page Label:** [1] SHEET 6 (XXXXX)  
**Lock:** Unlocked  
**Author:** AutoCAD SHX Text

130.00  
88  
7,150 SQ. FT. N16'53"

**Subject:**  
**Page Label:** [1] SHEET 6 7,150 SQ. FT.  
**Lock:** Unlocked  
**Author:** AutoCAD SHX Text

(82.62')

**Subject:**  
**Page Label:** [1] SHEET 6 (82.62')  
**Lock:** Unlocked  
**Author:** AutoCAD SHX Text

93  
6,000 SQ. FT.  
N73°06'12"E

**Subject:**  
**Page Label:** [1] SHEET 6 6,000 SQ. FT.  
**Lock:** Unlocked  
**Author:** AutoCAD SHX Text

136

N38°W 12'


**Subject:**  
**Page Label:** [1] SHEET 6 7,500 SQ. FT.  
**Lock:** Unlocked  
**Author:** AutoCAD SHX Text

(XXXXX)  
50.54'


**Subject:**  
**Page Label:** [1] SHEET 6 (XXXXX)  
**Lock:** Unlocked  
**Author:** AutoCAD SHX Text

L=18.50'  
(XXXXXX)

**Subject:**  
**Page Label:** [1] SHEET 6 (XXXXXX)  
**Lock:** Unlocked  
**Author:** AutoCAD SHX Text

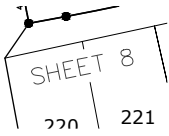

**Subject:**  
**Page Label:** [1] SHEET 6 SHEET 88  
**Lock:** Unlocked  
**Author:** AutoCAD SHX Text

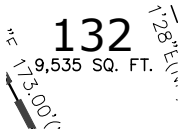

**Subject:**  
**Page Label:** [1] SHEET 6 9,535 SQ. FT.  
**Lock:** Unlocked  
**Author:** AutoCAD SHX Text

133


**Subject:**  
**Page Label:** [1] SHEET 6 7,157 SQ. FT.  
**Lock:** Unlocked  
**Author:** AutoCAD SHX Text

(XXXXXX)  
L=61.61'

**Subject:**  
**Page Label:** [1] SHEET 6 (XXXXXX)  
**Lock:** Unlocked  
**Author:** AutoCAD SHX Text

(XXXXXX)  
46', L=32.5

**Subject:**  
**Page Label:** [1] SHEET 6 (XXXXXX)  
**Lock:** Unlocked  
**Author:** AutoCAD SHX Text

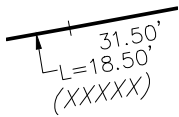

**Subject:**  
**Page Label:** [1] SHEET 6 L=18.50'  
**Lock:** Unlocked  
**Author:** AutoCAD SHX Text



**Subject:**  
**Page Label:** [1] SHEET 6 (XXXXXX)  
**Lock:** Unlocked  
**Author:** AutoCAD SHX Text

L=55.09'  
(XXXXXX)

**Subject:**  
**Page Label:** [1] SHEET 6 (XXXXXX)  
**Lock:** Unlocked  
**Author:** AutoCAD SHX Text

DRAWN BY: LCG  
CHECKED BY: TAK

**Subject:**  
**Page Label:** [1] SHEET 6 DRAWN BY: LCG  
**Lock:** Unlocked  
**Author:** AutoCAD SHX Text




Subject: (60 FEET WIDE)  
Page Label: [1] SHEET 6  
Lock: Unlocked  
Author: AutoCAD SHX Text


Subject: (XXXXXX)  
Page Label: [1] SHEET 6  
Lock: Unlocked  
Author: AutoCAD SHX Text



Subject: (XXXXXX)  
Page Label: [1] SHEET 6  
Lock: Unlocked  
Author: AutoCAD SHX Text

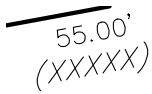


Subject: (XXXXXX)  
Page Label: [1] SHEET 6  
Lock: Unlocked  
Author: AutoCAD SHX Text

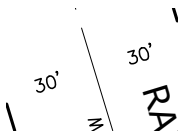


Subject: 30' 30'  
Page Label: [1] SHEET 6  
Lock: Unlocked  
Author: AutoCAD SHX Text

221


Subject: 7,083 SQ. FT.  
Page Label: [1] SHEET 6  
Lock: Unlocked  
Author: AutoCAD SHX Text

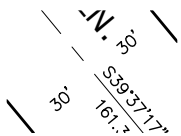


Subject: 30' 30'  
Page Label: [1] SHEET 6  
Lock: Unlocked  
Author: AutoCAD SHX Text

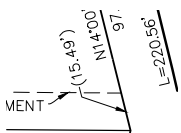

Subject: (15.49')  
Page Label: [1] SHEET 6  
Lock: Unlocked  
Author: AutoCAD SHX Text

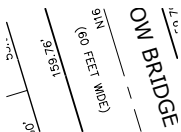


Subject: (60 FEET WIDE)  
Page Label: [1] SHEET 6  
Lock: Unlocked  
Author: AutoCAD SHX Text

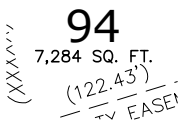

94

Subject: 7,284 SQ. FT.  
Page Label: [1] SHEET 6  
Lock: Unlocked  
Author: AutoCAD SHX Text

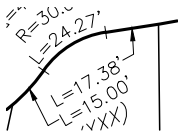


**Subject:**  
**Page Label:** [1] SHEET 6 L=17.38'  
**Lock:** Unlocked  
**Author:** AutoCAD SHX Text

**TRACT**  
0.067 ACRES  
S02°35'36"


**Subject:**  
**Page Label:** [1] SHEET 6 0.067 ACRES  
**Lock:** Unlocked  
**Author:** AutoCAD SHX Text




**Subject:**  
**Page Label:** [1] SHEET 6 (XXXXXX)  
**Lock:** Unlocked  
**Author:** AutoCAD SHX Text

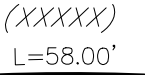

**Subject:**  
**Page Label:** [1] SHEET 6 (XXXXXX)  
**Lock:** Unlocked  
**Author:** AutoCAD SHX Text

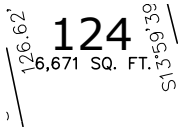

**Subject:**  
**Page Label:** [1] SHEET 6 6,671 SQ. FT.  
**Lock:** Unlocked  
**Author:** AutoCAD SHX Text

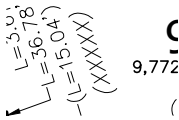


**Subject:**  
**Page Label:** [1] SHEET 6 (XXXXXX)  
**Lock:** Unlocked  
**Author:** AutoCAD SHX Text



**Subject:**  
**Page Label:** [1] SHEET 6 N  
**Lock:** Unlocked  
**Author:** AutoCAD SHX Text




**Subject:**  
**Page Label:** [1] SHEET 6 (XXXXXX)  
**Lock:** Unlocked  
**Author:** AutoCAD SHX Text

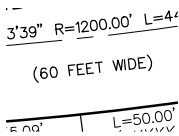


**Subject:**  
**Page Label:** [1] SHEET 6 (60 FEET WIDE)  
**Lock:** Unlocked  
**Author:** AutoCAD SHX Text




**Subject:**  
**Page Label:** [1] SHEET 6 9,772 SQ. FT.  
**Lock:** Unlocked  
**Author:** AutoCAD SHX Text

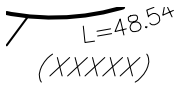

Subject: (XXXXXX)  
Page Label: [1] SHEET 6  
Lock: Unlocked  
Author: AutoCAD SHX Text

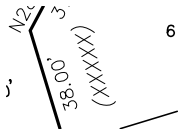


Subject: (XXXXXX)  
Page Label: [1] SHEET 6  
Lock: Unlocked  
Author: AutoCAD SHX Text

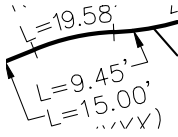

Subject: L=9.45'  
Page Label: [1] SHEET 6  
Lock: Unlocked  
Author: AutoCAD SHX Text

Subject: (XXXXXX)  
Page Label: [1] SHEET 6  
Lock: Unlocked  
Author: AutoCAD SHX Text

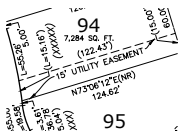

Subject: 15' UTILITY EASEMENT  
Page Label: [1] SHEET 6  
Lock: Unlocked  
Author: AutoCAD SHX Text

296

Subject: 6,875 SQ. FT.  
Page Label: [1] SHEET 6  
Lock: Unlocked  
Author: AutoCAD SHX Text



Subject: (60 FEET WIDE)  
Page Label: [1] SHEET 6  
Lock: Unlocked  
Author: AutoCAD SHX Text



Subject: (XXXXXX)  
Page Label: [1] SHEET 6  
Lock: Unlocked  
Author: AutoCAD SHX Text

Subject: 30' 30'  
Page Label: [1] SHEET 6  
Lock: Unlocked  
Author: AutoCAD SHX Text


96  
9,399 SQ. FT.

Subject: 9,399 SQ. FT.  
Page Label: [1] SHEET 6  
Lock: Unlocked  
Author: AutoCAD SHX Text



---

**Subject:**  
**Page Label:** [1] SHEET 6 L=15.91'  
**Lock:** Unlocked  
**Author:** AutoCAD SHX Text

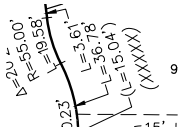

---

**Subject:**  
**Page Label:** [1] SHEET 6 L=36.78'  
**Lock:** Unlocked  
**Author:** AutoCAD SHX Text


---

**Subject:**  
**Page Label:** [1] SHEET 6 8,178 SQ. FT.  
**Lock:** Unlocked  
**Author:** AutoCAD SHX Text

293


---

**Subject:**  
**Page Label:** [1] SHEET 6 6,751 SQ. FT.  
**Lock:** Unlocked  
**Author:** AutoCAD SHX Text

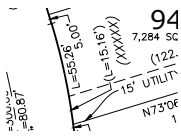


---

**Subject:**  
**Page Label:** [1] SHEET 6 (L=15.16')  
**Lock:** Unlocked  
**Author:** AutoCAD SHX Text

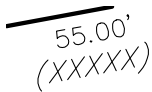


---

**Subject:**  
**Page Label:** [1] SHEET 6 (XXXXX)  
**Lock:** Unlocked  
**Author:** AutoCAD SHX Text

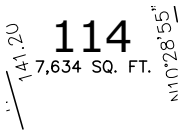


---

**Subject:**  
**Page Label:** [1] SHEET 6 7,634 SQ. FT.  
**Lock:** Unlocked  
**Author:** AutoCAD SHX Text

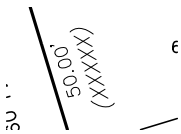


---

**Subject:**  
**Page Label:** [1] SHEET 6 (XXXXX)  
**Lock:** Unlocked  
**Author:** AutoCAD SHX Text

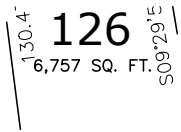

---


**Subject:**  
**Page Label:** [1] SHEET 6 6,757 SQ. FT.  
**Lock:** Unlocked  
**Author:** AutoCAD SHX Text

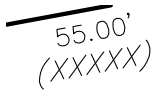

---

**Subject:**  
**Page Label:** [1] SHEET 6 (XXXXX)  
**Lock:** Unlocked  
**Author:** AutoCAD SHX Text



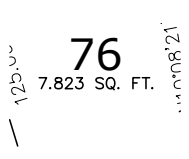


**Subject:**  
**Page Label:** [1] SHEET 6  
**Lock:** Unlocked  
**Author:** AutoCAD SHX Text

7.823 SQ. FT.




**Subject:**  
**Page Label:** [1] SHEET 6  
**Lock:** Unlocked  
**Author:** AutoCAD SHX Text

(XXXXX)

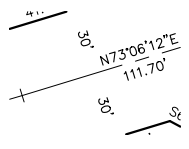


**Subject:**  
**Page Label:** [1] SHEET 6  
**Lock:** Unlocked  
**Author:** AutoCAD SHX Text

30' 30'

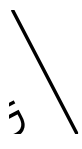

**Subject:**  
**Page Label:** [1] SHEET 6  
**Lock:** Unlocked  
**Author:** AutoCAD SHX Text

(XXXXX)

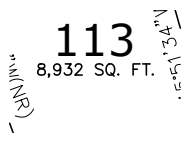


**Subject:**  
**Page Label:** [1] SHEET 6  
**Lock:** Unlocked  
**Author:** AutoCAD SHX Text

8,932 SQ. FT.


**Subject:**  
**Page Label:** [1] SHEET 6  
**Lock:** Unlocked  
**Author:** AutoCAD SHX Text

(XXXXX)

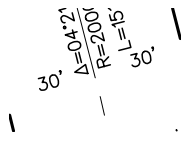


**Subject:**  
**Page Label:** [1] SHEET 6  
**Lock:** Unlocked  
**Author:** AutoCAD SHX Text

30' 30'

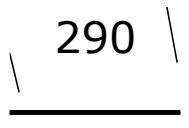


**Subject:**  
**Page Label:** [1] SHEET 6  
**Lock:** Unlocked  
**Author:** AutoCAD SHX Text

6,525 SQ. FT.

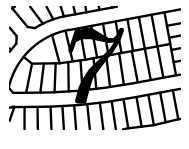

**Subject:**  
**Page Label:** [1] SHEET 6  
**Lock:** Unlocked  
**Author:** AutoCAD SHX Text

7

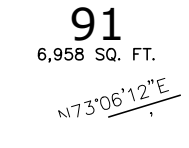


**Subject:**  
**Page Label:** [1] SHEET 6  
**Lock:** Unlocked  
**Author:** AutoCAD SHX Text

6,958 SQ. FT.

33.04' 21.1'  
(XXXXXX)

**Subject:**  
**Page Label:** [1] SHEET 6 (XXXXXX)  
**Lock:** Unlocked  
**Author:** AutoCAD SHX Text

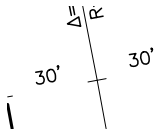

**Subject:**  
**Page Label:** [1] SHEET 6 30' 30'  
**Lock:** Unlocked  
**Author:** AutoCAD SHX Text

L=50.00'  
(XXXXXX)

**Subject:**  
**Page Label:** [1] SHEET 6 (XXXXXX)  
**Lock:** Unlocked  
**Author:** AutoCAD SHX Text

L=64.46'  
(XXXXXX)


**Subject:**  
**Page Label:** [1] SHEET 6 (XXXXXX)  
**Lock:** Unlocked  
**Author:** AutoCAD SHX Text

292

**Subject:**  
**Page Label:** [1] SHEET 6 6,751 SQ. FT.  
**Lock:** Unlocked  
**Author:** AutoCAD SHX Text

131.21  
121  
7,631 SQ. FT.

**Subject:**  
**Page Label:** [1] SHEET 6 7,631 SQ. FT.  
**Lock:** Unlocked  
**Author:** AutoCAD SHX Text

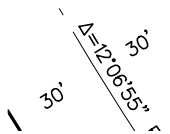

**Subject:**  
**Page Label:** [1] SHEET 6 30' 30'  
**Lock:** Unlocked  
**Author:** AutoCAD SHX Text

111  
9,858 SQ. FT.

**Subject:**  
**Page Label:** [1] SHEET 6 9,858 SQ. FT.  
**Lock:** Unlocked  
**Author:** AutoCAD SHX Text


105  
8,065 SQ. FT.

**Subject:**  
**Page Label:** [1] SHEET 6 8,065 SQ. FT.  
**Lock:** Unlocked  
**Author:** AutoCAD SHX Text


55.00'  
(XXXXXX)

**Subject:**  
**Page Label:** [1] SHEET 6 (XXXXXX)  
**Lock:** Unlocked  
**Author:** AutoCAD SHX Text


**Subject:**  
**Page Label:** [1] SHEET 6 30' 30'  
**Lock:** Unlocked  
**Author:** AutoCAD SHX Text

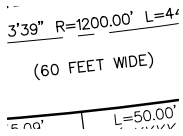


**Subject:**  
**Page Label:** [1] SHEET 6 (60 FEET WIDE)  
**Lock:** Unlocked  
**Author:** AutoCAD SHX Text

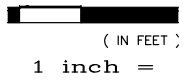


**Subject:**  
**Page Label:** [1] SHEET 6 1 inch =  
**Lock:** Unlocked  
**Author:** AutoCAD SHX Text

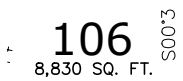

**Subject:**  
**Page Label:** [1] SHEET 6 8,830 SQ. FT.  
**Lock:** Unlocked  
**Author:** AutoCAD SHX Text

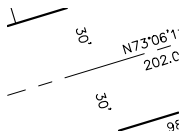

**Subject:**  
**Page Label:** [1] SHEET 6 30' 30'  
**Lock:** Unlocked  
**Author:** AutoCAD SHX Text

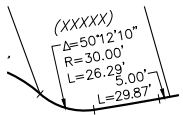

**Subject:**  
**Page Label:** [1] SHEET 6 Δ=50°12'10"R=30.00' L=26.29'  
**Lock:** Unlocked  
**Author:** AutoCAD SHX Text




**Subject:**  
**Page Label:** [1] SHEET 6 (XXXXX)  
**Lock:** Unlocked  
**Author:** AutoCAD SHX Text

**Subject:**  
**Page Label:** [1] SHEET 6 (XXXXX)  
**Lock:** Unlocked  
**Author:** AutoCAD SHX Text

DATE: DECEMB
SHEET: 6
PROJECT NO


**Subject:**  
**Page Label:** [1] SHEET 6 SHEET: 6  
**Lock:** Unlocked  
**Author:** AutoCAD SHX Text

**Subject:**  
**Page Label:** [1] SHEET 6 7,558 SQ. FT.  
**Lock:** Unlocked  
**Author:** AutoCAD SHX Text

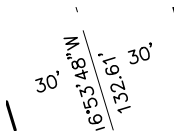


**Subject:**  
**Page Label:** [1] SHEET 6  
**Lock:** Unlocked  
**Author:** AutoCAD SHX Text

30' 30'

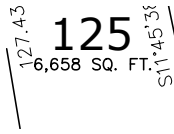


**Subject:**  
**Page Label:** [1] SHEET 6  
**Lock:** Unlocked  
**Author:** AutoCAD SHX Text

6,658 SQ. FT.

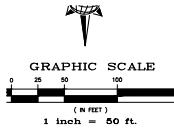

**Subject:**  
**Page Label:** [1] SHEET 6  
**Lock:** Unlocked  
**Author:** AutoCAD SHX Text

GRAPHIC SCALE

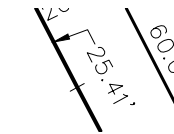

**Subject:**  
**Page Label:** [1] SHEET 6  
**Lock:** Unlocked  
**Author:** AutoCAD SHX Text

25.41'




**Subject:**  
**Page Label:** [1] SHEET 6  
**Lock:** Unlocked  
**Author:** AutoCAD SHX Text

(60 FEET WIDE)




**Subject:**  
**Page Label:** [1] SHEET 6  
**Lock:** Unlocked  
**Author:** AutoCAD SHX Text

(60 FEET WIDE)

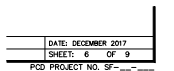


**Subject:**  
**Page Label:** [1] SHEET 6  
**Lock:** Unlocked  
**Author:** AutoCAD SHX Text

PCD PROJECT NO. SF-\_\_\_-\_\_\_

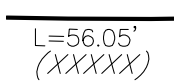


**Subject:**  
**Page Label:** [1] SHEET 6  
**Lock:** Unlocked  
**Author:** AutoCAD SHX Text

(XXXXX)

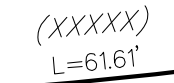

**Subject:**  
**Page Label:** [1] SHEET 6  
**Lock:** Unlocked  
**Author:** AutoCAD SHX Text

(XXXXX)

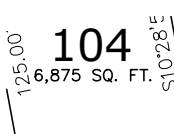

**Subject:**  
**Page Label:** [1] SHEET 6  
**Lock:** Unlocked  
**Author:** AutoCAD SHX Text

6,875 SQ. FT.

124.6  
129  
6,412 SQ. FT.  
S10°28'31"E

**Subject:**  
**Page Label:** [1] SHEET 6  
**Lock:** Unlocked  
**Author:** AutoCAD SHX Text

6,412 SQ. FT.

N79°31'05"E  
298.00'  
(60 FEET WIDE)  
55.00'

**Subject:**  
**Page Label:** [1] SHEET 6  
**Lock:** Unlocked  
**Author:** AutoCAD SHX Text

(60 FEET WIDE)

95  
8,772 SQ. FT.  
(128.59')  
15' UTILITY EASEMENT  
S89°35'13"(NR)  
130.00'  
96

**Subject:**  
**Page Label:** [1] SHEET 6  
**Lock:** Unlocked  
**Author:** AutoCAD SHX Text

15' UTILITY EASEMENT

131.66  
122  
7,303 SQ. FT.  
S16°53'

**Subject:**  
**Page Label:** [1] SHEET 6  
**Lock:** Unlocked  
**Author:** AutoCAD SHX Text

7,303 SQ. FT.

30' 30'

**Subject:**  
**Page Label:** [1] SHEET 6  
**Lock:** Unlocked  
**Author:** AutoCAD SHX Text

30' 30'

(XXXXXX)  
L=61.61'

**Subject:**  
**Page Label:** [1] SHEET 6  
**Lock:** Unlocked  
**Author:** AutoCAD SHX Text

(XXXXXX)

25

**Subject:**  
**Page Label:** [1] SHEET 6  
**Lock:** Unlocked  
**Author:** AutoCAD SHX Text

25

**Subject:**  
**Page Label:** [1] SHEET 6  
**Lock:** Unlocked  
**Author:** AutoCAD SHX Text

(XXXXXX)

OF 2017  
OF 9  
CF

**Subject:**  
**Page Label:** [1] SHEET 6  
**Lock:** Unlocked  
**Author:** AutoCAD SHX Text

OF 9

(80 FEET WIDE)

**Subject:**  
**Page Label:** [1] SHEET 6  
**Lock:** Unlocked  
**Author:** AutoCAD SHX Text

(80 FEET WIDE)



Subject: 2  
 Page Label: [1] SHEET 6  
 Lock: Unlocked  
 Author: AutoCAD SHX Text


NR

Subject: NR  
 Page Label: [1] SHEET 6  
 Lock: Unlocked  
 Author: AutoCAD SHX Text

Subject: (60 FEET WIDE)  
 Page Label: [1] SHEET 6  
 Lock: Unlocked  
 Author: AutoCAD SHX Text

L=50.00'  
 (XXXXXX)

Subject: (XXXXXX)  
 Page Label: [1] SHEET 6  
 Lock: Unlocked  
 Author: AutoCAD SHX Text

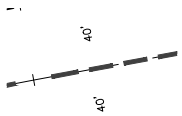

Subject: 40' 40'  
 Page Label: [1] SHEET 6  
 Lock: Unlocked  
 Author: AutoCAD SHX Text

109  
 8,846 SQ. FT.

Subject: 8,846 SQ. FT.  
 Page Label: [1] SHEET 6  
 Lock: Unlocked  
 Author: AutoCAD SHX Text

17'44" W

128.00'  
 117  
 7,040 SQ. FT.  
 N10°28'5"

Subject: 7,040 SQ. FT.  
 Page Label: [1] SHEET 6  
 Lock: Unlocked  
 Author: AutoCAD SHX Text

108  
 8,655 SQ. FT.


Subject: 8,655 SQ. FT.  
 Page Label: [1] SHEET 6  
 Lock: Unlocked  
 Author: AutoCAD SHX Text

32.5'

123.75'  
 99  
 7,210 SQ. FT.  
 00°E

Subject: 7,210 SQ. FT.  
 Page Label: [1] SHEET 6  
 Lock: Unlocked  
 Author: AutoCAD SHX Text

Subject: (60 FEET WIDE)  
 Page Label: [1] SHEET 6  
 Lock: Unlocked  
 Author: AutoCAD SHX Text

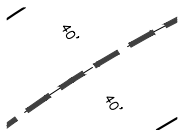


**Subject:**  
**Page Label:** [1] SHEET 6  
**Lock:** Unlocked  
**Author:** AutoCAD SHX Text

40' 40'

295


**Subject:**  
**Page Label:** [1] SHEET 6  
**Lock:** Unlocked  
**Author:** AutoCAD SHX Text

6,875 SQ. FT.

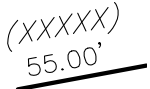


**Subject:**  
**Page Label:** [1] SHEET 6  
**Lock:** Unlocked  
**Author:** AutoCAD SHX Text

(XXXXX)

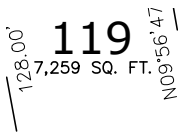


**Subject:**  
**Page Label:** [1] SHEET 6  
**Lock:** Unlocked  
**Author:** AutoCAD SHX Text

7,259 SQ. FT.

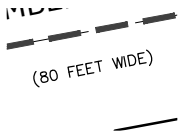


**Subject:**  
**Page Label:** [1] SHEET 6  
**Lock:** Unlocked  
**Author:** AutoCAD SHX Text

(80 FEET WIDE)

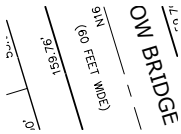

**Subject:**  
**Page Label:** [1] SHEET 6  
**Lock:** Unlocked  
**Author:** AutoCAD SHX Text

(60 FEET WIDE)

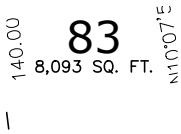


**Subject:**  
**Page Label:** [1] SHEET 6  
**Lock:** Unlocked  
**Author:** AutoCAD SHX Text

8,093 SQ. FT.

291

**Subject:**  
**Page Label:** [1] SHEET 6  
**Lock:** Unlocked  
**Author:** AutoCAD SHX Text


6,834 SQ. FT.

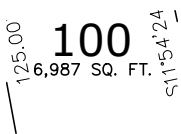

**Subject:**  
**Page Label:** [1] SHEET 6  
**Lock:** Unlocked  
**Author:** AutoCAD SHX Text

6,987 SQ. FT.

112

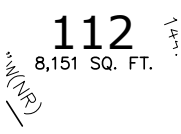

**Subject:**  
**Page Label:** [1] SHEET 6  
**Lock:** Unlocked  
**Author:** AutoCAD SHX Text

8,151 SQ. FT.

L=50.00'  
(XXXXX)


**Subject:**  
**Page Label:** [1] SHEET 6 (XXXXX)  
**Lock:** Unlocked  
**Author:** AutoCAD SHX Text

38.00'  
(XXXXX)

**Subject:**  
**Page Label:** [1] SHEET 6 (XXXXX)  
**Lock:** Unlocked  
**Author:** AutoCAD SHX Text

30' 30'

**Subject:**  
**Page Label:** [1] SHEET 6 30' 30'  
**Lock:** Unlocked  
**Author:** AutoCAD SHX Text

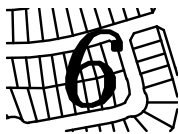

**Subject:**  
**Page Label:** [1] SHEET 6 6  
**Lock:** Unlocked  
**Author:** AutoCAD SHX Text

- LEGEND
- = FOUND MONUMENT AS SHOWN
  - = FOUND #4 REBAR WITH CAP
  - = SET #4 REBAR W/CAP
  - = SET #4 REBAR W/CAP
  - = SET #4 REBAR W/CAP
  - = NON-RADIAL BEARING
  - = EASEMENT OR NO-BUILD DIM.
  - = ADDRESS
  - = MATCHLINE

**Subject:**  
**Page Label:** [1] SHEET 6 = FOUND MONUMENT AS SHOWN = FOUND #4 REBAR WITH CAP PLS 34583 = SET #4 REBAR W/CAP PLS 34583 = NON-RADIAL BEARING = EASEMENT OR NO-BUILD DIM. = ADDRESS ADDRESS = MATCHLINE  
**Lock:** Unlocked  
**Author:** AutoCAD SHX Text

(60 FEET WIDE)  
INGPARK L

**Subject:**  
**Page Label:** [1] SHEET 6 (60 FEET WIDE)  
**Lock:** Unlocked  
**Author:** AutoCAD SHX Text

50

**Subject:**  
**Page Label:** [1] SHEET 6 50  
**Lock:** Unlocked  
**Author:** AutoCAD SHX Text

SHEET 7  
N70°31'05"E

**Subject:**  
**Page Label:** [1] SHEET 6 SHEET 7  
**Lock:** Unlocked  
**Author:** AutoCAD SHX Text



**Subject:**  
**Page Label:** [1] SHEET 6 STONEBRIDGE FILING 1  
**Lock:** Unlocked  
**Author:** AutoCAD SHX Text




**Subject:**  
**Page Label:** [1] SHEET 6 STAPLETON DRIVE  
**Lock:** Unlocked  
**Author:** AutoCAD SHX Text

INDEX




---

**Subject:**  
**Page Label:** [1] SHEET 6 (XXXXX)  
**Lock:** Unlocked  
**Author:** AutoCAD SHX Text

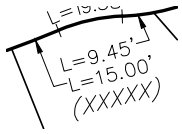

---

**Subject:**  
**Page Label:** [1] SHEET 6 L=15.00'  
**Lock:** Unlocked  
**Author:** AutoCAD SHX Text

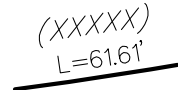

---

**Subject:**  
**Page Label:** [1] SHEET 6 (XXXXX)  
**Lock:** Unlocked  
**Author:** AutoCAD SHX Text

---

**Subject:**  
**Page Label:** [1] SHEET 6 L=8.99'  
**Lock:** Unlocked  
**Author:** AutoCAD SHX Text


---

**Subject:**  
**Page Label:** [1] SHEET 6 30' 30'  
**Lock:** Unlocked  
**Author:** AutoCAD SHX Text

DATE: DECEMBER 2017
SHEET: 6 OF 9
PCD PROJECT NO. SF-___


---

**Subject:**  
**Page Label:** [1] SHEET 6 DATE: DECEMBER 2017  
**Lock:** Unlocked  
**Author:** AutoCAD SHX Text

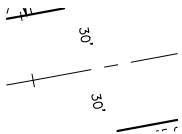


---

**Subject:**  
**Page Label:** [1] SHEET 6 30' 30'  
**Lock:** Unlocked  
**Author:** AutoCAD SHX Text

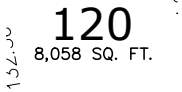

---

**Subject:**  
**Page Label:** [1] SHEET 6 8,058 SQ. FT.  
**Lock:** Unlocked  
**Author:** AutoCAD SHX Text

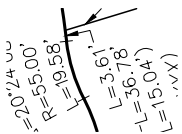

---

**Subject:**  
**Page Label:** [1] SHEET 6 L=3.61'  
**Lock:** Unlocked  
**Author:** AutoCAD SHX Text



---

**Subject:**  
**Page Label:** [1] SHEET 6 7,023 SQ. FT.  
**Lock:** Unlocked  
**Author:** AutoCAD SHX Text

128.00'  
115  
7,040 SQ. FT.  
N10°28'5"

**Subject:**  
**Page Label:** [1] SHEET 6  
**Lock:** Unlocked  
**Author:** AutoCAD SHX Text

7,040 SQ. FT.

92  
6,600 SQ. FT.  
N73°06'12"E

**Subject:**  
**Page Label:** [1] SHEET 6  
**Lock:** Unlocked  
**Author:** AutoCAD SHX Text

6,600 SQ. FT.

131  
8,366 SQ. FT.  
S14°57'25"E

**Subject:**  
**Page Label:** [1] SHEET 6  
**Lock:** Unlocked  
**Author:** AutoCAD SHX Text

8,366 SQ. FT.

TRACT I  
0.162 ACRES

**Subject:**  
**Page Label:** [1] SHEET 6  
**Lock:** Unlocked  
**Author:** AutoCAD SHX Text

0.162 ACRES

97  
9,197 SQ. FT.  
4"E(N)

**Subject:**  
**Page Label:** [1] SHEET 6  
**Lock:** Unlocked  
**Author:** AutoCAD SHX Text

9,197 SQ. FT.

L=55.48'  
(XXXXXX)

**Subject:**  
**Page Label:** [1] SHEET 6  
**Lock:** Unlocked  
**Author:** AutoCAD SHX Text

(XXXXXX)

**Subject:**  
**Page Label:** [1] SHEET 6  
**Lock:** Unlocked  
**Author:** AutoCAD SHX Text

(XXXXXX)

(H H H H)  
L=42.00'  
R=39.61'

**Subject:**  
**Page Label:** [1] SHEET 6  
**Lock:** Unlocked  
**Author:** AutoCAD SHX Text

(XXXXXX)

L=  
L=17.38'  
L=15.00'  
(XXXXXX)

**Subject:**  
**Page Label:** [1] SHEET 6  
**Lock:** Unlocked  
**Author:** AutoCAD SHX Text

L=15.00'

134.05  
80  
8,085 SQ. FT.  
N01°04'54"

**Subject:**  
**Page Label:** [1] SHEET 6  
**Lock:** Unlocked  
**Author:** AutoCAD SHX Text

8,085 SQ. FT.

-----  
**Subject:**  
**Page Label:** [1] SHEET 6 7,913 SQ. FT.  
**Lock:** Unlocked  
**Author:** AutoCAD SHX Text

DRAWN BY: LCG  
CHECKED BY: TAK

-----  
**Subject:**  
**Page Label:** [1] SHEET 6 CHECKED BY: TAK  
**Lock:** Unlocked  
**Author:** AutoCAD SHX Text

55.70  
5.00'  
L=15.16'  
(XXXXX)  
7,284  
11.12

-----  
**Subject:**  
**Page Label:** [1] SHEET 6 (XXXXX)  
**Lock:** Unlocked  
**Author:** AutoCAD SHX Text

(XXXXXX)  
L=42.00'

-----  
**Subject:**  
**Page Label:** [1] SHEET 6 (XXXXX)  
**Lock:** Unlocked  
**Author:** AutoCAD SHX Text

125.00  
103  
6,875 SQ. FT.  
510'28"

-----  
**Subject:**  
**Page Label:** [1] SHEET 6 6,875 SQ. FT.  
**Lock:** Unlocked  
**Author:** AutoCAD SHX Text

294

-----  
**Subject:**  
**Page Label:** [1] SHEET 6 6,834 SQ. FT.  
**Lock:** Unlocked  
**Author:** AutoCAD SHX Text

.29'  
5.00'  
=29.87'

-----  
**Subject:**  
**Page Label:** [1] SHEET 6 5.00'  
**Lock:** Unlocked  
**Author:** AutoCAD SHX Text

100  
I

-----  
**Subject:**  
**Page Label:** [1] SHEET 6 100  
**Lock:** Unlocked  
**Author:** AutoCAD SHX Text

142.95  
130  
6,808 SQ. FT.  
515'3.19"

-----  
**Subject:**  
**Page Label:** [1] SHEET 6 6,808 SQ. FT.  
**Lock:** Unlocked  
**Author:** AutoCAD SHX Text

30.  
S27°30'22"E  
300.00'

-----  
**Subject:**  
**Page Label:** [1] SHEET 6 S27°30'22"E300.00'  
**Lock:** Unlocked  
**Author:** AutoCAD SHX Text

(XXXXX)  
-L=8.32'  
1-50.52'

-----  
**Subject:**  
**Page Label:** [1] SHEET 6 (XXXXX)  
**Lock:** Unlocked  
**Author:** AutoCAD SHX Text



-----  
**Subject:**  
**Page Label:** [1] SHEET 6 (XXXXX)  
**Lock:** Unlocked  
**Author:** AutoCAD SHX Text

-----  
L=31'50"12" R=450.00' L=25'  
0.6  
0.6

-----  
**Subject:**  
**Page Label:** [1] SHEET 6 30' 30'  
**Lock:** Unlocked  
**Author:** AutoCAD SHX Text

-----  
128.0' 123 516'07.3  
6,795 SQ. FT.

-----  
**Subject:**  
**Page Label:** [1] SHEET 6 6,795 SQ. FT.  
**Lock:** Unlocked  
**Author:** AutoCAD SHX Text

-----  
L=1.00  
L=15.00  
(XXXXX)  
2)

-----  
**Subject:**  
**Page Label:** [1] SHEET 6 (XXXXX)  
**Lock:** Unlocked  
**Author:** AutoCAD SHX Text

-----  
135.00' 81 7,957 SQ. FT. NO4'05'15

-----  
**Subject:**  
**Page Label:** [1] SHEET 6 7,957 SQ. FT.  
**Lock:** Unlocked  
**Author:** AutoCAD SHX Text

-----  
**TRACT** E  
0.981 ACRES

-----  
**Subject:**  
**Page Label:** [1] SHEET 6 0.981 ACRES  
**Lock:** Unlocked  
**Author:** AutoCAD SHX Text

-----  
SHEET 5  
/ / /

-----  
**Subject:**  
**Page Label:** [1] SHEET 6 SHEET 55  
**Lock:** Unlocked  
**Author:** AutoCAD SHX Text

-----  
(XXXXX)  
L=59.50'

-----  
**Subject:**  
**Page Label:** [1] SHEET 6 (XXXXX)  
**Lock:** Unlocked  
**Author:** AutoCAD SHX Text

-----  
(XXXXX)  
55.00'

-----  
**Subject:**  
**Page Label:** [1] SHEET 6 (XXXXX)  
**Lock:** Unlocked  
**Author:** AutoCAD SHX Text

135

**Subject:**  
**Page Label:** [1] SHEET 6  
**Lock:** Unlocked  
**Author:** AutoCAD SHX Text

6,876 SQ. FT.

550.00'  
(XXXXXX)

**Subject:**  
**Page Label:** [1] SHEET 6  
**Lock:** Unlocked  
**Author:** AutoCAD SHX Text

(XXXXXX)

ING GLEN LA  
50.00'  
(XXXXXX)  
(60 FEET WIDE)

**Subject:**  
**Page Label:** [1] SHEET 6  
**Lock:** Unlocked  
**Author:** AutoCAD SHX Text

(60 FEET WIDE)

(XXXXXX)  
L=56.00'

**Subject:**  
**Page Label:** [1] SHEET 6  
**Lock:** Unlocked  
**Author:** AutoCAD SHX Text

(XXXXXX)

75

**Subject:**  
**Page Label:** [1] SHEET 6  
**Lock:** Unlocked  
**Author:** AutoCAD SHX Text

7,981 SQ. FT.

L=9.40'  
L=15.00'  
(XXXXXX)

**Subject:**  
**Page Label:** [1] SHEET 6  
**Lock:** Unlocked  
**Author:** AutoCAD SHX Text

(XXXXXX)

130.24  
7,851 SQ. FT.

79

**Subject:**  
**Page Label:** [1] SHEET 6  
**Lock:** Unlocked  
**Author:** AutoCAD SHX Text

7,851 SQ. FT.

N01°05'30"W

STON DRIVE

INDEX MAP  
N.T.S.

**Subject:**  
**Page Label:** [1] SHEET 6  
**Lock:** Unlocked  
**Author:** AutoCAD SHX Text

INDEX MAP

LEGEND

(XXXXXX)  
∠=50°12'11"

**Subject:**  
**Page Label:** [1] SHEET 6  
**Lock:** Unlocked  
**Author:** AutoCAD SHX Text

(XXXXXX)

125.28  
6,989 SQ. FT.

127


**Subject:**  
**Page Label:** [1] SHEET 6  
**Lock:** Unlocked  
**Author:** AutoCAD SHX Text

6,989 SQ. FT.

S07°17'15"E

---

**Subject:**  
**Page Label:** [1] SHEET 6 30' 30'  
**Lock:** Unlocked  
**Author:** AutoCAD SHX Text

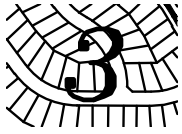

---

**Subject:**  
**Page Label:** [1] SHEET 6 3  
**Lock:** Unlocked  
**Author:** AutoCAD SHX Text

98  
8,935 SQ. FT.  
(XXXXXX)

---

**Subject:**  
**Page Label:** [1] SHEET 6 8,935 SQ. FT.  
**Lock:** Unlocked  
**Author:** AutoCAD SHX Text

TRACT  
C

---

**Subject:**  
**Page Label:** [1] SHEET 6 0.362 ACRES  
**Lock:** Unlocked  
**Author:** AutoCAD SHX Text

116  
7,040 SQ. FT.  
128.00' N10°28'E

---

**Subject:**  
**Page Label:** [1] SHEET 6 7,040 SQ. FT.  
**Lock:** Unlocked  
**Author:** AutoCAD SHX Text

TRACT  
C

---

**Subject:**  
**Page Label:** [1] SHEET 6 0.362 ACRES  
**Lock:** Unlocked  
**Author:** AutoCAD SHX Text

(XXXXXX)  
L=60.00'

---

**Subject:**  
**Page Label:** [1] SHEET 6 (XXXXXX)  
**Lock:** Unlocked  
**Author:** AutoCAD SHX Text

89  
7,150 SQ. FT.  
130.00' N16°55'E

---

**Subject:**  
**Page Label:** [1] SHEET 6 7,150 SQ. FT.  
**Lock:** Unlocked  
**Author:** AutoCAD SHX Text

90  
7,150 SQ. FT.  
130.00' N16°55'E

---

**Subject:**  
**Page Label:** [1] SHEET 6 7,150 SQ. FT.  
**Lock:** Unlocked  
**Author:** AutoCAD SHX Text

L=70.00'  
(XXXXXX)

---

**Subject:**  
**Page Label:** [1] SHEET 6 (XXXXXX)  
**Lock:** Unlocked  
**Author:** AutoCAD SHX Text

107  
8,948 SQ. FT.

**Subject:**  
**Page Label:** [1] SHEET 6  
**Lock:** Unlocked  
**Author:** AutoCAD SHX Text

8,948 SQ. FT.



**Subject:**  
**Page Label:** [1] SHEET 6  
**Lock:** Unlocked  
**Author:** AutoCAD SHX Text

WINDINGWALK FILING No. 1 AT MERIDIAN RANCH A PARCEL OF LAND LOCATED IN A PORTION OF SECTION 29, 30, AND 32 IN TOWNSHIP 12 SOUTH, RANGE 64 WEST OF THE 6TH PRINCIPAL MERIDIAN EL PASO COUNTY, COLORADO.

87  
7,216 SQ. FT.


**Subject:**  
**Page Label:** [1] SHEET 6  
**Lock:** Unlocked  
**Author:** AutoCAD SHX Text

7,216 SQ. FT.



**Subject:**  
**Page Label:** [1] SHEET 6  
**Lock:** Unlocked  
**Author:** AutoCAD SHX Text

THE VISTAS FILING 1

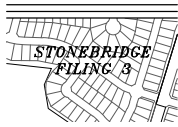

**Subject:**  
**Page Label:** [1] SHEET 6  
**Lock:** Unlocked  
**Author:** AutoCAD SHX Text

STONEBRIDGE FILING 3

L=8.27'  
/vXXX)

**Subject:**  
**Page Label:** [1] SHEET 6  
**Lock:** Unlocked  
**Author:** AutoCAD SHX Text

L=8.27'

(XXXXX)  
L=62.3

**Subject:**  
**Page Label:** [1] SHEET 6  
**Lock:** Unlocked  
**Author:** AutoCAD SHX Text

(XXXXX)

200

**Subject:**  
**Page Label:** [1] SHEET 6  
**Lock:** Unlocked  
**Author:** AutoCAD SHX Text

200

(XXXXX)  
55.00'

**Subject:**  
**Page Label:** [1] SHEET 6  
**Lock:** Unlocked  
**Author:** AutoCAD SHX Text

(XXXXX)

102  
6,875 SQ. FT.

**Subject:**  
**Page Label:** [1] SHEET 6  
**Lock:** Unlocked  
**Author:** AutoCAD SHX Text

6,875 SQ. FT.


135.00' 85 7,708 SQ. FT. N151.5'

Subject: 7,708 SQ. FT.  
Page Label: [1] SHEET 6  
Lock: Unlocked  
Author: AutoCAD SHX Text



Subject: 9  
Page Label: [1] SHEET 6  
Lock: Unlocked  
Author: AutoCAD SHX Text

Subject: (XXXXX)  
Page Label: [1] SHEET 6  
Lock: Unlocked  
Author: AutoCAD SHX Text

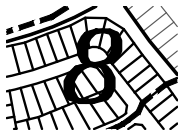

Subject: 8  
Page Label: [1] SHEET 6  
Lock: Unlocked  
Author: AutoCAD SHX Text

L=50.00'  
(XXXXX)

Subject: (XXXXX)  
Page Label: [1] SHEET 6  
Lock: Unlocked  
Author: AutoCAD SHX Text


(XXXXX)  
55.00'

Subject: (XXXXX)  
Page Label: [1] SHEET 6  
Lock: Unlocked  
Author: AutoCAD SHX Text

Subject: (XXXXX)  
Page Label: [1] SHEET 6  
Lock: Unlocked  
Author: AutoCAD SHX Text

**N.T.S.**

Subject: N.T.S.  
Page Label: [1] SHEET 6  
Lock: Unlocked  
Author: AutoCAD SHX Text

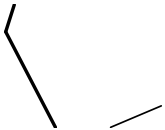


Subject: (XXXXX)  
Page Label: [1] SHEET 6  
Lock: Unlocked  
Author: AutoCAD SHX Text

128.00' 118 7,040 SQ. FT. N10°28'5"

Subject: 7,040 SQ. FT.  
Page Label: [1] SHEET 6  
Lock: Unlocked  
Author: AutoCAD SHX Text



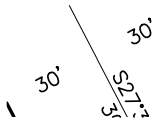


**Subject:**  
**Page Label:** [1] SHEET 6 30' 30'  
**Lock:** Unlocked  
**Author:** AutoCAD SHX Text

**Subject:**  
**Page Label:** [1] SHEET 6 (XXXXX)  
**Lock:** Unlocked  
**Author:** AutoCAD SHX Text

**Subject:**  
**Page Label:** [1] SHEET 6 8,290 SQ. FT.  
**Lock:** Unlocked  
**Author:** AutoCAD SHX Text

314

**Subject:**  
**Page Label:** [1] SHEET 7 6,598 SQ. FT.  
**Lock:** Unlocked  
**Author:** AutoCAD SHX Text

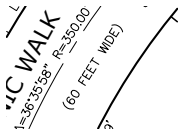


**Subject:**  
**Page Label:** [1] SHEET 7 (60 FEET WIDE)  
**Lock:** Unlocked  
**Author:** AutoCAD SHX Text

(XXXXX)  
L=15.00'  
40 90'

**Subject:**  
**Page Label:** [1] SHEET 7 (XXXXX)  
**Lock:** Unlocked  
**Author:** AutoCAD SHX Text

125.00  
268  
7,138 SQ. FT. 510'28"

**Subject:**  
**Page Label:** [1] SHEET 7 7,138 SQ. FT.  
**Lock:** Unlocked  
**Author:** AutoCAD SHX Text

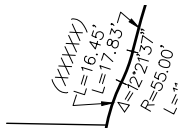

**Subject:**  
**Page Label:** [1] SHEET 7 L=16.45'  
**Lock:** Unlocked  
**Author:** AutoCAD SHX Text

129.37'  
271  
7,309 SQ. FT. 507'04"

**Subject:**  
**Page Label:** [1] SHEET 7 7,309 SQ. FT.  
**Lock:** Unlocked  
**Author:** AutoCAD SHX Text

50.00'  
(XXXXX)


**Subject:**  
**Page Label:** [1] SHEET 7 (XXXXX)  
**Lock:** Unlocked  
**Author:** AutoCAD SHX Text

(XXXXXX)  
L=46.72'

Subject: (XXXXXX)  
Page Label: [1] SHEET 7  
Lock: Unlocked  
Author: AutoCAD SHX Text

L=55.00'  
(XXXXXX)

Subject: (XXXXXX)  
Page Label: [1] SHEET 7  
Lock: Unlocked  
Author: AutoCAD SHX Text

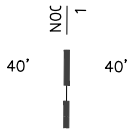

Subject: 40' 40'  
Page Label: [1] SHEET 7  
Lock: Unlocked  
Author: AutoCAD SHX Text



Subject: 3  
Page Label: [1] SHEET 7  
Lock: Unlocked  
Author: AutoCAD SHX Text

Subject: 6,734 SQ. FT.  
Page Label: [1] SHEET 7  
Lock: Unlocked  
Author: AutoCAD SHX Text

Subject: (60 FEET WIDE)  
Page Label: [1] SHEET 7  
Lock: Unlocked  
Author: AutoCAD SHX Text

(XXXXXX)  
55.00'


Subject: (XXXXXX)  
Page Label: [1] SHEET 7  
Lock: Unlocked  
Author: AutoCAD SHX Text

( IN FEET )  
.ch = 50

Subject: ( IN FEET )  
Page Label: [1] SHEET 7  
Lock: Unlocked  
Author: AutoCAD SHX Text



Subject: 7,915 SQ. FT.  
Page Label: [1] SHEET 7  
Lock: Unlocked  
Author: AutoCAD SHX Text

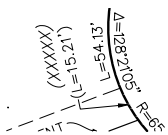

Subject: (L=15.21')  
Page Label: [1] SHEET 7  
Lock: Unlocked  
Author: AutoCAD SHX Text

50

**Subject:**  
**Page Label:** [1] SHEET 7  
**Lock:** Unlocked  
**Author:** AutoCAD SHX Text

50

135.00  
344  
7,425 SQ. FT. S10'28"

**Subject:**  
**Page Label:** [1] SHEET 7  
**Lock:** Unlocked  
**Author:** AutoCAD SHX Text

7,425 SQ. FT.

(XXXXXX)  
L=60.00'

**Subject:**  
**Page Label:** [1] SHEET 7  
**Lock:** Unlocked  
**Author:** AutoCAD SHX Text

(XXXXXX)

135.00  
326  
7,425 SQ. FT. N10'28"

**Subject:**  
**Page Label:** [1] SHEET 7  
**Lock:** Unlocked  
**Author:** AutoCAD SHX Text

7,425 SQ. FT.

STAPLETON DRIVE  
(EXISTING ROW 125' WIDE)  
SEC. 29  
SEC. 32

**Subject:**  
**Page Label:** [1] SHEET 7  
**Lock:** Unlocked  
**Author:** AutoCAD SHX Text

(EXISTING ROW 125' WIDE)

40'  
40'

**Subject:**  
**Page Label:** [1] SHEET 7  
**Lock:** Unlocked  
**Author:** AutoCAD SHX Text

40' 40'

125.00  
296  
6,875 SQ. FT. N10'28"

**Subject:**  
**Page Label:** [1] SHEET 7  
**Lock:** Unlocked  
**Author:** AutoCAD SHX Text

6,875 SQ. FT.

125.00  
295  
6,875 SQ. FT. N10'28"

**Subject:**  
**Page Label:** [1] SHEET 7  
**Lock:** Unlocked  
**Author:** AutoCAD SHX Text

6,875 SQ. FT.

ft.

**Subject:**  
**Page Label:** [1] SHEET 7  
**Lock:** Unlocked  
**Author:** AutoCAD SHX Text

ft.

STONEBRIDGE  
FILING 3

**Subject:**  
**Page Label:** [1] SHEET 7  
**Lock:** Unlocked  
**Author:** AutoCAD SHX Text

STONEBRIDGE FILING 3

---

**Subject:**  
**Page Label:** [1] SHEET 7 8,178 SQ. FT.  
**Lock:** Unlocked  
**Author:** AutoCAD SHX Text



---

**Subject:**  
**Page Label:** [1] SHEET 7 INDEX MAP  
**Lock:** Unlocked  
**Author:** AutoCAD SHX Text




---

**Subject:**  
**Page Label:** [1] SHEET 7 (XXXXX)  
**Lock:** Unlocked  
**Author:** AutoCAD SHX Text

100  
|

---

**Subject:**  
**Page Label:** [1] SHEET 7 100  
**Lock:** Unlocked  
**Author:** AutoCAD SHX Text

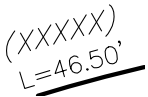

---

**Subject:**  
**Page Label:** [1] SHEET 7 (XXXXX)  
**Lock:** Unlocked  
**Author:** AutoCAD SHX Text

103  
|


---

**Subject:**  
**Page Label:** [1] SHEET 7 6,875 SQ. FT.  
**Lock:** Unlocked  
**Author:** AutoCAD SHX Text




---

**Subject:**  
**Page Label:** [1] SHEET 7 (XXXXX)  
**Lock:** Unlocked  
**Author:** AutoCAD SHX Text

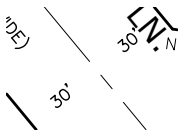


---

**Subject:**  
**Page Label:** [1] SHEET 7 30' 30'  
**Lock:** Unlocked  
**Author:** AutoCAD SHX Text

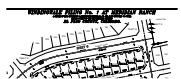


---

**Subject:**  
**Page Label:** [1] SHEET 7 WINDINGWALK FILING No. 1 AT MERIDIAN RANCH A PARCEL OF LAND LOCATED IN A PORTION OF SECTION 29, 30, AND 32 IN TOWNSHIP 12 SOUTH, RANGE 64 WEST OF THE 6TH PRINCIPAL MERIDIAN EL PASO COUNTY, COLORADO.  
**Lock:** Unlocked  
**Author:** AutoCAD SHX Text

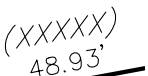


---


**Subject:**  
**Page Label:** [1] SHEET 7 (XXXXX)  
**Lock:** Unlocked  
**Author:** AutoCAD SHX Text

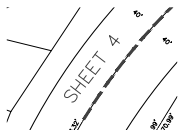


**Subject:** SHEET 44  
**Page Label:** [1] SHEET 7  
**Lock:** Unlocked  
**Author:** AutoCAD SHX Text

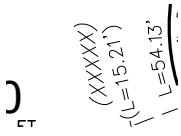

**Subject:** (XXXXX)  
**Page Label:** [1] SHEET 7  
**Lock:** Unlocked  
**Author:** AutoCAD SHX Text

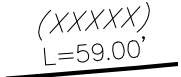


**Subject:** (XXXXXX)  
**Page Label:** [1] SHEET 7  
**Lock:** Unlocked  
**Author:** AutoCAD SHX Text

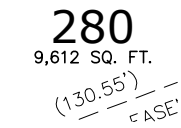


**Subject:** 9,612 SQ. FT.  
**Page Label:** [1] SHEET 7  
**Lock:** Unlocked  
**Author:** AutoCAD SHX Text



**Subject:** 7,480 SQ. FT.  
**Page Label:** [1] SHEET 7  
**Lock:** Unlocked  
**Author:** AutoCAD SHX Text

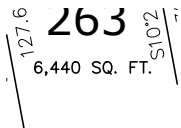

**Subject:** 6,440 SQ. FT.  
**Page Label:** [1] SHEET 7  
**Lock:** Unlocked  
**Author:** AutoCAD SHX Text

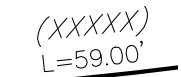

**Subject:** (XXXXXX)  
**Page Label:** [1] SHEET 7  
**Lock:** Unlocked  
**Author:** AutoCAD SHX Text



**Subject:** STONEBRIDGE FILING 1  
**Page Label:** [1] SHEET 7  
**Lock:** Unlocked  
**Author:** AutoCAD SHX Text



**Subject:** 6,916 SQ. FT.  
**Page Label:** [1] SHEET 7  
**Lock:** Unlocked  
**Author:** AutoCAD SHX Text



**Subject:** (XXXXXX)  
**Page Label:** [1] SHEET 7  
**Lock:** Unlocked  
**Author:** AutoCAD SHX Text

283  
7,057 SQ. FT.  
N66°28'47" W

Subject:  
Page Label: [1] SHEET 7  
Lock: Unlocked  
Author: AutoCAD SHX Text

7,057 SQ. FT.




Subject:  
Page Label: [1] SHEET 7  
Lock: Unlocked  
Author: AutoCAD SHX Text

8

322  
6,240 SQ. FT.  
S79°31'05" W


Subject:  
Page Label: [1] SHEET 7  
Lock: Unlocked  
Author: AutoCAD SHX Text

6,240 SQ. FT.

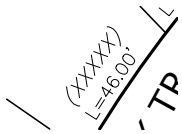


Subject:  
Page Label: [1] SHEET 7  
Lock: Unlocked  
Author: AutoCAD SHX Text

(XXXXX)

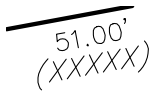

Subject:  
Page Label: [1] SHEET 7  
Lock: Unlocked  
Author: AutoCAD SHX Text

(XXXXX)

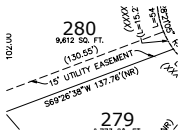


Subject:  
Page Label: [1] SHEET 7  
Lock: Unlocked  
Author: AutoCAD SHX Text

15' UTILITY EASEMENT

316

Subject:  
Page Label: [1] SHEET 7  
Lock: Unlocked  
Author: AutoCAD SHX Text

6,240 SQ. FT.

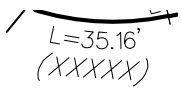

Subject:  
Page Label: [1] SHEET 7  
Lock: Unlocked  
Author: AutoCAD SHX Text

(XXXXX)



Subject:  
Page Label: [1] SHEET 7  
Lock: Unlocked  
Author: AutoCAD SHX Text

0.362 ACRES

220

Subject:  
Page Label: [1] SHEET 7  
Lock: Unlocked  
Author: AutoCAD SHX Text

7,023 SQ. FT.

318

**Subject:**  
**Page Label:** [1] SHEET 7  
**Lock:** Unlocked  
**Author:** AutoCAD SHX Text

6,631 SQ. FT.

**Subject:**  
**Page Label:** [1] SHEET 7  
**Lock:** Unlocked  
**Author:** AutoCAD SHX Text

7,410 SQ. FT.

L=55.00'  
(XXXXXX)

**Subject:**  
**Page Label:** [1] SHEET 7  
**Lock:** Unlocked  
**Author:** AutoCAD SHX Text

(XXXXXX)

**N.T.S.**

**Subject:**  
**Page Label:** [1] SHEET 7  
**Lock:** Unlocked  
**Author:** AutoCAD SHX Text

N.T.S.

**Subject:**  
**Page Label:** [1] SHEET 7  
**Lock:** Unlocked  
**Author:** AutoCAD SHX Text

L=8.99'

127.4'  
267  
6,564 SQ. FT. S10.28

**Subject:**  
**Page Label:** [1] SHEET 7  
**Lock:** Unlocked  
**Author:** AutoCAD SHX Text

6,564 SQ. FT.

**Subject:**  
**Page Label:** [1] SHEET 7  
**Lock:** Unlocked  
**Author:** AutoCAD SHX Text

(XXXXXX)

(XXXXXX)  
55.00'

**Subject:**  
**Page Label:** [1] SHEET 7  
**Lock:** Unlocked  
**Author:** AutoCAD SHX Text

(XXXXXX)

127.4  
330  
7,332 SQ. FT. N05.15.2

**Subject:**  
**Page Label:** [1] SHEET 7  
**Lock:** Unlocked  
**Author:** AutoCAD SHX Text

7,332 SQ. FT.

**EL**

**Subject:**  
**Page Label:** [1] SHEET 7  
**Lock:** Unlocked  
**Author:** AutoCAD SHX Text

(60 FEET WIDE)

(XXXXXX)  
L=60.00'

-----  
**Subject:**  
**Page Label:** [1] SHEET 7 (XXXXXX)  
**Lock:** Unlocked  
**Author:** AutoCAD SHX Text

122.64  
332  
6,882 SQ. FT.  
N00°46'25"

-----  
**Subject:**  
**Page Label:** [1] SHEET 7 6,882 SQ. FT.  
**Lock:** Unlocked  
**Author:** AutoCAD SHX Text



INDEX

-----  
**Subject:**  
**Page Label:** [1] SHEET 7 6,887 SQ. FT.  
**Lock:** Unlocked  
**Author:** AutoCAD SHX Text

-----  
**Subject:**  
**Page Label:** [1] SHEET 7 STAPLETON DRIVE  
**Lock:** Unlocked  
**Author:** AutoCAD SHX Text

-----  
**Subject:**  
**Page Label:** [1] SHEET 7 (60 FEET WIDE)  
**Lock:** Unlocked  
**Author:** AutoCAD SHX Text

279  
9,773 SQ. FT.

18'2"

-----  
**Subject:**  
**Page Label:** [1] SHEET 7 9,773 SQ. FT.  
**Lock:** Unlocked  
**Author:** AutoCAD SHX Text

130.66  
329  
7,520 SQ. FT.  
N07°03'10"

-----  
**Subject:**  
**Page Label:** [1] SHEET 7 7,520 SQ. FT.  
**Lock:** Unlocked  
**Author:** AutoCAD SHX Text

DATE: DECEMBER 2017
SHEET: 7 OF 9
PCD PROJECT NO. SF-___-___

-----  
**Subject:**  
**Page Label:** [1] SHEET 7 PCD PROJECT NO. SF-\_\_\_-\_\_\_  
**Lock:** Unlocked  
**Author:** AutoCAD SHX Text

40.00'  
L=14.00'  
(XXXXXX)

-----  
**Subject:**  
**Page Label:** [1] SHEET 7 (XXXXXX)  
**Lock:** Unlocked  
**Author:** AutoCAD SHX Text

1' R.  
30'  
00' L=223.57'  
30'

-----  
**Subject:**  
**Page Label:** [1] SHEET 7 30' 30'  
**Lock:** Unlocked  
**Author:** AutoCAD SHX Text



135.00'  
345  
7,425 SQ. FT.  
110°28'55"E

-----  
**Subject:**  
**Page Label:** [1] SHEET 7 7,425 SQ. FT.  
**Lock:** Unlocked  
**Author:** AutoCAD SHX Text

-----  
**Subject:**  
**Page Label:** [1] SHEET 7 30' 30'  
**Lock:** Unlocked  
**Author:** AutoCAD SHX Text

-----  
**Subject:**  
**Page Label:** [1] SHEET 7 7,419 SQ. FT.  
**Lock:** Unlocked  
**Author:** AutoCAD SHX Text

06'  
06'  
55'

-----  
**Subject:**  
**Page Label:** [1] SHEET 7 30' 30'  
**Lock:** Unlocked  
**Author:** AutoCAD SHX Text

126.01'  
334  
6,799 SQ. FT.  
N06°28'29"

-----  
**Subject:**  
**Page Label:** [1] SHEET 7 6,799 SQ. FT.  
**Lock:** Unlocked  
**Author:** AutoCAD SHX Text

SHEET 6  
N78°31'05"E

-----  
**Subject:**  
**Page Label:** [1] SHEET 7 SHEET 6  
**Lock:** Unlocked  
**Author:** AutoCAD SHX Text

-----  
**Subject:**  
**Page Label:** [1] SHEET 7 10.00'  
**Lock:** Unlocked  
**Author:** AutoCAD SHX Text

-----  
**Subject:**  
**Page Label:** [1] SHEET 7 (XXXXX)  
**Lock:** Unlocked  
**Author:** AutoCAD SHX Text

55.00'  
(XXXXX)

-----  
**Subject:**  
**Page Label:** [1] SHEET 7 (XXXXX)  
**Lock:** Unlocked  
**Author:** AutoCAD SHX Text


30'  
30'

-----  
**Subject:**  
**Page Label:** [1] SHEET 7 30' 30'  
**Lock:** Unlocked  
**Author:** AutoCAD SHX Text

282  
7,220 SQ. FT.  
77°39'41"W(NB)

Subject: 7,220 SQ. FT.  
Page Label: [1] SHEET 7  
Lock: Unlocked  
Author: AutoCAD SHX Text


Subject: 8,290 SQ. FT.  
Page Label: [1] SHEET 7  
Lock: Unlocked  
Author: AutoCAD SHX Text

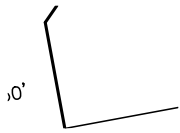

Subject: (XXXXX)  
Page Label: [1] SHEET 7  
Lock: Unlocked  
Author: AutoCAD SHX Text

221

Subject: 7,083 SQ. FT.  
Page Label: [1] SHEET 7  
Lock: Unlocked  
Author: AutoCAD SHX Text

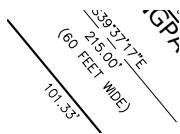

Subject: (60 FEET WIDE)  
Page Label: [1] SHEET 7  
Lock: Unlocked  
Author: AutoCAD SHX Text




Subject: (XXXXX)  
Page Label: [1] SHEET 7  
Lock: Unlocked  
Author: AutoCAD SHX Text



Subject: (XXXXX)  
Page Label: [1] SHEET 7  
Lock: Unlocked  
Author: AutoCAD SHX Text



Subject: (80 FEET WIDE)  
Page Label: [1] SHEET 7  
Lock: Unlocked  
Author: AutoCAD SHX Text

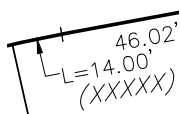

Subject: L=14.00'  
Page Label: [1] SHEET 7  
Lock: Unlocked  
Author: AutoCAD SHX Text

293  
6,751 SQ. FT.  
122.00' N10°28'


Subject: 6,751 SQ. FT.  
Page Label: [1] SHEET 7  
Lock: Unlocked  
Author: AutoCAD SHX Text

DRAWN BY: LCG  
CHECKED BY: TAK

**Subject:** DRAWN BY: LCG  
**Page Label:** [1] SHEET 7  
**Lock:** Unlocked  
**Author:** AutoCAD SHX Text

335  
9,389 SQ. FT.

**Subject:** 9,389 SQ. FT.  
**Page Label:** [1] SHEET 7  
**Lock:** Unlocked  
**Author:** AutoCAD SHX Text

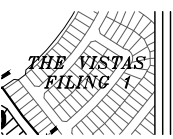

**Subject:** THE VISTAS FILING 1  
**Page Label:** [1] SHEET 7  
**Lock:** Unlocked  
**Author:** AutoCAD SHX Text

LEGEND  
● = FOUND MONUMENT AS SHOWN  
● = FOUND 4# REBAR WITH CAP PLS 34583  
● = SET #4 REBAR W/CAP PLS 34583  
● = NON-RADIAL BEARING  
[DASHED] = EASEMENT OR NO-BUILD DIM.  
[DASHED] = ADDRESS  
--- = MATCHLINE

**Subject:** = FOUND MONUMENT AS SHOWN = FOUND #4  
**Page Label:** [1] SHEET 7 REBAR WITH CAP PLS 34583 = SET #4  
**Lock:** Unlocked REBAR W/CAP PLS 34583 = NON-RADIAL  
**Author:** AutoCAD SHX Text BEARING = EASEMENT OR NO-BUILD DIM. =  
ADDRESS ADDRESS = MATCHLINE

50

**Subject:** 50  
**Page Label:** [1] SHEET 7  
**Lock:** Unlocked  
**Author:** AutoCAD SHX Text

**Subject:** (XXXXX)  
**Page Label:** [1] SHEET 7  
**Lock:** Unlocked  
**Author:** AutoCAD SHX Text

SEC. 29  
SEC. 32


**Subject:** SEC. 32  
**Page Label:** [1] SHEET 7  
**Lock:** Unlocked  
**Author:** AutoCAD SHX Text

127.62  
261  
6,947 SQ. FT. 510'28"

**Subject:** 6,947 SQ. FT.  
**Page Label:** [1] SHEET 7  
**Lock:** Unlocked  
**Author:** AutoCAD SHX Text

124.61  
333  
6,767 SQ. FT. N01'54'40"

**Subject:** 6,767 SQ. FT.  
**Page Label:** [1] SHEET 7  
**Lock:** Unlocked  
**Author:** AutoCAD SHX Text

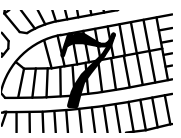

**Subject:** 7  
**Page Label:** [1] SHEET 7  
**Lock:** Unlocked  
**Author:** AutoCAD SHX Text

134.78  
327  
7,692 SQ. FT. N10°28'

Subject:  
Page Label: [1] SHEET 7  
Lock: Unlocked  
Author: AutoCAD SHX Text

7,692 SQ. FT.

(XXXXX)  
L=59.00'

Subject:  
Page Label: [1] SHEET 7  
Lock: Unlocked  
Author: AutoCAD SHX Text

(XXXXX)

124.85  
290  
6,525 SQ. FT. N10°28'

Subject:  
Page Label: [1] SHEET 7  
Lock: Unlocked  
Author: AutoCAD SHX Text

6,525 SQ. FT.

200  
I


Subject:  
Page Label: [1] SHEET 7  
Lock: Unlocked  
Author: AutoCAD SHX Text

200

117.43  
288  
6,972 SQ. FT. W117°43'43"

Subject:  
Page Label: [1] SHEET 7  
Lock: Unlocked  
Author: AutoCAD SHX Text

6,972 SQ. FT.

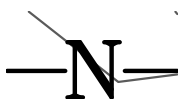


Subject:  
Page Label: [1] SHEET 7  
Lock: Unlocked  
Author: AutoCAD SHX Text

N

135.01  
343  
6,750 SQ. FT. S10°2'


Subject:  
Page Label: [1] SHEET 7  
Lock: Unlocked  
Author: AutoCAD SHX Text

6,750 SQ. FT.

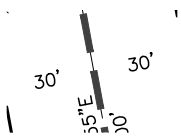

Subject:  
Page Label: [1] SHEET 7  
Lock: Unlocked  
Author: AutoCAD SHX Text

30' 30'

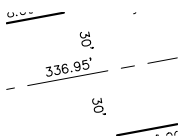

Subject:  
Page Label: [1] SHEET 7  
Lock: Unlocked  
Author: AutoCAD SHX Text

30' 30'


135.01  
342  
6,750 SQ. FT. S10°2'

Subject:  
Page Label: [1] SHEET 7  
Lock: Unlocked  
Author: AutoCAD SHX Text

6,750 SQ. FT.

(XXXXX) 36.59'

Subject: (XXXXX)  
Page Label: [1] SHEET 7  
Lock: Unlocked  
Author: AutoCAD SHX Text

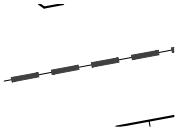

Subject: 30' 30'  
Page Label: [1] SHEET 7  
Lock: Unlocked  
Author: AutoCAD SHX Text


Subject: (XXXXX)  
Page Label: [1] SHEET 7  
Lock: Unlocked  
Author: AutoCAD SHX Text

129.37  
275  
7,309 SQ. FT. S02°19'1

Subject: 7,309 SQ. FT.  
Page Label: [1] SHEET 7  
Lock: Unlocked  
Author: AutoCAD SHX Text

278  
8,852 SQ. FT. S18°37'1

Subject: 8,852 SQ. FT.  
Page Label: [1] SHEET 7  
Lock: Unlocked  
Author: AutoCAD SHX Text

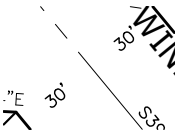


Subject: 30' 30'  
Page Label: [1] SHEET 7  
Lock: Unlocked  
Author: AutoCAD SHX Text

175.49  
289  
6,625 SQ. FT. N13°32'E

Subject: 6,625 SQ. FT.  
Page Label: [1] SHEET 7  
Lock: Unlocked  
Author: AutoCAD SHX Text

55.00'  
(XXXXX)

Subject: (XXXXX)  
Page Label: [1] SHEET 7  
Lock: Unlocked  
Author: AutoCAD SHX Text

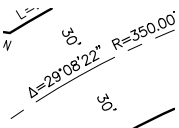

Subject: 30' 30'  
Page Label: [1] SHEET 7  
Lock: Unlocked  
Author: AutoCAD SHX Text

Subject: 8,948 SQ. FT.  
Page Label: [1] SHEET 7  
Lock: Unlocked  
Author: AutoCAD SHX Text

IG ROW 125' V  
SEC. 29  
SEC. 32

**Subject:**  
**Page Label:** [1] SHEET 7  
**Lock:** Unlocked  
**Author:** AutoCAD SHX Text

SEC. 29

122.5'  
337  
7,358 SQ. FT.  
127.59' 17

**Subject:**  
**Page Label:** [1] SHEET 7  
**Lock:** Unlocked  
**Author:** AutoCAD SHX Text

7,358 SQ. FT.

L=50.00'  
(XXXXXX)

**Subject:**  
**Page Label:** [1] SHEET 7  
**Lock:** Unlocked  
**Author:** AutoCAD SHX Text

(XXXXXX)

L=50.40  
4.95'  
(XXXXXX)


**Subject:**  
**Page Label:** [1] SHEET 7  
**Lock:** Unlocked  
**Author:** AutoCAD SHX Text

(XXXXXX)

111.5  
(60 FEET WIDE)  
50.00'  
(XXXXXX)


**Subject:**  
**Page Label:** [1] SHEET 7  
**Lock:** Unlocked  
**Author:** AutoCAD SHX Text

(60 FEET WIDE)

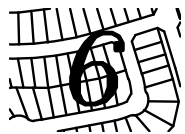

**Subject:**  
**Page Label:** [1] SHEET 7  
**Lock:** Unlocked  
**Author:** AutoCAD SHX Text

6

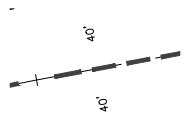

**Subject:**  
**Page Label:** [1] SHEET 7  
**Lock:** Unlocked  
**Author:** AutoCAD SHX Text

40' 40'

124.56  
331  
7,070 SQ. FT.  
103.23' 0"

**Subject:**  
**Page Label:** [1] SHEET 7  
**Lock:** Unlocked  
**Author:** AutoCAD SHX Text

7,070 SQ. FT.

DATE: DECEMB  
SHEET: 7  
D PROJECT NO

**Subject:**  
**Page Label:** [1] SHEET 7  
**Lock:** Unlocked  
**Author:** AutoCAD SHX Text

SHEET: 7

ER 201 /  
OF 9  
CF


**Subject:**  
**Page Label:** [1] SHEET 7  
**Lock:** Unlocked  
**Author:** AutoCAD SHX Text

OF 9

TRACT E

**Subject:**  
**Page Label:** [1] SHEET 7  
**Lock:** Unlocked  
**Author:** AutoCAD SHX Text

0.981 ACRES

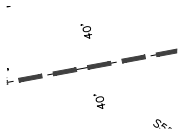

**Subject:**  
**Page Label:** [1] SHEET 7  
**Lock:** Unlocked  
**Author:** AutoCAD SHX Text

40' 40'

319  
6,598 SQ. FT.


S79°31'05"W

**Subject:**  
**Page Label:** [1] SHEET 7  
**Lock:** Unlocked  
**Author:** AutoCAD SHX Text

6,598 SQ. FT.


**Subject:**  
**Page Label:** [1] SHEET 7  
**Lock:** Unlocked  
**Author:** AutoCAD SHX Text

(XXXXXX)

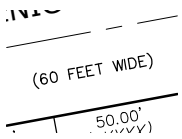


**Subject:**  
**Page Label:** [1] SHEET 7  
**Lock:** Unlocked  
**Author:** AutoCAD SHX Text

(60 FEET WIDE)

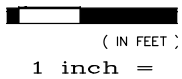

**Subject:**  
**Page Label:** [1] SHEET 7  
**Lock:** Unlocked  
**Author:** AutoCAD SHX Text

1 inch =

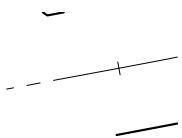

**Subject:**  
**Page Label:** [1] SHEET 7  
**Lock:** Unlocked  
**Author:** AutoCAD SHX Text

30' 30'

130.00  
276  
7,309 SQ. FT.

S01°04'2

**Subject:**  
**Page Label:** [1] SHEET 7  
**Lock:** Unlocked  
**Author:** AutoCAD SHX Text

7,309 SQ. FT.

L=55.00'  
(XXXXXX)

**Subject:**  
**Page Label:** [1] SHEET 7  
**Lock:** Unlocked  
**Author:** AutoCAD SHX Text

(XXXXXX)

320  
6,240 SQ. FT.

S79°31'05"W

**Subject:**  
**Page Label:** [1] SHEET 7  
**Lock:** Unlocked  
**Author:** AutoCAD SHX Text

6,240 SQ. FT.

**TRACT** C  
13.644 ACRES

**Subject:** 13.644 ACRES  
**Page Label:** [1] SHEET 7  
**Lock:** Unlocked  
**Author:** AutoCAD SHX Text

(XXXXXX)  
55.00'

**Subject:** (XXXXXX)  
**Page Label:** [1] SHEET 7  
**Lock:** Unlocked  
**Author:** AutoCAD SHX Text

130.00'  
**266**  
6,569 SQ. FT. 510.2'

**Subject:** 6,569 SQ. FT.  
**Page Label:** [1] SHEET 7  
**Lock:** Unlocked  
**Author:** AutoCAD SHX Text

(XXXXXX)  
52.00'

**Subject:** (XXXXXX)  
**Page Label:** [1] SHEET 7  
**Lock:** Unlocked  
**Author:** AutoCAD SHX Text

**Subject:** (XXXXXX)  
**Page Label:** [1] SHEET 7  
**Lock:** Unlocked  
**Author:** AutoCAD SHX Text

**317**

**Subject:** 6,240 SQ. FT.  
**Page Label:** [1] SHEET 7  
**Lock:** Unlocked  
**Author:** AutoCAD SHX Text

50.00'  
(XXXXXX)

**Subject:** (XXXXXX)  
**Page Label:** [1] SHEET 7  
**Lock:** Unlocked  
**Author:** AutoCAD SHX Text

(XXXXXX)  
L=46.09'

**Subject:** (XXXXXX)  
**Page Label:** [1] SHEET 7  
**Lock:** Unlocked  
**Author:** AutoCAD SHX Text


30'  
30.00'  
30'

**Subject:** 30' 30'  
**Page Label:** [1] SHEET 7  
**Lock:** Unlocked  
**Author:** AutoCAD SHX Text


**9**

**Subject:** 9  
**Page Label:** [1] SHEET 7  
**Lock:** Unlocked  
**Author:** AutoCAD SHX Text



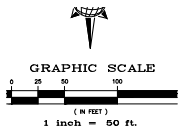

Subject: GRAPHIC SCALE  
Page Label: [1] SHEET 7  
Lock: Unlocked  
Author: AutoCAD SHX Text

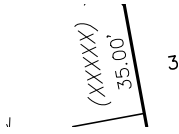

Subject: (XXXXX)  
Page Label: [1] SHEET 7  
Lock: Unlocked  
Author: AutoCAD SHX Text

DATE: DECEMBER 2017  
SHEET: 7 OF 9  
PCD PROJECT NO. SF-\_\_\_

Subject: DATE: DECEMBER 2017  
Page Label: [1] SHEET 7  
Lock: Unlocked  
Author: AutoCAD SHX Text




Subject: (60 FEET WIDE)  
Page Label: [1] SHEET 7  
Lock: Unlocked  
Author: AutoCAD SHX Text



Subject: (60 FEET WIDE)  
Page Label: [1] SHEET 7  
Lock: Unlocked  
Author: AutoCAD SHX Text




Subject: 4  
Page Label: [1] SHEET 7  
Lock: Unlocked  
Author: AutoCAD SHX Text

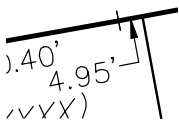

Subject: 4.95'  
Page Label: [1] SHEET 7  
Lock: Unlocked  
Author: AutoCAD SHX Text

25

Subject: 25  
Page Label: [1] SHEET 7  
Lock: Unlocked  
Author: AutoCAD SHX Text

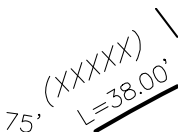

Subject: (XXXXX)  
Page Label: [1] SHEET 7  
Lock: Unlocked  
Author: AutoCAD SHX Text

Subject: (XXXXX)  
Page Label: [1] SHEET 7  
Lock: Unlocked  
Author: AutoCAD SHX Text

125.00  
SHEET 9

**Subject:**  
**Page Label:** [1] SHEET 7 SHEET 99  
**Lock:** Unlocked  
**Author:** AutoCAD SHX Text

DRAWN BY: LCG  
CHECKED BY: TAK

**Subject:**  
**Page Label:** [1] SHEET 7 CHECKED BY: TAK  
**Lock:** Unlocked  
**Author:** AutoCAD SHX Text

125.00  
260

**Subject:**  
**Page Label:** [1] SHEET 7 6,947 SQ. FT.  
**Lock:** Unlocked  
**Author:** AutoCAD SHX Text

130.00  
270  
6,583 SQ. FT.

**Subject:**  
**Page Label:** [1] SHEET 7 6,583 SQ. FT.  
**Lock:** Unlocked  
**Author:** AutoCAD SHX Text

**Subject:**  
**Page Label:** [1] SHEET 7 (XXXXXX)  
**Lock:** Unlocked  
**Author:** AutoCAD SHX Text

40'  
40'

**Subject:**  
**Page Label:** [1] SHEET 7 40' 40'  
**Lock:** Unlocked  
**Author:** AutoCAD SHX Text

30'  
30'  
S10'21"

**Subject:**  
**Page Label:** [1] SHEET 7 30' 30'  
**Lock:** Unlocked  
**Author:** AutoCAD SHX Text

70' 0"  
(80 FEET WIDE)

**Subject:**  
**Page Label:** [1] SHEET 7 (80 FEET WIDE)  
**Lock:** Unlocked  
**Author:** AutoCAD SHX Text

**Subject:**  
**Page Label:** [1] SHEET 7 9,519 SQ. FT.  
**Lock:** Unlocked  
**Author:** AutoCAD SHX Text

284  
7,076 SQ. FT.

**Subject:**  
**Page Label:** [1] SHEET 7 7,076 SQ. FT.  
**Lock:** Unlocked  
**Author:** AutoCAD SHX Text

55'7"46" W.  
120'

105

**Subject:**  
**Page Label:** [1] SHEET 7  
**Lock:** Unlocked  
**Author:** AutoCAD SHX Text

8,065 SQ. FT.

135.00'  
7,425 SQ. FT.  
N10°28'E

325

**Subject:**  
**Page Label:** [1] SHEET 7  
**Lock:** Unlocked  
**Author:** AutoCAD SHX Text

7,425 SQ. FT.

7.00'  
8,354 SQ. FT.  
S00°00'E

277

**Subject:**  
**Page Label:** [1] SHEET 7  
**Lock:** Unlocked  
**Author:** AutoCAD SHX Text

8,354 SQ. FT.

L=60.00'  
(XXXXXX)

**Subject:**  
**Page Label:** [1] SHEET 7  
**Lock:** Unlocked  
**Author:** AutoCAD SHX Text

(XXXXXX)

30'  
30'

**Subject:**  
**Page Label:** [1] SHEET 7  
**Lock:** Unlocked  
**Author:** AutoCAD SHX Text

30' 30'

5

**Subject:**  
**Page Label:** [1] SHEET 7  
**Lock:** Unlocked  
**Author:** AutoCAD SHX Text

5

**Subject:**  
**Page Label:** [1] SHEET 7  
**Lock:** Unlocked  
**Author:** AutoCAD SHX Text

(XXXXXX)

30'

**Subject:**  
**Page Label:** [1] SHEET 7  
**Lock:** Unlocked  
**Author:** AutoCAD SHX Text

30' 30'

30'  
9°38'53"E  
36.25'  
30'

**Subject:**  
**Page Label:** [1] SHEET 7  
**Lock:** Unlocked  
**Author:** AutoCAD SHX Text

30' 30'

6,598 SQ. FT.  
323

**Subject:**  
**Page Label:** [1] SHEET 7  
**Lock:** Unlocked  
**Author:** AutoCAD SHX Text

6,598 SQ. FT.

38.00'

L=50.00'  
(XXXXX)

Subject: (XXXXX)  
Page Label: [1] SHEET 7  
Lock: Unlocked  
Author: AutoCAD SHX Text

(XXXXX)  
L=16.45'  
L=17.83'  
R=127.537'  
R=55.00'  
L=11.86'

Subject: L=17.83'  
Page Label: [1] SHEET 7  
Lock: Unlocked  
Author: AutoCAD SHX Text

Subject: 8,655 SQ. FT.  
Page Label: [1] SHEET 7  
Lock: Unlocked  
Author: AutoCAD SHX Text

55.00'  
(XXXXX)

Subject: (XXXXX)  
Page Label: [1] SHEET 7  
Lock: Unlocked  
Author: AutoCAD SHX Text

127.59'  
265  
6,946 SQ. FT. S10°28'

Subject: 6,946 SQ. FT.  
Page Label: [1] SHEET 7  
Lock: Unlocked  
Author: AutoCAD SHX Text

(XXXXX)  
55.00'

Subject: (XXXXX)  
Page Label: [1] SHEET 7  
Lock: Unlocked  
Author: AutoCAD SHX Text

259

Subject: 6,440 SQ. FT.  
Page Label: [1] SHEET 7  
Lock: Unlocked  
Author: AutoCAD SHX Text

Subject: (XXXXX)  
Page Label: [1] SHEET 7  
Lock: Unlocked  
Author: AutoCAD SHX Text

50

Subject: 50  
Page Label: [1] SHEET 7  
Lock: Unlocked  
Author: AutoCAD SHX Text

50 FEET  
SHEET

Subject: (XXXXX)  
Page Label: [1] SHEET 7  
Lock: Unlocked  
Author: AutoCAD SHX Text

135.00'  
341  
7,425 SQ. FT. 510'28"

**Subject:**  
**Page Label:** [1] SHEET 7  
**Lock:** Unlocked  
**Author:** AutoCAD SHX Text

7,425 SQ. FT.

135.00'  
340  
6,750 SQ. FT. 510'28"

**Subject:**  
**Page Label:** [1] SHEET 7  
**Lock:** Unlocked  
**Author:** AutoCAD SHX Text

6,750 SQ. FT.

LAMBERT RC  
(80 FEET WIDE)  
510'28"

**Subject:**  
**Page Label:** [1] SHEET 7  
**Lock:** Unlocked  
**Author:** AutoCAD SHX Text

(80 FEET WIDE)

L=50.00'  
(XXXXXX)

**Subject:**  
**Page Label:** [1] SHEET 7  
**Lock:** Unlocked  
**Author:** AutoCAD SHX Text

(XXXXXX)

(XXXXXX)  
L=10.00'  
38.50'

**Subject:**  
**Page Label:** [1] SHEET 7  
**Lock:** Unlocked  
**Author:** AutoCAD SHX Text

(XXXXXX)

132.60'  
338  
7,696 SQ. FT. 510'28"

**Subject:**  
**Page Label:** [1] SHEET 7  
**Lock:** Unlocked  
**Author:** AutoCAD SHX Text

7,696 SQ. FT.

126.98'  
269  
6,452 SQ. FT. 509'20"

**Subject:**  
**Page Label:** [1] SHEET 7  
**Lock:** Unlocked  
**Author:** AutoCAD SHX Text

6,452 SQ. FT.

50.00'  
(XXXXXX)

**Subject:**  
**Page Label:** [1] SHEET 7  
**Lock:** Unlocked  
**Author:** AutoCAD SHX Text

(XXXXXX)

NR

**Subject:**  
**Page Label:** [1] SHEET 7  
**Lock:** Unlocked  
**Author:** AutoCAD SHX Text

NR

L=50.00'  
(XXXXXX)

**Subject:**  
**Page Label:** [1] SHEET 7  
**Lock:** Unlocked  
**Author:** AutoCAD SHX Text

(XXXXXX)

55.00'  
(XXXXXX)

**Subject:**  
**Page Label:** [1] SHEET 7 (XXXXXX)  
**Lock:** Unlocked  
**Author:** AutoCAD SHX Text

0'03" R=2500.00' L=4  
(60 FEET WIDE)

L=55.00'

**Subject:**  
**Page Label:** [1] SHEET 7 (60 FEET WIDE)  
**Lock:** Unlocked  
**Author:** AutoCAD SHX Text

281  
7,076 SQ. FT.  
N89°00'18"W(NR)

**Subject:**  
**Page Label:** [1] SHEET 7 7,076 SQ. FT.  
**Lock:** Unlocked  
**Author:** AutoCAD SHX Text

285  
7,230 SQ. FT.  
S54°08'W  
76'

**Subject:**  
**Page Label:** [1] SHEET 7 7,230 SQ. FT.  
**Lock:** Unlocked  
**Author:** AutoCAD SHX Text

(XXXXXX)  
L=59.00'

**Subject:**  
**Page Label:** [1] SHEET 7 (XXXXXX)  
**Lock:** Unlocked  
**Author:** AutoCAD SHX Text

0'

**Subject:**  
**Page Label:** [1] SHEET 7 (XXXXXX)  
**Lock:** Unlocked  
**Author:** AutoCAD SHX Text

(XXXXXX)  
L=46.00'

**Subject:**  
**Page Label:** [1] SHEET 7 (XXXXXX)  
**Lock:** Unlocked  
**Author:** AutoCAD SHX Text

130.00'  
272  
7,309 SQ. FT.  
S05°49'E

**Subject:**  
**Page Label:** [1] SHEET 7 7,309 SQ. FT.  
**Lock:** Unlocked  
**Author:** AutoCAD SHX Text

**Subject:**  
**Page Label:** [1] SHEET 7 (XXXXXX)  
**Lock:** Unlocked  
**Author:** AutoCAD SHX Text

321  
6,240 SQ. FT.  
S79°31'05"W

**Subject:**  
**Page Label:** [1] SHEET 7 6,240 SQ. FT.  
**Lock:** Unlocked  
**Author:** AutoCAD SHX Text

LOW BRIDGE  
(60 FEET WIDE)  
SHEET

**Subject:**  
**Page Label:** [1] SHEET 7 (60 FEET WIDE)  
**Lock:** Unlocked  
**Author:** AutoCAD SHX Text

130.00  
274  
6,649 SQ. FT.  
S03271

**Subject:**  
**Page Label:** [1] SHEET 7 6,649 SQ. FT.  
**Lock:** Unlocked  
**Author:** AutoCAD SHX Text

**Subject:**  
**Page Label:** [1] SHEET 7 (XXXXX)  
**Lock:** Unlocked  
**Author:** AutoCAD SHX Text

LOW BRIDGE  
(60 FEET WIDE)  
SHEET

**Subject:**  
**Page Label:** [1] SHEET 7 (60 FEET WIDE)  
**Lock:** Unlocked  
**Author:** AutoCAD SHX Text

(82.62')  
(12345)

**Subject:**  
**Page Label:** [1] SHEET 7 (82.62')  
**Lock:** Unlocked  
**Author:** AutoCAD SHX Text

**Subject:**  
**Page Label:** [1] SHEET 7 (XXXXX)  
**Lock:** Unlocked  
**Author:** AutoCAD SHX Text

125.00  
291  
6,834 SQ. FT.  
N10281E

**Subject:**  
**Page Label:** [1] SHEET 7 6,834 SQ. FT.  
**Lock:** Unlocked  
**Author:** AutoCAD SHX Text

(XXXXX)  
L=34.00  
32'  
N0217

**Subject:**  
**Page Label:** [1] SHEET 7 (XXXXX)  
**Lock:** Unlocked  
**Author:** AutoCAD SHX Text

336  
11,207 SQ. FT.

**Subject:**  
**Page Label:** [1] SHEET 7 11,207 SQ. FT.  
**Lock:** Unlocked  
**Author:** AutoCAD SHX Text

(XXXXX)  
55.00'

**Subject:**  
**Page Label:** [1] SHEET 7 (XXXXX)  
**Lock:** Unlocked  
**Author:** AutoCAD SHX Text

124.00  
298  
6,995 SQ. FT.

**Subject:**  
**Page Label:** [1] SHEET 7  
**Lock:** Unlocked  
**Author:** AutoCAD SHX Text

6,995 SQ. FT.

**Subject:**  
**Page Label:** [1] SHEET 7  
**Lock:** Unlocked  
**Author:** AutoCAD SHX Text

(60 FEET WIDE)

RACT C  
0.362 ACRES  
2.9'

**Subject:**  
**Page Label:** [1] SHEET 7  
**Lock:** Unlocked  
**Author:** AutoCAD SHX Text

0.362 ACRES

55.48  
L=8.00'  
(XXXXXX)

**Subject:**  
**Page Label:** [1] SHEET 7  
**Lock:** Unlocked  
**Author:** AutoCAD SHX Text

(XXXXXX)

125.00  
297  
6,848 SQ. FT. N10°28'

**Subject:**  
**Page Label:** [1] SHEET 7  
**Lock:** Unlocked  
**Author:** AutoCAD SHX Text

6,848 SQ. FT.

123.50'  
292  
6,751 SQ. FT. N10°28'E

**Subject:**  
**Page Label:** [1] SHEET 7  
**Lock:** Unlocked  
**Author:** AutoCAD SHX Text

6,751 SQ. FT.

339°37'17E  
2'15.00'  
(60 FEET WIDE)  
101.33'

**Subject:**  
**Page Label:** [1] SHEET 7  
**Lock:** Unlocked  
**Author:** AutoCAD SHX Text

(60 FEET WIDE)

(XXXXXX)  
55.00'

**Subject:**  
**Page Label:** [1] SHEET 7  
**Lock:** Unlocked  
**Author:** AutoCAD SHX Text

(XXXXXX)

(XXXXXX)  
52.00'  
CAM RR

**Subject:**  
**Page Label:** [1] SHEET 7  
**Lock:** Unlocked  
**Author:** AutoCAD SHX Text

(XXXXXX)

SHEET 3  
SHEET 3  
SHEET 3


**Subject:**  
**Page Label:** [1] SHEET 7  
**Lock:** Unlocked  
**Author:** AutoCAD SHX Text

SHEET 33




---

**Subject:**  
**Page Label:** [1] SHEET 7 7,046 SQ. FT.  
**Lock:** Unlocked  
**Author:** AutoCAD SHX Text

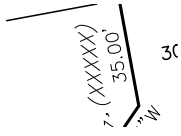


---

**Subject:**  
**Page Label:** [1] SHEET 7 (XXXXX)  
**Lock:** Unlocked  
**Author:** AutoCAD SHX Text

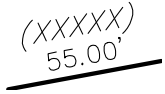


---

**Subject:**  
**Page Label:** [1] SHEET 7 (XXXXX)  
**Lock:** Unlocked  
**Author:** AutoCAD SHX Text

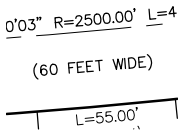

---

**Subject:**  
**Page Label:** [1] SHEET 7 (60 FEET WIDE)  
**Lock:** Unlocked  
**Author:** AutoCAD SHX Text

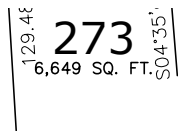


---

**Subject:**  
**Page Label:** [1] SHEET 7 6,649 SQ. FT.  
**Lock:** Unlocked  
**Author:** AutoCAD SHX Text



---

**Subject:**  
**Page Label:** [1] SHEET 7 7,644 SQ. FT.  
**Lock:** Unlocked  
**Author:** AutoCAD SHX Text

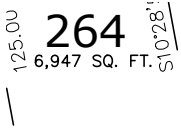


---

**Subject:**  
**Page Label:** [1] SHEET 7 6,947 SQ. FT.  
**Lock:** Unlocked  
**Author:** AutoCAD SHX Text

315

---

**Subject:**  
**Page Label:** [1] SHEET 7 6,240 SQ. FT.  
**Lock:** Unlocked  
**Author:** AutoCAD SHX Text

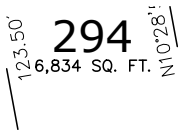


---

**Subject:**  
**Page Label:** [1] SHEET 7 6,834 SQ. FT.  
**Lock:** Unlocked  
**Author:** AutoCAD SHX Text

---

**Subject:**  
**Page Label:** [1] SHEET 7 (XXXXX)  
**Lock:** Unlocked  
**Author:** AutoCAD SHX Text

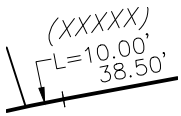


**Subject:**  
**Page Label:** [1] SHEET 7 L=10.00'  
**Lock:** Unlocked  
**Author:** AutoCAD SHX Text

0

**Subject:**  
**Page Label:** [1] SHEET 7 0  
**Lock:** Unlocked  
**Author:** AutoCAD SHX Text




**Subject:**  
**Page Label:** [1] SHEET 7 (XXXXXX)  
**Lock:** Unlocked  
**Author:** AutoCAD SHX Text

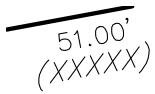


**Subject:**  
**Page Label:** [1] SHEET 7 (XXXXXX)  
**Lock:** Unlocked  
**Author:** AutoCAD SHX Text



**Subject:**  
**Page Label:** [1] SHEET 7 (XXXXXX)  
**Lock:** Unlocked  
**Author:** AutoCAD SHX Text

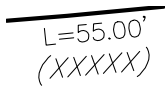

**Subject:**  
**Page Label:** [1] SHEET 7 (XXXXXX)  
**Lock:** Unlocked  
**Author:** AutoCAD SHX Text

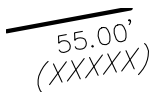


**Subject:**  
**Page Label:** [1] SHEET 7 (XXXXXX)  
**Lock:** Unlocked  
**Author:** AutoCAD SHX Text



**Subject:**  
**Page Label:** [1] SHEET 7 7,425 SQ. FT.  
**Lock:** Unlocked  
**Author:** AutoCAD SHX Text

106

**Subject:**  
**Page Label:** [1] SHEET 7 8,830 SQ. FT.  
**Lock:** Unlocked  
**Author:** AutoCAD SHX Text

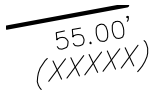


**Subject:**  
**Page Label:** [1] SHEET 7 (XXXXXX)  
**Lock:** Unlocked  
**Author:** AutoCAD SHX Text




5

**Subject:** SHEET 88  
**Page Label:** [1] SHEET 7  
**Lock:** Unlocked  
**Author:** AutoCAD SHX Text


**Subject:** 9,125 SQ. FT.  
**Page Label:** [1] SHEET 7  
**Lock:** Unlocked  
**Author:** AutoCAD SHX Text

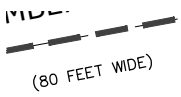


**Subject:** (80 FEET WIDE)  
**Page Label:** [1] SHEET 7  
**Lock:** Unlocked  
**Author:** AutoCAD SHX Text

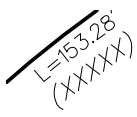

**Subject:** (XXXXX)  
**Page Label:** [1] SHEET 7  
**Lock:** Unlocked  
**Author:** AutoCAD SHX Text

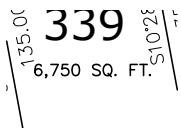


**Subject:** 6,750 SQ. FT.  
**Page Label:** [1] SHEET 7  
**Lock:** Unlocked  
**Author:** AutoCAD SHX Text

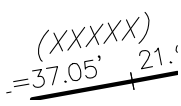

**Subject:** (XXXXX)  
**Page Label:** [1] SHEET 7  
**Lock:** Unlocked  
**Author:** AutoCAD SHX Text




**Subject:** (XXXXX)  
**Page Label:** [1] SHEET 7  
**Lock:** Unlocked  
**Author:** AutoCAD SHX Text

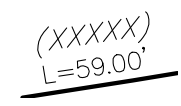

**Subject:** (XXXXX)  
**Page Label:** [1] SHEET 7  
**Lock:** Unlocked  
**Author:** AutoCAD SHX Text



**Subject:** (XXXXX)  
**Page Label:** [1] SHEET 7  
**Lock:** Unlocked  
**Author:** AutoCAD SHX Text

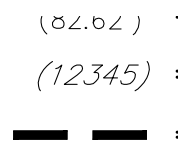

**Subject:** (12345)  
**Page Label:** [1] SHEET 7  
**Lock:** Unlocked  
**Author:** AutoCAD SHX Text

130.01  
262  
6,440 SQ. FT. S10°2'

-----  
**Subject:**  
**Page Label:** [1] SHEET 7 6,440 SQ. FT.  
**Lock:** Unlocked  
**Author:** AutoCAD SHX Text



-----  
**Subject:**  
**Page Label:** [1] SHEET 7 2  
**Lock:** Unlocked  
**Author:** AutoCAD SHX Text

-----  
**Subject:**  
**Page Label:** [1] SHEET 7 (XXXXX)  
**Lock:** Unlocked  
**Author:** AutoCAD SHX Text

-----  
**Subject:**  
**Page Label:** [1] SHEET 7 7,348 SQ. FT.  
**Lock:** Unlocked  
**Author:** AutoCAD SHX Text

100  
L=39.87  
(XXXXX)

-----  
**Subject:**  
**Page Label:** [1] SHEET 7 (XXXXX)  
**Lock:** Unlocked  
**Author:** AutoCAD SHX Text

R)  
L=16.45'  
L=17.83'  
4=12.27'

-----  
**Subject:**  
**Page Label:** [1] SHEET 7 (XXXXX)  
**Lock:** Unlocked  
**Author:** AutoCAD SHX Text

104


-----  
**Subject:**  
**Page Label:** [1] SHEET 7 6,875 SQ. FT.  
**Lock:** Unlocked  
**Author:** AutoCAD SHX Text

124.6'  
221  
7,083 SQ. FT. N12°4'

-----  
**Subject:**  
**Page Label:** [1] SHEET 8 7,083 SQ. FT.  
**Lock:** Unlocked  
**Author:** AutoCAD SHX Text

233  
6,875 SQ. FT. N51°35'04" W  
75.0'

-----  
**Subject:**  
**Page Label:** [1] SHEET 8 6,875 SQ. FT.  
**Lock:** Unlocked  
**Author:** AutoCAD SHX Text

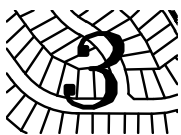

-----  
**Subject:**  
**Page Label:** [1] SHEET 8 3  
**Lock:** Unlocked  
**Author:** AutoCAD SHX Text

T 9

**Subject:**  
**Page Label:** [1] SHEET 8 (XXXXXX)  
**Lock:** Unlocked  
**Author:** AutoCAD SHX Text

5

**Subject:**  
**Page Label:** [1] SHEET 8 5  
**Lock:** Unlocked  
**Author:** AutoCAD SHX Text

XXXXXX  
16.59'  
36.03'

**Subject:**  
**Page Label:** [1] SHEET 8 16.59'  
**Lock:** Unlocked  
**Author:** AutoCAD SHX Text

30' S10°21'  
30'

**Subject:**  
**Page Label:** [1] SHEET 8 30' 30'  
**Lock:** Unlocked  
**Author:** AutoCAD SHX Text

28°55'W 136  
299  
7,410 SQ. FT.  
S15°06'3"

**Subject:**  
**Page Label:** [1] SHEET 8 7,410 SQ. FT.  
**Lock:** Unlocked  
**Author:** AutoCAD SHX Text

X

**Subject:**  
**Page Label:** [1] SHEET 8 (60 FEET WIDE)  
**Lock:** Unlocked  
**Author:** AutoCAD SHX Text

25

**Subject:**  
**Page Label:** [1] SHEET 8 25  
**Lock:** Unlocked  
**Author:** AutoCAD SHX Text

2R 201 /  
OF 9  
CF

**Subject:**  
**Page Label:** [1] SHEET 8 OF 9  
**Lock:** Unlocked  
**Author:** AutoCAD SHX Text

L=49.00'  
(XXXXXX)

**Subject:**  
**Page Label:** [1] SHEET 8 (XXXXXX)  
**Lock:** Unlocked  
**Author:** AutoCAD SHX Text

(XXXXXX)  
L=58.86'

**Subject:**  
**Page Label:** [1] SHEET 8 (XXXXXX)  
**Lock:** Unlocked  
**Author:** AutoCAD SHX Text

317  
6,240 SQ. FT.

N79°31'05"E

Subject:  
Page Label: [1] SHEET 8  
Lock: Unlocked  
Author: AutoCAD SHX Text

6,240 SQ. FT.

DRAWN BY: LCG  
CHECKED BY: TAK

Subject:  
Page Label: [1] SHEET 8  
Lock: Unlocked  
Author: AutoCAD SHX Text

DRAWN BY: LCG

(XXXXX)  
64.50'

Subject:  
Page Label: [1] SHEET 8  
Lock: Unlocked  
Author: AutoCAD SHX Text

(XXXXX)

303  
7,522 SQ. FT.  
32'E(NR)  
0.89'

Subject:  
Page Label: [1] SHEET 8  
Lock: Unlocked  
Author: AutoCAD SHX Text

7,522 SQ. FT.

Subject:  
Page Label: [1] SHEET 8  
Lock: Unlocked  
Author: AutoCAD SHX Text

(XXXXX)

232  
6,864 SQ. FT.  
151°35'04"  
15.00'

Subject:  
Page Label: [1] SHEET 8  
Lock: Unlocked  
Author: AutoCAD SHX Text

6,864 SQ. FT.

222  
7,046 SQ. FT.  
125.00'  
114°47'

Subject:  
Page Label: [1] SHEET 8  
Lock: Unlocked  
Author: AutoCAD SHX Text

7,046 SQ. FT.

(XXXXX)  
50' L=2

Subject:  
Page Label: [1] SHEET 8  
Lock: Unlocked  
Author: AutoCAD SHX Text

(XXXXX)

13.165'  
R=222  
L=20.00'  
7.12'  
(HHHH)

Subject:  
Page Label: [1] SHEET 8  
Lock: Unlocked  
Author: AutoCAD SHX Text

L=20.00'

Subject:  
Page Label: [1] SHEET 8  
Lock: Unlocked  
Author: AutoCAD SHX Text

30' 30'

100

I


**Subject:**  
**Page Label:** [1] SHEET 8  
**Lock:** Unlocked  
**Author:** AutoCAD SHX Text

100




**Subject:**  
**Page Label:** [1] SHEET 8  
**Lock:** Unlocked  
**Author:** AutoCAD SHX Text

(XXXXX)

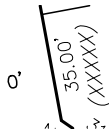

**Subject:**  
**Page Label:** [1] SHEET 8  
**Lock:** Unlocked  
**Author:** AutoCAD SHX Text

(XXXXX)

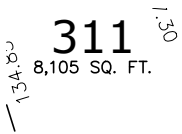


**Subject:**  
**Page Label:** [1] SHEET 8  
**Lock:** Unlocked  
**Author:** AutoCAD SHX Text

8,105 SQ. FT.




**Subject:**  
**Page Label:** [1] SHEET 8  
**Lock:** Unlocked  
**Author:** AutoCAD SHX Text

(XXXXX)

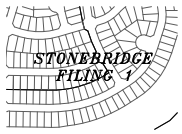

**Subject:**  
**Page Label:** [1] SHEET 8  
**Lock:** Unlocked  
**Author:** AutoCAD SHX Text

STONEBRIDGE FILING 1

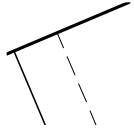

**Subject:**  
**Page Label:** [1] SHEET 8  
**Lock:** Unlocked  
**Author:** AutoCAD SHX Text

(15.00')

314

6,598 SQ. FT.

98.00'

**Subject:**  
**Page Label:** [1] SHEET 8  
**Lock:** Unlocked  
**Author:** AutoCAD SHX Text

6,598 SQ. FT.



**Subject:**  
**Page Label:** [1] SHEET 8  
**Lock:** Unlocked  
**Author:** AutoCAD SHX Text

9

236

**Subject:**  
**Page Label:** [1] SHEET 8  
**Lock:** Unlocked  
**Author:** AutoCAD SHX Text

6,190 SQ. FT.

(XXXXXX)  
L=58.82'


Subject: (XXXXXX)  
Page Label: [1] SHEET 8  
Lock: Unlocked  
Author: AutoCAD SHX Text

50  
|

Subject: 50  
Page Label: [1] SHEET 8  
Lock: Unlocked  
Author: AutoCAD SHX Text

318  
6,631 SQ. FT.  
N79°31'05"E


Subject: 6,631 SQ. FT.  
Page Label: [1] SHEET 8  
Lock: Unlocked  
Author: AutoCAD SHX Text

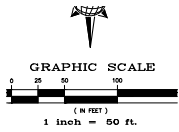

Subject: GRAPHIC SCALE  
Page Label: [1] SHEET 8  
Lock: Unlocked  
Author: AutoCAD SHX Text

254

Subject: 7,144 SQ. FT.  
Page Label: [1] SHEET 8  
Lock: Unlocked  
Author: AutoCAD SHX Text

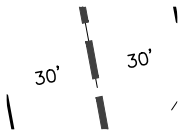

Subject: 30' 30'  
Page Label: [1] SHEET 8  
Lock: Unlocked  
Author: AutoCAD SHX Text



Subject: 2  
Page Label: [1] SHEET 8  
Lock: Unlocked  
Author: AutoCAD SHX Text

53.00'  
(XXXXXX)

Subject: (XXXXXX)  
Page Label: [1] SHEET 8  
Lock: Unlocked  
Author: AutoCAD SHX Text

(XXXXXX)  
L=26.65'  
Δ=1

Subject: (XXXXXX)  
Page Label: [1] SHEET 8  
Lock: Unlocked  
Author: AutoCAD SHX Text

Subject: DATE: DECEMBER 2017  
Page Label: [1] SHEET 8  
Lock: Unlocked  
Author: AutoCAD SHX Text

DATE: DECEMBER 2017
SHEET: 8 OF 9


PCD PROJECT NO. SF----



251

**Subject:**  
**Page Label:** [1] SHEET 8  
**Lock:** Unlocked  
**Author:** AutoCAD SHX Text


6,903 SQ. FT.

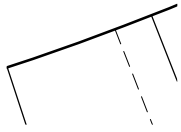

**Subject:**  
**Page Label:** [1] SHEET 8  
**Lock:** Unlocked  
**Author:** AutoCAD SHX Text

(L=15.00')

228

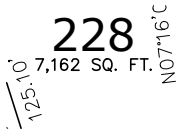

**Subject:**  
**Page Label:** [1] SHEET 8  
**Lock:** Unlocked  
**Author:** AutoCAD SHX Text


7,162 SQ. FT.

221



**Subject:**  
**Page Label:** [1] SHEET 8  
**Lock:** Unlocked  
**Author:** AutoCAD SHX Text

(XXXXXX)

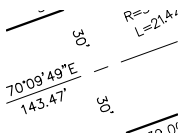


**Subject:**  
**Page Label:** [1] SHEET 8  
**Lock:** Unlocked  
**Author:** AutoCAD SHX Text

30' 30'

323

**Subject:**  
**Page Label:** [1] SHEET 8  
**Lock:** Unlocked  
**Author:** AutoCAD SHX Text

6,598 SQ. FT.

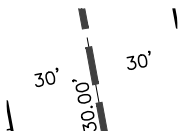

**Subject:**  
**Page Label:** [1] SHEET 8  
**Lock:** Unlocked  
**Author:** AutoCAD SHX Text

30' 30'

(XXXXXX)  
64.50'

**Subject:**  
**Page Label:** [1] SHEET 8  
**Lock:** Unlocked  
**Author:** AutoCAD SHX Text

(XXXXXX)




**Subject:**  
**Page Label:** [1] SHEET 8  
**Lock:** Unlocked  
**Author:** AutoCAD SHX Text

(60 FEET WIDE)


**Subject:**  
**Page Label:** [1] SHEET 8  
**Lock:** Unlocked  
**Author:** AutoCAD SHX Text

L=28.93'

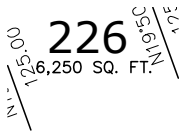


**Subject:** 6,250 SQ. FT.  
**Page Label:** [1] SHEET 8  
**Lock:** Unlocked  
**Author:** AutoCAD SHX Text

**Subject:** 8,655 SQ. FT.  
**Page Label:** [1] SHEET 8  
**Lock:** Unlocked  
**Author:** AutoCAD SHX Text

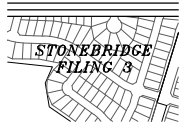


**Subject:** STONEBRIDGE FILING 3  
**Page Label:** [1] SHEET 8  
**Lock:** Unlocked  
**Author:** AutoCAD SHX Text

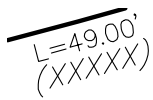


**Subject:** (XXXXX)  
**Page Label:** [1] SHEET 8  
**Lock:** Unlocked  
**Author:** AutoCAD SHX Text




**Subject:** (XXXXX)  
**Page Label:** [1] SHEET 8  
**Lock:** Unlocked  
**Author:** AutoCAD SHX Text

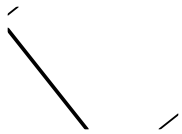

**Subject:** (XXXXX)  
**Page Label:** [1] SHEET 8  
**Lock:** Unlocked  
**Author:** AutoCAD SHX Text

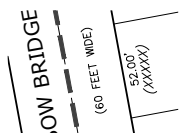


**Subject:** (60 FEET WIDE)  
**Page Label:** [1] SHEET 8  
**Lock:** Unlocked  
**Author:** AutoCAD SHX Text

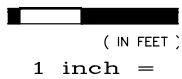

**Subject:** 1 inch =  
**Page Label:** [1] SHEET 8  
**Lock:** Unlocked  
**Author:** AutoCAD SHX Text

**Subject:** L=8.00'  
**Page Label:** [1] SHEET 8  
**Lock:** Unlocked  
**Author:** AutoCAD SHX Text

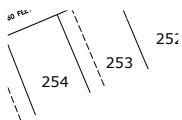

**Subject:** 15' UTILITY EASEMENT  
**Page Label:** [1] SHEET 8  
**Lock:** Unlocked  
**Author:** AutoCAD SHX Text

234  
6,250 SQ. FT.  
N51°35'04"W  
175.00'

Subject:  
Page Label: [1] SHEET 8 6,250 SQ. FT.  
Lock: Unlocked  
Author: AutoCAD SHX Text

SHEET 6

Subject:  
Page Label: [1] SHEET 8 SHEET 66  
Lock: Unlocked  
Author: AutoCAD SHX Text


39.00'  
(XXXXXX)

Subject:  
Page Label: [1] SHEET 8 (XXXXX)  
Lock: Unlocked  
Author: AutoCAD SHX Text

50 FEET  
52.00'  
(XXXXXX)

Subject:  
Page Label: [1] SHEET 8 (XXXXX)  
Lock: Unlocked  
Author: AutoCAD SHX Text

Subject:  
Page Label: [1] SHEET 8 (XXXXX)  
Lock: Unlocked  
Author: AutoCAD SHX Text

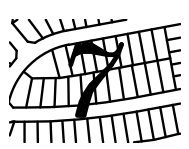

Subject:  
Page Label: [1] SHEET 8 7  
Lock: Unlocked  
Author: AutoCAD SHX Text

TRACT D  
13.644 ACRES

Subject:  
Page Label: [1] SHEET 8 13.644 ACRES  
Lock: Unlocked  
Author: AutoCAD SHX Text

252

Subject:  
Page Label: [1] SHEET 8 6,790 SQ. FT.  
Lock: Unlocked  
Author: AutoCAD SHX Text

306  
7,596 SQ. FT.

Subject:  
Page Label: [1] SHEET 8 7,596 SQ. FT.  
Lock: Unlocked  
Author: AutoCAD SHX Text

307  
7,990 SQ. FT.

Subject:  
Page Label: [1] SHEET 8 7,990 SQ. FT.  
Lock: Unlocked  
Author: AutoCAD SHX Text

(XXXXX)  
50.00'

Subject: (XXXXX)  
Page Label: [1] SHEET 8  
Lock: Unlocked  
Author: AutoCAD SHX Text


Subject: (XXXXX)  
Page Label: [1] SHEET 8  
Lock: Unlocked  
Author: AutoCAD SHX Text



Subject: SHEET 77  
Page Label: [1] SHEET 8  
Lock: Unlocked  
Author: AutoCAD SHX Text


(XXXXX)  
L=63.92'

Subject: (XXXXX)  
Page Label: [1] SHEET 8  
Lock: Unlocked  
Author: AutoCAD SHX Text

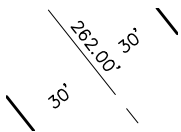

Subject: 30' 30'  
Page Label: [1] SHEET 8  
Lock: Unlocked  
Author: AutoCAD SHX Text

Subject: (XXXXX)  
Page Label: [1] SHEET 8  
Lock: Unlocked  
Author: AutoCAD SHX Text

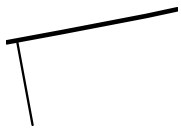


Subject: 10.00'  
Page Label: [1] SHEET 8  
Lock: Unlocked  
Author: AutoCAD SHX Text

- LEGEND
- = FOUND MONUMENT AS SHOWN
  - = FOUND REBAR WITH CAP
  - ⊙ = SET #4 REBAR W/CAP
  - ⊙ = SET #4 REBAR
  - ⊙ = NON-RADIAL BEARING
  - (EASE) = EASEMENT OR NO-BUILD DIM.
  - (EASE) = ADDRESS
  - = MATCHLINE

Subject: = FOUND MONUMENT AS SHOWN = FOUND #4  
Page Label: [1] SHEET 8 REBAR WITH CAP PLS 34583 = SET #4  
Lock: Unlocked REBAR W/CAP PLS 34583 = NON-RADIAL  
Author: AutoCAD SHX Text BEARING = EASEMENT OR NO-BUILD DIM. = ADDRESS ADDRESS = MATCHLINE

Subject: (XXXXX)  
Page Label: [1] SHEET 8  
Lock: Unlocked  
Author: AutoCAD SHX Text

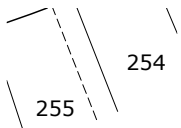

Subject: 15' UTILITY EASEMENT  
Page Label: [1] SHEET 8  
Lock: Unlocked  
Author: AutoCAD SHX Text

50

Subject:  
Page Label: [1] SHEET 8  
Lock: Unlocked  
Author: AutoCAD SHX Text

50

304

7,331 SQ. FT.  
24'08" E

Subject:  
Page Label: [1] SHEET 8  
Lock: Unlocked  
Author: AutoCAD SHX Text

7,331 SQ. FT.

301

7,546 SQ. FT.  
10'56" E

Subject:  
Page Label: [1] SHEET 8  
Lock: Unlocked  
Author: AutoCAD SHX Text

7,546 SQ. FT.

(XXXXXX)

L=8.99'  
27' 00"

Subject:  
Page Label: [1] SHEET 8  
Lock: Unlocked  
Author: AutoCAD SHX Text

(XXXXXX)

(XXXXXX)

20.47' 34'

Subject:  
Page Label: [1] SHEET 8  
Lock: Unlocked  
Author: AutoCAD SHX Text

(XXXXXX)

0

Subject:  
Page Label: [1] SHEET 8  
Lock: Unlocked  
Author: AutoCAD SHX Text

0

SHEET

Subject:  
Page Label: [1] SHEET 8  
Lock: Unlocked  
Author: AutoCAD SHX Text

(XXXXXX)

200

Subject:  
Page Label: [1] SHEET 8  
Lock: Unlocked  
Author: AutoCAD SHX Text

200

45.4  
L=8.88  
(XXXXXX)

Subject:  
Page Label: [1] SHEET 8  
Lock: Unlocked  
Author: AutoCAD SHX Text

(XXXXXX)

253

Subject:  
Page Label: [1] SHEET 8  
Lock: Unlocked  
Author: AutoCAD SHX Text

7,540 SQ. FT.

-----  
**Subject:**  
**Page Label:** [1] SHEET 8 6,951 SQ. FT.  
**Lock:** Unlocked  
**Author:** AutoCAD SHX Text

(XXXXXX)  
16.59'  
2' 3"

-----  
**Subject:**  
**Page Label:** [1] SHEET 8 (XXXXX)  
**Lock:** Unlocked  
**Author:** AutoCAD SHX Text

52.00'  
(XXXXX)

-----  
**Subject:**  
**Page Label:** [1] SHEET 8 (XXXXX)  
**Lock:** Unlocked  
**Author:** AutoCAD SHX Text

227  
6,562 SQ. FT.  
125.00'  
11.11'  
1.32'  
4.1'

-----  
**Subject:**  
**Page Label:** [1] SHEET 8 6,562 SQ. FT.  
**Lock:** Unlocked  
**Author:** AutoCAD SHX Text

30'  
30'  
538'24.5'

-----  
**Subject:**  
**Page Label:** [1] SHEET 8 30' 30'  
**Lock:** Unlocked  
**Author:** AutoCAD SHX Text

-----  
**Subject:**  
**Page Label:** [1] SHEET 8 (XXXXX)  
**Lock:** Unlocked  
**Author:** AutoCAD SHX Text

30' 30'

-----  
**Subject:**  
**Page Label:** [1] SHEET 8 30' 30'  
**Lock:** Unlocked  
**Author:** AutoCAD SHX Text

(XXXXXX)  
L=40.00'  
31'

-----  
**Subject:**  
**Page Label:** [1] SHEET 8 (XXXXX)  
**Lock:** Unlocked  
**Author:** AutoCAD SHX Text


DRAWN BY: LCG  
CHECKED BY: TAK

-----  
**Subject:**  
**Page Label:** [1] SHEET 8 CHECKED BY: TAK  
**Lock:** Unlocked  
**Author:** AutoCAD SHX Text


SKY  
(60 FEET WIDE)  
31'


-----  
**Subject:**  
**Page Label:** [1] SHEET 8 (60 FEET WIDE)  
**Lock:** Unlocked  
**Author:** AutoCAD SHX Text

Subject: (XXXXXX)  
Page Label: [1] SHEET 8  
Lock: Unlocked  
Author: AutoCAD SHX Text

  
( IN FEET )  
.ch = 50  
Subject: ( IN FEET )  
Page Label: [1] SHEET 8  
Lock: Unlocked  
Author: AutoCAD SHX Text


Subject: (XXXXXX)  
Page Label: [1] SHEET 8  
Lock: Unlocked  
Author: AutoCAD SHX Text

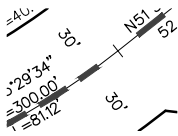
  
Subject: 30' 30'  
Page Label: [1] SHEET 8  
Lock: Unlocked  
Author: AutoCAD SHX Text

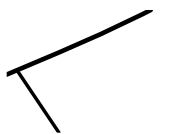  
Subject: 10.00'  
Page Label: [1] SHEET 8  
Lock: Unlocked  
Author: AutoCAD SHX Text

250  
Subject: 7,375 SQ. FT.  
Page Label: [1] SHEET 8  
Lock: Unlocked  
Author: AutoCAD SHX Text

50  
Subject: 50  
Page Label: [1] SHEET 8  
Lock: Unlocked  
Author: AutoCAD SHX Text

  
Subject: (XXXXXX)  
Page Label: [1] SHEET 8  
Lock: Unlocked  
Author: AutoCAD SHX Text

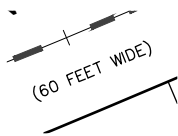
  
Subject: (60 FEET WIDE)  
Page Label: [1] SHEET 8  
Lock: Unlocked  
Author: AutoCAD SHX Text

Subject: (XXXXXX)  
Page Label: [1] SHEET 8  
Lock: Unlocked  
Author: AutoCAD SHX Text

(H/H/H/H)  
55.00'

Subject: (XXXXX)  
Page Label: [1] SHEET 8  
Lock: Unlocked  
Author: AutoCAD SHX Text

Subject: 30' 30'  
Page Label: [1] SHEET 8  
Lock: Unlocked  
Author: AutoCAD SHX Text

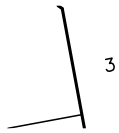

Subject: (XXXXX)  
Page Label: [1] SHEET 8  
Lock: Unlocked  
Author: AutoCAD SHX Text



Subject: WINDINGWALK FILING No. 1 AT MERIDIAN RANCH A PARCEL OF LAND LOCATED IN A PORTION OF SECTION 29, 30, AND 32 IN TOWNSHIP 12 SOUTH, RANGE 64 WEST OF THE 6TH PRINCIPAL MERIDIAN EL PASO COUNTY, COLORADO.  
Page Label: [1] SHEET 8  
Lock: Unlocked  
Author: AutoCAD SHX Text

ft.

Subject: ft.  
Page Label: [1] SHEET 8  
Lock: Unlocked  
Author: AutoCAD SHX Text

315  
6,240 SQ. FT.

N79°31'05"E

Subject: 6,240 SQ. FT.  
Page Label: [1] SHEET 8  
Lock: Unlocked  
Author: AutoCAD SHX Text

Subject: L=12.35'  
Page Label: [1] SHEET 8  
Lock: Unlocked  
Author: AutoCAD SHX Text

123.45  
223  
6,887 SQ. FT.  
120.0

Subject: 6,887 SQ. FT.  
Page Label: [1] SHEET 8  
Lock: Unlocked  
Author: AutoCAD SHX Text

116.4658  
224  
6,311 SQ. FT.  
118.36

Subject: 6,311 SQ. FT.  
Page Label: [1] SHEET 8  
Lock: Unlocked  
Author: AutoCAD SHX Text

237

Subject: 6,672 SQ. FT.  
Page Label: [1] SHEET 8  
Lock: Unlocked  
Author: AutoCAD SHX Text



---

**Subject:**  
**Page Label:** [1] SHEET 8 7,299 SQ. FT.  
**Lock:** Unlocked  
**Author:** AutoCAD SHX Text




---

**Subject:**  
**Page Label:** [1] SHEET 8 THE VISTAS FILING 1  
**Lock:** Unlocked  
**Author:** AutoCAD SHX Text



---

**Subject:**  
**Page Label:** [1] SHEET 8 (XXXXX)  
**Lock:** Unlocked  
**Author:** AutoCAD SHX Text

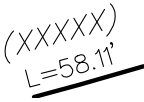

---

**Subject:**  
**Page Label:** [1] SHEET 8 (XXXXX)  
**Lock:** Unlocked  
**Author:** AutoCAD SHX Text




---

**Subject:**  
**Page Label:** [1] SHEET 8 8  
**Lock:** Unlocked  
**Author:** AutoCAD SHX Text



---

**Subject:**  
**Page Label:** [1] SHEET 8 (XXXXX)  
**Lock:** Unlocked  
**Author:** AutoCAD SHX Text

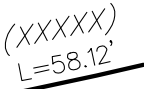

---

**Subject:**  
**Page Label:** [1] SHEET 8 (XXXXX)  
**Lock:** Unlocked  
**Author:** AutoCAD SHX Text




---

**Subject:**  
**Page Label:** [1] SHEET 8 (60 FEET WIDE)  
**Lock:** Unlocked  
**Author:** AutoCAD SHX Text

---

**Subject:**  
**Page Label:** [1] SHEET 8 6,672 SQ. FT.  
**Lock:** Unlocked  
**Author:** AutoCAD SHX Text

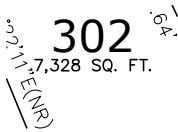

---

**Subject:**  
**Page Label:** [1] SHEET 8 7,328 SQ. FT.  
**Lock:** Unlocked  
**Author:** AutoCAD SHX Text


322

Subject:  
Page Label: [1] SHEET 8 6,240 SQ. FT.  
Lock: Unlocked  
Author: AutoCAD SHX Text

(XXXXX)  
L=53.78'

Subject:  
Page Label: [1] SHEET 8 (XXXXX)  
Lock: Unlocked  
Author: AutoCAD SHX Text


Subject:  
Page Label: [1] SHEET 8 (15.00')  
Lock: Unlocked  
Author: AutoCAD SHX Text

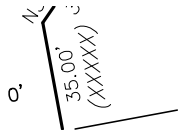

Subject:  
Page Label: [1] SHEET 8 (XXXXX)  
Lock: Unlocked  
Author: AutoCAD SHX Text



Subject:  
Page Label: [1] SHEET 8 (XXXXX)  
Lock: Unlocked  
Author: AutoCAD SHX Text

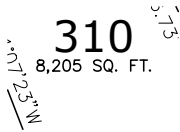

Subject:  
Page Label: [1] SHEET 8 8,205 SQ. FT.  
Lock: Unlocked  
Author: AutoCAD SHX Text



Subject:  
Page Label: [1] SHEET 8 SHEET 99  
Lock: Unlocked  
Author: AutoCAD SHX Text



Subject:  
Page Label: [1] SHEET 8 (XXXXX)  
Lock: Unlocked  
Author: AutoCAD SHX Text



Subject:  
Page Label: [1] SHEET 8 (XXXXX)  
Lock: Unlocked  
Author: AutoCAD SHX Text

(82.62')  
(12345)

Subject:  
Page Label: [1] SHEET 8 (82.62')  
Lock: Unlocked  
Author: AutoCAD SHX Text

---

**Subject:**  
**Page Label:** [1] SHEET 8 L=8.00'  
**Lock:** Unlocked  
**Author:** AutoCAD SHX Text



---

**Subject:**  
**Page Label:** [1] SHEET 8 7,419 SQ. FT.  
**Lock:** Unlocked  
**Author:** AutoCAD SHX Text




---

**Subject:**  
**Page Label:** [1] SHEET 8 6,240 SQ. FT.  
**Lock:** Unlocked  
**Author:** AutoCAD SHX Text




---

**Subject:**  
**Page Label:** [1] SHEET 8 (60 FEET WIDE)  
**Lock:** Unlocked  
**Author:** AutoCAD SHX Text

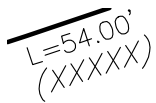

---

**Subject:**  
**Page Label:** [1] SHEET 8 (XXXXX)  
**Lock:** Unlocked  
**Author:** AutoCAD SHX Text

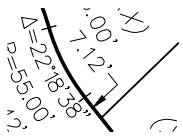


---

**Subject:**  
**Page Label:** [1] SHEET 8 7.12'  
**Lock:** Unlocked  
**Author:** AutoCAD SHX Text



---

**Subject:**  
**Page Label:** [1] SHEET 8 (60 FEET WIDE)  
**Lock:** Unlocked  
**Author:** AutoCAD SHX Text

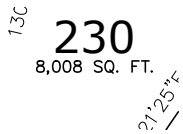

---

**Subject:**  
**Page Label:** [1] SHEET 8 8,008 SQ. FT.  
**Lock:** Unlocked  
**Author:** AutoCAD SHX Text

---

**Subject:**  
**Page Label:** [1] SHEET 8 (XXXXX)  
**Lock:** Unlocked  
**Author:** AutoCAD SHX Text



---

**Subject:**  
**Page Label:** [1] SHEET 8 6,240 SQ. FT.  
**Lock:** Unlocked  
**Author:** AutoCAD SHX Text

-----  
**Subject:**  
**Page Label:** [1] SHEET 8 L=28.93'  
**Lock:** Unlocked  
**Author:** AutoCAD SHX Text

(XXXXX)  
L=42.50'

-----  
**Subject:**  
**Page Label:** [1] SHEET 8 (XXXXX)  
**Lock:** Unlocked  
**Author:** AutoCAD SHX Text

-----  
**N.T.S.**

-----  
**Subject:**  
**Page Label:** [1] SHEET 8 N.T.S.  
**Lock:** Unlocked  
**Author:** AutoCAD SHX Text

-----  
**Subject:**  
**Page Label:** [1] SHEET 8 6,995 SQ. FT.  
**Lock:** Unlocked  
**Author:** AutoCAD SHX Text

-----  
0°28'55"W 13'  
**313**  
7,348 SQ. FT. N13°54'E

-----  
**Subject:**  
**Page Label:** [1] SHEET 8 7,348 SQ. FT.  
**Lock:** Unlocked  
**Author:** AutoCAD SHX Text

-----  
STON DRIVE  
**INDEX MAP**  
N.T.S.

-----  
**Subject:**  
**Page Label:** [1] SHEET 8 INDEX MAP  
**Lock:** Unlocked  
**Author:** AutoCAD SHX Text

-----  
**231**  
7,385 SQ. FT. S5°21'26"E 38'

-----  
**Subject:**  
**Page Label:** [1] SHEET 8 7,385 SQ. FT.  
**Lock:** Unlocked  
**Author:** AutoCAD SHX Text

-----  
136.42'  
**312**  
7,343 SQ. FT. N17°20'E

-----  
**Subject:**  
**Page Label:** [1] SHEET 8 7,343 SQ. FT.  
**Lock:** Unlocked  
**Author:** AutoCAD SHX Text

-----  
**Subject:**  
**Page Label:** [1] SHEET 8 (XXXXX)  
**Lock:** Unlocked  
**Author:** AutoCAD SHX Text

-----  
**Subject:**  
**Page Label:** [1] SHEET 8 7,461 SQ. FT.  
**Lock:** Unlocked  
**Author:** AutoCAD SHX Text

316  
6,240 SQ. FT.

N79°31'05"E

**Subject:**  
**Page Label:** [1] SHEET 8  
**Lock:** Unlocked  
**Author:** AutoCAD SHX Text

6,240 SQ. FT.

229  
8,191 SQ. FT.

N13°27'11"

**Subject:**  
**Page Label:** [1] SHEET 8  
**Lock:** Unlocked  
**Author:** AutoCAD SHX Text

8,191 SQ. FT.




**Subject:**  
**Page Label:** [1] SHEET 8  
**Lock:** Unlocked  
**Author:** AutoCAD SHX Text

(XXXXX)

NR

**Subject:**  
**Page Label:** [1] SHEET 8  
**Lock:** Unlocked  
**Author:** AutoCAD SHX Text

NR

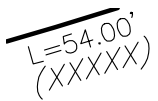


**Subject:**  
**Page Label:** [1] SHEET 8  
**Lock:** Unlocked  
**Author:** AutoCAD SHX Text

(XXXXX)



**Subject:**  
**Page Label:** [1] SHEET 8  
**Lock:** Unlocked  
**Author:** AutoCAD SHX Text

4

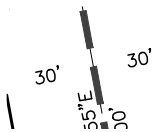

**Subject:**  
**Page Label:** [1] SHEET 8  
**Lock:** Unlocked  
**Author:** AutoCAD SHX Text


30' 30'

308  
8,054 SQ. FT.

N16°4'

**Subject:**  
**Page Label:** [1] SHEET 8  
**Lock:** Unlocked  
**Author:** AutoCAD SHX Text

8,054 SQ. FT.

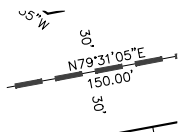

**Subject:**  
**Page Label:** [1] SHEET 8  
**Lock:** Unlocked  
**Author:** AutoCAD SHX Text

30' 30'



**Subject:**  
**Page Label:** [1] SHEET 8  
**Lock:** Unlocked  
**Author:** AutoCAD SHX Text

(XXXXX)

**Subject:**  
**Page Label:** [1] SHEET 8 (XXXXX)  
**Lock:** Unlocked  
**Author:** AutoCAD SHX Text

**Subject:**  
**Page Label:** [1] SHEET 8 8,891 SQ. FT.  
**Lock:** Unlocked  
**Author:** AutoCAD SHX Text

(82.62)  
(12345)  
: **Subject:**  
**Page Label:** [1] SHEET 8 (12345)  
**Lock:** Unlocked  
**Author:** AutoCAD SHX Text

DATE: DECEMB
SHEET: 8

SD PROJECT NO  
**Subject:**  
**Page Label:** [1] SHEET 8 SHEET: 8  
**Lock:** Unlocked  
**Author:** AutoCAD SHX Text

**Subject:**  
**Page Label:** [1] SHEET 8 0.067 ACRES  
**Lock:** Unlocked  
**Author:** AutoCAD SHX Text

**Subject:**  
**Page Label:** [1] SHEET 8 (60 FEET WIDE)  
**Lock:** Unlocked  
**Author:** AutoCAD SHX Text

309  
8,124 SQ. FT.  
35  
118"W  
**Subject:**  
**Page Label:** [1] SHEET 8 8,124 SQ. FT.  
**Lock:** Unlocked  
**Author:** AutoCAD SHX Text

(4444)  
50.00'  
LN  
**Subject:**  
**Page Label:** [1] SHEET 8 (XXXXX)  
**Lock:** Unlocked  
**Author:** AutoCAD SHX Text

45.28'  
L=8.88'  
(XXXX)  
**Subject:**  
**Page Label:** [1] SHEET 8 L=8.88'  
**Lock:** Unlocked  
**Author:** AutoCAD SHX Text

**Subject:**  
**Page Label:** [1] SHEET 8 (XXXXX)  
**Lock:** Unlocked  
**Author:** AutoCAD SHX Text

HEET  
CAM PR


Subject: (XXXXX)  
Page Label: [1] SHEET 8  
Lock: Unlocked  
Author: AutoCAD SHX Text

(XXXXX)  
50.00'

Subject: (XXXXX)  
Page Label: [1] SHEET 8  
Lock: Unlocked  
Author: AutoCAD SHX Text

305  
7,588 SQ. FT.  
50"E

Subject: 7,588 SQ. FT.  
Page Label: [1] SHEET 8  
Lock: Unlocked  
Author: AutoCAD SHX Text

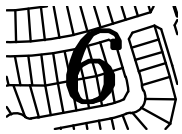

Subject: 6  
Page Label: [1] SHEET 8  
Lock: Unlocked  
Author: AutoCAD SHX Text




Subject: STAPLETON DRIVE  
Page Label: [1] SHEET 8  
Lock: Unlocked  
Author: AutoCAD SHX Text


INDEX

235  
6,875 SQ. FT.  
N51°35'04"  
50'

Subject: 6,875 SQ. FT.  
Page Label: [1] SHEET 8  
Lock: Unlocked  
Author: AutoCAD SHX Text

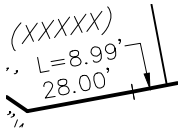

Subject: L=8.99'  
Page Label: [1] SHEET 8  
Lock: Unlocked  
Author: AutoCAD SHX Text

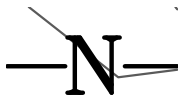

Subject: N  
Page Label: [1] SHEET 8  
Lock: Unlocked  
Author: AutoCAD SHX Text

(XXXXX)  
L=58.63'

Subject: (XXXXX)  
Page Label: [1] SHEET 8  
Lock: Unlocked  
Author: AutoCAD SHX Text

Subject: 6,190 SQ. FT.  
Page Label: [1] SHEET 8  
Lock: Unlocked  
Author: AutoCAD SHX Text

N123°25' 225  
6,372 SQ. FT. N19°50'

**Subject:**  
**Page Label:** [1] SHEET 8  
**Lock:** Unlocked  
**Author:** AutoCAD SHX Text

6,372 SQ. FT.

DATE: DECEMBER 2017  
SHEET: 8 OF 9  
PCD PROJECT NO. SF- - -

**Subject:**  
**Page Label:** [1] SHEET 8  
**Lock:** Unlocked  
**Author:** AutoCAD SHX Text

PCD PROJECT NO. SF- - -

(60 FEET WIDE)  
L=54.00'  
XXXX

**Subject:**  
**Page Label:** [1] SHEET 8  
**Lock:** Unlocked  
**Author:** AutoCAD SHX Text

(60 FEET WIDE)

19°31'05"E  
80.00'

**Subject:**  
**Page Label:** [1] SHEET 8  
**Lock:** Unlocked  
**Author:** AutoCAD SHX Text

30' 30'

N110°28'50" 220  
7,023 SQ. FT. N10°47'16"

**Subject:**  
**Page Label:** [1] SHEET 8  
**Lock:** Unlocked  
**Author:** AutoCAD SHX Text

7,023 SQ. FT.

**Subject:**  
**Page Label:** [1] SHEET 8  
**Lock:** Unlocked  
**Author:** AutoCAD SHX Text

30' 30'

XXXXXX

**Subject:**  
**Page Label:** [1] SHEET 8  
**Lock:** Unlocked  
**Author:** AutoCAD SHX Text

(XXXXXX)

STONEBRIDGE  
FILING 1

**Subject:**  
**Page Label:** [1] SHEET 9  
**Lock:** Unlocked  
**Author:** AutoCAD SHX Text

STONEBRIDGE FILING 1

XXXXXX


**Subject:**  
**Page Label:** [1] SHEET 9  
**Lock:** Unlocked  
**Author:** AutoCAD SHX Text

(XXXXXX)

**Subject:**  
**Page Label:** [1] SHEET 9  
**Lock:** Unlocked  
**Author:** AutoCAD SHX Text

(XXXXXX)



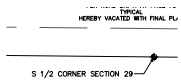

ACT F

**Subject:**  
**Page Label:** [1] SHEET 9  
**Lock:** Unlocked  
**Author:** AutoCAD SHX Text

S 1/2 CORNER SECTION 29

**Subject:**  
**Page Label:** [1] SHEET 9  
**Lock:** Unlocked  
**Author:** AutoCAD SHX Text

7,419 SQ. FT.

200


**Subject:**  
**Page Label:** [1] SHEET 9  
**Lock:** Unlocked  
**Author:** AutoCAD SHX Text

200




**Subject:**  
**Page Label:** [1] SHEET 9  
**Lock:** Unlocked  
**Author:** AutoCAD SHX Text

(XXXXX)

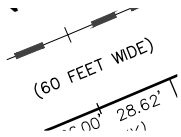

**Subject:**  
**Page Label:** [1] SHEET 9  
**Lock:** Unlocked  
**Author:** AutoCAD SHX Text

(60 FEET WIDE)

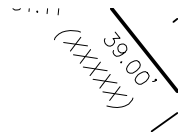

**Subject:**  
**Page Label:** [1] SHEET 9  
**Lock:** Unlocked  
**Author:** AutoCAD SHX Text

(XXXXX)



**Subject:**  
**Page Label:** [1] SHEET 9  
**Lock:** Unlocked  
**Author:** AutoCAD SHX Text

(XXXXX)

DATE: DECEMB
SHEET: 9
PROJECT NO

**Subject:**  
**Page Label:** [1] SHEET 9  
**Lock:** Unlocked  
**Author:** AutoCAD SHX Text

SHEET: 9

**Subject:**  
**Page Label:** [1] SHEET 9  
**Lock:** Unlocked  
**Author:** AutoCAD SHX Text

7,588 SQ. FT.

SEC. 29

SEC. 32

**Subject:**  
**Page Label:** [1] SHEET 9  
**Lock:** Unlocked  
**Author:** AutoCAD SHX Text

SEC. 29



**Subject:**  
**Page Label:** [1] SHEET 9  
**Lock:** Unlocked  
**Author:** AutoCAD SHX Text

STONEBRIDGE FILING 3

241  
7,461 SQ. FT.

N74°16'16"E

**Subject:**  
**Page Label:** [1] SHEET 9  
**Lock:** Unlocked  
**Author:** AutoCAD SHX Text

7,461 SQ. FT.



**Subject:**  
**Page Label:** [1] SHEET 9  
**Lock:** Unlocked  
**Author:** AutoCAD SHX Text

WINDINGWALK FILING No. 1 AT MERIDIAN RANCH A PARCEL OF LAND LOCATED IN A PORTION OF SECTION 29, 30, AND 32 IN TOWNSHIP 12 SOUTH, RANGE 64 WEST OF THE 6TH PRINCIPAL MERIDIAN EL PASO COUNTY, COLORADO.

50

**Subject:**  
**Page Label:** [1] SHEET 9  
**Lock:** Unlocked  
**Author:** AutoCAD SHX Text

50

26.00' 20.00'  
(XXXXXX)

**Subject:**  
**Page Label:** [1] SHEET 9  
**Lock:** Unlocked  
**Author:** AutoCAD SHX Text

(XXXXXX)

10.00'

**Subject:**  
**Page Label:** [1] SHEET 9  
**Lock:** Unlocked  
**Author:** AutoCAD SHX Text

10.00'

**Subject:**  
**Page Label:** [1] SHEET 9  
**Lock:** Unlocked  
**Author:** AutoCAD SHX Text

L=8.88'



**Subject:**  
**Page Label:** [1] SHEET 9  
**Lock:** Unlocked  
**Author:** AutoCAD SHX Text

8

**Subject:**  
**Page Label:** [1] SHEET 9  
**Lock:** Unlocked  
**Author:** AutoCAD SHX Text

(XXXXXX)

60.00'  
(15.00')  
(XXXXXX)


**Subject:**  
**Page Label:** [1] SHEET 9  
**Lock:** Unlocked  
**Author:** AutoCAD SHX Text

(15.00')

DRAWN BY: LCG  
CHECKED BY: TAK

**Subject:**  
**Page Label:** [1] SHEET 9  
**Lock:** Unlocked  
**Author:** AutoCAD SHX Text

DRAWN BY: LCG

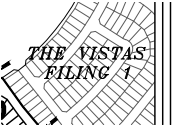

**Subject:**  
**Page Label:** [1] SHEET 9  
**Lock:** Unlocked  
**Author:** AutoCAD SHX Text

THE VISTAS FILING 1


**Subject:**  
**Page Label:** [1] SHEET 9  
**Lock:** Unlocked  
**Author:** AutoCAD SHX Text

7,546 SQ. FT.

SEC. 29  
SEC. 32

**Subject:**  
**Page Label:** [1] SHEET 9  
**Lock:** Unlocked  
**Author:** AutoCAD SHX Text

SEC. 32

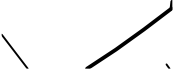

**Subject:**  
**Page Label:** [1] SHEET 9  
**Lock:** Unlocked  
**Author:** AutoCAD SHX Text

(XXXXXX)

(L=15.00')  
(XXXXXX)

**Subject:**  
**Page Label:** [1] SHEET 9  
**Lock:** Unlocked  
**Author:** AutoCAD SHX Text

(XXXXXX)

**N.T.S.**

**Subject:**  
**Page Label:** [1] SHEET 9  
**Lock:** Unlocked  
**Author:** AutoCAD SHX Text

N.T.S.

**Subject:**  
**Page Label:** [1] SHEET 9  
**Lock:** Unlocked  
**Author:** AutoCAD SHX Text

(XXXXXX)

L=40.00'  
(XXXXXX)


**Subject:**  
**Page Label:** [1] SHEET 9  
**Lock:** Unlocked  
**Author:** AutoCAD SHX Text

(XXXXXX)

L=49.50'  
(XXXXXX)

**Subject:**  
**Page Label:** [1] SHEET 9  
**Lock:** Unlocked  
**Author:** AutoCAD SHX Text

(XXXXXX)

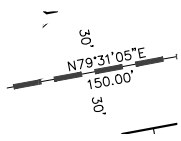


**Subject:**  
**Page Label:** [1] SHEET 9 30' 30'  
**Lock:** Unlocked  
**Author:** AutoCAD SHX Text

(82.62')  
(12345)


**Subject:**  
**Page Label:** [1] SHEET 9 (82.62')  
**Lock:** Unlocked  
**Author:** AutoCAD SHX Text




**Subject:**  
**Page Label:** [1] SHEET 9 4  
**Lock:** Unlocked  
**Author:** AutoCAD SHX Text

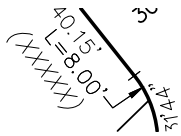

**Subject:**  
**Page Label:** [1] SHEET 9 L=8.00'  
**Lock:** Unlocked  
**Author:** AutoCAD SHX Text

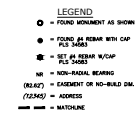


**Subject:**  
**Page Label:** [1] SHEET 9 = FOUND MONUMENT AS SHOWN = FOUND #4  
**Lock:** Unlocked REBAR WITH CAP PLS 34583 = SET #4  
**Author:** AutoCAD SHX Text REBAR W/CAP PLS 34583 = NON-RADIAL BEARING = EASEMENT OR NO-BUILD DIM. = ADDRESS ADDRESS = MATCHLINE

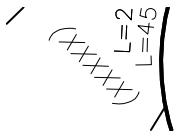

**Subject:**  
**Page Label:** [1] SHEET 9 (XXXXX)  
**Lock:** Unlocked  
**Author:** AutoCAD SHX Text



**Subject:**  
**Page Label:** [1] SHEET 9 L=12.35'  
**Lock:** Unlocked  
**Author:** AutoCAD SHX Text

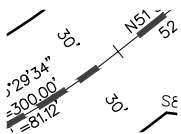


**Subject:**  
**Page Label:** [1] SHEET 9 30' 30'  
**Lock:** Unlocked  
**Author:** AutoCAD SHX Text

309

**Subject:**  
**Page Label:** [1] SHEET 9 8,124 SQ. FT.  
**Lock:** Unlocked  
**Author:** AutoCAD SHX Text

238

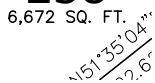

**Subject:**  
**Page Label:** [1] SHEET 9 6,672 SQ. FT.  
**Lock:** Unlocked  
**Author:** AutoCAD SHX Text


---

**Subject:**  
**Page Label:** [1] SHEET 9 7,328 SQ. FT.  
**Lock:** Unlocked  
**Author:** AutoCAD SHX Text

252  
6,790 SQ. FT.

---

**Subject:**  
**Page Label:** [1] SHEET 9 6,790 SQ. FT.  
**Lock:** Unlocked  
**Author:** AutoCAD SHX Text

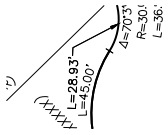

---

**Subject:**  
**Page Label:** [1] SHEET 9 L=28.93'  
**Lock:** Unlocked  
**Author:** AutoCAD SHX Text



---

**Subject:**  
**Page Label:** [1] SHEET 9 (XXXXX)  
**Lock:** Unlocked  
**Author:** AutoCAD SHX Text

2017 /  
OF 9  
CF

---

**Subject:**  
**Page Label:** [1] SHEET 9 OF 9  
**Lock:** Unlocked  
**Author:** AutoCAD SHX Text



---

**Subject:**  
**Page Label:** [1] SHEET 9 5  
**Lock:** Unlocked  
**Author:** AutoCAD SHX Text

ft.

---

**Subject:**  
**Page Label:** [1] SHEET 9 ft.  
**Lock:** Unlocked  
**Author:** AutoCAD SHX Text

50

---

**Subject:**  
**Page Label:** [1] SHEET 9 50  
**Lock:** Unlocked  
**Author:** AutoCAD SHX Text

---

**Subject:**  
**Page Label:** [1] SHEET 9 (XXXXX)  
**Lock:** Unlocked  
**Author:** AutoCAD SHX Text

---

**Subject:**  
**Page Label:** [1] SHEET 9 (XXXXX)  
**Lock:** Unlocked  
**Author:** AutoCAD SHX Text

---

Subject: (XXXXX)  
Page Label: [1] SHEET 9  
Lock: Unlocked  
Author: AutoCAD SHX Text

306

Subject: 7,596 SQ. FT.  
Page Label: [1] SHEET 9  
Lock: Unlocked  
Author: AutoCAD SHX Text

Subject: (XXXXX)  
Page Label: [1] SHEET 9  
Lock: Unlocked  
Author: AutoCAD SHX Text

Subject: 7,331 SQ. FT.  
Page Label: [1] SHEET 9  
Lock: Unlocked  
Author: AutoCAD SHX Text

NR

Subject: NR  
Page Label: [1] SHEET 9  
Lock: Unlocked  
Author: AutoCAD SHX Text

3

Subject: (XXXXX)  
Page Label: [1] SHEET 9  
Lock: Unlocked  
Author: AutoCAD SHX Text

250  
7,375 SQ. FT.

Subject: 7,375 SQ. FT.  
Page Label: [1] SHEET 9  
Lock: Unlocked  
Author: AutoCAD SHX Text

55' x 26' 4 1/2"  
25.4

30' PUBLIC HIGHWAY  
ON EACH SIDE OF  
ALL SECTION LINES  
PER ROAD BK. A AT PAGE 78  
TYPICAL  
HEREBY VACATED WITH FINAL PLAT

Subject: 30' PUBLIC HIGHWAY ON EACH SIDE OF ALL SECTION LINES PER ROAD BK. A AT PAGE 78 TYPICAL HEREBY VACATED WITH FINAL PLAT  
Page Label: [1] SHEET 9  
Lock: Unlocked  
Author: AutoCAD SHX Text

30' PUBLIC HIGHWAY  
ON EACH SIDE OF  
ALL SECTION LINES  
PER ROAD BK. A AT PAGE 78  
TYPICAL  
HEREBY VACATED WITH FINAL PLAT

Subject: 30' PUBLIC HIGHWAY ON EACH SIDE OF ALL SECTION LINES PER ROAD BK. A AT PAGE 78 TYPICAL HEREBY VACATED WITH FINAL PLAT  
Page Label: [1] SHEET 9  
Lock: Unlocked  
Author: AutoCAD SHX Text

247  
9,025 SQ. FT.

Subject: 9,025 SQ. FT.  
Page Label: [1] SHEET 9  
Lock: Unlocked  
Author: AutoCAD SHX Text

9' W(NR)

-----  
**Subject:**  
**Page Label:** [1] SHEET 9 6,240 SQ. FT.  
**Lock:** Unlocked  
**Author:** AutoCAD SHX Text

L=49.50'  
(XXXXX)

-----  
**Subject:**  
**Page Label:** [1] SHEET 9 (XXXXX)  
**Lock:** Unlocked  
**Author:** AutoCAD SHX Text

ETON DRIVE  
INDEX MAP  
N.T.S.

-----  
**Subject:**  
**Page Label:** [1] SHEET 9 INDEX MAP  
**Lock:** Unlocked  
**Author:** AutoCAD SHX Text

SHEET 7

-----  
**Subject:**  
**Page Label:** [1] SHEET 9 SHEET 77  
**Lock:** Unlocked  
**Author:** AutoCAD SHX Text

DATE: DECEMBER 2017  
SHEET: 9 OF 9  
PCD PROJECT NO. SF-\_\_\_\_-

-----  
**Subject:**  
**Page Label:** [1] SHEET 9 PCD PROJECT NO. SF-\_\_\_\_-\_\_\_\_  
**Lock:** Unlocked  
**Author:** AutoCAD SHX Text

235

151°35'04"

-----  
**Subject:**  
**Page Label:** [1] SHEET 9 6,875 SQ. FT.  
**Lock:** Unlocked  
**Author:** AutoCAD SHX Text

TRACT C  
13.644 ACRES

-----  
**Subject:**  
**Page Label:** [1] SHEET 9 13.644 ACRES  
**Lock:** Unlocked  
**Author:** AutoCAD SHX Text

22.35'  
L=40.00'  
(XXXXX)

-----  
**Subject:**  
**Page Label:** [1] SHEET 9 (XXXXX)  
**Lock:** Unlocked  
**Author:** AutoCAD SHX Text

-----  
**Subject:**  
**Page Label:** [1] SHEET 9 7,410 SQ. FT.  
**Lock:** Unlocked  
**Author:** AutoCAD SHX Text

25

-----  
**Subject:**  
**Page Label:** [1] SHEET 9 25  
**Lock:** Unlocked  
**Author:** AutoCAD SHX Text

240  
6,951 SQ. FT.

160'06"54"  
46'

**Subject:**  
**Page Label:** [1] SHEET 9  
**Lock:** Unlocked  
**Author:** AutoCAD SHX Text

6,951 SQ. FT.

128.71'  
257  
6,793 SQ. FT.

515'26"


**Subject:**  
**Page Label:** [1] SHEET 9  
**Lock:** Unlocked  
**Author:** AutoCAD SHX Text

6,793 SQ. FT.



**Subject:**  
**Page Label:** [1] SHEET 9  
**Lock:** Unlocked  
**Author:** AutoCAD SHX Text

(XXXXX)

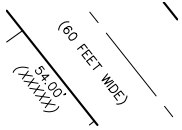

**Subject:**  
**Page Label:** [1] SHEET 9  
**Lock:** Unlocked  
**Author:** AutoCAD SHX Text

(60 FEET WIDE)

100  
|


**Subject:**  
**Page Label:** [1] SHEET 9  
**Lock:** Unlocked  
**Author:** AutoCAD SHX Text

100



**Subject:**  
**Page Label:** [1] SHEET 9  
**Lock:** Unlocked  
**Author:** AutoCAD SHX Text

15' UTILITY EASEMENT

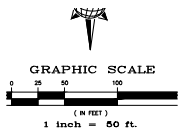

**Subject:**  
**Page Label:** [1] SHEET 9  
**Lock:** Unlocked  
**Author:** AutoCAD SHX Text

GRAPHIC SCALE



**Subject:**  
**Page Label:** [1] SHEET 9  
**Lock:** Unlocked  
**Author:** AutoCAD SHX Text

(XXXXX)



**Subject:**  
**Page Label:** [1] SHEET 9  
**Lock:** Unlocked  
**Author:** AutoCAD SHX Text

3

50  
|

**Subject:**  
**Page Label:** [1] SHEET 9  
**Lock:** Unlocked  
**Author:** AutoCAD SHX Text


50



30' PUBLIC HIGHWAY  
ON EACH SIDE OF  
ALL SECTION LINES  
PER ROAD BK. A AT PAGE 78  
TYPICAL  
HEREBY VACATED WITH FINAL PLAT

**Subject:**  
**Page Label:** [1] SHEET 9  
**Lock:** Unlocked  
**Author:** AutoCAD SHX Text

30' PUBLIC HIGHWAY ON EACH SIDE OF ALL  
SECTION LINES PER ROAD BK. A AT PAGE 78  
TYPICAL HEREBY VACATED WITH FINAL PLAT

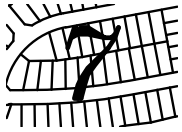


**Subject:**  
**Page Label:** [1] SHEET 9  
**Lock:** Unlocked  
**Author:** AutoCAD SHX Text

7



**Subject:**  
**Page Label:** [1] SHEET 9  
**Lock:** Unlocked  
**Author:** AutoCAD SHX Text

15' UTILITY EASEMENT

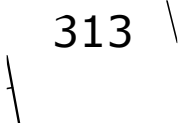


**Subject:**  
**Page Label:** [1] SHEET 9  
**Lock:** Unlocked  
**Author:** AutoCAD SHX Text

7,348 SQ. FT.



**Subject:**  
**Page Label:** [1] SHEET 9  
**Lock:** Unlocked  
**Author:** AutoCAD SHX Text

7,887 SQ. FT.

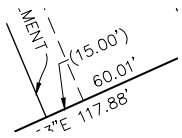

**Subject:**  
**Page Label:** [1] SHEET 9  
**Lock:** Unlocked  
**Author:** AutoCAD SHX Text

(15.00')



**Subject:**  
**Page Label:** [1] SHEET 9  
**Lock:** Unlocked  
**Author:** AutoCAD SHX Text

9

**Subject:**  
**Page Label:** [1] SHEET 9  
**Lock:** Unlocked  
**Author:** AutoCAD SHX Text

6,250 SQ. FT.


**Subject:**  
**Page Label:** [1] SHEET 9  
**Lock:** Unlocked  
**Author:** AutoCAD SHX Text

(XXXXX)

DRAWN BY: LCG  
CHECKED BY: TAK

**Subject:**  
**Page Label:** [1] SHEET 9  
**Lock:** Unlocked  
**Author:** AutoCAD SHX Text

CHECKED BY: TAK

  
( IN FEET )  
1 inch =

-----  
**Subject:** 1 inch =  
**Page Label:** [1] SHEET 9  
**Lock:** Unlocked  
**Author:** AutoCAD SHX Text

-----  
**Subject:** (60 FEET WIDE)  
**Page Label:** [1] SHEET 9  
**Lock:** Unlocked  
**Author:** AutoCAD SHX Text

*(H H H H)*  
55.00'

-----  
**Subject:** (XXXXX)  
**Page Label:** [1] SHEET 9  
**Lock:** Unlocked  
**Author:** AutoCAD SHX Text

310

-----  
**Subject:** 8,205 SQ. FT.  
**Page Label:** [1] SHEET 9  
**Lock:** Unlocked  
**Author:** AutoCAD SHX Text

125.00'  
260  
6,947 SQ. FT. 510'28'

-----  
**Subject:** 6,947 SQ. FT.  
**Page Label:** [1] SHEET 9  
**Lock:** Unlocked  
**Author:** AutoCAD SHX Text

STAPLETON DRIVE  
(EXISTING ROW 125' WIDE)

-----  
**Subject:** (EXISTING ROW 125' WIDE)  
**Page Label:** [1] SHEET 9  
**Lock:** Unlocked  
**Author:** AutoCAD SHX Text

363.39'  
254  
7,144 SQ. FT. 363.39'

-----  
**Subject:** 7,144 SQ. FT.  
**Page Label:** [1] SHEET 9  
**Lock:** Unlocked  
**Author:** AutoCAD SHX Text

-----  
**Subject:** 6,631 SQ. FT.  
**Page Label:** [1] SHEET 9  
**Lock:** Unlocked  
**Author:** AutoCAD SHX Text

*(H H H H)*  
47.00'

-----  
**Subject:** (XXXXX)  
**Page Label:** [1] SHEET 9  
**Lock:** Unlocked  
**Author:** AutoCAD SHX Text

  
STAPLETON DRIVE

-----  
**Subject:** STAPLETON DRIVE  
**Page Label:** [1] SHEET 9  
**Lock:** Unlocked  
**Author:** AutoCAD SHX Text

INDEX


---

**Subject:**  
**Page Label:** [1] SHEET 9 (60 FEET WIDE)  
**Lock:** Unlocked  
**Author:** AutoCAD SHX Text




---

**Subject:**  
**Page Label:** [1] SHEET 9 2  
**Lock:** Unlocked  
**Author:** AutoCAD SHX Text

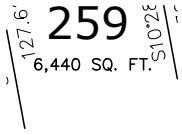


---

**Subject:**  
**Page Label:** [1] SHEET 9 6,440 SQ. FT.  
**Lock:** Unlocked  
**Author:** AutoCAD SHX Text

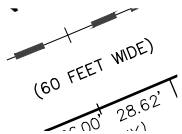


---

**Subject:**  
**Page Label:** [1] SHEET 9 (60 FEET WIDE)  
**Lock:** Unlocked  
**Author:** AutoCAD SHX Text

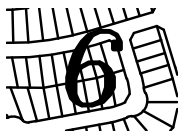


---

**Subject:**  
**Page Label:** [1] SHEET 9 6  
**Lock:** Unlocked  
**Author:** AutoCAD SHX Text

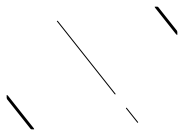

---

**Subject:**  
**Page Label:** [1] SHEET 9 30' 30'  
**Lock:** Unlocked  
**Author:** AutoCAD SHX Text

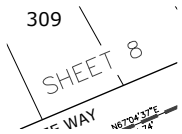


---

**Subject:**  
**Page Label:** [1] SHEET 9 SHEET 8  
**Lock:** Unlocked  
**Author:** AutoCAD SHX Text




---

**Subject:**  
**Page Label:** [1] SHEET 9  $\Delta=17^{\circ}51'47''$  R=1410.00'  
**Lock:** Unlocked L=439.60'CH=N80°43'00"W CHL=437.82'  
**Author:** AutoCAD SHX Text

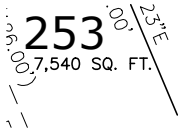

---

**Subject:**  
**Page Label:** [1] SHEET 9 7,540 SQ. FT.  
**Lock:** Unlocked  
**Author:** AutoCAD SHX Text

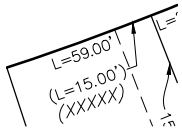

---

**Subject:**  
**Page Label:** [1] SHEET 9 (L=15.00')  
**Lock:** Unlocked  
**Author:** AutoCAD SHX Text


30' PUBLIC HIGHWAY  
ON EACH SIDE OF  
ALL SECTION LINES  
PER ROAD BK. A AT PAGE  
TYPICAL  
HEREBY VACATED WITH FINAL

**Subject:**  
**Page Label:** [1] SHEET 9  
**Lock:** Unlocked  
**Author:** AutoCAD SHX Text

30' PUBLIC HIGHWAY ON EACH SIDE OF ALL  
SECTION LINES PER ROAD BK. A AT PAGE 78  
TYPICAL HEREBY VACATED WITH FINAL PLAT

**Subject:**  
**Page Label:** [1] SHEET 9  
**Lock:** Unlocked  
**Author:** AutoCAD SHX Text

(XXXXX)

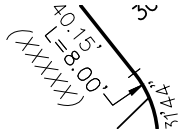

**Subject:**  
**Page Label:** [1] SHEET 9  
**Lock:** Unlocked  
**Author:** AutoCAD SHX Text


L=8.00'

**Subject:**  
**Page Label:** [1] SHEET 9  
**Lock:** Unlocked  
**Author:** AutoCAD SHX Text

(60 FEET WIDE)

**Subject:**  
**Page Label:** [1] SHEET 9  
**Lock:** Unlocked  
**Author:** AutoCAD SHX Text

(XXXXX)

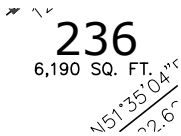

**Subject:**  
**Page Label:** [1] SHEET 9  
**Lock:** Unlocked  
**Author:** AutoCAD SHX Text

6,190 SQ. FT.



**Subject:**  
**Page Label:** [1] SHEET 9  
**Lock:** Unlocked  
**Author:** AutoCAD SHX Text

(XXXXX)

**Subject:**  
**Page Label:** [1] SHEET 9  
**Lock:** Unlocked  
**Author:** AutoCAD SHX Text

(XXXXX)

**Subject:**  
**Page Label:** [1] SHEET 9  
**Lock:** Unlocked  
**Author:** AutoCAD SHX Text

7,083 SQ. FT.



**Subject:**  
**Page Label:** [1] SHEET 9  
**Lock:** Unlocked  
**Author:** AutoCAD SHX Text

6,903 SQ. FT.

---

**Subject:**  
**Page Label:** [1] SHEET 9 6,240 SQ. FT.  
**Page Label:** [1] SHEET 9 (XXXXX)  
**Lock:** Unlocked  
**Author:** AutoCAD SHX Text

50.00'  
(XXXXX)

---

**Subject:**  
**Page Label:** [1] SHEET 9 (XXXXX)  
**Lock:** Unlocked  
**Author:** AutoCAD SHX Text


L=28.93'  
L=45.00'  
R=300'  
L=36'

---

**Subject:**  
**Page Label:** [1] SHEET 9 L=28.93'  
**Lock:** Unlocked  
**Author:** AutoCAD SHX Text

---

**Subject:**  
**Page Label:** [1] SHEET 9 (60 FEET WIDE)  
**Lock:** Unlocked  
**Author:** AutoCAD SHX Text

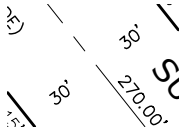

---


**Subject:**  
**Page Label:** [1] SHEET 9 30' 30'  
**Lock:** Unlocked  
**Author:** AutoCAD SHX Text

TRACT F  
THE METROPOLITAN CLUB  
RECEPTION NO. 208712913  
(VACATED WITH THIS PLAT)

TRACT D

---

**Subject:**  
**Page Label:** [1] SHEET 9 THE METROPOLITAN CLUB RECEPTION NO.  
**Lock:** Unlocked 208712913 (VACATED WITH THIS PLAT)  
**Author:** AutoCAD SHX Text

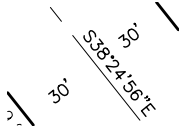

---

**Subject:**  
**Page Label:** [1] SHEET 9 30' 30'  
**Lock:** Unlocked  
**Author:** AutoCAD SHX Text

---

**Subject:**  
**Page Label:** [1] SHEET 9 (XXXXXX)  
**Lock:** Unlocked  
**Author:** AutoCAD SHX Text



---

**Subject:**  
**Page Label:** [1] SHEET 9 (XXXXXX)  
**Lock:** Unlocked  
**Author:** AutoCAD SHX Text




---

**Subject:**  
**Page Label:** [1] SHEET 9 (XXXXXX)  
**Lock:** Unlocked  
**Author:** AutoCAD SHX Text

APLETON DRIVE  
(EXISTING ROW 130' WIDE)

---

**Subject:**  
**Page Label:** [1] SHEET 9 (EXISTING ROW 130' WIDE)  
**Lock:** Unlocked  
**Author:** AutoCAD SHX Text

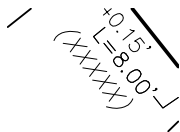

---

**Subject:**  
**Page Label:** [1] SHEET 9 (XXXXXX)  
**Lock:** Unlocked  
**Author:** AutoCAD SHX Text

---

**Subject:**  
**Page Label:** [1] SHEET 9 7,522 SQ. FT.  
**Lock:** Unlocked  
**Author:** AutoCAD SHX Text

245  
8,903 SQ. FT.

Subject:  
Page Label: [1] SHEET 9  
Lock: Unlocked  
Author: AutoCAD SHX Text

8,903 SQ. FT.

130.00'  
258  
6,734 SQ. FT. 512.41'

Subject:  
Page Label: [1] SHEET 9  
Lock: Unlocked  
Author: AutoCAD SHX Text

6,734 SQ. FT.

Subject:  
Page Label: [1] SHEET 9  
Lock: Unlocked  
Author: AutoCAD SHX Text

6,240 SQ. FT.

242  
8,891 SQ. FT.

Subject:  
Page Label: [1] SHEET 9  
Lock: Unlocked  
Author: AutoCAD SHX Text

8,891 SQ. FT.

S76'

Subject:  
Page Label: [1] SHEET 9  
Lock: Unlocked  
Author: AutoCAD SHX Text

(XXXXXX)

243  
8,906 SQ. FT.

Subject:  
Page Label: [1] SHEET 9  
Lock: Unlocked  
Author: AutoCAD SHX Text

8,906 SQ. FT.

218'30"

408.79  
EASTONVILLE ROAD  
(EXISTING ROW 70' WIDE)

Subject:  
Page Label: [1] SHEET 9  
Lock: Unlocked  
Author: AutoCAD SHX Text

(EXISTING ROW 70' WIDE)

Subject:  
Page Label: [1] SHEET 9  
Lock: Unlocked  
Author: AutoCAD SHX Text

6,947 SQ. FT.

Subject:  
Page Label: [1] SHEET 9  
Lock: Unlocked  
Author: AutoCAD SHX Text

6,875 SQ. FT.

308

Subject:  
Page Label: [1] SHEET 9  
Lock: Unlocked  
Author: AutoCAD SHX Text

8,054 SQ. FT.

314

**Subject:**  
**Page Label:** [1] SHEET 9  
**Lock:** Unlocked  
**Author:** AutoCAD SHX Text

6,598 SQ. FT.

(15.00")  
(XXXXXX)

**Subject:**  
**Page Label:** [1] SHEET 9  
**Lock:** Unlocked  
**Author:** AutoCAD SHX Text

(XXXXXX)

312

**Subject:**  
**Page Label:** [1] SHEET 9  
**Lock:** Unlocked  
**Author:** AutoCAD SHX Text

7,343 SQ. FT.

237

6,672 SQ. FT.  
151'35"04"  
7.0'

**Subject:**  
**Page Label:** [1] SHEET 9  
**Lock:** Unlocked  
**Author:** AutoCAD SHX Text

6,672 SQ. FT.

307

**Subject:**  
**Page Label:** [1] SHEET 9  
**Lock:** Unlocked  
**Author:** AutoCAD SHX Text

7,990 SQ. FT.

**Subject:**  
**Page Label:** [1] SHEET 9  
**Lock:** Unlocked  
**Author:** AutoCAD SHX Text

(XXXXXX)

256

6,759 SQ. FT.  
518'11"  
518'11"

**Subject:**  
**Page Label:** [1] SHEET 9  
**Lock:** Unlocked  
**Author:** AutoCAD SHX Text

6,759 SQ. FT.

( IN FEET )  
ch = 50

**Subject:**  
**Page Label:** [1] SHEET 9  
**Lock:** Unlocked  
**Author:** AutoCAD SHX Text

( IN FEET )

(4444)  
50.00'

**Subject:**  
**Page Label:** [1] SHEET 9  
**Lock:** Unlocked  
**Author:** AutoCAD SHX Text

(XXXXXX)

311

**Subject:**  
**Page Label:** [1] SHEET 9  
**Lock:** Unlocked  
**Author:** AutoCAD SHX Text

8,105 SQ. FT.



244

9,082 SQ. FT.

Subject:  
Page Label: [1] SHEET 9  
Lock: Unlocked  
Author: AutoCAD SHX Text

9,082 SQ. FT.

TRACT C

13.644 ACRES

Subject:  
Page Label: [1] SHEET 9  
Lock: Unlocked  
Author: AutoCAD SHX Text


13.644 ACRES

(82.62)

(12345)

Subject:  
Page Label: [1] SHEET 9  
Lock: Unlocked  
Author: AutoCAD SHX Text

(12345)

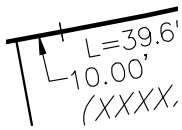

Subject:  
Page Label: [1] SHEET 9  
Lock: Unlocked  
Author: AutoCAD SHX Text

10.00'


248

8,655 SQ. FT.

51" W(NR)

Subject:  
Page Label: [1] SHEET 9  
Lock: Unlocked  
Author: AutoCAD SHX Text

8,655 SQ. FT.

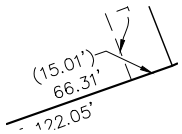

Subject:  
Page Label: [1] SHEET 9  
Lock: Unlocked  
Author: AutoCAD SHX Text

(15.01')

SEC. 29

SEC. 32

Subject:  
Page Label: [1] SHEET 9  
Lock: Unlocked  
Author: AutoCAD SHX Text

SEC. 29

Subject:  
Page Label: [1] SHEET 9  
Lock: Unlocked  
Author: AutoCAD SHX Text

(60 FEET WIDE)

249

7,299 SQ. FT.

51' 35.04" W

Subject:  
Page Label: [1] SHEET 9  
Lock: Unlocked  
Author: AutoCAD SHX Text

7,299 SQ. FT.

239

6,190 SQ. FT.


51' 35.04" W

Subject:  
Page Label: [1] SHEET 9  
Lock: Unlocked  
Author: AutoCAD SHX Text


6,190 SQ. FT.

Subject: (XXXXX)  
Page Label: [1] SHEET 9  
Lock: Unlocked  
Author: AutoCAD SHX Text

SEC. 29  
SEC. 32  
Subject: SEC. 32  
Page Label: [1] SHEET 9  
Lock: Unlocked  
Author: AutoCAD SHX Text

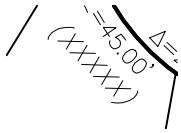

Subject: (XXXXX)  
Page Label: [1] SHEET 9  
Lock: Unlocked  
Author: AutoCAD SHX Text

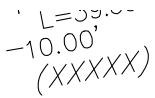

Subject: (XXXXX)  
Page Label: [1] SHEET 9  
Lock: Unlocked  
Author: AutoCAD SHX Text

**TRACT C**  
13.644 ACRES

Subject: 13.644 ACRES  
Page Label: [1] SHEET 9  
Lock: Unlocked  
Author: AutoCAD SHX Text

DATE: DECEMBER 2017
SHEET: 9 OF 9
PCD PROJECT NO. SF-___

Subject: DATE: DECEMBER 2017  
Page Label: [1] SHEET 9  
Lock: Unlocked  
Author: AutoCAD SHX Text



Subject: (60 FEET WIDE)  
Page Label: [1] SHEET 9  
Lock: Unlocked  
Author: AutoCAD SHX Text



Subject: (EXISTING ROW 80' WIDE)  
Page Label: [1] SHEET 9  
Lock: Unlocked  
Author: AutoCAD SHX Text


Subject: 30' 30'  
Page Label: [1] SHEET 9  
Lock: Unlocked  
Author: AutoCAD SHX Text



Subject: (XXXXX)  
Page Label: [1] SHEET 9  
Lock: Unlocked  
Author: AutoCAD SHX Text


**Subject:**  
**Page Label:** [1] SHEET 9  
**Lock:** Unlocked  
**Author:** AutoCAD SHX Text

dsdlaforce (11)

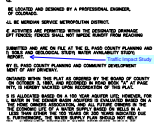


**Subject:** Callout  
**Page Label:** [1] SHEET 1  
**Lock:** Unlocked  
**Author:** dsdlaforce

Traffic Impact Study

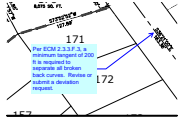

**Subject:** Callout  
**Page Label:** [1] SHEET 2  
**Lock:** Unlocked  
**Author:** dsdlaforce

Per ECM 2.3.3.F.3, a minimum tangent of 200 ft is required to separate all broken back curves. Revise or submit a deviation request.

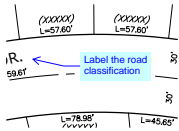

**Subject:** Callout  
**Page Label:** [1] SHEET 2  
**Lock:** Unlocked  
**Author:** dsdlaforce

Label the road classification



**Subject:** Callout  
**Page Label:** [1] SHEET 3  
**Lock:** Unlocked  
**Author:** dsdlaforce

See the PUDSP redline regarding sight distance



**Subject:** Highlight  
**Page Label:** [1] SHEET 3  
**Lock:** Unlocked  
**Author:** dsdlaforce




**Subject:** Highlight  
**Page Label:** [1] SHEET 4  
**Lock:** Unlocked  
**Author:** dsdlaforce



**Subject:** Callout  
**Page Label:** [1] SHEET 4  
**Lock:** Unlocked  
**Author:** dsdlaforce

See the PUDSP redline regarding sight distance

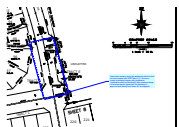


**Subject:** Cloud+  
**Page Label:** [1] SHEET 6  
**Lock:** Unlocked  
**Author:** dsdlaforce

Intersection spacing along the residential collector does not meet criteria (see ECM Table 2-7). Revise or submit a deviation request with justification. Justification shall include identify other roadway design criteria that may be impacted if the deviation is approved and identify how these will be mitigated.



**Subject:** Cloud+  
**Page Label:** [1] SHEET 6  
**Lock:** Unlocked  
**Author:** dsdlaforce

Cul-de-sac exceeds the maximum length of 750' for urban conditions. Revise or submit a deviation request. As part of the request, the deviation must include an express written endorsement from the Fire District (ECM 2.3.8.A)

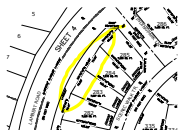

**Subject:** Highlight  
**Page Label:** [1] SHEET 7  
**Lock:** Unlocked  
**Author:** dsdlaforce



**Subject:** Callout  
**Page Label:** [1] SHEET 7  
**Lock:** Unlocked  
**Author:** dsdlaforce

See the PUDSP redline regarding sight distance

---


dsdruiz (2)

---



**Subject:** Cloud+  
**Page Label:** [1] SHEET 1  
**Lock:** Unlocked  
**Author:** dsdruiz

FYI: this is anticipated to be amended in 2020 where all may be subject to the TIF

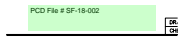

**Subject:** Text Box  
**Page Label:** [1] SHEET 1  
**Lock:** Unlocked  
**Author:** dsdruiz

PCD File # SF-18-002