





- NOTES:
- DO NOT REMOVE OR CUT LEADER.
 - PRUNE ONLY DEAD OR BROKEN BRANCHES IMMEDIATELY PRIOR TO PLANTING.
 - REMOVE ANY DOUBLE LEADER, UNLESS OTHERWISE DIRECTED BY OWNER'S REPRESENTATIVE
 - KEEP PLANTS MOIST AND SHADED UNTIL PLANTING.
 - AVOID FALL PLANTING IF POSSIBLE.
 - AMENDED BACKFILL SHALL BE 80% SOIL FROM PLANTING PIT AND 20% ORGANIC MATERIAL, PREFERABLY CANADIAN PEAT MOSS.
 - STAKING POST SHALL BE 1 1/2" DIA. TREATED WOOD STAKE. METAL POST WILL NOT BE APPROVED

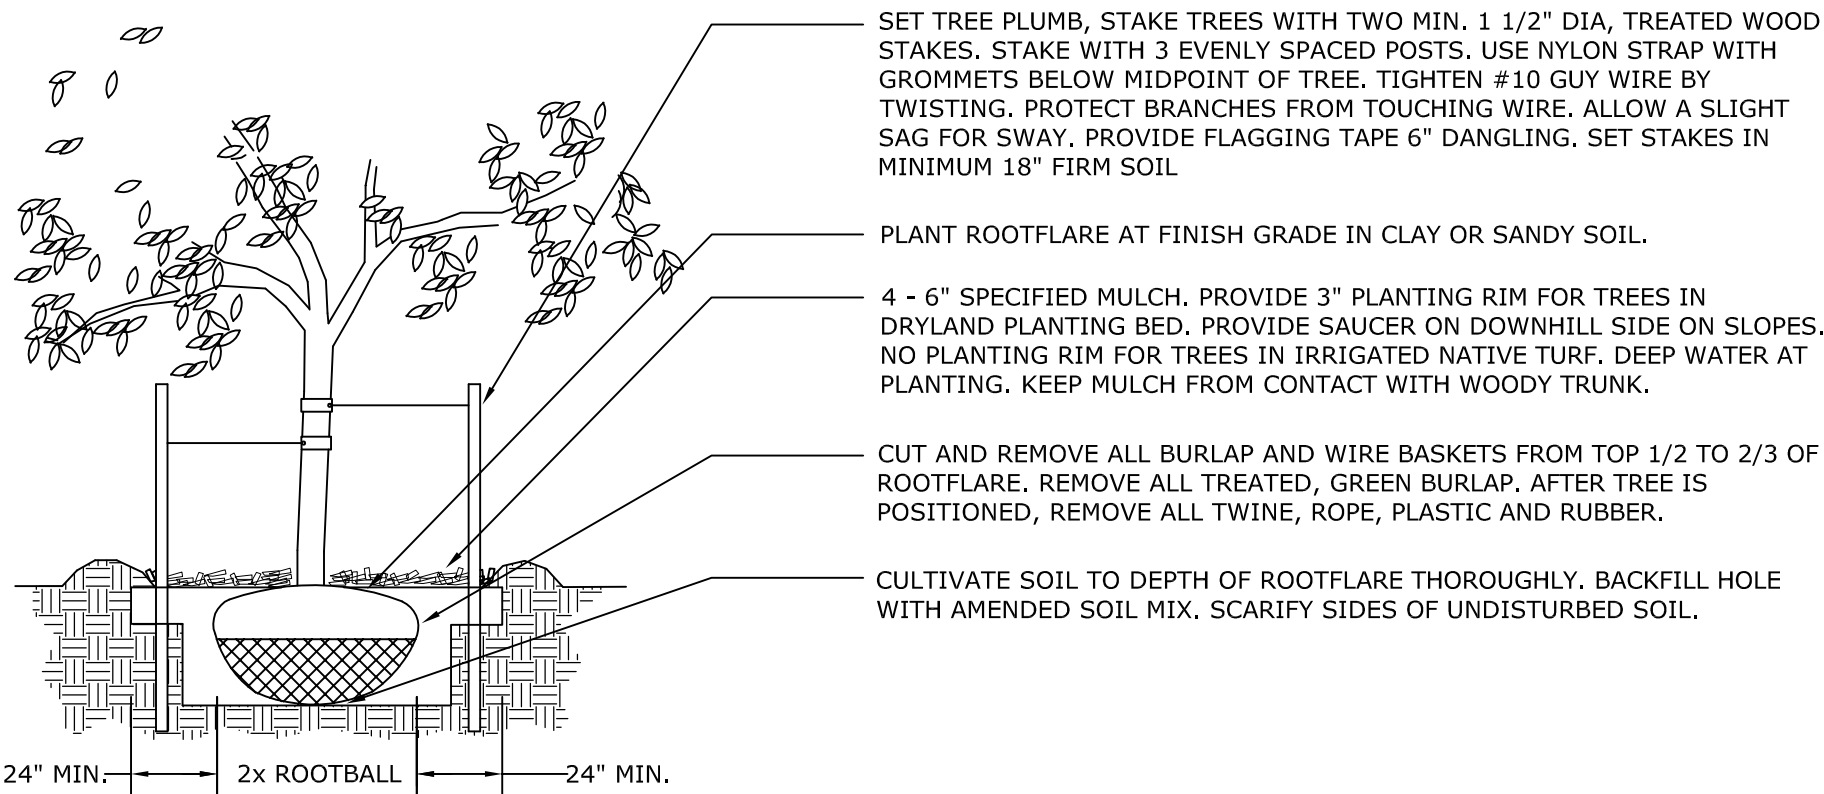


1
LS2 DECIDUOUS TREE PLANTING DETAIL
N.T.S.


- NOTES:
- PRUNE ONLY DEAD OR BROKEN BRANCHES IMMEDIATELY PRIOR TO PLANTING.
 - KEEP PLANTS MOIST AND SHADED UNTIL PLANTING.
 - DO NOT FERTILIZE FOR AT LEAST ONE GROWING SEASON.
 - AMENDED BACKFILL SHALL BE 70% SOIL FROM PLANTING PIT AND 30% ORGANIC MATERIAL, PREFERABLY CANADIAN PEAT MOSS.

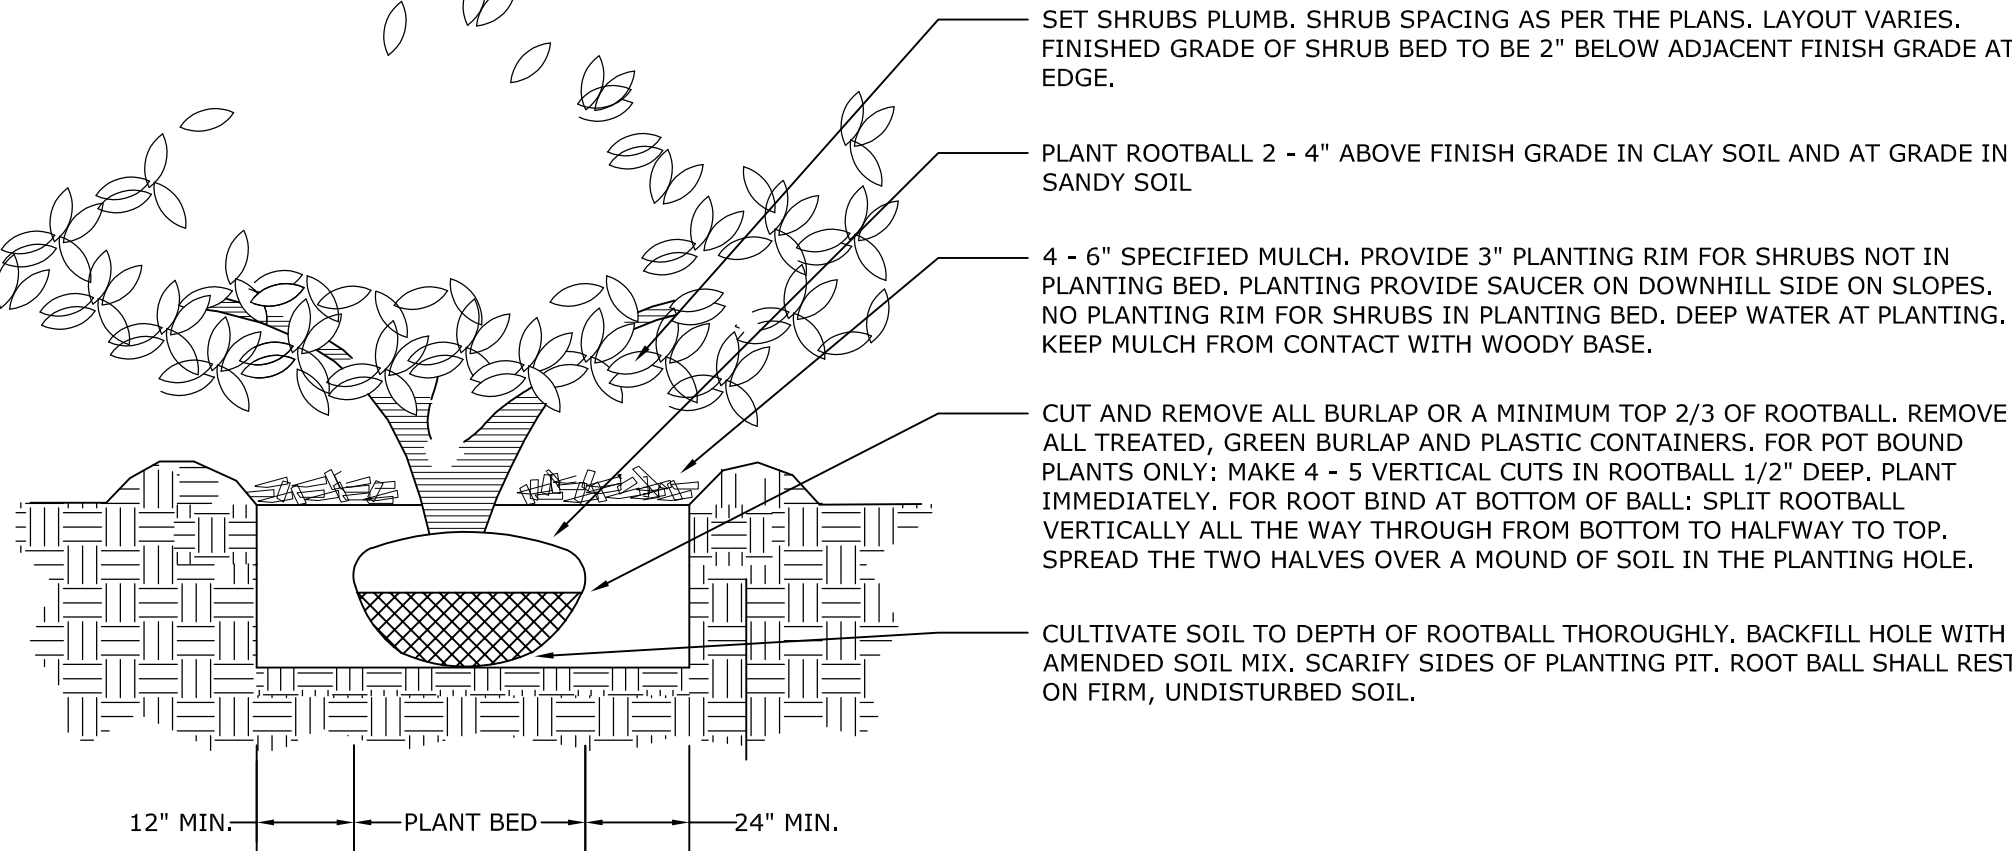


2
LS2 SHRUB PLANTING DETAIL
N.T.S.

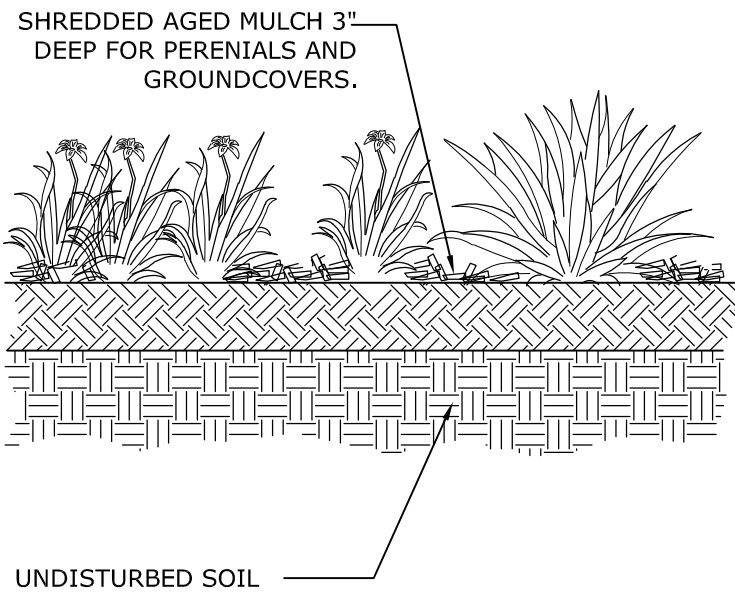


3
LS2 PERENNIAL/GROUND COVER PLANTING DETAIL
N.T.S.

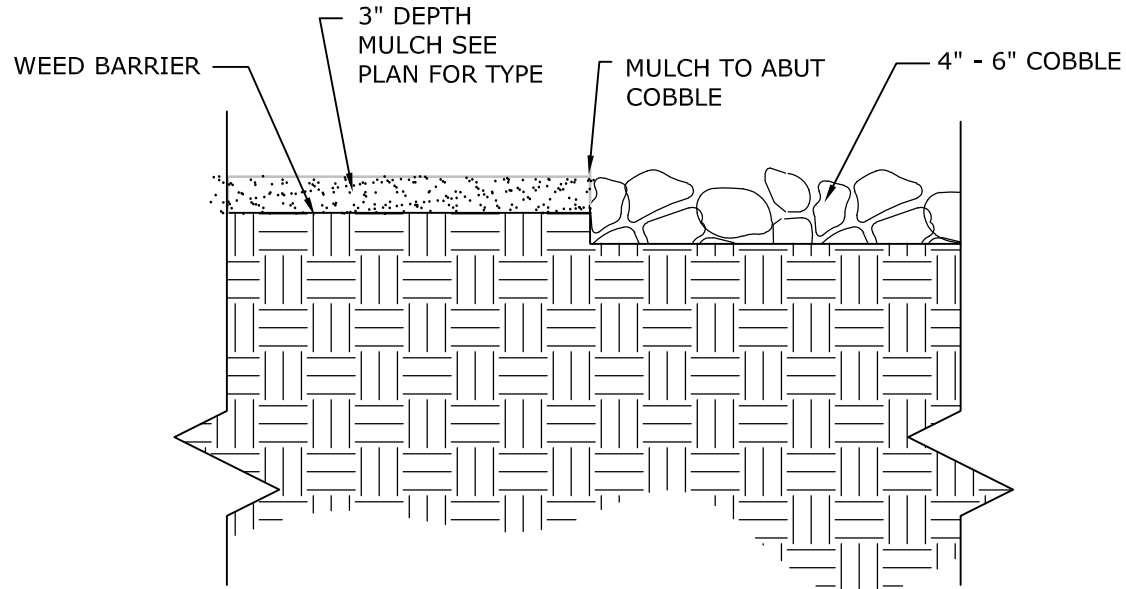

4
LS2 COBBLE @ MULCH
N.T.S.

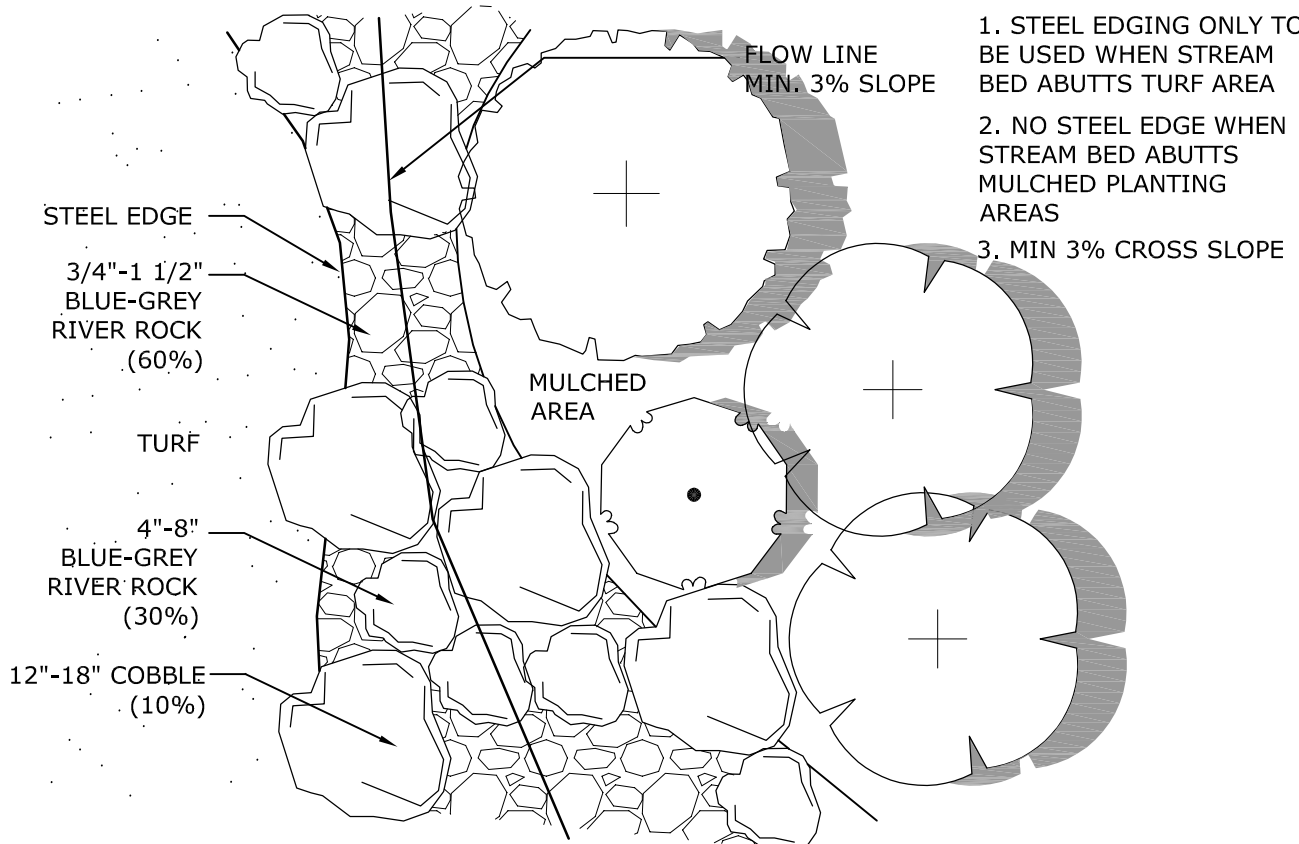


5
LS2 TYPICAL STREAM BED
N.T.S.

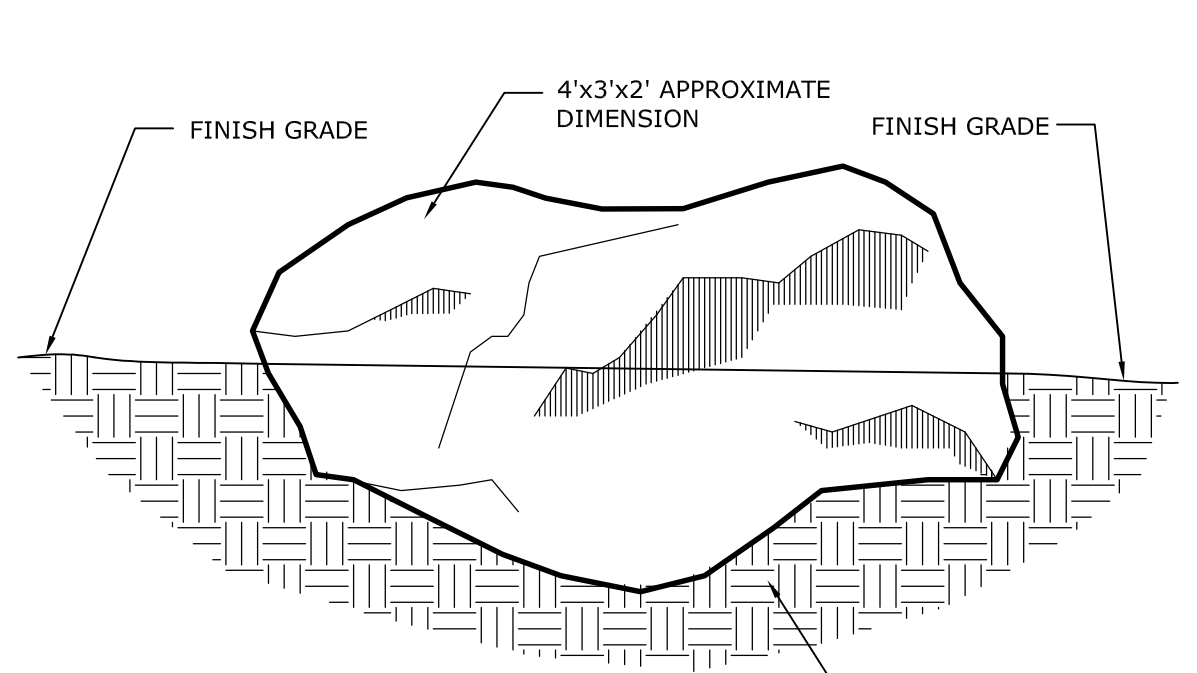

NOTE:
1/3 TO 1/2 OF ROCK SHALL BE BURIED

6
LS LANDSCAPE BOULDER
N.T.S.

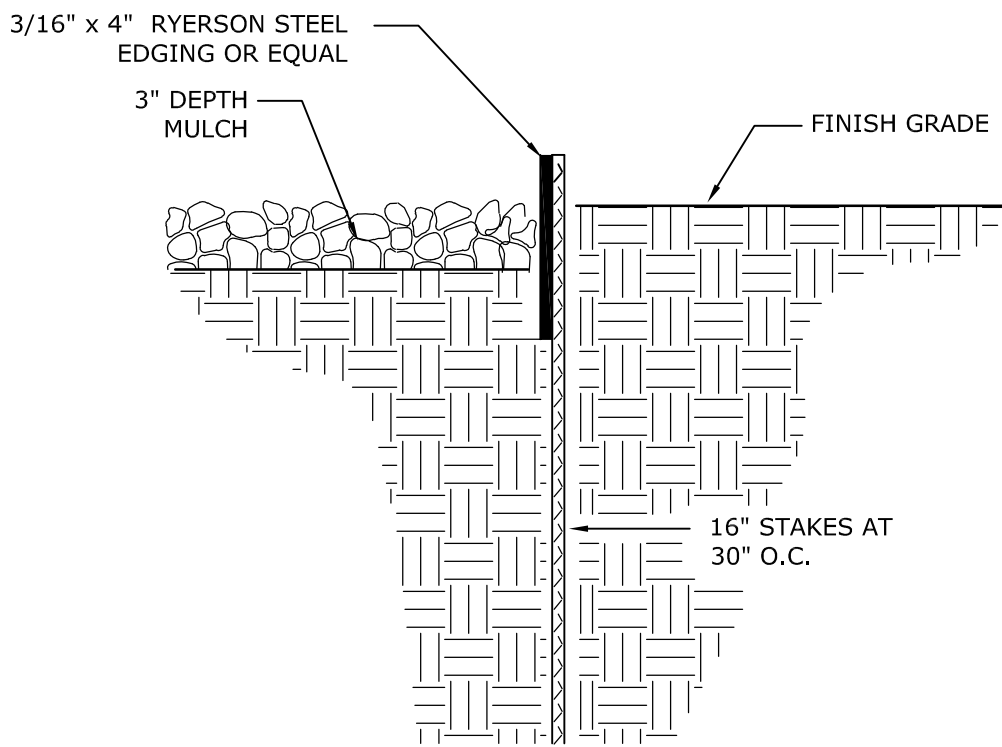

7
LS2 STEEL EDGE DETAIL
N.T.S.


PLANT SCHEDULE

TREES	CODE	QTY	BOTANICAL NAME / COMMON NAME	WIDTH	COND	SIZE
	GI	4	Gleditsia triacanthos inermis `Sunburst` / Sunburst Common Honeylocust	20-30`	B & B	1.5" Cal.
	MC	3	Malus x `Coralcole` TM / Coralburst Crab Apple	10-15`	B & B	1.5" Cal.
	PN	7	Prunus nigra `Princess Kay` / Princess Kay Plum	15`	B & B	1.5" Cal.
SHRUBS	CODE	QTY	BOTANICAL NAME / COMMON NAME	WIDTH	COND	SIZE
	CRG	12	Cornus alba `Red Gnome` / Tatarian Dogwood	3-5`	CONT.	5 GAL
	JSB	23	Juniperus sabina `Buffalo` / Buffalo Juniper	4-6`	CONT.	5 GAL
	Pod	11	Physocarpus opulifolius `Diablo` / Diablo Ninebark	8`	CONT.	5 GAL
PERENNIALS	CODE	QTY	BOTANICAL NAME / COMMON NAME	WIDTH	COND	SIZE
	Ach	23	Aquilegia chrysantha / Golden Columbine	2-3`	CONT.	1 GAL
	Cru	15	Centranthus ruber / Red Valerian	2-3`	CONT.	1 GAL
	HmA	27	Hemerocallis x `Autumn Red` / Autumn Red Daylily	3`	CONT.	1 GAL
GRASSES	CODE	QTY	BOTANICAL NAME / COMMON NAME	WIDTH	COND	SIZE
	CO	53	Calamagrostis x acutiflora `Overdam` / Overdam Feather Reed Grass	2-3`	CONT.	1 GAL
	Hse	56	Helictotrichon sempervirens / Blue Oat/Blue Avena	2-3`	CONT.	1 GAL

Contractor :

COPYRIGHT 2017 LGA STUDIOS. THIS DOCUMENT AND ITS CONTENTS ARE THE PROPERTY OF AND MAY NOT BE REPRODUCED WITHOUT THE WRITTEN PERMISSION OF LGA STUDIOS. ALL RIGHTS RESERVED.

Michael W. Hentschel RA, CSI
MWH & ASSOCIATES
Consulting Architectural Services
Larry Gillard, LEED AP, CSI, CPBD
201 East Las Animas Street, Suite 113
Colorado Springs, CO 80903
Office: (719) 594-8880
Fax: (719) 594-2088
LGAstudiosmailbox@gmail.com
www.lgastudios.com

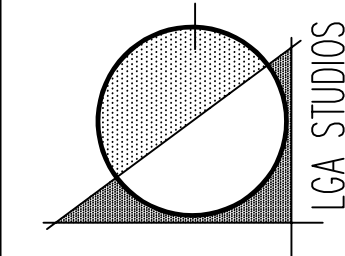

JACKSON Office Warehouse
Storage Buildings SDP
8140 SANDY COURT
COLORADO SPRINGS, COLORADO 80915

Project No. LGS17-1523

File No.

Drawn:


Checked:

Issued:

Revisions:

Markup Summary

#003300 (1)

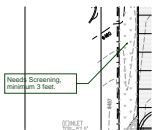

Subject: Callout
Page Label: 1
Lock: Locked
Status:
Checkmark: Unchecked
Author: dsdkendall
Date: 12/29/2017 9:08:28 AM
Color:
Layer:
Space:

Needs Screening, minimum 3 feet.