


NO:	REVISIONS

JAC
Drafting Services

719-498-8214
J. Elliott
12218 Crystal Downs Rd.

**MAIN LEVEL (BASEMENT)
FOR
MASTER PLAN**

DATE: 3/19/18
SCALE: AS SHOWN
JOB NO.: 1000
SHEET:
A 3.0

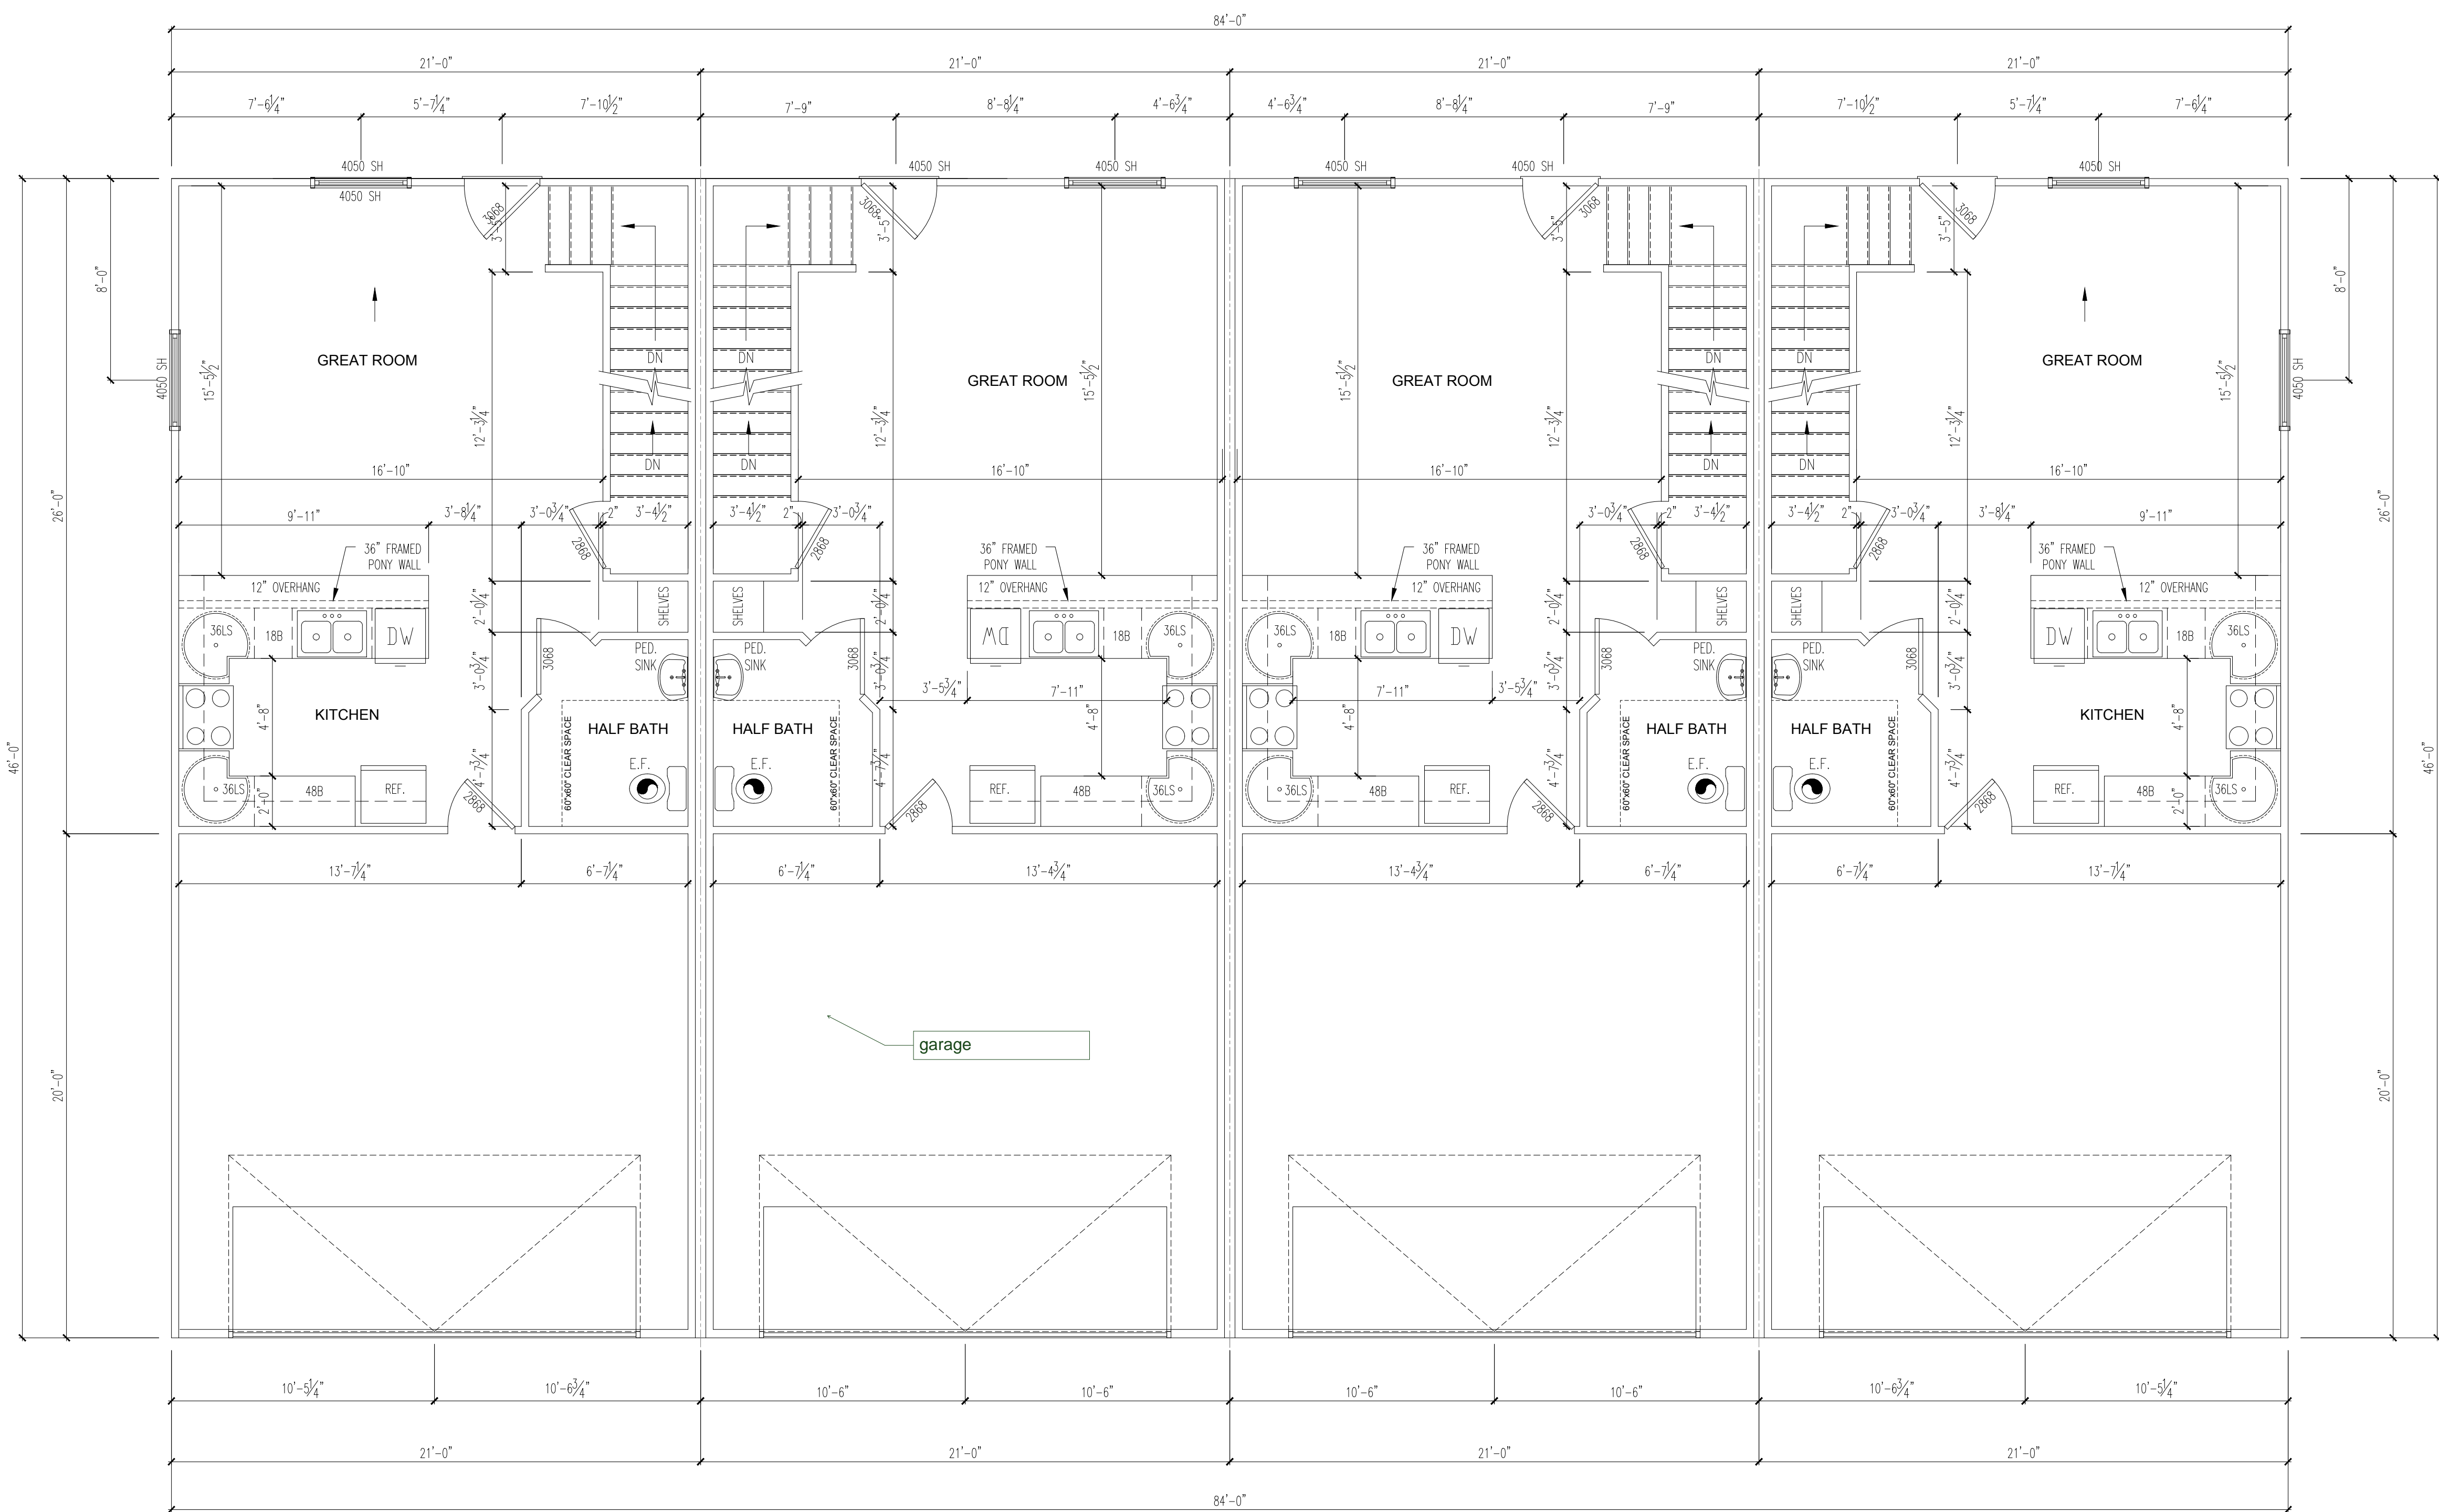

SQUARE FOOTAGE(BASEMENT MODEL)


MAIN FLOOR: 541
UPPER FLOOR: 960

TOTAL LIVING: 1990


U/F BSMT: 489

2 CAR GARAGE: 416


MAIN LEVEL

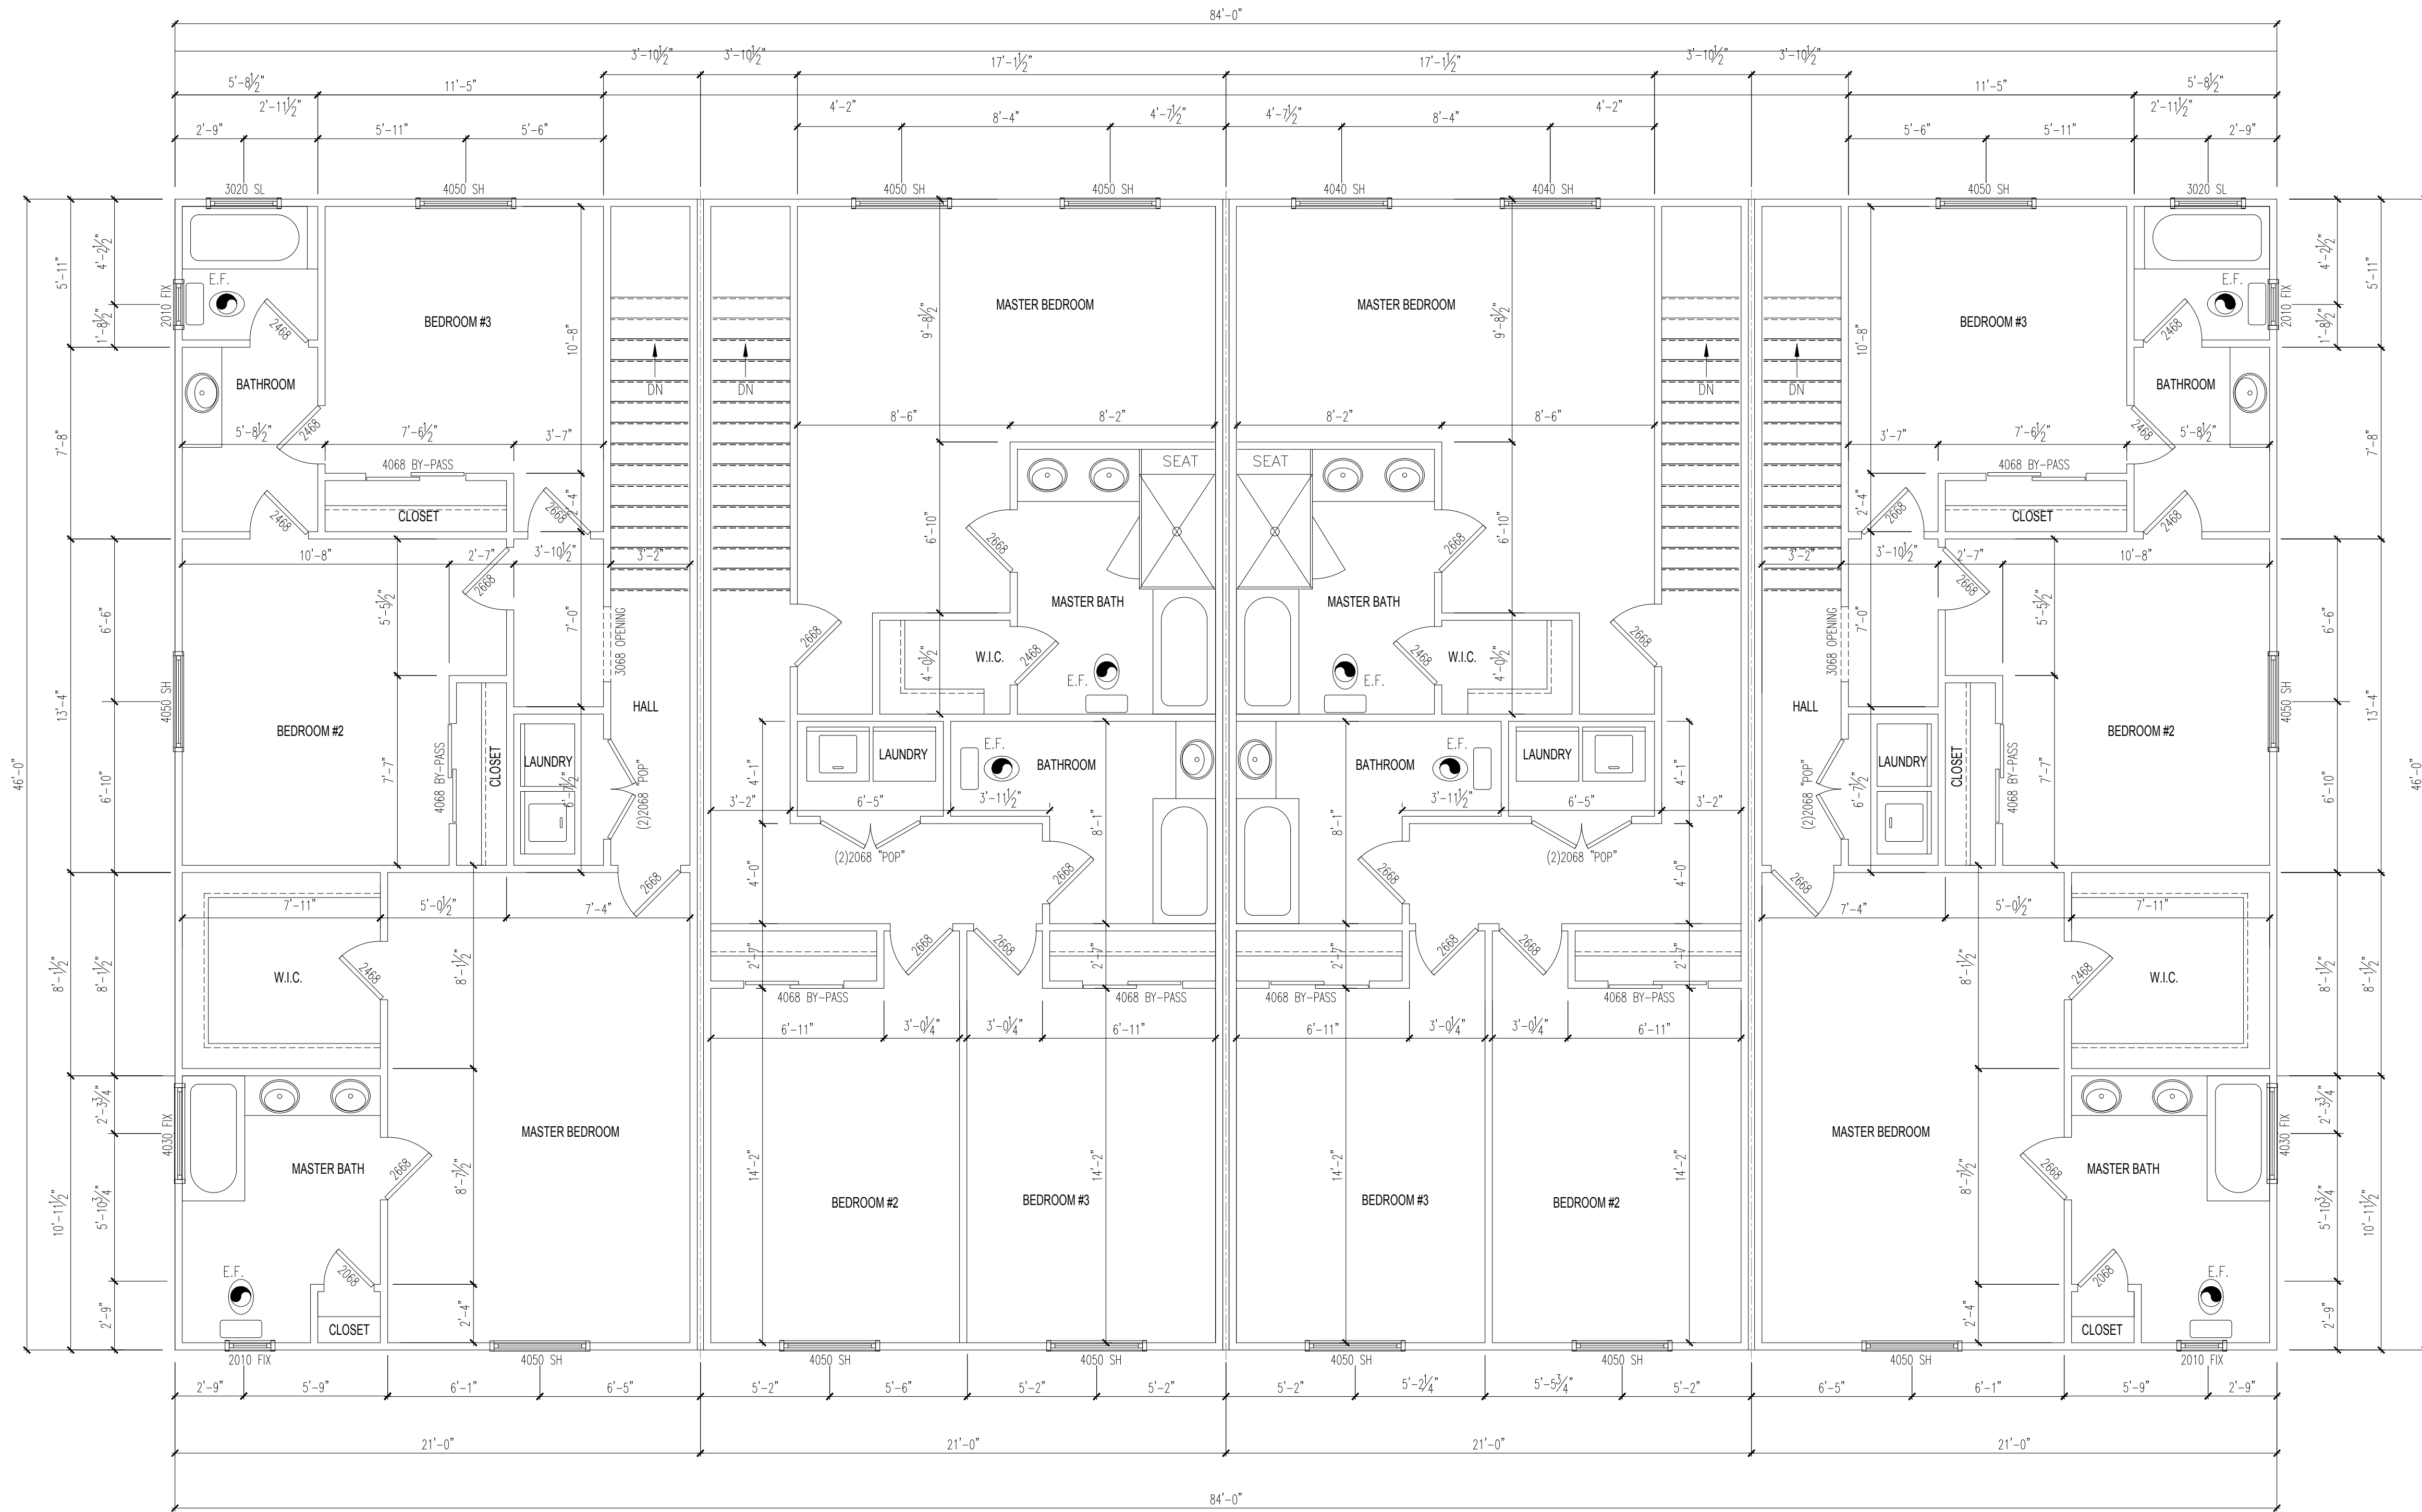

UPPER LEVEL

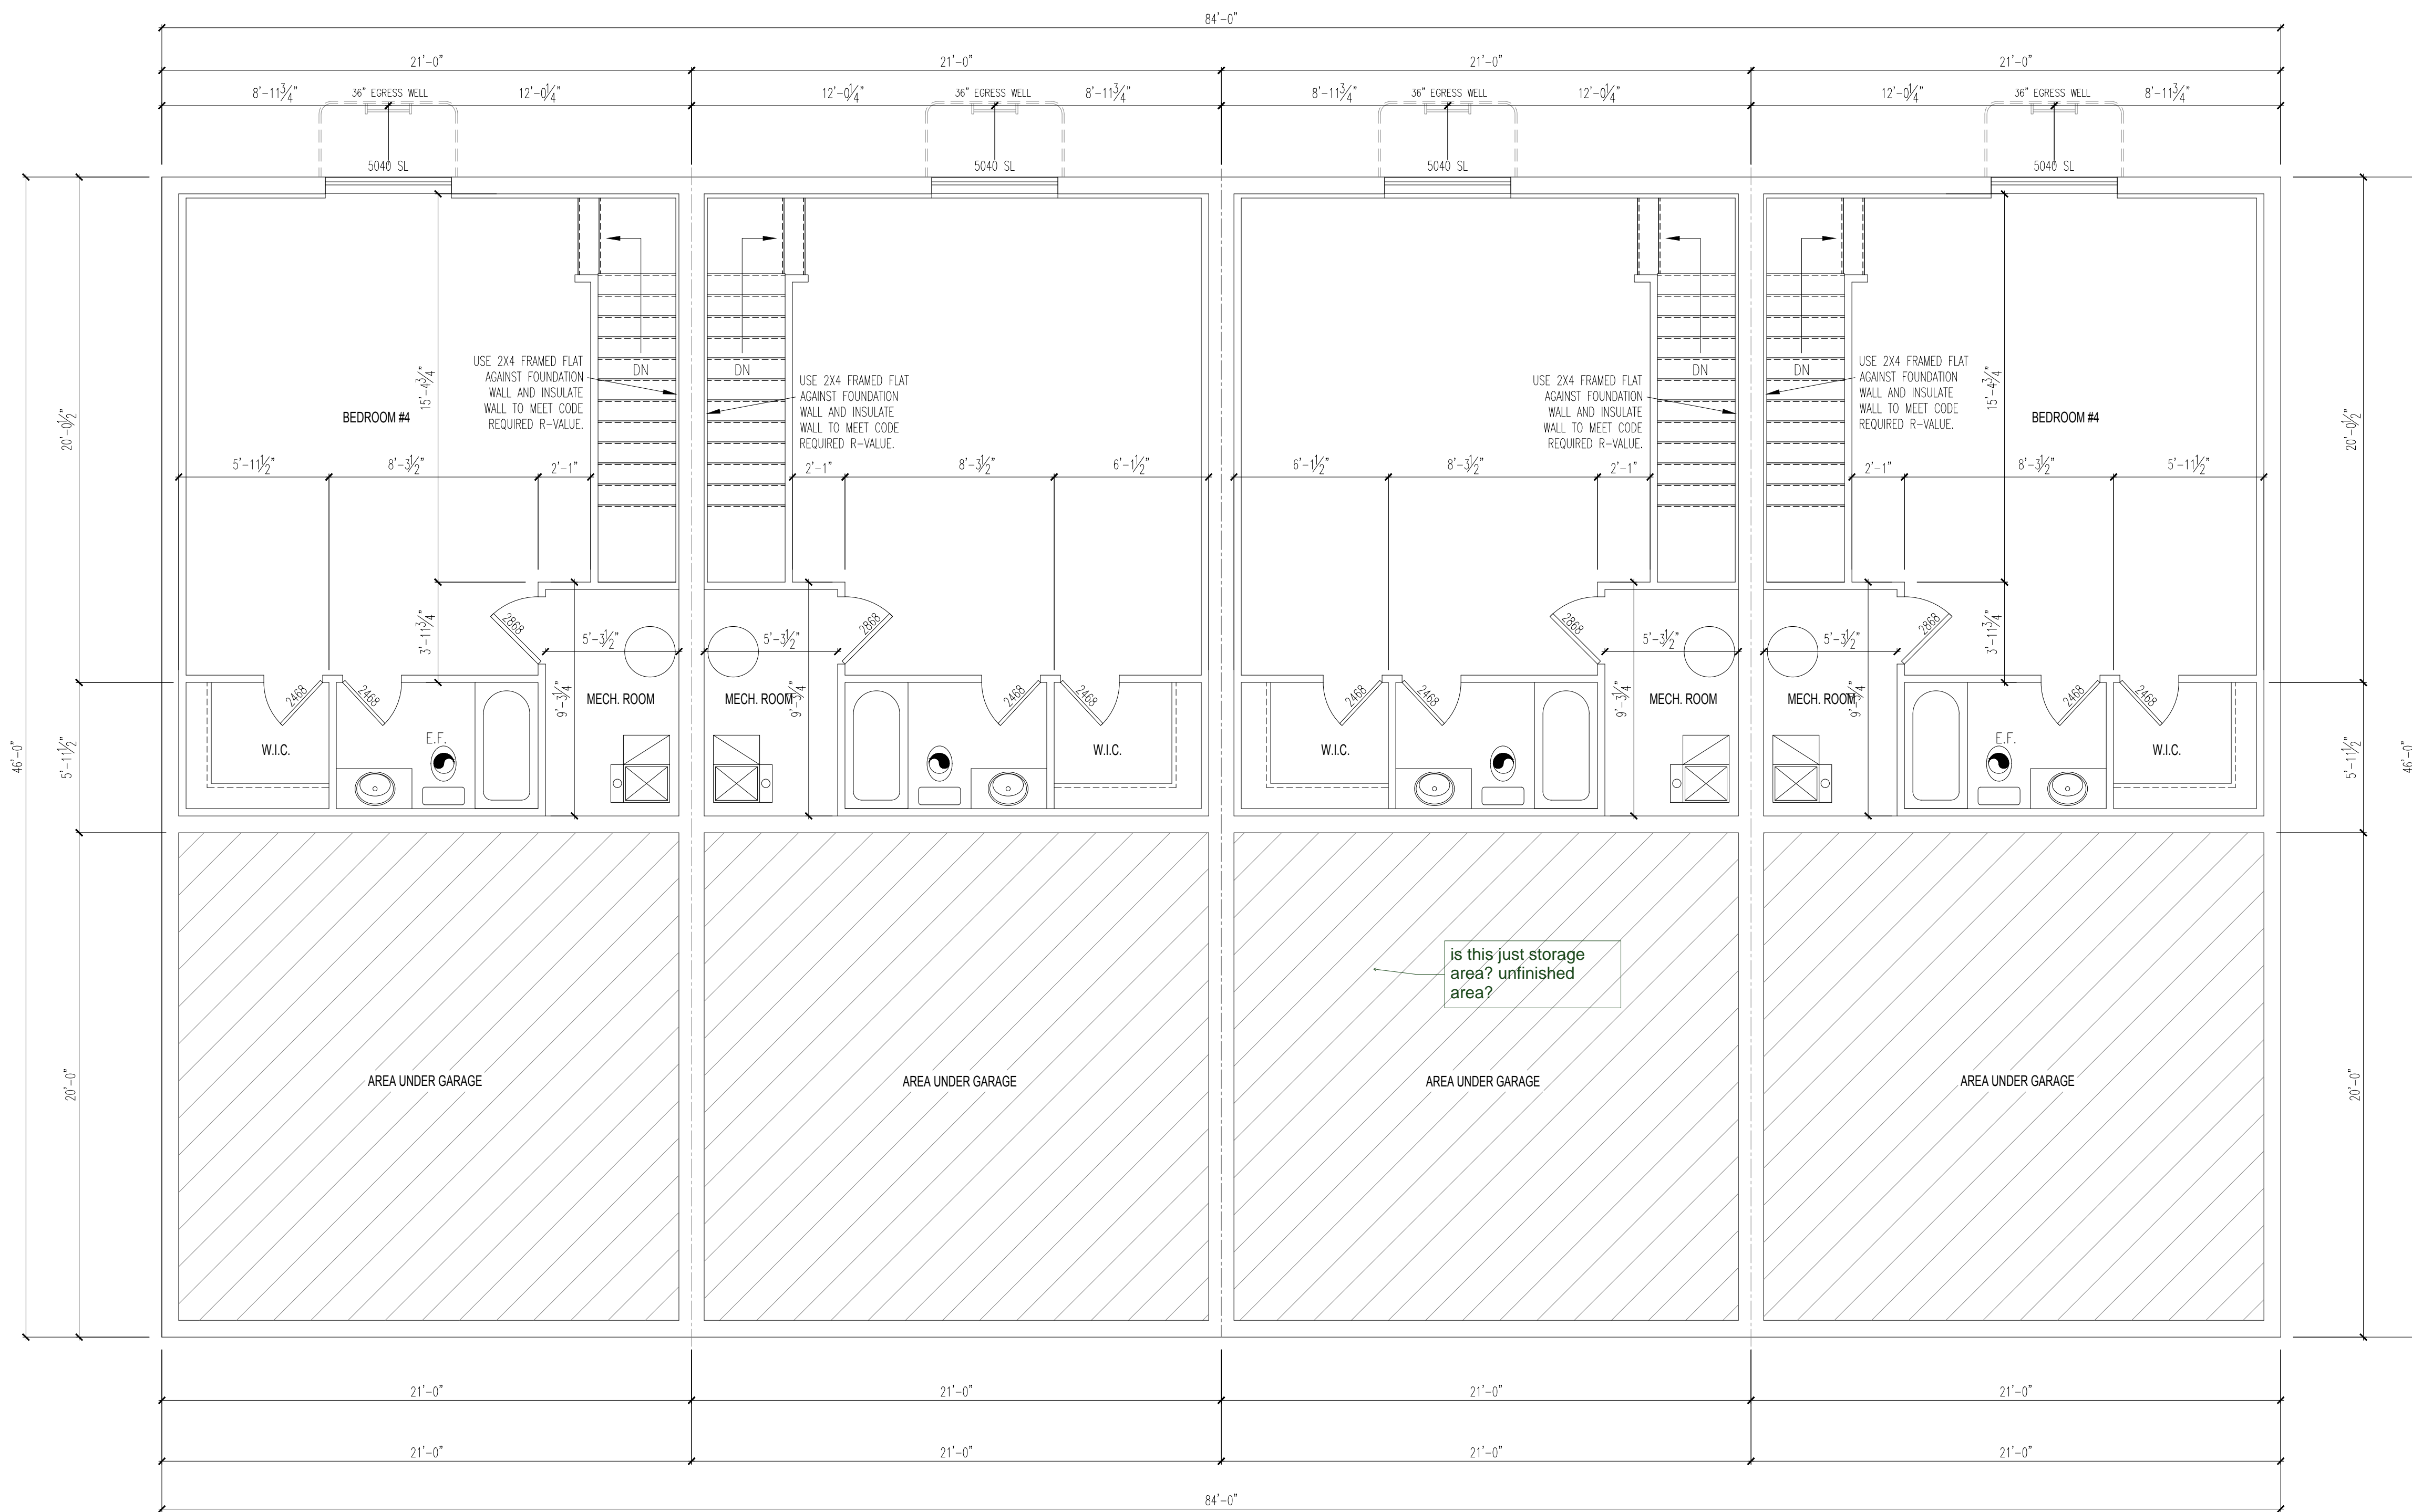

BASEMENT LEVEL

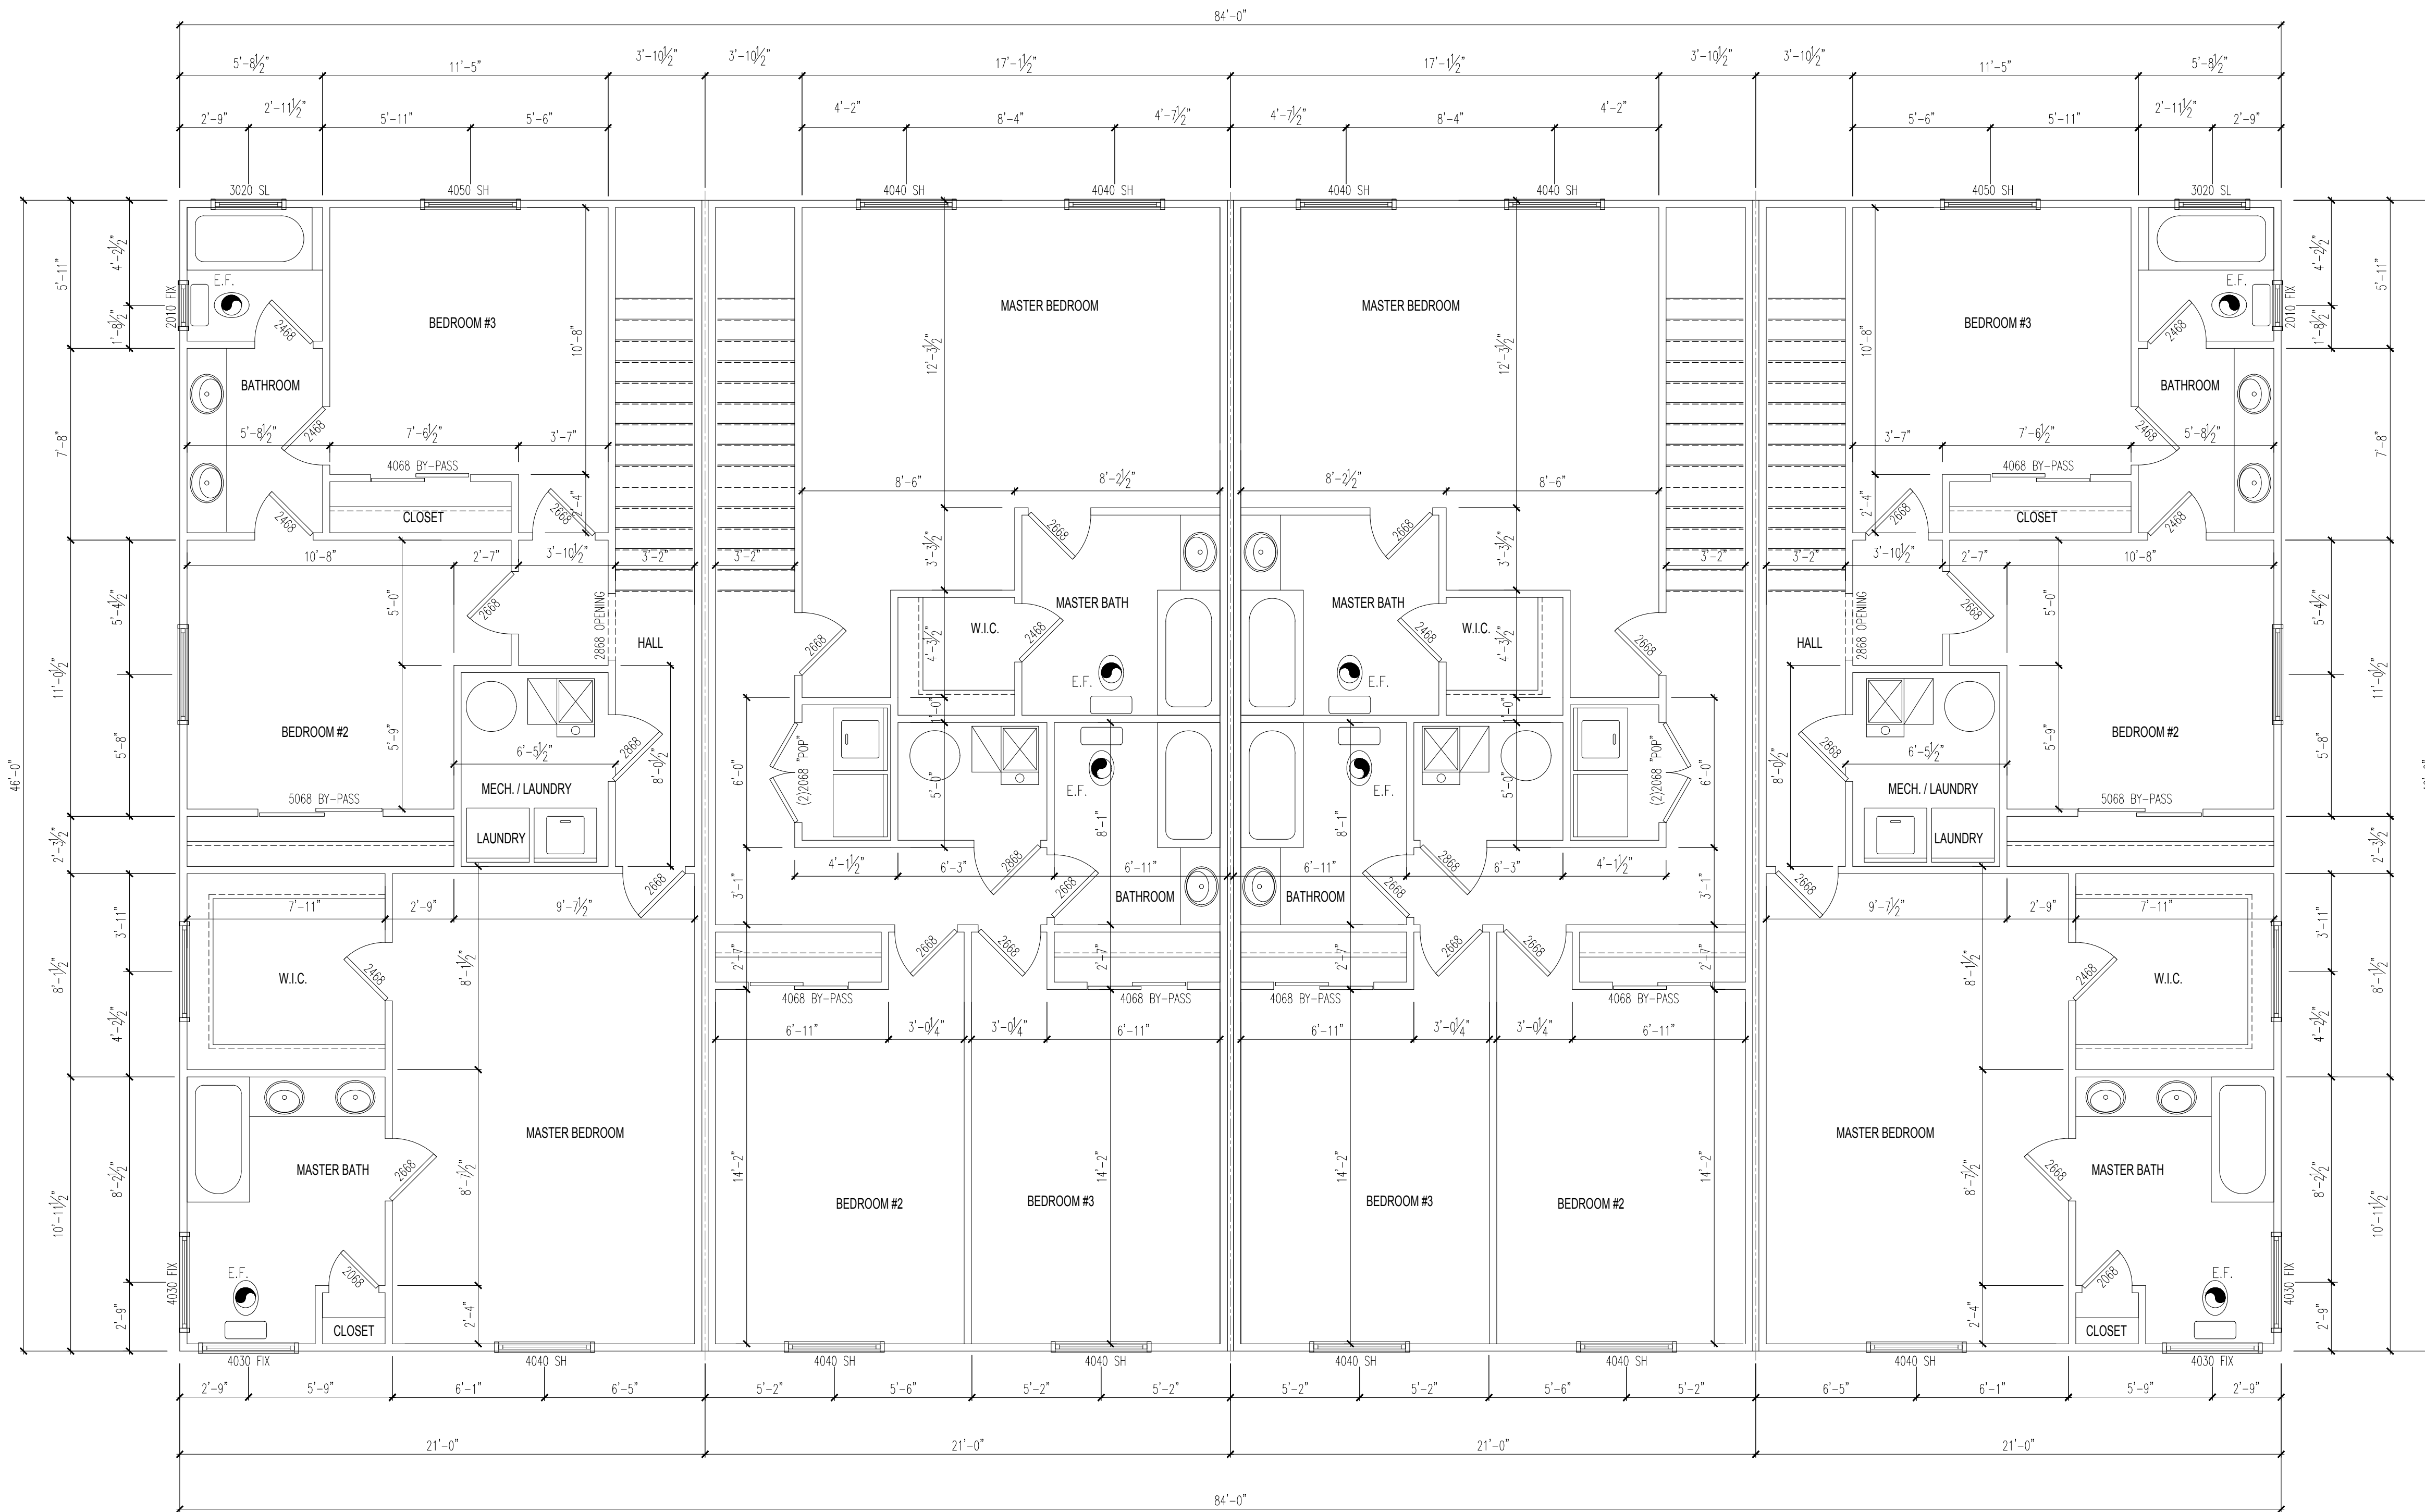


label different unit
Types (all sheets)

UPPER LEVEL (SLAB)

which buildings are
which unit types?



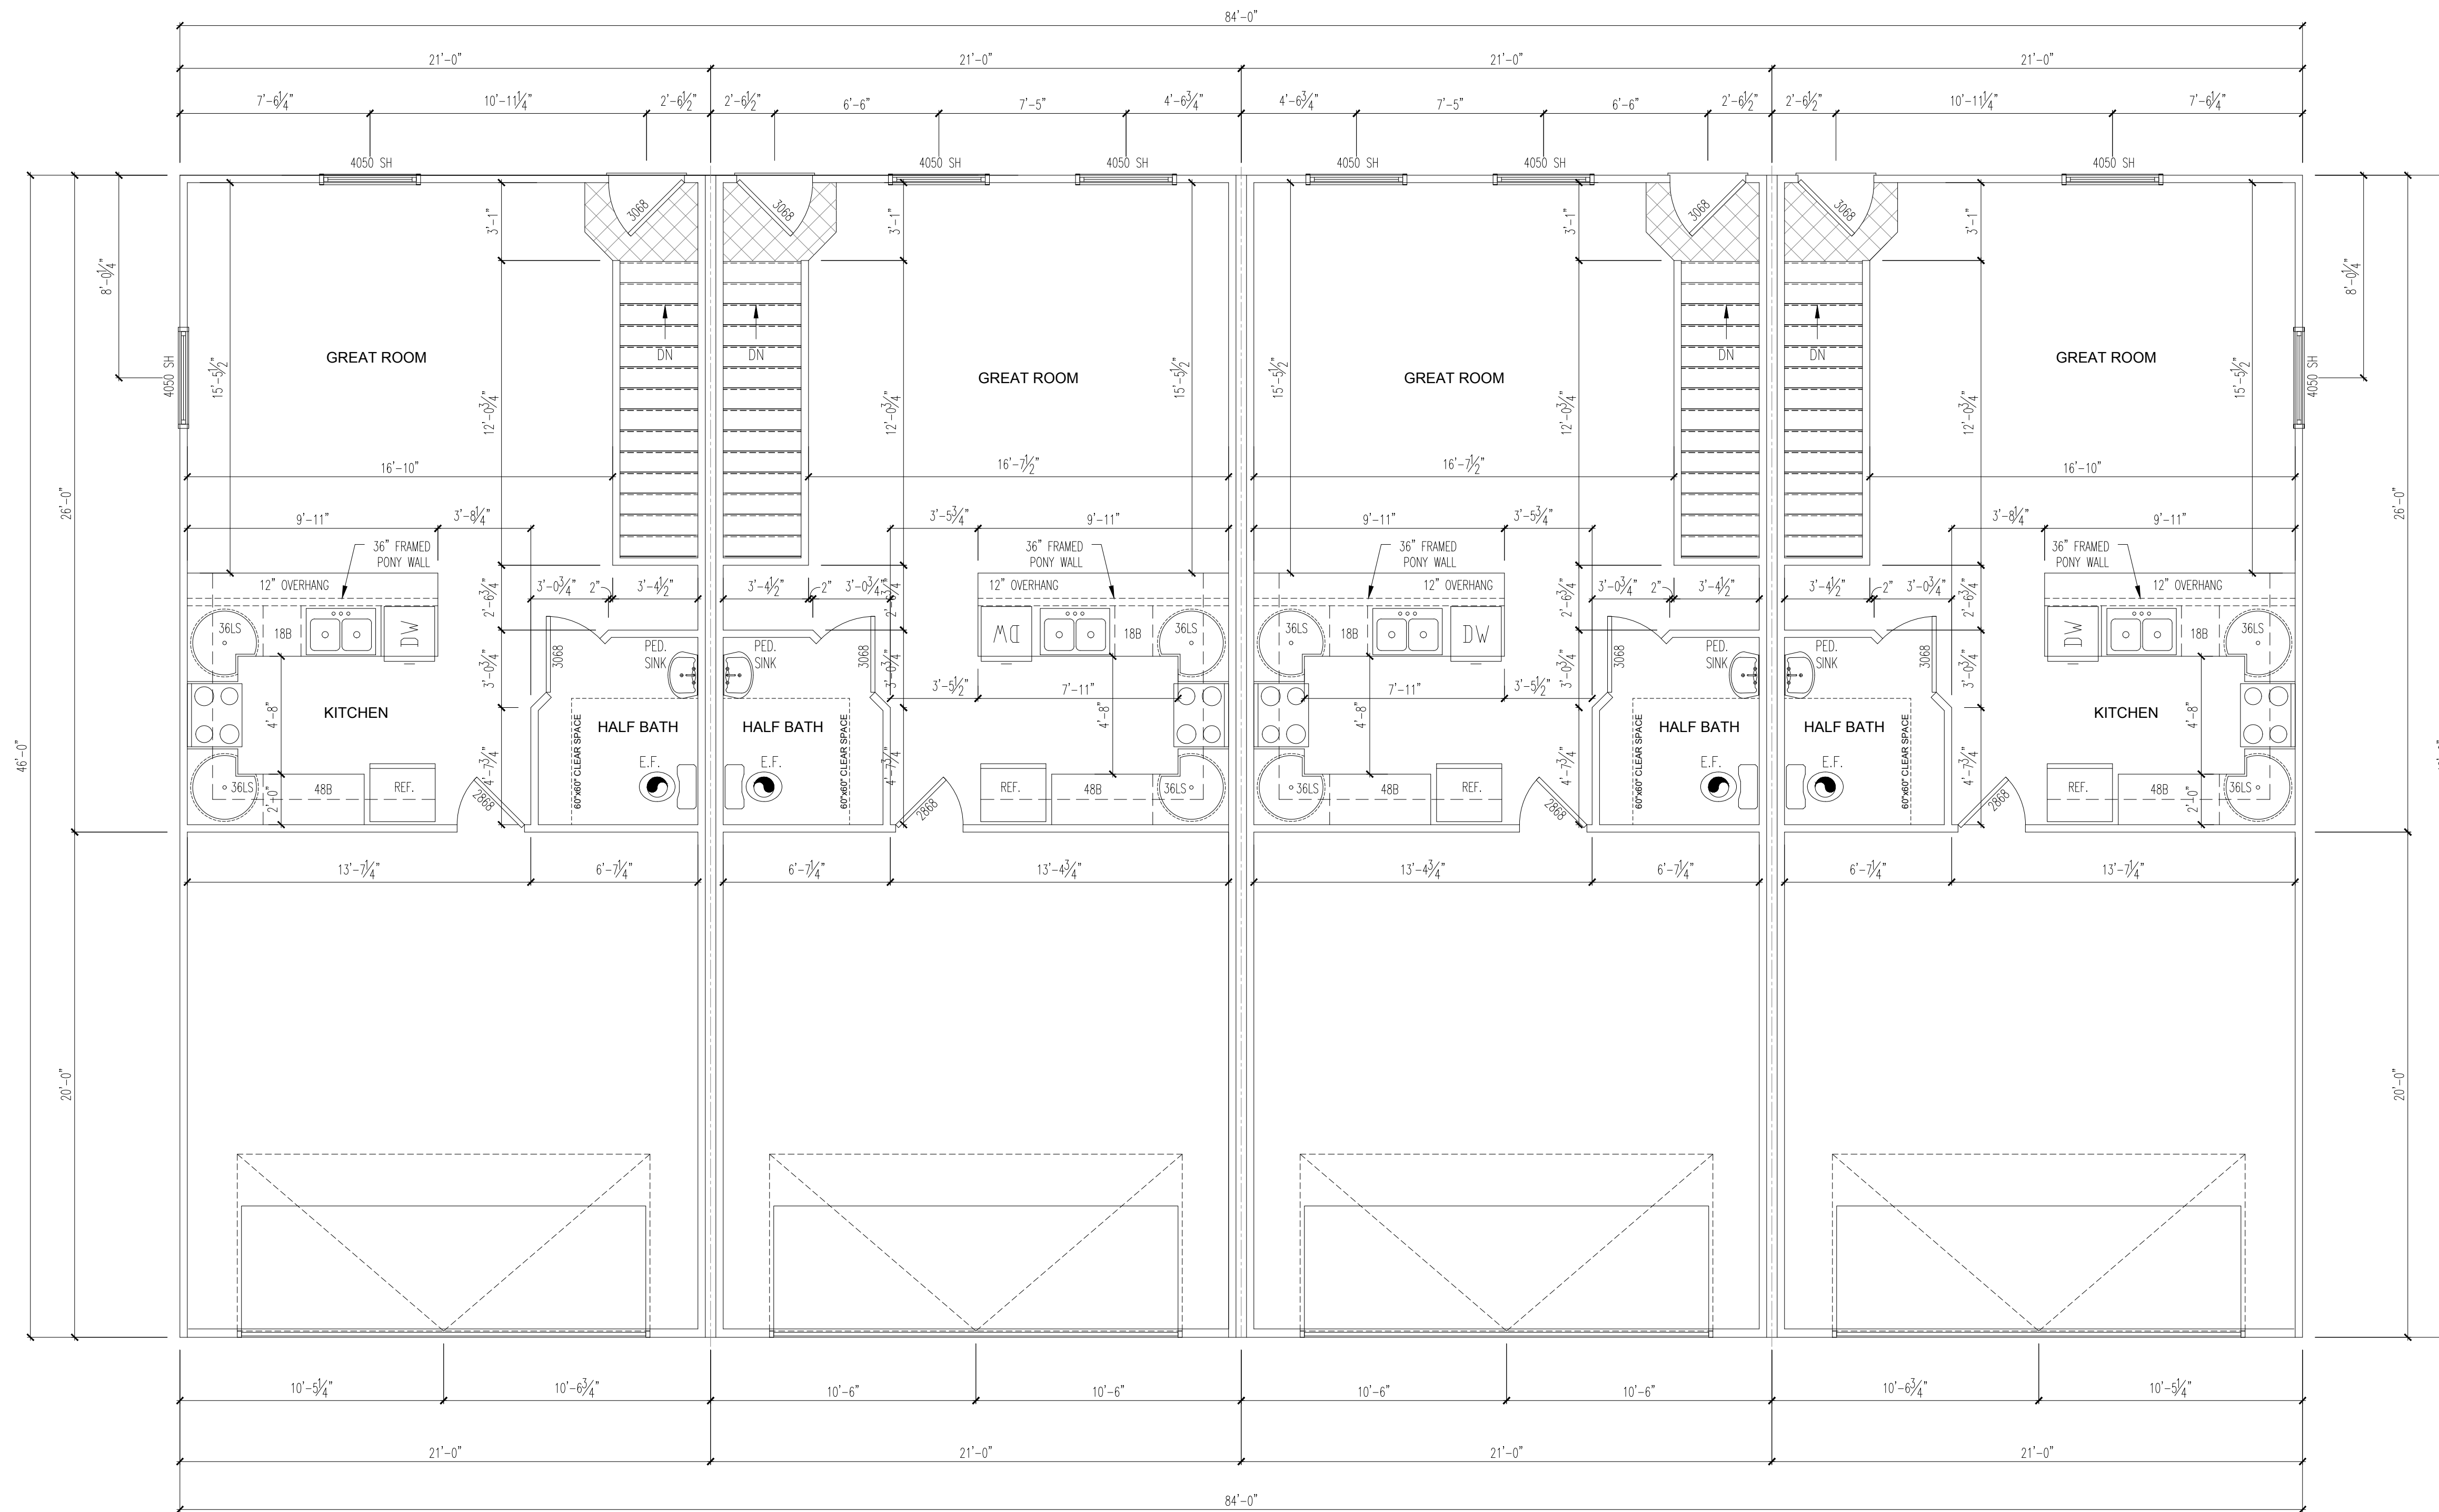

MAIN LEVEL (SLAB)

SQUARE FOOTAGE(SLAB MODEL)

MAIN FLOOR: 541
 UPPER FLOOR: 960
 TOTAL LIVING: 1501
 2 CAR GARAGE: 416


Markup Summary

Callout (4)




Subject: Callout
Page Label: 1
Author: dsdparsons
Date: 11/7/2018 11:06:13 AM
Color: ■

garage

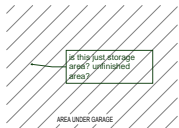


Subject: Callout
Page Label: 3
Author: dsdparsons
Date: 11/7/2018 11:07:41 AM
Color: ■

is this just storage area? unfinished area?

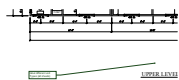

Subject: Callout
Page Label: 4
Author: dsdparsons
Date: 11/7/2018 11:09:07 AM
Color: ■

 label different unit Types (all sheets)



Subject: Callout
Page Label: 4
Author: dsdparsons
Date: 11/7/2018 11:09:25 AM
Color: ■

which buildings are which unit types?