

THIS DRAWING CONTAINS MATERIAL & INFORMATION WHICH MAY NOT BE REPRODUCED WITHOUT WRITTEN CONSENT OF HAMMERS CONSTRUCTION, INC. THESE DRAWINGS ARE INTENDED TO BE USED ONLY BY HAMMERS CONSTRUCTION & ITS REPRESENTATIVES. THESE DRAWINGS HAVE NOT BEEN PREPARED FOR ANY OTHER PURPOSE THAN TO INDICATE THE GENERAL FEATURES AND PLACEMENT OF THE PROPOSED PROJECT. COPYRIGHT © 2018 HAMMERS CONSTRUCTION


**PAD-3**  
**PADMARK BUSINESS PARK - LOT 3**  
 1190 MEADOWBROOK PKWY  
 COLORADO SPRINGS, CO 80915  
 EL PASO COUNTY, COLORADO

**McShea Consulting, LLC**  
 MECHANICAL • ELECTRICAL • PLUMBING  
 4445 Northpark Dr. Suite 200  
 Colorado Springs, CO 80907  
 mcshconsulting.com

90% REVIEW SET; NOT FOR CONSTRUCTION

DATE: SEPT. 20, 2018  
 DRAWN BY: C.C.F.  
 PROJ. MNR: Z. CRABTREE  
 SCALE: SEE PLAN  
 APPROVED BY:  
 JOB NO: 18-937

RESUBMITTALS:  
 ▲  
 ▲  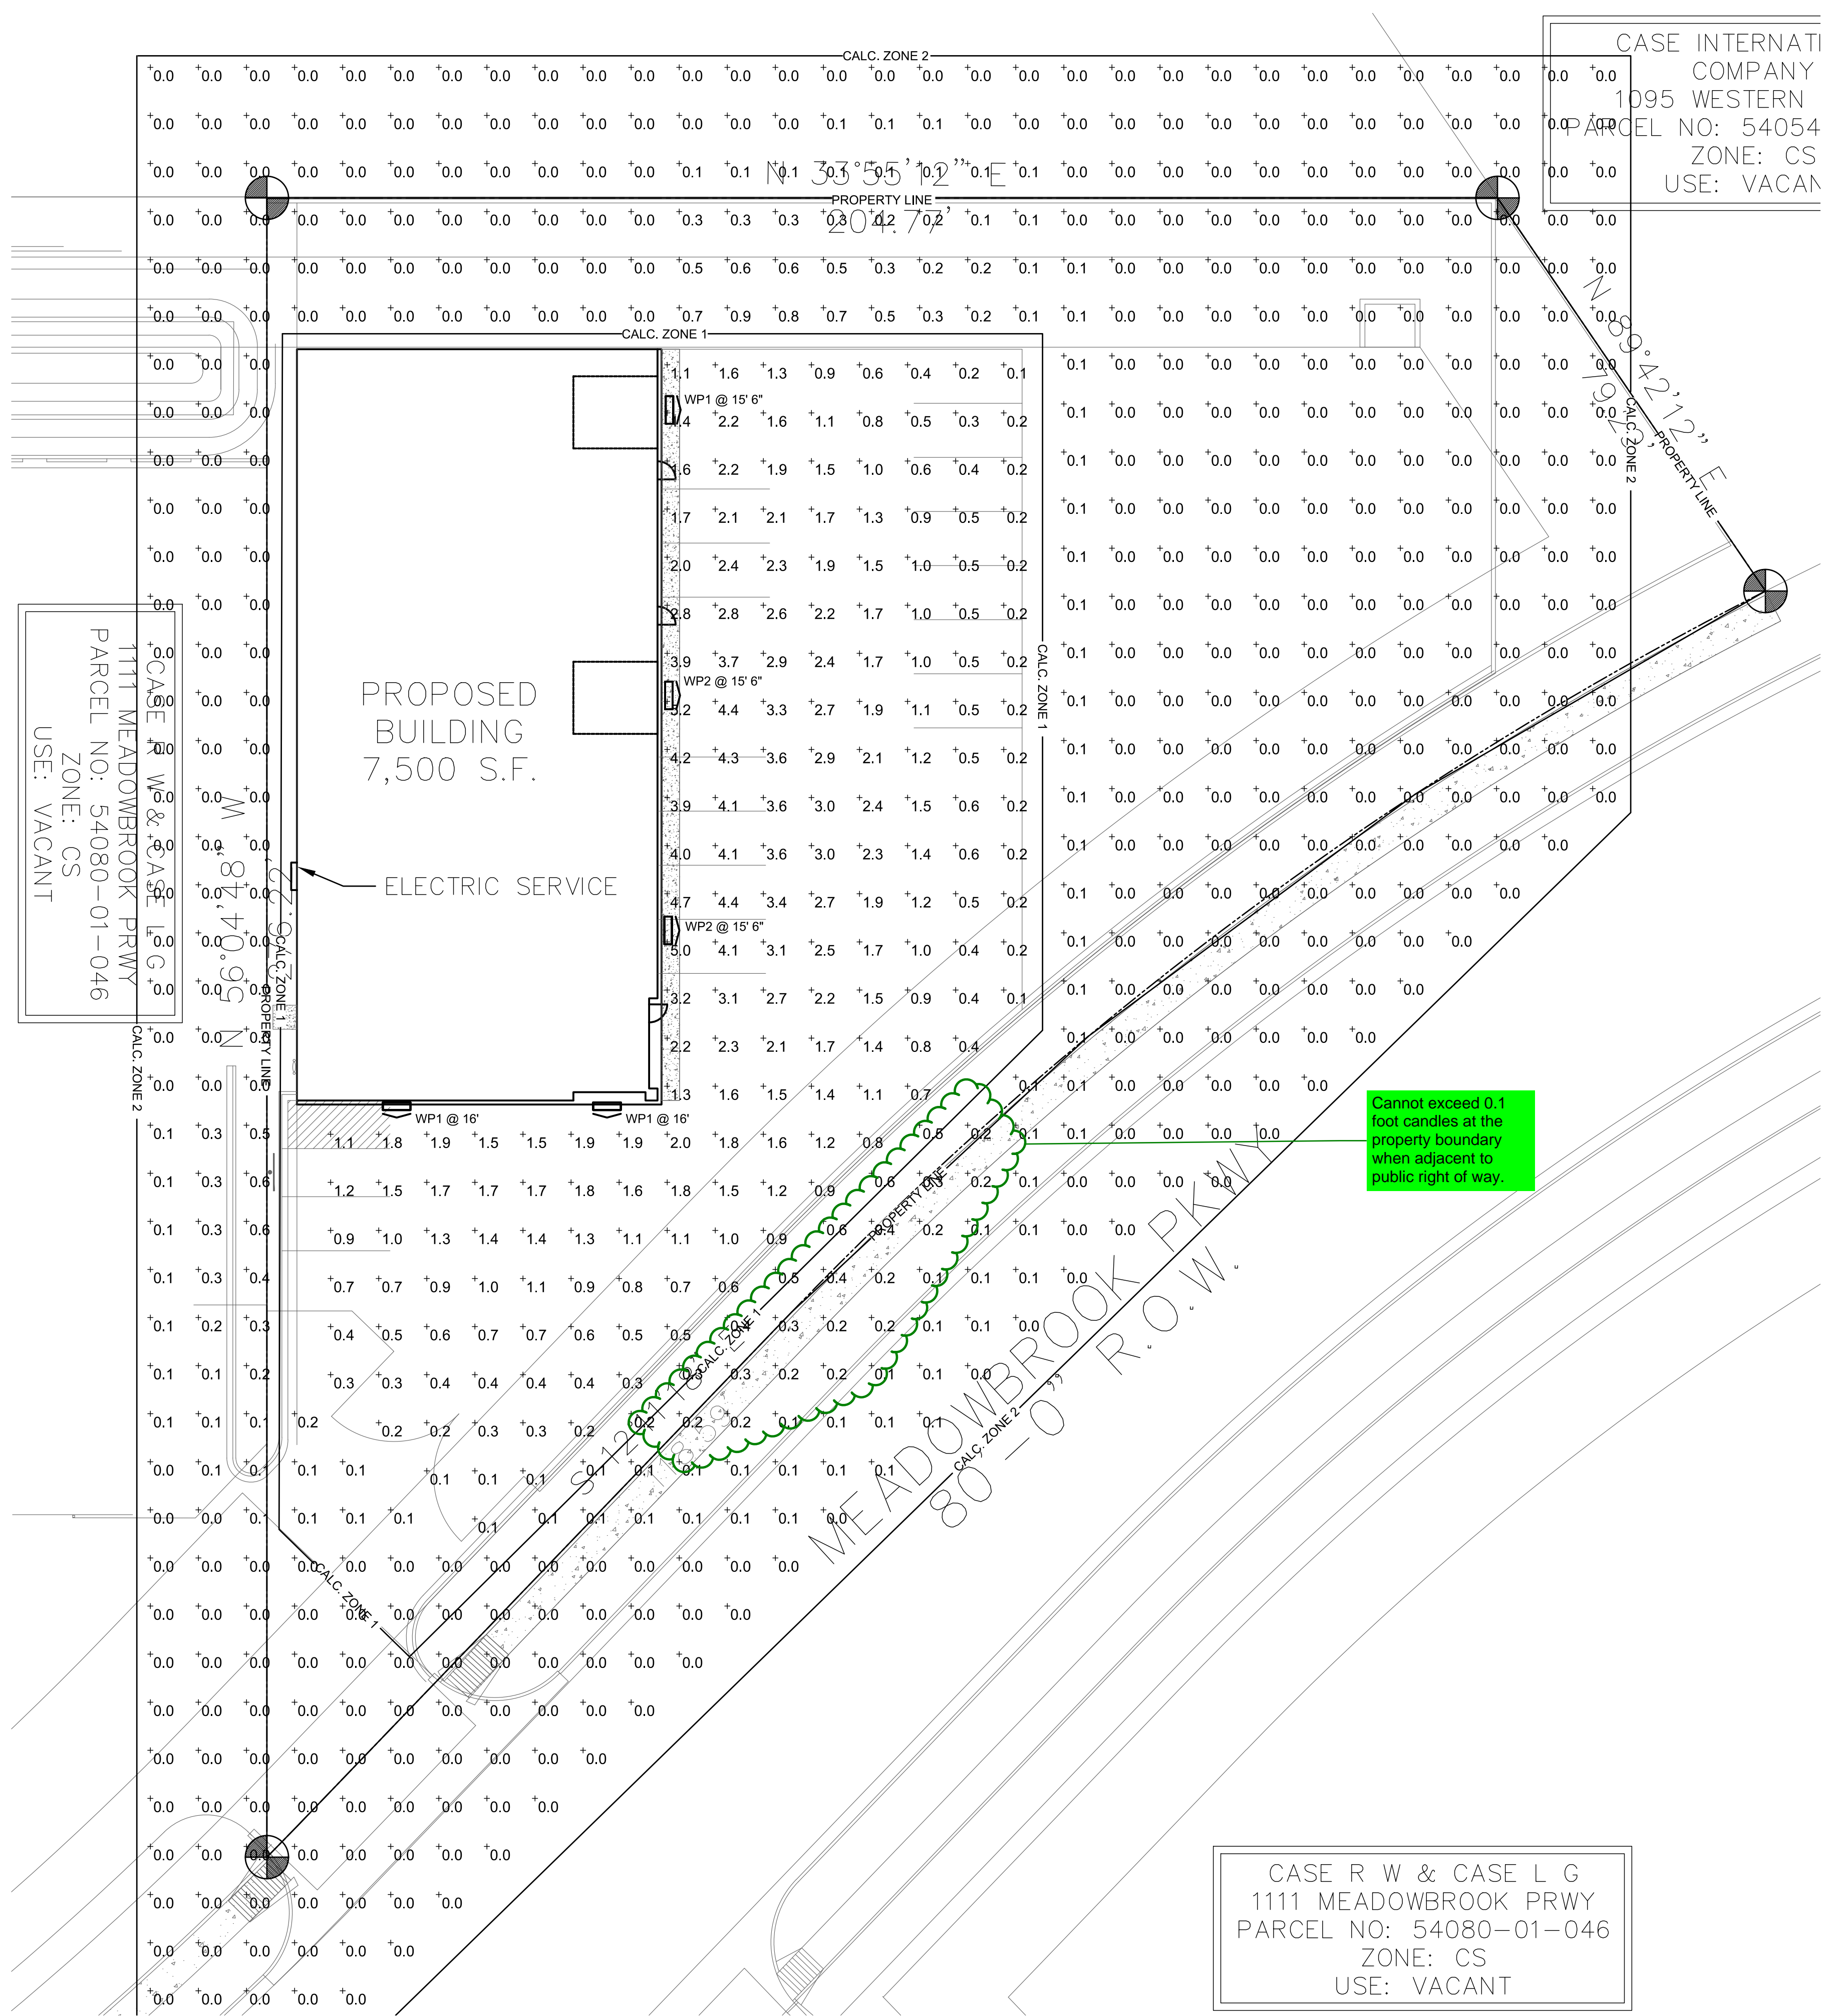
CASE INTERNATI  
 COMPANY  
 1095 WESTERN  
 PARCEL NO: 54054  
 ZONE: CS  
 USE: VACAN

CASE R W & CASE L G  
 1111 MEADOWBROOK PRWY  
 PARCEL NO: 54080-01-046  
 ZONE: CS  
 USE: VACANT

CASE R W & CASE L G  
 1111 MEADOWBROOK PRWY  
 PARCEL NO: 54080-01-046  
 ZONE: CS  
 USE: VACANT



2 DSXW2 LED AREA LUMINAIRE  
 8 NOT TO SCALE

CALCULATION ZONE 1 STATISTICS					
DESCRIPTION	SYMBOL	AVERAGE	MAXIMUM	MINIMUM	AVG/MIN
CALCULATION ZONE	+	1.5 fc	5.2 fc	0.1 fc	15.0:1


CALCULATION ZONE 2 STATISTICS					
DESCRIPTION	SYMBOL	AVERAGE	MAXIMUM	MINIMUM	AVG/MIN
CALCULATION ZONE	+	0.0 fc	0.9 fc	0.0 fc	N/A

1 PHOTOMETRIC SITE PLAN  
 8 SCALE: 1/16" = 1'-0"



# Markup Summary

dskendall (1)

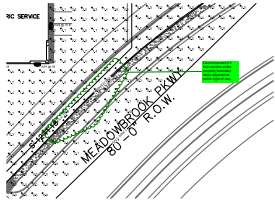

**Subject:** Cloud+  
**Page Label:** [4] Padmark Lot 3 - Electrical - 082718-ES-1  
**Lock:** Unlocked  
**Author:** dskendall  
**Date:** 10/5/2018 3:04:15 PM  
**Color:** ■

Cannot exceed 0.1 foot candles at the property boundary when adjacent to public right of way.