#### KNOW ALL MEN BY THESE PRESENTS:

THAT CHALLENGER COMMUNITIES, L.L.C., A COLORADO LIMITED LIABILITY COMPANY; AS THEIR INTERESTS MAY APPEAR BEING THE OWNER OF THE FOLLOWING DESCRIBED TRACT OF LAND:

#### LEGAL DESCRIPTION:

PARCELS OF LAND AS DESCRIBED IN WARRANTY DEEDS RECORDED AT RECEPTION NO. 219074560 AND 219074561 OF THE EL PASO COUNTY CLERK AND RECORDER OFFICE, BEING A PORTION OF THE WEST HALF OF SECTION 1, TOWNSHIP 13 SOUTH, RANGE 65 WEST, OF THE 6<sup>TH</sup> PRINCIPAL MERIDIAN, LOCATED IN EL PASO COUNTY, STATE OF COLORADO, BEING MORE PARTICULARLY DESCRIBED AS FOLLOWS:

#### BASIS OF BEARINGS:

ALL BEARINGS ARE GRID BEARINGS OF THE COLORADO STATE PLANE COORDINATE SYSTEM, CENTRAL ZONE, NORTH AMERICAN DATUM 1983. THE BEARING OF THE LINE BETWEEN THE SOUTHWEST CORNER OF SECTION 1, T13S, R65W AND THE WEST QUARTER CORNER OF SECTION 1, T13S, R65W IS N0013'46'W AND MONUMENTED AS SHOWN:

COMMENCING AT THE SOUTHWEST QUARTER CORNER OF SAID SECTION 1; THENCE NOO"13'46"W WITH THE WEST LINE OF SAID SECTION 1, A DISTANCE OF 1928.67 FEET TO THE SOUTHWEST CORNER OF A PARCEL DESCRIBED IN WARRANTY DEED RECORDED AT RECEPTION NO. 21303554 OF THE EL PASO COUNTY CLERK AND RECORDER OFFICE; THENCE WITH THE SOUTH LINE OF SAID PARCEL, N89°47'22"E A DISTANCE OF 419.98 FEET TO THE SOUTHEAST CORNER OF SAID PARCEL AND BEING THE SOUTHWEST CORNER OF A STRIP OF LAND DESCRIBED IN QUIT CLAIM DEED AT RECEPTION NO. 209061972 AND ALSO BEING THE POINT OF BEGINNING:

THENCE NOO"13'46"W, A DISTANCE OF 206.47 FEET TO A POINT OF CURVATURE; THENCE ALONG SAID CURVE TO THE RIGHT, HAVING A RADIUS OF 605.00 FEET, A CENTRAL ANGLE OF 23°58'12", A DISTANCE OF 253.10 FEET, A CHORD BEARING OF N11°45'20"E WITH A CHORD DISTANCE OF 251.26 FEET;

THENCE N23'44'26"E, A DISTANCE OF 301.49 FEET TO A POINT OF CURVATURE; THENCE ALONG SAID CURVE TO THE RIGHT, HAVING A RADIUS OF 605.00 FEET, A CENTRAL ANGLE OF 65°45'45", A DISTANCE OF 694.40 FEET, A CHORD BEARING OF N56°37'18"E WITH A CHORD DISTANCE OF 656.91 FEET; THENCE N89°30'12"E, A DISTANCE OF 62.90 FEET;

THENCE NO0"14'14"W, A DISTANCE OF 938.90 FEET TO A POINT ON THE SOUTH LINE OF THE MEADOWS FILING NO. 3, RECORDED AT RECEPTION NO. 200135677 AND ALSO BEING A POINT ON THE SOUTH LINE OF THE NORTH 1/16TH OF SAID SECTION 1; THENCE WITH SAID SOUTH LINE, N89°36'34"E, A DISTANCE OF 1431.39 FEET TO THE NORTH 1/16TH CORNER OF SAID SECTION 1;

THENCE N89°36'02"E, A DISTANCE OF 28.34 FEET; THENCE S00°22'19"E, DISTANCE OF 619.54 FEET TO A POINT ON THE NORTH RIGHT OF WAY LINE OF BENT GRASS MEADOWS DRIVE (AN 80' PUBLIC RIGHT OF WAY) AND BEING A POINT ON THE NORTH LINE OF BENT GRASS RESIDENTIAL FILING NO. 1, RECORDED AT RECEPTION NO. 215713636;

THENCE WITH SAID NORTH RIGHT OF WAY LINE AND THE NORTH LINE OF SAID BENT GRASS RESIDENTIAL FILING NO.1, S89°38'09"W, A DISTANCE OF 28.48 FEET TO THE NORTHWEST CORNER OF SAID BENT GRASS MEADOWS DRIVE RIGHT OF WAY AND BEING A POINT ON THE EAST 1/16 LINE OF SAID SECTION 1;

THENCE WITH SAID EAST 1/16 LINE, SO0°21'34"E, A DISTANCE OF 699.51 FEET; THENCE CONTINUING WITH SAID EAST 1/16 LINE, SOO<sup>\*</sup>21'50"E, A DISTANCE OF 693.63 FEET TO THE NORTHEAST CORNER OF A PARCEL DESCRIBED IN DEED AT BOOK 3233, PAGE 824 OF THE EL PASO COUNTY CLERK & RECORDER; THENCE WITH THE NORTH OF LINE OF SAID PARCEL, S89'47'22"W, A DISTANCE OF

952.75 FEET TO THE NORTHWEST CORNER OF SAID PARCEL DESCRIBED IN BOOK 3233 AT PAGE 824: THENCE ALONG THE WEST LINE OF SAID PARCEL, SO0°22'01"E, A DISTANCE OF 18.25

FEET TO THE NORTHEAST CORNER OF A PARCEL DESCRIBED IN DEED AT RECEPTION NO. 208053974: THENCE WITH THE NORTH LINE OF SAID PARCEL DESCRIBED AT RECEPTION NO.

208053974, S89°47'22"W, A DISTANCE OF 179.94 FEET; THENCE NOO12'38"W, A DISTANCE OF 119.39 FEET TO A POINT OF CURVE; THENCE ALONG SAID CURVE TO THE LEFT, HAVING A RADIUS OF 450.00 FEET, A CENTRAL ANGLE OF 55°58'18", A DISTANCE OF 439.60 FEET, A CHORD BEARING OF N28"11'47"W WITH A CHORD DISTANCE OF 422.33 FEET;

THENCE N56"10'56"W, A DISTANCE OF 198.31 FEET TO A POINT OF CURVE; THENCE ALONG SAID CURVE TO THE RIGHT, HAVING A RADIUS OF 540.00 FEET, A CENTRAL ANGLE OF 16°06'20", A DISTANCE OF 151.79 FEET, A CHORD BEARING OF N48°07'46"W WITH A CHORD DISTANCE OF 151.29 FEET; THENCE N40°04'36"W, A DISTANCE OF 279.73 FEET TO A POINT OF NON-TANGENT

CURVE: THENCE ALONG SAID NON-TANGENT CURVE TO THE LFET, HAVING A RADIUS OF 525.00 FEET, A CENTRAL ANGLE OF 32°26'00", A DISTANCE OF 297.18 FEET, A CHORD

BEARING OF S39°57'26"W WITH A CHORD DISTANCE OF 293.23 FEET; THENCE S23°44'26"W. A DISTANCE OF 301.49 FEET TO A POINT OF CURVATURE: THENCE ALONG SAID CURVE TO THE LEFT, HAVING A RADIUS OF 525.00 FEET, A CENTRAL ANGLE OF 23°58'12", A DISTANCE OF 219.64 FEET, A CHORD BEARING OF S11°45'20"W WITH A CHORD DISTANCE OF 218.04 FEET; THENCE S00°13'46"E, A DISTANCE OF 206.50 FEET TO THE SOUTHEAST CORNER OF

SAID STRIP OF LAND DESCRIBED IN QUITCLAIM DEED AT RECEPTION NO. 209061972; THENCE WITH SOUTH LINE OF SAID STRIP OF LAND, S89°47'22"W, A DISTANCE OF 80.00 FEET TO THE POINT OF BEGINNING.

THE ABOVE DESCRIBED PARCEL CONTAINS 2,985,862 SQUARE FEET OR 68.55 ACRES, MORE OR LESS.

#### DEDICATION:

THE ABOVE OWNER HAS CAUSED SAID TRACT TO BE PLATTED INTO LOTS, TRACTS, PUBLIC RIGHT OF WAY AND EASEMENTS AS SHOWN HEREON. THE UNDERSIGNED DOES HEREBY GRANT AND CONVEY TO THE COUNTY OF EL PASO ALL STREETS AND EASEMENTS FOR PUBLIC USE. THIS TRACT OF LAND HEREIN PLATTED SHALL BE KNOWN AS **"BENT GRASS RESIDENTIAL, FILING NO 2"**, IN THE COUNTY OF EL PASO COUNTY, COLORADO.

#### **OWNERS CERTIFICATE:**

THE UNDERSIGNED, BEING ALL THE OWNERS, MORTGAGEES, BENEFICIARIES OF DEEDS OF TRUST AND HOLDERS OF OTHER INTERESTS IN THE LAND DESCRIBED HEREIN, HAVE LAID OUT, SUBDIVIDED, AND PLATTED SAID LANDS INTO LOTS AND EASEMENTS AS SHOWN HEREON UNDER THE NAME AND SUBDIVISION OF BENT GRASS RESIDENTIAL FILING NO. 2. ALL PUBLIC IMPROVEMENTS SO PLATTED ARE HEREBY DEDICATED TO PUBLIC USE AND SAID OWNER DOES HEREBY COVENANT AND AGREE THAT THE PUBLIC IMPROVEMENTS WILL BE CONSTRUCTED TO EL PASO COUNTY STANDARDS AND THAT PROPER DRAINAGE AND EROSION CONTROL FOR SAME WILL BE PROVIDED AT SAID OWNER'S EXPENSE, ALL TO THE SATISFACTION OF THE BOARD OF COUNTY COMMISSIONERS OF EL PASO COUNTY, COLORADO. UPON ACCEPTANCE BY RESOLUTION, AL PUBLIC IMPROVEMENTS SO DEDICATED WILL BECOME MATTERS OF MAINTENANCE BY EL PASO COUNTY, COLORADO. THE UTILITY EASEMENTS SHOWN HEREON ARE HEREBY DEDICATED FOR PUBLIC UTILITIES AND COMMUNICATION SYSTEMS AND OTHER PURPOSES AS SHOWN HEREON. THE ENTITIES RESPONSIBLE FOR PROVIDING THE SERVICES FOR WHICH THE EASEMENTS ARE ESTABLISHED ARE HEREBY GRANTED THE PERPETUAL RIGHT OF INGRESS AND EGRESS FROM AND TO ADJACENT PROPERTIES FOR INSTALLATION, MAINTENANCE, AND REPLACEMENT OF UTILITY LINES AND RELATED FACILITIES.

CHALLENGER COMMUNITIES, LLC, A COLORADO LIMITED LIABILITY COMPANY

BY:		 
DATE:		 
STATE OF CC COUNTY OF	DLORADO ) )ss.	

\_\_\_\_\_ AS \_\_\_\_\_

ACKNOWLEDGED BEFORE ME THIS \_\_\_\_\_ DAY OF \_\_\_\_\_, 2021 BY


MY COMMISSION EXPIRES \_\_\_\_\_

WITNESS MY HAND AND OFFICIAL SEAL

NOTARY PUBLIC

# BENT GRASS RESIDENTIAL FILING NO. 2

LOCATED IN THE NORTHWEST QUARTER AND SOUTHWEST QUARTER OF SECTION 1 T13S R65W OF THE 6TH PRINCIPAL MERIDIAN COUNTY OF EL PASO, STATE OF COLORADO

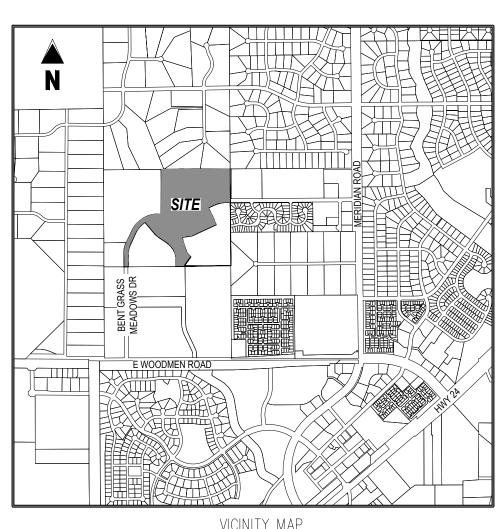

 $\frac{\text{VICINITY MAP}}{1"} = 2000'$ 

#### EASEMENTS:

UNLESS OTHERWISE INDICATED, ALL LOT LINES ARE HEREBY PLATTED WITH 5 FOOT SIDE, 10 FOOT FRONT, AND 7.5 FOOT REAR PUBLIC UTILITY AND DRAINAGE EASEMENT. ALL EXTERIOR SUBDIVISION BOUNDARIES ARE HEREBY PLATTED WITH A 20 FOOT PUBLIC UTILITY AND DRAINAGE EASEMENT. THE SOLE RESPONSIBILITY FOR MAINTENANCE OF THESE EASEMENTS IS HEREBY VESTED WITH THE INDIVIDUAL PROPERTY OWNERS.

SHEET INDEX SHEET 2 PLAT NOTES & TRACT TABLE OVERALL BOUNDARY & EXISTING EASEMENTS MAP SHEET 3 SHEET 4–6 LOT CONFIGURATION SHEET 7 CURVE TABLE

ACCEPTANCE CERTIFICATE FOR TRACTS: WOODMEN HILLS METROPOLITAN DISTRICT

THE DEDICATION OF TRACTS A, B, C, D, E, F, G, H, I, J, K, L AND M FOR THE PURPOSES SPECIFIED IN THE TRACT TABLE (SEE SHEET 2 OF 7) ARE HEREBY ACCEPTED FOR OWNERSHIP AND MAINTENANCE BY THE BENT GRASS METROPOLITAN DISTRICT.

BY: RANDLE CASE II, PRESIDENT, BENT GRASS METROPOLITAN DISTRICT

\_, EL PASO COUNTY

STATE OF COLORADO ) SS.

COUNTY OF \_\_\_\_\_)

ACKNOWLEDGED BEFORE ME THIS \_\_\_\_ DAY OF \_\_\_\_, 2021 BY \_\_\_\_\_ AS \_\_\_\_\_.

MY COMMISSION EXPIRES: \_\_\_\_\_

WITNESS MY HAND AND OFFICIAL SEAL

NOTARY PUBLIC

**RECORDING:** 

STATE OF COLORADO ) ss.

COUNTY OF EL PASO )

I HEREBY CERTIFY THAT THIS INSTRUEMENT WAS FILED FOR RECORD AT MY OFFICE AT \_\_\_\_\_O' CLOCK \_\_\_\_\_, THIS \_\_\_\_\_ DAY OF \_\_\_\_\_, 2021 A.D. AND IS DULY RECORDED UNDER RECEPTION NUMBER \_\_\_\_\_ OF THE RECORDS OF EL PASO COUNTY, COLORADO.

CHUCK BROERMAN, RECORDER

FEE: \_\_\_\_\_ BY: \_\_\_\_\_ DEPUTY

1155 Kelly Johnson Blvd, Suite 305 Colorado Springs, CO 80920 719.900.7220 GallowayUS.com

#### NOTICE:

ACCORDING TO COLORADO LAW YOU MUST COMMENCE ANY LEGAL ACTION BASED UPON ANY DEFECT IN THIS SURVEY WITHIN THREE YEARS AFTER YOU FIRST DISCOVER SUCH DEFECT. IN NO EVENT, MAY ANY ACTION BASED UPON ANY DEFECT IN THIS SURVEY BE COMMENCED MORE THAN TEN YEARS FROM THE DATE OF THE CERTIFICATION SHOWN HEREON.

ANY PERSON WHO KNOWINGLY REMOVES, ALTERS, OR DEFACES ANY PUBLIC LAND SURVEY MONUMENT, LAND BOUNDARY MONUMENT, OR ACCESSORY COMMITS A CLASS TWO (2) MISDEMEANOR, PURSUANT TO STATE STATUTE 18-4-508 OF THE COLORADO REVISED STATUTES.

#### BOARD OF COUNTY COMMISSIONERS CERTIFICATE:

THIS PLAT FOR BENT GRASS RESIDENTIAL FILING NO. 2 WAS APPROVED FOR FILING BY THE EL PASO COUNTY, COLORADO BOARD OF COUNTY COMMISSIONERS ON THE \_\_\_\_\_ DAY OF \_\_\_\_, 20\_, SUBJECT TO ANY NOTES SPECIFIED HEREON AND ANY CONDITIONS INCLUDED IN THE RESOLUTION OF APPROVAL. THE DEDICATIONS OF LAND TO THE PUBLIC STREETS AND EASEMENT ARE ACCEPTED, BUT PUBLIC IMPROVEMENTS THEREON WILL NOT BECOME THE MAINTENANCE RESPONSIBILITY OF EL PASO COUNTY UNTIL PRELIMINARY ACCEPTANCE OF THE PUBLIC IMPROVEMENTS IN ACCORDANCE WITH THE REQUIREMENTS OF THE LAND DEVELOPMENT CODE AND ENGINEERING CRITERIA MANUAL, AND THE SUBDIVISION IMPROVEMENTS AGREEMENT.

CHAIR, BOARD OF COUNTY COMMISSIONERS	DATE	
EXECUTIVE DIRECTOR, PLANNING AND COMMUNITY DEVELOPMENT	DATE	

#### SURVEYOR'S CERTIFICATE:

I, BRIAN J. DENNIS, A DULY REGISTERED PROFESSIONAL LAND SURVEYOR IN THE STATE OF COLORADO, DO HEREBY CERTIFY THAT THIS PLAT TRULY AND CORRECTLY REPRESENTS THE RESULTS OF A SURVEY MADE ON DATE OF SURVEY, BY ME OR UNDER MY DIRECT SUPERVISION AND THAT ALL MONUMENTS EXIST AS SHOWN HEREON; THAT MATHEMATICAL CLOSURE ERRORS ARE LESS THAN 1:10,000; AND THAT SAID PLAT HAS BEEN PREPARED IN FULL COMPLIANCE WITH ALL APPLICABLE LAWS OF THE STATE OF COLORADO DEALING WITH MONUMENTS. SUBDIVISION. OR SURVEYING OF LAND AND ALL APPLICABLE PROVISIONS OF THE EL PASO COUNTY LAND DEVELOPMENT CODE.

I ATTEST THE ABOVE ON THIS \_\_\_\_\_ DAY OF \_\_\_\_\_, 2021.

BRIAN J. DENNIS COLORADO PROFESSIONAL LAND SURVEYOR NO. 38069 FOR AND ON BEHALF OF GALLOWAY & COMPANY, INC.

CLERK AND RECORDER STATE OF COLORADO COUNTY OF EL PASO I HEREBY CERTIFY THAT THIS INSTRUMENT WAS FILED FOR RECORD IN MY OFFICE AT

\_ O' CLOCK \_\_.M., THIS \_\_\_\_ DAY OF \_\_\_\_\_, 2021 A.D., AND IS DULY RECORDED AT RECEPTION NO. OF THE RECORDS OF EL PASO COUNTY, COLORADO.

DATE

EL PASO COUNTY CLERK AND RECORDER

SUMMARY:				
178 LOTS 13 TRACTS RIGHTS-OF-WAY TOTAL	33.904 ACRES 19.316 ACRES 15.325 ACRES 68.545 ACRES	49.5% 28.2% 22.3%		
FEES:				
FEE:		SURCH	IARGE:	
DRAINAGE FEE:		Bridg	E FEE:	
SCHOOL FEE: PARK FEE:				

Ŧ O  $\sim$ Ο ž δם FILING HWES AL MEF TIAL  $\Box$ ΜΗ SIDEN<sup>-</sup> QUARTEF OF THE 6 PASO, ST/ Ω FINAL RTHWEST ( 13S R65W ( FY OF EL P/ Ц S RAS C ENT Ш # Date Issue / Description Init. 1 01/22/20 Add County Comments AAY 2 02/05/20 Add County Comments AAY <u>3</u> 03/17/20 Add County Comments AAY \_\_\_\_\_ \_\_\_\_\_ \_\_\_\_\_ \_\_\_\_\_ \_\_\_\_ \_\_\_\_\_ \_\_\_\_\_ \_\_\_\_\_ \_\_\_\_\_ \_\_\_\_\_

Checked By: BJD	Project No:	CLH014.20
	Drawn By:	AAY
Date: 5/11/2010	Checked By:	BJD
Date. 3/14/2018	Date:	5/14/2019

SHEET 1 OF 7

#### PLAT NOTES:

- 1) THE PURPOSE OF THE PLAT IS TO CREATE NEW LOTS, TRACTS, PUBLIC RIGHT OF WAYS AND EASEMENTS.
- 2) FIELD WORK WAS COMPLETED ON: MARCH 8, 2019.
- 3) ALL LINEAL MEASUREMENTS SHOWN ARE GROUND DISTANCES AND U.S. SURVEY FEET.
- 4) THIS MAP DOES NOT REPRESENT A TITLE SEARCH BY GALLOWAY & COMPANY, INC. TO DETERMINE OWNERSHIP OR THIS TRACT, VERIFY THE DESCRIPTION SHOWN, VERIFY THE COMPATIBILITY OF THIS DESCRIPTION WITH THAT OF ADJACENT TRACTS OR VERIFY EASEMENTS OF RECORD. FOR ALL INFORMATION REGARDING EASEMENTS, RIGHT OF WAY OR TITLE THEREOF, GALLOWAY & COMPANY INC. RELIED UPON THE INFORMATION OR TITLE COMMITMENT/REPORT PROVIDED AT THE TIME OF SURVEY BY THE CLIENT TITLE COMMITMENT PROVIDED BY CLIENT AND PREPARED BY LAND TITLE GUARANTEE COMPANY. ORDER NO. SC55075690. WITH AN EFFECTIVE DATE OF MARCH 16, 2019 AT 5:00 P.M.
- 5) EASEMENTS AND PUBLIC DOCUMENTS SHOWN OR NOTED ON THIS SURVEY WERE EXAMINED AS TO LOCATION AND PURPOSE AND WERE NOT EXAMINED AS TO RESTRICTIONS, EXCLUSIONS, CONDITIONS, OBLIGATIONS, TERMS OR AS THE RIGHT TO GRANT THE SAME.
- 6) CAUTION: THE SURVEYOR PREPARING THIS MAP WILL NOT BE RESPONSIBLE FOR, OR LIABLE FOR, UNAUTHORIZED CHANGES TO OR USES OF THIS MAP. ALL CHANGES TO THIS EXHIBIT MUST BE APPROVED IN WRITING BY THE SURVEYOR IN CHARGE.
- THE PROPERTY IS SUBJECT TO THE TERMS, CONDITIONS, PROVISIONS, OBLIGATIONS AND AGREEMENTS AS SET FORTH IN THE UPPER BLACK SQUIRREL CREEK GROUND WATER MANAGEMENT DISTRICT FINAL ORDER AND DECREE, RECORDED DECEMBER 11, 1979 IN BOOK 3260 AT PAGE 701.
- 8) THE PROPERTY IS SUBJECT TO THE TERMS, CONDITIONS, PROVISIONS, OBLIGATIONS AND AGREEMENTS AS SET FORTH IN THE FALCON FIRE PROTECTION DISTRICT AS INSTRUMENTS, RECORDED DECEMBER 2, 1980 IN BOOK 3380 AT PAGE 670 AND 675 AND RECORDED FEBRUARY 17, 1981 IN BOOK 3404 AT PAGE 582 AND 587.
- 9) THE PROPERTY IS SUBJECT TO THE FINDINGS AND ORDER AS SET FORTH IN THE COLORADO GROUND WATER COMMISSION FINDINGS AND ORDER, RECORDED JULY 10, 2003, UNDER RECEPTION NO. 203158843.
- 10) THE PROPERTY IS SUBJECT TO THE TERMS, CONDITIONS, PROVISIONS, OBLIGATIONS AND AGREEMENTS AS SET FORTH IN THE ORDER OF THE INCLUSION OF THE WOODMEN HILLS METROPOLITAN DISTRICT, RECORDED DECEMBER 12, 2003 UNDER RECEPTION NO. 203286253, AND RECORDED JANUARY 23, 2004 UNDER RECEPTION NO. 204013207, AND RECORDED FEBRUARY 11, 2011, UNDER RECEPTION NO. 211015822.
- 11) THE PROPERTY IS SUBJECT TO THE TERMS, CONDITIONS, PROVISIONS, OBLIGATIONS AND AGREEMENTS AS SET FORTH IN THE ORDER OF THE INCLUSION OF REAL PROPERTY IN THE WOODMEN ROAD METROPOLITAN DISTRICT, RECORDED JANUARY 29, 2004, UNDER RECEPTION NO. 204016142.
- 12) THE PROPERTY IS SUBJECT TO THE TERMS, CONDITIONS, PROVISIONS, OBLIGATIONS AND AGREEMENTS AS SET FORTH IN THE THE EFFECT OF RESOLUTION NO. 04-501, RECORDED JANUARY 24, 2005, UNDER RECEPTION NO. 205011638.
- 13) THE PROPERTY IS SUBJECT TO THE TERMS, CONDITIONS, PROVISIONS, OBLIGATIONS AND AGREEMENTS AS SET FORTH FOR THE CONVEYANCE OF ALL WATER AND WATER RIGHTS AS CONVEYED TO WOODMEN HILLS METROPOLITAN DISTRICT DESCRIBED IN THOSE SPECIAL WARRANTY DEEDS--WATER RIGHTS RECORDED APRIL 8, 2005 UNDER RECEPTION NOS. 205050350 AND 205050349.
- 14) THE PROPERTY IS SUBJECT TO THE RESTRICTIVE COVENANTS AS SET FORTH AND AS CONTAINED IN INSTRUMENT RECORDED APRIL 07, 2006, UNDER RECEPTION NO. 206051091.
- 15) THE PROPERTY IS SUBJECT TO THE TERMS, CONDITIONS, PROVISIONS, OBLIGATIONS AND AGREEMENTS AS SET FORTH FOR THE EFFECT OF RESOLUTION NO. 07–133 REGARDING REZONING RECORDED MAY 30. 2007 UNDER RECEPTION NO. 207072586.
- 16) THE PROPERTY IS SUBJECT TO THE TERMS, CONDITIONS, PROVISIONS, OBLIGATIONS AND AGREEMENTS AS SET FORTH FOR THE EFFECT OF RESOLUTION NO. 07-134 REGARDING REZONING RECORDED MAY 30, 2007 UNDER RECEPTION NO. 207072587.
- 17) THE PROPERTY IS SUBJECT TO THE TERMS, CONDITIONS, PROVISIONS OBLIGATIONS AND AGREEMENTS AS SET FORTH FOR THE EFFECT OF RESOLUTION NO. 07–135 REGARDING THE BENT GRASS PRELIMINARY PLAN RECORDED MAY 30, 2007 UNDER RECEPTION NO. 207072588.
- 18) THE PROPERTY IS SUBJECT TO THE TERMS, CONDITIONS, PROVISIONS, OBLIGATIONS AND AGREEMENTS AS SET FORTH FOR THE EFFECT OF BENT GRASS OVERALL PUD DEVELOPMENT PLAN MAP RECORDED JUNE 4, 2007 UNDER RECEPTION NO. 207074523.
- 19) THE PROPERTY IS SUBJECT TO THE TERMS, CONDITIONS, PROVISIONS, OBLIGATIONS AND AGREEMENTS AS SET FORTH FOR THE EFFECT OF BENT GRASS PHASE ONE SITE SPECIFIC PUD DEVELOPMENT PLAN RECORDED JUNE 4, 2007 UNDER RECEPTION NO. 207074524.
- 20) THE PROPERTY IS SUBJECT TO THE TERMS, CONDITIONS, PROVISIONS, OBLIGATIONS AND AGREEMENTS AS SET FORTH FOR THE EFFECT OF RESOLUTION NO. 07-388 REGARDING BENT GRASS METROPOLITAN DISTRICT RECORDED SEPTEMBER 25, 2007 UNDER RECEPTION NO. 207124524.
- 21) ANY TAX, LIEN, FEE, OR ASSESSMENT BY REASON OF INCLUSION OF SUBJECT PROPERTY IN THE BENT GRASS METROPOLITAN DISTRICT, AS EVIDENCED BY INSTRUMENT RECORDED NOVEMBER 29, 2007, UNDER RECEPTION NO. 207152168. NOTICE OF SPECIAL DISTRICT DISCLOSURE RECORDED DECEMBER 18, 2007 UNDER RECEPTION NO. 207160587.
- 22) THE PROPERTY IS SUBJECT TO THE TERMS, CONDITIONS, PROVISIONS, OBLIGATIONS AND AGREEMENTS AS SET FORTH FOR THE EFFECT OF EL PASO COUNTY SPECIAL DISTRICT ANNUAL REPORT AND DISCLOSURE FORM, RECORDED AUGUST 07, 2013, UNDER RECEPTION NO. 213101580.
- 23) THE PROPERTY IS SUBJECT TO THE TERMS, CONDITIONS, PROVISIONS, OBLIGATIONS AND AGREEMENTS AS SET FORTH FOR THE EFFECT OF RESOLUTION NO. 14-260, RECORDED JULY 23, 2014, UNDER RECEPTION NO. 214065375.

PLAT NOTES (CONTINUED):

- 24) THE PROPERTY IS SUBJECT TO THE TERMS, CONDITIONS, PROVISIONS, OBLIGATIONS AND AGREEMENTS AS SET FORTH FOR THE EFFECT OF RESOLUTION NO. 14–259, RECORDED JULY 23, 2014, UNDER RECEPTION NO. 214065376.
- 25) THE PROPERTY IS SUBJECT TO THE TERMS, CONDITIONS, PROVISIONS, OBLIGATIONS AND AGREEMENTS AS SET FORTH FOR THE EFFECT OF BENT GRASS PLANNED UNIT DEVELOPMENT PLAN AMENDMENT, RECORDED JULY 30, 2014, UNDER RECEPTION NO. 214068054.
- 26) SPECIAL DISTRICT DISCLOSURE: ALL PROPERTY WITHIN THIS SUBDIVISION IS IN A PLANNED UNIT DEVELOPMENT DISTRICT. A TITLE 32 SPECIAL DISTRICT ANNUAL REPORT AND DISCLOSURE FORM SATISFACTORY TO THE PLANNING AND COMMUNITY DEVELOPMENT DEPARTMENT SHALL BE RECORDED WITH EACH PLAT.
- 27) WOODMEN ROAD DISTRICT NOTE: ALL PROPERTY WITHIN THIS SUBDIVISION IS WITHIN THE BOUNDARIES OF THE WOODMEN ROAD METROPOLITAN DISTRICT AND, AS SUCH, IS SUBJECT TO A MILL LEVY, PLATTING FEES AND BUILDING PERMIT FEES FOR THE PURPOSE OF FINANCING CONSTRUCTION OF SPECIFIED IMPROVEMENTS TO WOODMEN ROAD.
- 28) THE FOLLOWING REPORTS HAVE BEEN SUBMITTED IN ASSOCIATION WITH THE FINAL PLAT FOR THIS SUBDIVISION AND ARE ON FILE AT THE COUNTY PLANNING AND COMMUNITY DEVELOPMENT DEPARTMENT: PLANNED UNIT DEVELOPMENT (FILE NO. PUD142), SOILS AND GEOLOGICAL STUDY, MASTER DEVELOPMENT DRAINAGE PLAN. DRAINAGE REPORT. WATER RESOURCES REPORT, FIRE PROTECTION REPORT, NATURAL FEATURES REPORT, EROSION CONTROL REPORT, TRAFFIC IMPACT ANALYSIS.
- 29) STORMWATER DRAINAGE NOTE: ALL PROPERTY OWNERS ARE RESPONSIBLE FOR MAINTAINING PROPER STORM WATER DRAINAGE IN AND THROUGH THEIR PROPERTY. PUBLIC DRAINAGE EASEMENTS AS SPECIFICALLY NOTED ON THE PLAT SHALL BE MAINTAINED BY THE INDIVIDUAL LOT OWNERS UNLESS OTHERWISE INDICATED. STRUCTURES, FENCES, MATERIALS OR LANDSCAPING THAT COULD IMPEDE THE FLOW OF RUNOFF SHALL NOT BE PLACED IN DRAINAGE EASEMENTS.
- 30) ENVIRONMENTAL NOTE: DEVELOPER SHALL COMPLY WITH FEDERAL AND STATE LAWS, REGULATIONS, ORDINANCES, REVIEW AND PERMIT REQUIREMENTS, AND OTHER AGENCY REQUIREMENTS, IF ANY, OF APPLICABLE AGENCIES INCLUDING, BUT NOT LIMITED TO, THE COLORADO PARKS & WILDLIFE, COLORADO DEPARTMENT OF TRANSPORTATION, U.S. ARMY CORPS OF ENGINEERS AND THE U.S. FISH AND WILDLIFE SERVICE REGARDING THE ENDANGERED SPECIES ACT, PARTICULARLY AS IT RELATES TO THE LISTED SPECIES, (E.G. PREBLE'S MEADOW JUMPING MOUSE).
- 31) ADDRESS NOTE: THE ADDRESSED EXHIBITED ON THIS PLAT ARE FOR INFORMATIONAL PURPOSES ONLY. THEY ARE NOT THE LEGAL DESCRIPTION AND ARE SUBJECT TO CHANGE.
- 32) GEOLOGIC HAZARD NOTE: THE FOLLOWING PROJECT SITE HAS BEEN FOUND TO BE IMPACTED BY GEOLOGIC HAZARDS. MITIGATION MEASURES AND A MAP OF 45) THE BASE FLOOD ELEVATIONS SHOWN ON THIS PLAT ARE SOLELY BASED ON THE HAZARD AREA CAN BE FOUND IN THE REPORT GEOLOGY AND SOILS THE FEMA FLOOD MAPS NOTED ABOVE. THE BASE FLOOD ELEVATIONS ARE REPORT. BENT GRASS RESIDENTIAL, FILING NO. 2, EL PASO COUNTY. FOR INFORMATIONAL PURPOSES ONLY AND ARE NOT FIELD VERIFIED BY THIS COLORADO BY ROCKY MOUNTAIN GROUP (RMG) DATED OCTOBER 21, 2019, SURVEY. AMENDED JANUARY 13, 2020 AND SUBSURFACE SOIL INVESTIGATION DATED JANUARY 21, 2020, FILE BENT GRASS RESIDENTIAL FILING NO. 2, #SF-19-014 AVAILABLE AT THE EL PASO COUNTY PLANNING AND COMMUNITY DEVELOPMENT DEPARTMENT:
- FAULTS/SEISMICITY: (LOTS 1–178)
- RADIOACTIVITY/RADON GAS: (LOTS 1–178)
- EXPANSIVE/COMPRESSIBLE SOILS (LOTS 1–178) BED ROCK (LOTS 1–178)

THE GEOLOGIC CONDITIONS ENCOUNTERED AT THIS SITE ARE RELATIVELY COMMON TO THE IMMEDIATE AREA AND MITIGATION CAN BE ACCOMPLISHED BY IMPLEMENTING COMMON ENGINEERING AND CONSTRUCTION PRACTICES. NONE OF THESE CONDITIONS ARE ANTICIPATED TO PRECLUDE THE PROPOSED DEVELOPMENT.

- 33) ACCESS NOTE: NO DRIVEWAY SHALL BE ESTABLISHED UNLESS AN ACCESS PERMIT HAS BEEN GRANTED BY EL PASO COUNTY.
- 34) MAILBOXES: MAILBOXES SHALL BE INSTALLED IN ACCORDANCE WITH ALL EL PASO COUNTY AND UNITED STATES SERVICE REGULATIONS.
- 35) NO LOT OR INTEREST THEREIN, SHALL BE SOLD, CONVEYED, OR TRANSFERRED WHETHER BY DEED OR BY CONTRACT, NOR SHALL BUILDING PERMITS BE ISSUED, UNTIL AND UNLESS EITHER THE REQUIRED PUBLIC AND COMMON DEVELOPMENT IMPROVEMENTS HAVE BEEN CONSTRUCTED AND COMPLETED AND PRELIMINARILY ACCEPTED IN ACCORDANCE WITH THE SUBDIVISION IMPROVEMENTS AGREEMENT BETWEEN THE APPLICANT/OWNER AND EL PASO COUNTY AS RECORDED UNDER RECEPTION NUMBER THE OFFICE OF THE CLERK AND RECORDER OF EL PASO COUNTY, COLORADO

OR. IN THE ALTERNATIVE. OTHER COLLATERAL IS PROVIDED TO MAKE PROVISION FOR THE COMPLETION OF SAID IMPROVEMENTS IN ACCORDANCE WITH THE EL PASO COUNTY LAND DEVELOPMENT CODE AND ENGINEERING CRITERIA MANUAL. ANY SUCH ALTERNATIVE COLLATERAL MUST BE APPROVED BY THE BOARD OF COUNTY COMMISSIONERS OR, IF PERMITTED BY THE

SUBDIVISION IMPROVEMENTS AGREEMENT. BY THE COUNTY PLANNING AND COMMUNITY DEVELOPMENT DEPARTMENT DIRECTOR AND MEET THE POLICY AND PROCEDURE REQUIREMENTS OF EL PASO COUNTY PRIOR TO THE RELEASE BY THE COUNTY OF ANY LOTS FOR SALE, CONVEYANCE OR TRANSFER.

- 36) TRACTS SHALL BE UTILIZED AS SPECIFIED IN THE TRACT TABLE, AS SHOWN. OWNERSHIP AND MAINTENANCE OF ALL TRACTS SHALL BE VESTED TO THE BENT GRASS METROPOLITAN DISTRICT.
- 37) WILDFIRE NOTE: AT THE TIME OF APPROVAL OF THIS PROJECT, THIS PROPERTY IS LOCATED WITHIN THE FALCON FIRE PROTECTION DISTRICT. WHICH HAS ADOPTED A FIRE CODE REQUIRING RESIDENTIAL FIRE SPRINKLER REQUIREMENTS FOR COVERED STRUCTURES OVER 6000 SQUARE FEET IN SIZE, AND OTHER FIRE MITIGATION REQUIREMENTS DEPENDING UPON THE LEVEL OF FIRE RISK ASSOCIATED WITH THE PROPERTY AND STRUCTURES. THE OWNER OF ANY LOT SHOULD CONTACT THE FIRE DISTRICT TO DETERMINE THE EXACT DEVELOPMENT REQUIREMENTS RELATIVE TO THE ADOPTED FIRE CODE. DUE TO WILDFIRE CONCERNS, HOMEOWNERS ARE ENCOURAGED TO INCORPORATE WILDFIRE FUEL BREAK PROVISIONS AS RECOMMENDED BY THE COLORADO STATE FOREST SERVICE AND ILLUSTRATED THROUGH PUBLICATIONS

AVAILABLE THROUGH THE STATE FOREST SERVICE.

# **BENT GRASS RESIDENTIAL FILING NO. 2**

LOCATED IN THE NORTHWEST QUARTER AND SOUTHWEST QUARTER OF SECTION 1 T13S R65W OF THE 6TH PRINCIPAL MERIDIAN COUNTY OF EL PASO, STATE OF COLORADO

- 38) ADJACENT INDUSTRIAL AREAS: THIS PROPERTY MAY BE ADVERSELY IMPACTED BY NOISE, DUST, FUMES, AND LIGHT POLLUTION CAUSED BY ADJACENT INDUSTRIAL PROPERTIES AND ACTIVITIES. THE BUYER SHOULD RESEARCH AND BE AWARE OF THIS POTENTIALITY AND THE RAMIFICATIONS THEREOF.
- 39) A BLANKET ACCESS EASEMENT IS HEREBY CREATED, OVER AND ACROSS TRACTS G & J, AND DEDICATED TO EL PASO COUNTY, FOR THE PURPOSES OF INSPECTION AND MAINTENANCE OF TRACTS H & K (DRAINAGE CHANNEL). THE PROPERTY OWNER OR BENT GRASS METROPOLITAN DISTRICT SHALL BE RESPONSIBLE FOR MAINTENANCE OF THE DRAINAGE CHANNEL UNTIL THE NECESSARY CHANNEL STABILIZATION IMPROVEMENTS ARE CONSTRUCTED AND ACCEPTED FOR MAINTENANCE BY EL PASO COUNTY.
- 40) LOT RESTRICTION NOTE: LOTS 34, 35, 36 & 37 ARE RESTRICTED TO A SINGLE-STORY SINGLE FAMILY HOME PER PUD 14-2.
- GROUNDWATER NOTE: GROUNDWATER MEDIATION SHALL INCLUDE INDIVIDUAL 41) LOT UNDERDRAINS WITH SUMP PUMPS. PUMP DISCHARGES SHALL BE INSTALLED ALONG REAR LOT LINES. PUMP DISCHARGE SHALL NOT BE DIRECTED TO THE STREET RIGHT OF WAY.
- 42) SET BACKS NOTE:
- FRONT: 20 FEET
- SIDE: 5 FEET
- REAR: 20 FEET MINIMUM: LOTS 157, 144, 135, TRACT G, TRACT H AND TRACT I SHALL HAVE A 50 FOOT SET BACK ALONG THE NORTH PROPERTY LINE.
- CORNER LOTS: 'FRONT' SHALL BE DESIGNATED AS THE LOT LINE WHERE DRIVEWAY ACCESS POINT IS LOCATED AND THE 'SIDE YARD SETBACK' FOR THE SIDE STREET SHALL BE 10 FEET.
- SUBDIVISION PERIMETER: 20 FEET
- 43) BUILDING HEIGHT RESTRICTION NOTE: LOTS 34, 35, 36, 37 ARE RESTRICTED TO A MAXIMUM HEIGHT OF 25 FEET. "single-story" homes and 25 feet.
- 44) FLOODPLAIN NOTE: PER THE FEMA FLOOD INSURANCE RATE MAP (FIRM). MAP NO. 08041C0553G WITH AN EFFECTIVE DATE OF DECEMBER 07, 2018, INDICATES THE MAJORITY OF THE SUBJECT PROPERTY IS DESIGNATED AS ZONE X (AREAS DETERMINED TO BE OUTSIDE 0.2% ANNUAL CHANCE FLOODPLAIN). A PORTION OF THE PROJECT SITE LIES WITHIN ZONE AE (SPECIAL FLOOD HAZARD AREAS (SFHAS) SUBJECT TO INUNDATION BY THE 1% ANNUAL CHANCE FLOOD WITH BASE FLOOD ELEVATIONS DETERMINED). THE AREAS OF THE PROJECT SITE DESIGNATED AS ZONE AE ARE CONTAINED WITHIN TRACTS H AND K. NO STRUCTURES OR FENCES ARE PERMITTED IN THIS AREA.

The El Paso County Board of County Commissioners disclaims any interest in the temporary turn around easement purported to be conveyed to El Paso County by quitclaim deed recorded at Reception No. 214078281, as such easement was never accepted by the County in accordance with legal requirements. To the extent that El Paso County may nonetheless have an interest in such easement, the Board of County Commissioners hereby consents to the vacation of such

easement.

#### LIST OF CONTACTS

APPLICANT/DEVELOPER CHALLENGER HOMES, INC 13570 NORTHGATE ESTATES DR. COLORADO SPRINGS, CO 80921 CONTACT: JIM BYERS EMAIL: JIM@MYCHALLENGERHOMES.COM TEL: (719) 598–5190

#### ENGINEER/CONSULTANT GALLOWAY & COMPANY, INC. 1155 KELLY JOHNSON BLVD., SUITE 305

COLORADO SPRINGS, CO 80920 CONTACT: GRANT DENNIS, P.E. EMAIL: GRANTDENNIS@GALLOWAYUS.COM TEL: (719) 900–7220

EL PASO COUNTY EL PASO COUNTY, PLANNING & COMMUNITY DEVELOPMENT 2880 INTERNATIONAL CIRCLE, SUITE 110 COLORADO SPRINGS, CO 80910 TEL: (719) 520–6300

#### SURVEYOR GALLOWAY & COMPANY, INC. 1155 KELLY JOHNSON BLVD., SUITE 305 COLORADO SPRINGS, CO 80920 CONTACT: LYLE BISSEGGER EMAIL: LYLEBISSEGGER@GALLOWAYUS.COM TEL: (719) 900–7220

UTILITY REVIEW - WATER/WASTEWATER WOODMEN HILLS METRO DISTRICT 8046 EASTONVILLE ROAD FALCON, CO 80831 CONTACT: JERRY JACOBSON EMAIL: JERRY@WHMD.ORG TEL: (719) 495–2500

<u>UTILITY REVIEW – GAS</u> COLORADO SPRINGS UTILITIES 1521 HANCOCK EXPY #4801 COLORADO SPRINGS, CO 80903 CONTACT: RYNE SOLBERG EMAIL: RSOLBERG@CSU.ORG TEL: (719) 668–8267


ELECTRIC MOUNTAIN VIEW ELECTRIC 11140 E WOODMEN RD FALCON, CO 80831 TEL: (719) 495–2283

FIRE DISTRICT FALCON FIRE PROTECTION DISTRICT 7030 OLD MERIDIAN ROAD PEYTON, CO 80831 EMAIL: FALCONFIRE@FALCONFIREPD.ORG TEL: (719) 495–4050

TRACT NO.
TRACT A
TRACT B
TRACT C
TRACT D
TRACT E
TRACT F
TRACT G
TRACT H
TRACT I
TRACT J
TRACT K
TRACT L
TRACT M

\*SEE NOTE #39



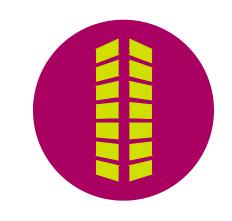

0

 $\mathbf{\alpha}$ 

δD

NES.

ΜΗ

 $\sim$ 

Ο

Ž

FILING

TIAL


TRACT USE	ACREAGE	TRACT OWNERSHIP AND MAINTENANCE
POCKET PARK	0.18	BENT GRASS METROPOLITAN DISTRICT
DRAINAGE/OPEN SPACE/UTILITIES	0.63	BENT GRASS METROPOLITAN DISTRICT
DRAINAGE/OPEN SPACE	0.64	BENT GRASS METROPOLITAN DISTRICT
POCKET PARK	0.22	BENT GRASS METROPOLITAN DISTRICT
DRAINAGE/OPEN SPACE	0.37	BENT GRASS METROPOLITAN DISTRICT
OPEN SPACE	0.09	BENT GRASS METROPOLITAN DISTRICT
FUTURE DEVELOPMENT	3.47	BENT GRASS METROPOLITAN DISTRICT
DRAINAGE	1.94	OWNERSHIP: BENT GRASS METROPOLITAN DISTRICT MAINTENANCE: SEE NOTE #39
FUTURE DEVELOPMENT	4.81	BENT GRASS METROPOLITAN DISTRICT
OPEN SPACE	3.82	BENT GRASS METROPOLITAN DISTRICT
DRAINAGE	2.42	OWNERSHIP: BENT GRASS METROPOLITAN DISTRICT MAINTENANCE: SEE NOTE #39
OPEN SPACE	0.16	BENT GRASS METROPOLITAN DISTRICT
OPEN SPACE	0.56	BENT GRASS METROPOLITAN DISTRICT

### Ш ARTE THE ( 0, ST/ SID $\triangleleft$ FIN REST (VEST ( RTHWEST 13S R65V Y OF EL S တ RA C ENT Z Ω പറ Ш # Date Issue / Description <u>1</u> 01/22/20 Add County Comments AAY 2 02/05/20 Add County Comments AAY <u>3</u> 03/17/20 Add County Comments AAY \_\_\_\_\_ \_\_\_\_ \_\_\_\_ \_\_\_\_\_ \_\_\_\_ \_\_\_\_\_ \_\_\_\_\_

ΑΑΥ
AAT
BJD
5/14/2019


SHEET INDEXSHEET 2PLAT NOTES & TRACT TABLESHEET 3OVERALL BOUNDARY & EXISTING EASEMENTSSHEET 4-6LOT CONFIGURATIONSHEET 7CURVE TABLE
--



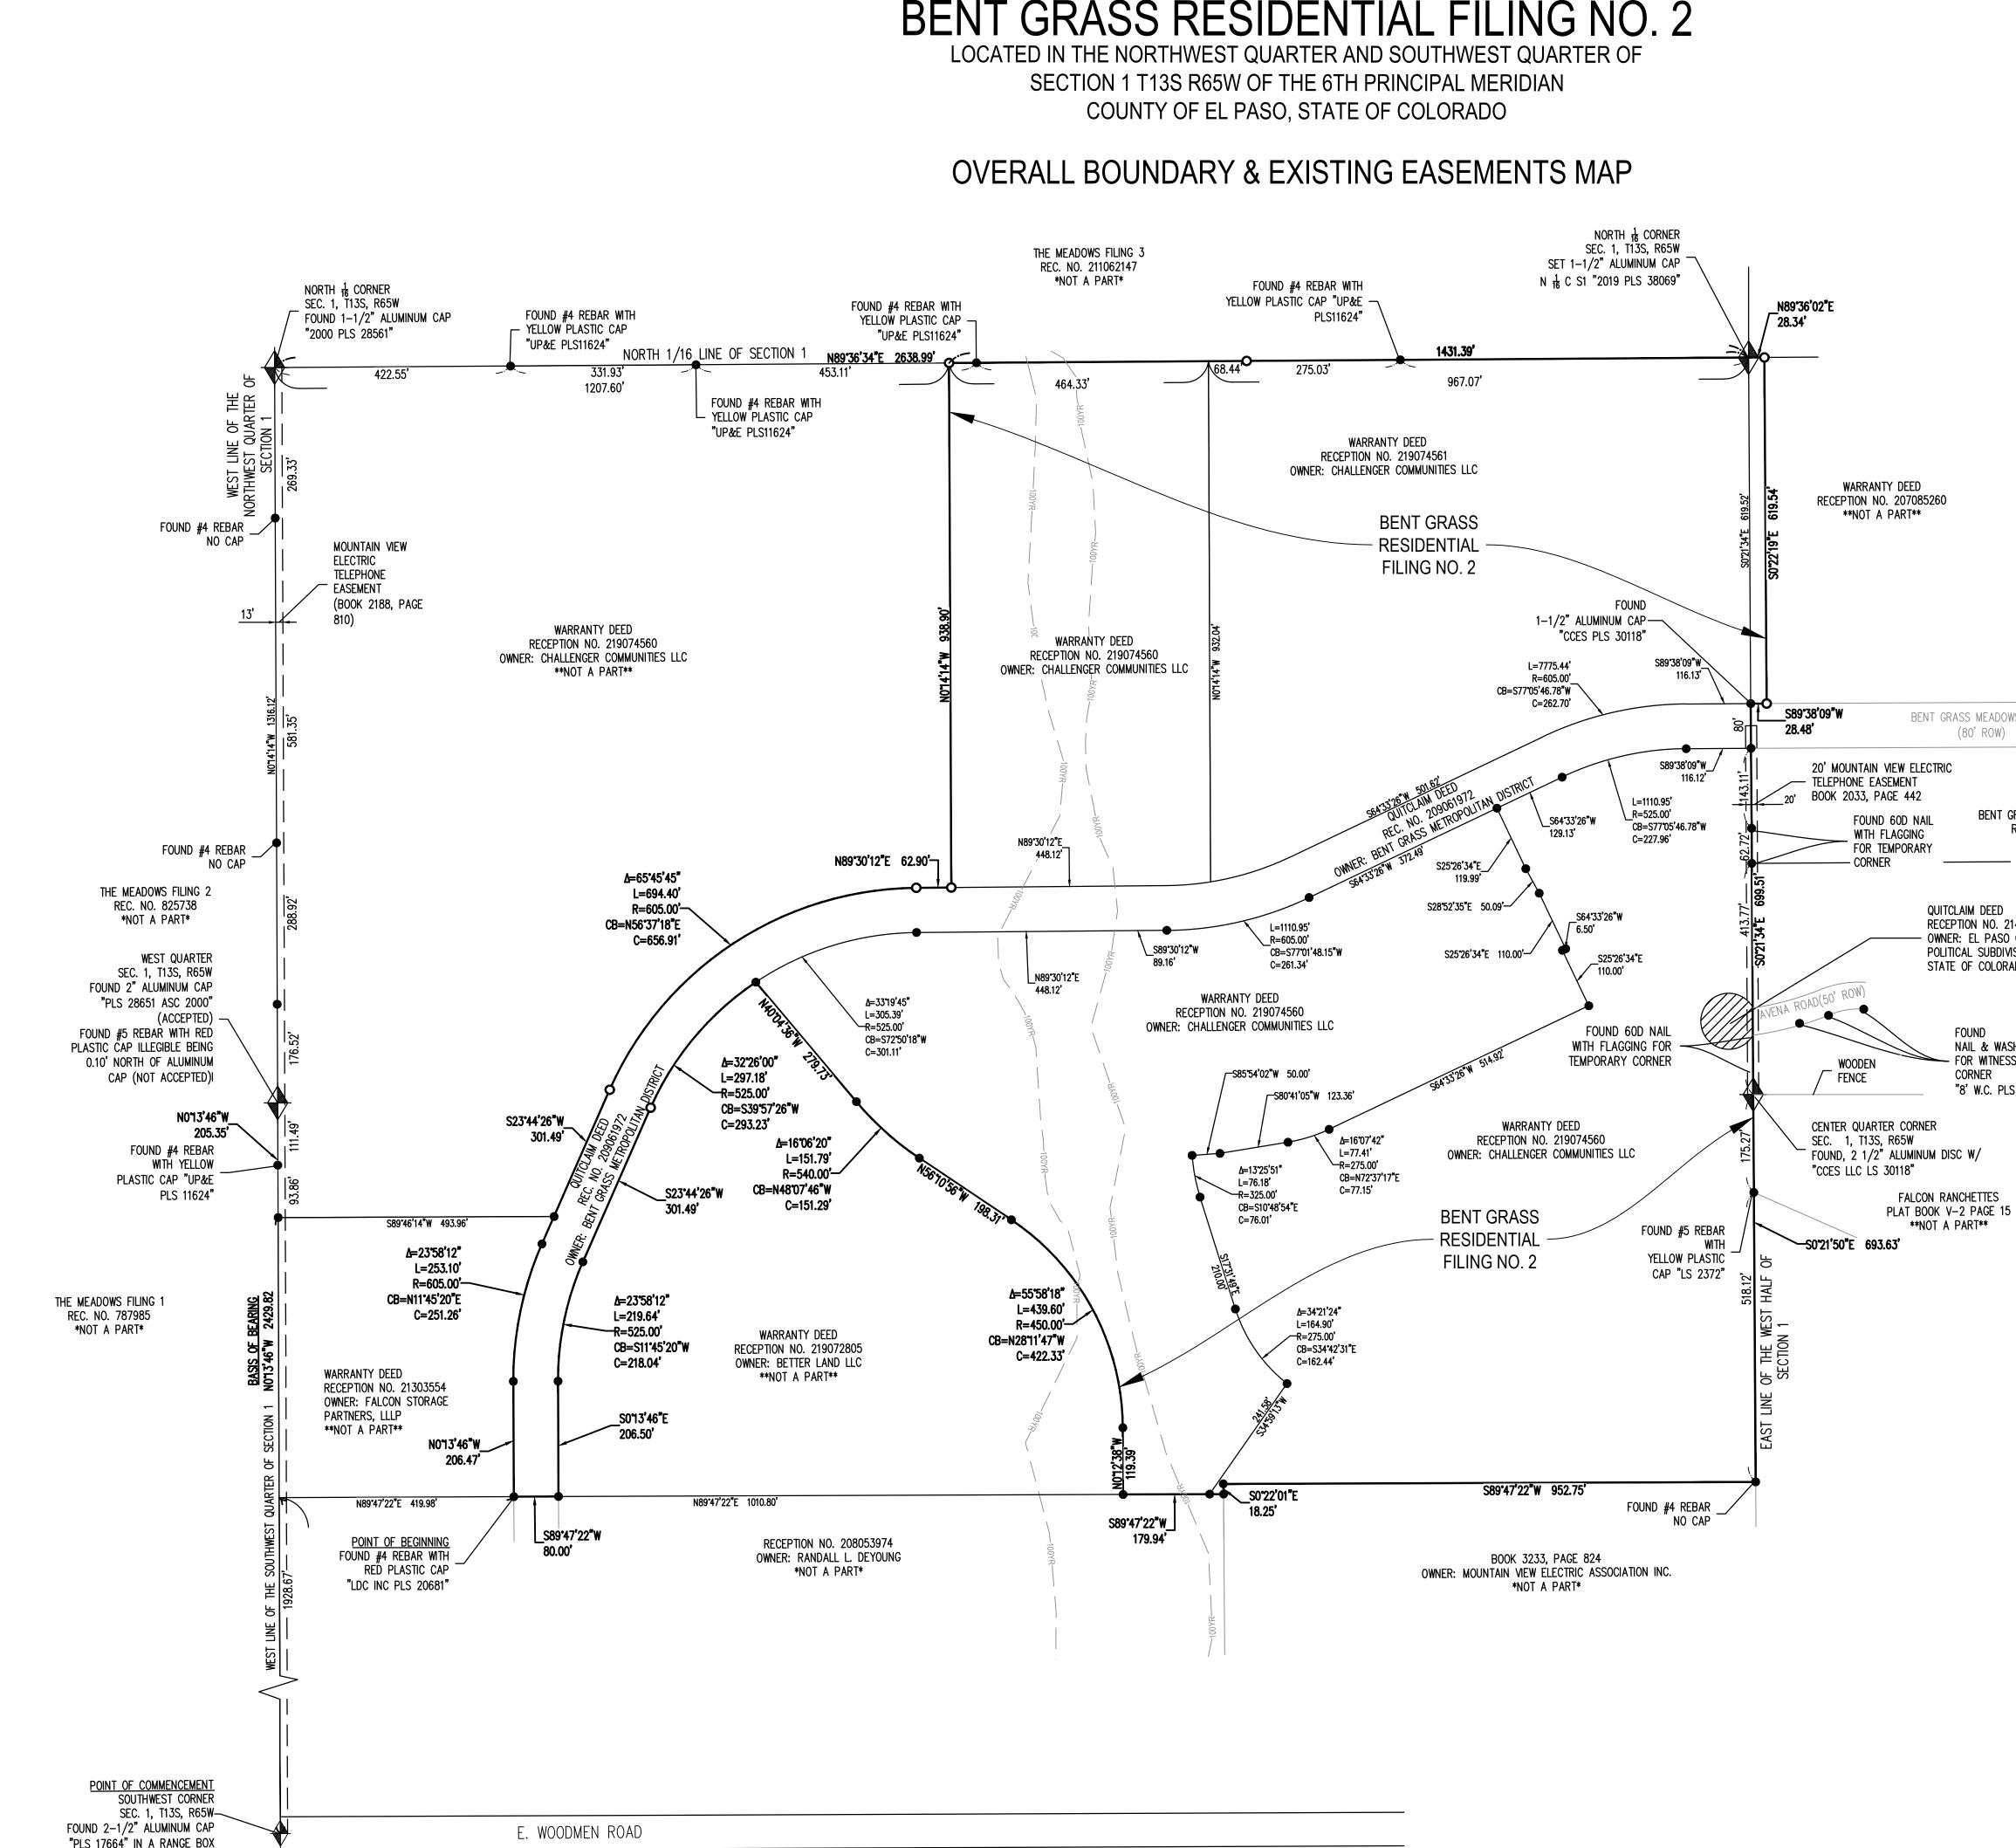

## BENT GRASS RESIDENTIAL FILING NO. 2

Galloway 1155 Kelly Johnson Blvd, Suite 305 Colorado Springs, CO 80920 719.900.7220 GallowayUS.com 

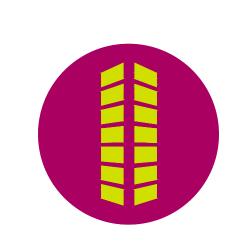

RTE

NO.

FILING I OUTHWEST

TIA

S

RAS:

ΞΨ

**B** E

# Date Issue / Description

Project No:

Drawn By:

MAP

Checked By:

0

<u>1</u> 01/22/20 Add County Comments AAY

2 02/05/20 Add County Comments AAY

<u>3</u> 03/17/20 Add County Comments AAY

Init.

CLH014.20

AAY

BJD 5/14/2019

FINAL PL/ RESIDENT VEST QUARTER / R65W OF THE 6T R65W OF THE 6T

4

BENT GRASS MEADOWS DRIVE (80'ROW)

> BENT GRASS RESIDENTIAL FILING 1 REC. NO. 215713636 \*NOT A PART\*

QUITCLAIM DEED RECEPTION NO. 214078281 · OWNER: EL PASO COUNTY, A POLITICAL SUBDIVISION OF THE STATE OF COLORADO

> FOUND NAIL & WASHER - FOR WITNESS CORNER "8' W.C. PLS 30118"

 P.U.C
 LOT
 PROF

LEGEND

Ο S00°00'00"E 1000.00' (12345)

\_ \_\_ \_\_ \_\_

\_\_\_\_\_ · \_\_\_\_ · \_\_\_\_ · \_\_\_\_ BFE 6945


.D.E (PUBLIC UTILITY & DRAINAGE EASEMENT) LINE PERTY BOUNDARY ROAD CENTERLINE SECTION LINE 100-YEAR FLOODPLAIN LINE SET, NO. 5 REBAR, 24" LONG W/ 1 1/4" ORANGE PLASTIC CAP, "PLS 38069", UNLESS OTHERWISE NOTED FOUND, NO. 4 REBAR W' RED PLASTIC CAP, "LDC INC PLS 20681", UNLESS OTHERWISE NOTED ALIQUOT CORNER (AS DESCRIBED)


EASEMENT INFORMATION ENUMERATED ADDRESS

BASE FLOOD ELEVATION (ELEVATIONS ARE BASED ON FEMA FIRM PANEL BASE FLOOD ELEVATIONS. ELEVATIONS SHOWN ARE NAVD88)


SHEET INDEX	
SHEET 2 PLAT NOTES & TRA	CT TABLE
SHEET 3 OVERALL BOUNDARY	<b>&amp; EXISTING EASEMENTS</b>
SHEET 4-6 LOT CONFIGURATION	
SHEET 7 CURVE TABLE	



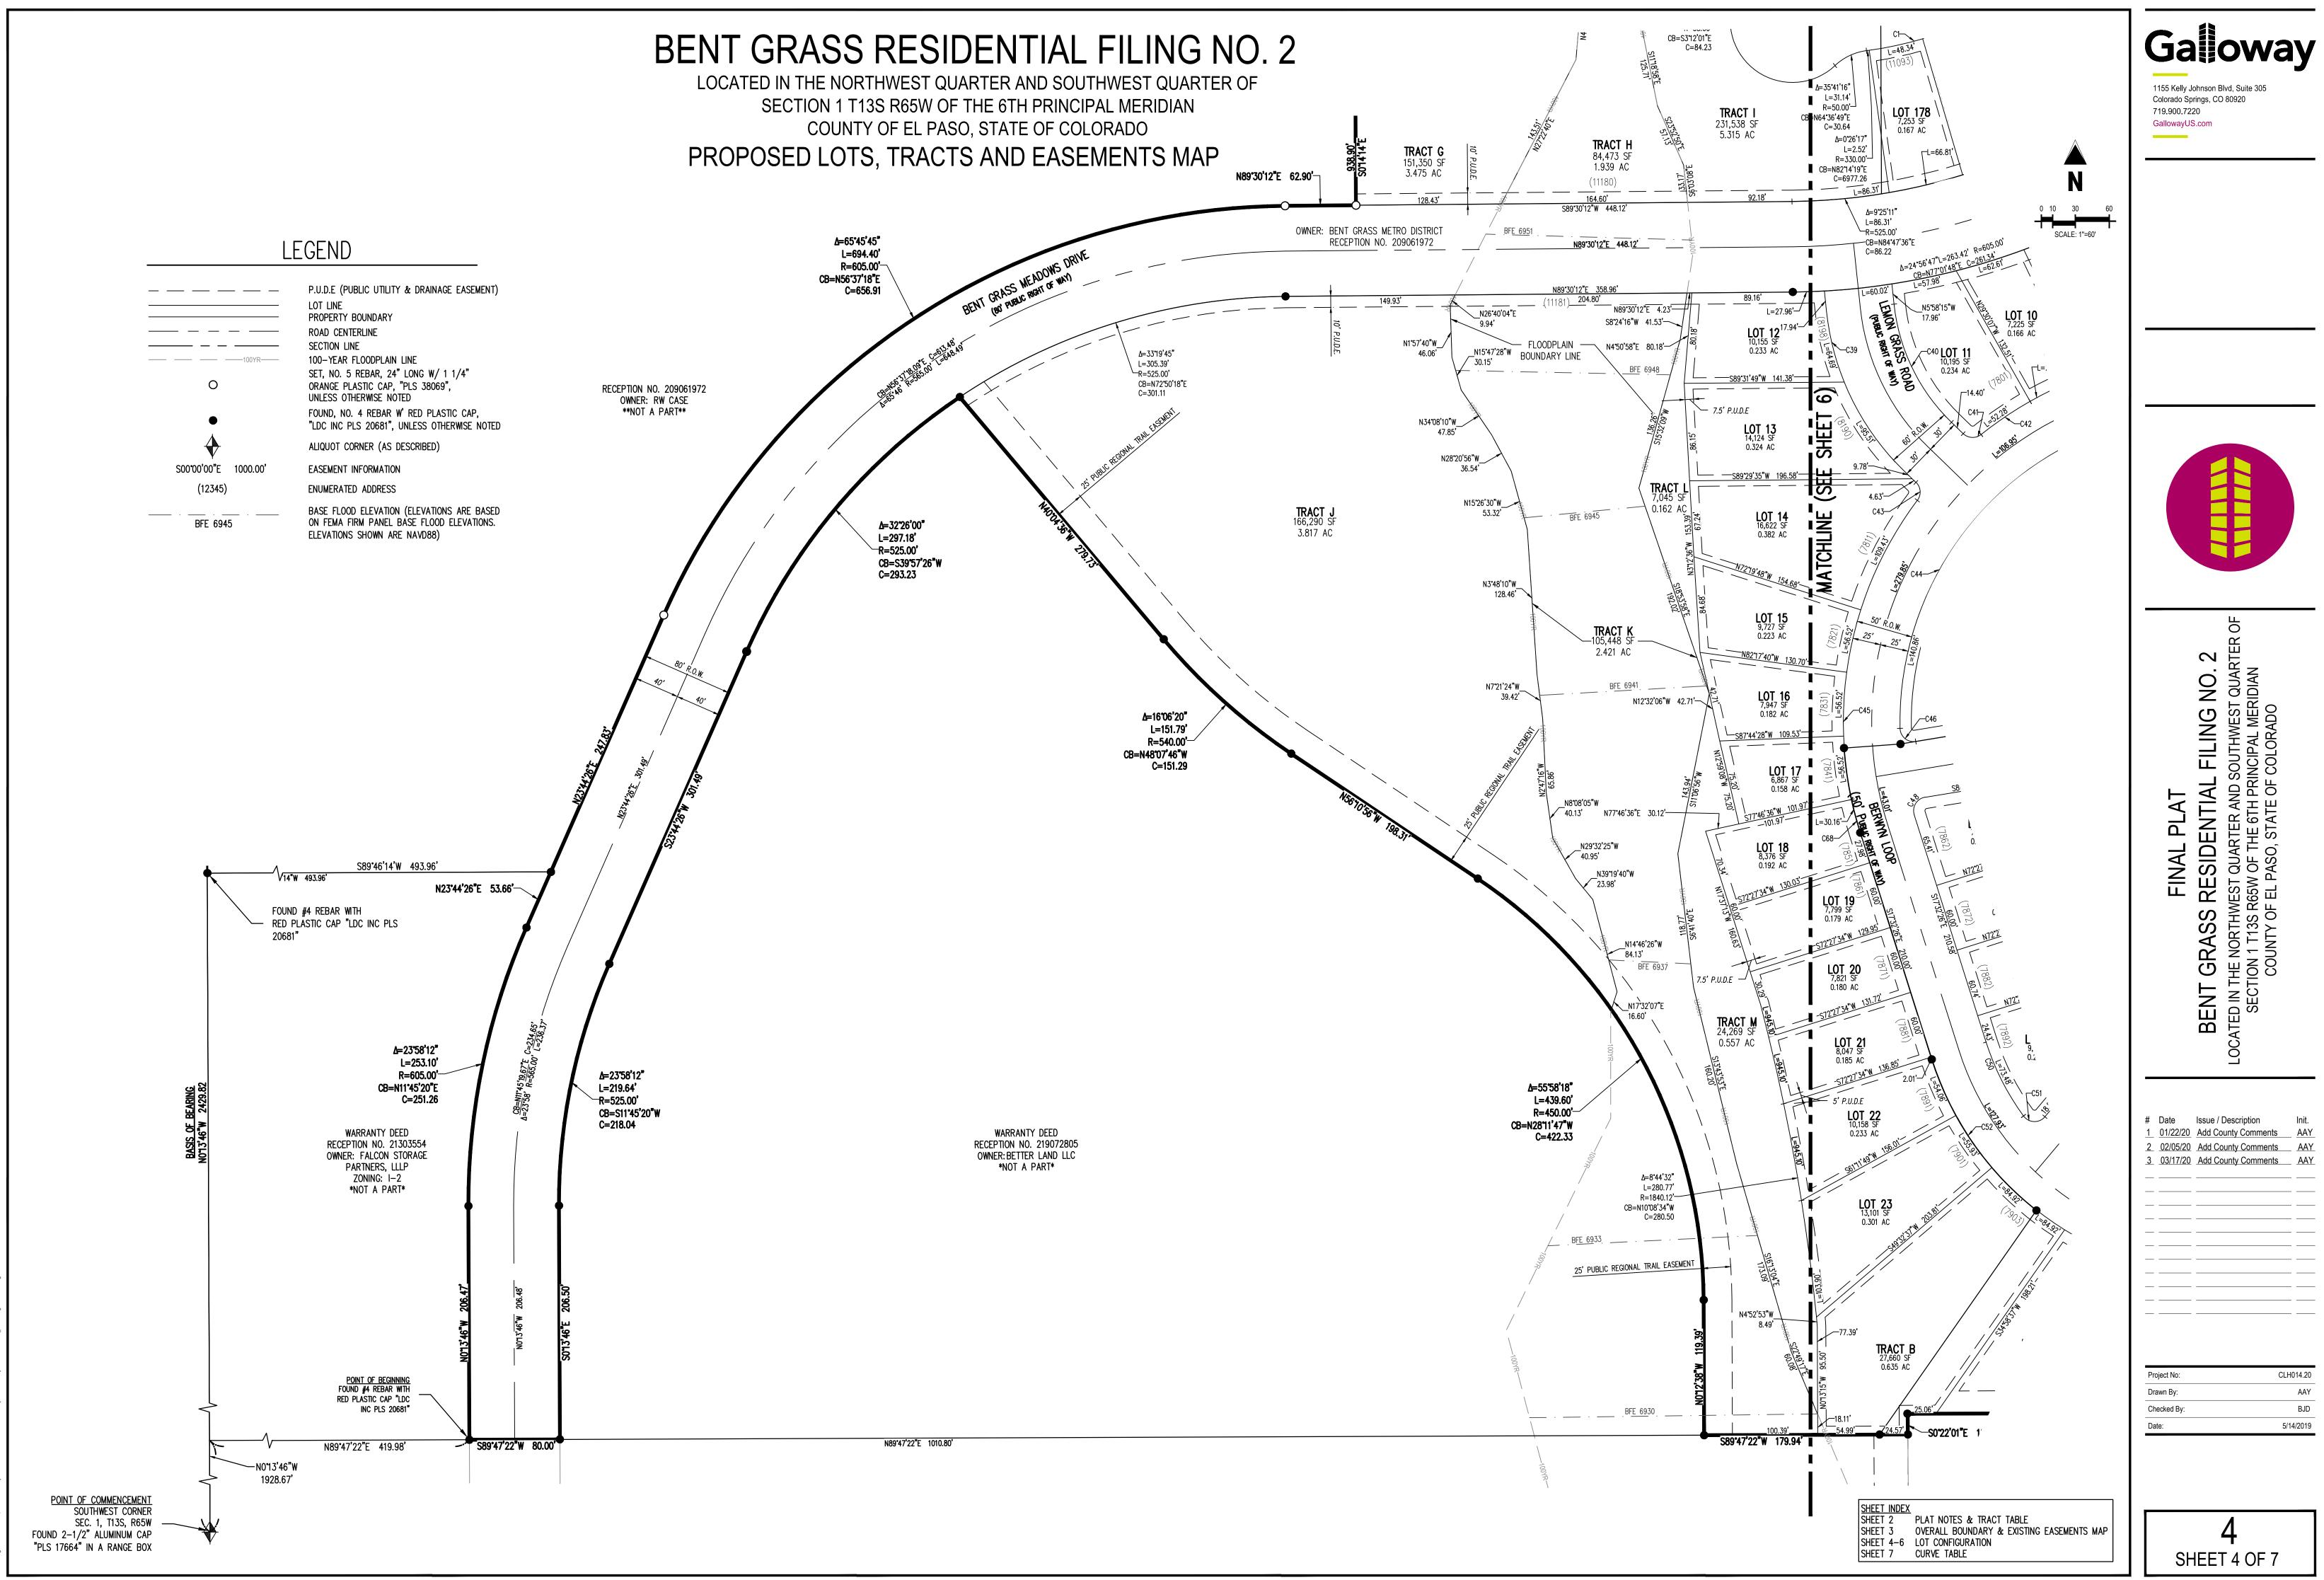

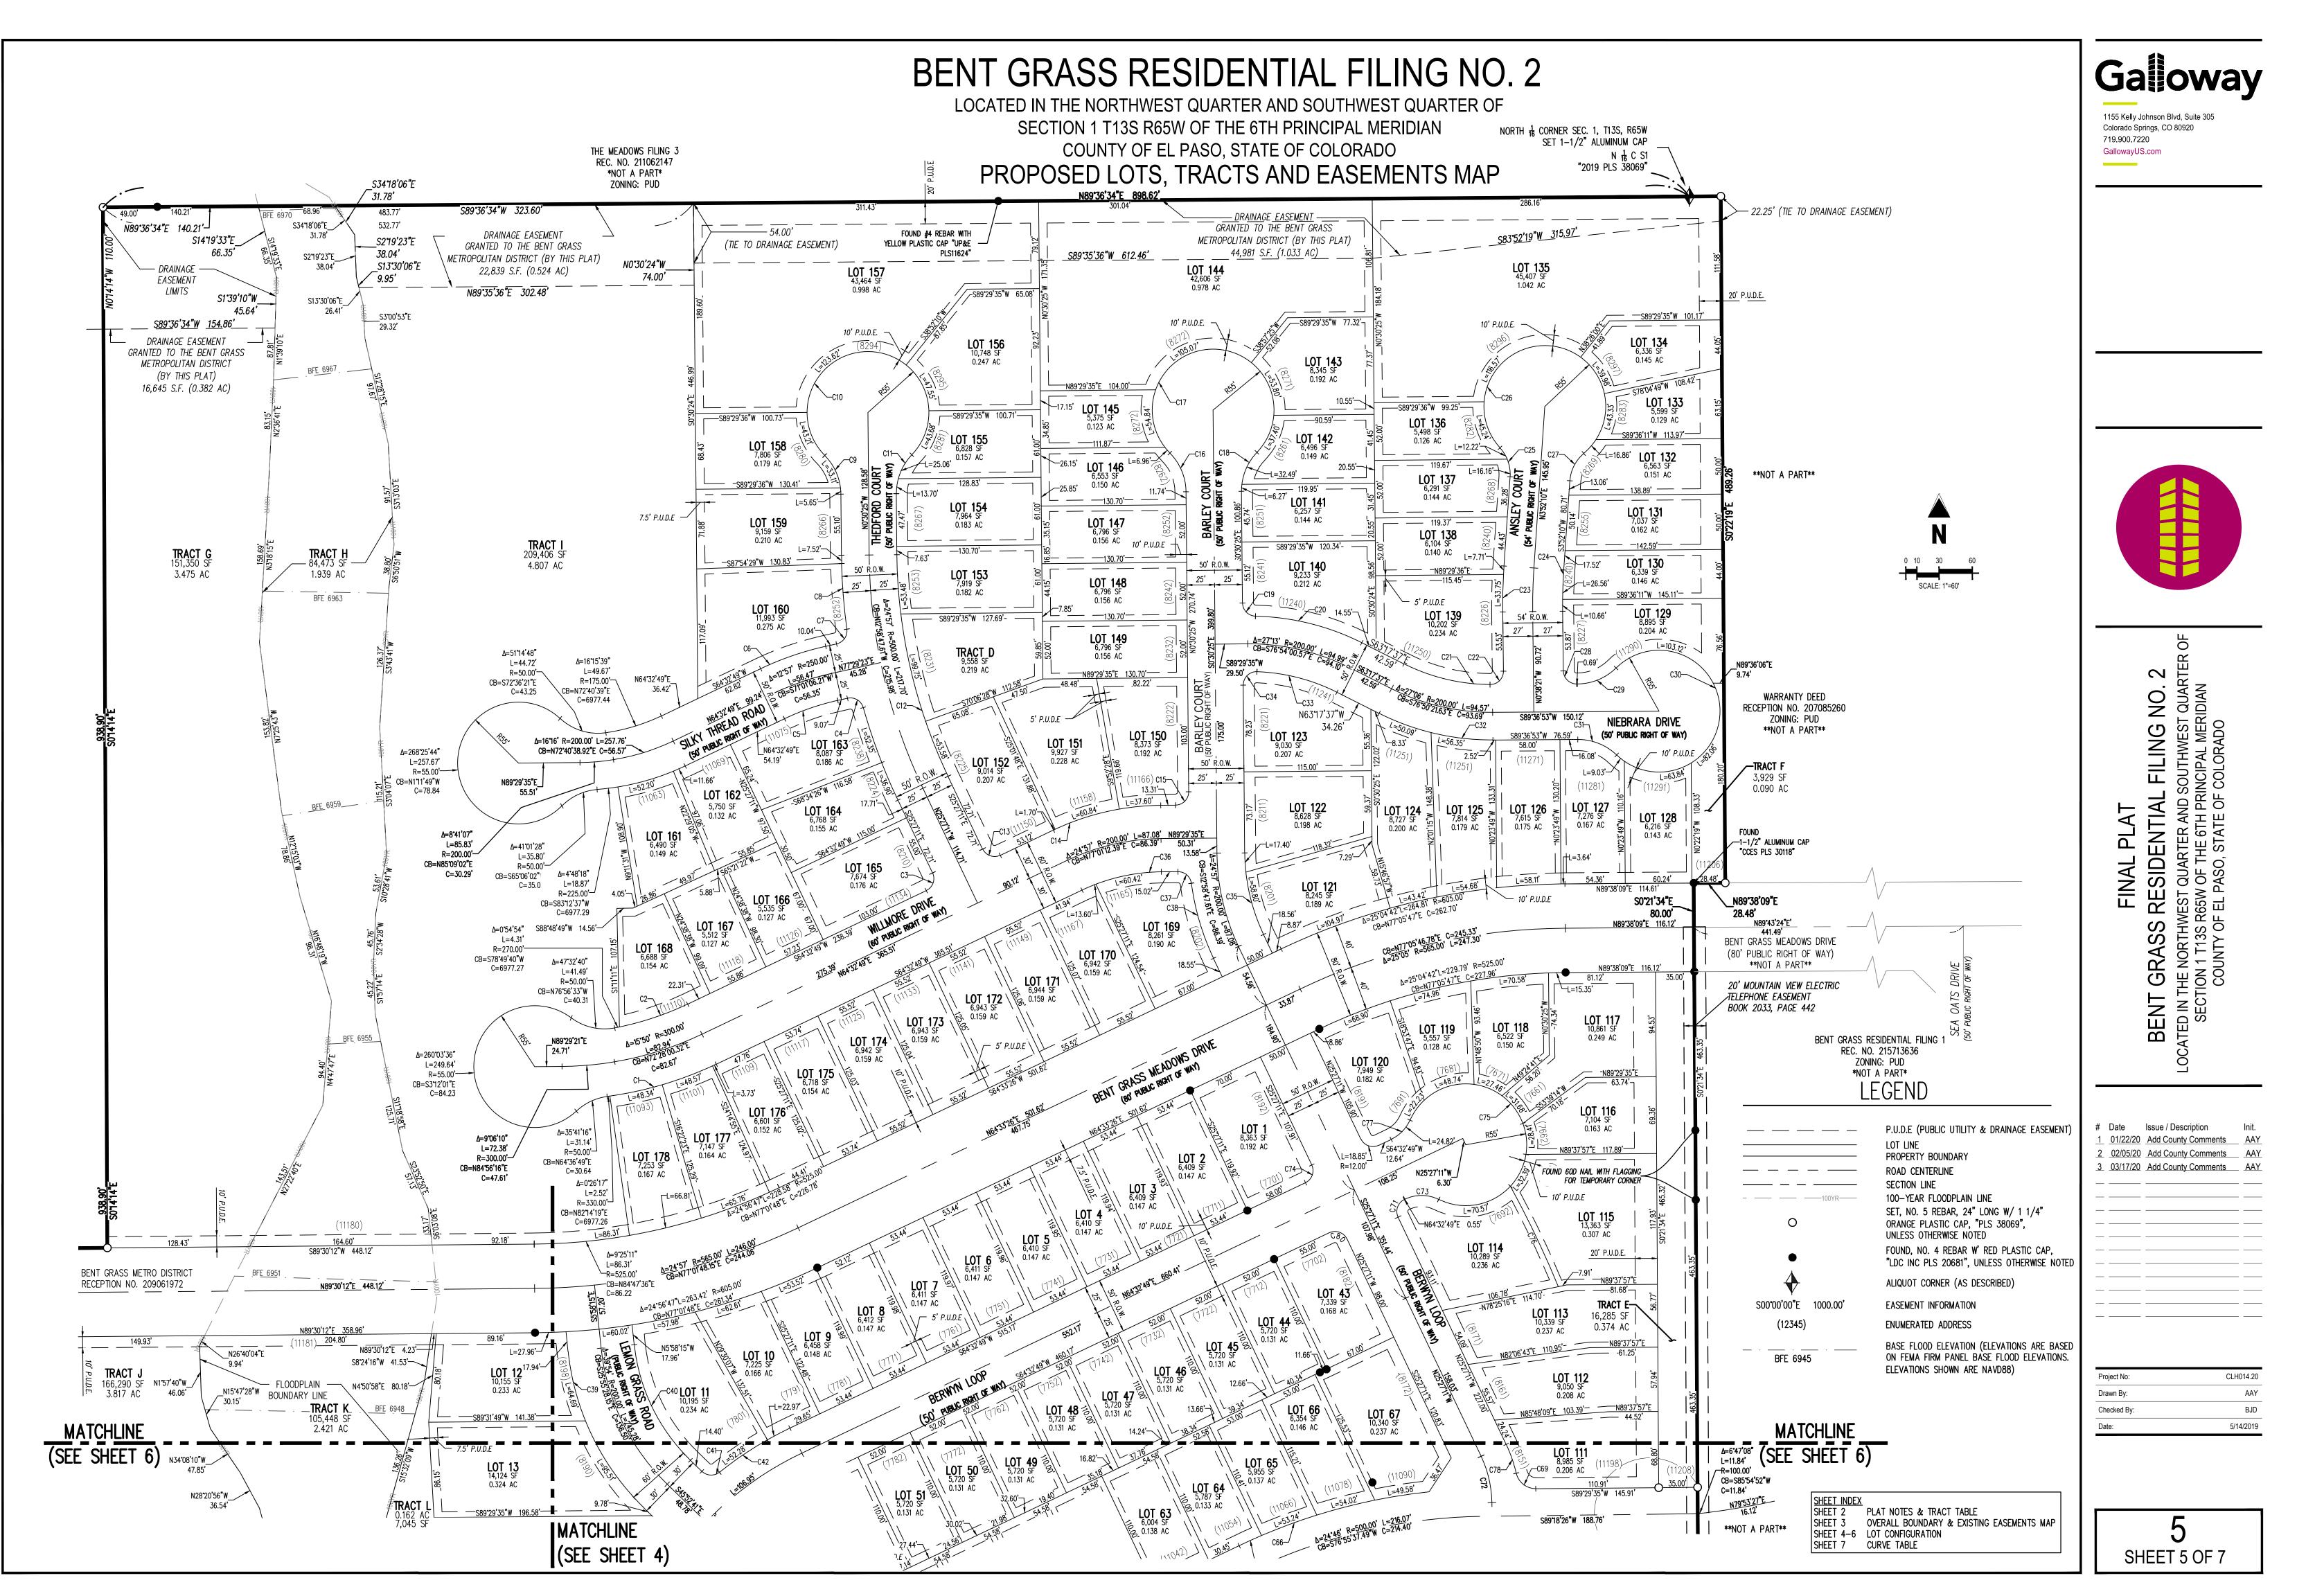

mes InclCO, El Paso County-CLH0000014.20-Bent Grass\Survey/CADD\Survey/PLATICLH00014\_PLAT.dwg - Adam Young - 3/19/2020

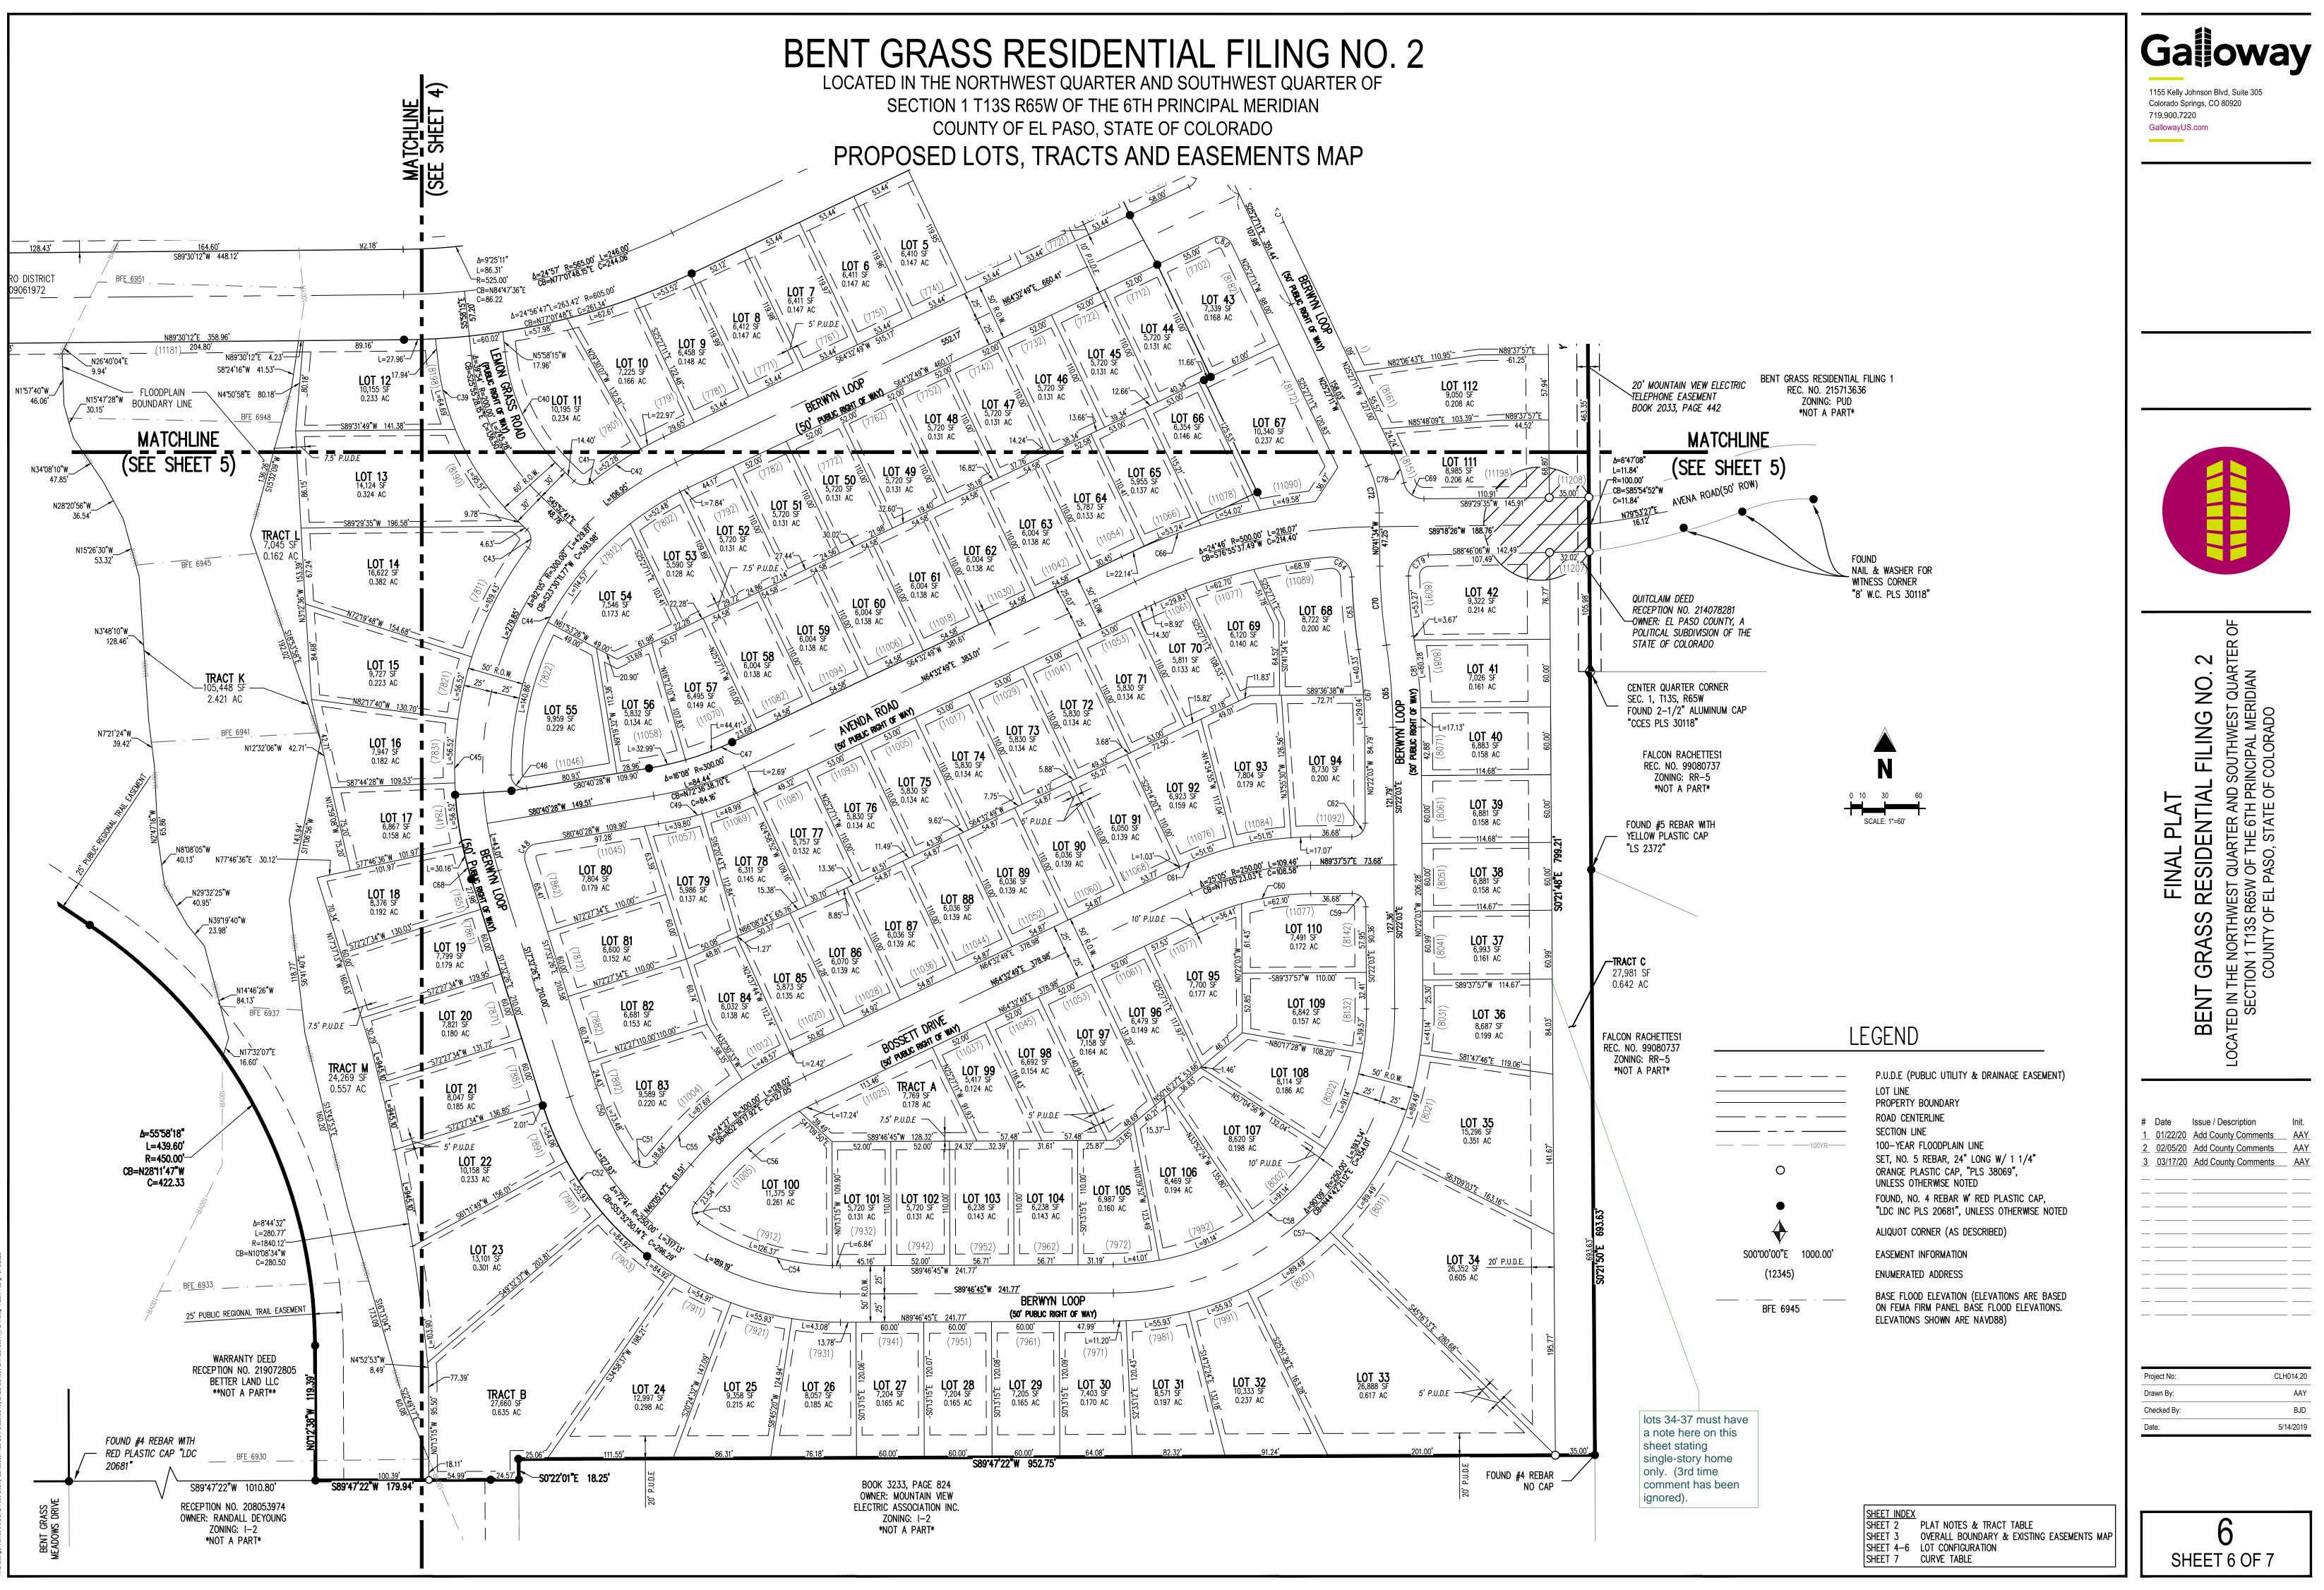

		PARCEL CI	JRVE SEGME	NT TABLE	
CURVE TAG #	DELTA	LENGTH (FT)	RADIUS (FT)	CHORD BEARING	CHORD LENGTH
C1	17 <b>°</b> 28'21"	100.63	330.00	S7317'00"W	100.25
C2	13•49'23"	65.14	270.00	S71*27'31"W	64.98
C3	90°00'00"	18.85	12.00	S19 <b>*</b> 32'49"W	16.97
C4	86°47'51"	18.18	12.00	S59°06'41"E	16.49
C5	12*56'34"	50.83	225.00	N71°01'06"E	50.72
C6	12*56'34"	62.12	275.00	S71°01'06"W	61.99
C7	8518'00"	17.87	12.00	N34°50'23"E	16.26
C8	6 <b>°</b> 28'57"	59.40	525.00	S4*34'09"E	59.37
C9	44°24'55"	38.76	50.00	N22*42'52"W	37.80
C10	268•49'50"	258.06	55.00	S89*29'35"W	78.57
C11	44°24'55"	38.76	50.00	S21*42'03"W	37.80
C12	24 <b>°</b> 56'46"	206.81	475.00	S12*58'48"E	205.18
C13	90°00'00"	18.85	12.00	N70°27'11"W	16.97
C14	24 <b>°</b> 56'46"	100.14	230.00	S77*01'12"W	99.35
C15	90°00'00"	18.85	12.00	N44°29'35"E	16.97
C17	268*49'50"	258.06	55.00	S89*29'35"W	78.57
C18	44°24'55"	38.76	50.00	S21°42'03"W	37.80
C19	88"11'13"	18.47	12.00	S44°36'01"E	16.70
C20	25 <b>°</b> 24'01"	99.75	225.00	N75 <b>*</b> 59'37"W	98.93
C21	26 <b>°</b> 22'14"	80.54	175.00	S76°28'44"E	79.84

PARCEL CURVE SEGMENT TABLE						
CURVE TAG #	DELTA	LENGTH (FT)	RADIUS (FT)	CHORD BEARING	CHORD LENGTH (FT)	
C62	90°00'00"	18.85	12.00	N44°37'57"E	16.97	
C63	6"18'42"	64.57	586.17	S512'38"E	64.54	
C64	93 <b>°</b> 28'28"	29.37	18.00	N48 <b>*</b> 25'26"W	26.22	
C65	8°22'02"	73.02	500.00	N4°33'04"W	72.95	
C66	11*42'20"	107.26	525.00	S72 <b>*</b> 39'49"W	107.07	
C67	8°22'02"	69.37	475.00	N4°33'04"W	69.30	
C68	5"19'02"	30.16	325.00	S14*52'55"E	30.15	
C69	77*42'32"	24.41	18.00	N51°39'08"W	22.58	
C70	8°02'30"	70.18	500.00	N4*42'49"W	70.12	
C71	90°00'00"	18.85	12.00	N19 <b>*</b> 32'49"E	16.97	
C72	24•45'36"	43.21	100.00	N13°04'23"W	42.88	
C73	51 <b>°</b> 46'05"	31.62	35.00	S89*34'08"E	30.56	
C74	90°00'00"	18.85	12.00	S19 <b>°</b> 32'49"W	16.97	
C75	272*23'53"	261.48	55.00	N19*53'03"W	76.14	
C76	6"11'03"	100.38	930.00	S25°28'44"E	100.33	
C77	40°37'48"	24.82	35.00	S4413'55"W	24.30	
C78	12 <b>°</b> 39'18"	27.61	125.00	N19 <b>°</b> 07'32"W	27.55	
C79	90 <b>°</b> 32'43"	28.45	18.00	S43*29'45"W	25.58	
C80	90°00'00"	18.85	12.00	N70°27'11"W	16.97	
C81	6 <b>°</b> 34'27"	60.28	525.33	N5 <b>°</b> 31'30"W	6977.52	

## BENT GRASS RESIDENTIAL FILING NO. 2 LOCATED IN THE NORTHWEST QUARTER AND SOUTHWEST QUARTER OF

SECTION 1 T13S R65W OF THE 6TH PRINCIPAL MERIDIAN COUNTY OF EL PASO, STATE OF COLORADO

### CURVE TABLE

NGTH	(FT
25	
98	
97	
49	
72	
99	
26	
37	
30	
57	
80	
.18	
97	
35	
97	
57	
30	
70	
33	

	PARCEL CURVE SEGMENT TABLE				
CURVE TAG ;	# DELTA	LENGTH (FT)	RADIUS (FT)	CHORD BEARING	CHORD LENGTH (FT)
C22	90 <b>°</b> 58'30"	19.05	12.00	N44°50'54"E	17.11
C23	4°30'31"	41.47	527.00	S1°36'54"W	41.46
C24	4°30'31"	37.22	473.00	S1°36'54"W	37.21
C25	46 <b>°</b> 27'28"	28.38	35.00	N19 <b>*</b> 21'34"W	27.61
C26	272*54'56"	261.98	55.00	N86°07'50"W	75.78
C27	46 <b>°</b> 27'28"	28.38	35.00	S27 <b>*</b> 05'54"W	27.61
C28	89 <b>°</b> 49'07"	18.81	12.00	S45*28'33"E	16.94
C29	44 <b>°</b> 24'55"	38.76	50.00	N67°24'26"E	37.80
C30	268*49'50"	258.06	55.00	N0°23'07"W	78.57
C31	44 <b>°</b> 24'55"	38.76	50.00	N68°10'39"W	37.80
C32	27*06'12"	106.43	225.00	S76*50'43"E	105.45
C33	24 <b>°</b> 34'36"	75.07	175.00	N75°34'55"W	74.49
C34	92 <b>°</b> 38'11"	19.40	12.00	S45*48'41"W	17.36
C35	24 <b>°</b> 56'46"	76.19	175.00	S12*58'48"E	75.59
C36	24 <b>°</b> 56'46"	74.02	170.00	S77*01'12"W	73.43
C37	83°06'42"	17.41	12.00	N48*57'03"W	15.92
C38	18'03'29"	70.91	225.00	N16°25'26"W	70.62
C39	39 <b>°</b> 54'27"	160.20	230.00	S25*55'28"E	156.98
C40	39 <b>°</b> 54'27"	118.41	170.00	N25 <b>*</b> 55'28"W	116.03
C41	82*50'26"	17.35	12.00	N87"17'55"W	15.88

PARCEL CURVE SEGMENT TABLE					
CURVE TAG #	DELTA	LENGTH (FT)	RADIUS (FT)	CHORD BEARING	CHORD LENGTH (FT
C42	13"15'57"	75.25	325.00	S57*54'51"W	75.08
C43	82*50'26"	17.35	12.00	S4°27'28"E	15.88
C44	64 <b>°</b> 09'09"	307.91	275.00	S30*50'18"W	292.08
C45	54 <b>°</b> 30'11"	309.16	325.00	S9°42'40"W	297.63
C46	98 <b>°</b> 05'15"	20.54	12.00	S50°16'54"E	18.13
C47	16 <b>°</b> 07'39"	77.41	275.00	S72 <b>*</b> 36'39"W	77.15
C48	98°12'54"	20.57	12.00	S31*34'01"W	18.14
C49	15 <b>°</b> 39'11"	88.79	325.00	S72*50'52"W	88.51
C50	18 <b>•</b> 42'42"	73.48	225.00	S26*53'47"E	73.15
C51	103•39'06"	21.71	12.00	S88°04'41"E	18.87
C52	72*40'49"	348.84	275.00	S53*52'50"E	325.92
C53	96 <b>°</b> 23'46"	20.19	12.00	N8°06'06"W	17.89
C54	33*55'15"	133.21	225.00	N7315'37"W	131.27
C55	24 <b>°</b> 27'03"	138.69	325.00	S5219'18"W	137.64
C56	20 <b>°</b> 51'31"	100.11	275.00	N50°31'32"E	99.56
C57	90°08'49"	432.67	275.00	N44°42'21"E	389.41
C58	90°08'49"	354.01	225.00	S44°42'21"W	318.61
C59	90°00'00"	18.85	12.00	S45°22'03"E	16.97
C60	25 <b>°</b> 05'07"	98.51	225.00	N77 <b>°</b> 05'23"E	97.73
C61	25 <b>°</b> 05'07"	120.40	275.00	S77°05'23"W	119.44

)	

HEET	INDEX	
HEET	2	PLAT NOTES & TRACT TABLE
SHEET	3	OVERALL BOUNDARY & EXISTING EASEMENTS MAP
HEET	4–6	LOT CONFIGURATION
HEET	7	CURVE TABLE

Galloway 1155 Kelly Johnson Blvd, Suite 305 Colorado Springs, CO 80920 719.900.7220 GallowayUS.com \_\_\_\_\_

FINAL PLAT	<b>BENT GRASS RESIDENTIAL FILING NO. 2</b>	V OF THE 61	COUNTY OF EL PASO, STATE OF COLORADO	
	Add Co Add Co	Description Dunty Comme Dunty Comme Dunty Comme Dunty Comme Dunty Comme	ents	AA
Project No: Drawn By: Checked By:			CLH	)14.2 AA BJE

7
SHEET 7 OF 7

### Plat V\_4 b redlines.pdf Markup Summary

dsdparsons (3)		
11.0 LOARD WE IT SEE THE SEENAL FUR 2.0 FEE C.2 FEE RETURN NOTE: LOT 54, 35, 34, 37 ARE RESPECTED OF 38 RETURN TO COMPARE SEENAL 7.0 FEAL FLOOD SERVICE AND WE FOR ALL 1.0 FEELS OF COMPARE OF COMPARE OF COMPARE 1.0 FEELS OF COMPARE OF COMPARE OF COMPARE OF COMPARE 1.0 FEELS OF COMPARE OF COMPARE OF COMPARE OF COMPARE 1.0 FEELS OF COMPARE OF COMPARE OF COMPARE OF COMPARE 1.0 FEELS OF COMPARE OF COMPARE OF COMPARE OF COMPARE 1.0 FEELS OF COMPARE OF COMPARE OF COMPARE OF COMPARE 1.0 FEELS OF COMPARE OF C	Subject: Callout Page Label: [1] SHEET 2 Author: dsdparsons Date: 4/16/2020 9:56:25 AM Status: Color: Layer: Space:	"single-story" homes and 25 feet.
TURNET A une de la construir d	Subject: Callout Page Label: [1] SHEET 2 Author: dsdparsons Date: 4/16/2020 9:57:16 AM Status: Color: Layer: Space:	The EI Paso County Board of County Commissioners disclaims any interest in the temporary turn around easement purported to be conveyed to El Paso County by quitclaim deed recorded at Reception No. 214078281, as such easement was never accepted by the County in accordance with legal requirements. To the extent that El Paso County may nonetheless have an interest in such easement, the Board of County Commissioners hereby consents to the vacation of such easement.
	Subject: Callout Page Label: [1] SHEET 6 Author: dsdparsons Date: 4/3/2020 12:28:45 PM Status: Color: Layer: Space:	lots 34-37 must have a note here on this sheet stating single-story home only. (3rd time comment has been ignored).