



please provide the height of the building along with unit of measurement.

if there will be lighting mounted on the building, please show it.

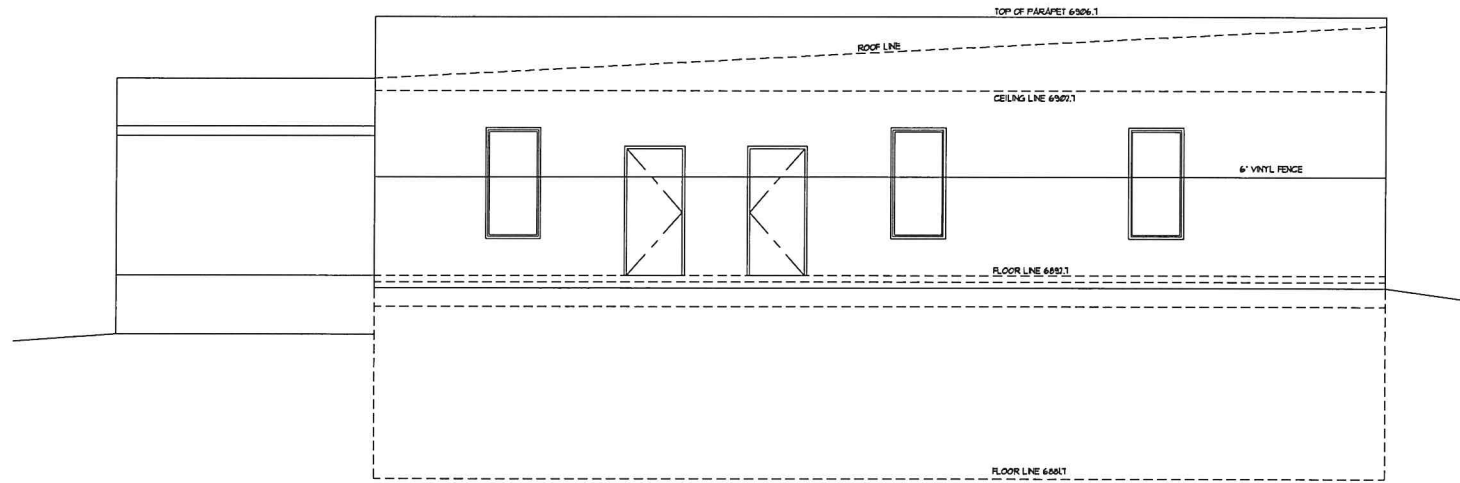

EAST ELEVATION
SCALE: 1/8"=1'-0"

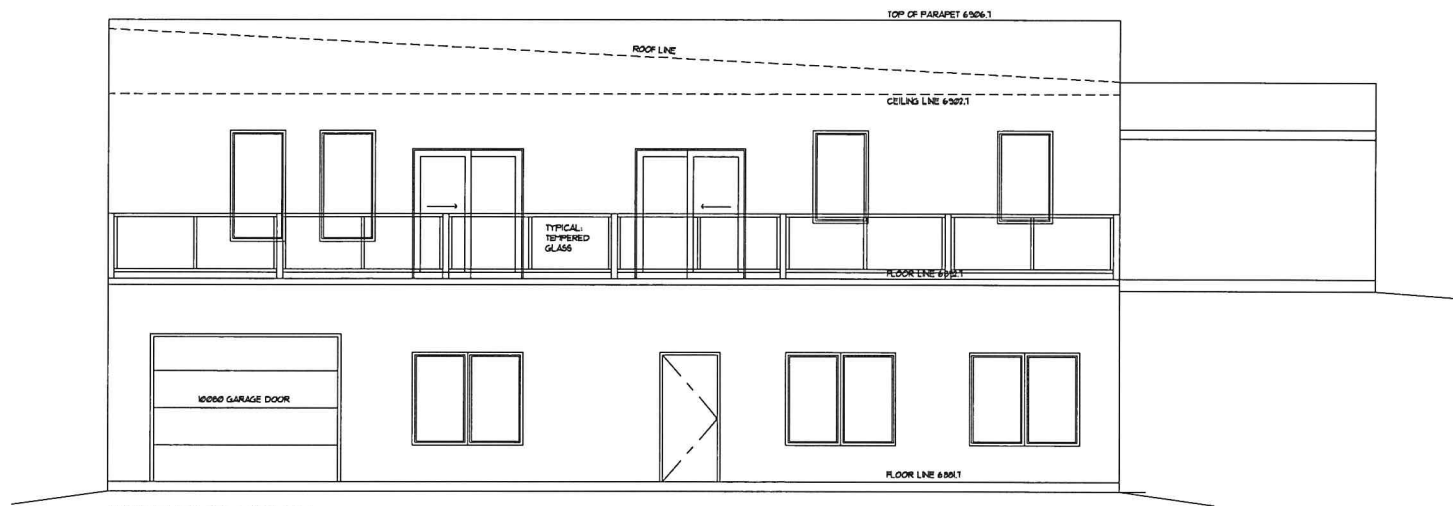

WEST ELEVATION
SCALE: 1/8"=1'-0"

REVISION	BY


Crossroads Chapel
5030 Silver Drive, Colorado Springs, CO 80921
Phone: 719-243-4888
Eastgate Building
745 E Highway 24, Colorado Springs, CO
Suites 100, 105, 110, 115, 120, 125
TR A Highway 24 Eastgate Business Park
EX Purpose: Unit D in Building 1, EX Building 4

RJM Designs
Robert J. Mainier
ARCHITECT/PLANNER
cell: (719) 660-6183
rjmainier@aol.com


SQUARE FOOTAGE	
Main Floor Plan	3575 SF
Lower Floor Plan	4535 SF
Garage	3400 SF
Deck	1310 SF

DRAWN	RJM
CHECKED	RJM
DATE	02 / 05 / 2021
JOB NO.	20-181
SHEET NO.	

A-4

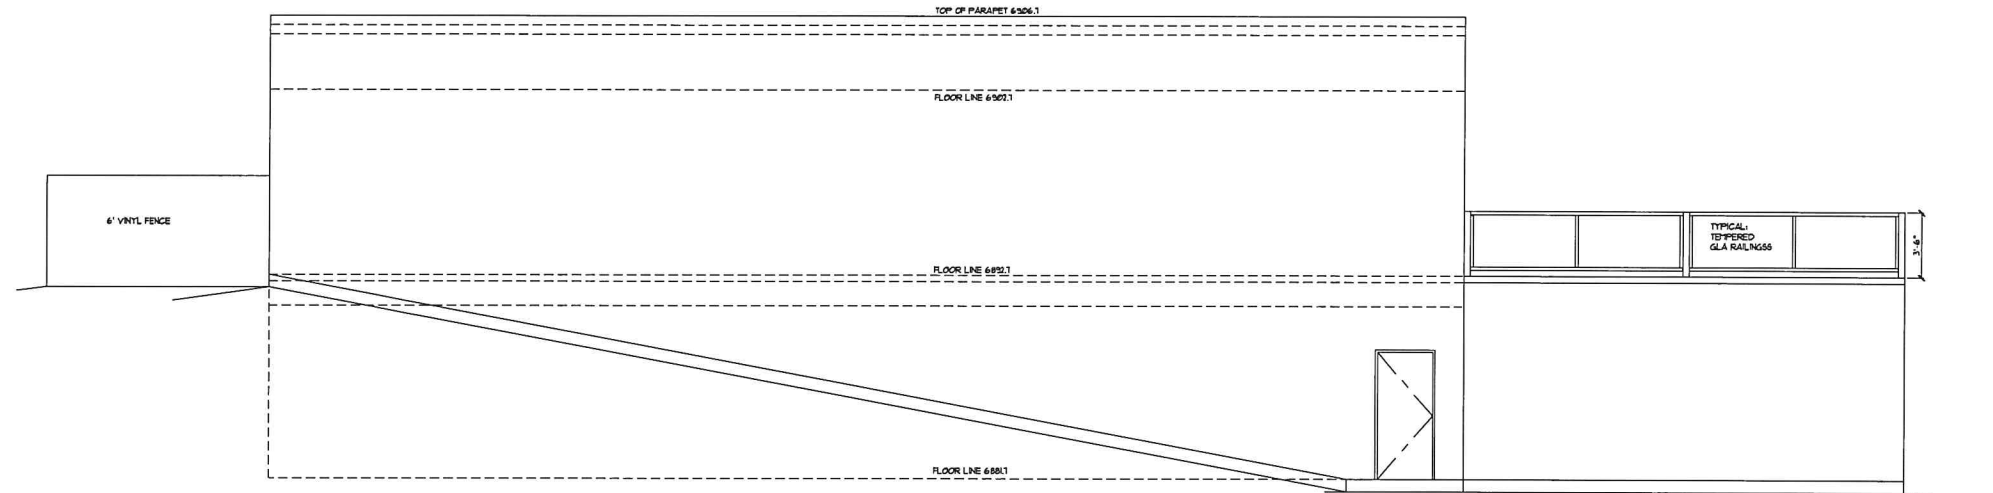

NORTH ELEVATION
SCALE: 1/4"=1'-0"

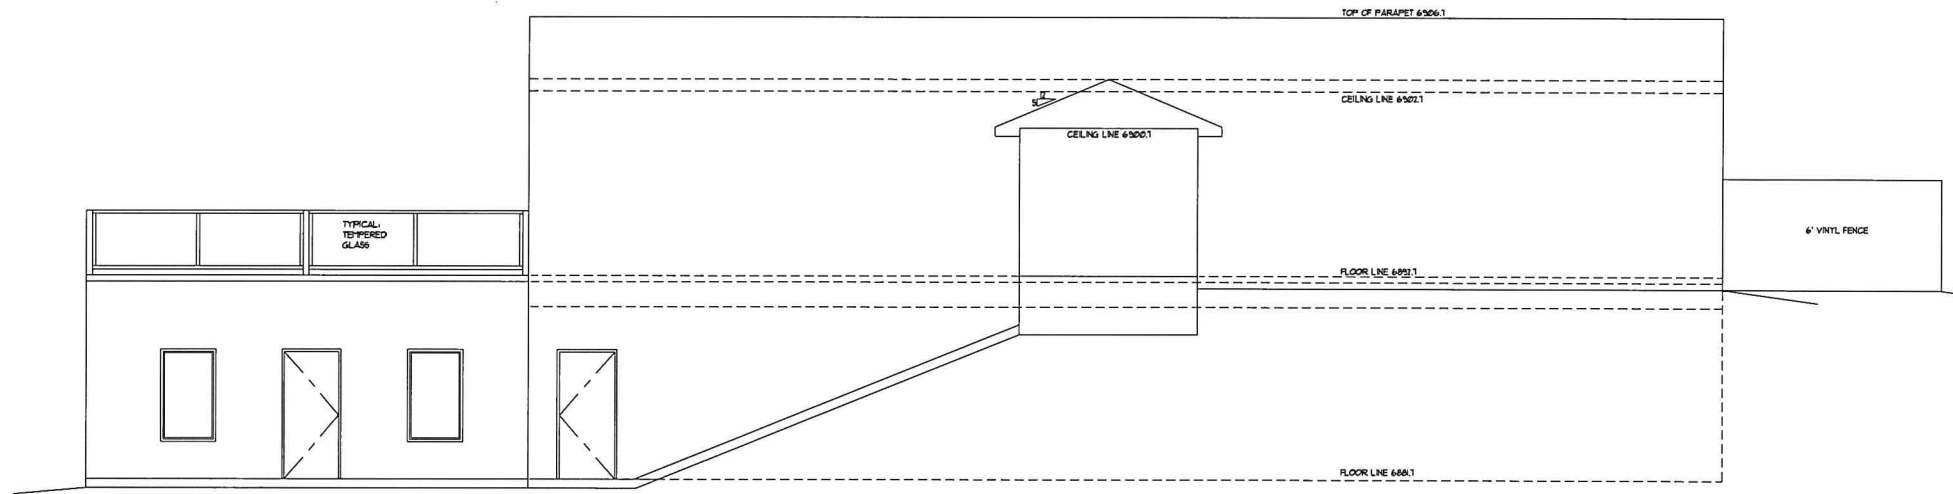

SOUTH ELEVATION
SCALE: 1/4"=1'-0"

NO.	BY

Crossroads Chapel
5930 Silver Drive, Colorado Springs, CO 80921
Phone 719-243-4188
Eastgate Building
1745 E Highway 24, Colorado Springs, CO
Suites 100, 105, 110, 115, 120, 125
TR A Highway 74 Eastgate Business Park,
EX Purposec Unit D in Building 1, EX Building 4

RJM Designs
Robert J. Maixner
ARCHITECT/PLANNER
cell (719) 660-4183
max@rjcdesign.com

SQUARE FOOTAGE	
Main Floor Plan	1579 SF
Lower Floor Plan	4335 SF
Garage	346 SF
Deck	1310 SF

DRAWN	RJM
CHECKED	RJM
SAY	02 / 08 / 2021
DATE	20-181
SHEET NO.	

A-3