



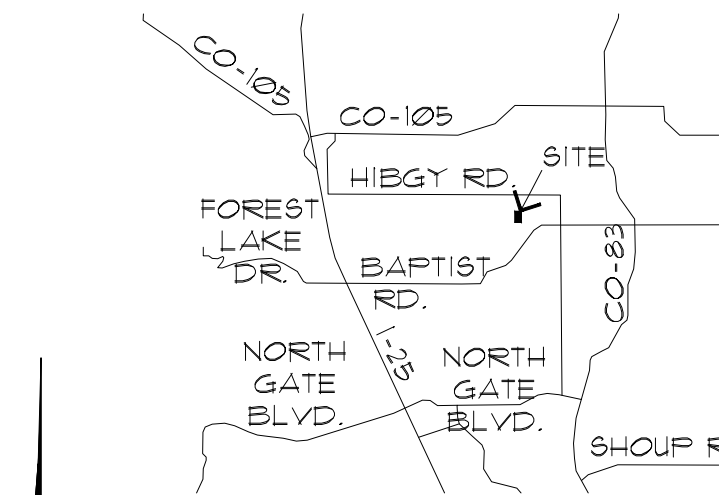


VICINITY MAP

NO SCALE

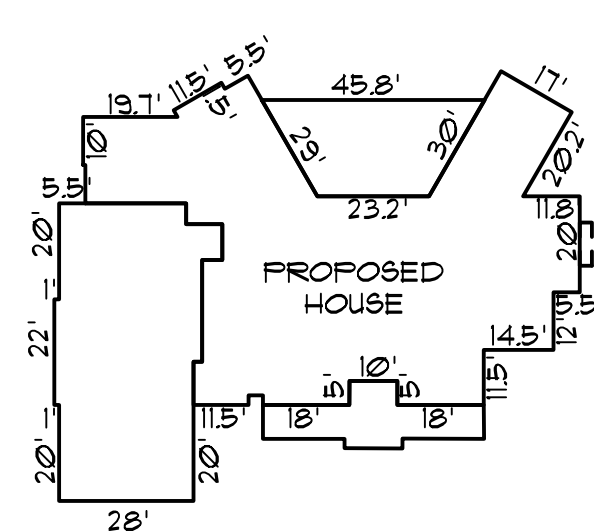


HOUSE FOOTPRINT

NO SCALE

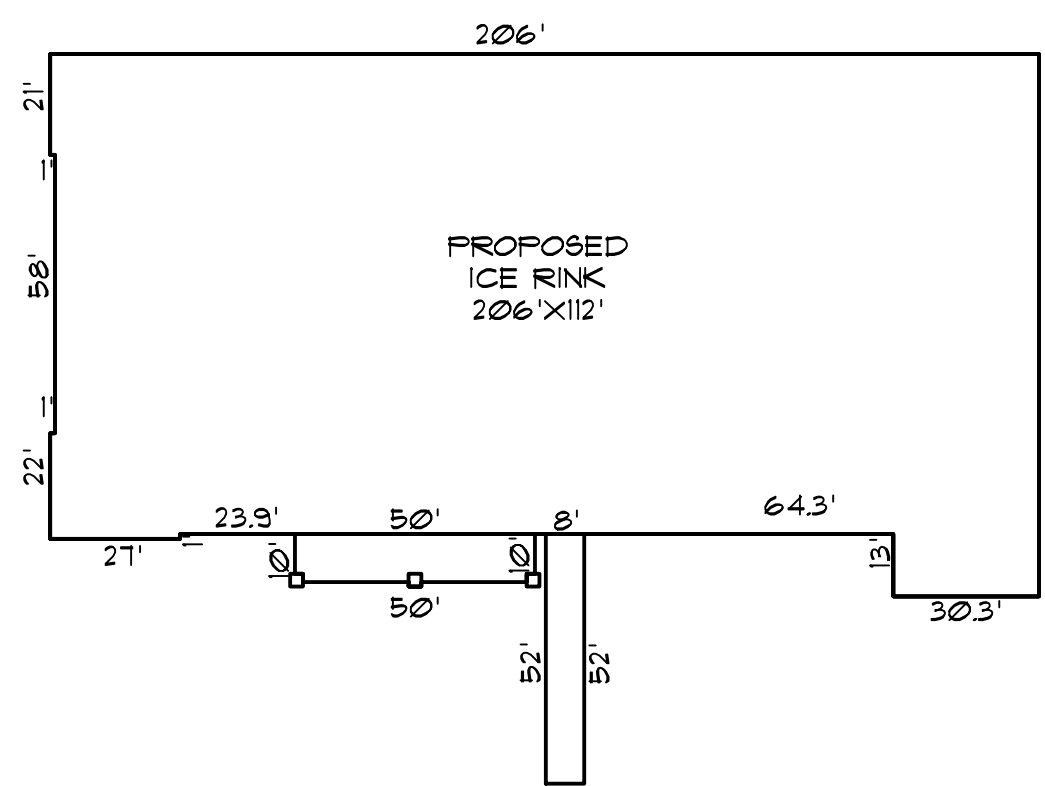

SPORTS COURT FOOTPRINT

NO SCALE

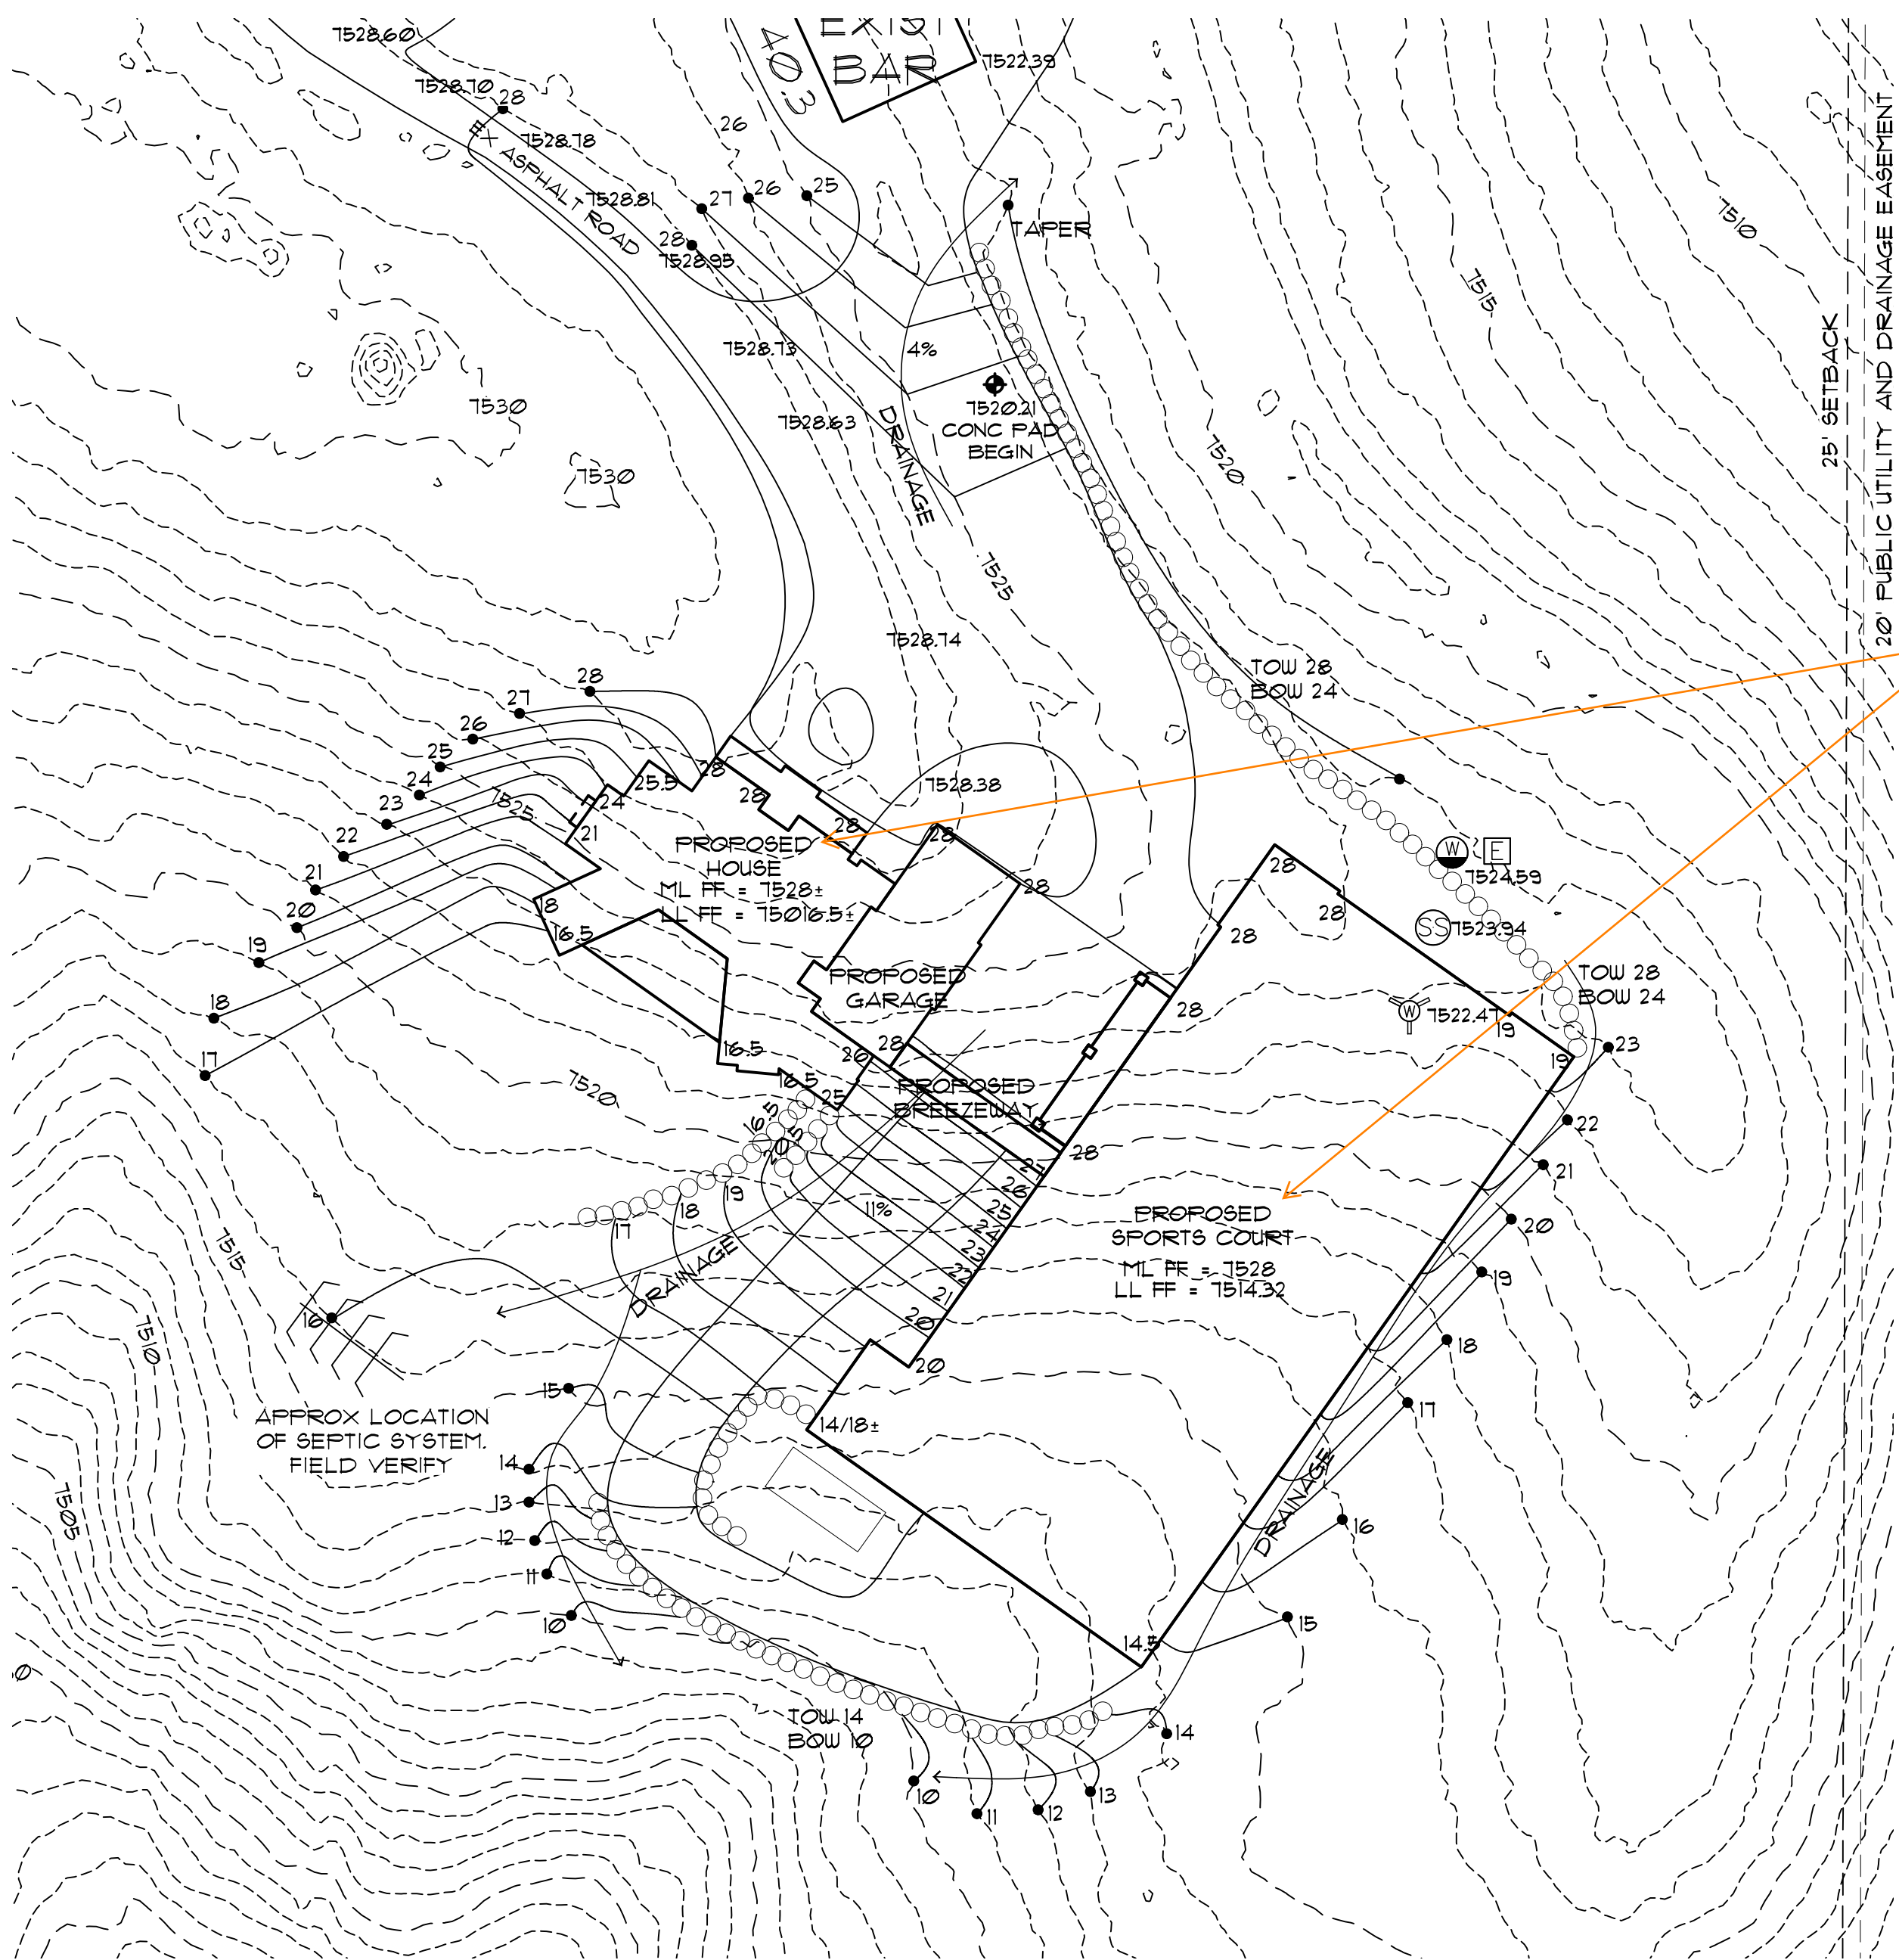

Please provide the impervious % for the lot (similar to lot coverage but includes all hard surfaces like driveways and parking).

Please clarify what is proposed vs existing at the time of the application. Recent aerial imagery shows the sports court is already constructed.

Show proposed location of construction control measures (e.g., culvert protection, perimeter control, vehicle tracking control, concrete washout area, etc.)

SITE PLAN



SCALE: 1" = 40'

NORTH


NOTE: THE CONTOURS SHOWN HEREON ARE AT A ONE-FOOT INTERVAL (NAVD83) AND WERE ACQUIRED FROM THE 2018 AERIAL LIDAR SURVEY FOR 3DEP AND ARE NOT GUARANTEED TO MEET CURRENT ASPRS, CDOT OR FGDC CONTOUR SPECIFICATIONS FOR A ONE-FOOT INTERVAL

SITE PLAN



SCALE: 1" = 80'

NORTH

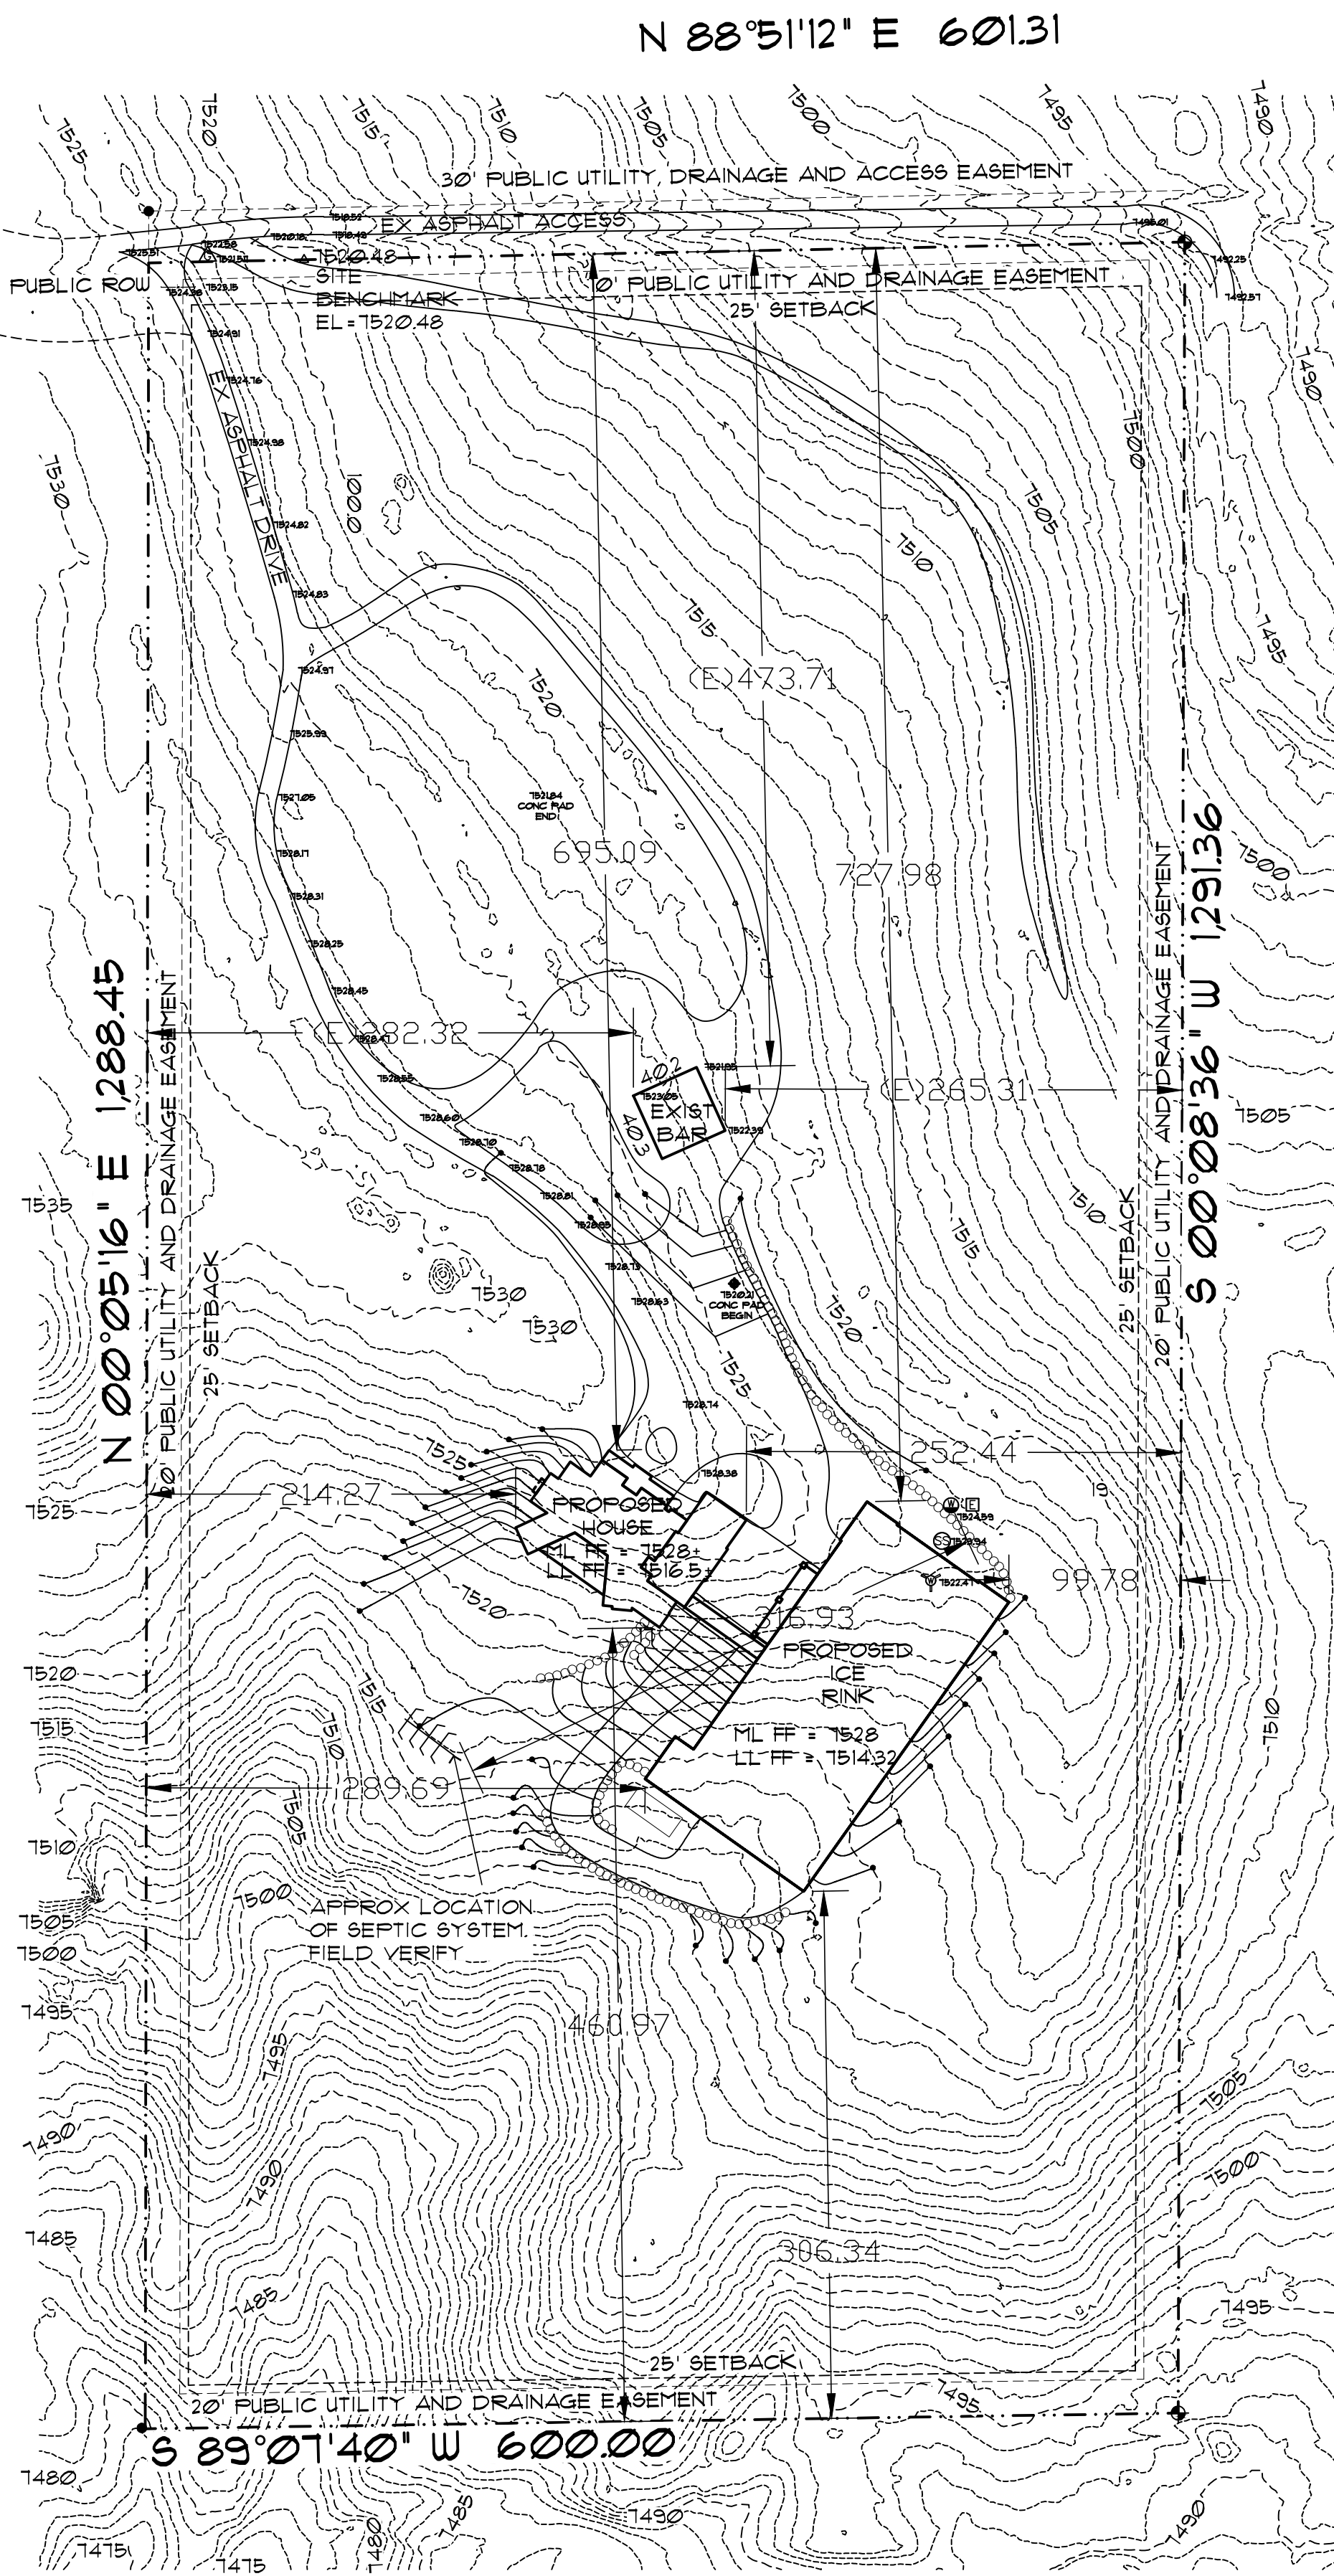

REFERENCE INFO:

TOPO INFO:
TERRA NOVA
ENGINEERING INC.
121 S. 23RD STREET
COLORADO SPRINGS, CO 80904
PHONE: (719) 635-6422
WWW.TNE
JOB: 2344.00
CONTRACTOR INFO:
DAVID HAMMER
HAMMER CUSTOM HOMES
20 COYOTE WILLOW DR
COLORADO SPRINGS, CO 80921
PHONE: (719) 332-3578

SITE INFO:

ADDRESS: 16735 HAPPY LANDINGS DRIVE
~~1905 VINE CLIFF HTG~~
LEGAL:
LOT 01, HAPPYLAND ESTATES,
FILING NO. 1,
EL PASO COUNTY, COLORADO.
SITE DATA:
LOT SIZE: 17.36 ACRE = 756,201.6 SQFT
BUILDING FOOTPRINT:
HOUSE = 4,178 SQFT
GARAGE = 1,823 SQFT
COV PORCH = 400 SQFT
DECK = 695 SQFT
ICE RINK = 20,919 SQFT
COV PORCH = 500 SQFT
BREEZEWAY = 416 SQFT
TOTAL = 28,985 SQFT
LOT COVERAGE = 3.8%
ZONING = RR-5
PLAT NO. = R13368
TAX SCHEDULE # = 61200-01-053
BUILDING HEIGHT = SEE ELEVATIONS

SITE NOTES:

- 1) Topographic information is to be supplied by others. See below for info.
- 2) Dashed lines indicate existing contours. Solid lines indicate proposed contours.
- 3) Contractor to verify easements.
- 4) Contractor to limit cut and fill areas and limit material and vehicle storage to the building areas in order to minimize vegetation and site disturbance.
- 5) Final landscaping to be determined by the Contractor/Owner(s). It shall minimize impact to the site. All landscaping to be completed by the Contractor/Owner(s).
- 6) Use wattles and silt fencing to minimize erosion during construction. And also stabilize area with seeded blankets for erosion control as necessary.
- 7) Earth materials are not to be stockpiled on streets or sidewalks, but on site or staging areas.
- 8) Contractor is required to provide positive drainage away from and around structure in all directions as shown.
- 9) Any boulder retaining walls shown shall be 48" max high and 48"-60" min apart laterally if (2) or more retaining walls exist. Or retaining walls shall be engineered by a licensed CO soils engineer.
- 10) General Contractor, Subcontractors, Suppliers, and Owner(s) shall familiarize themselves & verify all notes, dimensions and information on drawing(s) prior to starting construction. It shall be the responsibility of those parties to report any changes and/or discrepancies to the Designer. Questions regarding these drawings such as: drawing interpretation, dimensions, notes, scale and other similar questions shall be brought to the attention of the Designer immediately, in writing. Failure to do any of the above shall relieve the designer of any errors. Designer shall not be responsible for any changes not noted in writing to this plan.


SITE LEGEND:

- PROPERTY LINES & CORNERS
- EXISTING CONTOURS
PROPOSED CONTOURS
- PROPOSED BOULDER RETAINING WALL
- FOUND MONUMENT
ELECTRIC PEDESTAL
GAS METER
SANITARY SEWER MANHOLE
WELL HEAD
YARD HYDRANT
STORM DRAIN - 18" CIP
WIRE FENCE
- 00 = FINISH GRADE
NO ROCK OUT CROPPING EXIST AT SITE

SITE TERMS:

ABBREVIATIONS:
BOU= BOTTOM OF RETAINING WALL
(E)= EXISTING TO REMAIN
FF= FINISH FLOOR
LL= LOWER LEVEL
ML= MAIN LEVEL
(N)= NEW CONSTRUCTION
(R)= REMOVE
ROW= RIGHT OF WAY
SB= SETBACK
SQ. FT. OR SF= SQUARE FEET
TOF= TOP OF FOUNDATION
TOW= TOW OF RETAINING WALL
UL= UPPER LEVEL
WO= WALKOUT

REVISIONS

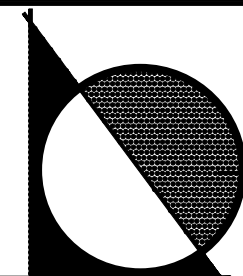

201 E. Las Animas Street Suite 113
Colorado Springs, CO. 80903
Phone: (719) 635-0880
Email: Office@LGAstudios.com
Website: www.lgastudios.com

CONTRACTOR
HAMMER HOMES INC.
CUSTOM HOME BUILDER
Colorado Springs, CO 80921
Phone: (719) 332-3578

THE CREPS SPORTS COURT
16735 HAPPY LANDING DR
COMPUTER FILE # 24-2425

DRAWN BY: EAH

CHECKED BY: LGA
PLOT 11/23/24 10:42 AM

SITE PLAN
VICINITY MAP
SITE NOTES

Sheet #
SP1
OF 1 Sheets