


# THE SHOP'S AT MERIDIAN RANCH

FILING NO. 1, LOT 4

PHOTOMETRIC PLAN

EL PASO COUNTY, COLORADO.

FALCON, COLORADO

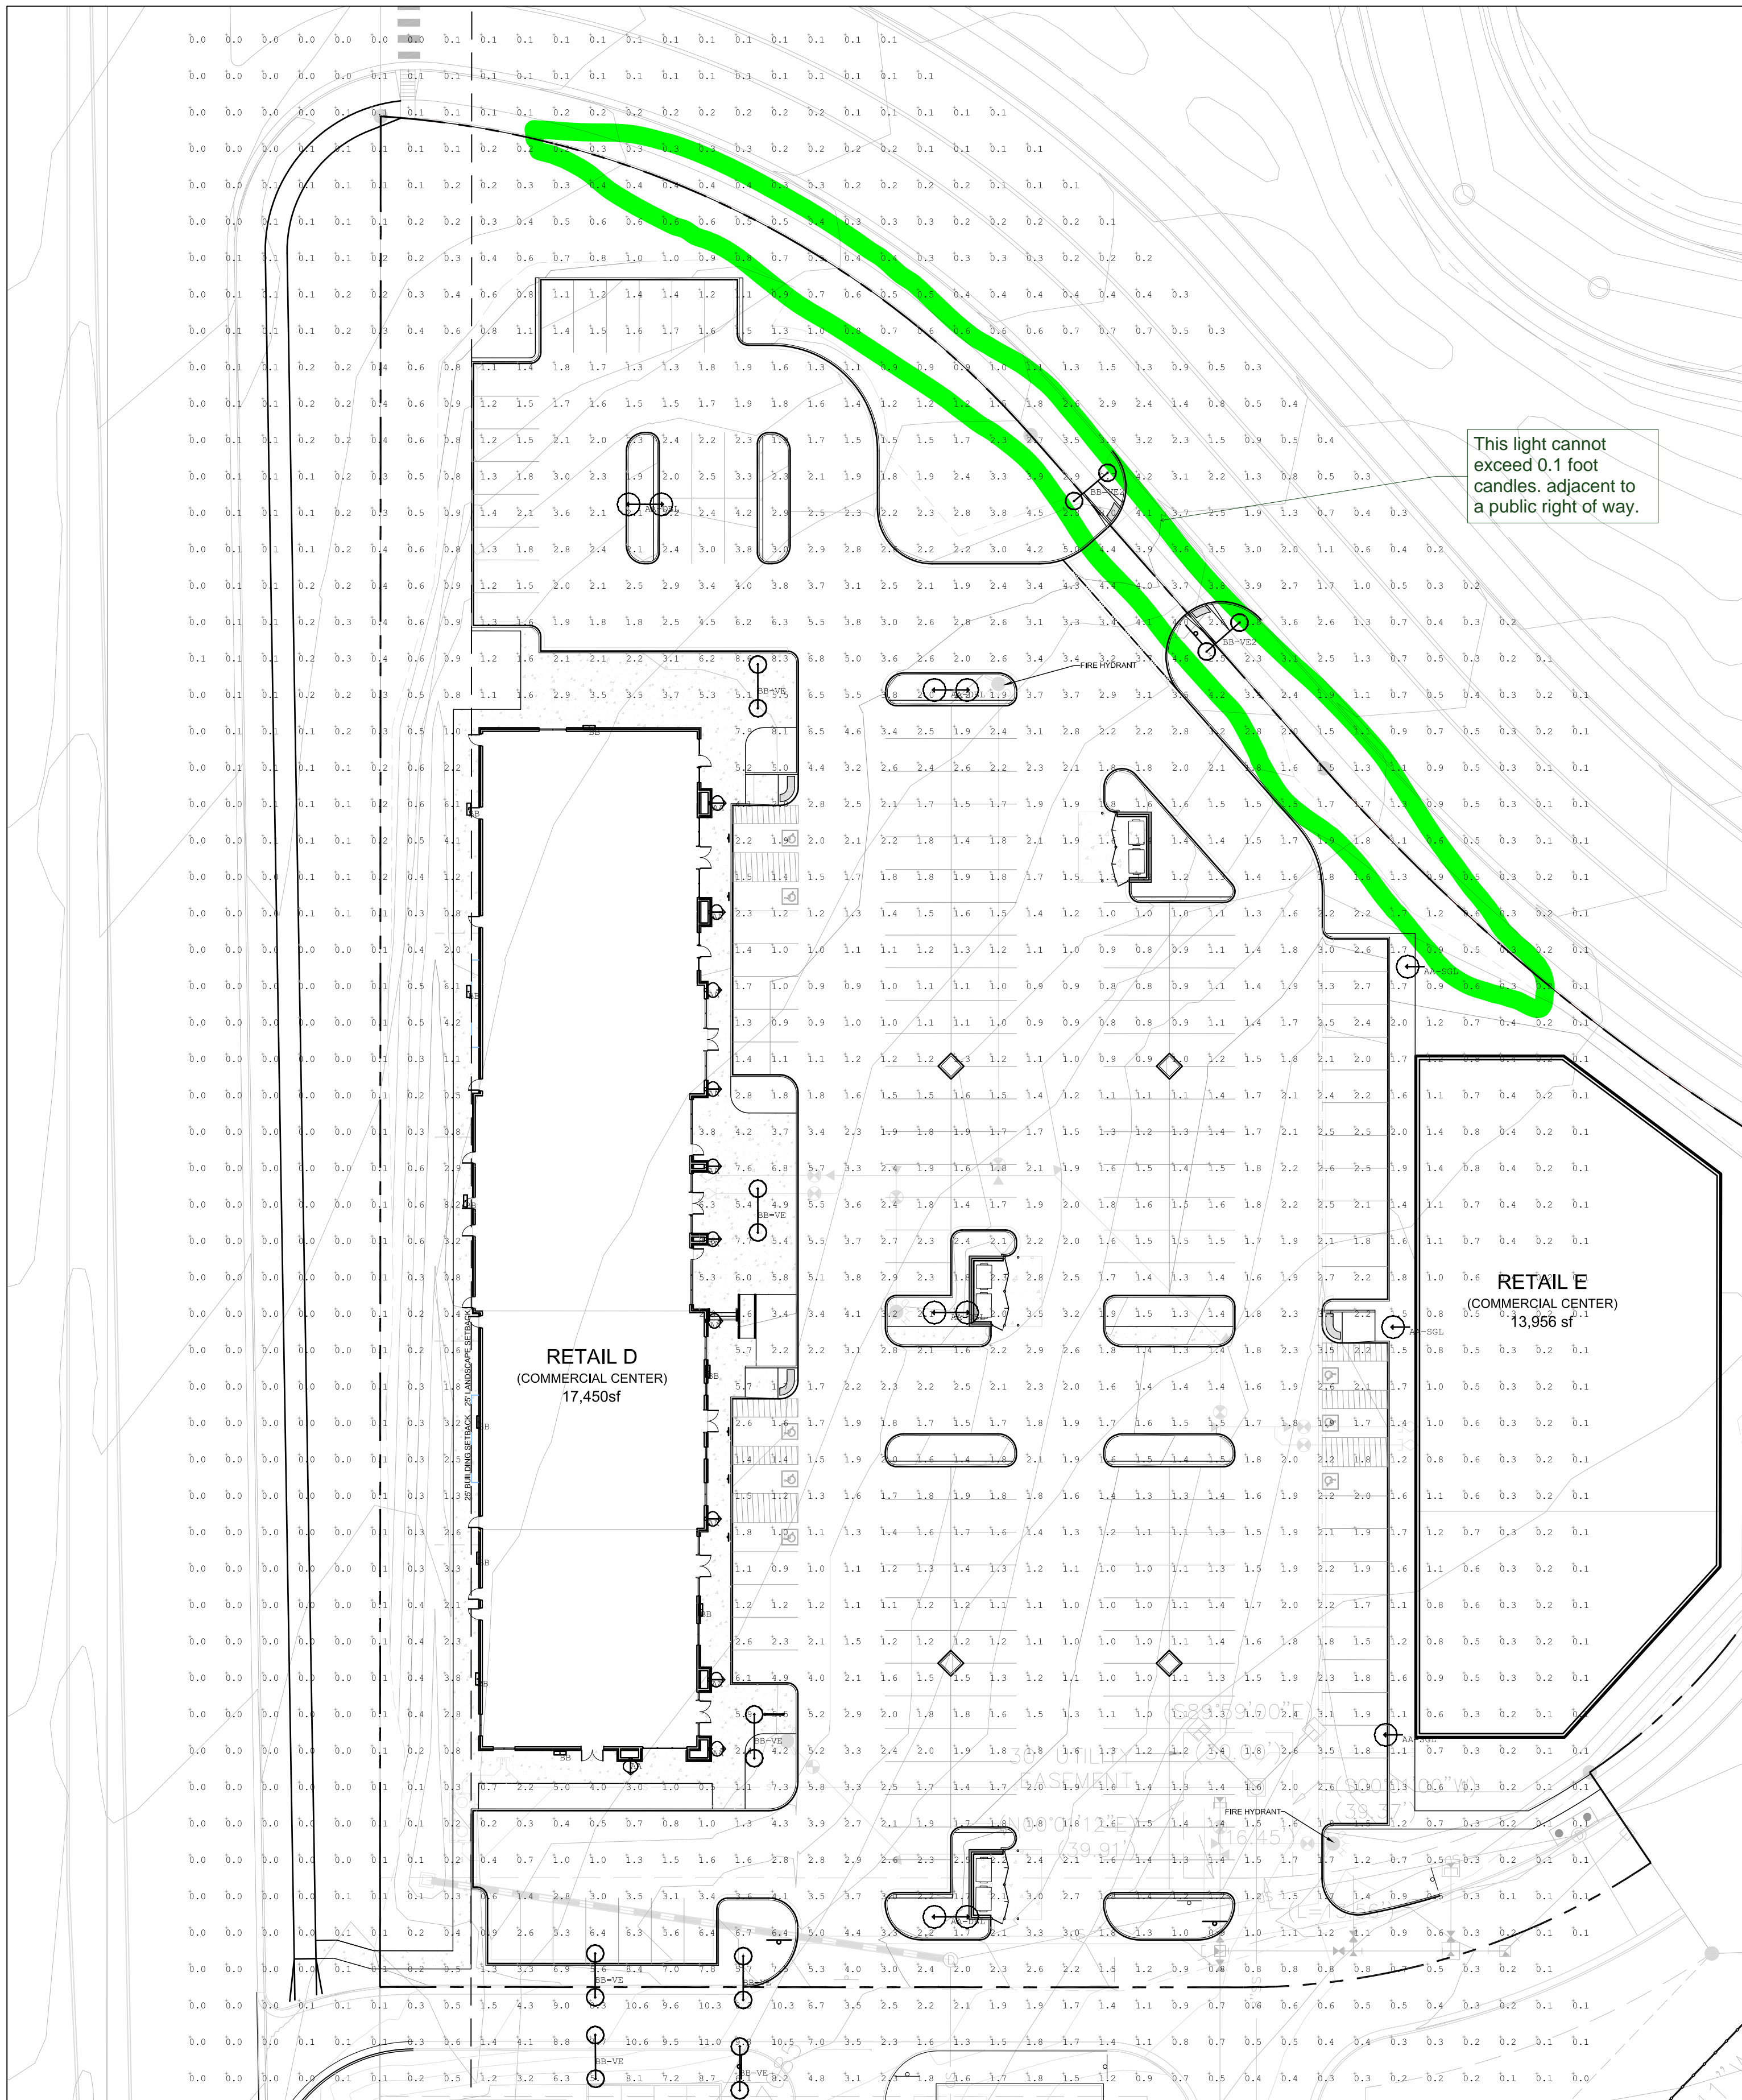

**UCS - Universal Small Housing Scale**

Job Name: UCS - Universal Small Housing Scale  
 Project: UCS - Universal Small Housing Scale  
 Drawing No: UCS-STR-12LED-NW  
 Date: 6/22/2018

**1. LUMINAIRE**

UCS - Universal Small Housing Scale  
 12" LED  
 12" LED  
 12" LED

**2. OPTICAL INTERVAL**

UCS - Universal Small Housing Scale  
 12" LED  
 12" LED  
 12" LED

**3. LAMP/FLUORESCENT**

UCS - Universal Small Housing Scale  
 12" LED  
 12" LED  
 12" LED

**4. COLOR**

UCS - Universal Small Housing Scale  
 12" LED  
 12" LED  
 12" LED

**5. OPTICAL AXIS**

UCS - Universal Small Housing Scale  
 12" LED  
 12" LED  
 12" LED

**PR4 - Aluminum Pole**

Job Name: PR4 - Aluminum Pole  
 Project: PR4 - Aluminum Pole  
 Drawing No: PR4-412-226-CRT  
 Date: 6/22/2018

**1. NAME & FILE**

PR4 - Aluminum Pole  
 4" DIA  
 12' HGT

**2. SPECIFICATIONS**

PR4 - Aluminum Pole  
 4" DIA  
 12' HGT

**3. COLOR**

PR4 - Aluminum Pole  
 4" DIA  
 12' HGT

**25' Arm Mounted, Curvilinear, Floodlight**

Job Name: 25' Arm Mounted, Curvilinear, Floodlight  
 Project: 25' Arm Mounted, Curvilinear, Floodlight  
 Drawing No: CC/CCS25  
 Date: 6/22/2018

**Standard Features**

25' Arm Mounted, Curvilinear, Floodlight  
 CC/CCS25

**Mounting**

25' Arm Mounted, Curvilinear, Floodlight  
 CC/CCS25

**Electrical**

25' Arm Mounted, Curvilinear, Floodlight  
 CC/CCS25

**UCS - Universal Small Housing Scale**

Job Name: UCS - Universal Small Housing Scale  
 Project: UCS - Universal Small Housing Scale  
 Drawing No: UCS-STR-12LED-NW  
 Date: 6/22/2018

**1. LUMINAIRE**

UCS - Universal Small Housing Scale  
 12" LED  
 12" LED  
 12" LED

**2. OPTICAL INTERVAL**

UCS - Universal Small Housing Scale  
 12" LED  
 12" LED  
 12" LED

**3. LAMP/FLUORESCENT**

UCS - Universal Small Housing Scale  
 12" LED  
 12" LED  
 12" LED

**4. COLOR**

UCS - Universal Small Housing Scale  
 12" LED  
 12" LED  
 12" LED

**5. OPTICAL AXIS**

UCS - Universal Small Housing Scale  
 12" LED  
 12" LED  
 12" LED

**ROUND NON-TAPERED STEEL DS340**

Job Name: ROUND NON-TAPERED STEEL DS340  
 Project: ROUND NON-TAPERED STEEL DS340  
 Drawing No: DS340  
 Date: 6/22/2018

**ANCHORAGE DATA**

ROUND NON-TAPERED STEEL DS340  
 DS340

**LOAD AND DIMENSIONAL DATA**

ROUND NON-TAPERED STEEL DS340  
 DS340

**PRODUCT ORDERING CODES**

ROUND NON-TAPERED STEEL DS340  
 DS340

**VOITRE ARCHITECTURAL WALL PACK**

Job Name: VOITRE ARCHITECTURAL WALL PACK  
 Project: VOITRE ARCHITECTURAL WALL PACK  
 Drawing No: VWP  
 Date: 6/22/2018

**VWP SERIES**


VOITRE ARCHITECTURAL WALL PACK  
 VWP

**FEATURES**

VOITRE ARCHITECTURAL WALL PACK  
 VWP

**ORDERING INFORMATION**

VOITRE ARCHITECTURAL WALL PACK  
 VWP

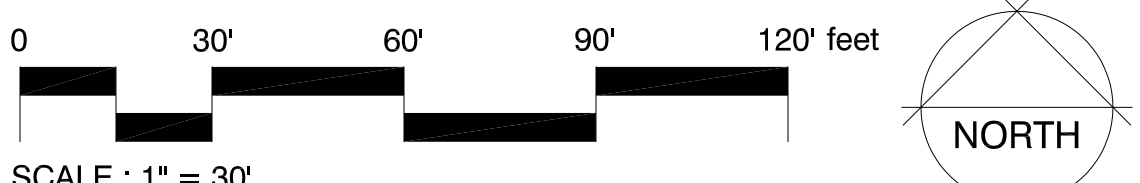

Symbol	Qty	Label	Arrangement	Total Lamp Lumens	LLF	Description	Lum. Watts	Total Watts
AA	11	AA	SINGLE	0.900	N.A.	UCS-STR-12LED-NW	26.0	266.0
BB	10	BB	SINGLE	0.900	N.A.	VWPH4-30-730-T3-SDGL-OPT-EDD-UNV	35.7	357.0
AA-DBL	4	AA-DBL	BACK-BACK	0.900	N.A.	2B/CC253P70-96L4K	216.9	1735.2
AA-SGL	3	AA-SGL	SINGLE	0.900	N.A.	1A/CC253P70-96L4K	216.9	650.7
BB-VE	7	BB-VE	BACK-BACK	0.900	N.A.	2-UCM-ANG-T3-32LED-4K-700-AWT	71.3	998.2001
BB-VE2	2	BB-VE2	BACK-BACK	0.900	N.A.	2-UCM-ANG-T3-32LED-4K-700-AWT	71.3	285.2

**OWNER INFO**

company name: SHOPS AT MERIDIAN RANCH LLC  
 address city/state: P.O. BOX 80036 SAN DIEGO CA 92138  
 phone no:

previous co. file no:  
 approved co. file no:



**YOW ARCHITECTS PC**  
 ARCHITECTURE & PLANNING  
 115 S. Weber Colorado Springs, Colorado 475-8133

Structural:  
 Electrical:  
 Mechanical:  
 Plumbing:

**Shop's @ Meridian Ranch**  
 Site Development Plan  
 Meridian Road  
 Falcon, CO


No. 18,115  
 Date: 6/22/2018  
 Drawing No. **4**  
 PHOTOMETRIC PLAN



# Markup Summary


dsdkendall (3)

---

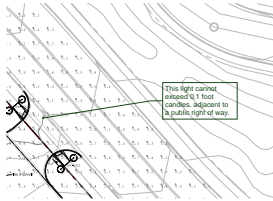


**Subject:** Callout  
**Page Label:** 1  
**Author:** dsdkendall  
**Date:** 8/8/2018 10:10:11 AM  
**Color:** ■

This light cannot exceed 0.1 foot candles adjacent to a public right of way.

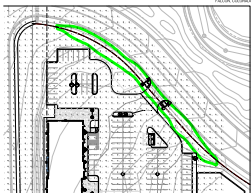

---

**Subject:** Highlight  
**Page Label:** 1  
**Author:** dsdkendall  
**Date:** 8/8/2018 10:10:13 AM  
**Color:** ■

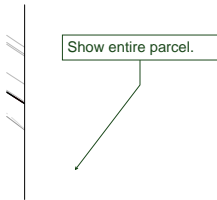

---

**Subject:** Callout  
**Page Label:** 1  
**Author:** dsdkendall  
**Date:** 8/8/2018 10:10:15 AM  
**Color:** ■

Show entire parcel.