
















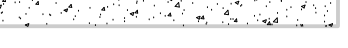





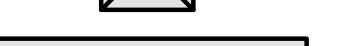

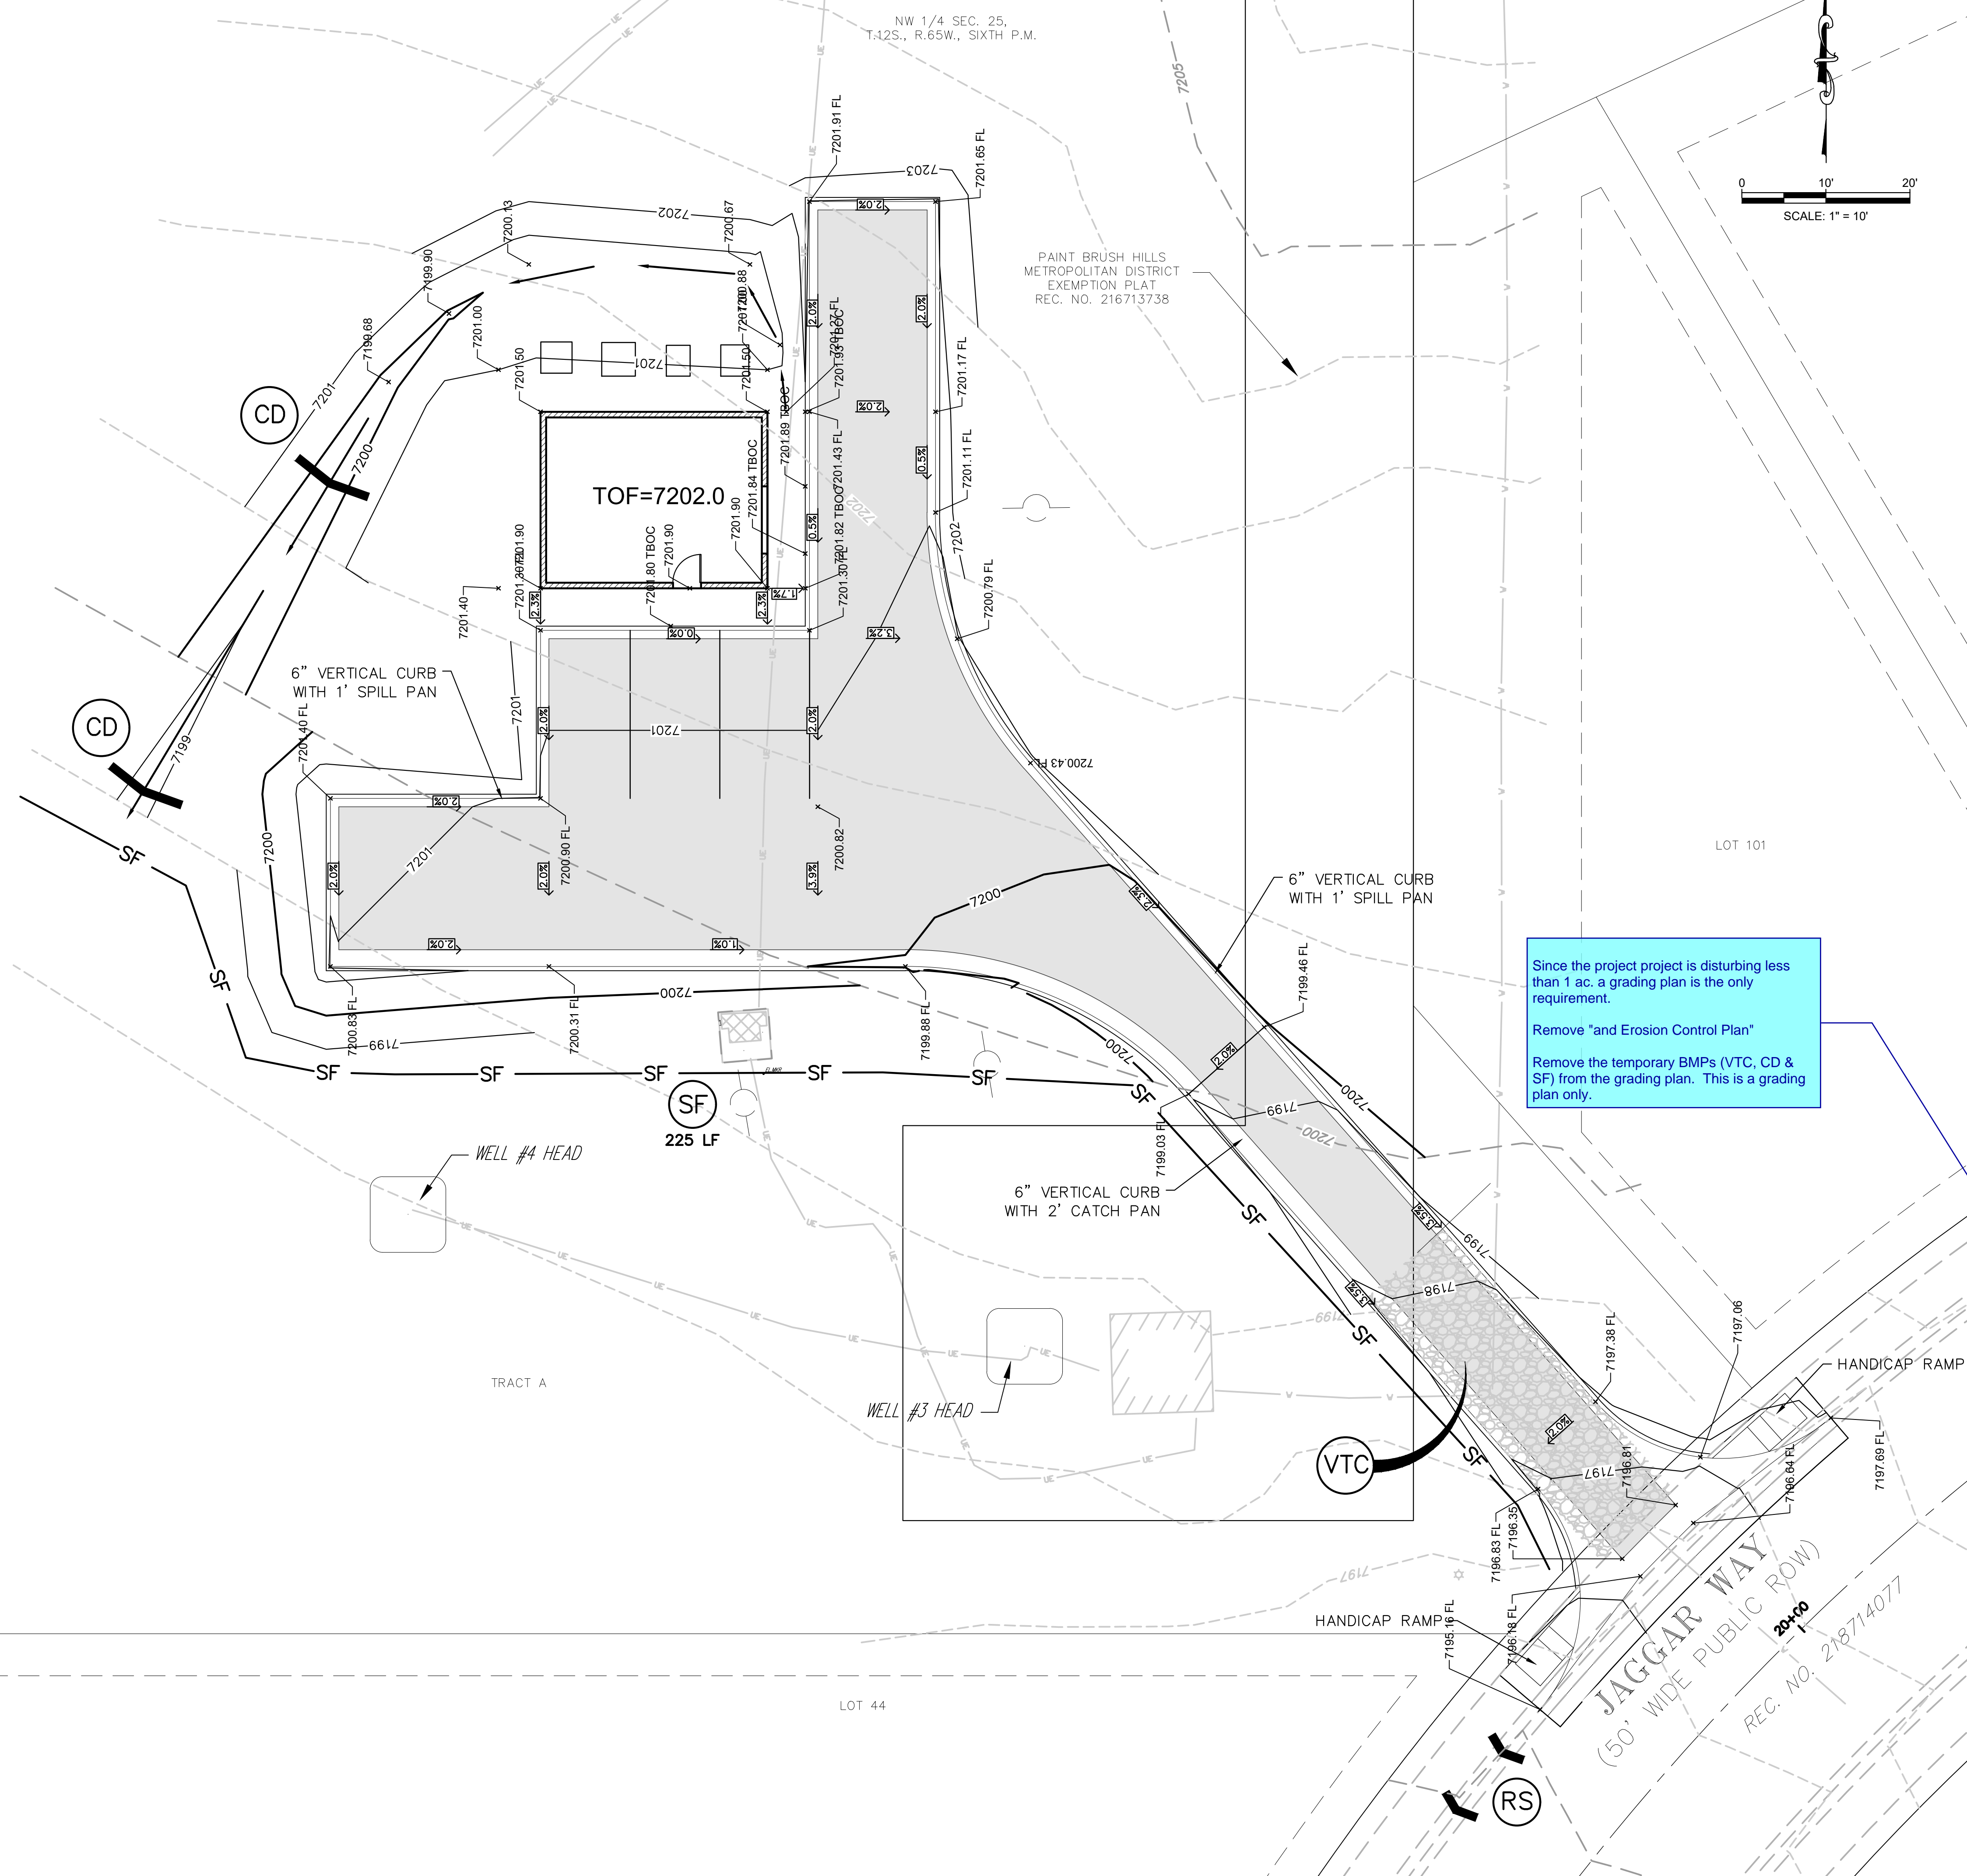
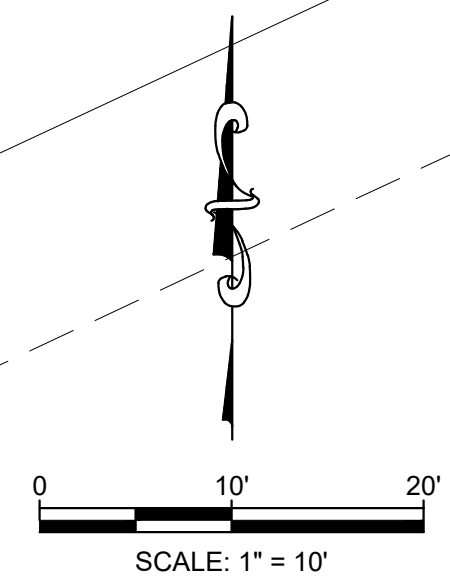


LEGEND

-  EX WATER LINE UNDERGROUND
-  EX WATER VALVE
-  EX ELECTRIC MH
-  EX ELECTRIC MKR
-  EX ELECTRIC TRANSFORMER
-  EX ELECTRIC UNDERGROUND
-  EX LIGHT POLE
-  EX FIBER OPTIC UNDERGROUND
-  EX CABLE TV UNDERGROUND
-  EX GAS LINE UNDERGROUND
-  EX EDGE CONCRETE
-  EX BUILDING
-  EX CONT-MJR
-  EX CONT-MNR
-  PR CONT-MJR
-  PR CONT-MNR
-  EX. ELECTRICAL POLE LOCATION
-  PR CONCRETE
-  PR SILT FENCE
-  PR VEHICLE TRACKING CONTROL
-  PR ROCK SOCK
-  PR CHECK DAM
-  PR CONCRETE WASHOUT
-  PR ASPHALT ROADWAY
-  PR 4" PVC WATERLINE



Since the project project is disturbing less than 1 ac, a grading plan is the only requirement.
 Remove "and Erosion Control Plan"
 Remove the temporary BMPs (VTC, CD & SF) from the grading plan. This is a grading plan only.



48 hours before you dig, CALL UTILITY NOTIFICATION CENTER OF COLORADO (UNCC) **811**
 Go Electric, Telephone, City and Penetration Eastern Pipeline Locations
SCALE VERIFICATION
 BAR IS ONE INCH ON ORIGINAL DRAWING
 IF NOT ONE INCH ON THIS SHEET SCALE ACCORDINGLY

NO.	REVISIONS DESCRIPTION	DATE	BY

RG AND ASSOCIATES, LLC
 4885 Ward Road, Suite 100 • Wheat Ridge, CO 80033
 Del Norte • Gypsum • Wheat Ridge
 303-293-8107 • www.rgengineers.com




PAINT BRUSH HILLS PUMP HOUSE
 GRADING PLAN AND EROSION CONTROL PLAN
 prepared for
PAINT BRUSH HILLS METROPOLITAN DISTRICT

DRAWN BY:	DESIGNED BY:
JOB NUMBER: 1070.0010	DATE: MARCH, 2019
SCALE: 1"=10'	DRAWING NAME:
SHEET NO: 5	of 8

Markup Summary

dsdlaforce (1)

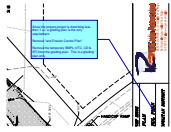

Subject: Callout
Page Label: [1] grading and erosion control plan
Author: dsdlaforce
Date: 5/6/2019 1:39:13 PM
Color: ■

Since the project project is disturbing less than 1 ac. a grading plan is the only requirement.

Remove "and Erosion Control Plan"

Remove the temporary BMPs (VTC, CD & SF) from the grading plan. This is a grading plan only.