


Andrea w/ Remax

5.00 AC. ±

You need to show the exact setbacks from property lines, especially the one that is in question. Add a north arrow on the site plan. Add a scale or mark it as "not to scale". Include dimensions and setbacks of all buildings.

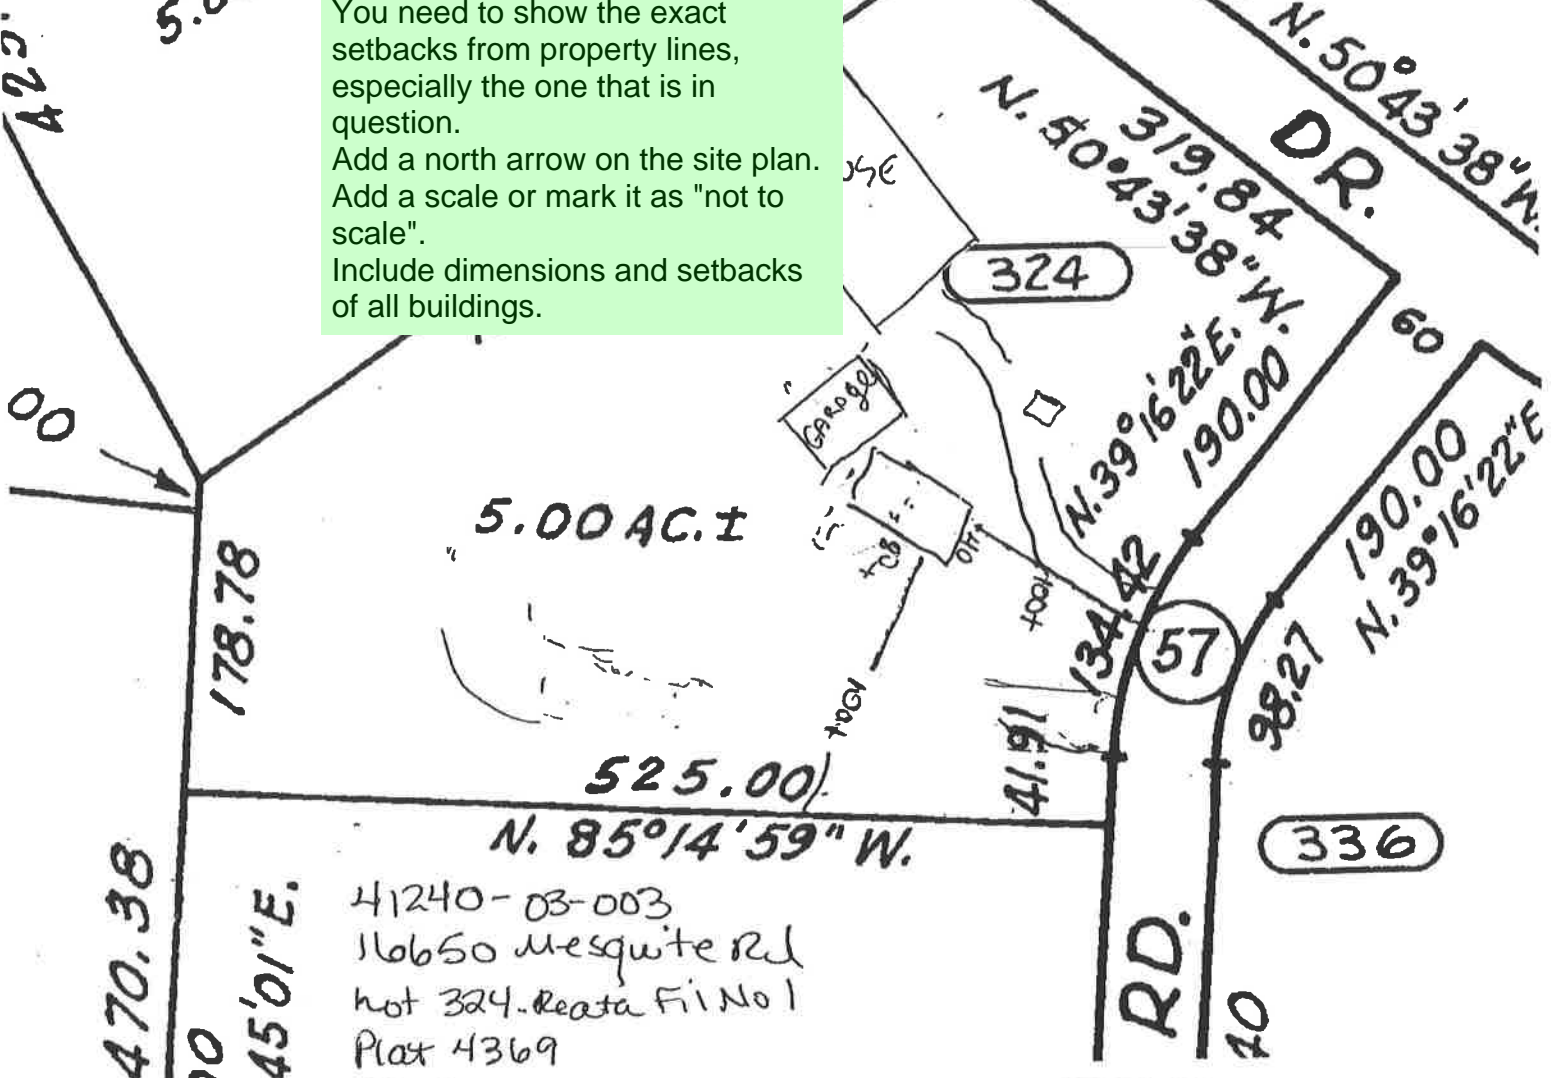

5.00 AC. ±

525.00
N. 85°14'59" W.

470.38
45°01" E.

41240-03-003
116650 Mesquite Rd
lot 324. Reata Fil No 1
Plat 4369
RR-5
AG1725

APPROVED **DENIED**
BY myrn DATE 6/12/17
FOR 3200 sq ft Base
NOTES Subject to inspection
for AG use

EL PASO COUNTY
PLANNING AND COMMUNITY DEVELOPMENT

Planning and Community Development approval is contingent upon compliance with all applicable notes on the recorded plat.

An access permit must be granted by the Planning and Community Development Engineering Division prior to the establishment of any driveway onto a County Road.

Diversion of blockage of any drainageway is not permitted without the approval of the Planning and Community Development Engineering Division.


Any approval given by El Paso County does not oblate the need to comply with applicable Federal, State or Local laws and/or regulations.

BESQCP Not Required
by m on 6/12/17

AG 17-25

Markup Summary

dskendall (1)

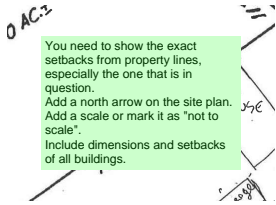

Subject: Text Box
Page Label: 1
Author: dskendall
Date: 8/8/2018 11:36:05 AM
Color: ■

You need to show the exact setbacks from property lines, especially the one that is in question.
Add a north arrow on the site plan.
Add a scale or mark it as "not to scale".
Include dimensions and setbacks of all buildings.