SADDLEHORN RANCH FILING NO. 2

A PARCEL OF LAND LOCATED IN SECTION 3 AND THE NORTH HALF OF THE NORTHEAST QUARTER OF SECTION 10,

TOWNSHIP 13 SOUTH, RANGE 64 WEST OF THE 6TH PRINCIPAL MERIDIAN

COUNTY OF EL PASO, STATE OF COLORADO

KNOW ALL MEN BY THESE PRESENTS


THAT GORILLA CAPITAL CO SADDLEHORN RANCH, LLC, BEING THE OWNER OF THE FOLLOWING TRACT OF LAND: A PARCEL OF LAND LOCATED IN SECTION 3 AND THE NORTH HALF OF THE NORTH HALF OF SECTION 10, TOWNSHIP 13 SOUTH, RANGE 64 WEST OF THE 6TH P.M., COUNTY OF EL PASO, STATE OF COLORADO, BEING MORE PARTICULARLY DESCRIBED AS FOLLOWS:

COMMENCING AT THE SOUTHWEST CORNER OF SECTION 3, TOWNSHIP 13 SOUTH, RANGE 64 WEST OF THE 6TH PRINCIPAL MERIDIAN; THENCE ON THE WEST LINE OF SAID SECTION 3, NOO"32'28"W A DISTANCE OF 1,987.87 FEET, TO THE POINT OF BEGINNING;

THENCE CONTINUING ON SAID WEST LINE, NO0°32'28"W A DISTANCE OF 799.26 FEET;

THENCE DEPARTING SAID WEST LINE, THE FOLLOWING FORTY-THREE (43) COURSES:

- 1. S89°59'23"E A DISTANCE OF 442.27 FEET;
- 2. N00°00'37"E A DISTANCE OF 35.00 FEET;
- 3. S89°59'23"E A DISTANCE OF 60.00 FEET;
- 4. S00°00'37"W A DISTANCE OF 35.00 FEET;
- 5. S89°59'23"E A DISTANCE OF 303.52 FEET, TO A POINT OF CURVE;
- 6. ON THE ARC OF A CURVE TO THE RIGHT, HAVING A RADIUS OF 780.00 FEET, A CENTRAL ANGLE OF 18°44'59" AND AN ARC LENGTH OF 255.25 FEET, TO A POINT OF TANGENT:
- 7. S71°14'24"E A DISTANCE OF 260.86 FEET, TO A POINT OF CURVE;
- 8. ON THE ARC OF A CURVE TO THE RIGHT, HAVING A RADIUS OF 2,780.00 FEET, A CENTRAL ANGLE OF 13°06'52" AND AN ARC LENGTH OF 636.31 FEET, TO A POINT OF TANGENT;
- 9. S58°07'32"E A DISTANCE OF 223.80 FEET;
- 10. N29°44'39"E A DISTANCE OF 35.38 FEET;
- 11. S60°15'21"E A DISTANCE OF 60.00 FEET;
- 12. N29°44'39"E A DISTANCE OF 495.87 FEET, TO A POINT OF CURVE;
- 13. ON THE ARC OF A CURVE TO THE LEFT, HAVING A RADIUS OF 3,780.00 FEET, A CENTRAL ANGLE OF 00°51'00" AND AN ARC LENGTH OF 56.07 FEET, TO A POINT OF NON-TANGENT;
- 14. S89°25'13"E A DISTANCE OF 432.63 FEET:
- 15. S59°26'28"E A DISTANCE OF 121.12 FEET;
- 16. S75°58'13"E A DISTANCE OF 220.14 FEET;
- 17. S85°18'55"E A DISTANCE OF 313.66 FEET;
- 18. N83°04'57"E A DISTANCE OF 318.88 FEET;
- 19. S25°56'36"E A DISTANCE OF 301.68 FEET:
- 20. S26°16'17"W A DISTANCE OF 214.44 FEET;
- 21. S05°54'31"E A DISTANCE OF 82.94 FEET:
- 22. S13°43'48"W A DISTANCE OF 203.03 FEET;
- 23. S06°03'03"W A DISTANCE OF 170.95 FEET;
- 24. S05°01'03"E A DISTANCE OF 170.65 FEET; 25. S16°56'32"E A DISTANCE OF 186.60 FEET:
- 26. S27°24'02"E A DISTANCE OF 192.44 FEET;
- 27. S13°17'43"E A DISTANCE OF 212.72 FEET;
- 28. S00°16'06"E A DISTANCE OF 51.63 FEET;
- 29. S02°30'39"E A DISTANCE OF 152.35 FEET;
- 30. S11°38'45"W A DISTANCE OF 81.99 FEET;
- 31. S19°38'54"W A DISTANCE OF 229.89 FEET;
- 32. S06°50'26"W A DISTANCE OF 194.89 FEET;
- 33. S19°29'10"E A DISTANCE OF 71.64 FEET;
- 34. S06°37'39"W A DISTANCE OF 125.80 FEET;
- 35. S05°35'15"E A DISTANCE OF 49.97 FEET;
- 36. S48°39'06"E A DISTANCE OF 168.97 FEET;
- 37. S29°11'10"E A DISTANCE OF 194.69 FEET;
- 38. S05°12'41"W A DISTANCE OF 154.91 FEET; 39. S10°23'16"W A DISTANCE OF 70.73 FEET;
- 40. S16°51'56"W A DISTANCE OF 142.94 FEET;
- 41. S30°54'25"W A DISTANCE OF 164.26 FEET;
- 42. S00°00'00"E A DISTANCE OF 158.78 FEET;
- 43. S00°53'29"W A DISTANCE OF 417.37 FEET, TO A POINT ON THE SOUTH LINE OF THE NORTH HALF OF THE NORTHEAST QUARTER OF SECTION 10. TOWNSHIP 13 SOUTH, RANGE 64 WEST OF THE 6TH PRINCIPAL MERIDIAN:

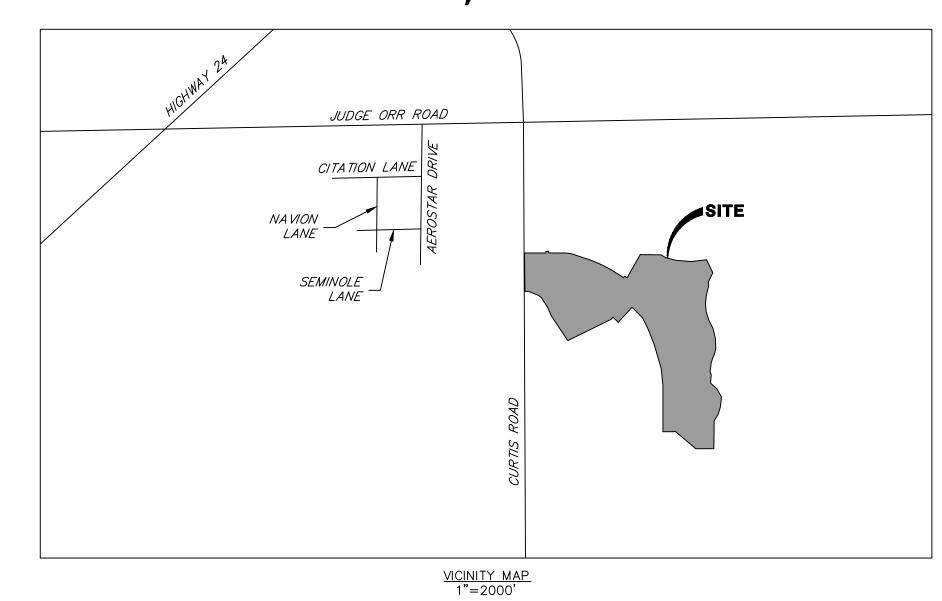

THENCE ON SAID SOUTH LINE, S89°34'02"W A DISTANCE OF 376.10 FEET;

THENCE DEPARTING SAID SOUTH LINE, ON THE EASTERLY AND NORTHERLY LINES OF SADDLEHORN RANCH FILING NO. 1 RECORDED UNDER RECEPTION NO. ______ IN THE RECORDS OF THE EL PASO COUNTY CLERK AND RECORDER, THE FOLLOWING TWENTY-ONE (21)

- 1. N49°37'00"W A DISTANCE OF 565.01 FEET, TO A POINT OF NON-TANGENT CURVE;
- 2. ON THE ARC OF A CURVE TO THE RIGHT WHOSE CENTER BEARS N19°28'44"W, HAVING A RADIUS OF 170.00 FEET, A CENTRAL ANGLE OF 19°02'46" AND AN ARC LENGTH OF 56.51 FEET, TO A POINT OF TANGENT;
- 3. S89°34'03"W A DISTANCE OF 197.98 FEET;
- 4. N00°00'00"E A DISTANCE OF 964.76 FEET;
- 5. N05°58'59"W A DISTANCE OF 349.19 FEET;
- 6. N16°11'46"W A DISTANCE OF 257.34 FEET; 7. N16°11'46"W A DISTANCE OF 261.98 FEET;
- 8. N21°16'04"W A DISTANCE OF 343.92 FEET;
- 9. N26°10'49"W A DISTANCE OF 266.32 FEET;
- 10. N44°25'17"W A DISTANCE OF 280.03 FEET;
- 11. N56°30'41"W A DISTANCE OF 35.01 FEET;
- 12. S42°31'10"W A DISTANCE OF 422.77 FEET, TO A POINT OF NON-TANGENT CURVE;
- 13. ON THE ARC OF A CURVE TO THE LEFT WHOSE CENTER BEARS S47°44'09"W, HAVING A RADIUS OF 1680.00 FEET, A CENTRAL ANGLE OF 05°10'02" AND AN ARC LENGTH OF 151.51 FEET, TO A POINT OF NON-TANGENT;
- 14. S42°34'07"W A DISTANCE OF 60.00 FEET;
- 15. S63°48'26"W A DISTANCE OF 1.002.65 FEET:
- 16. N33°50'17"W A DISTANCE OF 610.26 FEET;
- 17. N24°10'40"W A DISTANCE OF 207.55 FEET;
- 18. N32°24'01"W A DISTANCE OF 240.57 FEET;
- 19. N53°08'37"W A DISTANCE OF 71.78 FEET;
- 20. N68°03'22"W A DISTANCE OF 227.58 FEET;
- 21. S89°27'32"W A DISTANCE OF 72.00 FEET, TO THE POINT OF BEGINNING.
- CONTAINING A CALCULATED AREA OF 7,669,842 SQUARE FEET 176.0754 ACRES.

DEDICATION

CHUCK BROERMAN, RECORDER

BOCC certificate THE ABOVE OWNER HAS CAUSED SAID TRACT OF LAND TO BE PLATTED INTO 42 LOTS, STREETS, 2 TRACTS, AND EASEMENTS AS SHOWN ON THIS PLAT. THE UNDERSIGNED DOES HEREBY DEDICATE, GRANT AND CONVEY TO EL PASO COUNTY THOSE PUBLIC EASEMENTS AS SHOWN ON THE PLAT; AND FURTHER RESTRICTS THE USE OF ALL PUBLIC EASEMENTS TO EL PASO COUNTY AND/OR ITS ASSIGNS, PROVIDED HOWEVER, THAT THE SOLE RIGHT AND AUTHORITY TO VACATE, RELEASE OR QUIT-CLAIM ALL OR ANY SUCH PUBLIC EASEMENTS SHALL REMAIN

EXCLUSIVELY VESTED IN EL PASO COUNTY. ALL PUBLIC STREETS ARE HEREBY DEDICATED TO EL PASO COUNTY FOR PUBLIC USE. THIS TRACT

All other

documentation lists

Filing 2 as 132 acres.

Please revise where

If you are pursuing

administrative final

plat, you don't need

appropriate for


consistency.

CLERK AND RECORDER STATE OF COLORADO COUNTY OF EL PASO I HEREBY CERTIFY THAT THIS INSTRUMENT WAS FILED FOR RECORD IN MY OFFICE AT ______ O'CLOCK ____,M., THIS _____ DAY OF ______, 20____, A.D. AND IS DULY RECORDED AT RECEPTION NO. ______ OF THE RECORDS OF EL PASO COUNTY, COLORADO.

OF LAND AS HEREIN PLATTED SHALL BE KNOWN AS "SADDLEHORN RANCH FILING NO. 2" IN EL PASO COUNTY, COLORADO.

OWNERS CERTIFICATE

THE UNDERSIGNED, BEING ALL THE OWNERS, MORTGAGEES, BENEFICIARIES OF DEEDS OF TRUST AND HOLDERS OF OTHER INTERESTS IN THE LAND DESCRIBED HEREIN, HAVE LAID OUT, SUBDIVIDED, AND PLATTED SAID LANDS INTO LOTS, TRACTS, STREETS, AND EASEMENTS AS SHOWN HEREON UNDER THE NAME AND SUBDIVISION OF SADDLEHORN RANCH FILING NO. 2. ALL PUBLIC IMPROVEMENTS SO PLATTED ARE HEREBY DEDICATED TO PUBLIC USE AND SAID OWNER DOES HEREBY COVENANT AND AGREE THAT THE PUBLIC IMPROVEMENTS WILL BE CONSTRUCTED TO EL PASO COUNTY STANDARDS AND THAT PROPER DRAINAGE AND EROSION CONTROL FOR SAME WILL BE PROVIDED AT SAID OWNER'S EXPENSE, ALL TO THE SATISFACTION OF THE BOARD OF COUNTY COMMISSIONERS OF EL PASO COUNTY, COLORADO. UPON ACCEPTANCE BY RESOLUTION, ALL PUBLIC IMPROVEMENTS SO DEDICATED WILL BECOME MATTERS OF MAINTENANCE BY EL PASO COUNTY, COLORADO. THE UTILITY EASEMENTS SHOWN HEREON ARE HEREBY DEDICATED FOR PUBLIC UTILITIES AND COMMUNICATION SYSTEMS AND OTHER PURPOSES AS SHOWN HEREON. THE ENTITIES RESPONSIBLE FOR PROVIDING THE SERVICES FOR WHICH THE EASEMENTS ARE ESTABLISHED ARE HEREBY GRANTED THE PERPETUAL RIGHT OF INGRESS AND EGRESS FROM AND TO ADJACENT PROPERTIES FOR INSTALLATION, MAINTENANCE, AND REPLACEMENT OF UTILITY LINES AND RELATED FACILITIES.

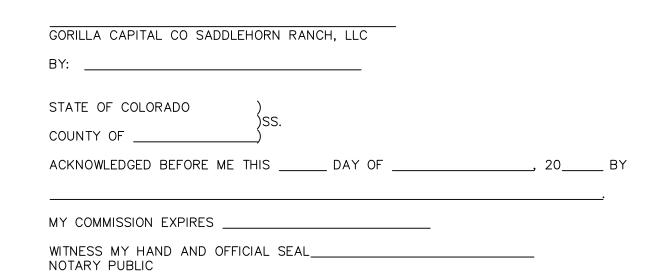

ACCEPTANCE CERTIFICATE FOR TRACTS

THE DEDICATION OF TRACTS A, B AND C ARE HEREBY ACCEPTED FOR OWNERSHIP AND MAINTENANCE BY THE SADDLEHORN RANCH METROPOLITAN DISTRICT.

SADDLEHORN RANCH METROPOLITAN DISTRICT		
BY:PRESIDENT STATE OF COLORADO		
ACKNOWLEDGED BEFORE ME THIS DAY OF	, 20	BY
AS	<u>.</u>	
MY COMMISSION EXPIRES:		
WITNESS MY HAND AND OFFICIAL SEALNOTARY PUBLIC	-	

SURVEYORS CERTIFICATE

mann and a second


I DEREK LEE VAGIAS, A DULY REGISTERED PROFESSIONAL LAND SURVEYOR IN THE STATE OF COLORADO, DO HEREBY CERTIFY THAT THIS PLAT TRULY AND CORRECTLY REPRESENTS THE RESULTS OF A SURVEY MADE ON DATE OF SURVEY, BY ME OR UNDER MY DIRECT SUPERVISION AND THAT ALL MONUMENTS EXIST AS SHOWN HEREON: THAT MATHEMATICAL CLOSURE ERRORS ARE LESS THAN 1:10.000: AND THAT SAID PLAT HAS BEEN PREPARED IN FULL COMPLIANCE WITH ALL APPLICABLE LAWS OF THE STATE OF COLORADO DEALING WITH MONUMENTS, SUBDIVISION, OR SURVEYING OF LAND AND ALL APPLICABLE PROVISIONS OF THE EL PASO COUNTY LAND DEVELOPMENT CODE.

I ATTEST THE ABOVE ON THIS ____ DAY OF _____, 20____.

DEREK LEE VAGIAS,	DATE
COLORADO REGISTERED PLS #38578	
FOR AND ON BEHALF OF JR ENGINEERING, LLC	

BOARD OF COUNTY COMMISSIONERS CERTIFICATE

THIS PLAT FOR SADDLEHORN RANCH FILING NO. 1 WAS APPROVED FOR FILING BY THE EL PASO COUNTY, COLORADO BOARD OF COUNTY COMMISSIONERS ON THE _______ DAY OF ________, 20______, SUBJECT TO ANY NOTES SPECIFIED HEREON AND ANY CONDITIONS INCLUDED IN THE RESOLUTION OF APPROVAL. THE DEDICATIONS OF LAND TO THE PUBLIC (STREETS, TRACTS, EASEMENTS: LIST THOSE APPLICABLE) ARE ACCEPTED, BUT PUBLIC IMPROVEMENTS THEREON WILL NOT BECOME THE MAINTENANCE RESPONSIBILITY OF EL PASO COUNTY UNTIL PRELIMINARY ACCEPTANCE OF THE PUBLIC IMPROVEMENTS IN ACCORDANCE WITH THE REQUIREMENTS OF THE LAND DEVELOPMENT CODE AND ENGINEERING CRITERIA MANUAL, AND THE SUBDIVISION IMPROVEMENTS AGREEMENT.

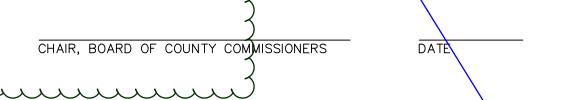

PLANNING AND COMMUNITY DEVELOPMENT DIRECTOR CERTIFICATE

THIS PLAT FOR SADDLEHORN RANCH FILING NO. 1 WAS APPROVED FOR FILING BY THE EL PASO COUNTY, COLORADO PLANNING AND COMMUNITY DEVELOPMENT DEPARTMENT DIRECTOR ON THE _____ DAY OF _____, 20___, SUBJECT TO ANY NOTES OR CONDITIONS SPECIFIED HEREON.

PLANNING AND COMMUNITY DEVELOPMENT DIRECTOR

RECORDING: ____

SCHOOL: DRAINAGE: _

BRIDGE:

Name, address and telephone number of the owner of record located in the lower right hand corner,

Names, address, and telephone number of person(s) responsible for preparing the plat (e.g., licensed surveyor, licensed engineer or designer of the plat) located in the lower right hand corner

SHEET 1 OF 5 Include provisions for dating

JOB NO. 25142.04 JUNE 3, 2021





Centennial 303-740-9393 • Colorado Springs 719-593-2593 Fort Collins 970-491-9888 • www.irengineering.com

SADDLEHORN RANCH FILING NO. 2


A PARCEL OF LAND LOCATED IN SECTION 3 AND THE NORTH HALF OF THE NORTHEAST QUARTER OF SECTION 10, TOWNSHIP 13 SOUTH, RANGE 64 WEST OF THE 6TH PRINCIPAL MERIDIAN **COUNTY OF EL PASO, STATE OF COLORADO**

GENERAL NOTES:

- PER C.R.S. 38-51-106, "ALL LINEAL UNITS DEPICTED ON THIS LAND SURVEY PLAT ARE U.S. SURVEY FEET". ONE METER EQUALS 39.37/12 U.S. SURVEY FEET, EXACTLY ACCORDING TO THE NATIONAL INSTITUTE OF STANDARDS AND TECHNOLOGY
- BASIS OF BEARING: THE WEST LINE OF SECTION 3, T3S, R64W, 6TH P.M., MONUMENTED BY A 3-1/4" ALUMINUM CAP STAMPED "PLS 17496" IN A RANGE BOX AT THE NORTHWEST CORNER OF SECTION 3 AND A NO. 6 REBAR IN A RANGE BOX AT THE SOUTHWEST CORNER OF SECTION 3, BEARING NO0°32'28"W AS REFERENCED TO COLORADO STATE PLANE CENTRAL ZONE.
- ALL REFERENCES TO BOOKS, PAGES, MAPS, AND RECEPTION NUMBERS ARE PUBLIC DOCUMENTS ON FILE WITH THE CLERK AND RECORDER OF EL PASO COUNTY, STATE OF COLORADO.
- THIS SITE IS WITHIN A SPECIAL FLOOD HAZARD AREA "ZONE AE" (SPECIAL FLOOD HAZARD AREAS SUBJECT TO INUNDATION BY THE 1% ANNUAL CHANCE FLOOD), AS DETERMINED BY GRAPHIC INTERPRETATION. FLOODPLAIN INFORMATION WAS OBTAINED FROM F.E.M.A. FLOODPLAIN, AS SHOWN ON THE FLOOD INSURANCE RATE MAPS FOR EL PASO COUNTY, COLORADO, MAP NUMBERS 08041C0558G AND 08041C0566G BOTH WITH REVISED DATES OF DECEMBER 7, 2018.
- THIS LAND SURVEY DOES NOT CONSTITUTE A TITLE SEARCH BY JR ENGINEERING, LLC TO DETERMINE OWNERSHIP OF THIS TRACT, VERIFY THE DESCRIPTION SHOWN, VERIFY THE COMPATIBILITY OF THIS DESCRIPTION WITH THAT OF ADJACENT TRACTS, OR VERIFY EASEMENTS OF RECORD. FOR ALL INFORMATION REGARDING EASEMENTS, RIGHT-OF-WAY OR TITLE OF RECORD, JR ENGINEERING, LLC RELIED UPON TITLE COMMITMENT NO. 83142ECS, AMENDMENT NO. 1, PREPARED BY STEWART TITLE GUARANTY COMPANY COMPANY, DATED APRIL 19, 2021, 7:30 A.M.
- BY APPROVAL OF THIS PLAT EL PASO COUNTY VACATES THE POTENTIAL ROW ALONG THE SOUTH LINE OF SECTION 3 AND THE NORTH LINE OF SECTION 10 AS MAY HAVE BEEN ACQUIRED BY BOCC RESOLUTION RECORDED AT BOOK A, PAGE 78 IN THE RECORDS OF THE EL PASO COUNTY CLERK AND RECORDER.
- TRACTS A AND B ARE FOR OPEN SPACE AND DRAINAGE PURPOSES. TRACTS A AND B SHALL BE OWNED AND MAINTAINED BY THE SADDLEHORN RANCH METROPOLITAN DISTRICT.
- THE ADDRESSES EXHIBITED ON THIS PLAT ARE FOR INFORMATIONAL PURPOSES ONLY. THEY ARE NOT THE LEGAL DESCRIPTION AND ARE SUBJECT TO CHANGE.
- ALL PROPERTY OWNERS ARE RESPONSIBLE FOR MAINTAINING PROPER STORM WATER DRAINAGE IN AND THROUGH THEIR PROPERTY. PUBLIC DRAINAGE EASEMENTS SHALL BE MAINTAINED BY THE INDIVIDUAL LOT OWNERS UNLESS OTHERWISE INDICATED. STRUCTURES, FENCES, MATERIALS OR LANDSCAPING THAT COULD IMPEDE THE FLOW OR RUNOFF SHALL NOT BE PLACED IN THE DRAINAGE EASEMENTS.
- 10. WATER SERVICE SHALL BE SUPPLIED BY SADDLEHORN RANCH METROPOLITAN DISTRICT.
- SEWAGE TREATMENT IS THE RESPONSIBILITY OF EACH INDIVIDUAL PROPERTY OWNER. THE EL PASO COUNTY HEALTH DEPARTMENT MUST APPROVE EACH SYSTEM AND IN SOME CASES THE DEPARTMENT MAY REQUIRE AN ENGINEER DESIGNED SYSTEM PRIOR TO PERMIT APPROVAL
- 12. IMPERVIOUS LOT COVERAGE IS RESTRICTED TO NO MORE THAN 10,900 SQUARE FEET PER LOT TO CONFORM WITH THE EL PASO COUNTY'S MS4 STORM WATER DISCHARGE PERMIT.
- 13. UNLESS SHOWN OTHERWISE, ALL SIDE, FRONT AND REAR LOT LINES ARE HEREBY PLATTED WITH A 10 FOOT WIDE PUBLIC UTILITY AND DRAINAGE EASEMENT. ALL EXTERIOR SUBDIVISION BOUNDARIES ARE HEREBY PLATTED WITH A 20 FOOT WIDE PUBLIC UTILITY AND DRAINAGE EASEMENT. THE SOLE RESPONSIBILITY FOR MAINTENANCE OF THESE EASEMENTS IS HEREBY VESTED WITH THE INDIVIDUAL PROPERTY OWNERS.
- 14. THE FOLLOWING REPORTS HAVE BEEN SUBMITTED IN ASSOCIATION WITH THE PRELIMINARY PLAN OR FINAL PLAT FOR THIS SUBDIVISION AND ARE ON FILE AT THE COUNTY PLANNING AND COMMUNITY DEVELOPMENT DEPARTMENT: TRANSPORTATION IMPACT STUDY; DRAINAGE REPORT; WATER RESOURCES REPORT; WASTEWATER DISPOSAL REPORT, GEOLOGY AND SOILS REPORT; FIRE PROTECTION REPORT, WILDFIRE HAZARDS REPORT; NATURAL FEATURES REPORT.
- —— Parks and DEVELOPER SHALL COMPLY WITH FEDERAL AND STATE LAWS, REGULATION, ORDINANCES, REVIEW AND PERMIT REQUIREMENTS, AND OTHER AGENCY REQUIREMENT, IF ANY, OF APPLICABLE AGENCIES INCLUDING, BUT NOT LIMITED TO, THE COLORADO DEPARTMENT OF WILDLIFE, COLORADO DEPARTMENT OF TRANSPORTATION, U.S. ARMY CORPS OF ENGINEERS, AND THE U.S. FISH & WILDLIFE SERVICE REGARDING THE ENDANGERED SPECIES ACT, PARTICULARLY AS IT RELATES TO THE LISTED SPECIES (E.G., PREBLES MEADOW JUMPING MOUSE).
- 16. NO LOT OR INTEREST THEREIN, SHALL BE SOLD, CONVEYED, OR TRANSFERRED WHETHER BY DEED OR BY CONTRACT, NOR SHALL BUILDING PERMITS BE ISSUED, UNTIL AND UNLESS EITHER THE REQUIRED PUBLIC AND COMMON DEVELOPMENT IMPROVEMENTS HAVE BEEN CONSTRUCTED AND PRELIMINARILY ACCEPTED IN ACCORDANCE WITH THE SUBDIVISION IMPROVEMENTS AGREEMENT BETWEEN THE APPLICANT/OWNER AND EL PASO COUNTY AS RECORDED UNDER RECEPTION NO. IN THE OFFICE OF THE CLERK AND RECORDER OF EL PASO COUNTY, COLORADO OR, IN THE ALTERNATIVE, OTHER COLLATERAL IS PROVIDED TO MAKE PROVISION FOR THE COMPLETION OF SAID IMPROVEMENTS IN ACCORDANCE WITH THE EL PASO LAND DEVELOPMENT CODE AND ENGINEERING CRITERIA MANUAL. ANY SUCH ALTERNATIVE COLLATERAL MUST BE APPROVED BY THE BOARD OF COUNTY COMMISSIONERS OR, IF PERMITTED BY THE SUBDIVISION IMPROVEMENTS AGREEMENT, BY THE DEVELOPMENT SERVICES DEPARTMENT DIRECTOR AND MEET THE POLICY AND PROCEDURE REQUIREMENTS OF EL PASO COUNTY PRIOR TO THE RELEASE BY THE COUNTY OF ANY LOTS FOR SALE, CONVEYANCE OR TRANSFER. THIS PLAT RESTRICTION MAY BE REMOVED OR RESCINDED BY THE BOARD OF COUNTY COMMISSIONERS OR, IF PERMITTED BY THE SUBDIVISION IMPROVEMENTS AGREEMENT, BY THE PLANNING AND COMMUNITY DEVELOPMENT DEPARTMENT DIRECTOR UPON EITHER APPROVAL OF AN ALTERNATIVE FORM OF COLLATERAL OR COMPLETION AND PRELIMINARY ACCEPTANCE BY THE EL PASO BOARD OF COUNTY COMMISSIONERS OF ALL IMPROVEMENT REQUIRED TO BE CONSTRUCTED AND COMPLETED IN ACCORDANCE WITH SAID SUBDIVISION IMPROVEMENTS AGREEMENT. THE PARTIAL RELEASE OF LOTS FOR SALE, CONVEYANCE OR TRANSFER MAY ONLY BE GRANTED IN ACCORDANCE WITH ANY PLANNED PARTIAL RELEASE OF LOTS AUTHORIZED BY THE SUBDIVISION IMPROVEMENTS AGREEMENT.
- 17. A DRIVEWAY PERMIT IS REQUIRED TO BE APPLIED FOR AND APPROVED BY EL PASO COUNTY PLANNING AND COMMUNITY DEVELOPMENT DEPARTMENT PRIOR TO THE ESTABLISHMENT OF ANY DRIVEWAY. INDIVIDUAL LOT PURCHASERS ARE RESPONSIBLE FOR CONSTRUCTING DRIVEWAYS, INCLUDING DRAINAGE CULVERTS FROM TRUCHAS TRAIL, OSCURO TRAIL, DEL CERRO TRAIL, EL RAICENO TRAIL, AND BENITO WELLS TRAIL PER LAND DEVELOPMENT CODE SECTION 6.3.3.C.2 AND 6.3.3.C3. DUE TO THEIR LENGTH, SOME OF THE DRIVEWAYS WILL NEED TO BE SPECIFICALLY APPROVED BY THE FALCON FIRE PROTECTION DISTRICT.
- 18. THERE SHALL BE NO DIRECT LOT ACCESS TO CURTIS ROAD.
- 19. THE FOLLOWING LOTS (33, 34, 35, 36, 37, 41 & TRACT A) HAVE BEEN FOUND TO BE IMPACTED BY GEOLOGIC HAZARDS. MITIGATION MEASURES AND A MAP OF THE HAZARD ARE CAN BE FOUND IN THE GROLOGIC HAZARD REPORT PREPARED BY ENTECH ENGINEERING DATED APRIL 24, 2020 IN THE SADDLEHORN RANCH PRELIMINARY PLAN FILE #1SP-19-006 AVAILABLE AT THE EL PASO COUNTY PLANNING AND COMMUNITY DEVELOPMENT DEPARTMENT. IF ANY STRUCTURES ARE PROPOSED IN ANY HAZARD AREA, A SUBSURFACE SOILS INVESTIGATION AND AN ENGINEERED SITE PLANKWILL BE REQUIRED FOR COUNTY REVIEW.

 $\sim\sim\sim$

- 20. THIS SUBDIVISION IS SURROUNDED BY AGRICULTURAL LAND. PROPERTY OWNERS MAY BE IMPACTED BY SOUNDS, SMELLS AND/OR ACTIVITIES ASSOCIATED WITH ACTIVE AGRICULTURAL PRACTICES. PURSUANT TO ARTICLE 3.5, TITLE 35, C.R.S., IT IS THE DECLARED POLICY OF THE STATE OF COLORADO TO CONSERVE, PROTECT, AND ENCOURAGE THE DEVELOPMENT AND IMPROVEMENT OF ITS AGRICULTURAL LAND FOR THE PRODUCTION OF FOOD AND OTHER AGRICULTURAL PRODUCTS COLORADO IS A "RIGHT-TO-FARM" STATE PURSUANT TO C.R.S. 35-3.5-101, ET SEQ. LANDOWNERS, RESIDENTS AND VISITORS MUST BE PREPARED TO ACCEPT THE ACTIVITIES, SIGHTS, SOUNDS, AND SMELLS OF AGRICULTURAL OPERATIONS AS A NORMAL AND NECESSARY IMPACT OF LIVING IN A COUNTY WITH A STRONG RURAL CHARACTER AND A HEALTHY AGRICULTURAL SECTOR. STATE LAW PROVIDES THAT RANCHING, FARMING, OR OTHER AGRICULTURAL ACTIVITIES AND OPERATIONS SHALL NOT BE CONSIDERED TO BE NUISANCES SO LONG AS OPERATED IN CONFORMANCE WITH THE LAW AND IN A NON-NEGLIGANT MANNER. THEREFORE, ALL MUST BE PREPARED TO ENCOUNTER NOISES, ODORS, LIGHTS, MUD, DUST, SMOKE, CHEMICALS, MACHINERY ON PUBLIC ROADS, LIVESTOCK ON PUBLIC ROADS, STORAGE AND DISPOSAL OF MANURE, AND THE APPLICATION BY SPAYING OR OTHERWISE OF CHEMICAL FERTILIZERS, SOIL AMENDMENTS, HERBICIDES, AND PESTICIDES, AND ONE OR MORE OF WHICH MAY NATURALLY OCCUR AS A PART OF LEGAL AND NON-NEGLIGENT AGRICULTURAL OPERATIONS. Public Works —
- 21. MAILBOXES SHALL BE INSTALLED IN ACCORDANCE WITH ALL EL PASO COUNTY DEPARTMENT OF TRANSPORTATION AND UNITED STATES POSTAL SERVICE REGULATIONS.
- 22. THE SUBDIVIDER AGREES ON BEHALF OF HIM/HERSELF AND ANY DEVELOPER OR BUILDER SUCCESSORS AND ASSIGNEES THAT SUBDIVIDER AND/OR SAID SUCCESSORS AND ASSIGNS SHALL BE REQUIRED TO PAY TRAFFIC IMPACT FEES IN ACCORDANCE WITH THE EL PASO COUNTY ROAD IMPACT FEE PROGRAM RESOLUTION (RESOLUTION NO. 19-471), OR ANY AMENDMENTS THERETO, AT OR PRIOR TO THE TIME OF BUILDING PERMIT SUBMITTALS.

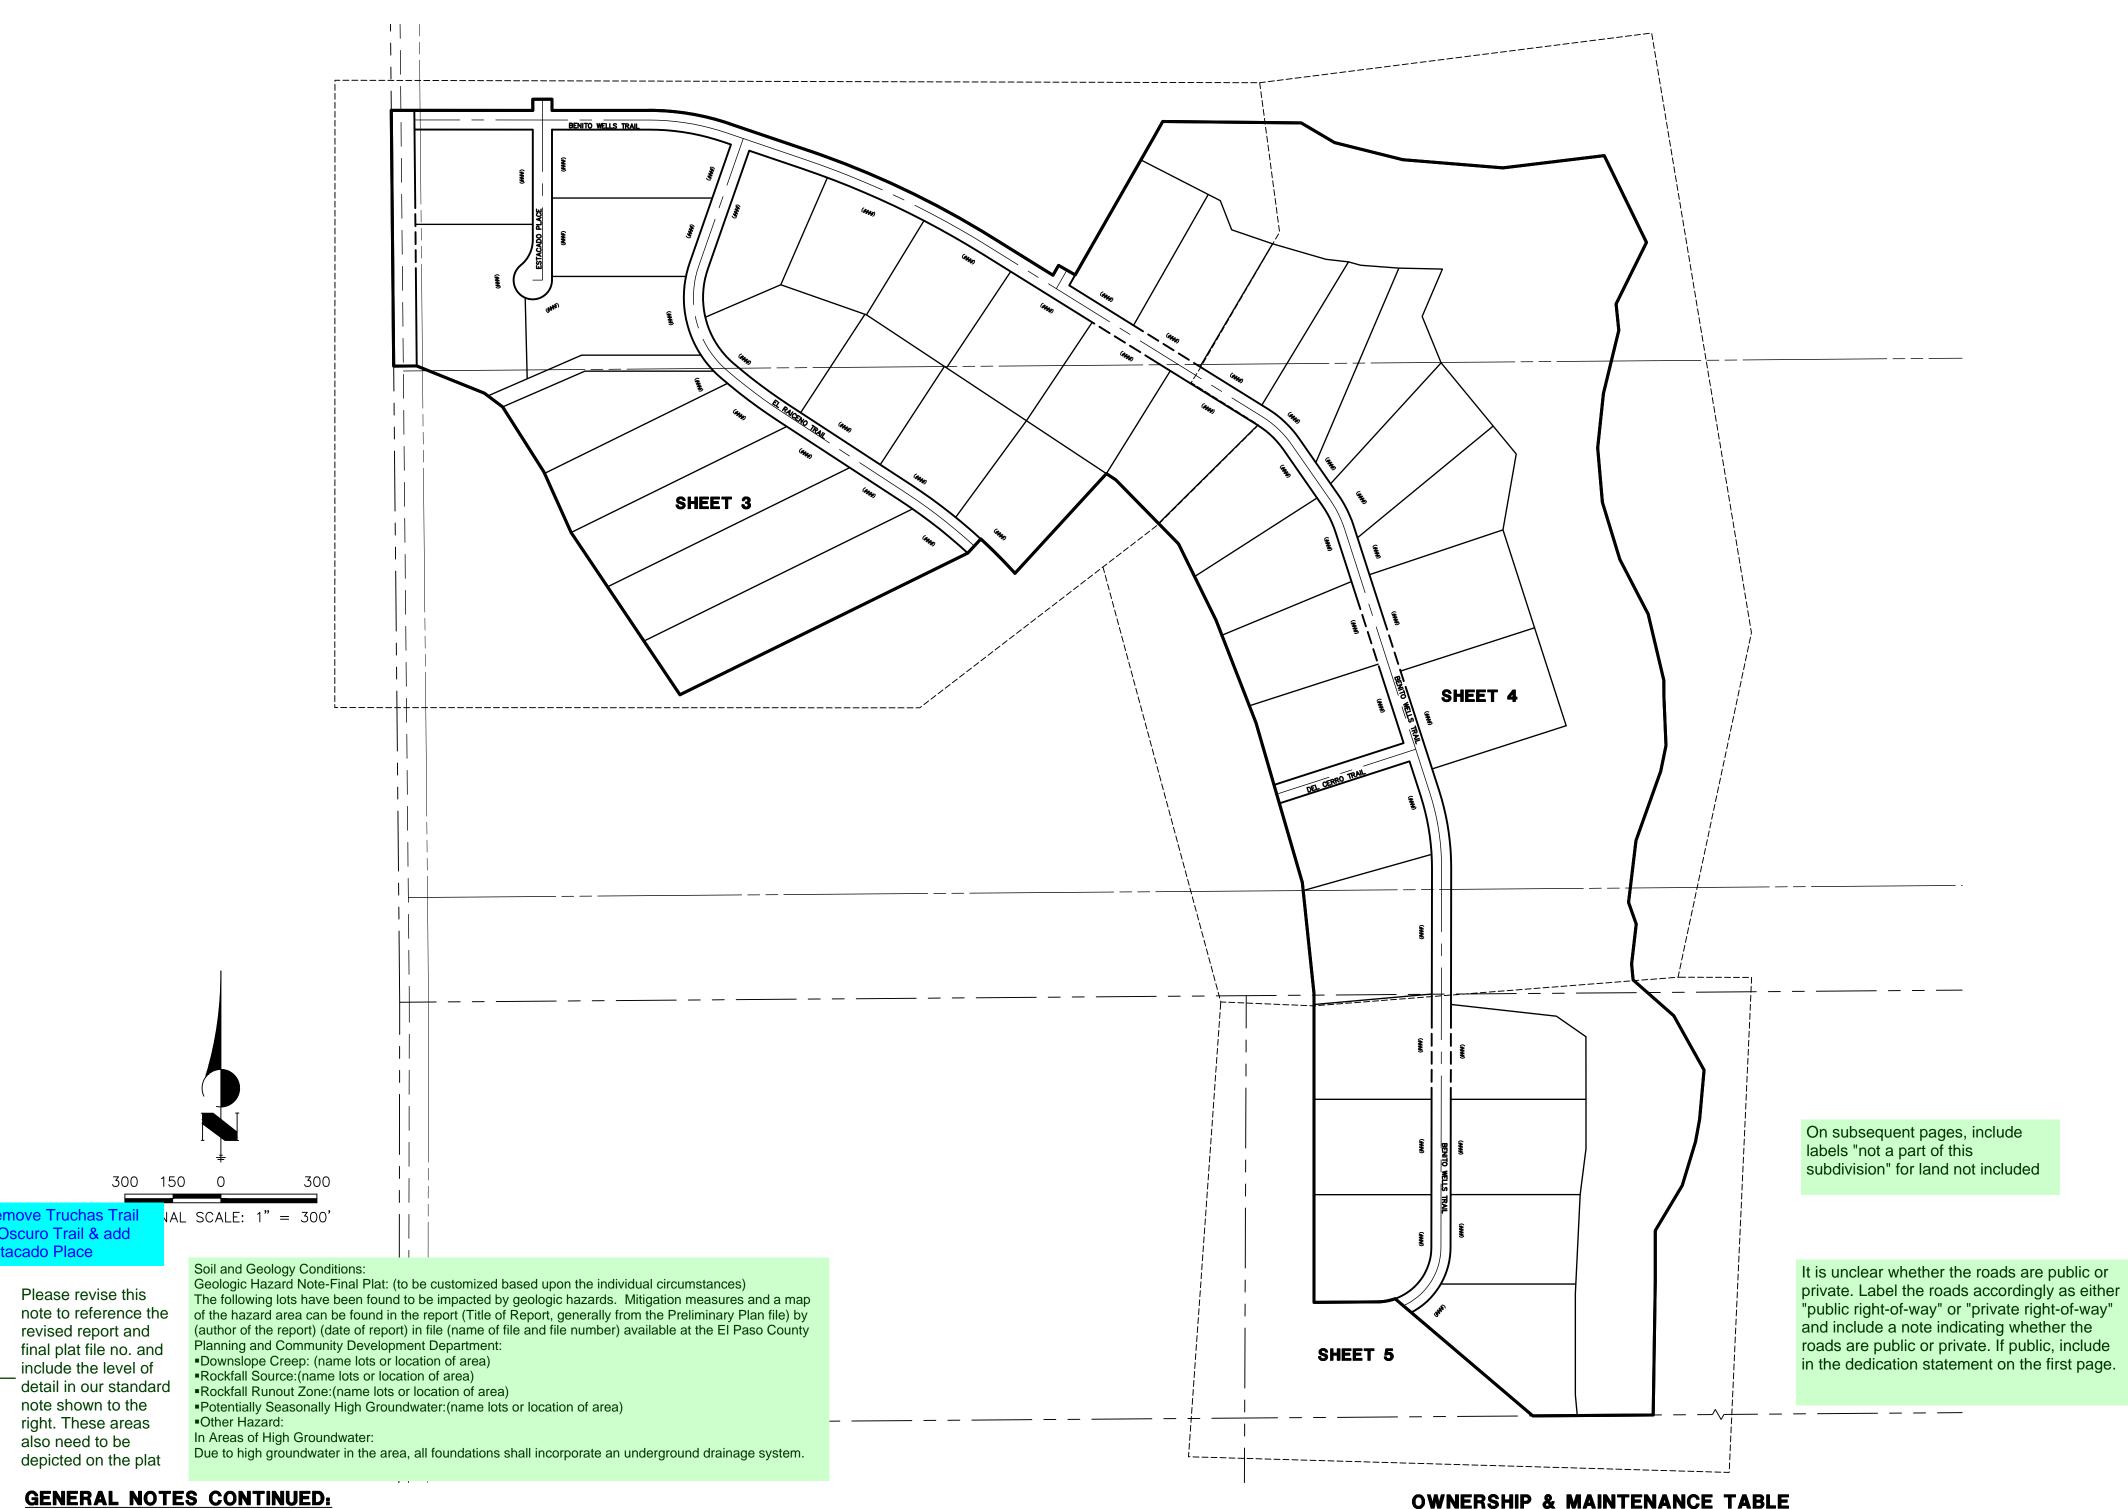

GENERAL NOTES CONTINUED:

- 23. THIS PROPERTY IS INCLUDED WITHIN A SPECIAL TAXING DISTRICT, SADDLEHORN RANCH METROPOLITAN DISTRICT, CREATED OF THE PURPOSE OF CONSTRUCTING AND MAINTAINING CERTAIN PUBLIC IMPROVEMENTS, DRAINAGE AND RECREATION IMPROVEMENTS. SPECIAL TAXING DISTRICTS ARE SUBJECT TO GENERAL OBLIGATION INDEBTEDNESS THAT IS PAID BY REVENUES PRODUCED FROM ANNUAL TAX LEVIES ON THE TAXABLE PROPERTY WITHIN SUCH DISTRICTS. THE BUYER SHOULD FAMILIARIZE HIMSELF / HERSELF WITH THE POTENTIALITY AND RAMIFICATIONS THEREOF.
- 24. THE TEMPORARY TURNAROUND EASEMENT AS SHOWN ON THIS PLAT AND REFERENCED IN THE EASEMENT AGREEMENT AS RECORDED AT RECEPTION NOS. OF THE RECORDS OF EL PASO AND COUNTY WILL BE VACATED UPON THE COMPLETION OF ROADWAY CONSTRUCTION OF EL RAICENO TRAIL AND CARRANZA K TRAIL WITH A FUTURE FINAL PLAT.
- 25. WATER IN THE DENVER BASIN AQUIFERS IS ALLOCATED BASED ON A 100 YEAR AQUIFER LIFE; HOWEVER, FOR EL PASO COUNTY PLANNING PURPOSES, WATER IN THE DENVER BASIN AQUIFERS IS EVALUATED BASED ON A 300 YEAR AQUIFER LIFE. APPLICANT AND ALL FUTURE OWNERS IN THE SUBDIVISION SHOULD BE AWARE THAT THE ECONOMIC LIFE OF A WATER SUPPLY BASED ON WELLS IN A GIVEN DENVER BASIN AQUIFER MAY BE LESS THAN EITHER THE 100 YEARS OR 300 YEARS USED FOR ALLOCATION INDICATED DUE TO ANTICIPATED WATER LEVEL DECLINES. FURTHERMORE, THE WATER SUPPLY PLAN SHOULD NOT RELY SOLELY UPON NON-RENEWABLE AQUIFERS. ALTERNATIVE RENEWABLE WATER RESOURCES SHOULD BE ACQUIRED AND INCORPORATED IN A PERMANENT WATER SUPPLY PLAN THAT PROVIDES FUTURE GENERATIONS WITH A WATER SUPPLY.

Add note regarding nearby in vicinity to project and ems which may be encountered because of that.

USE	OWNER	MAINTENANCE
EN SPACE, DRAINAGE	SADDLEHORN REANCH METROPOLITAN DISTRICT	SADDLEHORN REANCH METROPOLITAN DISTRIC
EN SPACE, DRAINAGE	SADDLEHORN REANCH METROPOLITAN DISTRICT	SADDLEHORN REANCH METROPOLITAN DISTRIC

TOTAL LOT AREA | 5120401 | 117.5482 TOTAL ROW AREA | 577,172 | 13.2500 TOTAL SITE AREA | 7,669,842 | 1,76.0754 |

TOTAL TRACT AREA | 1,972,269 | 45.2771

AREA (SF) | AREA (AC) |

1,937,962 | 44.4895 | OPE

34,307 | 0.7876 | OPE


No Temporary ırnarounds are shown. emove note.


Include the final total gross acreage, the total number of lots, gross density, net density and net acreage of the

JOB NO. 25142.04 JUNE 3, 2021 SHEET 2 OF 5




Centennial 303-740-9393 • Colorado Springs 719-593-2593 Fort Collins 970-491-9888 • www.jrengineering.com

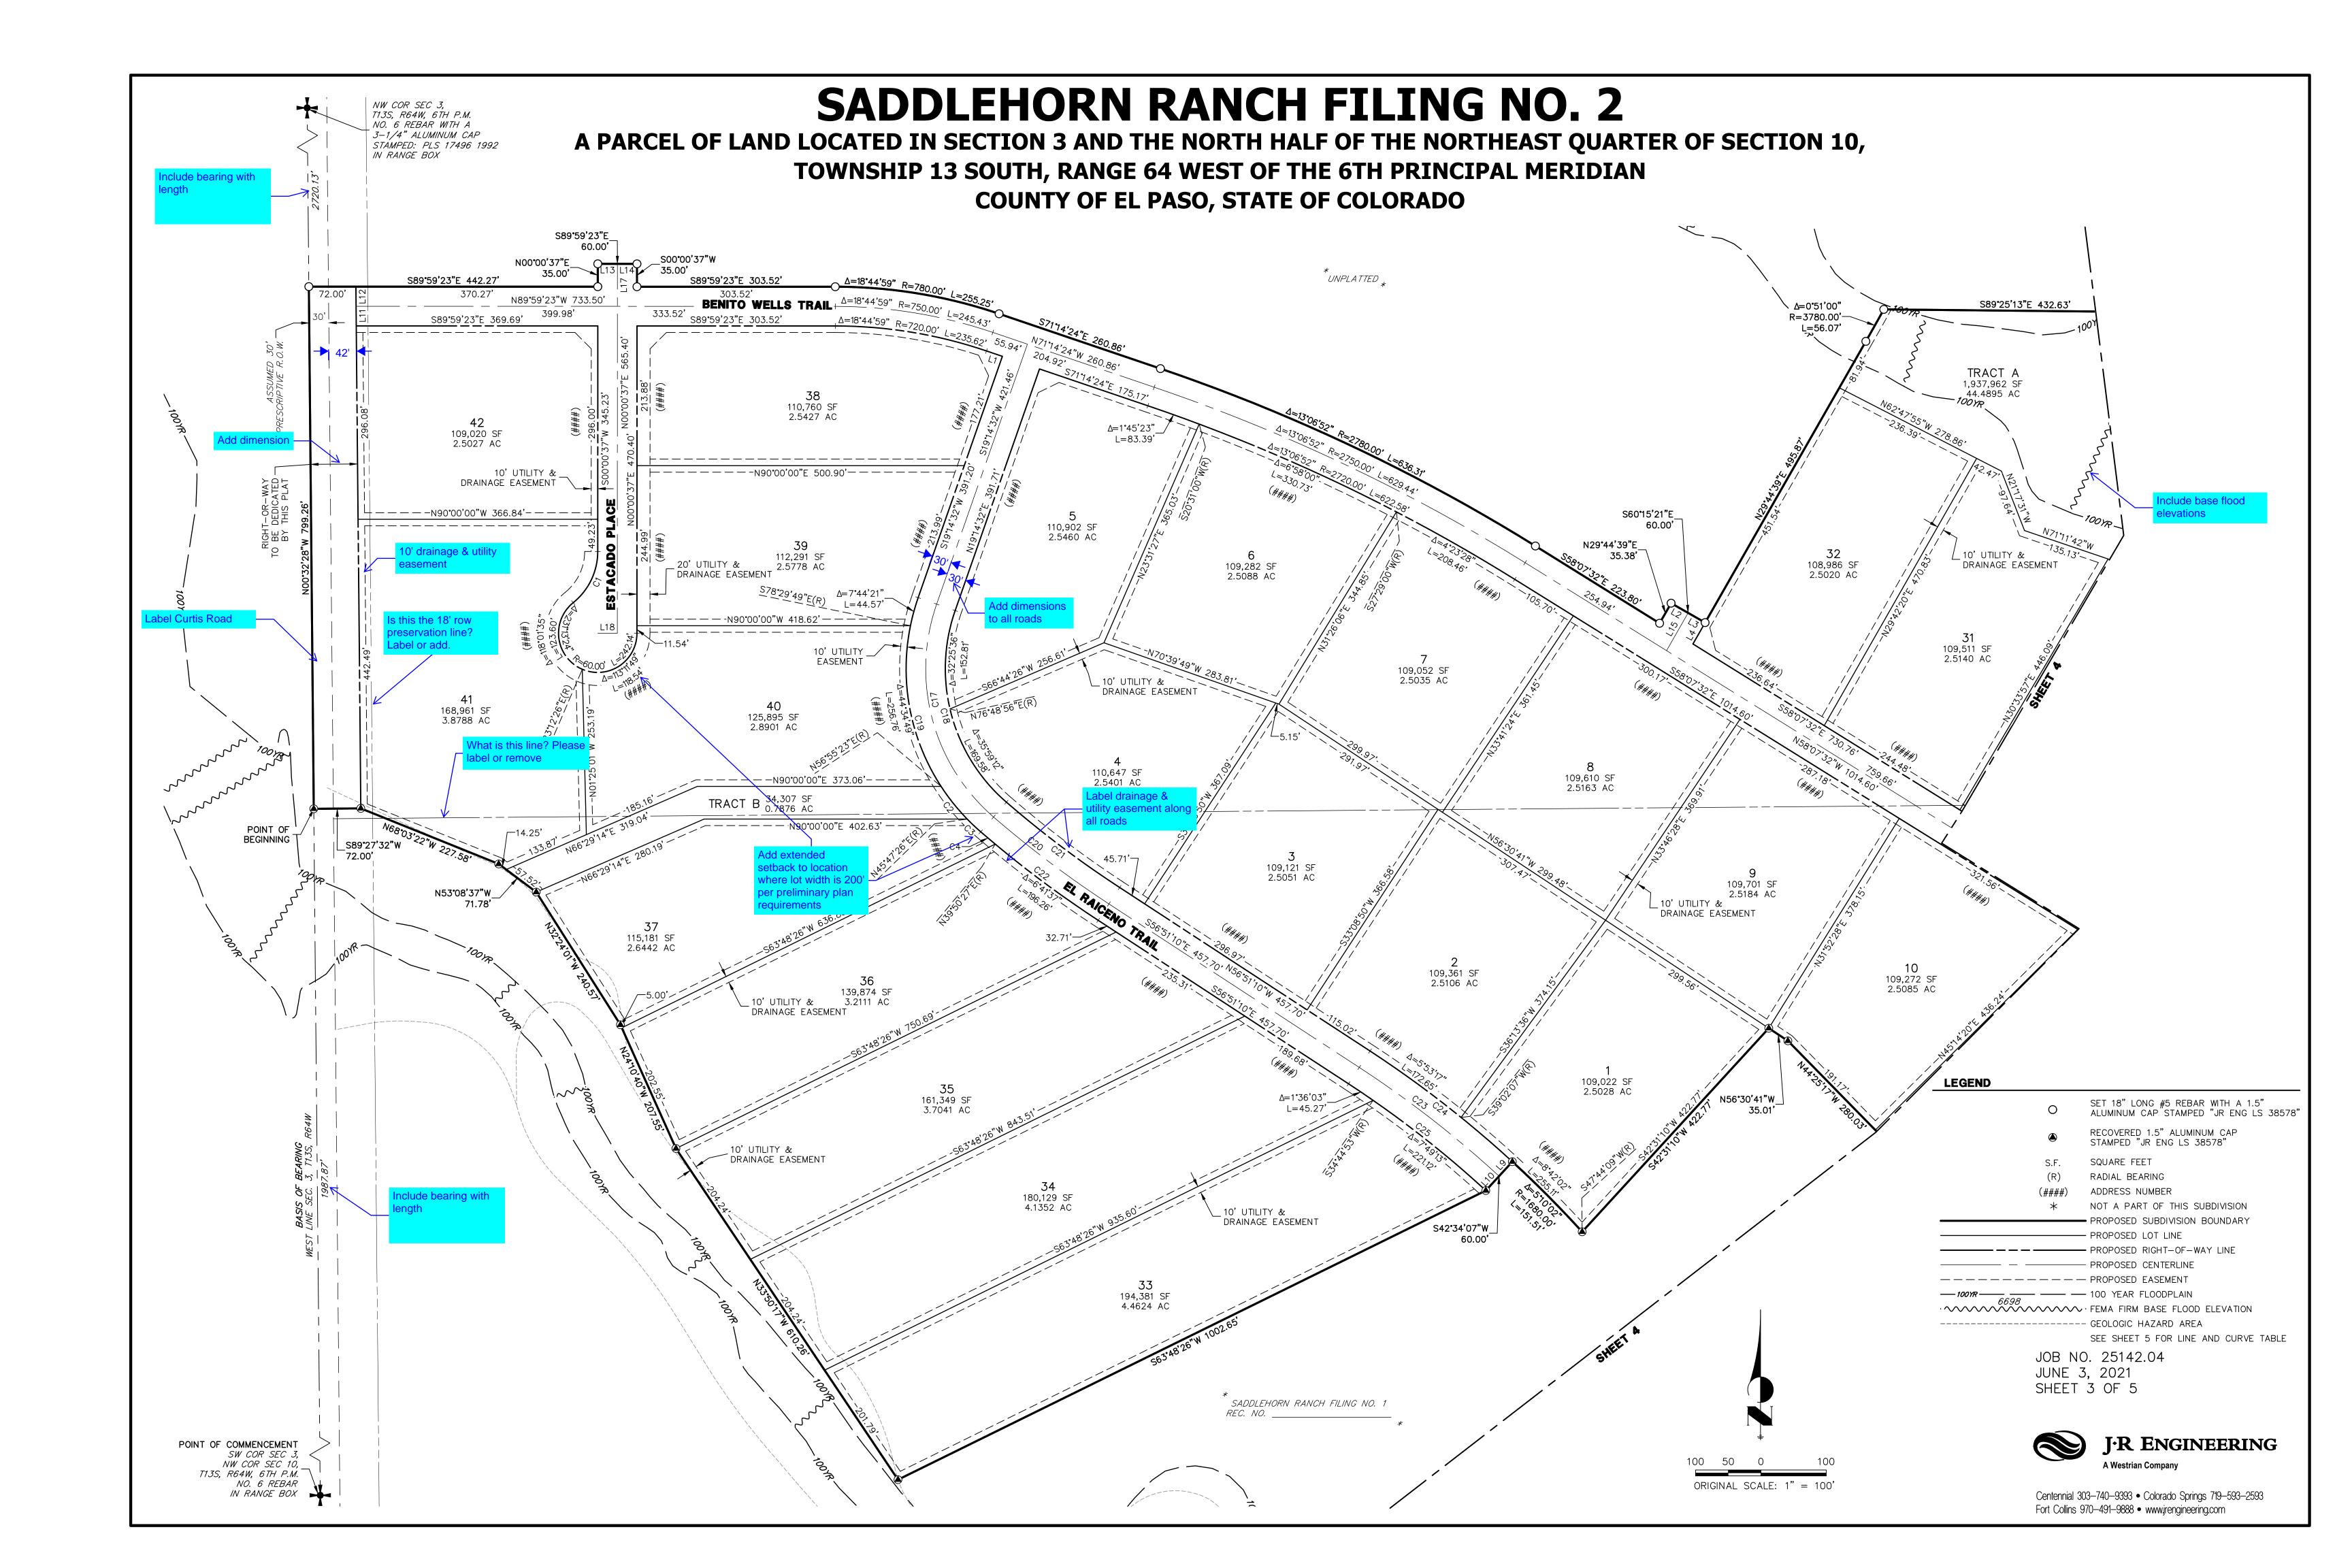

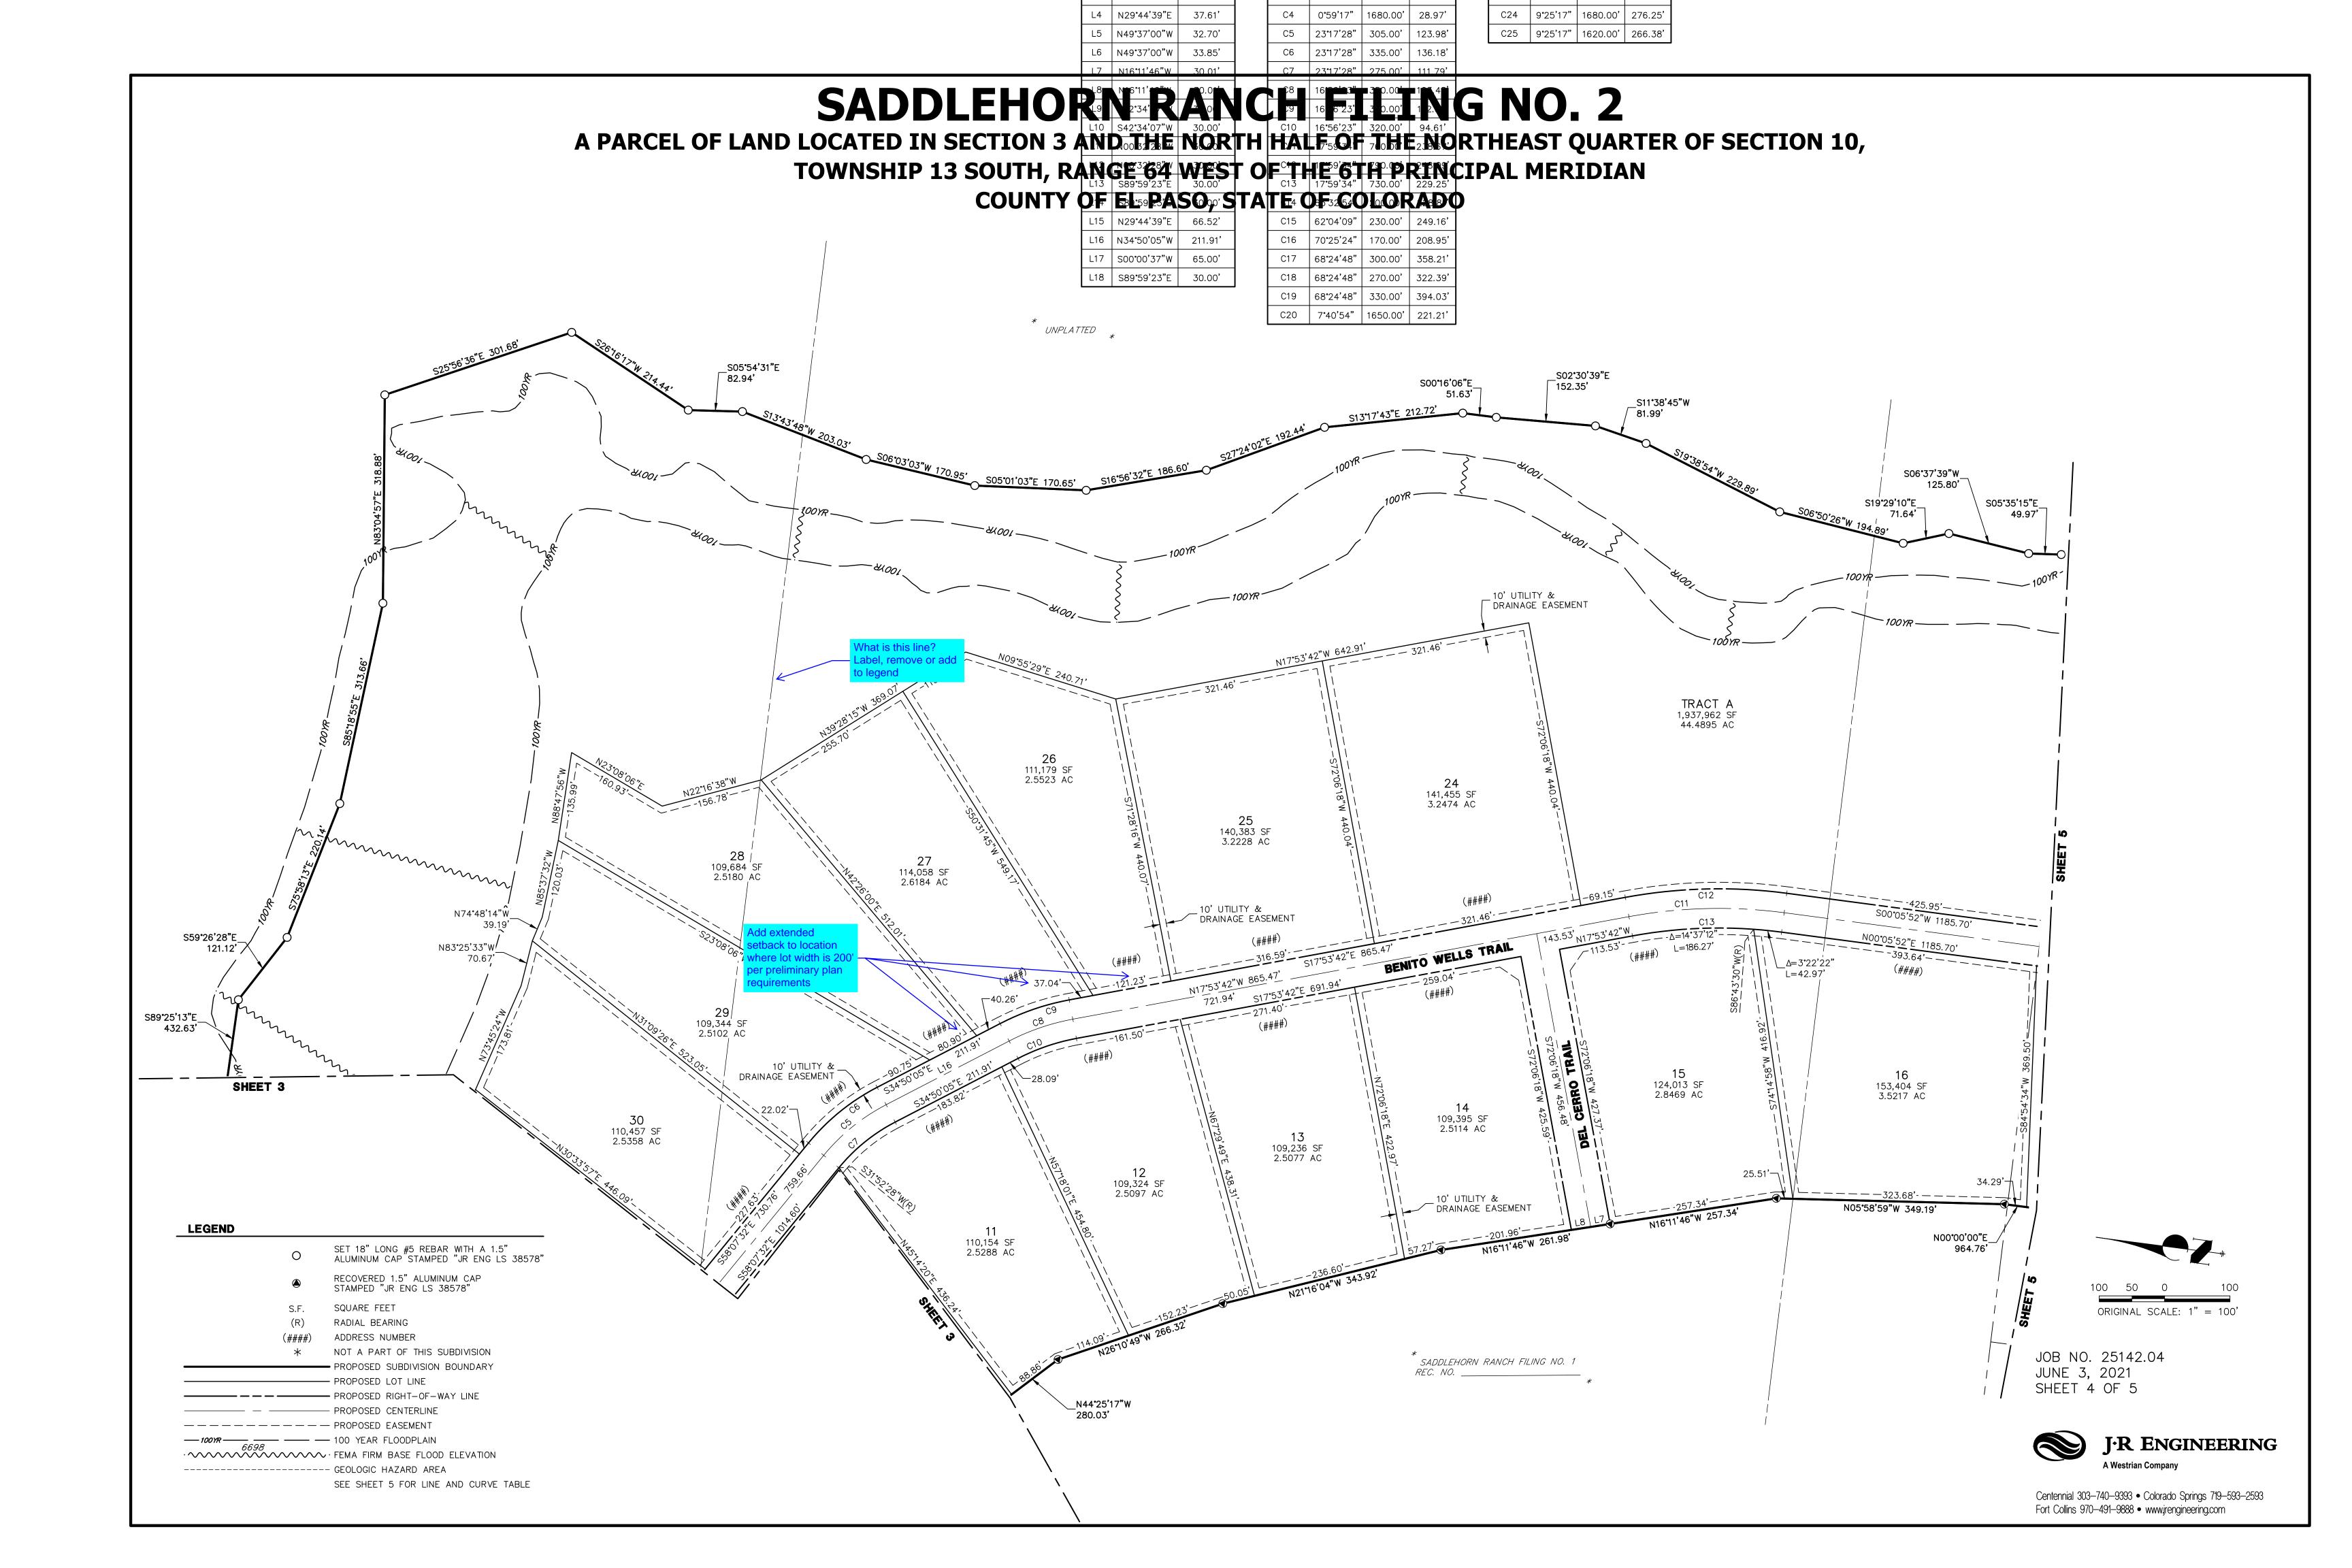

SADDLEHORN RANCH FILING NO. 2

A PARCEL OF LAND LOCATED IN SECTION 3 AND THE NORTH HALF OF THE NORTHEAST QUARTER OF SECTION 10,
TOWNSHIP 13 SOUTH, RANGE 64 WEST OF THE 6TH PRINCIPAL MERIDIAN
COUNTY OF EL PASO, STATE OF COLORADO

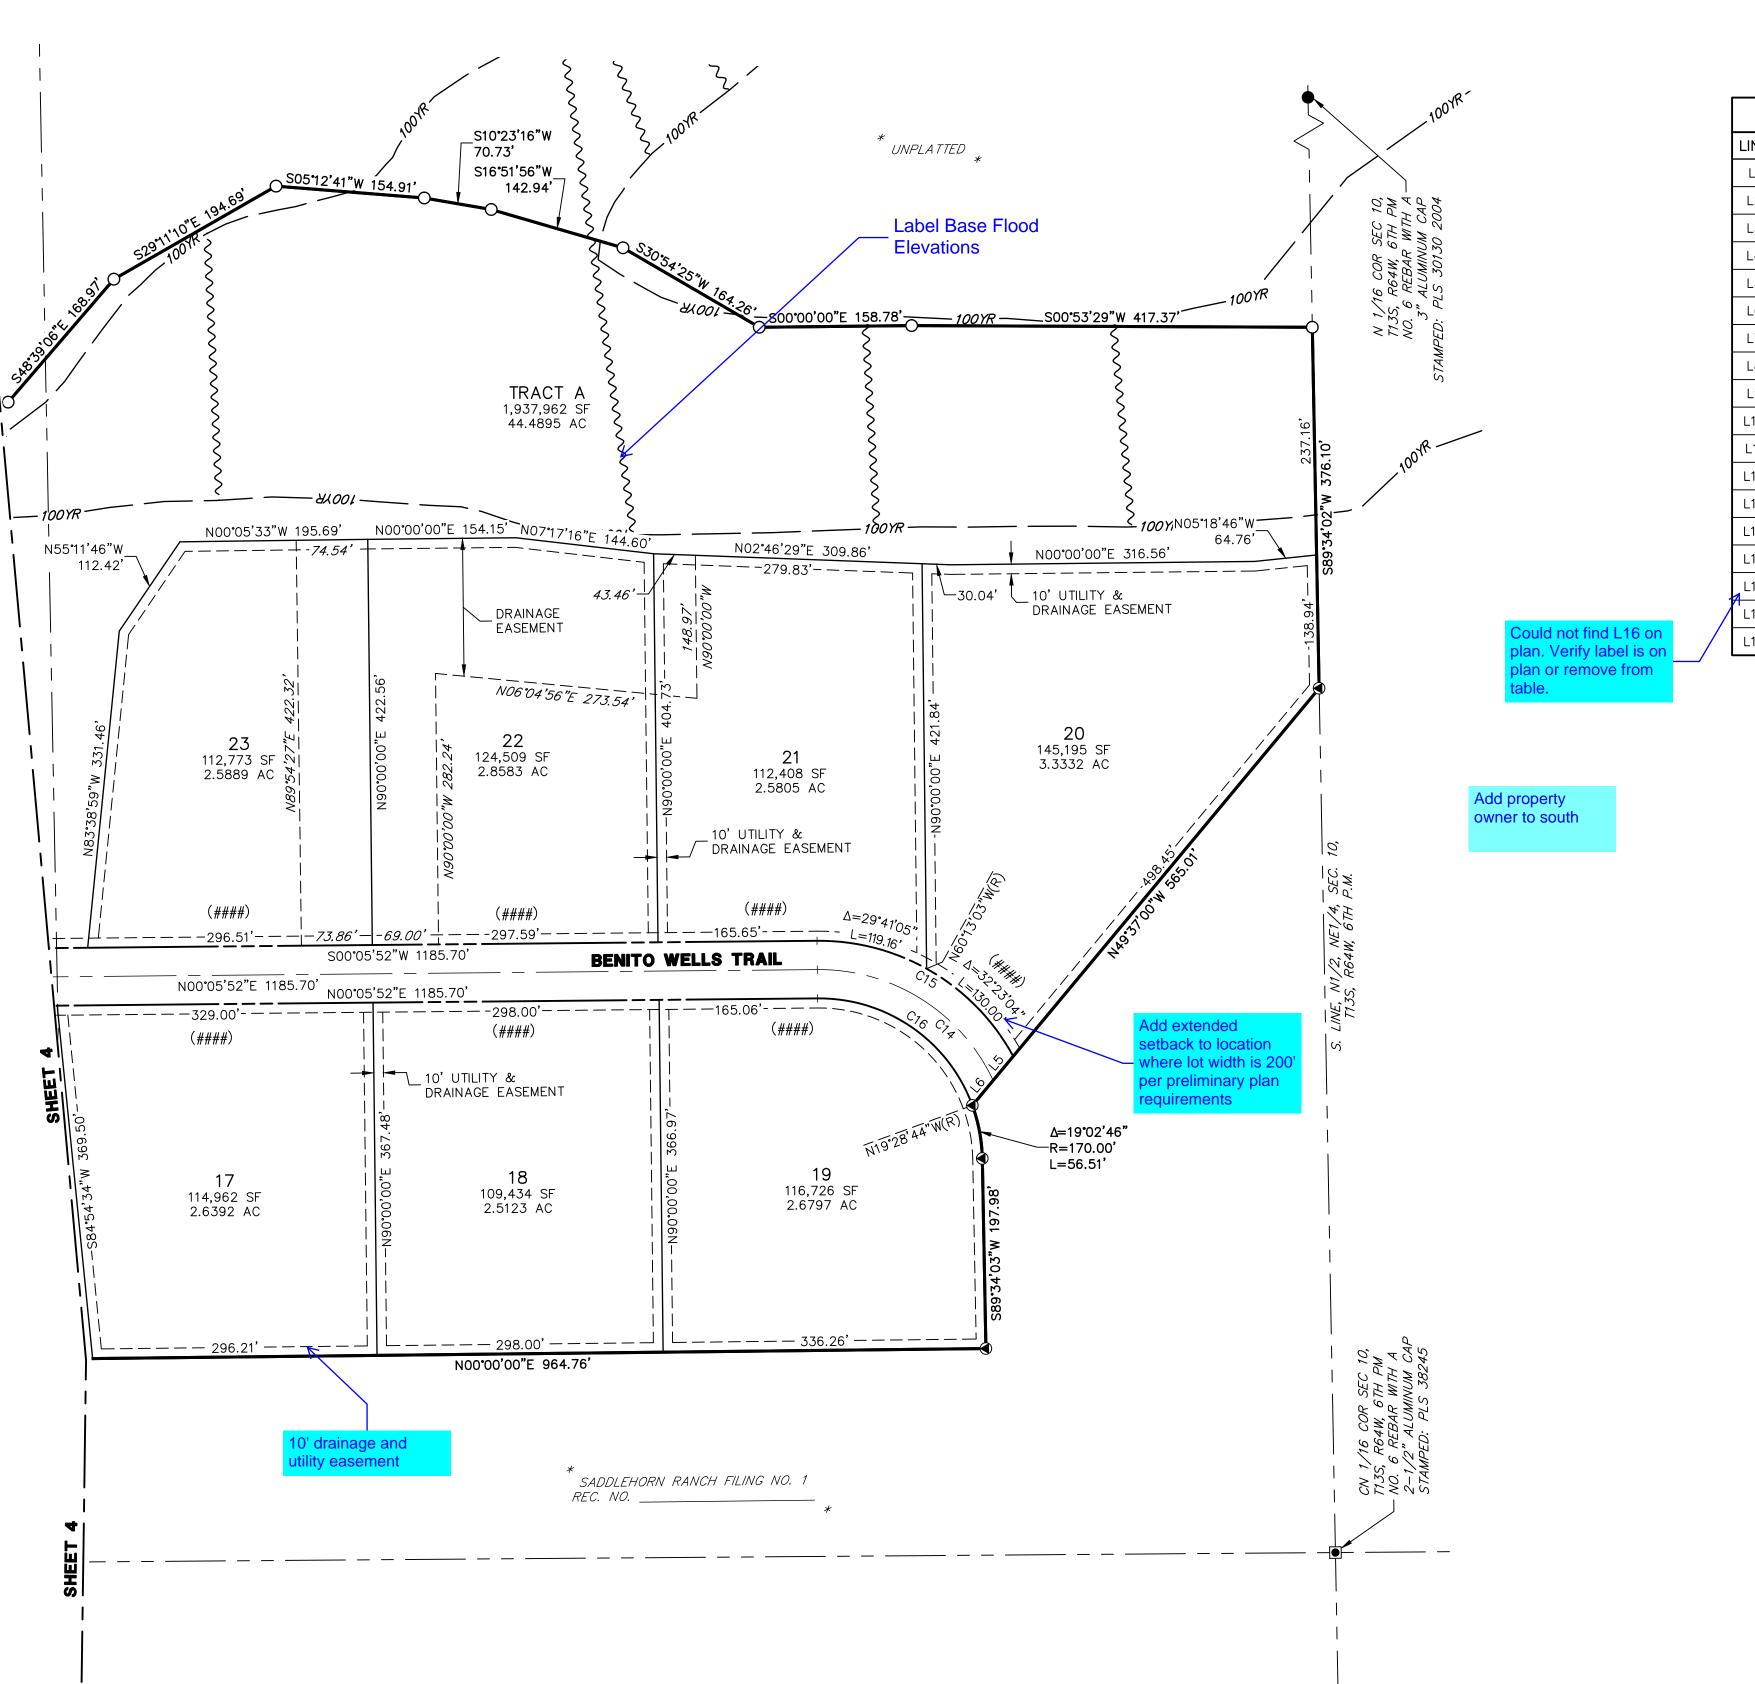

LINE TABLE			
LINE	BEARING	DISTANCE	
L1	S71°14'24"E	25.69'	
L2	S60°15'21"E	30.00'	
L3	S60°15'21"E	30.00'	
L4	N29°44'39"E	37.61'	
L5	N49°37'00"W	32.70'	
L6	N49°37'00"W	33.85'	
L7	N16°11'46"W	30.01'	
L8	N16°11'46"W	30.01	
L9	S42°34'07"W	30.00'	
L10	S42°34'07"W	30.00'	
L11	N00°32'28"W	30.00'	
L12	N00°32'28"W	30.00'	
L13	S89°59'23"E	30.00'	
L14	S89°59'23"E	30.00'	
L15	N29°44'39"E	66.52	
L16	N34°50'05"W	211.91'	
L17	S00°00'37"W	65.00'	
L18	S89°59'23"E	30.00'	

	CURVE	TABLE	
RVE	DELTA	RADIUS	LENGTH
C1	51°13'24"	100.55	89.89'
2	11°07'56"	330.00'	64.12'
:3	4°57'43"	330.00'	28.58'
:4	0°59'17"	1680.00'	28.97'
:5	23°17'28"	305.00'	123.98'
6	23°17'28"	335.00'	136.18
:7	23°17'28"	275.00'	111.79'
:8	16 ° 56'23"	350.00'	103.48
9	16°56'23"	380.00'	112.35
10	16 ° 56'23"	320.00'	94.61'
11	17°59'34"	760.00'	238.67
12	17°59'34"	790.00'	248.09
13	17 ° 59'34"	730.00'	229.25
14	65°32'54"	200.00'	228.81
15	62°04'09"	230.00'	249.16'
16	70°25'24"	170.00'	208.95
17	68 ° 24'48"	300.00'	358.21
18	68 ° 24'48"	270.00'	322.39
19	68°24'48"	330.00'	394.03'
20	7°40'54"	1650.00'	221.21

CURVE TABLE			
CURVE	DELTA	RADIUS	LENGTH
C21	7°40'54"	1620.00'	217.19'
C22	7°40'54"	1680.00'	225.23
C23	9°25'17"	1650.00'	271.31'
C24	9°25'17"	1680.00'	276.25
C25	9°25'17"	1620.00'	266.38'

LEGEND

SET 18" LONG #5 REBAR WITH A 1.5" ALUMINUM CAP STAMPED "JR ENG LS 38578"

RECOVERED 1.5" ALUMINUM CAP STAMPED "JR ENG LS 38578"

S.F. SQUARE FEET

R) RADIAL BEARING

ADDRESS NUMBER

* NOT A PART OF THIS SUBDIVISION PROPOSED SUBDIVISION BOUNDARY

PROPOSED LOT LINE

PROPOSED RIGHT-OF-WAY LINE
PROPOSED CENTERLINE

_____ PROPOSED EASEMENT

· · · · · FEMA FIRM BASE FLOOD ELEVATION
----- GEOLOGIC HAZARD AREA

SEE SHEET 5 FOR LINE AND CURVE TABLE



100 50 0 100

ORIGINAL SCALE: 1" = 100'

JOB NO. 25142.04 JUNE 3, 2021 SHEET 5 OF 5



Centennial 303-740-9393 • Colorado Springs 719-593-2593 Fort Collins 970-491-9888 • www.jrengineering.com