

STERLING RANCH SKETCH PLAN AMENDMENT

SECTION 27, TOWNSHIP 12, RANGE 65 WEST OF THE 6TH P.M., EL PASO, CO

No. 4 Minor Amendment

LAND USE LEGEND:

31 AC. RESIDENTIAL: 2.5 DU/AC	9 D.U.
105 AC. RESIDENTIAL: 2 DU/AC	151 D.U.
882 A.C. RESIDENTIAL: 3-5 DU/AC	2,766 D.U.
129 AC. RESIDENTIAL: 5-8 DU/AC	600 D.U.
47 AC. MIXED USE 8-25 DU/AC *	600 D.U.
50 AC. ELEMENTARY / K-8 SCHOOL	
18 AC. NEIGHBORHOOD PARK	
28 AC. COMMUNITY PARK	
62 AC. OPEN SPACE / PARK / GREENWAY	
40 AC. OPEN SPACE / BUFFER	
11.5 AC. UTILITY PARCEL	
5 AC. INDUSTRIAL	
35.5 AC. RIGHT-OF-WAY	
TOTAL: 1,444 AC.	TOTAL: 4,800 D.U. Max

* COMMERCIAL / MULTIFAMILY UP TO 25 DU/AC

LEGAL DESCRIPTION:

THE WEST HALF OF THE WEST HALF OF THE EAST HALF AND EAST HALF OF THE WEST HALF AND THE SOUTHWEST QUARTER OF THE SOUTHWEST QUARTER OF SECTION 27; THE EAST HALF OF THE SOUTHEAST QUARTER AND THAT PORTION OF THE SOUTHWEST QUARTER OF THE SOUTHWEST QUARTER LYING SOUTH AND EAST OF THE COUNTY ROAD KNOWN AS VOLLMER ROAD, OF SECTION 28, THE WEST HALF OF THE EAST HALF AND THE WEST HALF OF SECTION 34; THE EAST HALF AND THE EAST HALF OF THE SOUTHWEST QUARTER AND THE SOUTHWEST QUARTER OF THE SOUTHWEST QUARTER OF SECTION 33, AND ALL THAT PART OF THE NORTHWEST QUARTER OF SECTION 33 LYING SOUTH AND EAST OF THE COUNTY ROAD KNOWN AS VOLLMER ROAD, EXCEPT THAT PORTION OF THE SOUTHWEST QUARTER OF THE NORTHWEST QUARTER OF SAID SECTION 33 LYING SOUTH AND EAST OF SAID COUNTY ROAD AS DEEDED TO COLORADO INTERSTATE GAS COMPANY BY WARRANTY DEED RECORDED IN BOOK 1173 AT PAGE 359; AND THAT PORTION OF THE NORTHEAST QUARTER OF THE SOUTHEAST QUARTER AND THE SOUTHWEST QUARTER OF THE SOUTHWEST QUARTER LYING SOUTHWEST OF THE COUNTY ROAD KNOWN AS VOLLMER ROAD, OF SECTION 32, EXCEPT THAT PORTION OF THE NORTHEAST QUARTER OF THE SOUTHWEST QUARTER OF SAID SECTION 32 DEEDED TO I. MARCUS BROWN BY TRUSTEES' DEED RECORDED IN BOOK 3292 AT PAGE 168; ALL IN TOWNSHIP 12 SOUTH, RANGE 65 WEST OF THE 6TH P.M., EL PASO COUNTY, COLORADO. ALL THAT PORTION OF THE NORTHWEST QUARTER OF THE SOUTHWEST QUARTER OF SECTION 28, TOWNSHIP 12 SOUTH, RANGE 65 WEST OF THE 6TH P.M., EL PASO COUNTY, COLORADO LYING SOUTH AND EAST OF THE COUNTY ROAD (VOLLMER ROAD), ALSO: THE NORTHWEST QUARTER OF THE NORTHWEST QUARTER OF SECTION 4, TOWNSHIP 13 SOUTH, RANGE 65 WEST OF THE SIXTH PRINCIPAL MERIDIAN, LYING SOUTHERLY OF AN EXISTING EAST- WEST FENCE AS DESCRIBED IN SPECIAL WARRANTY DEED RECORDED DECEMBER 23, 2004 AT RECEPTION NO. 204209417, COUNTY OF EL PASO, STATE OF COLORADO, ALSO: THE SOUTHWEST QUARTER OF THE SOUTHWEST QUARTER OF THE SOUTHWEST QUARTER OF SECTION 32, TOWNSHIP 12 SOUTH, RANGE 65 WEST OF THE 6TH P.M., LYING SOUTHEASTERLY OF THE PUBLIC ROAD KNOWN AS VOLLMER ROAD, EL PASO COUNTY, COLORADO, AND CONTAINING 1443.695 ACRES MORE OR LESS.

OWNERS OF AMENDED AREA:

CLASSIC SRJ LAND, LLC
2138 FLYING HORSE CLUB DRIVE
COLORADO SPRINGS, CO 80921

SYMBOL LEGEND:

- ROAD
- FULL MOVEMENT ACCESS POINT
- 3/4 MOVEMENT
- RI/RO
- 100-YEAR FLOODPLAIN
- TRAIL
- BUFFER / OS TRAIL CORRIDOR / EASEMENT
- NEIGHBORHOOD PARK
- AQUATIC RESOURCES

AMENDED AREA DESCRIPTION:

THE APPROXIMATE AREA OF THIS AMENDMENT (SKP241) IS 166 ACRES.


- GENERAL NOTES:**
- THERE ARE AQUATIC RESOURCES ON THE SITE, PRESUMED TO BE NON-JURISDICTIONAL DUE TO THEIR LACK OF SURFACE WATER CONNECTION TO SAND CREEK TO THE WEST OR ANY OTHER DOWNSTREAM WOTUS. AN APPROVED JURISDICTIONAL DETERMINATION MAY BE NEEDED TO CONFIRM THE REGULATORY STATUS OF THE WETLANDS PRESENT. IF THESE WETLANDS ARE DETERMINED TO BE JURISDICTIONAL, A SECTION 404 PERMIT FROM THE USACE WOULD BE REQUIRED. REGARDLESS OF REGULATORY STATUS, THE WETLANDS ON THE SITE WILL BE IMPACTED BY DEVELOPMENT THROUGH FILL AND REGRADING. WETLAND AREAS WITHIN THE OPEN SPACE BUFFER ON THE EASTERN BOUNDARY WILL REMAIN LARGELY UNDISTURBED.

SKP224 CONDITION OF APPROVAL:

- APPLICANT HAS PROVIDED AN UPDATED TRAFFIC IMPACT STUDY WHICH LIMITS THE MAXIMUM DWELLING UNITS TO 4,800 WITH THE APPROVED 2022 SKETCH PLAN AMENDMENT (SKP224).

Overall Development Dwelling Unit Table


FILING	Plat File No.	Lot No.
Sterling Ranch Filing 2	SF2015	49
Sterling Ranch Filing 3	SF2132	63
Sterling Ranch Filing 3A	SF2413	3
Sterling Ranch Filing 4	SF2230	148
Copper Chase	SF2316	138
Branding Iron Filing 1	SF1724	51
Branding Iron Filing 2	SF1918	75
Homestead Filing 1	SF1725	72
Homestead Filing 2	SF194	104
Homestead North Filing 1	SF2213	73
Homestead North Filing 2	SF2218	74
Homestead North Filing 3	SF2229	77
Sterling Ranch East Filing 1	SF2235	294
Sterling Ranch East Filing 2	SF2237	42
FourSquare at Sterling Ranch	SF2236	158
TOTAL ENTITLED UNITS		1483
REMAINING DEVELOPABLE UNITS		3307
MAXIMUM ALLOWED DWELLING UNITS		4800

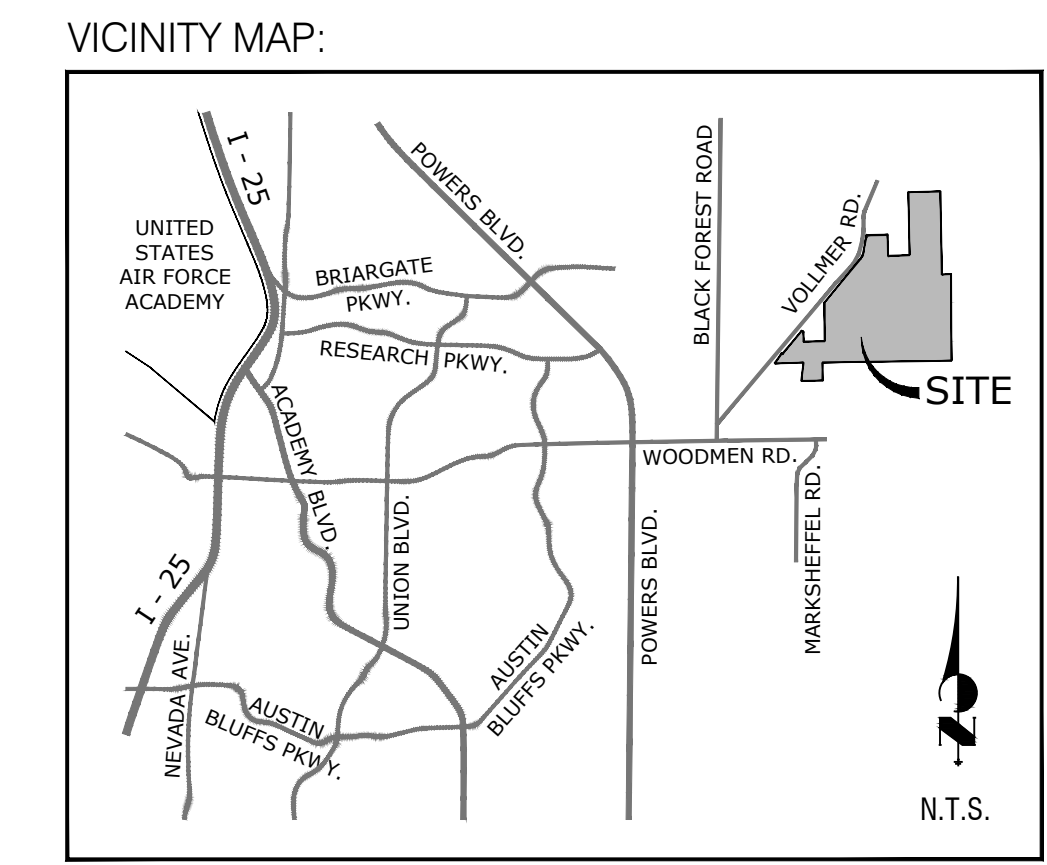

ROAD CLASSIFICATION TABLE

Roadway	Existing	2040 MTCP	2060 MTCP/CPP	Sterling Ranch Proposed
Voller Road	2 lane Collector - 60'	4 lane Minor - 100'	4 lane Minor - 100'	4 lane Minor - 100'
Briargate Parkway	4 lane Principal - 130'	4 lane Principal - 130'	4 lane Principal - 130'	4 lane Principal - 130'
Banning Lewis Parkway	4 lane Principal - 130'	4 lane Principal - 130'	4 lane Principal - 130'	4 lane Principal - TBD
Marksheffel Road	2 lane Principal - 130'	4 lane Principal - 130'	4 lane Principal - 130'	4 lane Principal - TBD *

* A deviation is approved for Marksheffel Road to be built to the City of Colorado Springs standards.

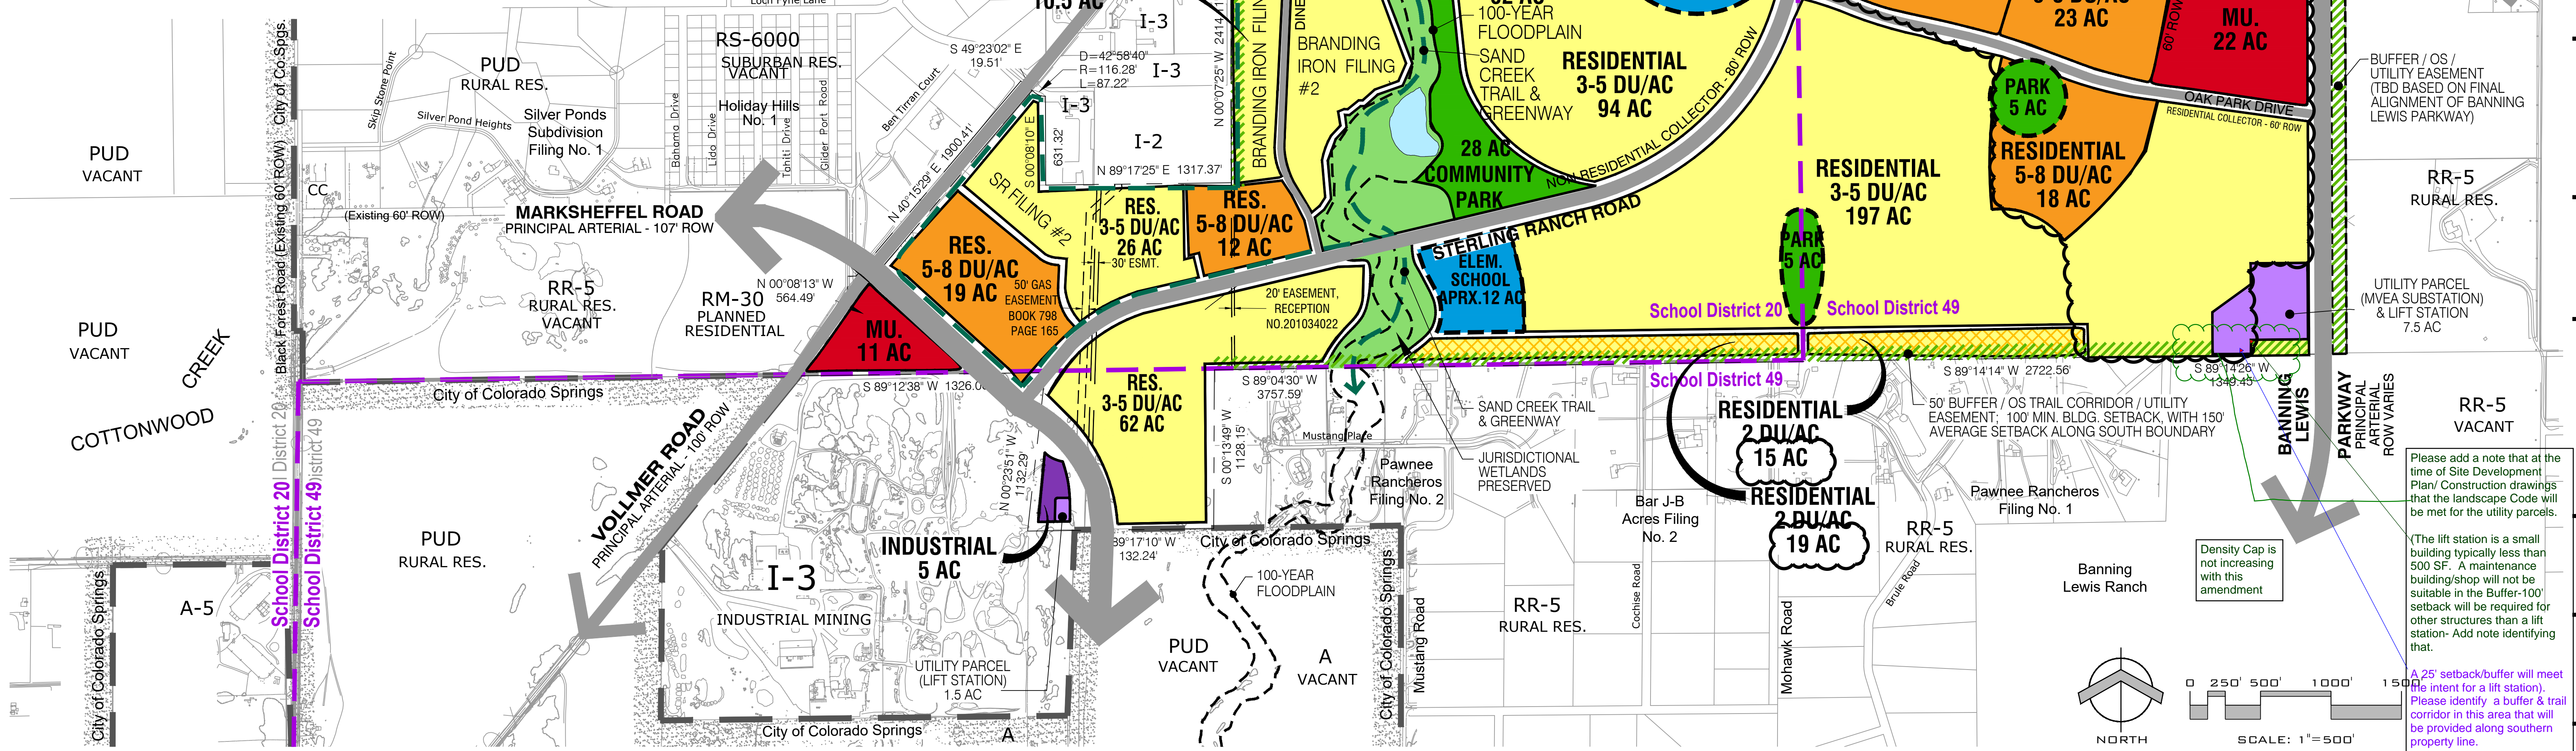

18 acres added 5-8 DU where school site was; 25 acres of 5-8 DU added north of road; and maybe 3 acres utility parcel reconfigured; not seeing the 166 acres...

Land Planning
Landscape Architecture
Urban Design

NES

N.E.S. Inc.
619 N. Cascade Avenue, Suite 200
Colorado Springs, CO 80903

Tel. 719.471.0073
Fax 719.471.0267

www.nescolorado.com

© 2012. All Rights Reserved.

STERLING RANCH

SKETCH PLAN AMENDMENT #4
minor amendment

CLASSIC SRJ LAND, LLC.

DATE: 08/29/2024
PROJECT MGR: A. BARLOW
PREPARED BY: C. HEHLINGER

AMENDMENT #4

DATE: BY: DESCRIPTION:

SCALE: 1" = 500'

1 OF 1

SKP XXX
SKP-241

V1_Sketch Plan Drawing(s).pdf Markup Summary

CDurham (2)

SKP-241

Subject: Text Box
Page Label: [1] SKP
Author: CDurham
Date: 10/11/2024 9:01:04 AM
Status:
Color: ■
Layer:
Space:


SKP-241




Subject: Text Box
Page Label: [1] SKP
Author: CDurham
Date: 10/11/2024 9:04:28 AM
Status:
Color: ■
Layer:
Space:

SKP-241

dsdparsons (10)

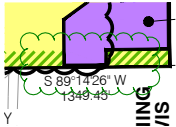

Subject: Cloud
Page Label: [1] SKP
Author: dsdparsons
Date: 10/14/2024 3:16:36 PM
Status:
Color: ■
Layer:
Space:

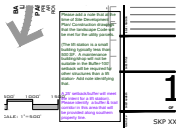


Subject: Text Box
Page Label: [1] SKP
Author: dsdparsons
Date: 10/14/2024 3:27:25 PM
Status:
Color: ■
Layer:
Space:


Please add a note that at the time of Site Development Plan/ Construction drawings that the landscape Code will be met for the utility parcels.

(The lift station is a small building typically less than 500 SF. A maintenance building/shop will not be suitable in the Buffer-100' setback will be required for other structures than a lift station- Add note identifying that.


A 25' setback/buffer will meet the intent for a lift station). Please identify a buffer & trail corridor in this area that will be provided along southern property line.

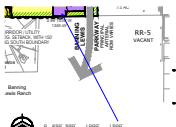

Subject: Arrow
Page Label: [1] SKP
Author: dsdparsons
Date: 10/14/2024 3:26:40 PM
Status:
Color: ■
Layer:
Space:

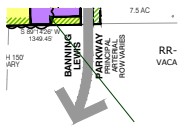

Subject: Arrow
Page Label: [1] SKP
Author: dsdparsons
Date: 10/14/2024 3:26:51 PM
Status:
Color: ■
Layer:
Space:

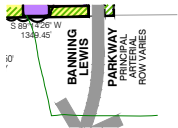

Subject: Pen
Page Label: [1] SKP
Author: dsdparsons
Date: 10/14/2024 3:26:33 PM
Status:
Color: ■
Layer:
Space:

L

Density Cap is not increasing with this amendment

Subject: Text Box
Page Label: [1] SKP
Author: dsdparsons
Date: 10/14/2024 3:33:04 PM
Status:
Color: ■
Layer:
Space:

Density Cap is not increasing with this amendment

No. 4 Minor Amendment



Subject: Text Box
Page Label: [1] SKP
Author: dsdparsons
Date: 10/14/2024 3:36:42 PM
Status:
Color: ■
Layer:
Space:

No. 4 Minor Amendment

SKETCH PLAN AMENDMENT #4 minor amendment

CLASSIC SRS LAND, LLC.

Subject: Text Box
Page Label: [1] SKP
Author: dsdparsons
Date: 10/14/2024 3:37:11 PM
Status:
Color: ■
Layer:
Space:

minor amendment

18 acres added 5-8 DU where school site was ; 25 acres of 5-8 DU added north of road; and maybe 3 acres utility parcel reconfigured; not seeing the 166 acres...

Subject: Planner
Page Label: [1] SKP
Author: dsdparsons
Date: 10/14/2024 3:45:46 PM
Status:
Color: ■
Layer:
Space:

18 acres added 5-8 DU where school site was ; 25 acres of 5-8 DU added north of road; and maybe 3 acres utility parcel reconfigured; not seeing the 166 acres...



Subject: Arrow
Page Label: [1] SKP
Author: dsdparsons
Date: 10/14/2024 3:44:57 PM
Status:
Color: ■
Layer:
Space: