


V2_Sketch Plan.pdf Markup Summary



_____ Subject: Image Page Label: [1] SKP Author: dsdparsons Date: 1/10/2024 4:00:52 PM Status: Color: 📕 Layer: Space:

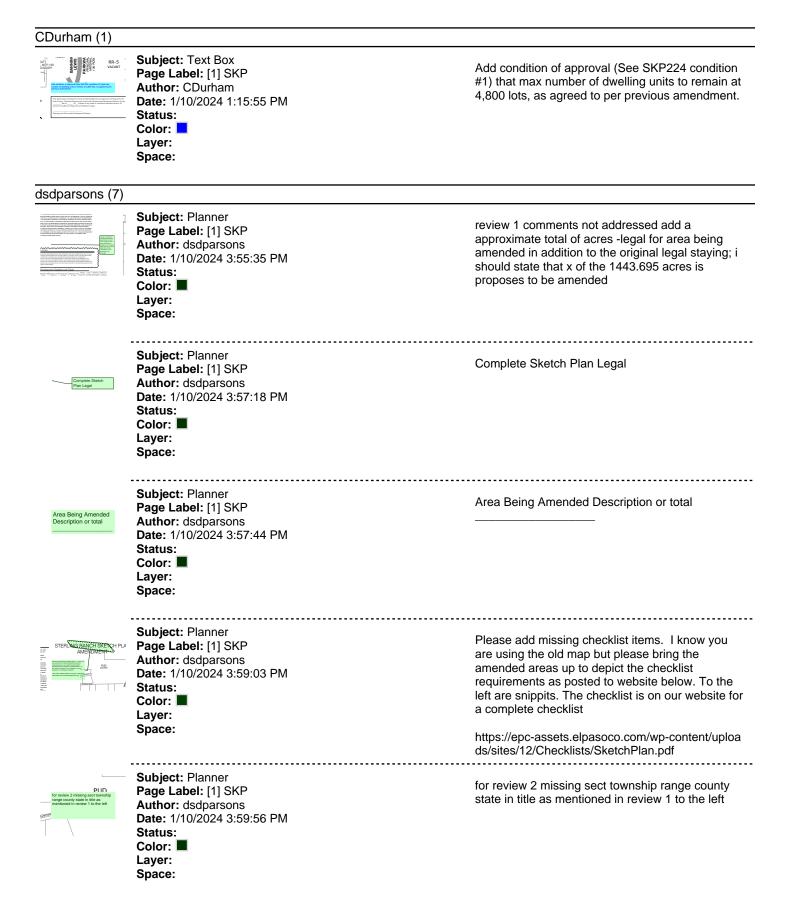

_____ Subject: Planner Page Label: [1] SKP Author: dsdparsons Date: 1/10/2024 4:01:48 PM Status: Color: Layer: Space:

this will go to PC and BOCC so delete- a resolution will be recorded