


What does this line represent? Based on the assessor's it does not appear that this is a separate parcel. Revise to accurately reflect what is shown on the assessor's site.

Identify the property line

Show the distance from each structure to the closest lot line.

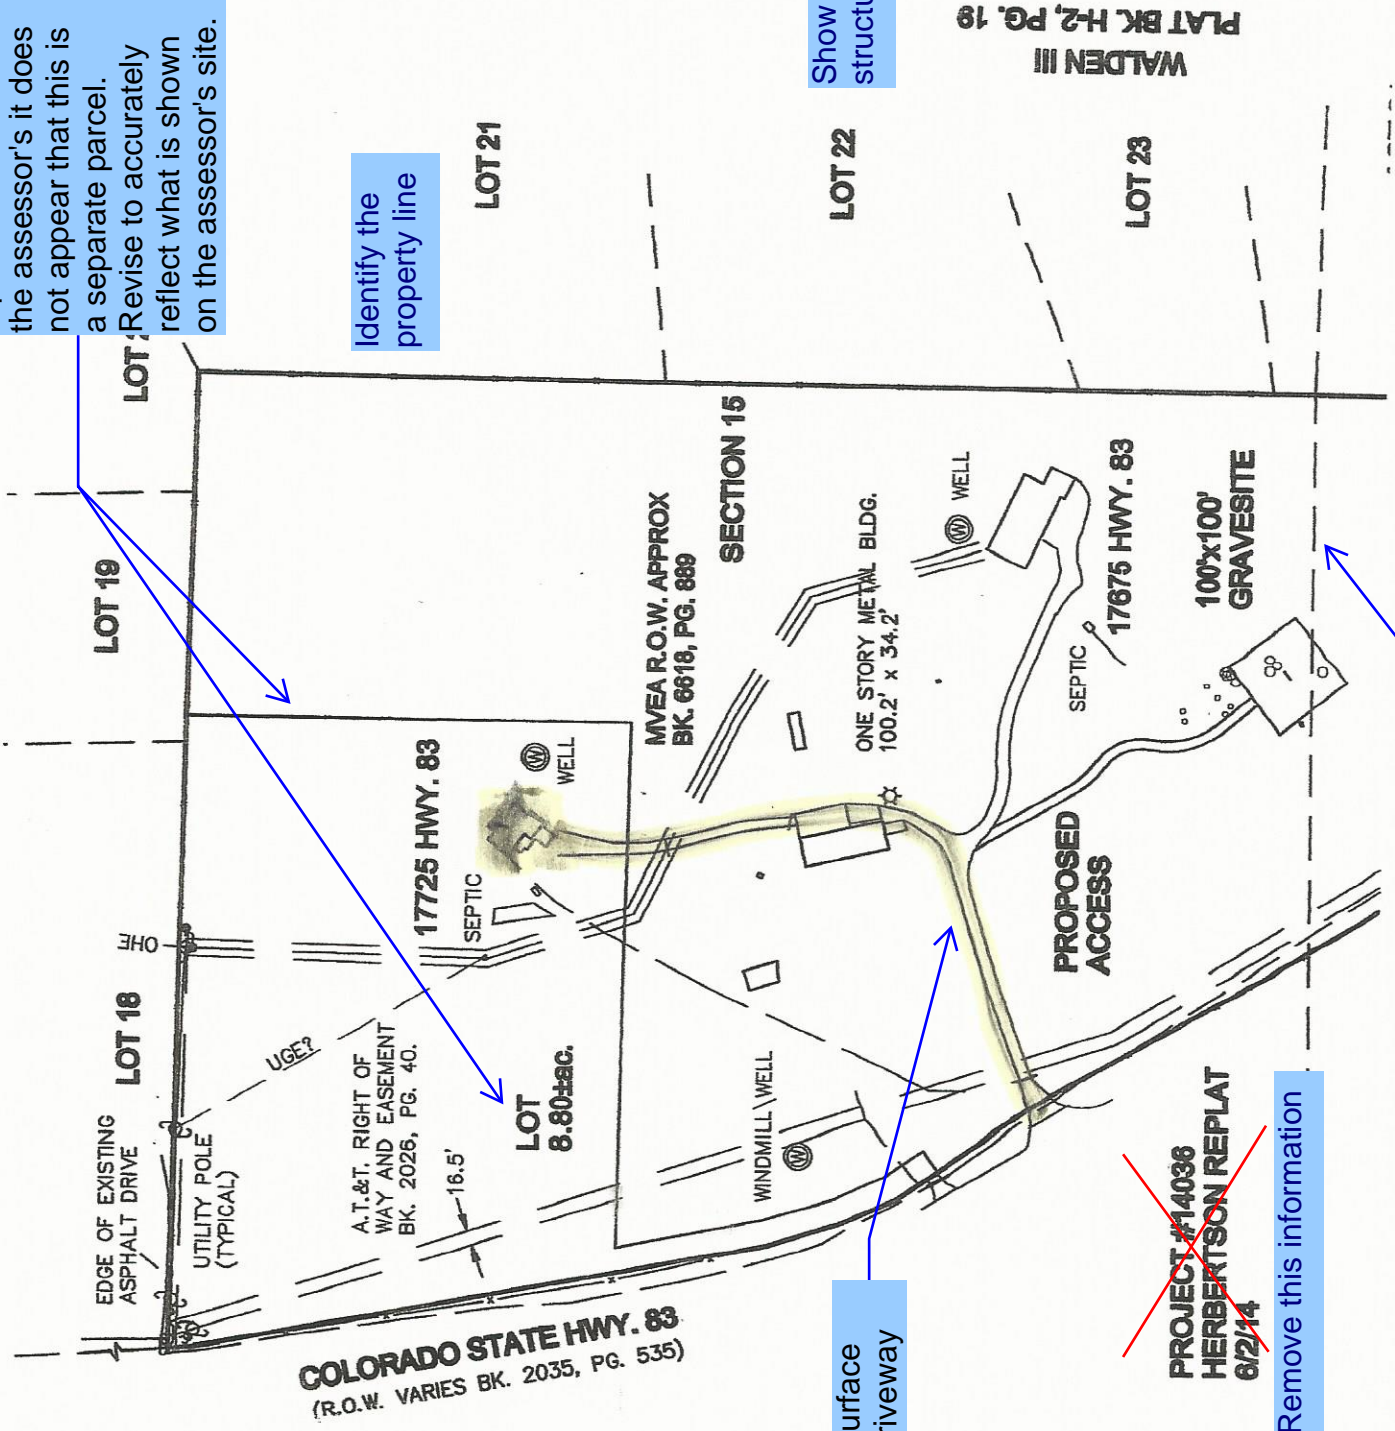


Identify the surface type of the driveway

Remove this information


Identify what this dashed line represents.

Markup Summary


dsdgrimm (9)

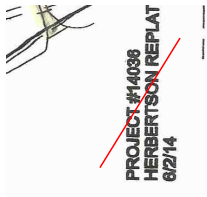

Subject: Line
Page Label: 1
Lock: Unlocked
Author: dsdgrimm
Date: 3/21/2019 11:21:59 AM
Color: ■

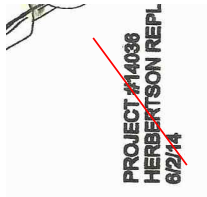


Subject: Line
Page Label: 1
Lock: Unlocked
Author: dsdgrimm
Date: 3/21/2019 11:22:02 AM
Color: ■

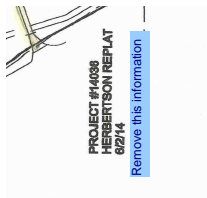

Subject: Engineer
Page Label: 1
Lock: Unlocked
Author: dsdgrimm
Date: 3/21/2019 11:22:29 AM
Color: ■

Remove this information

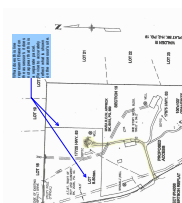

Subject: Engineer
Page Label: 1
Lock: Unlocked
Author: dsdgrimm
Date: 3/21/2019 11:24:16 AM
Color: ■

What does this line represent? Based on the assessor's it does not appear that this is a separate parcel. Revise to accurately reflect what is shown on the assessor's site.



Subject: Engineer
Page Label: 1
Lock: Unlocked
Author: dsdgrimm
Date: 3/21/2019 11:24:56 AM
Color: ■

Identify the property line




Subject: Engineer
Page Label: 1
Lock: Unlocked
Author: dsdgrimm
Date: 3/21/2019 11:25:41 AM
Color: ■

Add PCD File No. VA193




Subject: Engineer
Page Label: 1
Lock: Unlocked
Author: dsdgrimm
Date: 3/21/2019 11:26:30 AM
Color: ■

Identify what this dashed line represents.

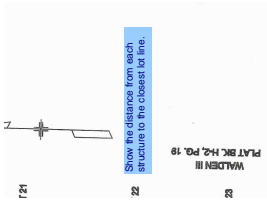

Subject: Engineer
Page Label: 1
Lock: Unlocked
Author: dsdgrimm
Date: 3/21/2019 11:44:43 AM
Color: ■

Show the distance from each structure to the closest lot line.

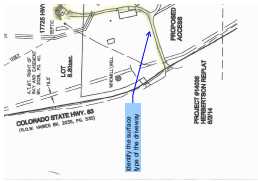

Subject: Engineer
Page Label: 1
Lock: Unlocked
Author: dsdgrimm
Date: 3/21/2019 11:49:22 AM
Color: ■

Identify the surface type of the driveway